

ATTACHMENT NO.8



FACILITY SITE PLAN AND WAREHOUSE DRAWING

LEGAL DESCRIPTION

A SURVEY OF LOTS 8 THRU 14, INCLUSIVE, BLOCK 1, ORIENT PARK, AS RECORDED IN PLAT BOOK 11, PAGE 7, PUBLIC RECORDS OF HILLSBOROUGH COUNTY, FLORIDA; TOGETHER WITH THE EAST 1/2 OF THAT PORTION OF 72ND STREET (62ND STREET PER PLAT) ABUTTING LOTS, BLOCK 1, AND LOT 2, BLOCK 2, OF STATED ORIENT PARK.

DESCRIPTION: (WATER LINE EASEMENT)

THE SOUTH 5.0 FEET OF LOTS 8 THRU 14, INCLUSIVE, BLOCK 1, ORIENT PARK, AS RECORDED IN PLAT BOOK 11, PAGE 7, PUBLIC RECORDS OF HILLSBOROUGH COUNTY, FLORIDA; TOGETHER WITH THE SOUTH 5.0 FEET OF THE EAST 1/2 OF THAT PORTION OF 72ND STREET (62ND STREET PER PLAT) ABUTTING LOT 8, BLOCK 1, AND LOT 2, BLOCK 2, OF STATED ORIENT PARK.

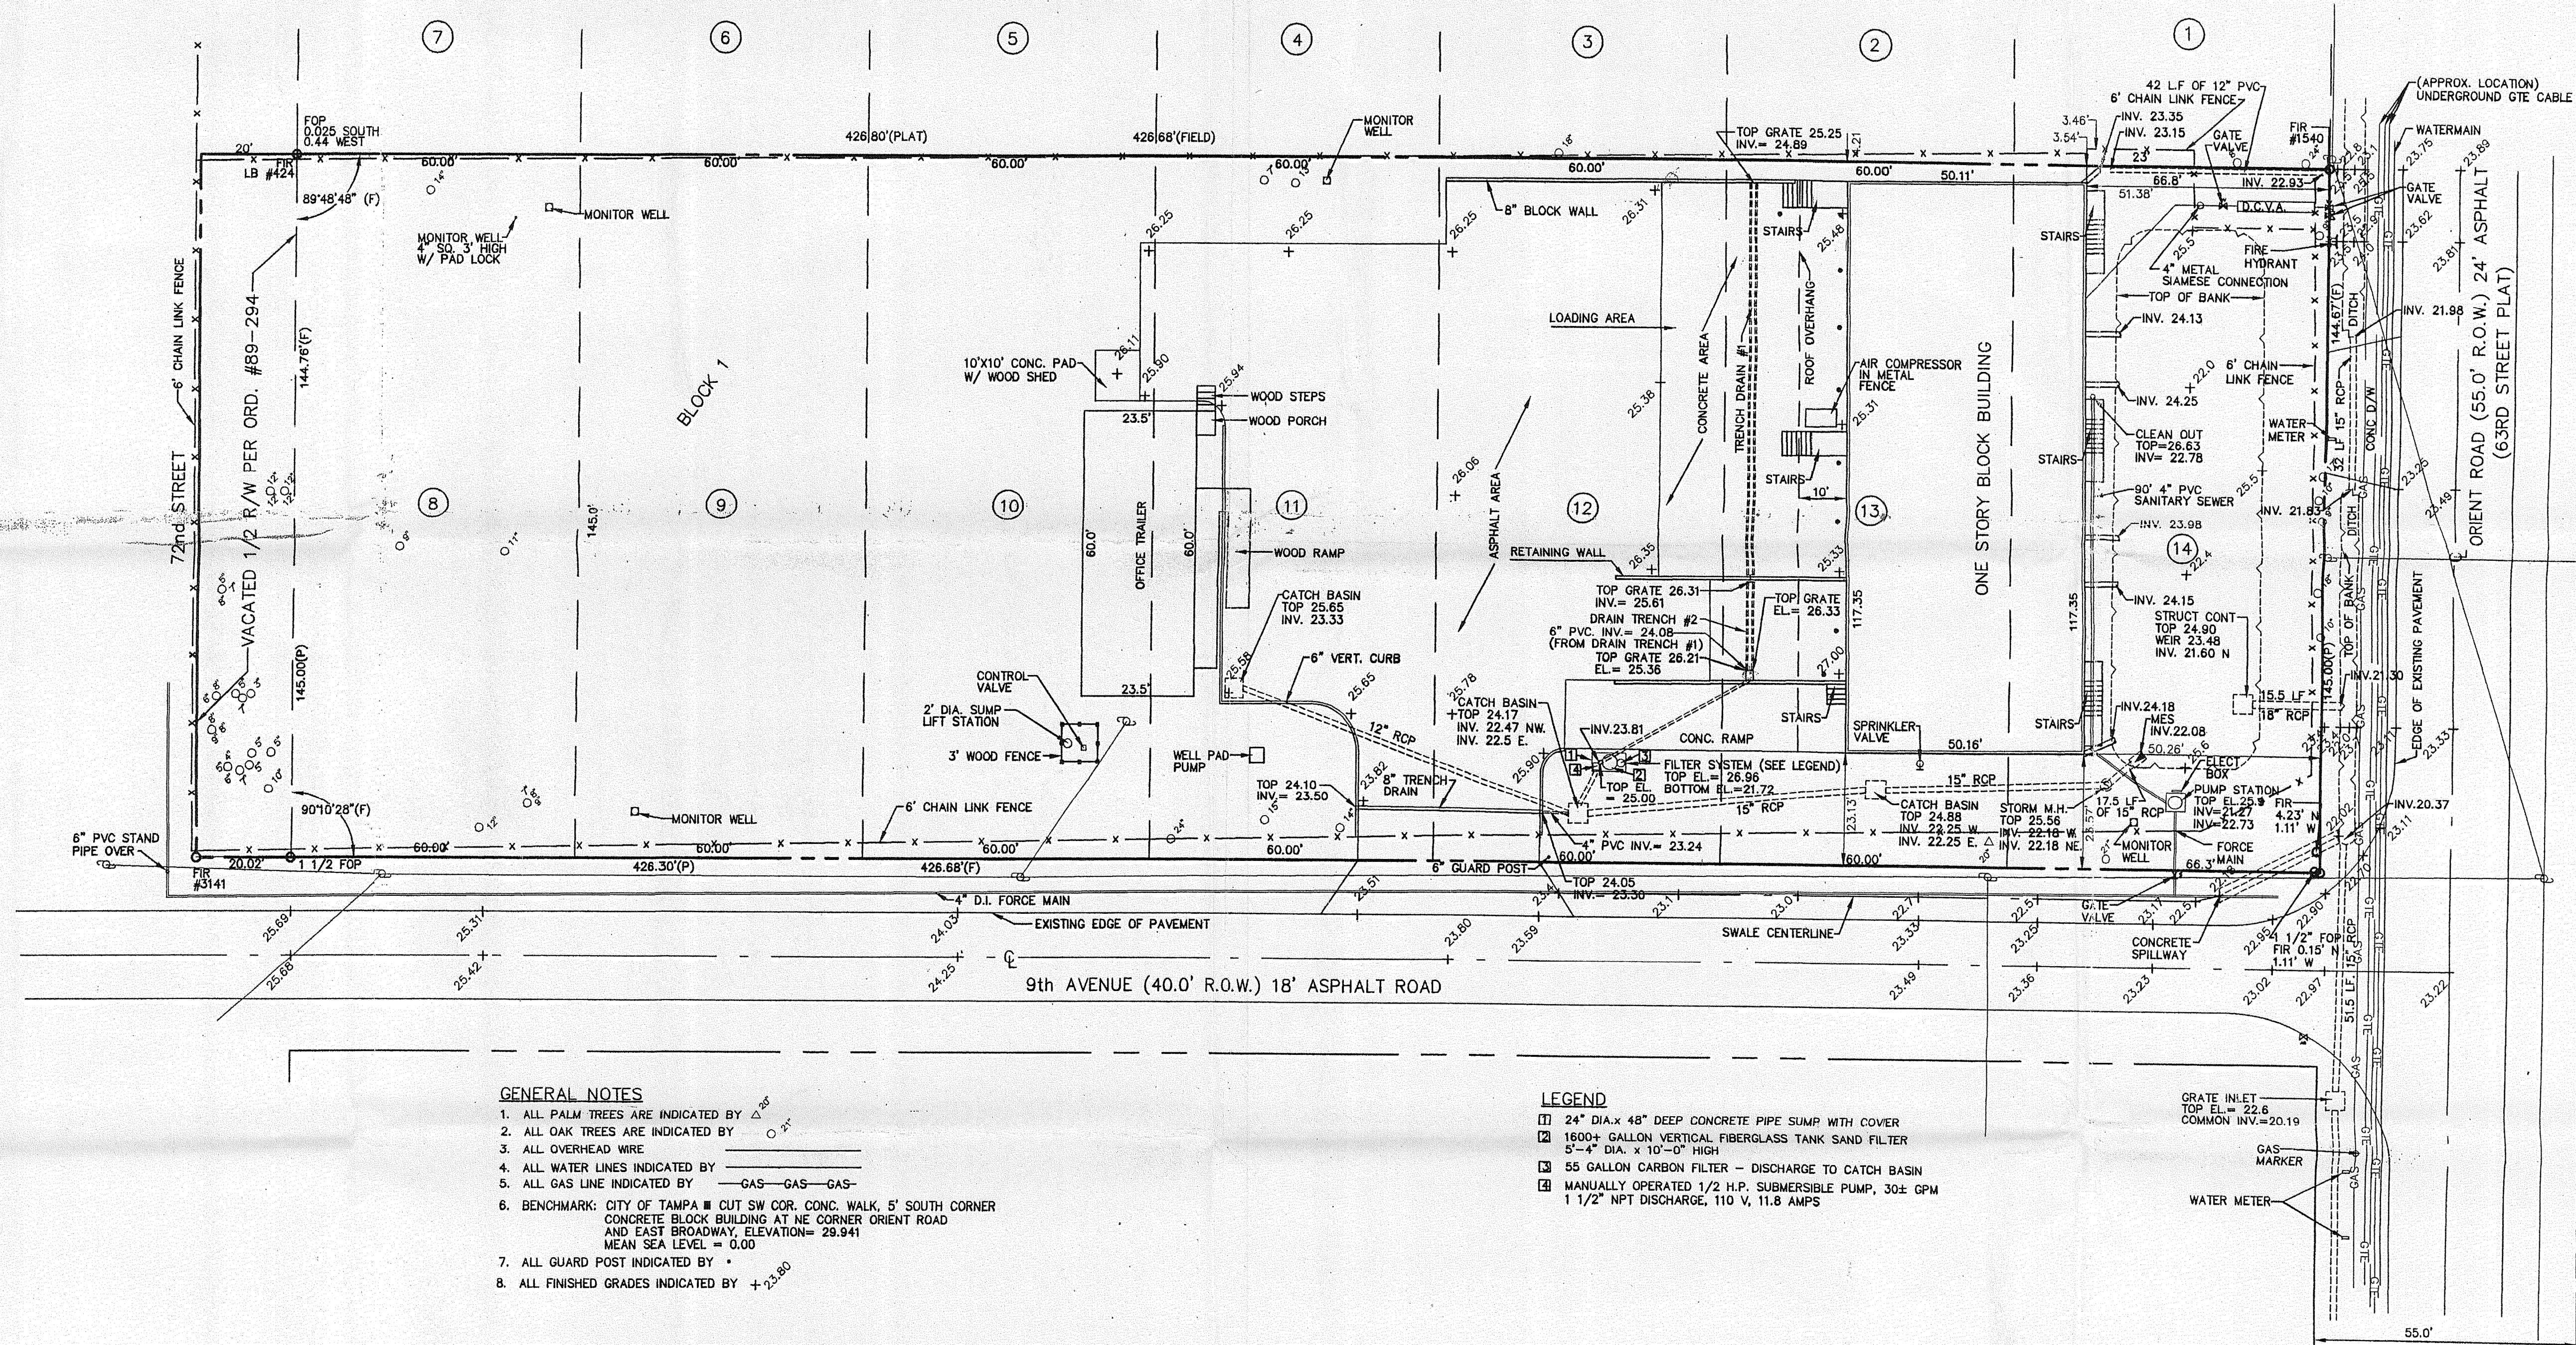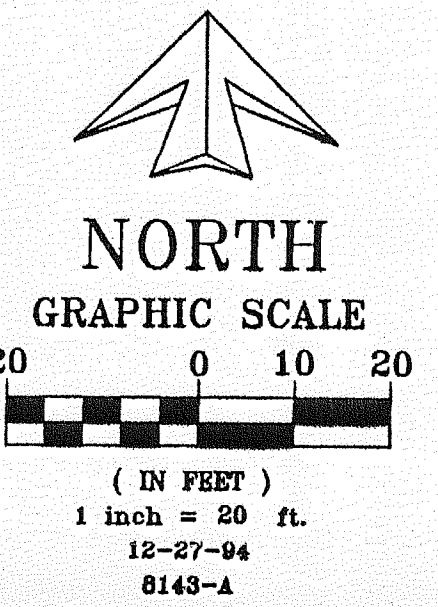

GENERAL NOTES

1. ALL PALM TREES ARE INDICATED BY
2. ALL OAK TREES ARE INDICATED BY
3. ALL OVERHEAD WIRE
4. ALL WATER LINES INDICATED BY
5. ALL GAS LINE INDICATED BY
6. BENCHMARK: CITY OF TAMPA ■ CUT SW COR. CONC. WALK, 5' SOUTH CORNER CONCRETE BLOCK BUILDING AT NE CORNER ORIENT ROAD AND EAST BROADWAY, ELEVATION= 29.941 MEAN SEA LEVEL = 0.00
7. ALL GUARD POST INDICATED BY
8. ALL FINISHED GRADES INDICATED BY

LEGEND

1. 24" DIA. x 48" DEEP CONCRETE PIPE SUMP WITH COVER
2. 1600+ GALLON VERTICAL FIBERGLASS TANK SAND FILTER 5'-4" DIA. x 10'-0" HIGH
3. 55 GALLON CARBON FILTER - DISCHARGE TO CATCH BASIN
4. MANUALLY OPERATED 1/2 H.P. SUBMERSIBLE PUMP, 30± GPM 1 1/2" NPT DISCHARGE, 110 V, 11.8 AMPS

GRATE INLET
TOP EL= 22.6
COMMON INV.=20.19

GAS MARKER

WATER METER

CITY ENVIRONMENTAL
SERVICES OF FLORIDA, INC.


7202 EAST EIGHTH AVENUE
TAMPA, FLORIDA 33619



KBN ENGINEERING AND APPLIED SCIENCES, INC.
5405 W. Cypress St., Suite 215
Tampa, Florida 33607
Telephone: (813) 287-1717
Fax: (813) 287-1716

DATE	No.	REVISIONS	BY	SR	CLIENT	DATE
12/21/94		KBN ENGINEERING AND APPLIED SCIENCES, INC.; BY WLR			UNIVERSAL WASTE & TRANSIT, INC.	12-12-94
12/12/94		JOB NO. 8143; DRAWN BY JES	JHM			DRAWN BY JES
4/12/89		JOB NO. 8143; SEMINOLE ENGINEERING; BY CN	EWB			CHECKED BY JHM
					SCALE 1" = 20'	

EXISTING LOT PLAN

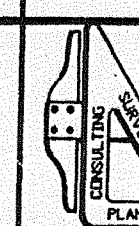



SEMINOLE ENGINEERING, INC.

14483 62nd STREET NORTH
CLEARWATER, FL. 34620
TELEPHONE (813) 539-0051

RECORD DRAWING - 11/22/94


James M. Winter
JAMES M. WINTER, P.E. # 18313
DATE: 12/27/94

DWG. FILE NO.
8143-A
FIELD BOOK No.
PROJECT No.
8143
ENG. SHEET No.
1 OF 2

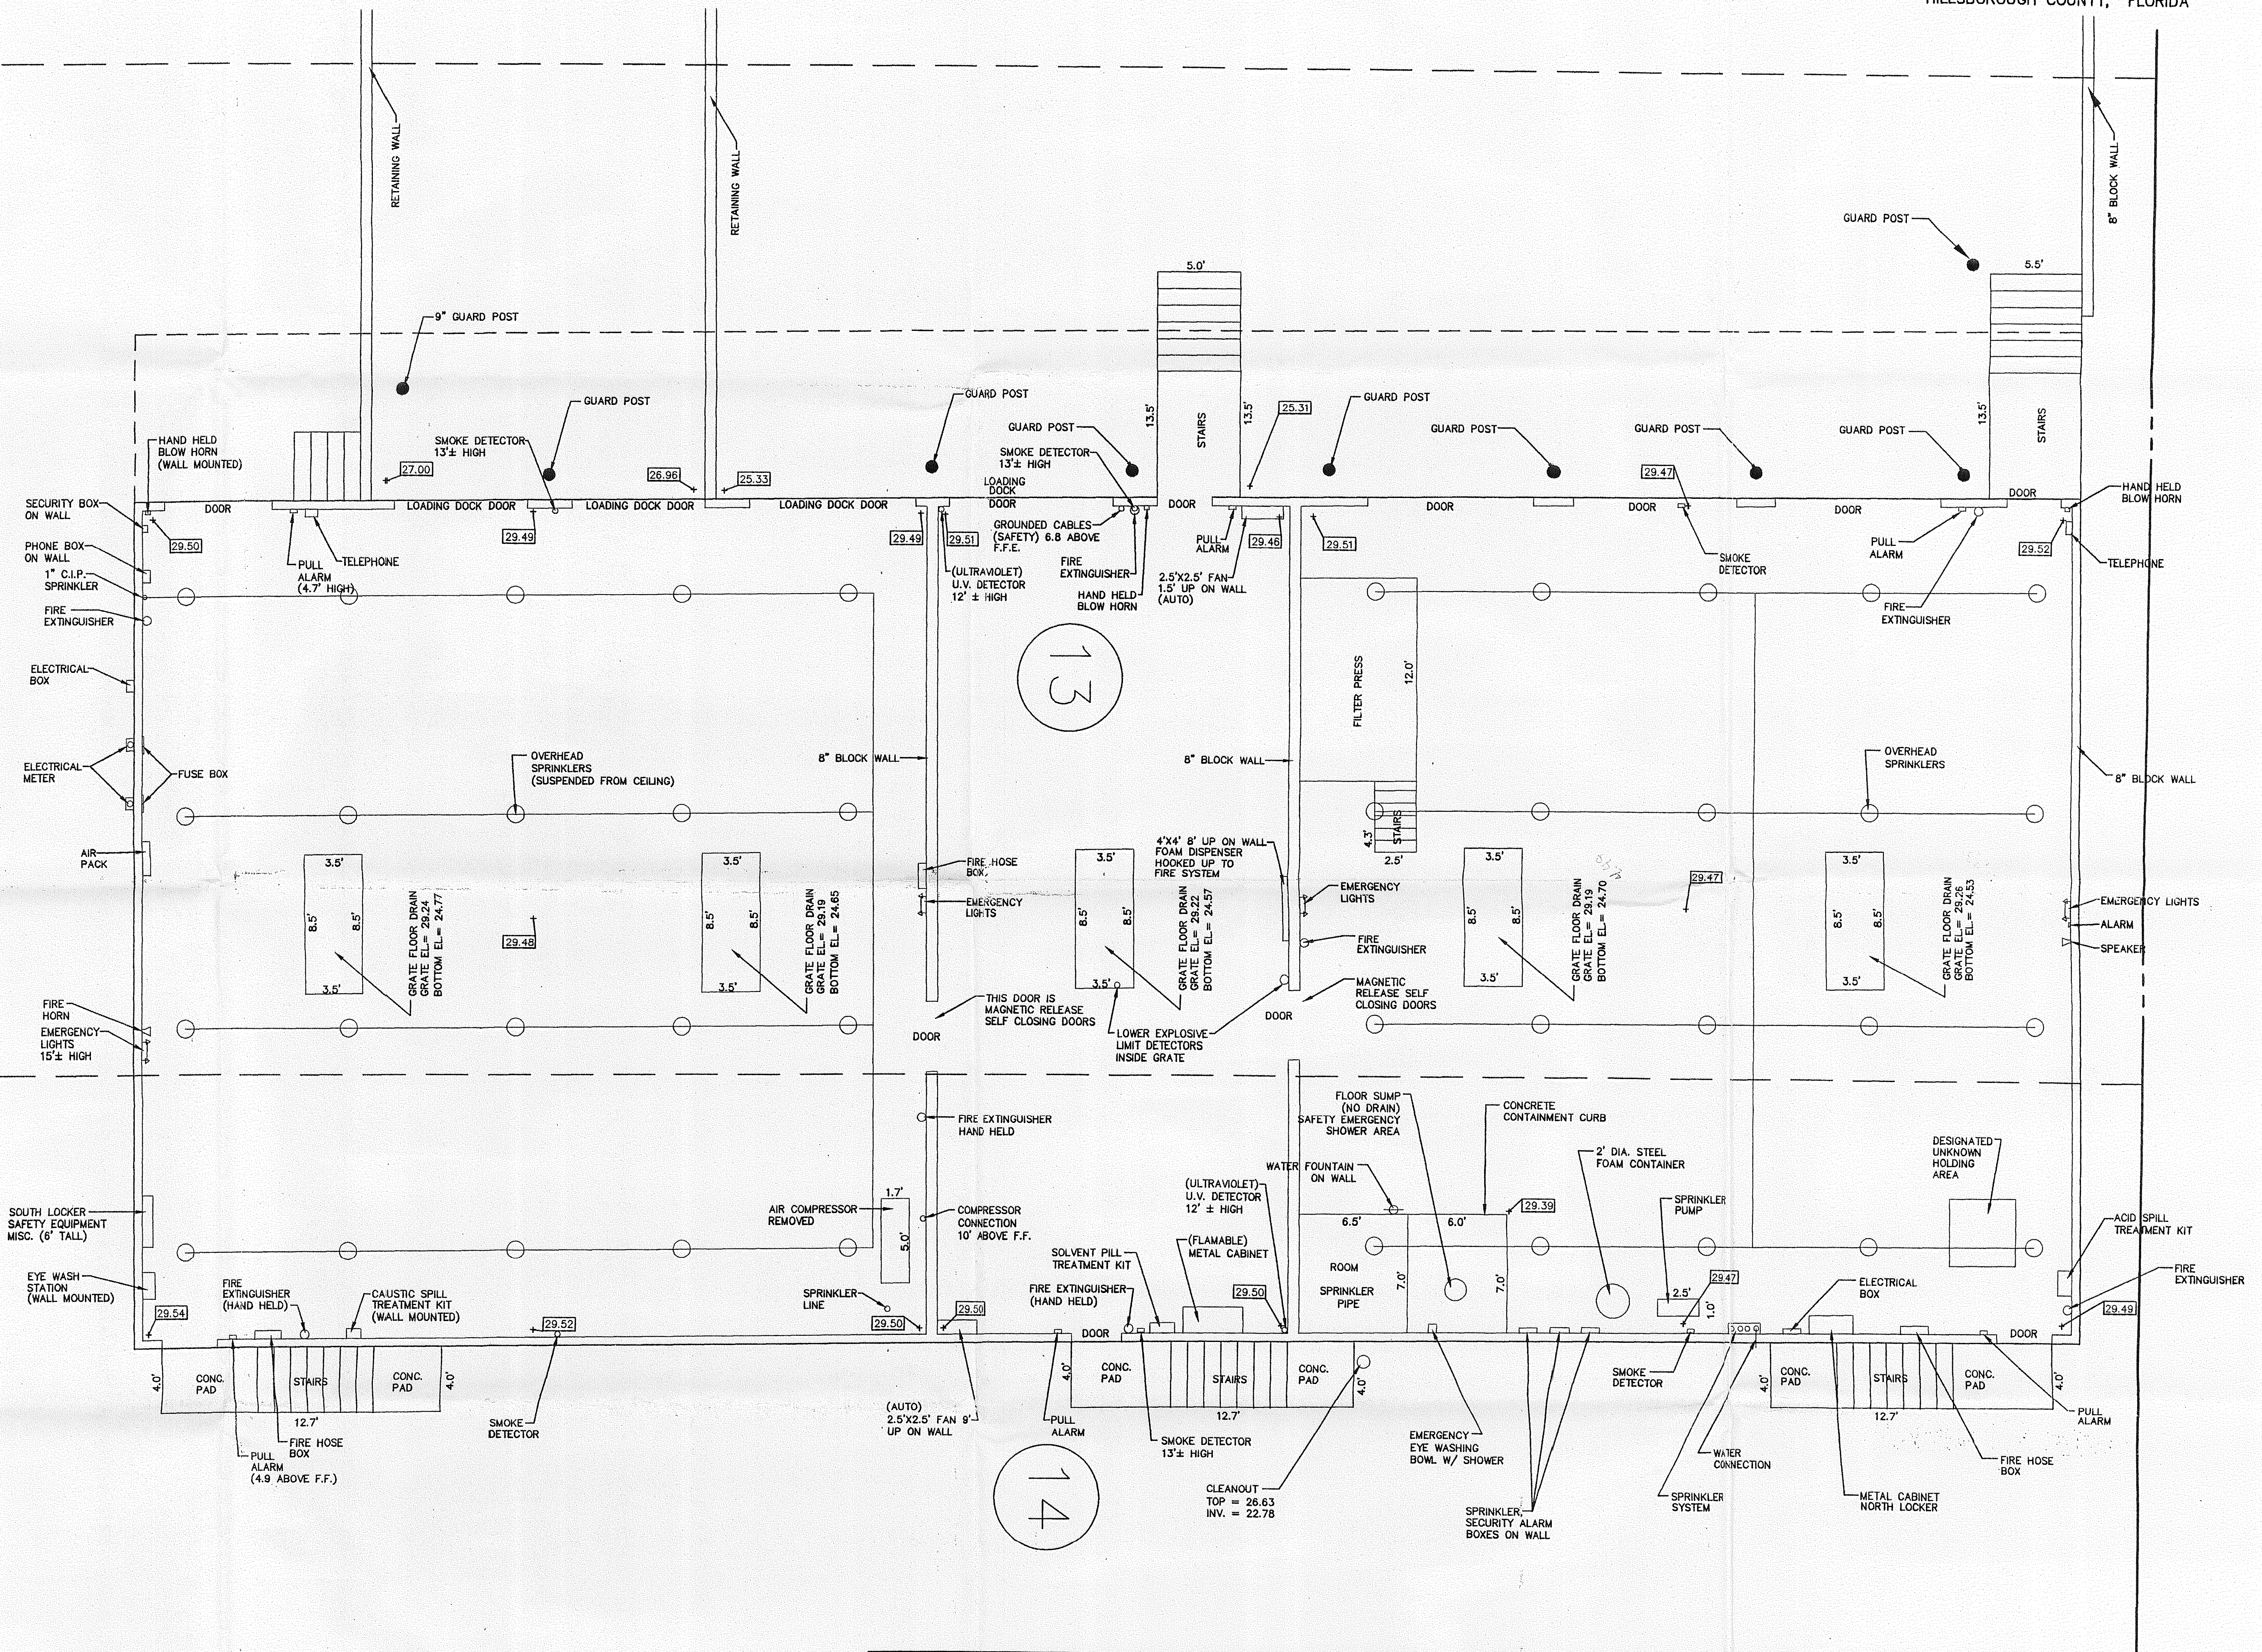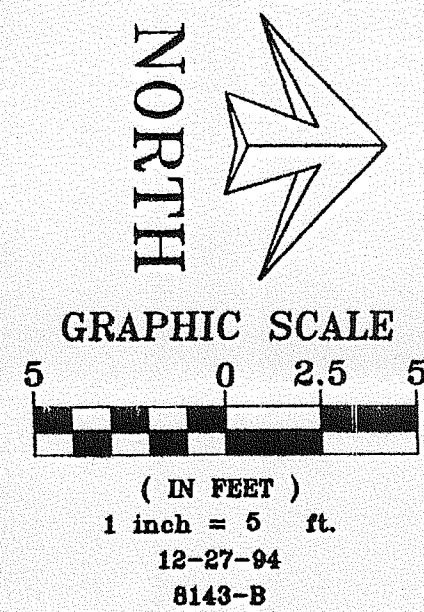

CITY ENVIRONMENTAL
SERVICES OF FLORIDA, INC. 7202 EAST EIGHTH AVENUE
TAMPA, FLORIDA 33619

KBN KBN ENGINEERING AND APPLIED SCIENCES, INC.
5405 W. Cypress St., Suite 215 Telephone: (813) 287-1717
Tampa, Florida 33607 FAX: (813) 287-1716

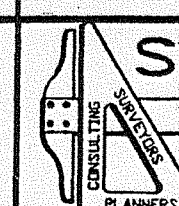

SEMINOLE ENGINEERING, INC.

14483 62nd STREET NORTH
CLEARWATER, FL 34620
TELEPHONE (813) 539-0051

RECORD DRAWING - 11/22/94

James M. Winter
JAMES M. WINTER, P.E., # 18313
DATE: 12/27/94

DWG. FILE No.
8143-B PROJECT No.
8143
FIELD BOOK No. ENG. SHEET No.

2 OF 2

DATE	No.	REVISIONS	BY

☐ PRELIMINARY
☐ CONSTRUCTION
☒ RECORD DRAWING

CLIENT
UNIVERSAL WASTE
& TRANSIT, INC.
SCALE
1" = 5'

DATE
12-12-94
DRAWN BY
JES
CHECKED BY
JMH

EXISTING BUILDING PLAN