



IMAGE QUALITY

AS YOU VIEW THE FOLLOWING
DOCUMENT, PLEASE NOTE THAT
PORTIONS OF THE ORIGINAL WERE OF
POOR QUALITY

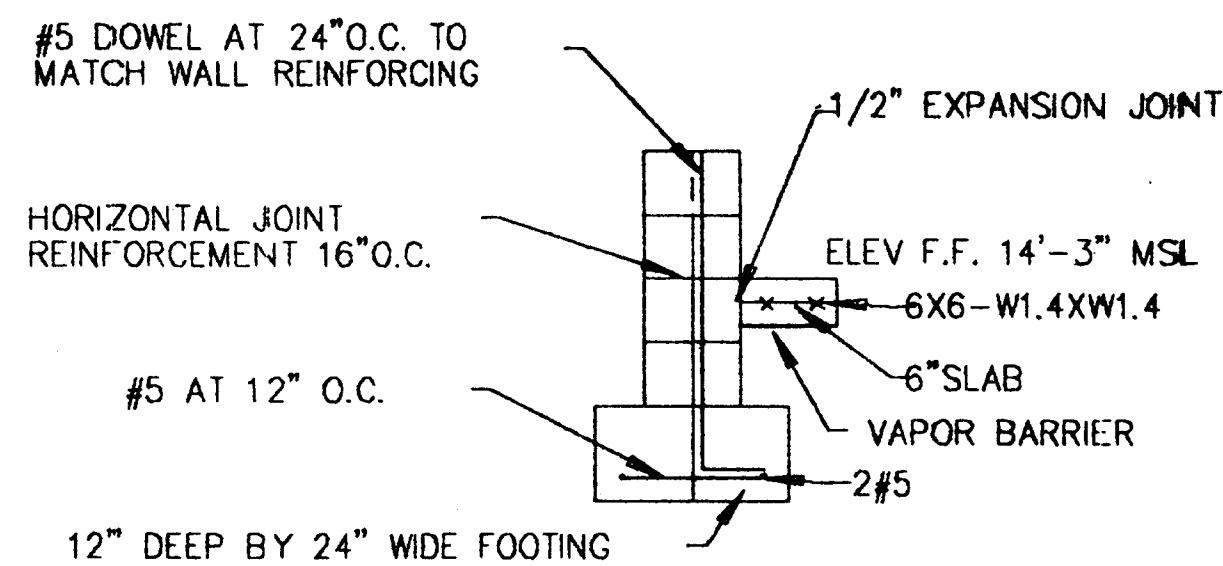


SECTION 4
SCALE: 1/2" = 1'-0"


#5 DOWEL AT 42" O.C.
TO MATCH REINFORCING
TYPICAL INTERIOR WALLS

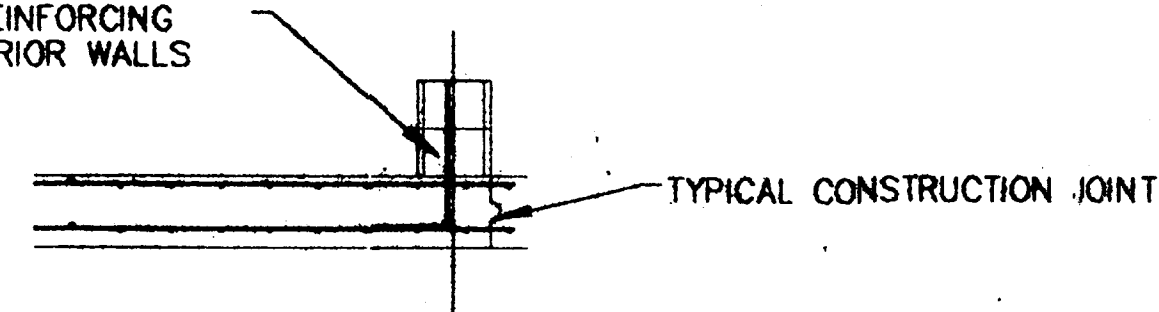


SECTION 5
SCALE: 3/8" = 1'-0"

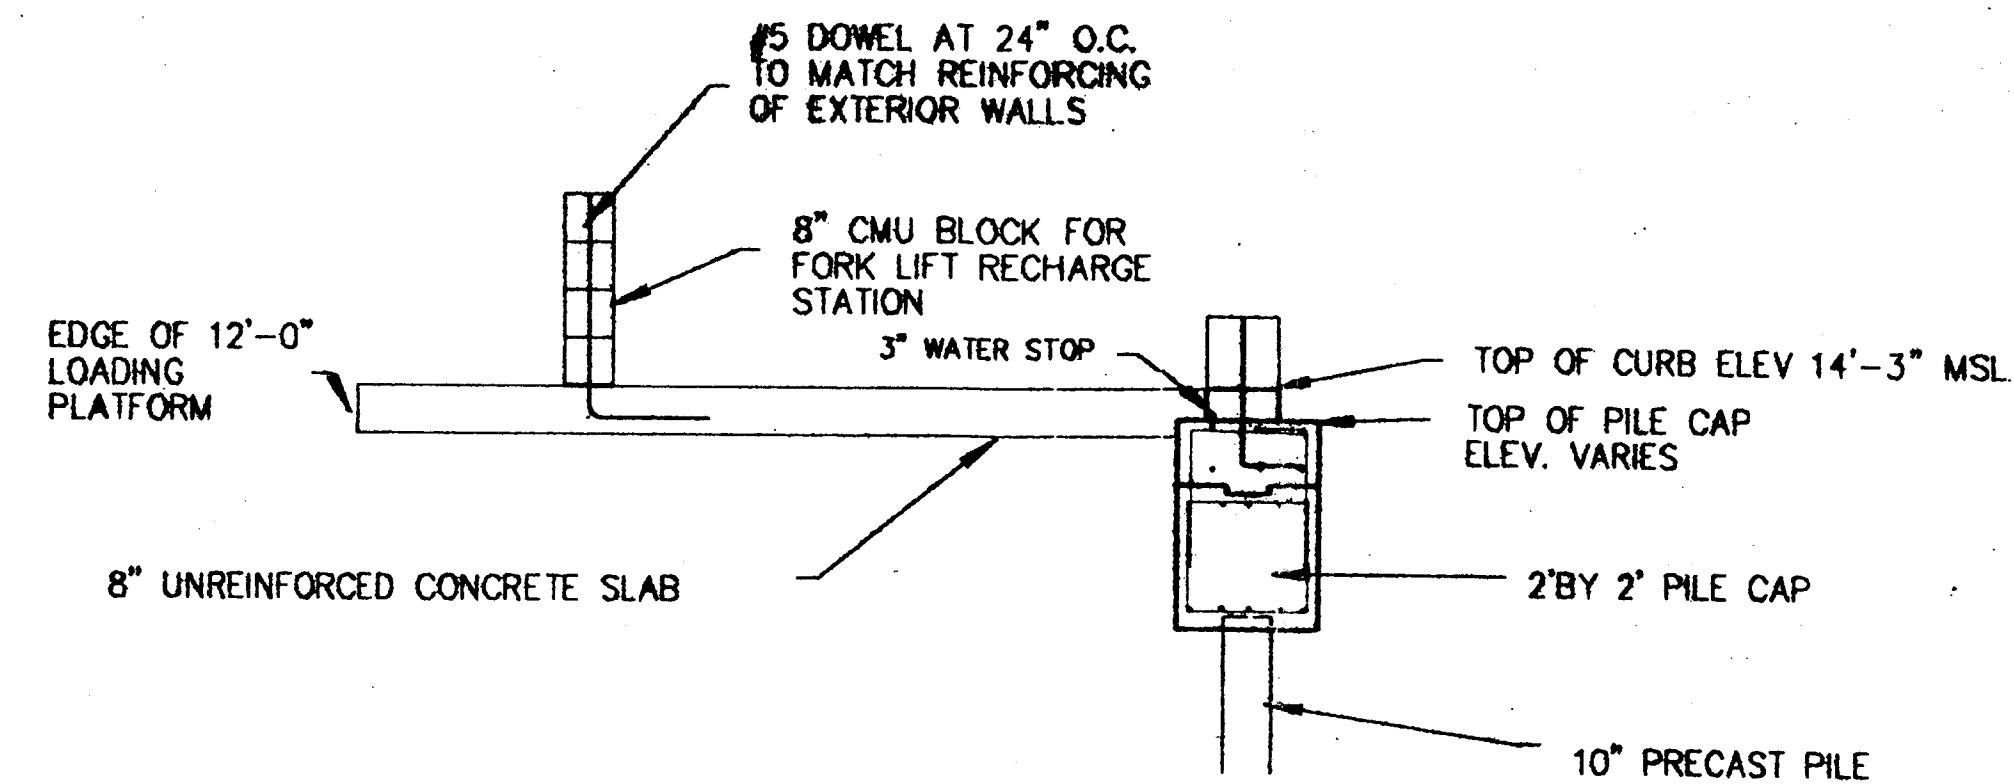


SECTION 6
SCALE: 3/8" = 1'-0"

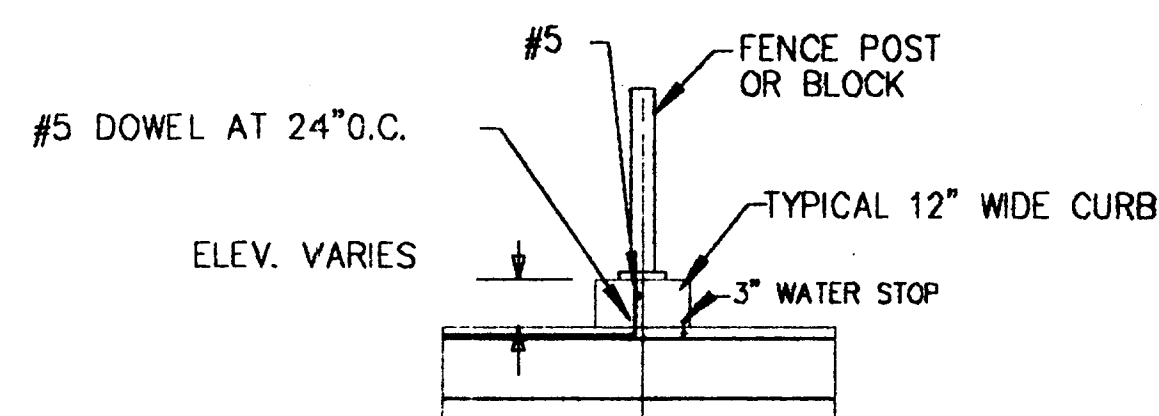


SECTION 1
SCALE: 1/2" = 1'-0"

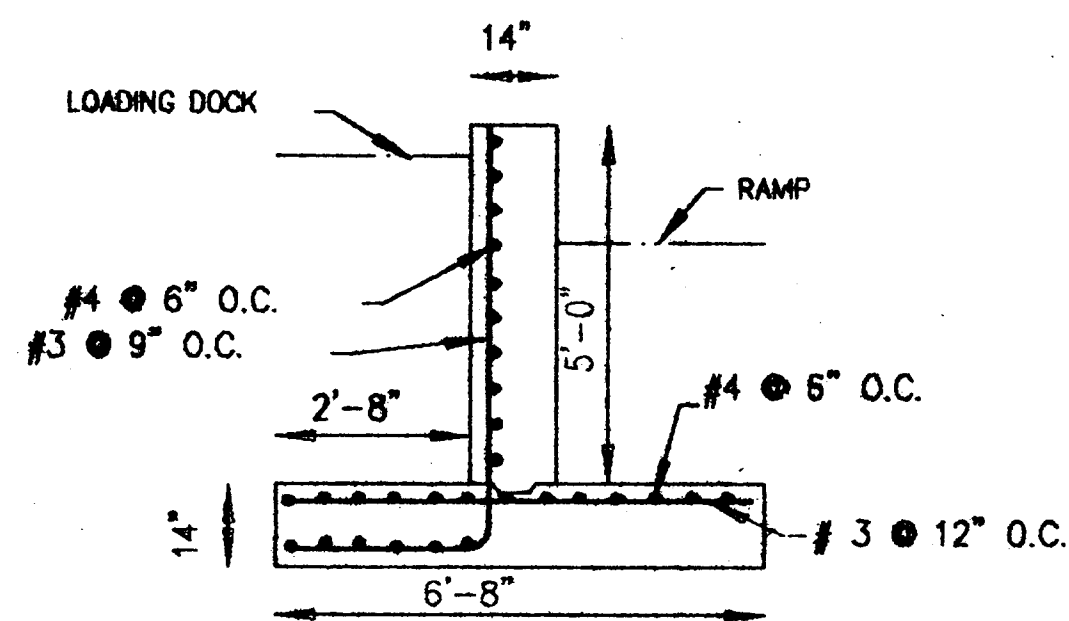


SECTION 6
SEE C-7 FOR LOCATION

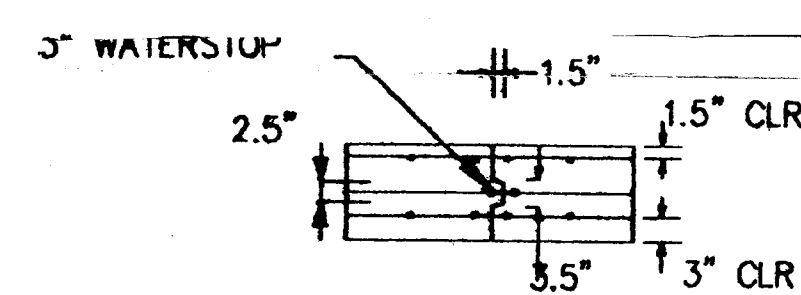


SECTION 1
SCALE: 1/2" = 1'-0"

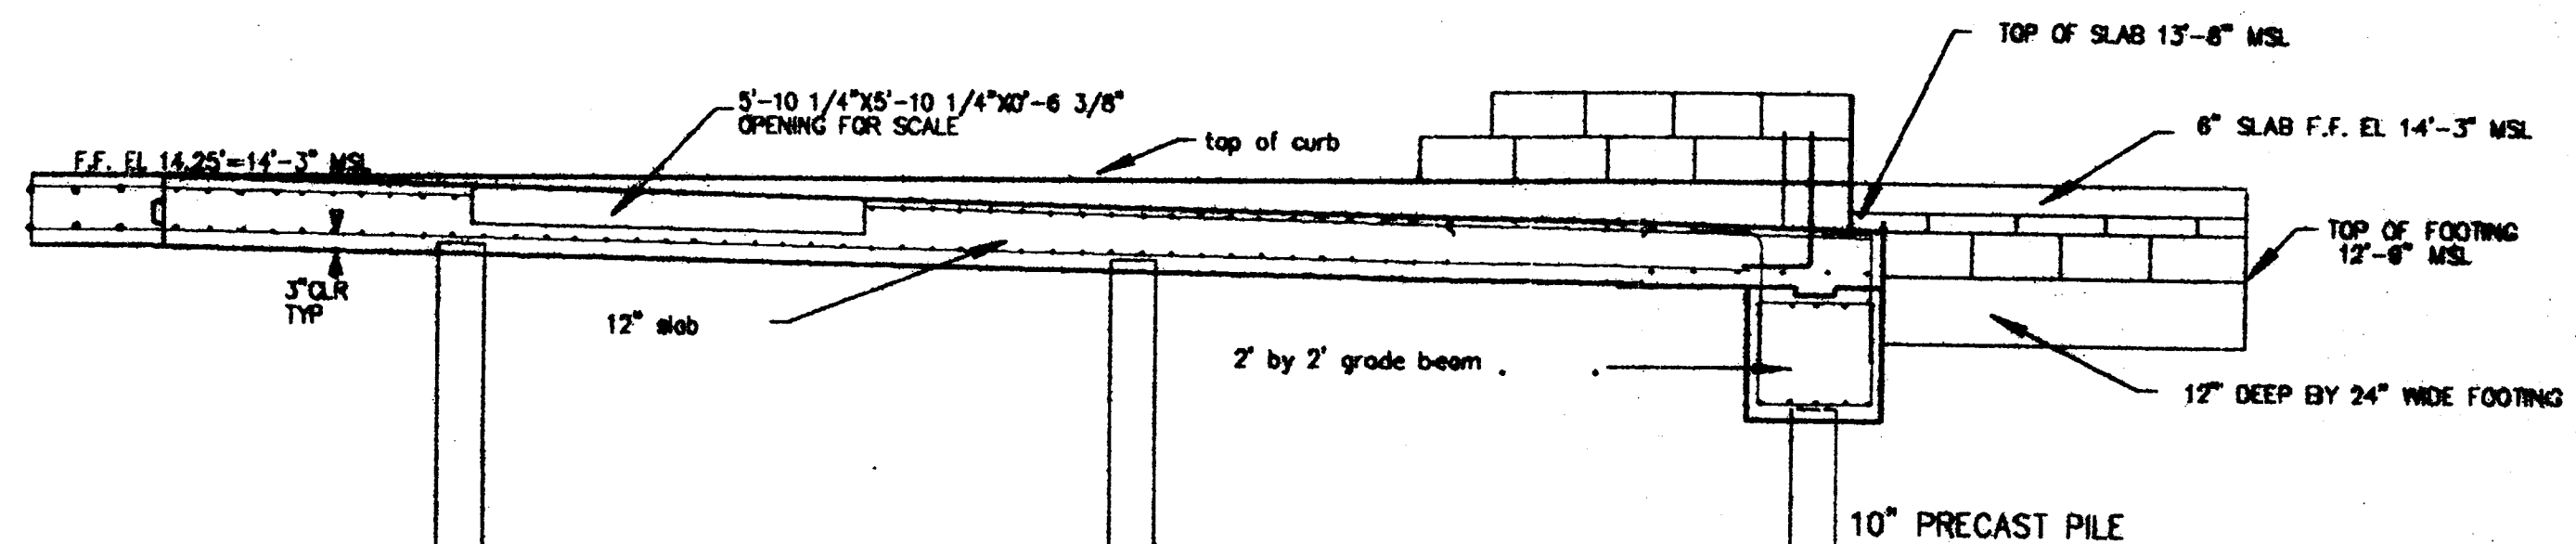


SECTION 3
SCALE: 3/8" = 1'-0"

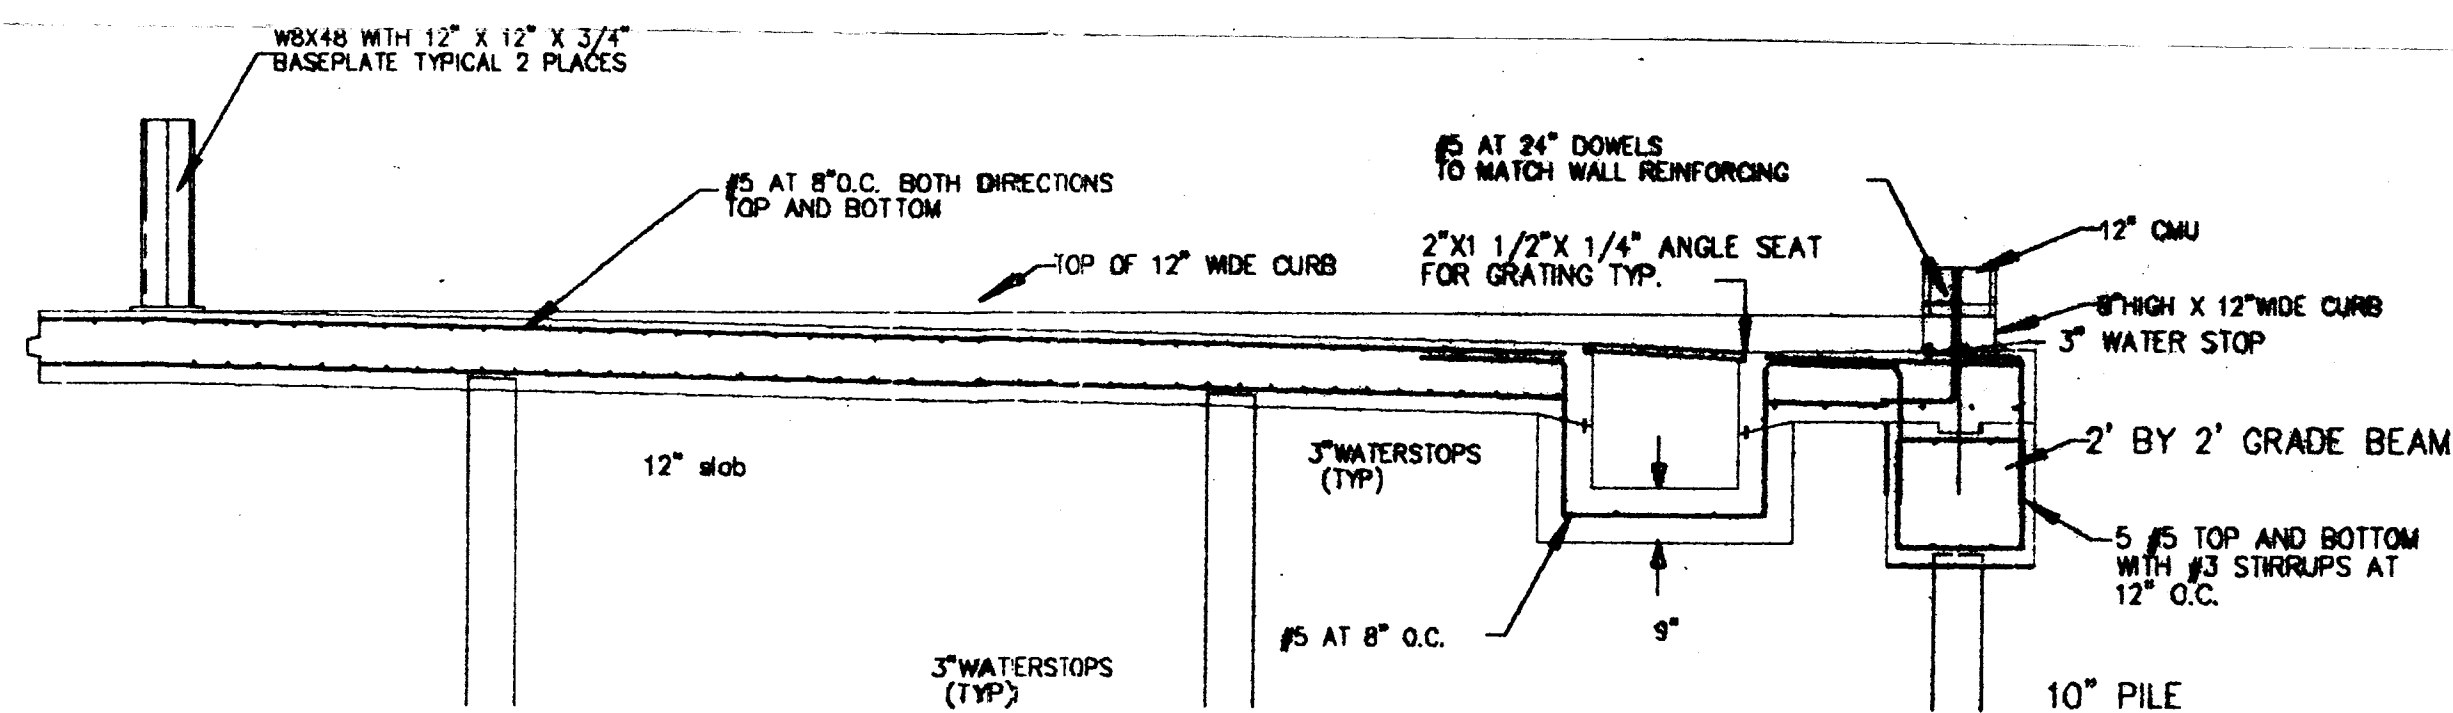


SECTION 2
SCALE: 3/8" = 1'-0"

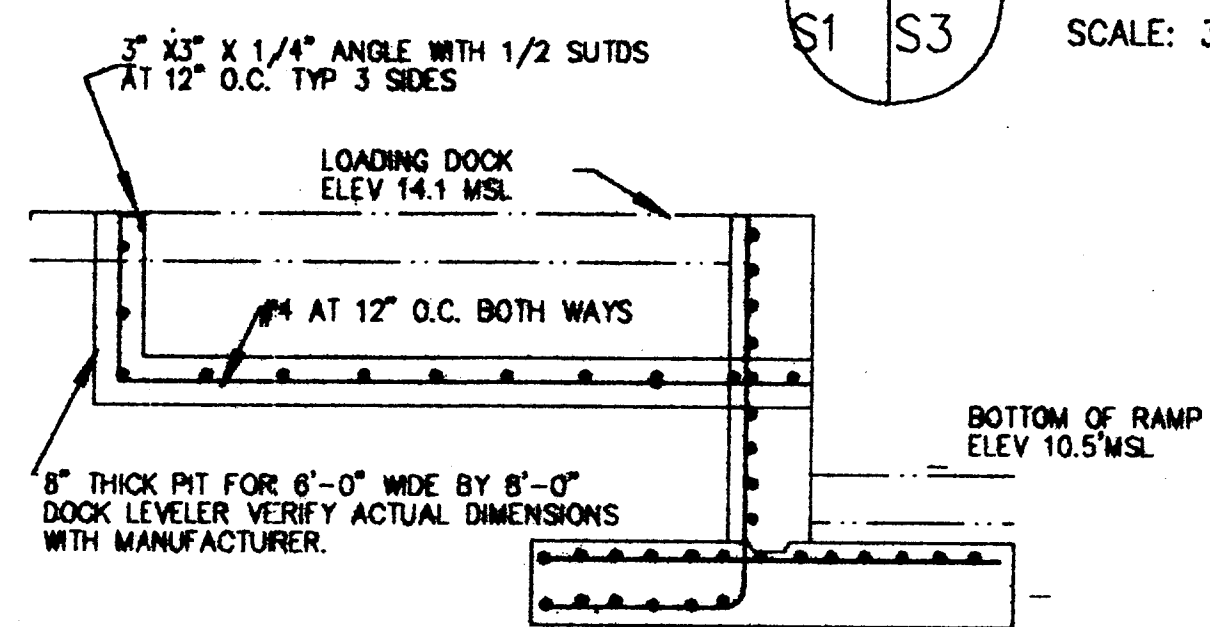

SECTION 7

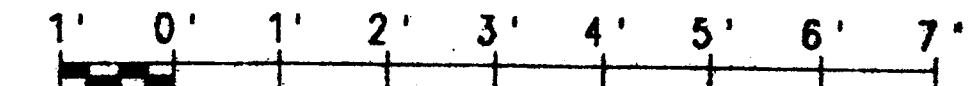

SCALE 1/2" = 1'-0"

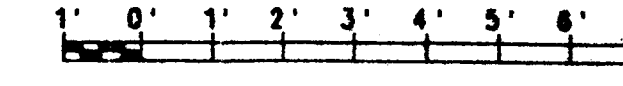

3/8" = 1'-0"

GRAPHIC SCALES

AS BUILT

REV.	DESCRIPTION	DATE	APPROVED	PREP BY
1	ISSUED FOR CONSTRUCTION	3/27/95		
2	ISSUED FOR CONSTRUCTION	3/27/95		
