

RECEIVED
RCRA

OCT 15 2013

Hazardous Waste Regulation

Jones Ecosystem Management

Mr. Bheem Kothur
Florida Department of Environmental Protection
Hazardous Waste Section
2600 Blair Stone Road
Tallahassee, FL 32399

OCT 18 2013

October 12, 2013


RE: Raider Environmental Services Used Oil Processor Permit
Mulberry, Florida
FLR 000 176 271

Dear Mr. Kothur:

Attached please find Raider Environmental Services as-built drawings for the facility.

Please let me know if you require any additional information.


Sincerely,

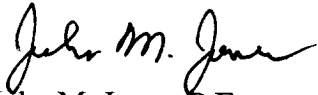


John M. Jones, P.E.

cc: Steve Obst-Raider


01/10/2013 10:42am Local Drive: Tank Farm Layout.dwg, Pg. 2 Of 2, 544x1000, 1/4" = 1'-0"

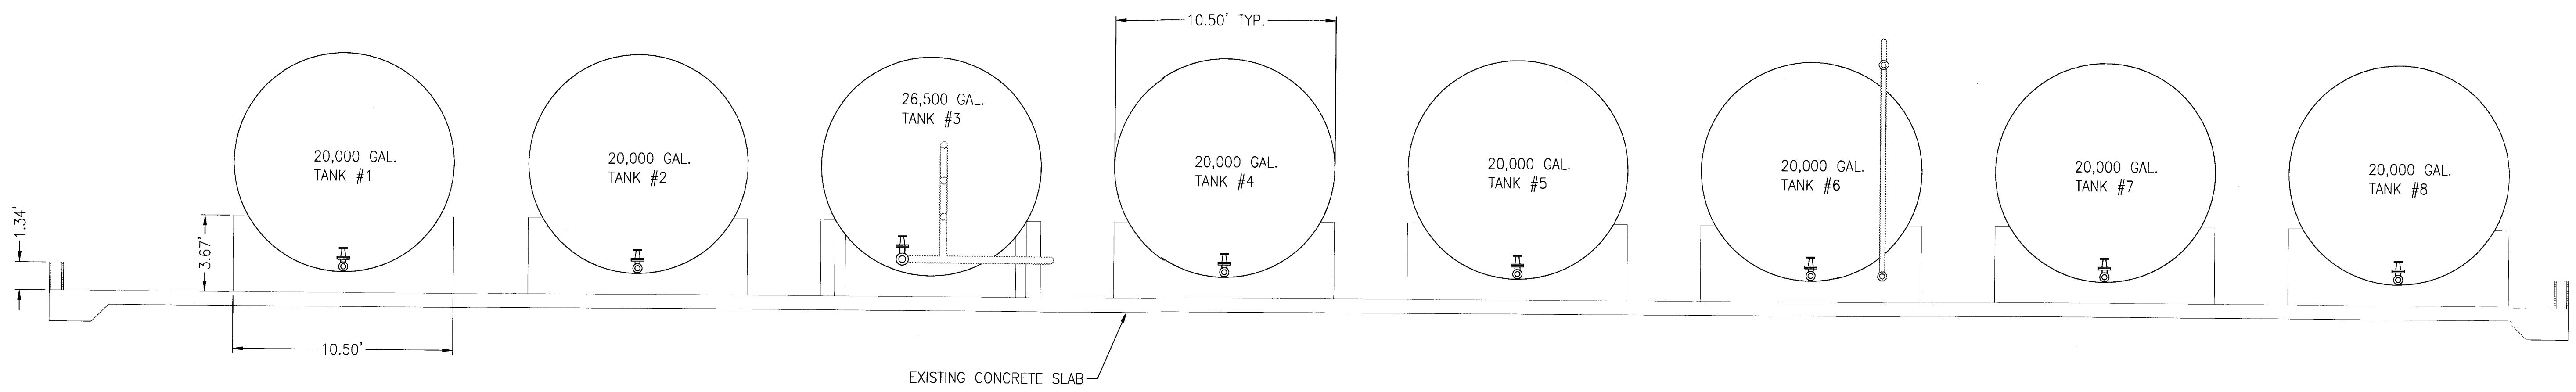

SECTION
SCALE: 1/4" = 1'-0"
A
1 2

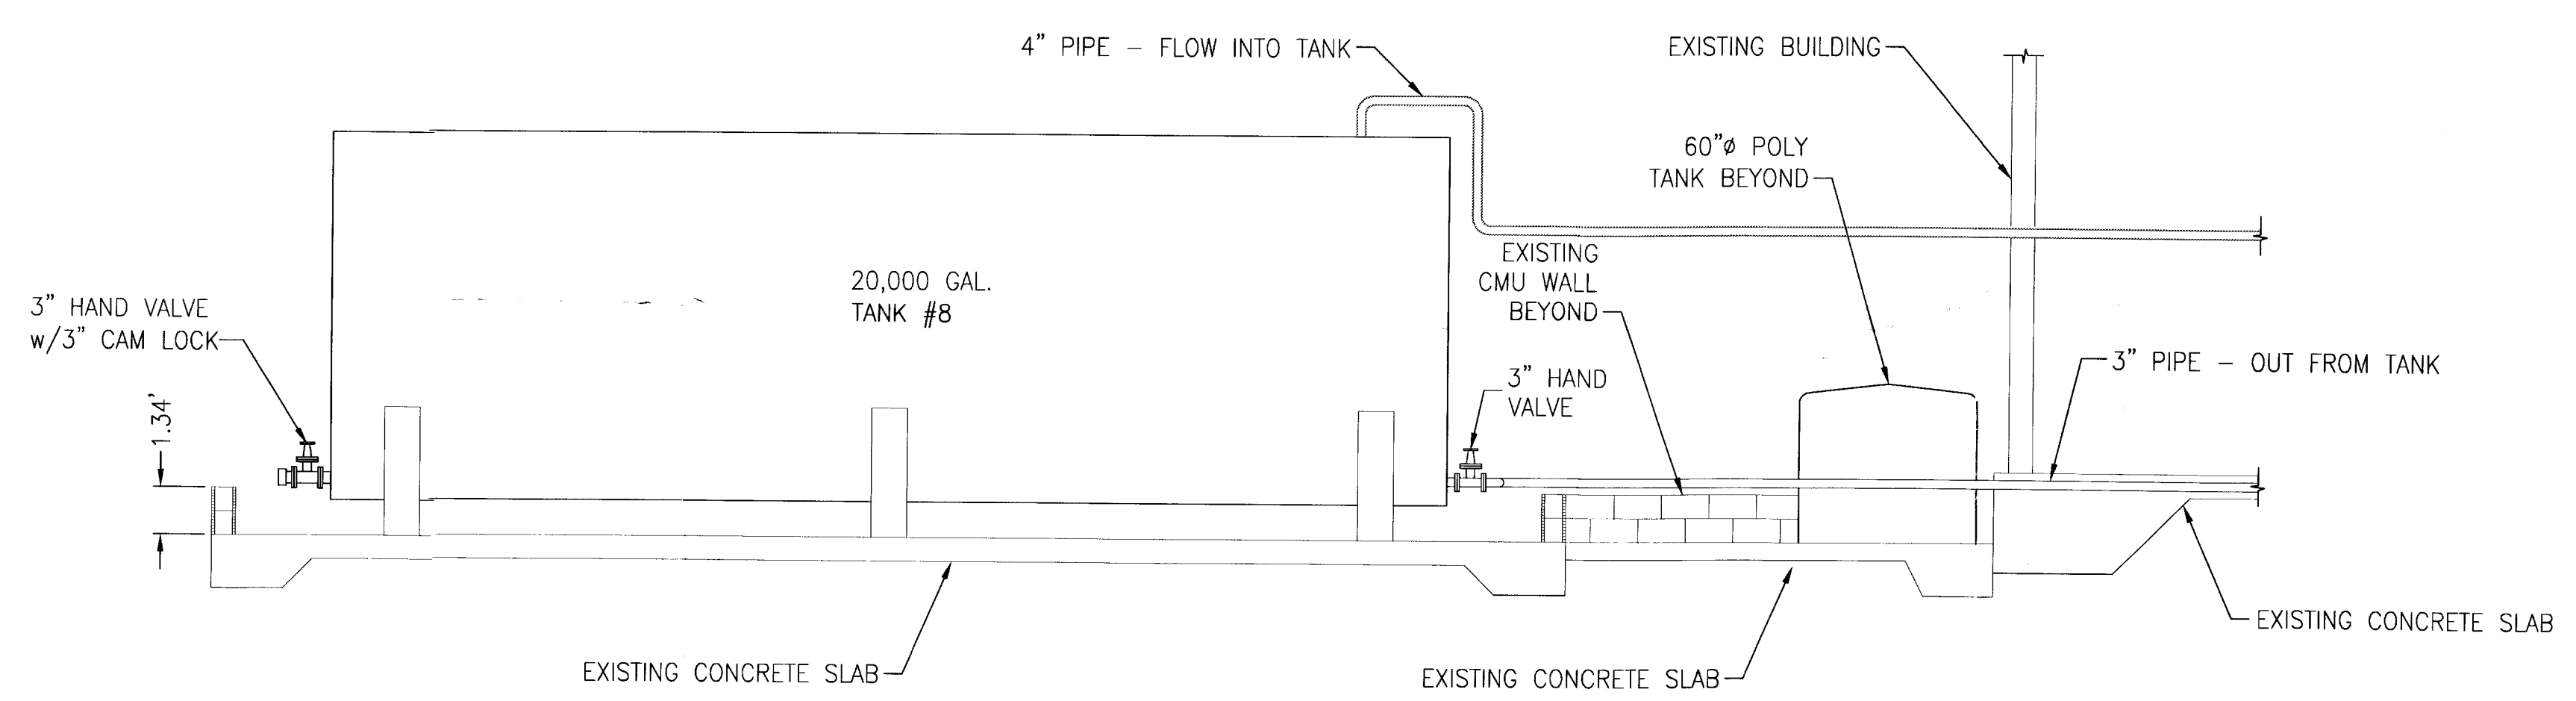

SECTION
SCALE: 1/4" = 1'-0"
B
1 2

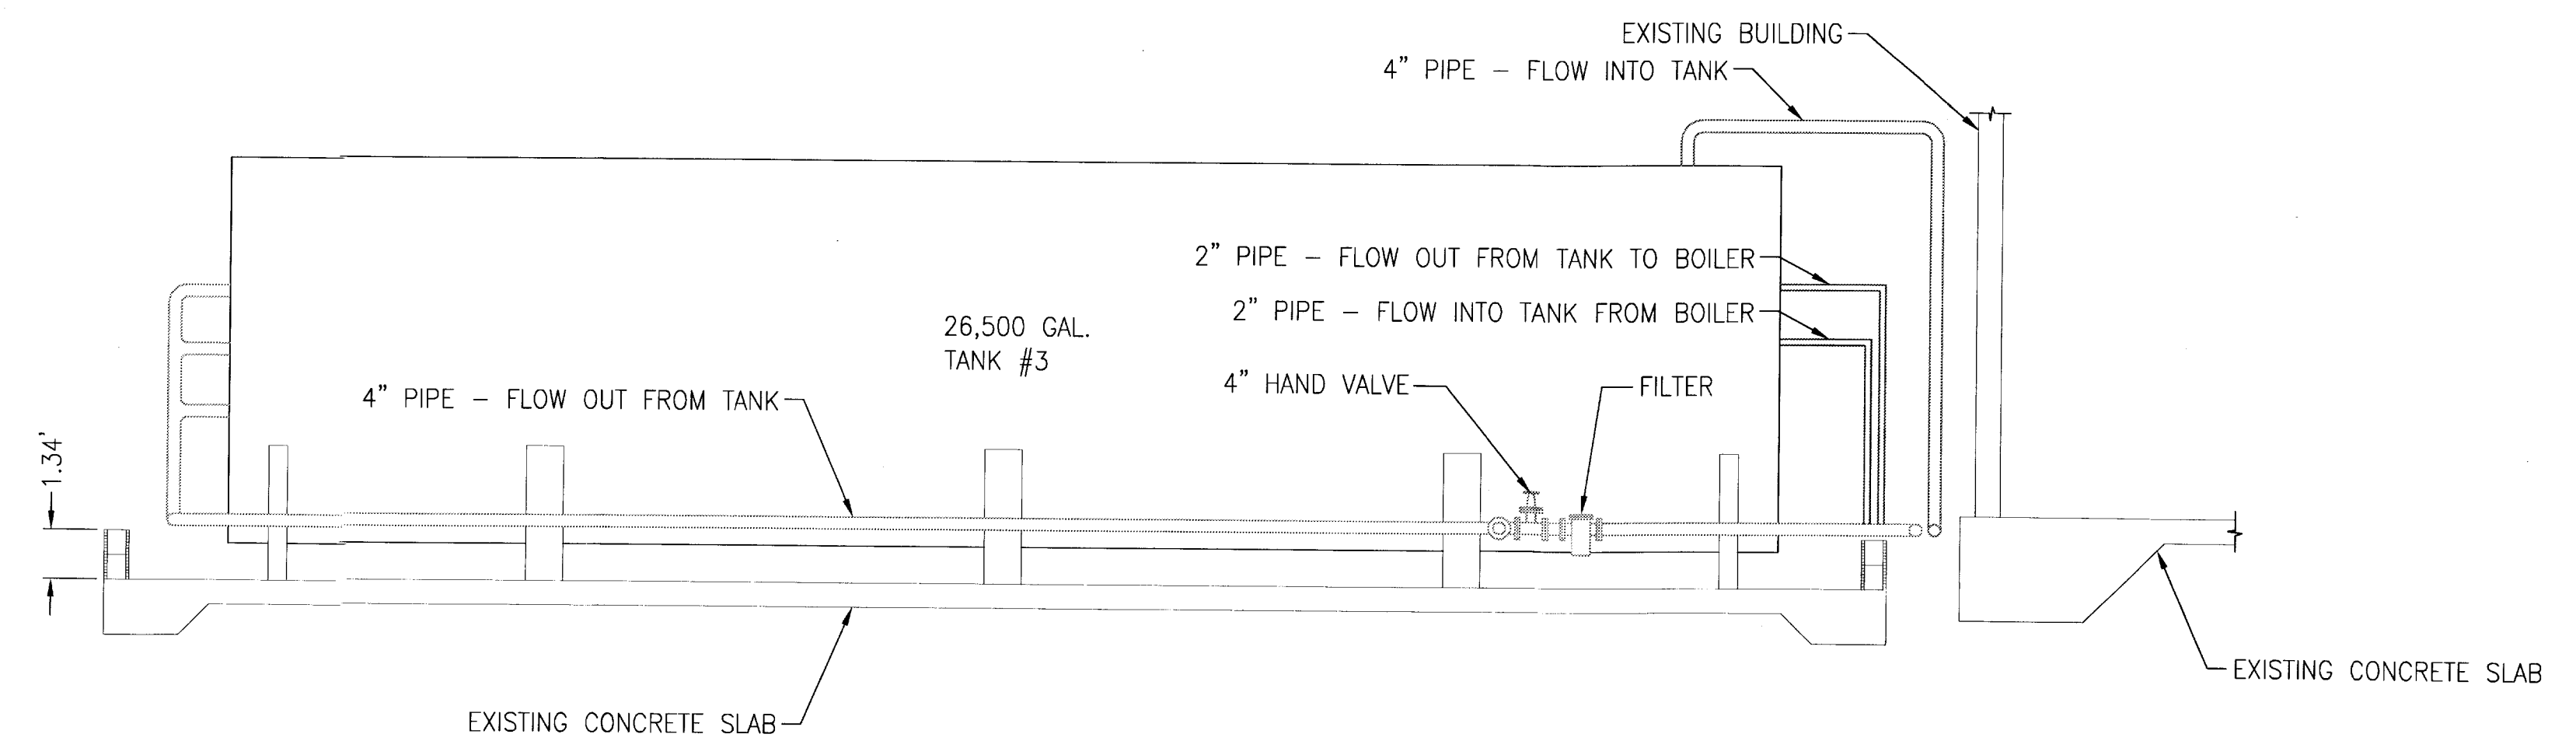


SECTION
SCALE: 1/4" = 1'-0"
C
1 2

RECEIVED
01/10/2013
10:42am
Local Drive: Tank Farm Layout.dwg, Pg. 2 Of 2, 544x1000, 1/4" = 1'-0"

SECTIONS	PROJECT TITLE
	TANK FARM AS-BUILT

RAIDER ENVIRONMENTAL SERVICES
5080 HIGHWAY 60 EAST
MULBERRY, FL 33860

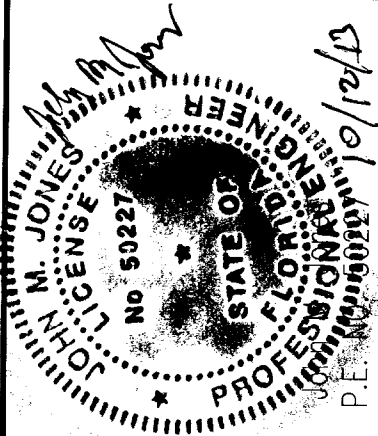

BY	REVISIONS

DESIGNED BY
J.M.J.
DRAWN BY
R.M.
CHECKED BY
J.M.J.
DATE
9-10-13
SCALE
AS SHOWN
PROJECT NO.
X
SHEET 2 of 2