


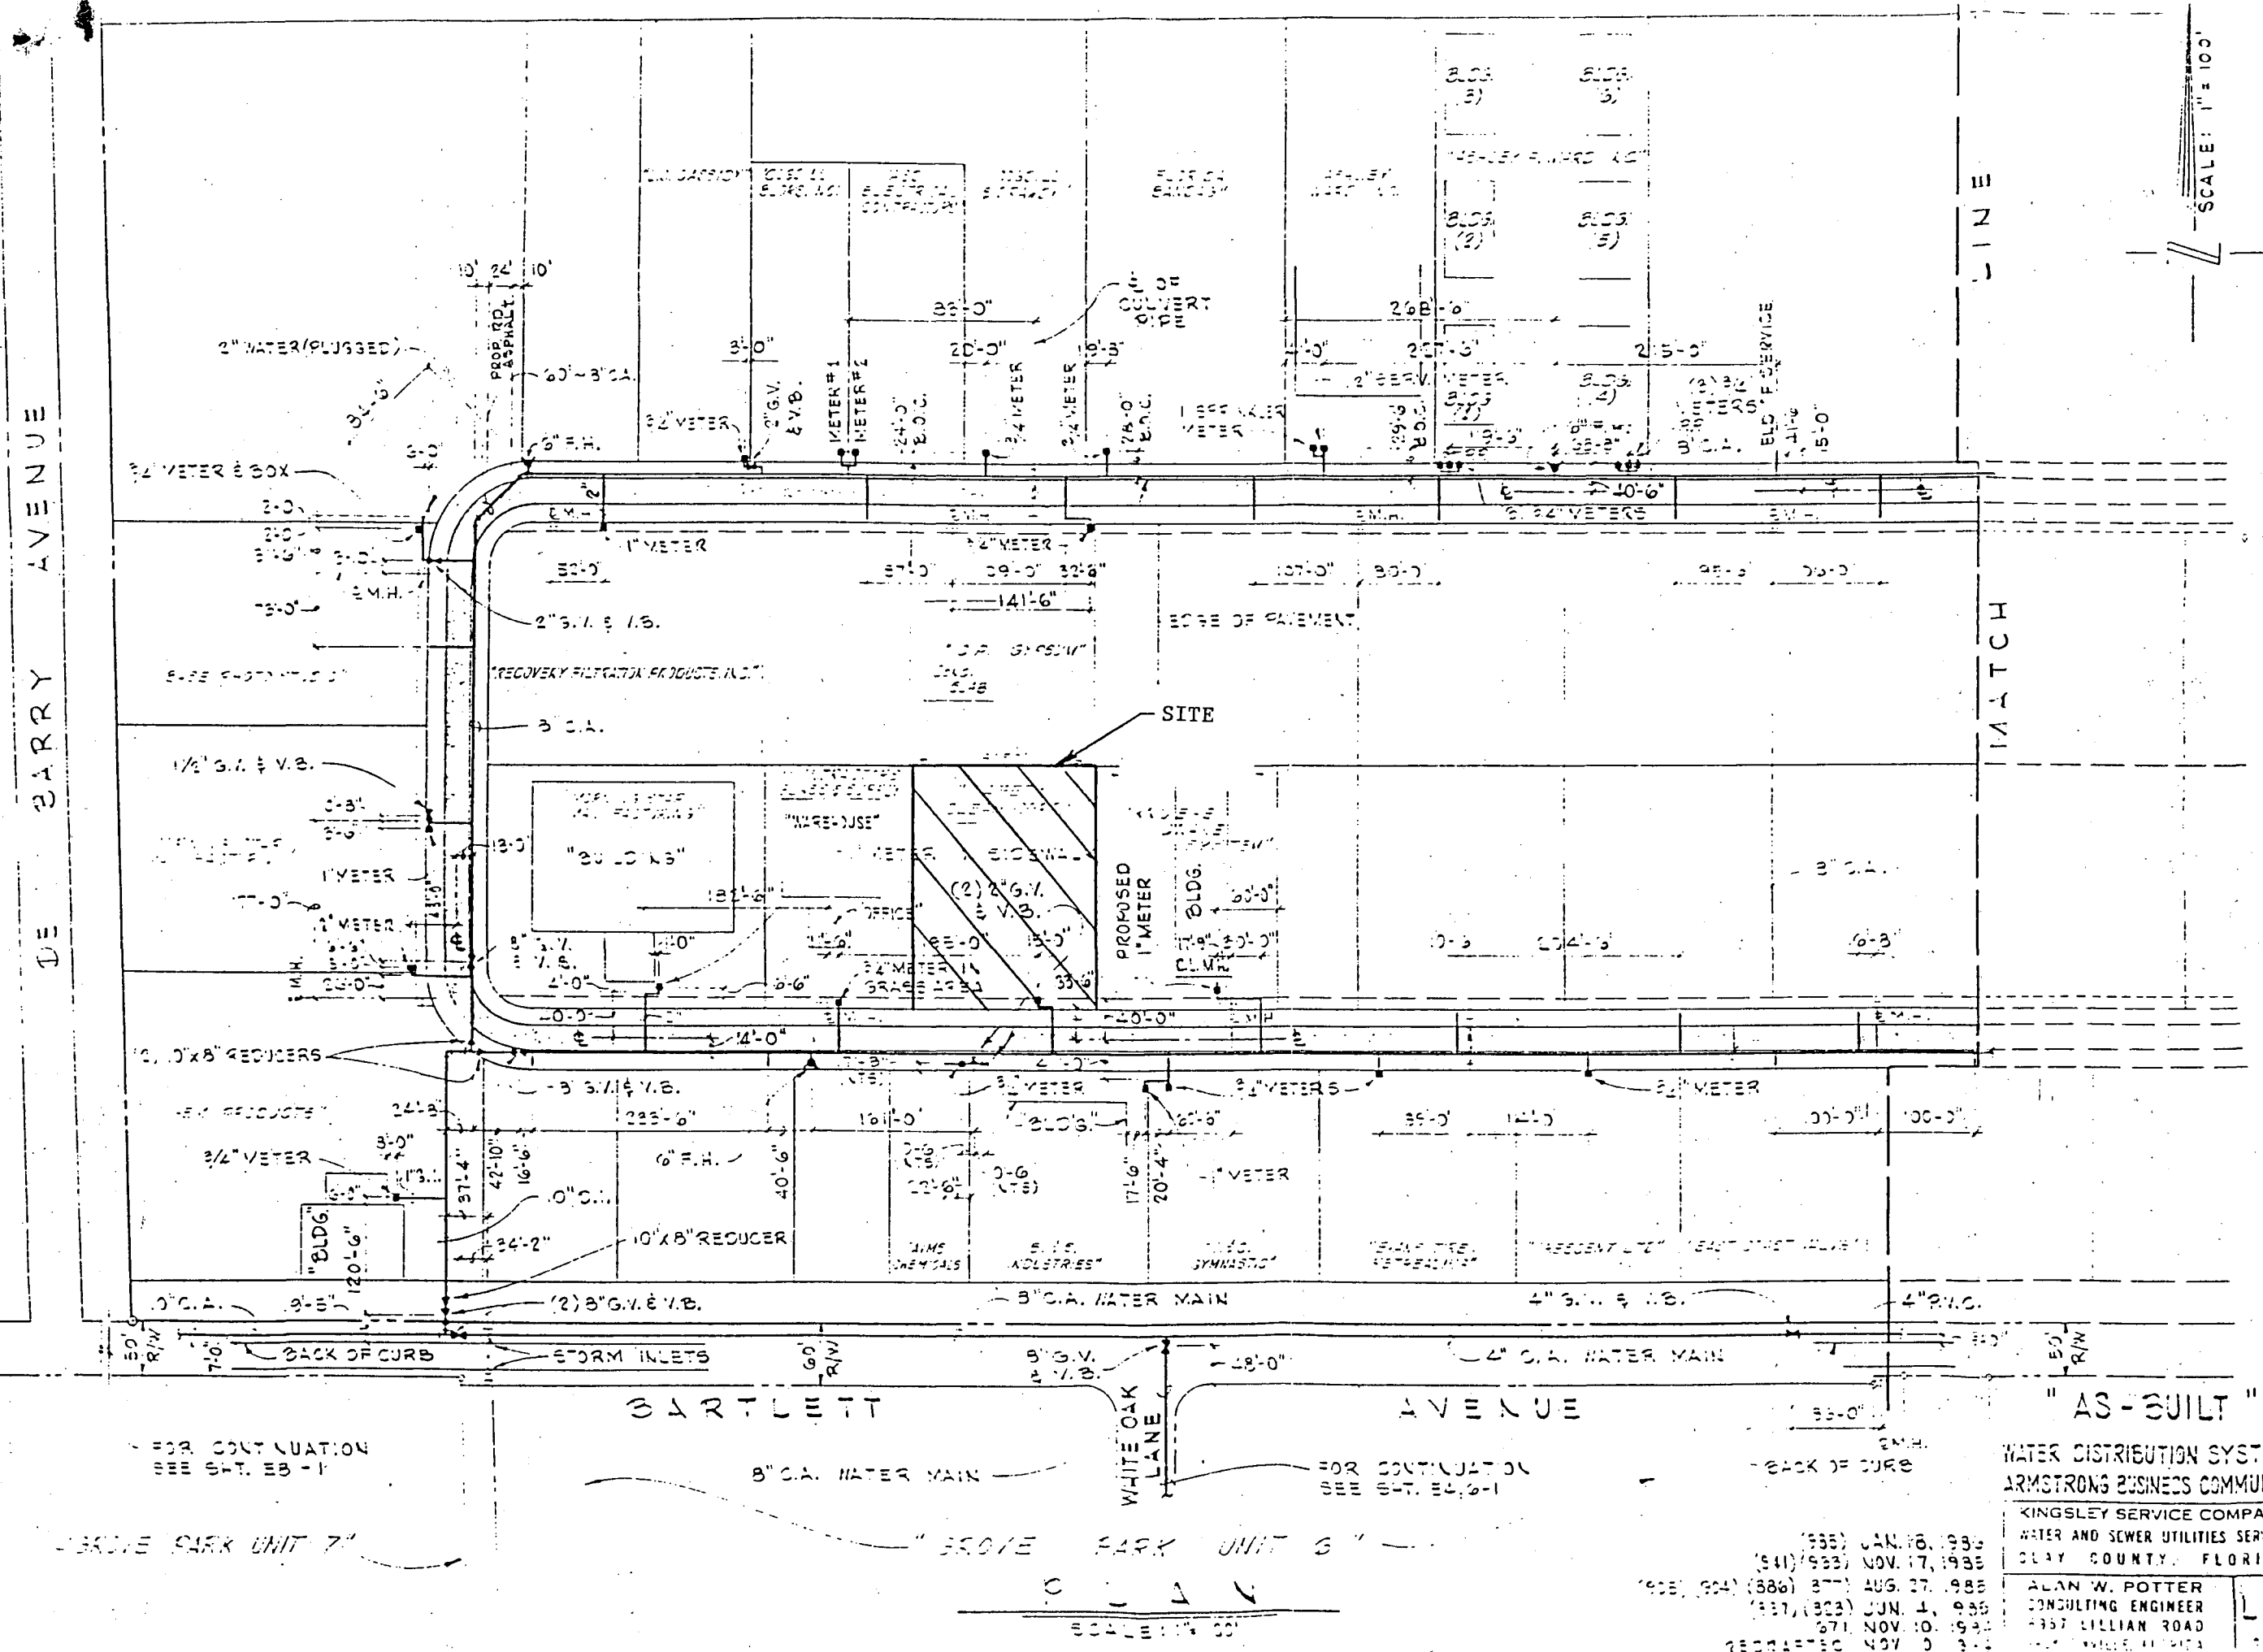

Surrounding Land
Uses

Figure I.B.4-3

"AS-BUILT"

WATER DISTRIBUTION SYSTEM
ARMSTRONG BUSINESS COMMUNITY

KINGSLEY SERVICE COMPANY
WATER AND SEWER UTILITIES SERVICE
CLAY COUNTY, FLORIDA

ALAN W. POTTER
CONSULTING ENGINEER
4357 LILLIAN ROAD
DAVIE, FLORIDA

LI-2

555) JAN. 16, 1985
 541) 533) NOV. 17, 1985
 505) 504) 536) 577) AUG. 27, 1985
 537) 523) JUN. 1, 1985
 571) NOV. 10, 1985
 25011-150 NOV. 3, 1985