


DE BARRY AVENUE

LINE

MATCH

SCALE: 1" = 100'

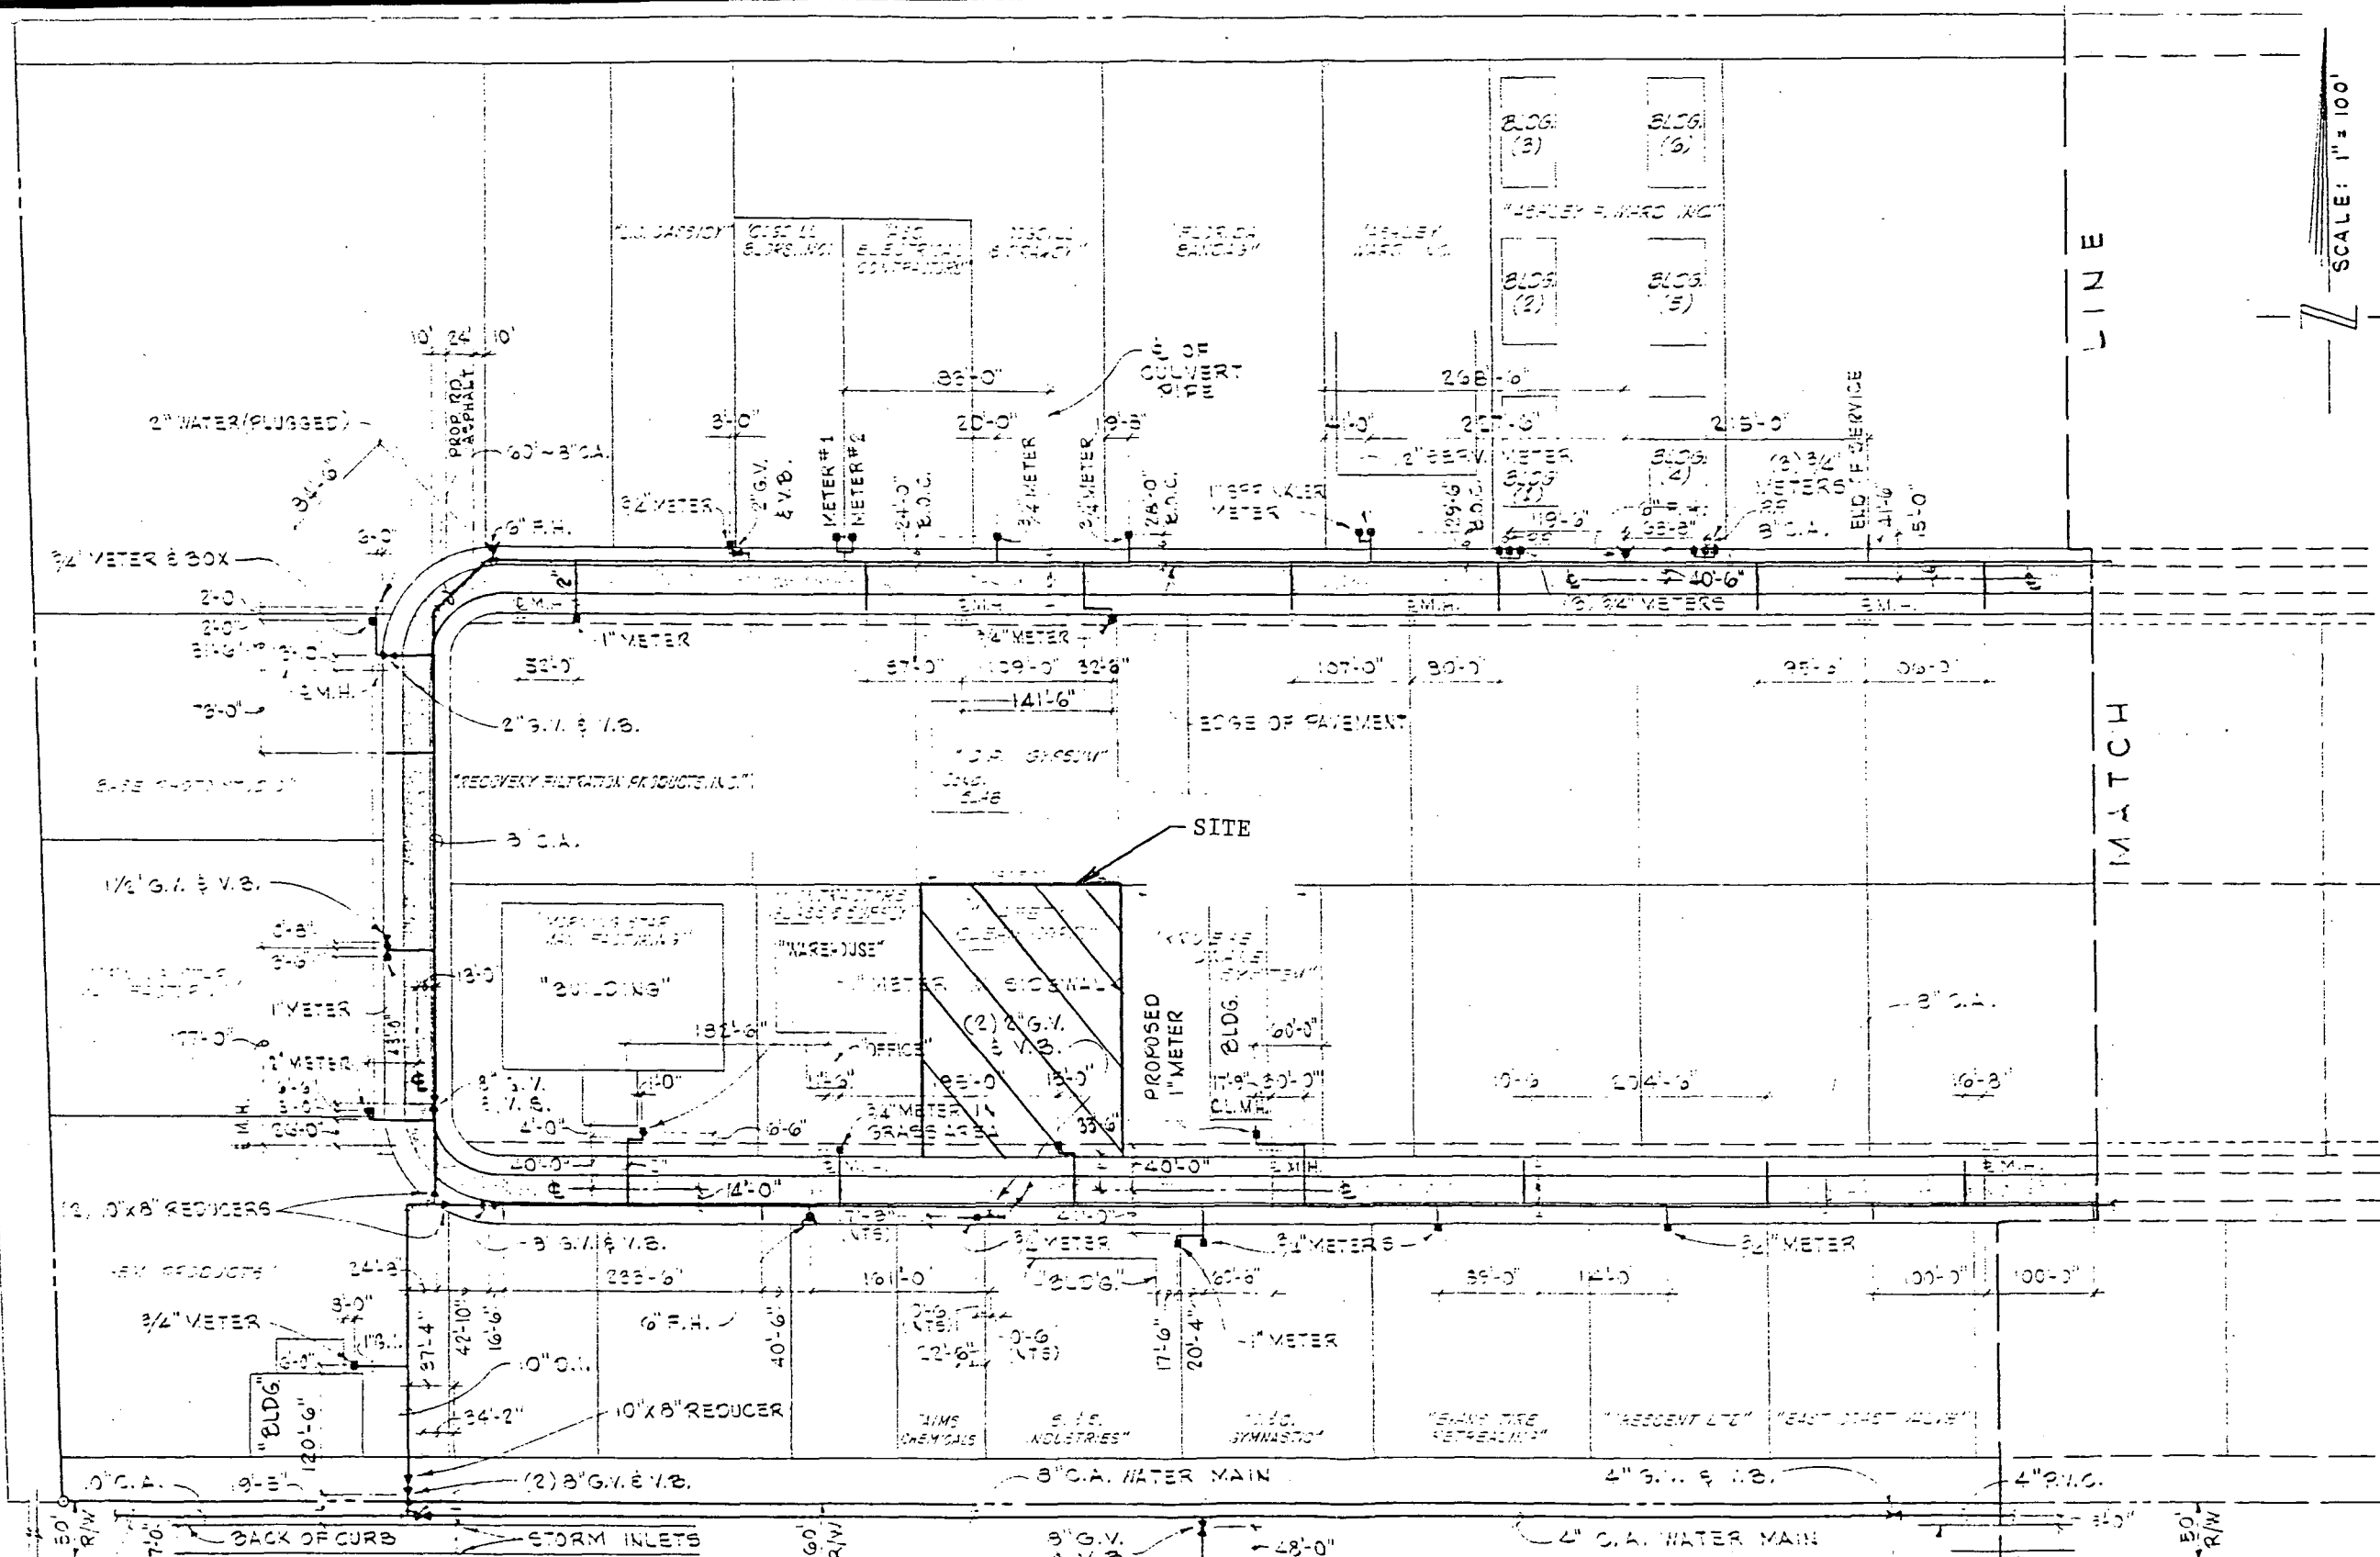

"AS-BUILT"

WATER DISTRIBUTION SYSTEM  
ARMSTRONG BUSINESS COMMUNITY

KINGSLEY SERVICE COMPANY  
WATER AND SEWER UTILITIES SERVICE  
CLAY COUNTY, FLORIDA

ALAN W. POTTER  
CONSULTING ENGINEER  
4357 LILLIAN ROAD  
DAKEVILLE, FLORIDA

LI-2  
SHEET

Exhibit I.B.3-4

1985 JAN. 16, 1986  
(341) (933) NOV. 17, 1985  
(305), (304) (886) (377) AUG. 27, 1985  
(337), (323) JUN. 1, 1985  
671 NOV. 10, 1990  
RECORDED NOV. 10, 1990

SCALE: 1" = 100'