
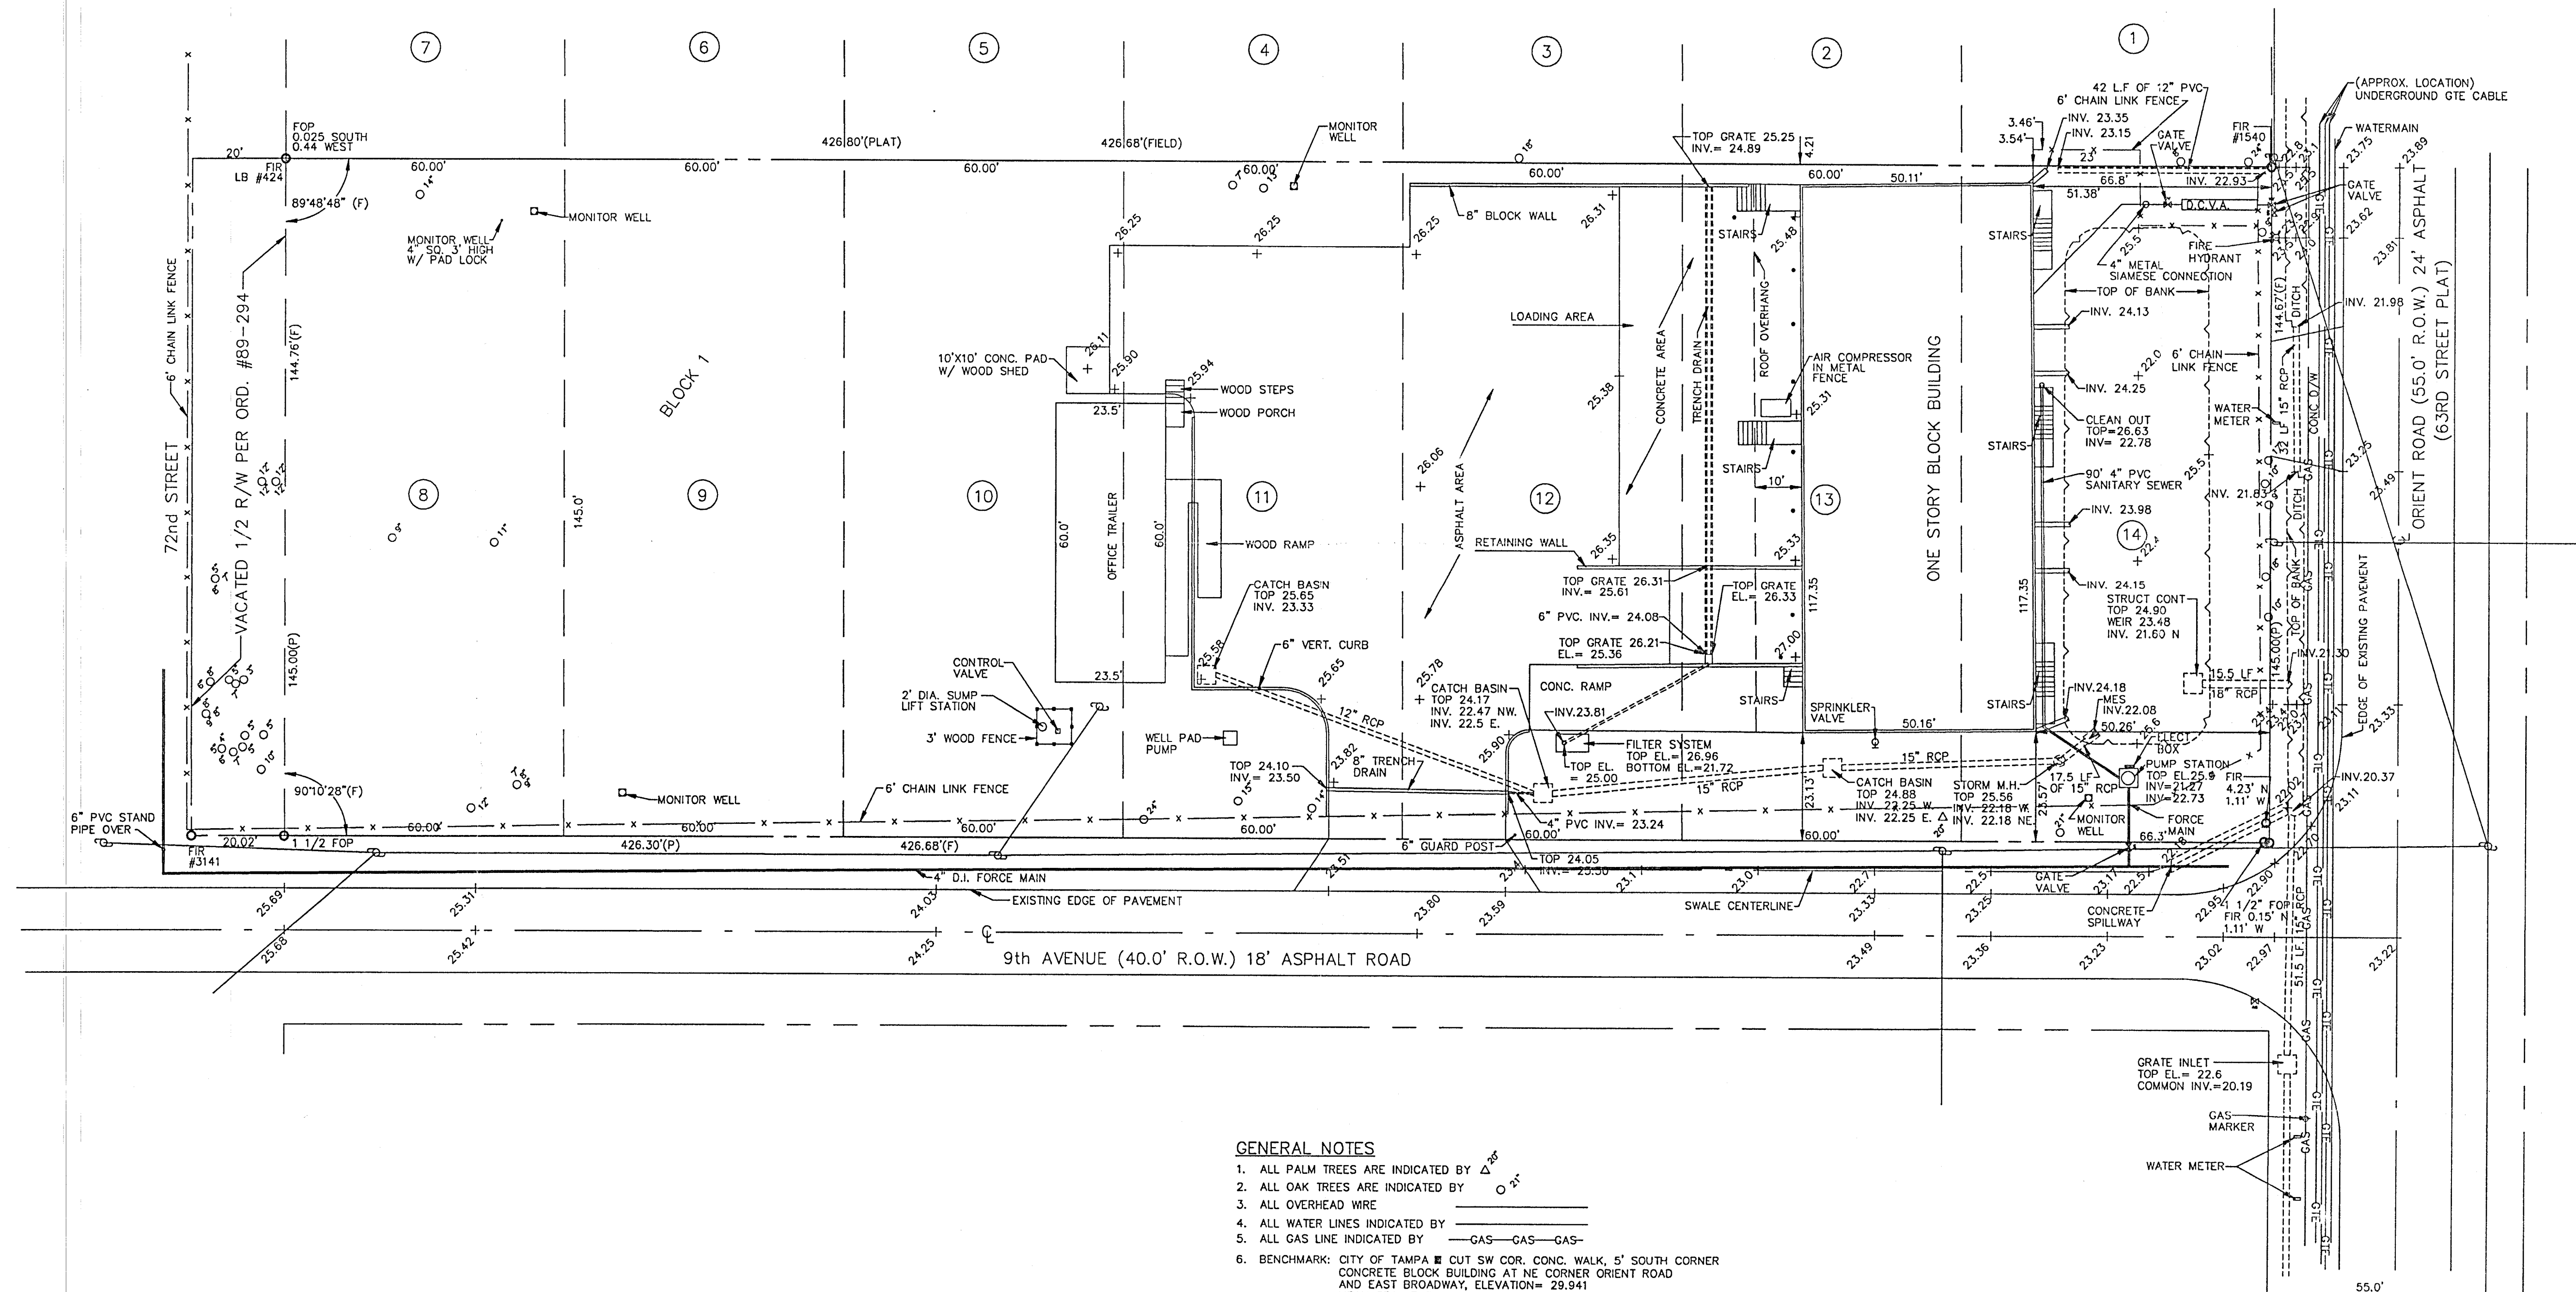
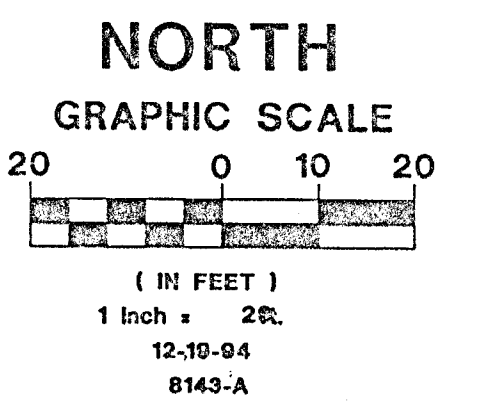


A SURVEY OF LOTS 8 THRU 14, INCLUSIVE, BLOCK1, ORIENT PARK, AS RECORDED IN PLAT BOOK 11, PAGE 7, PUBLIC RECORDS OF HILLSBOROUGH COUNTY, FLORIDA; TOGETHER WITH THE EAST 1/2 OF THAT PORTION OF 72ND STREET (62ND STREET PER PLAT) ABUTTING LOTS, BLOCK 1, AND LOT 2, BLOCK2, OF STATED ORIENT PARK.

DESCRIPTION: (WATER LINE EASEMENT)
THE SOUTH 5.0 FEET OF LOTS 8 THRU 14, INCLUSIVE, BLOCK 1, ORIENT PARK, AS RECORDED IN PLAT BOOK 11, PAGE 7, PUBLIC RECORDS OF HILLSBOROUGH COUNTY, FLORIDA; TOGETHER WITH THE SOUTH 5.0 FEET OF THE EAST 1/2 OF THAT PORTION OF 72ND STREET (62ND STREET PER PLAT) ABUTTING LOT 8, BLOCK1, AND LOT 2, BLOCK 2, OF STATED ORIENT PARK

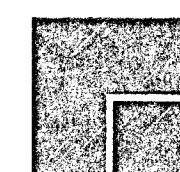

1. ALL PALM TREES ARE INDICATED BY Δ 80
2. ALL OAK TREES ARE INDICATED BY Δ 21
3. ALL OVERHEAD WIRE _____
4. ALL WATER LINES INDICATED BY _____
5. ALL GAS LINE INDICATED BY _____ GAS—GAS—GAS—
6. BENCHMARK: CITY OF TAMPA $\square$ CUT SW COR. CONC. WALK, 5' SOUTH CORNER
CONCRETE BLOCK BUILDING AT NE CORNER ORIENT ROAD
AND EAST BROADWAY ELEVATION = 29.941
MEAN SEA LEVEL = 0.00
7. ALL GUARD POST INDICATED BY *
8. ALL FINISHED GRADES INDICATED BY ∇ 23.80

[illegible]

Engineering & Applied Science, Inc.
Tampa, Florida



Source: Seminole Engineering (1989), KBN (1994).

ORIENT ROAD FACILITY SITE MAP



CITY ENVIRONMENTAL SERVICES, INC. OF FLORIDA
7202 EAST EIGHTH AVENUE • TAMPA, FLORIDA 33619

Designed: SGR	PN: 96001
Drawn: WLR	Sheet:
Checked: SGR	1 of 2
Date: 02/17/96	

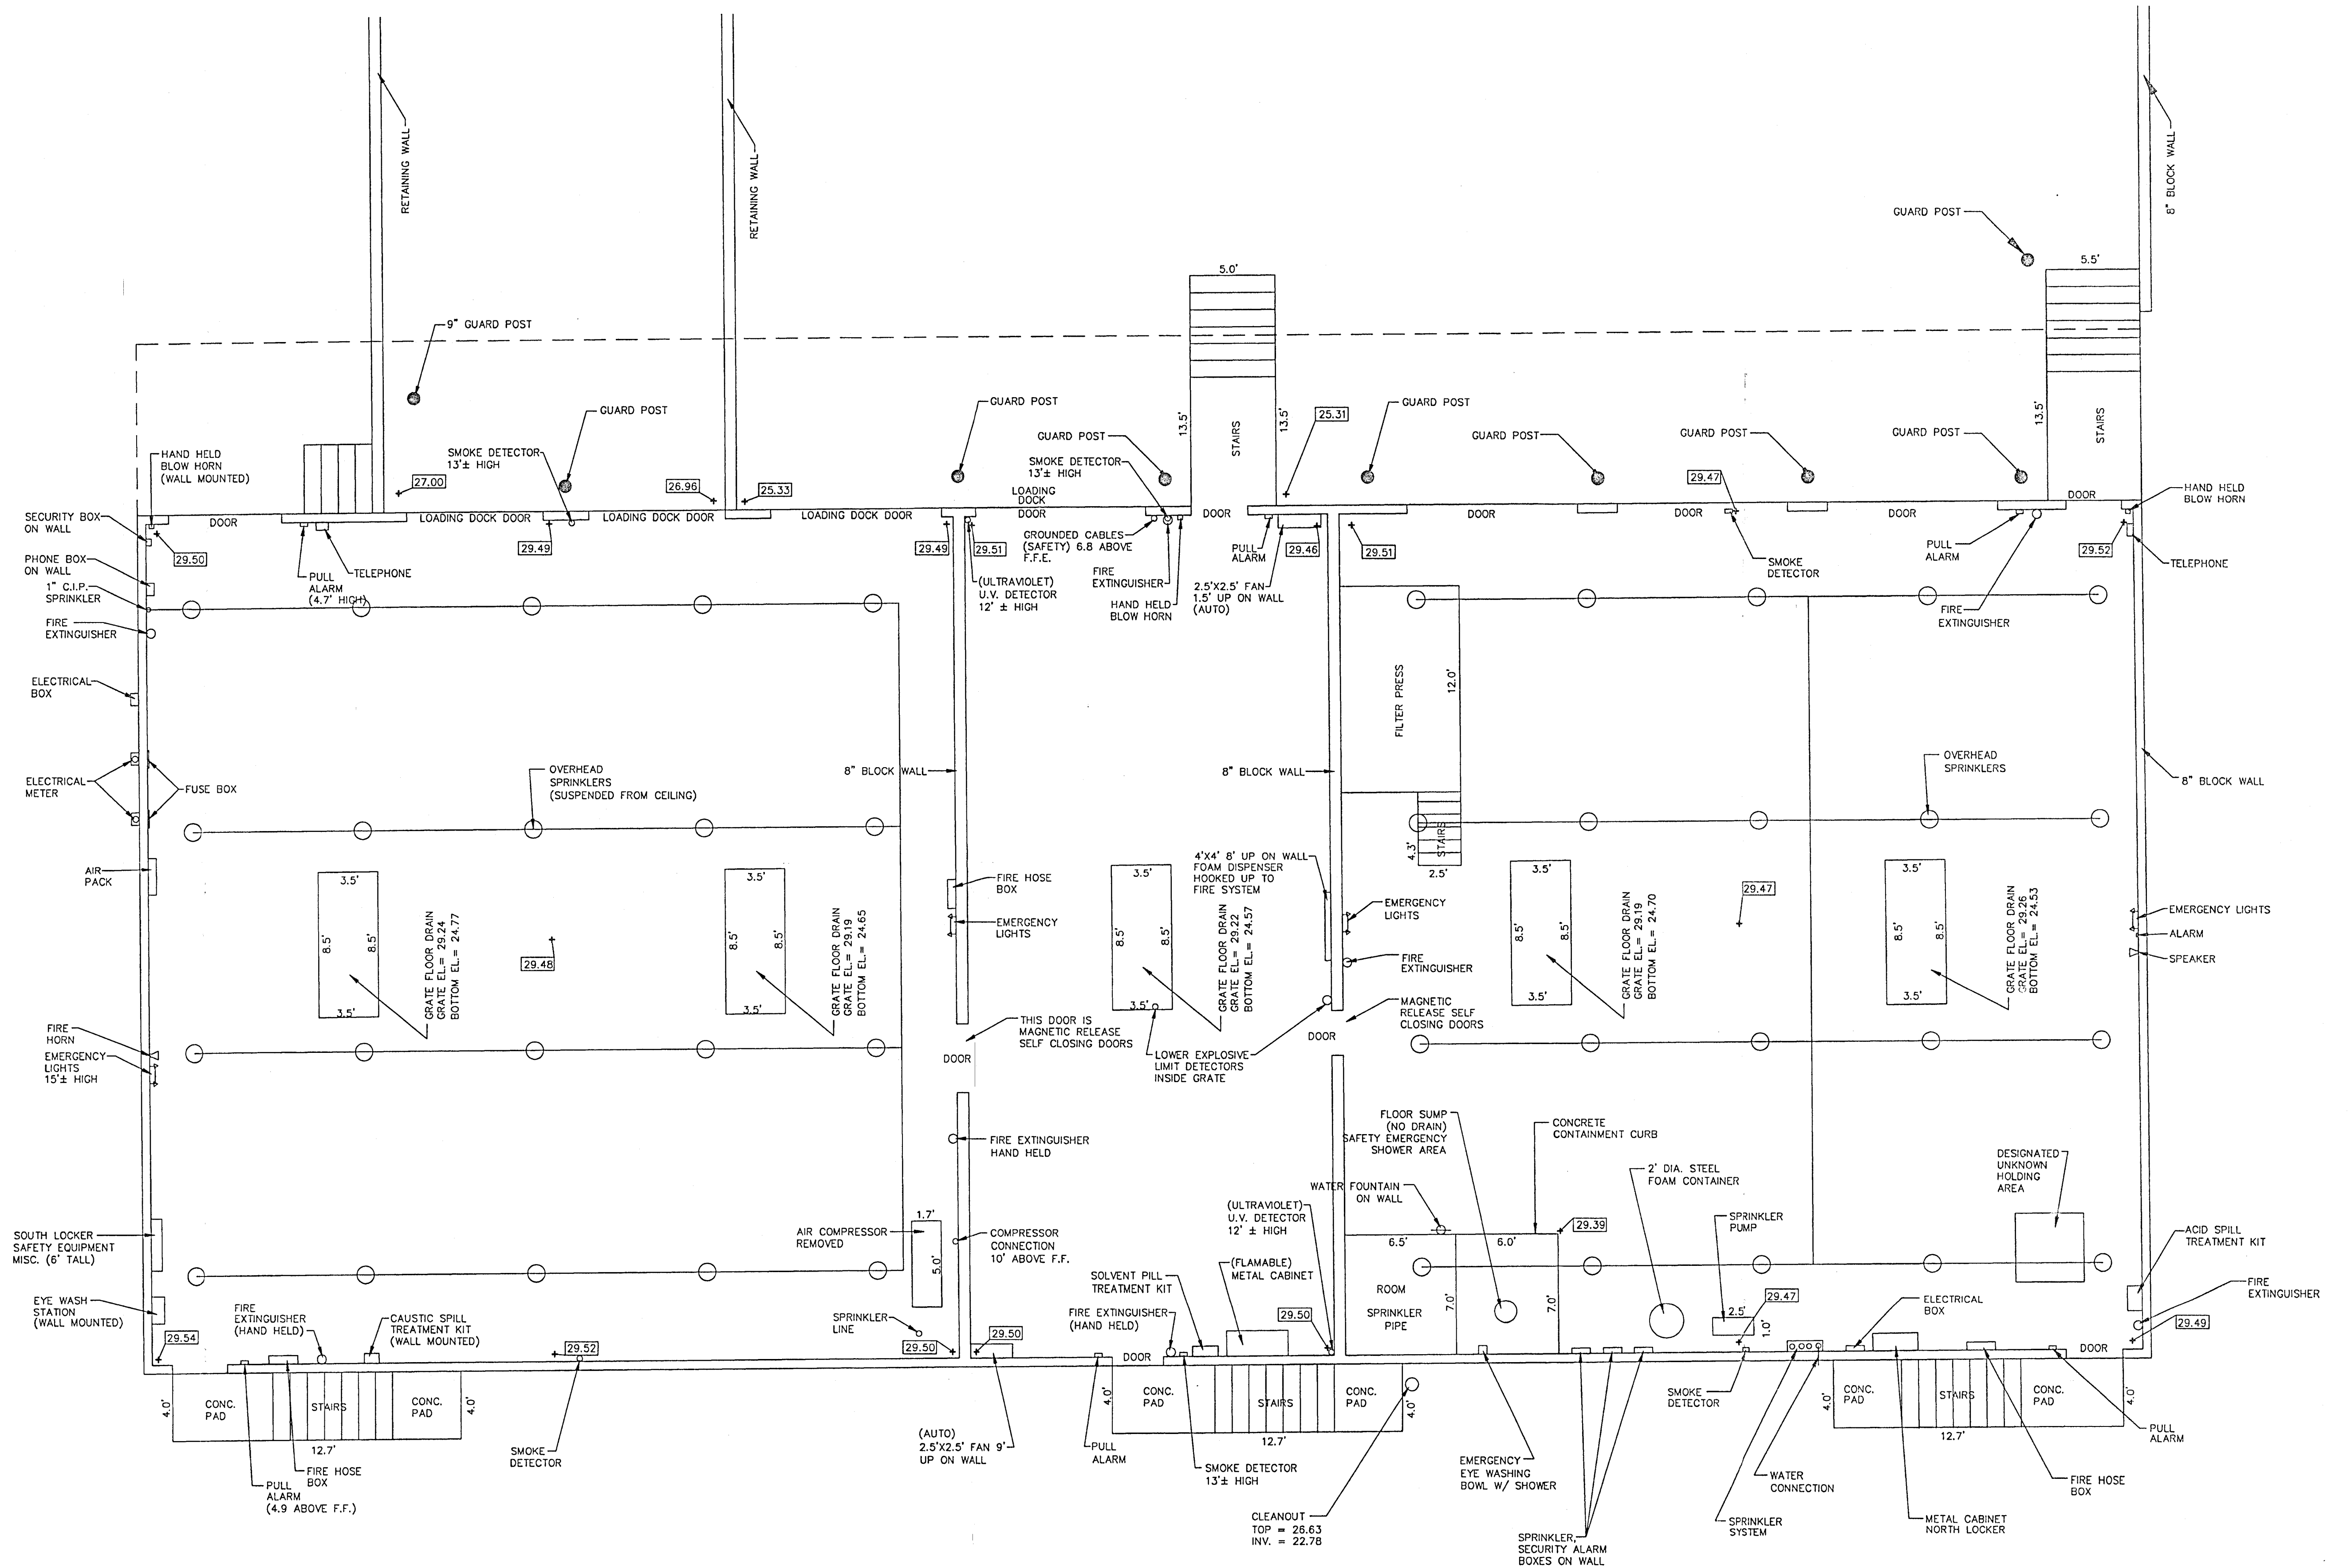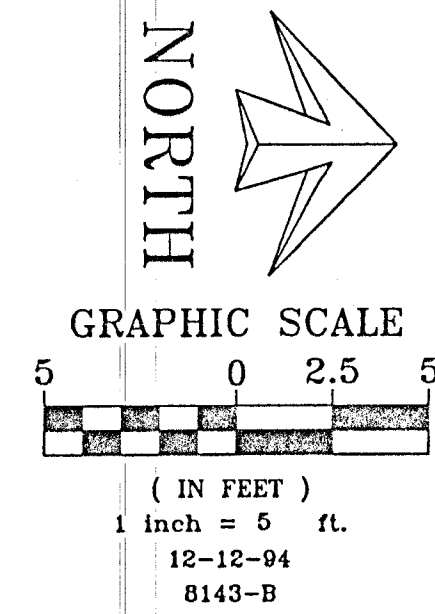

Sketch A
PL DE NO. 29608
8/12/96

No.	DRAWN	CHECKED	REVISION	DATE
1	WLR	SR	EAS	08/06/96

Engineering & Applied Science, Inc.
Tampa, Florida
SOURCE: SEMINOLE ENGINEERING (1989), KBN (1994)

ORIENT ROAD FACILITY WASTE MANAGEMENT BUILDING

CITY
CITY ENVIRONMENTAL SERVICES, INC. OF FLORIDA
7202 EAST EIGHTH AVENUE • TAMPA, FLORIDA 33619


Designed:	SGR	PN:	96001
Drawn:	WLR	Sheet:	
Checked:	SGR		
Date:	02/19/96		

LEGAL DESCRIPTION


A SURVEY OF LOTS 8 THRU 14, INCLUSIVE, BLOCK 1, ORIENT PARK, AS RECORDED IN PLAT BOOK 11, PAGE 7, PUBLIC RECORDS OF HILLSBOROUGH COUNTY, FLORIDA; TOGETHER WITH THE EAST 1/2 OF THAT PORTION OF 72ND STREET (62ND STREET PER PLAT) ABUTTING LOT 8, BLOCK 1, AND LOT 2, BLOCK 2, OF STATED ORIENT PARK.

DESCRIPTION; (WATER LINE EASEMENT)


THE SOUTH 5.0 FEET OF LOTS 8 THRU 14, INCLUSIVE, BLOCK 1, ORIENT PARK, AS RECORDED IN PLAT BOOK 11, PAGE 7, PUBLIC RECORDS OF HILLSBOROUGH COUNTY, FLORIDA; TOGETHER WITH THE SOUTH 5.0 FEET OF THE EAST 1/2 OF THAT PORTION OF 72ND STREET (62ND STREET PER PLAT) ABUTTING LOT 8, BLOCK 1, AND LOT 2, BLOCK 2, OF STATED ORIENT PARK.

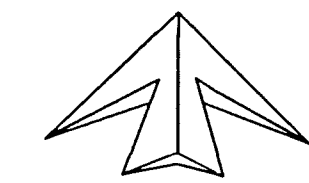

NORTH
GRAPHIC SCALE

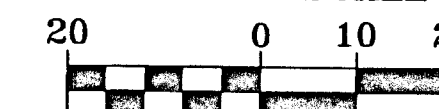

(IN FEET)
1 inch = 20 ft.
12-27-94
8143-A

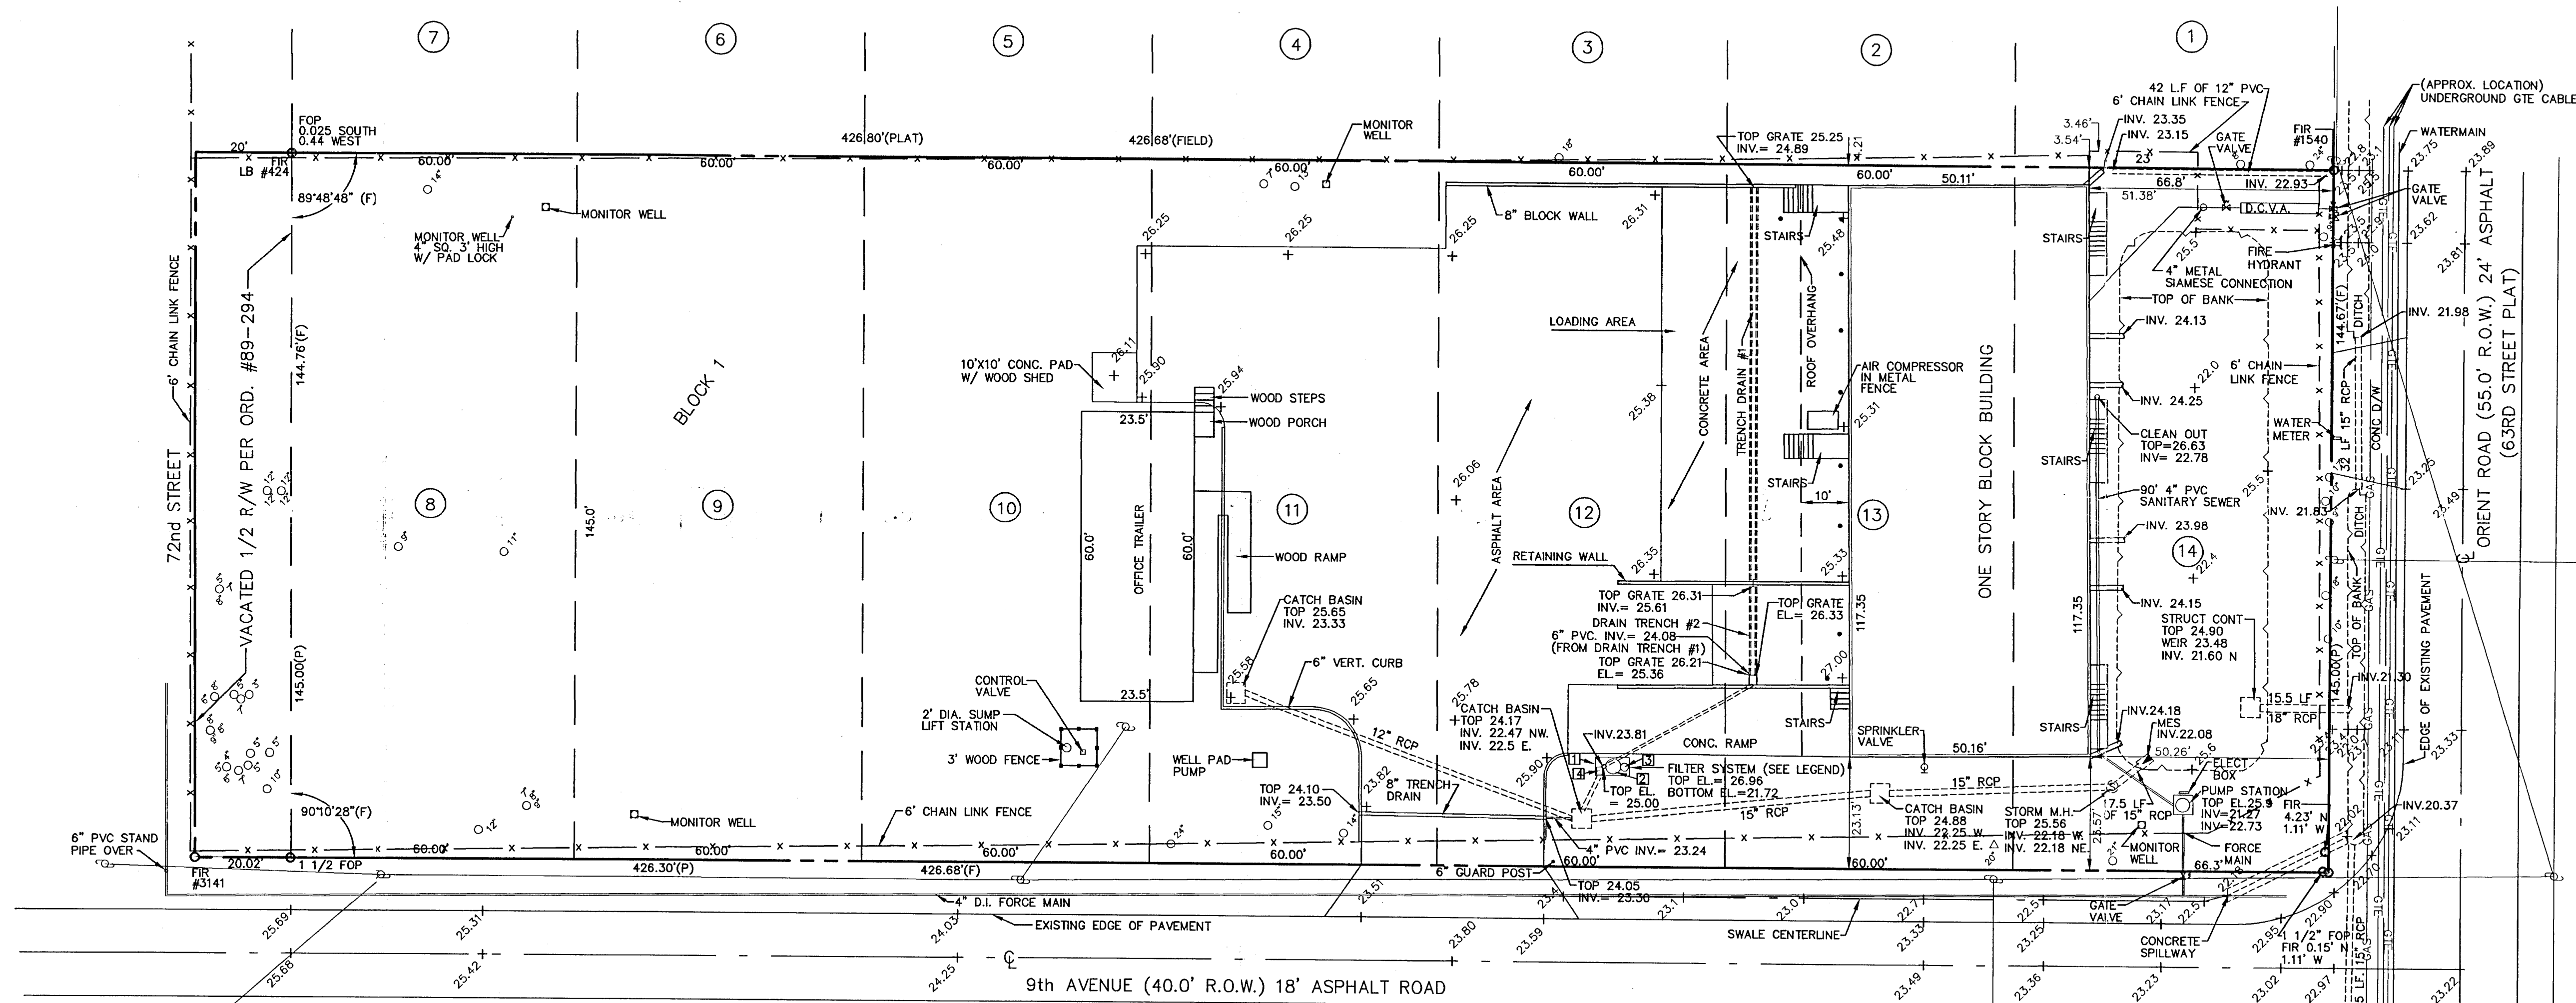

GENERAL NOTES

1. ALL PALM TREES ARE INDICATED BY
2. ALL OAK TREES ARE INDICATED BY
3. ALL OVERHEAD WIRE
4. ALL WATER LINES INDICATED BY
5. ALL GAS LINE INDICATED BY
6. BENCHMARK: CITY OF TAMPA ■ CUT SW COR. CONC. WALK, 5' SOUTH CORNER CONCRETE BLOCK BUILDING AT NE CORNER ORIENT PARK AND EAST BROADWAY, ELEVATION= 29.941 MEAN SEA LEVEL = 0.00
7. ALL GUARD POST INDICATED BY
8. ALL FINISHED GRADES INDICATED BY +23.80

LEGEND

1. 24" DIA. x 48" DEEP CONCRETE PIPE SUMP WITH COVER
2. 1600+ GALLON VERTICAL FIBERGLASS TANK SAND FILTER
3. 5" - 4" DIA. x 10' - 0" HIGH
4. 55 GALLON CARBON FILTER - DISCHARGE TO CATCH BASIN
5. MANUALLY OPERATED 1/2 H.P. SUBMERSIBLE PUMP, 30+ GPM 1 1/2" NPT DISCHARGE, 110 V, 11.8 AMPS

GRATE INLET
TOP EL.= 22.6
COMMON INV.=20.19

GAS MARKER


WATER METER



Universal Waste
& Transit, Inc.



KBN ENGINEERING AND APPLIED SCIENCES, INC.
5405 W. Cypress St., Suite 215 Tel: (813) 287-1717
Tampa, Florida 33607 FAX: (813) 287-1716

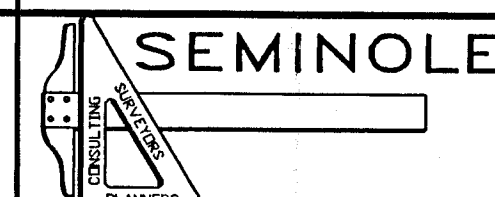

SEMINOLE ENGINEERING, INC.

14483 62nd STREET NORTH
CLEARWATER, FL. 34620
TELEPHONE (813) 539-0051

RECORD DRAWING - 11/22/94

James M. Winter, P.E. # 18313
DATE: 12/27/94

DWG. FILE No.
8143-A
PROJECT No.
8143
FIELD BOOK No.
ENC. SHEET No.
1 OF 2



EXISTING LOT PLAN

DATE	No.	REVISIONS	BY	SCALE	CHECKED BY	DATE
12/21/94		KBN ENGINEERING AND APPLIED SCIENCES, INC.; BY WLR	SR	1" = 20'	JMH	12-12-94
12/12/94		JOB NO. 8143; DRAWN BY JES	JHM		JES	
4/12/89		JOB NO. 8143; SEMINOLE ENGINEERING; BY CN	EW		JMH	

PRELIMINARY
CONSTRUCTION
RECORD DRAWING

CLIENT
UNIVERSAL WASTE
& TRANSIT, INC.

DATE
12-12-94
DRAWN BY
JES
CHECKED BY
JMH

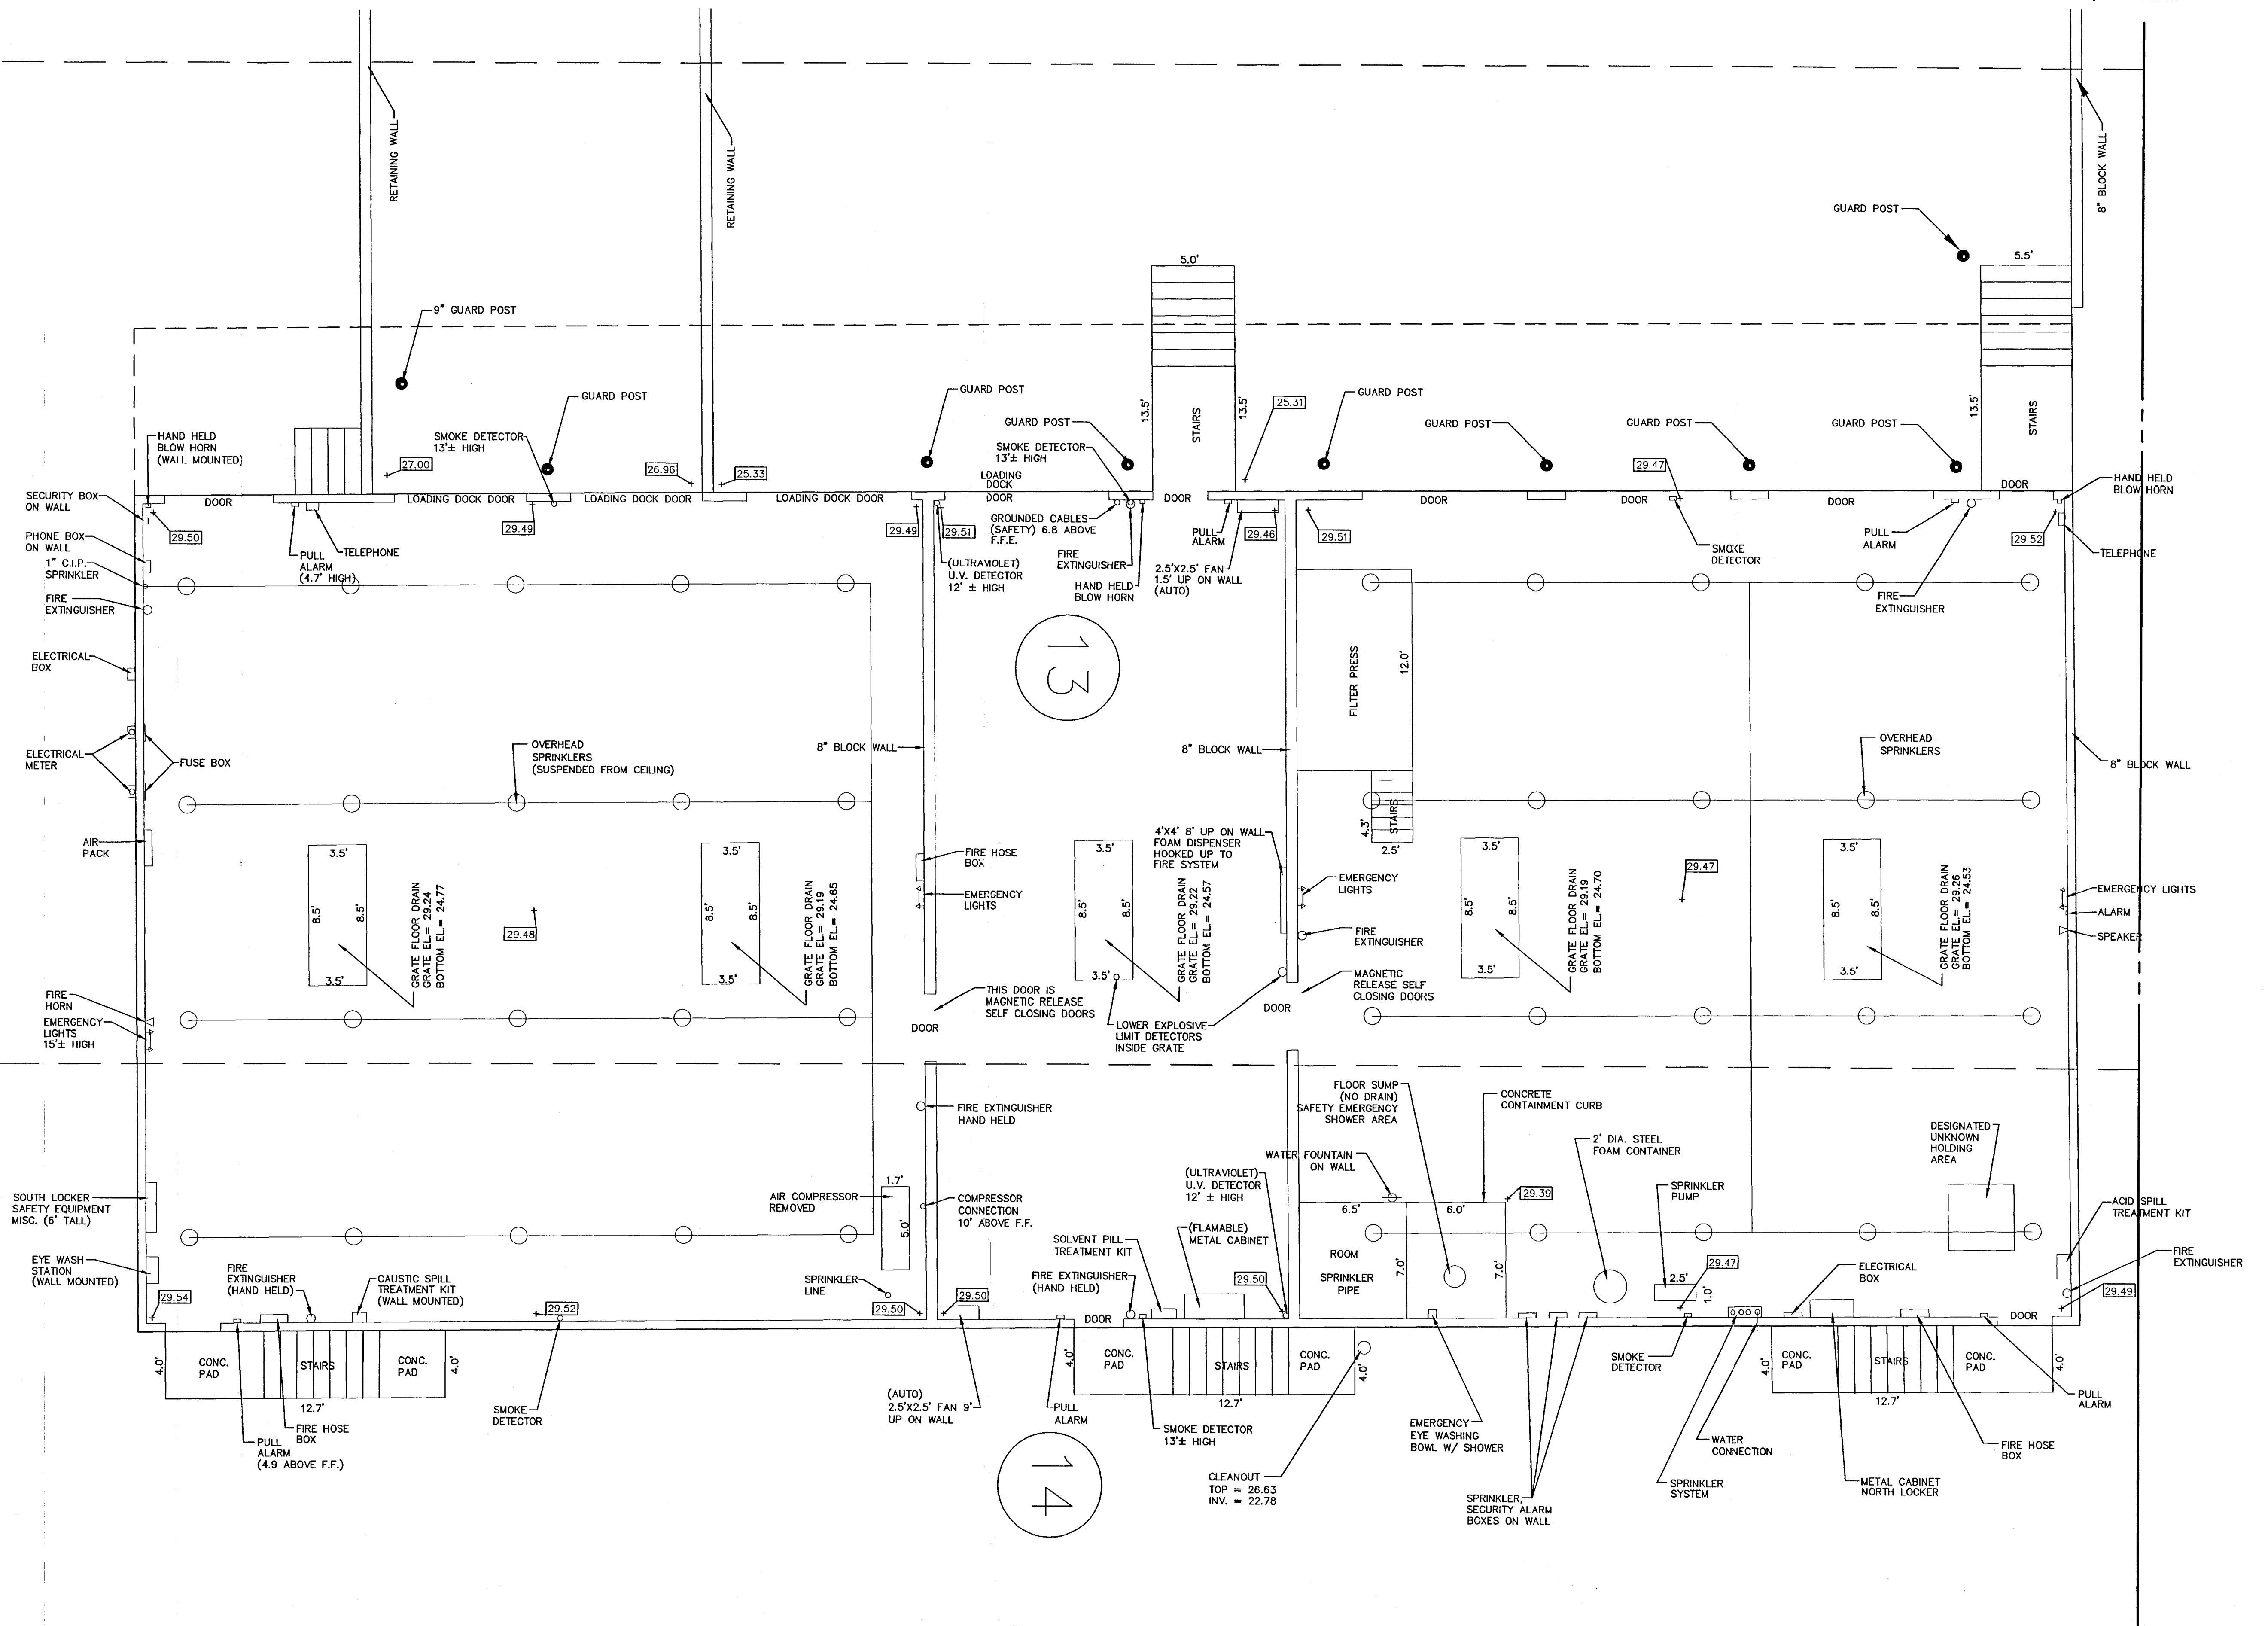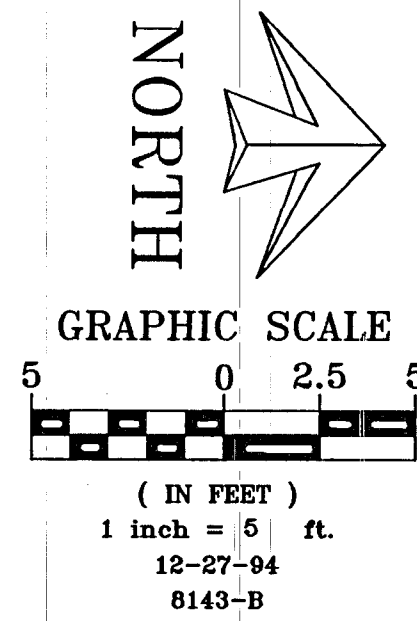

Universal Waste
& Transit, Inc.



KBN ENGINEERING AND APPLIED SCIENCES, INC.
5405 W. Cypress St., Suite 215 Telephone: (813) 287-1717
Tampa, Florida 33607 FAX: (813) 287-1716

DATE	No.	REVISIONS	BY


- ☐ PRELIMINARY
☐ CONSTRUCTION
☒ RECORD DRAWING

CLIENT
UNIVERSAL WASTE
& TRANSIT, INC.

DATE
12-12-94
DRAWN BY
JES
CHECKED BY
JMH

SCALE
1" = 5'

EXISTING BUILDING PLAN

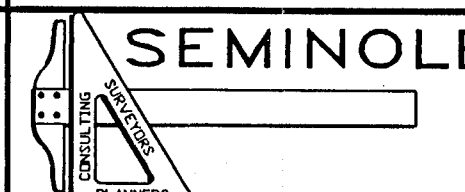

SEMINOLE ENGINEERING, INC.

14483 62nd STREET NORTH
CLEARWATER, FL. 34620
TELEPHONE (813) 539-0051

RECORD DRAWING - 11/22/94

James Winter
JAMES M. WINTER, P.E. # 18313
DATE: 12/27/94

DWG. FILE No.
8143-B
FIELD BOOK No.

PROJECT No.
8143
ENG. SHEET No.
2 OF 2