


PHASE II PHASE I

REPAIR PANEL

• PHASE IA
PHASE IB

PHASE IB
PHASE IC

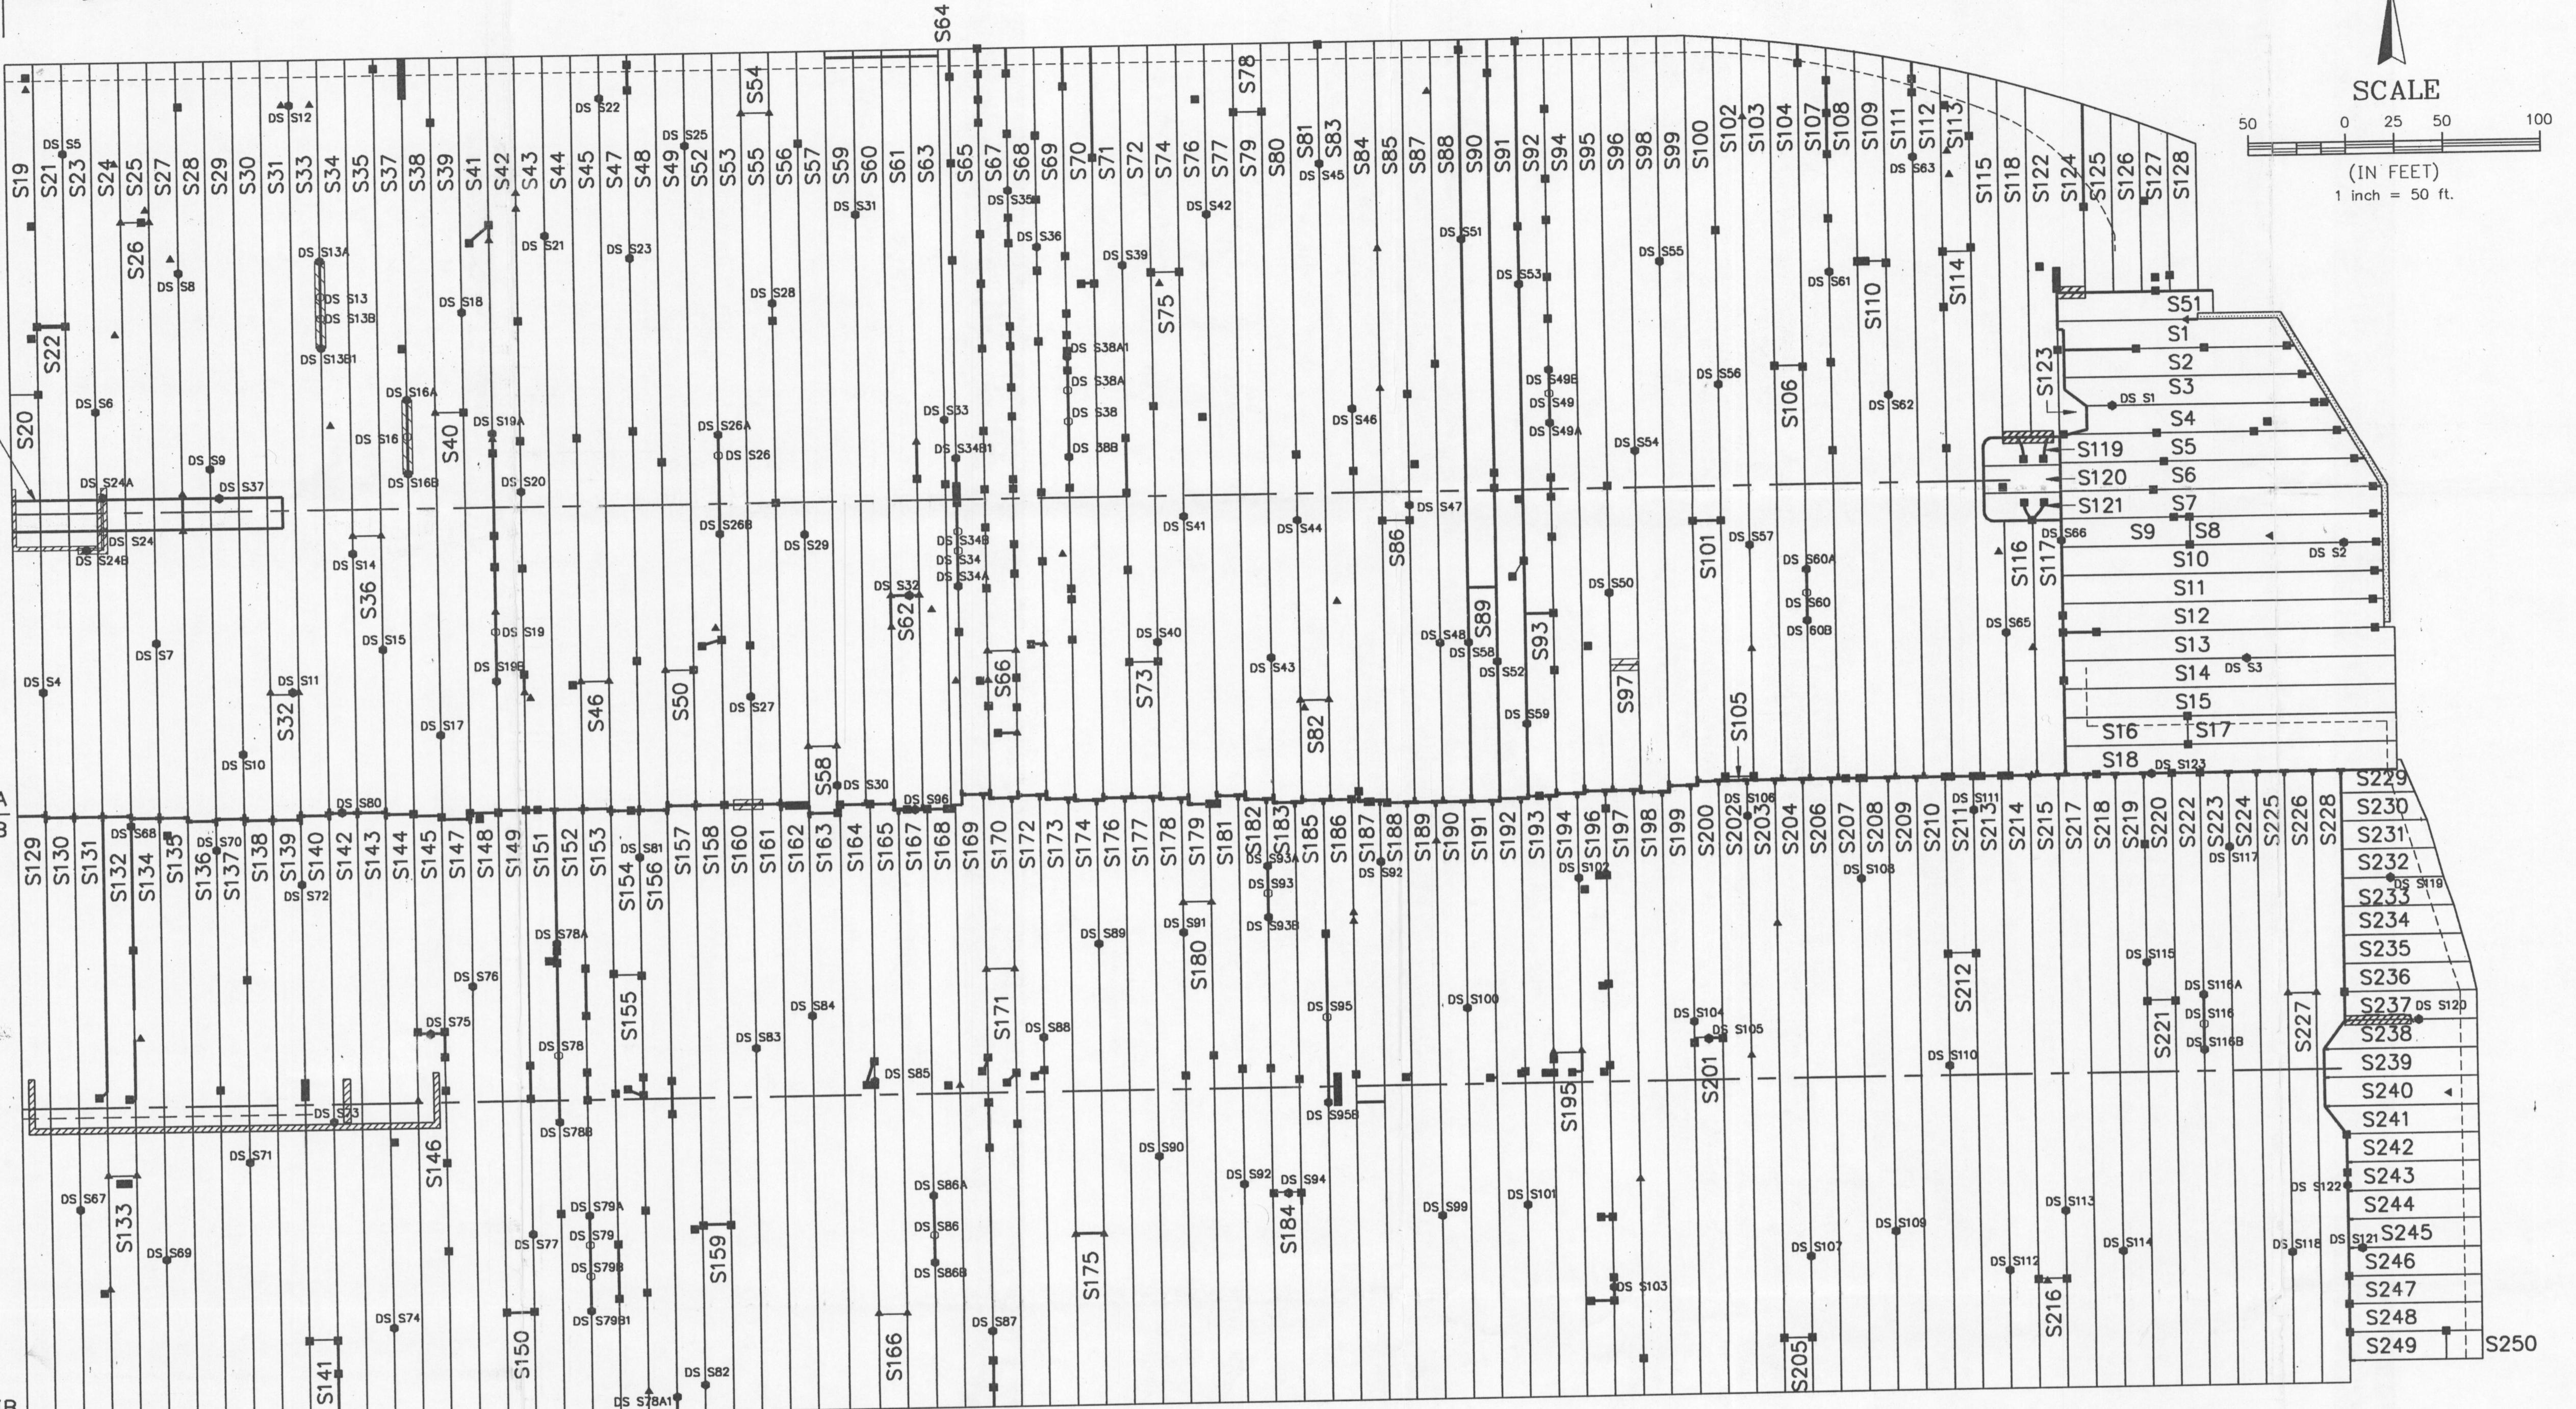

LEGEND

S18	DS 24	SECONDARY GEOMEMBRANE PANEL NUMBER
DS 24	DS 37	PASSED DESTRUCTIVE SEAM SAMPLE
DS 37	▲	FAILED DESTRUCTIVE SEAM SAMPLE
▲	■	EXTRUSION WELD REPAIR LOCATION
■	●	PATCH REPAIR LOCATION
●	—	EXTRUDED SEAM
—	▨	CAPPED SEAM (EXTRUSION SEAMED)
▨	—	FUSION SEAM
—	—	LEACHATE COLLECTION PIPE
—	—	Q OF ANCHOR TRENCH
—	▨	CONTAINMENT/RETAINING WALL

THIS RECORD DRAWING IS A GRAPHIC REPRESENTATION OF THE SECONDARY HDPE GEOMEMBRANE PANEL PLACEMENT AND DESTRUCTIVE SEAM SAMPLE LOCATIONS. FOR TRUE LENGTH OF THE HDPE GEOMEMBRANE PANELS, SEAMS, AND SAMPLE LOCATIONS, REFER TO APPENDICES OF GEOSYNTEC CONSULTANTS CQA FINAL REPORT DATED MAY 1992.

GeoSYNTEC
CONSULTANTS
Boynton Beach, Florida

11 May 1992
DATE

REV.	DATE	DESCRIPTION	DRN BY	APP BY
		PROJECT NO. FQ20:0	SCALE: 1"=50'	
DATE:	5-9-92	PROJECT: TRAIL RIDGE LANDFILL		
DES BY	-	PHASE: IA AND IB		
DRN BY	SLB	DATE: 5-5-92		
CHK BY	HMT	5-8-92		
REV BY	DAS	5-9-92		
APP BY	AK	5-9-92		

SHEET TITLE:
SECONDARY GEOMEMBRANE PANEL
LAYOUT AND SEAM REPAIR LOCATION

1	OF 3
SHEET 1 OF 3	DRAWING NO.

Trail Ridge Landfill, Inc.