Angelo's Recycled Materials

P.O. BOX 1493 **LARGO, FL 33779**



Apopka **Dade City** 407,290,8010 407,290,8115 (fax) 352.567.7676 352.567.9448 (fax)

Tamna Largo

April 13, 2012

Southwest And State on the State of the Stat Ms. Susan Pelz, P.E. Solid Waste Section Manager Florida Department of Environmental Protection – Southwest District 13051 North Telecom Parkway Temple Terrace, FL 33637

RE:

Angelo's Recycled Materials

Enterprise Class III Landfill, Permit No.: 177982-007-SO/T3 Annual Estimate of Remaining Life and Capacity for Landfill

Dear Ms. Pelz:

This letter report is provided to the Department as required by Rule 62-701.500(13)(c), F.A.C. A new topographic survey (signed and sealed) showing the top of the active fill areas was completed by Simmons and Beall, Inc. on March 7, 2012 and is enclosed.

To date Cells 1, 2, 3, 4, 5, and 15 have been constructed, certified by the Department, and have accepted Class III materials.

The remaining airspace capacity of the permitted landfill is estimated to be approximately 446,000 cy (as of January 1, 2012), which will take approximately 2.1 years to fill assuming the current annual disposal rate remains constant.

If you have any questions, please feel free to call me at (352) 339-1408.


Sincerely.

John P. Arnold, P.E.

Enclosure


Dominic Infrate Gary Bucholz

SPECIFIC PURPOSE ELEVATION SURVEY

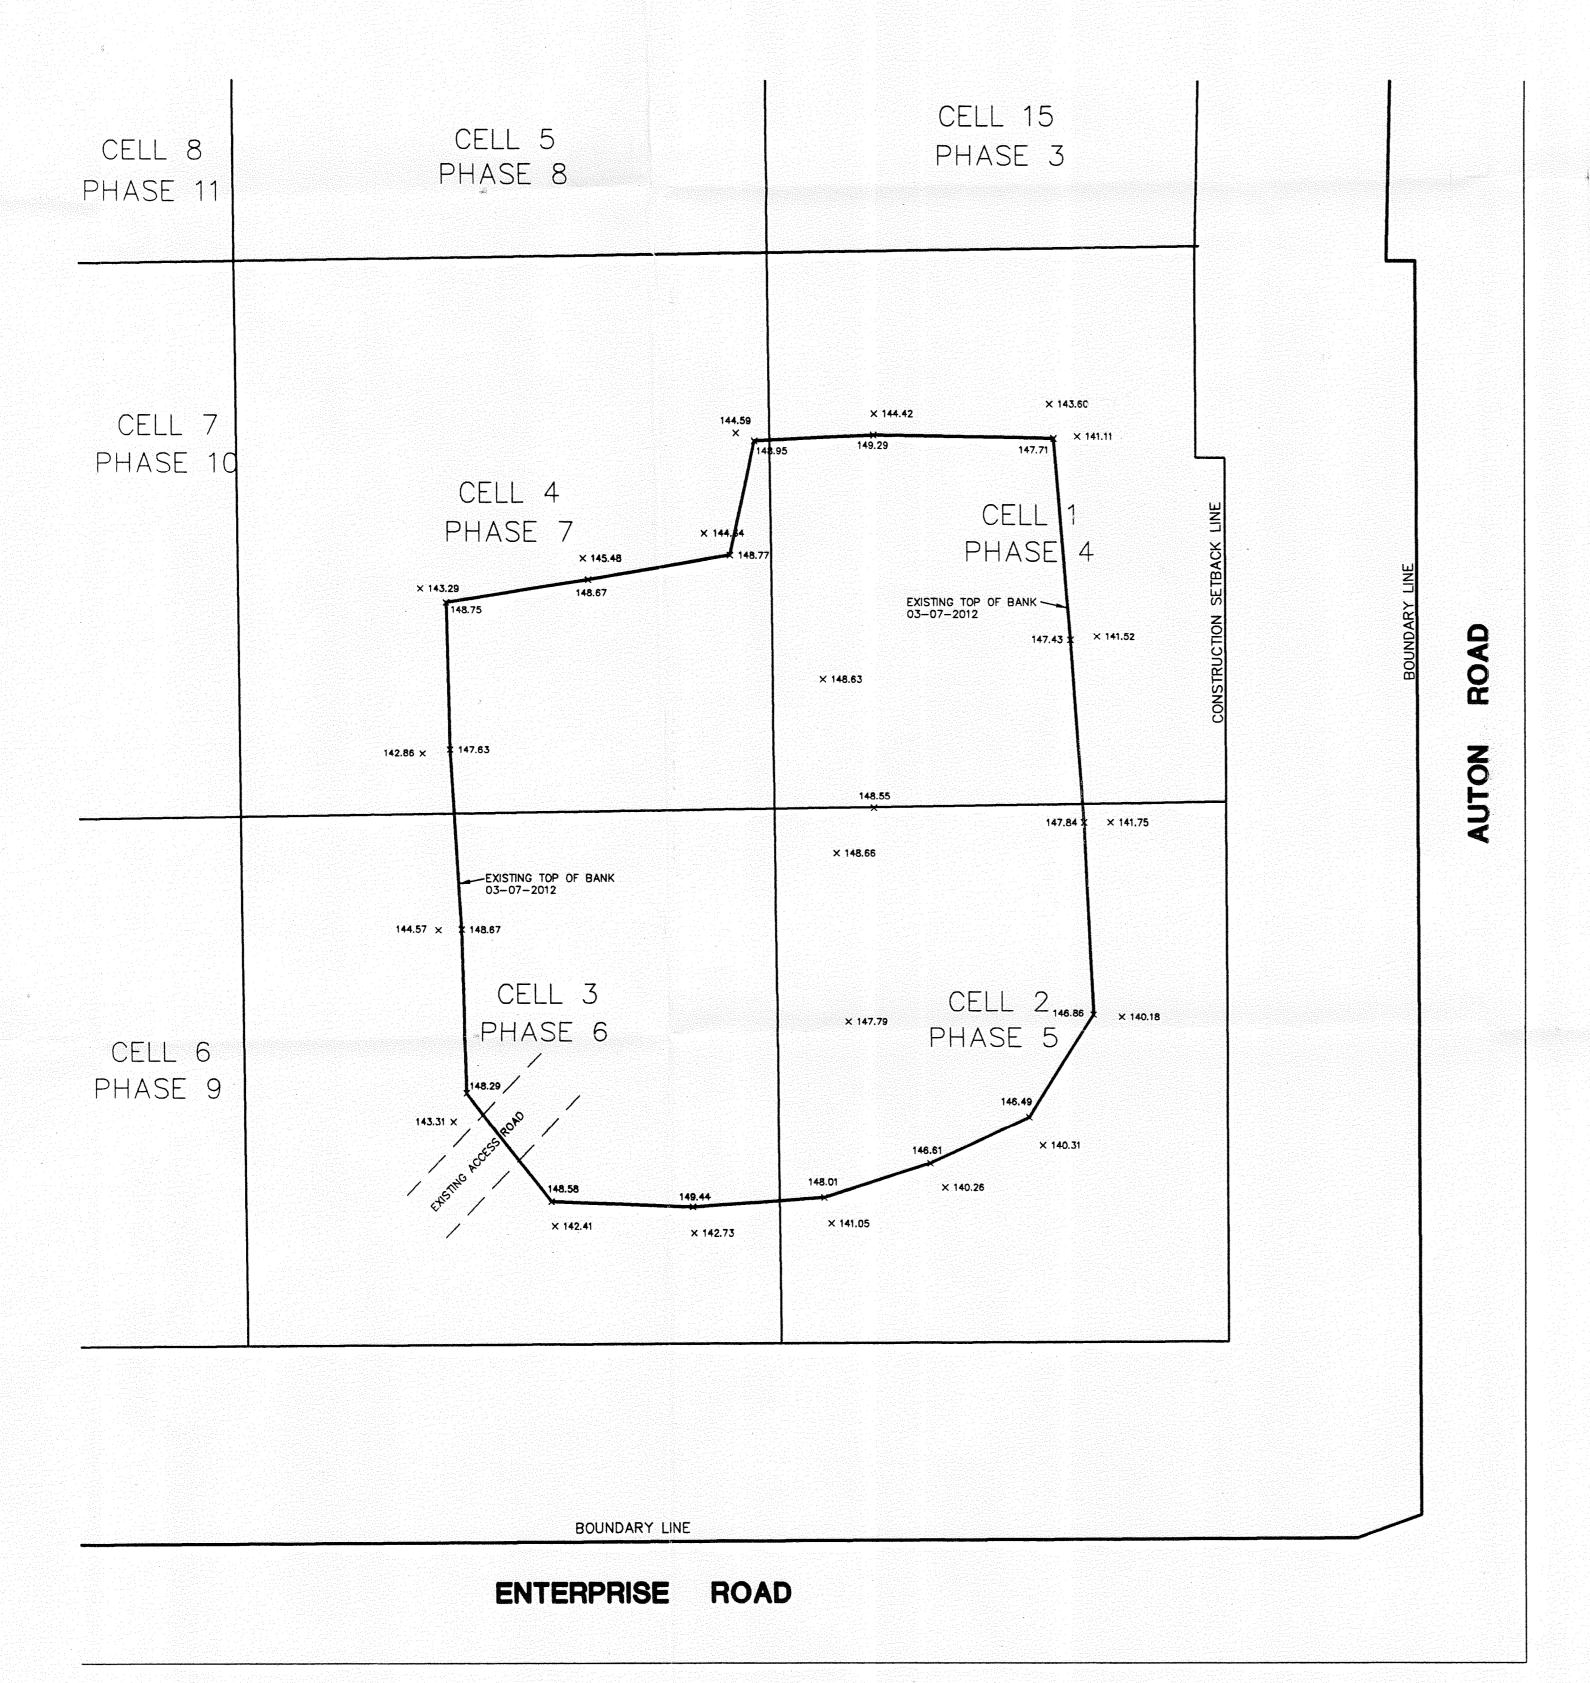


ANGELO'S RECYCLED MATERIALS ENTERPRISE ROAD FACILITIES


SECTION 8 TOWNSHIP 25 SOUTH RANGE 22 EAST PASCO COUNTY, FLORIDA

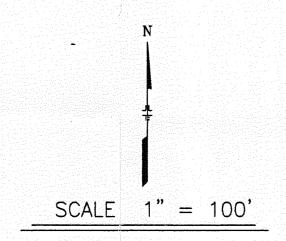


NOTES

- 1. THIS MAP REPRESENTS A SPECIFIC PURPOSE ELEVATION SURVEY.
- 2. ELEVATIONS SHOWN HEREON ARE IN FEET AND REFERENCED TO THE NATIONAL GEODETIC VERTICAL DATUM OF 1929. U.S.G.S. BENCHMARK Q-56, PUBLISHED ELEVATION = 96.273. THE SITE BENCHMARK IS LOCATED ON THE NORTH SIDE OF ENTERPRISE ROAD APPROXIMATELY 75 FEET WEST OF THE ENTRANCE TO ANGELO'S RECYCLED MATERIALS LAND FILL, BEING A 5/8" IRON ROD AND CAP NO. LB6382 IN THE CENTER OF AN AERIAL PANEL WITH AN ELEVATION OF 148.94 FEET.
- NOT VALID WITHOUT THE SIGNATURE AND THE ORIGINAL RAISED SEAL OF A FLORIDA LICENSED SURVEYOR AND MAPPER. ADDITIONS OR DELETIONS TO SURVEY MAPS OR REPORTS BY OTHER THAN THE SIGNING PARTY OR PARTIES IS PROHIBITED WITHOUT WRITTEN CONSENT OF THE SIGNING PARTY OR PARTIES.

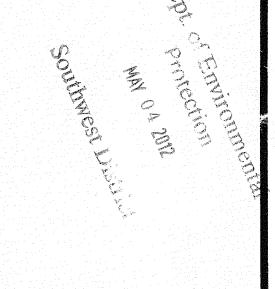

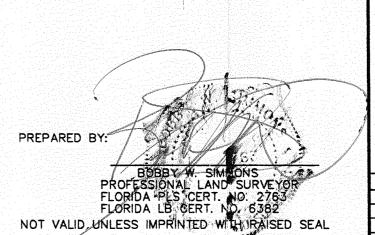

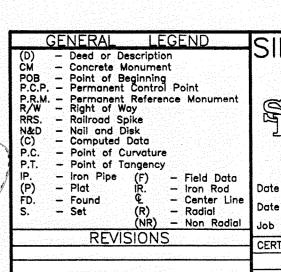

SIMMONS & BEALL, INC
SURVEYING & MAPPING

P.O. BOX 1297
36739 S.R. 52
DADE CITY, FLORIDA 33526
(352) 567 - 0048
FAX (352) 567 - 0048
FAX (352) 567 - 0675
LB NUMBER 6382

Date of Survey: 03-07-2012 Drawn by: MWB
Date of Plat: 03-07-2012 Checked by: BWS
Job Number: 06087-CELL1 ASB Sheet: ONE OF ONE
CERTIFIED TO: ANGELO'S RECYCLED MATERIALS

C\SURV\ENTERPRISE RECYCLING FACILITY\06087\06087-CELL1-TOP ASBUILT