



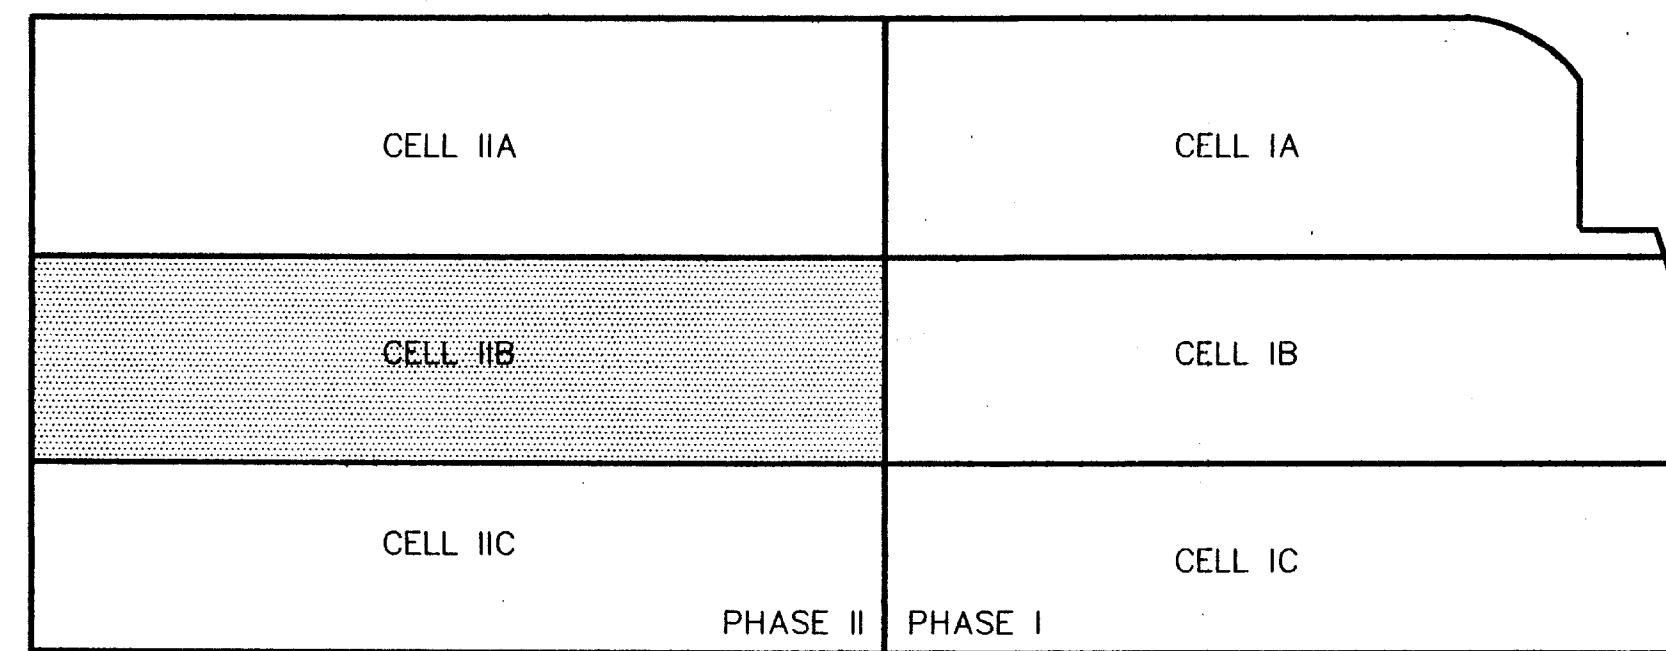


CELL LOCATION MAP
SCALE: 1" = 500'

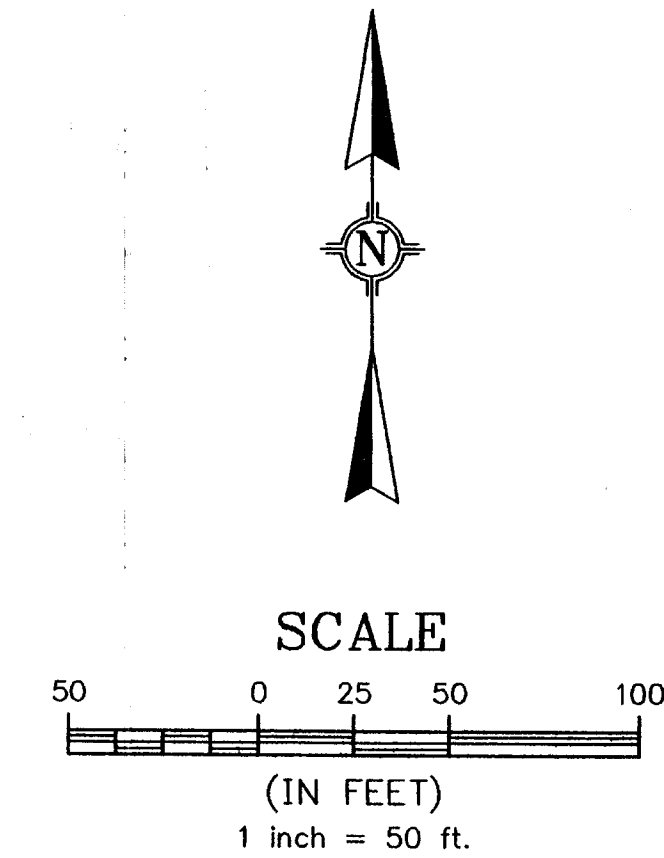

LEGEND


- S448 SECONDARY GEOMEMBRANE PANEL NUMBER
- DS S157 PASSING DESTRUCTIVE SEAM SAMPLE
- DS S154 FAILED DESTRUCTIVE SEAM SAMPLE
- ▲ EXTRUSION WELD REPAIR LOCATION
- PATCH REPAIR LOCATION
- EXTRUDED SEAM
- CAPPED SEAM (EXTRUSION SEAM)
- FUSION SEAM
- C OF ANCHOR TRENCH
- CREST OF SLOPE
- TOE OF SLOPE

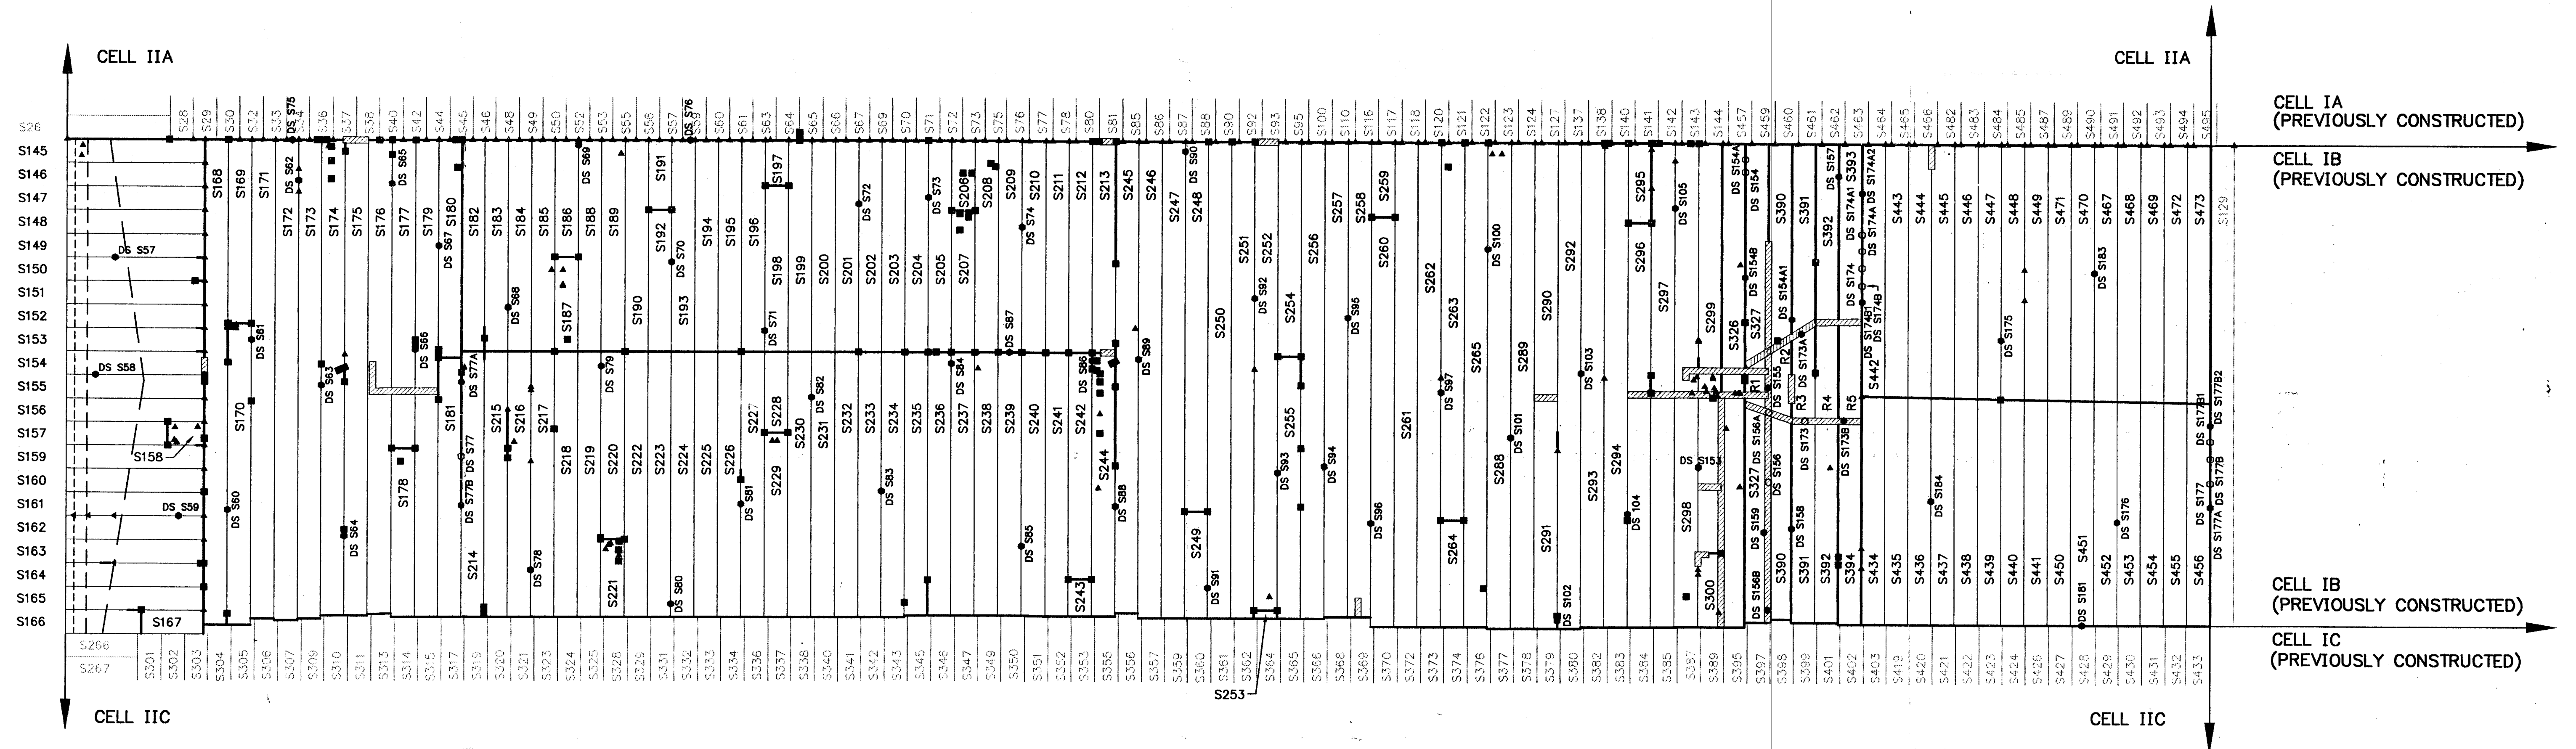


NOTE:
DS-S156 WAS ISOLATED BY DS-S156A1 AND DS-S156B WHICH WERE OBTAINED FROM TRAIL WELDS.

1 4-1-93 PER ETM'S COMMENTS		SLB	AK
DATE: 1-21-93		PROJECT NO. FQ2030 SCALE: 1"=50'	
DES BY: -		PROJECT: TRAIL RIDGE LANDFILL	
DRN BY: SLB 1-11-93		CELL IIB	
CHK BY: JPG 1-12-93		SHEET TITLE:	
REV BY: DAS 1-13-93		SECONDARY GEOMEMBRANE	
APP BY: AK 1-19-93		PANEL LAYOUT	
SHEET 5 OF 10		DRAWING NO.	
5		Trail Ridge Landfill, Inc.	


THIS RECORD DRAWING IS A GRAPHIC REPRESENTATION OF THE SECONDARY HDPE GEOMEMBRANE PANEL PLACEMENT AND DESTRUCTIVE SEAM SAMPLE LOCATIONS. FOR TRUE LENGTH OF THE HDPE GEOMEMBRANE PANELS, SEAMS, AND SAMPLE LOCATIONS, REFER TO APPENDICES OF GEOSYNTEC CONSULTANTS CQA FINAL REPORT DATED JANUARY 1993.

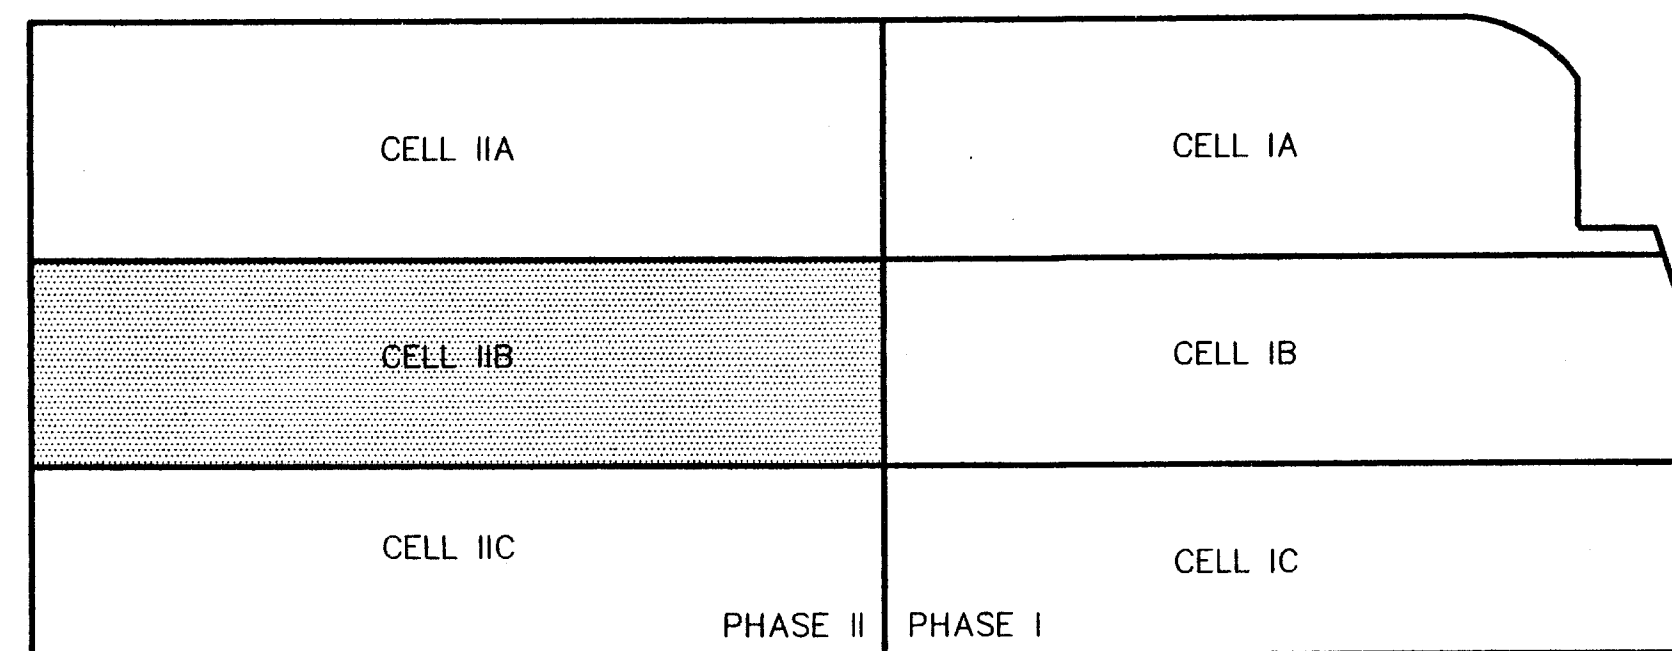

CELL LOCATION MAP
SCALE: 1" = 500'

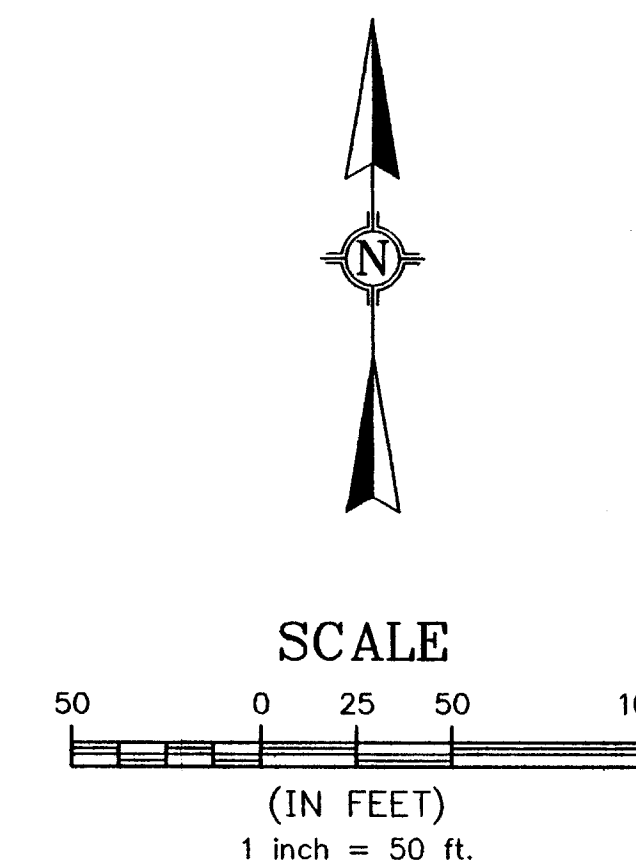

- LEGEND**
- P387 PRIMARY GEOMEMBRANE PANEL NUMBER
 - DS P165 PASSING DESTRUCTIVE SEAM SAMPLE
 - DS P167 FAILED DESTRUCTIVE SEAM SAMPLE
 - ▲ EXTRUSION WELD REPAIR LOCATION
 - PATCH REPAIR LOCATION
 - EXTRUDED SEAM
 - ▨ CAPPED SEAM (EXTRUSION SEAM)
 - FUSION SEAM
 - C OF ANCHOR TRENCH
 - CREST OF SLOPE
 - TOE OF SLOPE
 - LEACHATE CONTROL FLAP

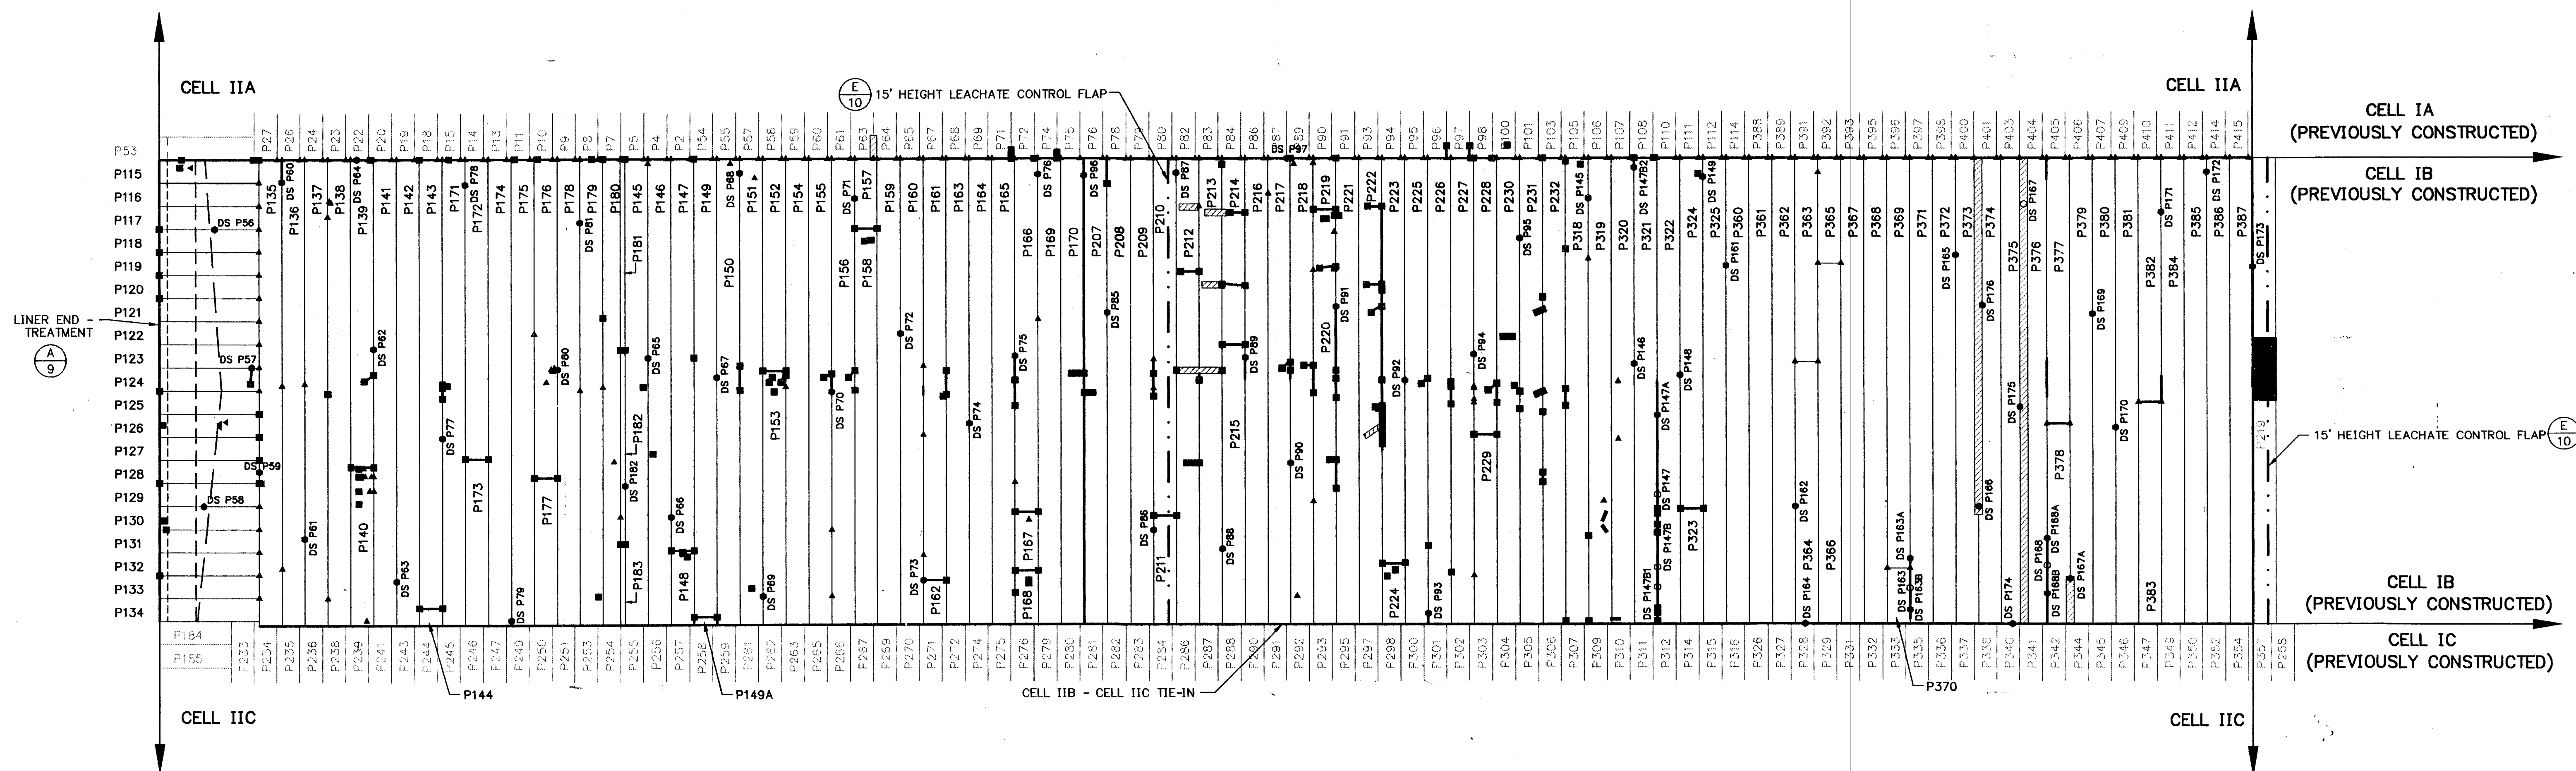

THIS RECORD DRAWING IS A GRAPHIC REPRESENTATION OF THE PRIMARY HDPE GEOMEMBRANE PANEL PLACEMENT AND DESTRUCTIVE SEAM SAMPLE LOCATIONS. FOR TRUE LENGTH OF THE HDPE GEOMEMBRANE PANELS, SEAMS, AND SAMPLE LOCATIONS, REFER TO APPENDICES OF GEOSYNTEC CONSULTANTS COA FINAL REPORT DATED JANUARY 1993.

 Boca Raton, Florida 1 April 1993 DATE		1 4-1-93 PER ETM'S COMMENTS SLB AK	
REV.	DATE	DESCRIPTION	DRN BY APP BY
DATE	1-21-93	PROJECT NO. FQ2030	SCALE: 1"=50'
DES BY	SLB	PROJECT:	TRAIL RIDGE LANDFILL
CHK BY	JPG	SHEET TITLE:	CELL IIB
REV BY	DAS	PRIMARY GEOMEMBRANE PANEL LAYOUT	
APP BY	AK	1-19-93	
		SHEET 6 OF 10 DRAWING NO. 6	