

ENGINEERING PLANNING

April 3, 1996

Ms. Susan J. Pelz
Solid Waste Section
Division of Waste Management
Department of Environmental Protection
Southwest District
3804 Coconut Palm Drive
Tampa, Florida 33619

REGUVED APR - 5 1996

Departi CaroninemarProtection SOUTHWEST DISTRICT av

40612 4005030001

RE: Hardee County Landfill

Pending Modification #286397 to Permit No. S025-214306

Dear Ms. Pelz:

Thank you for your review and comments concerning the above referenced permit modification for Hardee County. In response to your letter of March 22, 1996 (included in attachment A), the following comments are provided. Your questions are indicated in bold type followed by our response.

1. Please provide an estimated schedule for filling the sequences shown in the drawings submitted. Please provide an estimated schedule for the implementation of the cover/leachate minimization plan, including placement of sod and additional soil.

It has been determined that the Hardee County Landfill has a remaining capacity of approximately 267,600 cy (excluding final cover) as of September 1995. It is estimated that Hardee County Landfill will reach its final capacity in approximately 9 years based on a bale density of 1750 lbs./bale and an assumed intermediate cover volume of 10% of the waste volume. Based on the sequencing plan provided on Sheet 2 of the drawings, the estimated schedule for filling the sequences is as follows:

Sequence	Volume Available (cy)	Begin Filling Sequence
1	5,400	Upon FDEP approval
2	16,500	3 months after beginning Sequence 1
3	26,200	9 months after beginning Sequence 2
4	85,200	12 months after beginning Sequence 3
5	57,000	27 months after beginning Sequence 4
6	77,300	25 months after beginning Sequence 5



Department of Environmental Protection

Lawton Chiles Governor Southwest District 3804 Coconut Palm Drive Tampa, Florida 33619

Virginia B. Wetherell Secretary

Mr. J.R. Prestridge, County Manager Hardee County Department of Solid Waste P.O. Box 246 Wauchula, FL 33873

March 22, 1996

RE: Hardee County Landfill
Pending Modification #286397 to Permit

Pending Modification #286397 to Permit No. SO25-214306

Dear Mr. Prestridge:

This is to acknowledge receipt of your request to modify the existing operation permit for the solid waste management facility, referred to as the Hardee County Landfill. This letter constitutes notice that a permit will be required for your project pursuant to Chapter(s) 403, Florida Statutes. Your application for a permit modification is incomplete. Please provide the information listed below promptly. Evaluation of your proposed project will be delayed until all requested information has been received.

The following information is needed in support of the solid waste application [Chapter 62-701, Florida Administrative Code (F.A.C.)]:

- Please provide an estimated schedule for filling the sequences shown in the drawings submitted. Please provide an estimated schedule for the implementation of the cover/leachate minimization plan, including placement of sod and additional soil.
- 2. It appears that Section D on Sheet 1 should be referenced back to Sheet 2 where the location of the section is shown. Please note the location of the silt fence detail on Sheet 2.
- 3. Please clarify if the area is graded to drain to stormwater and sodded "when the working area in [a] sequence... is reduced to [the size noted on the plans]...." and the next sequence begins.
- 4. How often will the silt screens be checked and cleaned?

NOTICE! Pursuant to the provisions of Section 120.60, F.S. and Chapter 62-4.070(5), F.A.C., if the Department does not receive a complete response to this request for information within 30 days of the date of this letter, the Department may issue a final order denying your application. You need to respond within 30 days after the date of this letter, responding to all of the information requests.

You are requested to submit your response to this letter together, as one complete package. If there are points which must be discussed and resolved, please contact me at (813) 744-6100 ext. 386.

Sincerely,

Susan J. Pelz, E.I. Solid Waste Section

Division of Waste Management

вjр

C. Edward Hilton, P.E., PBSJ, 1560 Orange Ave., Ste. 700, Winter Park, Fl. 32789
Steve Morgan, FDEP Tampa

"Protect, Conserve and Manage Florida's Environment and Natural Resources"

Ms. Susan J. Pelz April 3, 1996 Page 2

> Sequence 6 is expected to reach capacity approximately 32 months after filling this sequence begins.

> Upon receiving approval for this permit modification from the FDEP, the County will initiate the cover/leachate minimization plan immediately.

It appears that Section D on Sheet 1 should be referenced back to Sheet 2 where the location of the section is shown. Please note the location of the silt fence detail on Sheet 2.

Section D on Sheet 1 was inadvertently referenced back to its own sheet. The detail title target has been revised so that Section D references Sheet 2.

On Sheet 2, a detail label for the silt fence, referencing Sheet 1, has been added to each of the sequences noting their locations.

Please clarify if the area is graded to drain to stormwater and sodded "when the working area in [a] sequence...is reduced to [the size noted on the plans]...and the next sequence begins.

Filled areas will be closed by placing and grading 12-inches of cover material to drain the rainfall to the existing stormwater management system and placing sod as the next sequence begins operation. The information has been clarified on the sequencing descriptions for the proposed stormwater design presented on Sheet 1 of the drawings.

How often will the silt screens be checked and cleaned?

The silt screens will be checked each work day and cleaned or replaced as necessary.

If you have any questions or comments regarding this response, please do not hesitate to call.

Sincerely,

C. Rdward Hibry C. Edward Hilton, Jr., P.E.


Program Manager Solid Waste Program

J.R. Prestridge, Hardee County Bill Telford, PBS&J Maureen Mauriello, PBS&J

H:\ENV\WASTEMAN\HARDEE\LE0329-1.MM

Chall Edward Hild 5

ATTACHMENT A

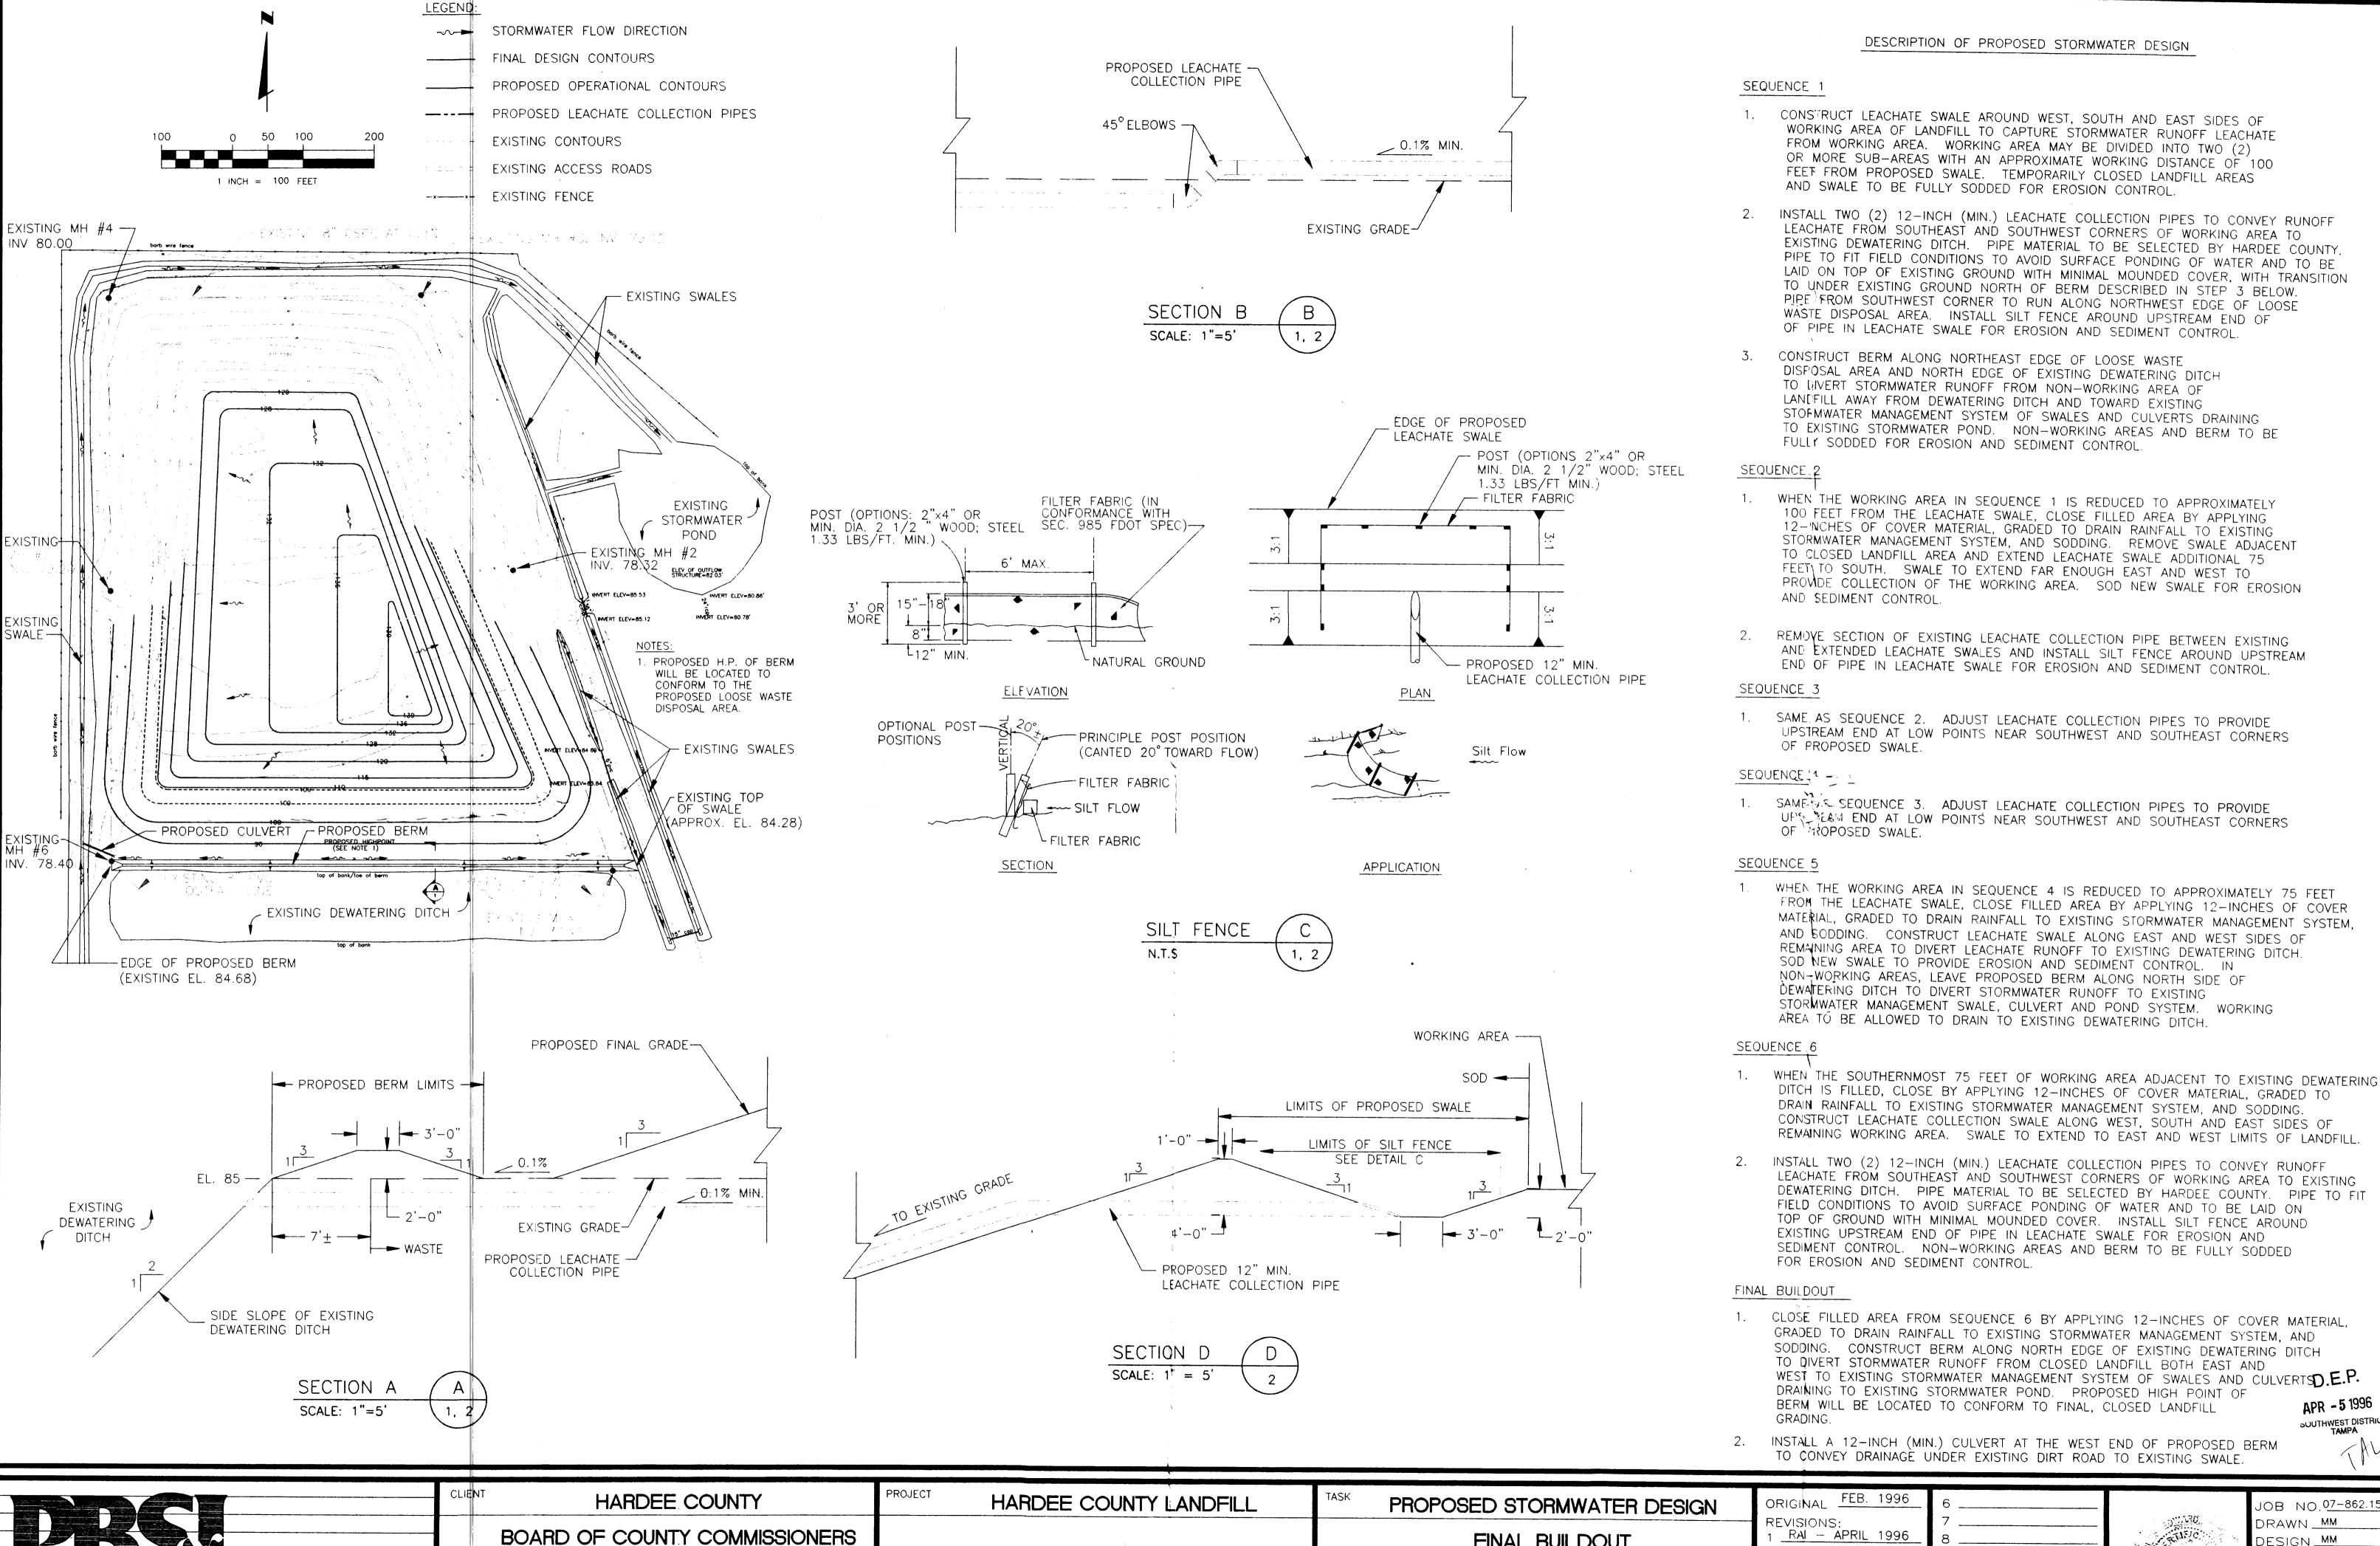

OST, BUCKLEY, SCHUH & JERNIGAN, IN

FINAL BUILDOUT AND

DETAILS


1 RAI - APRIL 1996


how Blood She

JOB NO.07-862.15 DRAWN _MM_ DESIGN MM CHECKED BT Q.C. EH

APR - 5 1996

SOUTHWEST DISTRICT

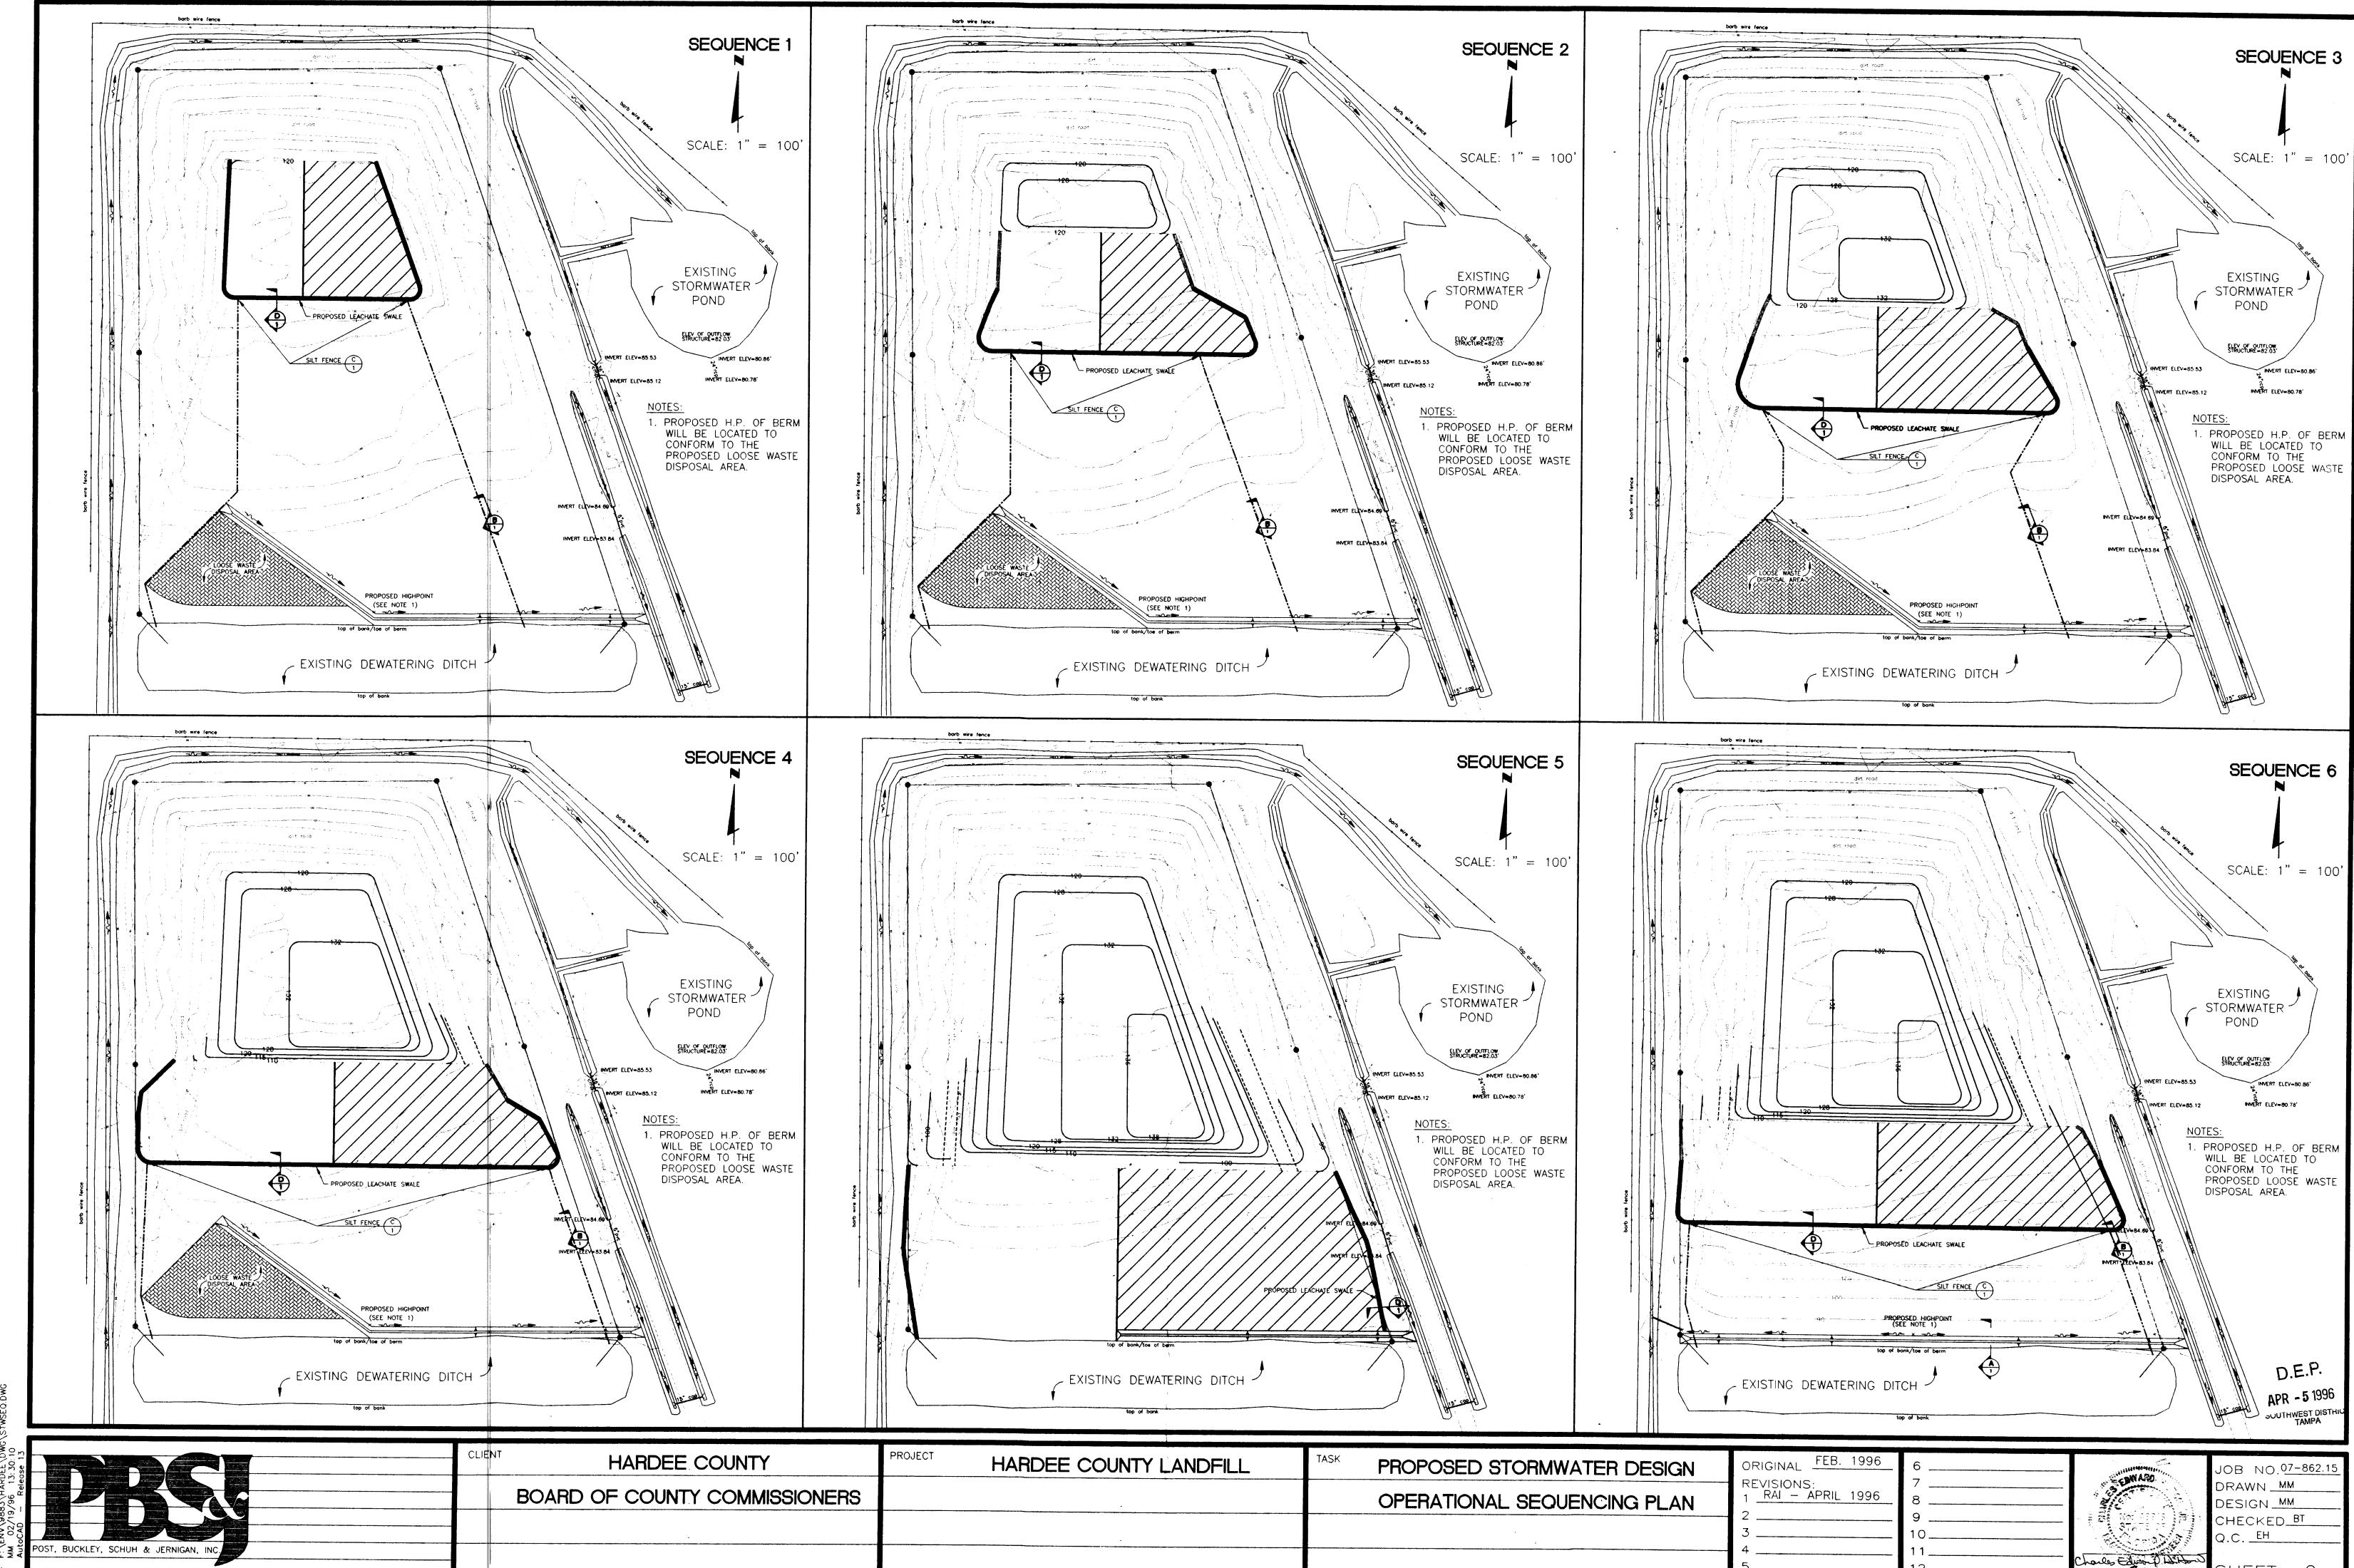

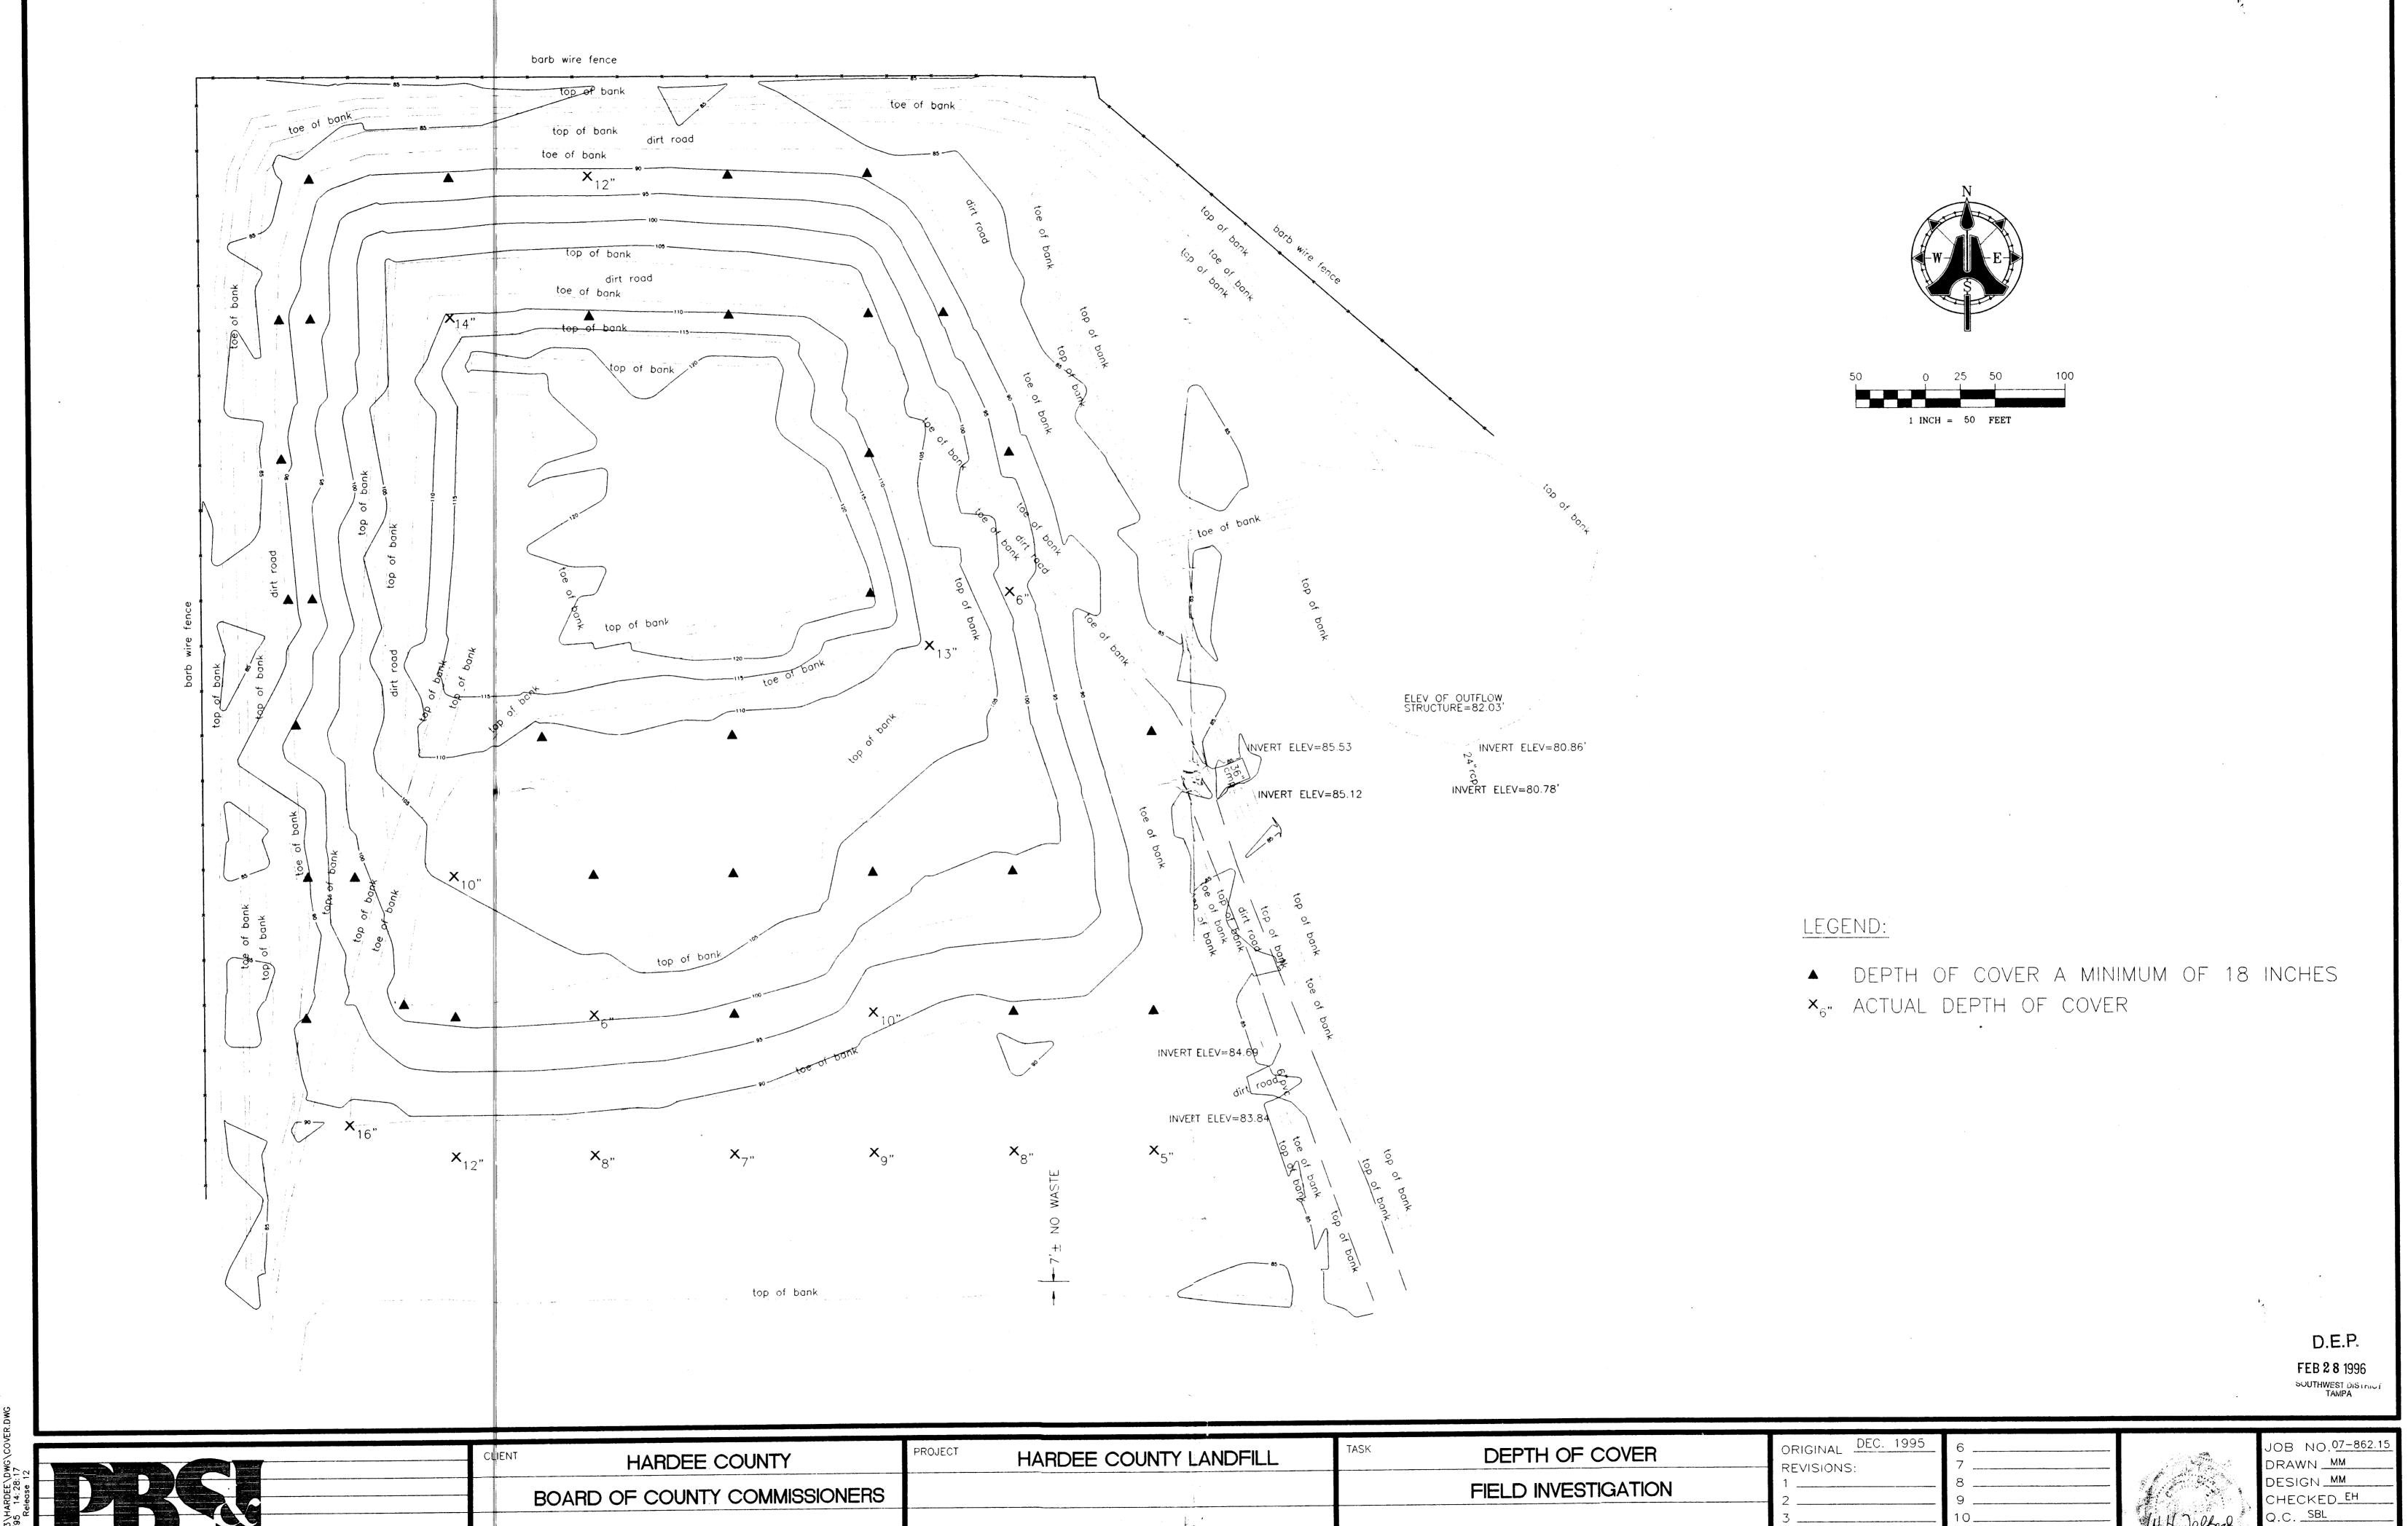

POST, BUCKLEY, SCHUH & JERNIGAN, INC.

