



“AS - BUILTS” OF TRAIL RIDGE LANDFILL PHASES I, II AND IIIA FOR TRAIL RIDGE LANDFILL, INC. AND CITY OF JACKSONVILLE, FLORIDA

WACS# 33628

CL1

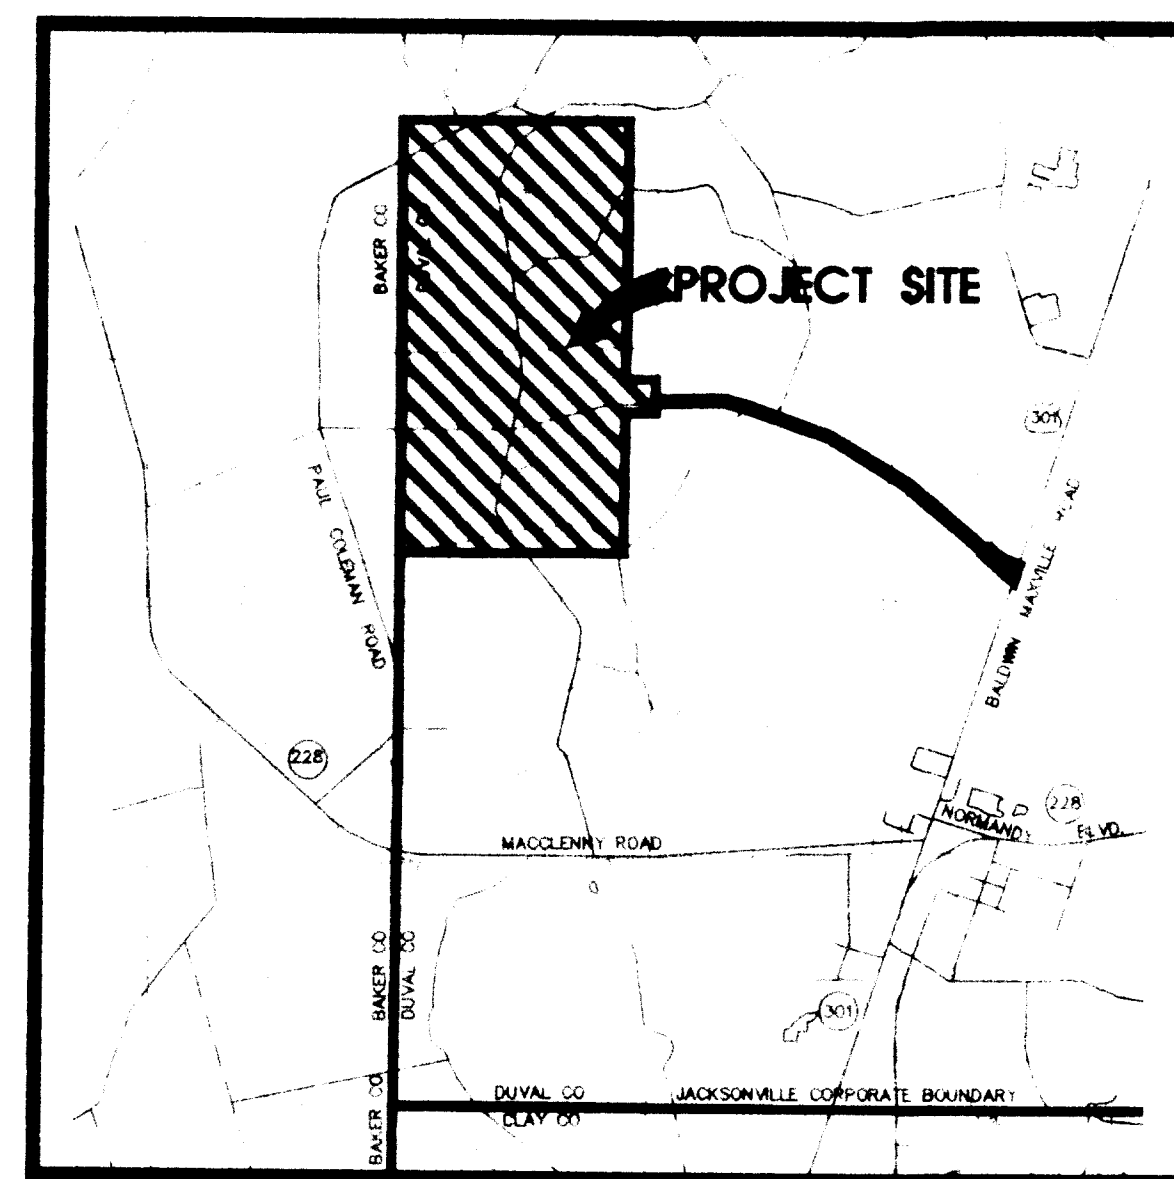

VICINITY MAP
SCALE: 1" = 4000'

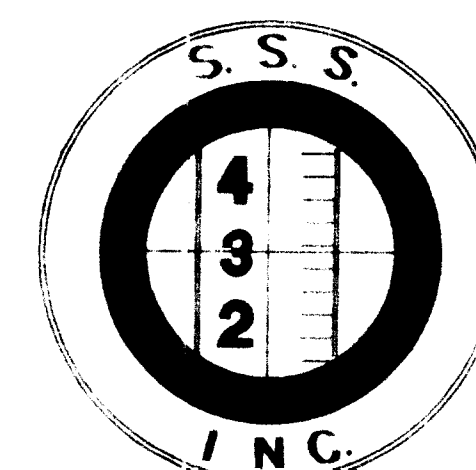

SUNSHINE STATE SURVEYORS INC.


SURVEYORS & LAND PLANNERS 3131 ST. JOHNS BLUFF RD. SOUTH
JACKSONVILLE, FLORIDA 32216
(904) 642-8550

UPDATED: SEPTEMBER, 1995
UPDATED: JANUARY, 1993
UPDATED: DECEMBER, 1992
DATE: SEPTEMBER, 1992

INDEX OF DRAWINGS




SHEET NO.	DESCRIPTION
COVER SHEET NUMBER 1	COVER SHEET
GROUNDWATER WELLS	
GW-1	GROUNDWATER MONITORING WELLS
LINER SYSTEM	
LS-1	LINER SYSTEM - PHASES I AND II
LS-2	LINER SYSTEM - PHASES I AND II
LS-3	LINER SYSTEM - PHASES I AND II
LS-4	LINER SYSTEM - PHASE IIIA
LS-5	LINER SYSTEM - PHASE IIIA
LEACHATE SYSTEM	
LE-1	LEACHATE FORCE MAIN
LE-2	LEACHATE FORCE MAIN
ELECTRICAL SYSTEM	
E-1	ELECTRICAL SYSTEM
E-2	ELECTRICAL SYSTEM
DRAINAGE PLANS	
D-1	DRAINAGE STRUCTURE AND SPREADER PIPE DATA SHEET
D-2	PHASES I AND II DRAINAGE STRUCTURES
D-3	DETENTION LAKE
D-4	FILTER BED AREA
D-5	DRAINAGE STRUCTURES - PHASE IIIA
D-6	DRAINAGE STRUCTURE TABLE - PHASE IIIA
ANCILLARY FACILITIES	
A-1	ANCILLARY AREA FORCE MAIN, WATER MAIN AND STORM DRAINAGE
A-2	ANCILLARY AREA FORCE MAIN, WATER MAIN AND STORM DRAINAGE
ENTRANCE ROAD	
ER-1	ENTRANCE ROAD STORM DRAINAGE
ER-2	ENTRANCE ROAD STORM DRAINAGE
ER-3	ENTRANCE ROAD STORM DRAINAGE
ER-4	ENTRANCE ROAD STORM DRAINAGE
ER-5	ENTRANCE ROAD STORM DRAINAGE
ER-6	ENTRANCE ROAD STORM DRAINAGE
ER-7	ENTRANCE ROAD STORM DRAINAGE
FIRE PUMP	
P-1	CLASS I FIRE PUMP / HYDROTANK STORMWATER
WATER TREATMENT FACILITIES	
WT-1	WATER TREATMENT FACILITY
WT-2	WATER TREATMENT FACILITY
WT-3	WATER TREATMENT FACILITY
WT-4	WATER TREATMENT PLANT
ANCILLARY FACILITIES BUILDINGS	
201-711	ANCILLARY FACILITIES BUILDINGS PROVIDED BY THE HASKELL COMPANY
L-1 THRU L-4	ANCILLARY FACILITIES BUILDINGS PROVIDED BY THE HASKELL COMPANY

Sunshine State Surveyors, Inc.
OCT - 2 1995

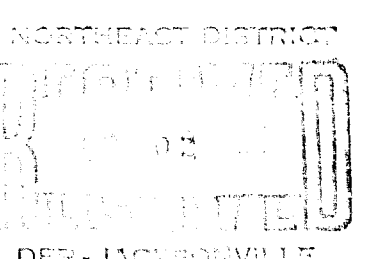

K:\ENGINEER\JAN14\2005\AS-BUILT\LS-5.dwg 1/19/05 10:20:00

SECTION 24
SECTION 13
BAKER COUNTY
DUVAL COUNTY
PROPERTY BOUNDARY

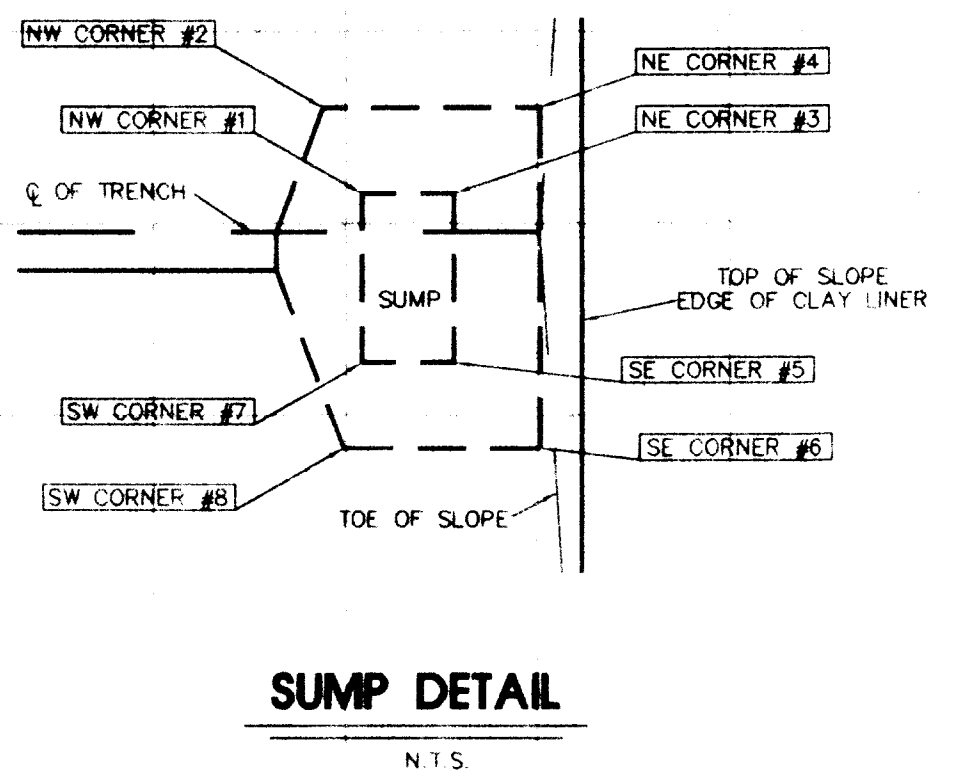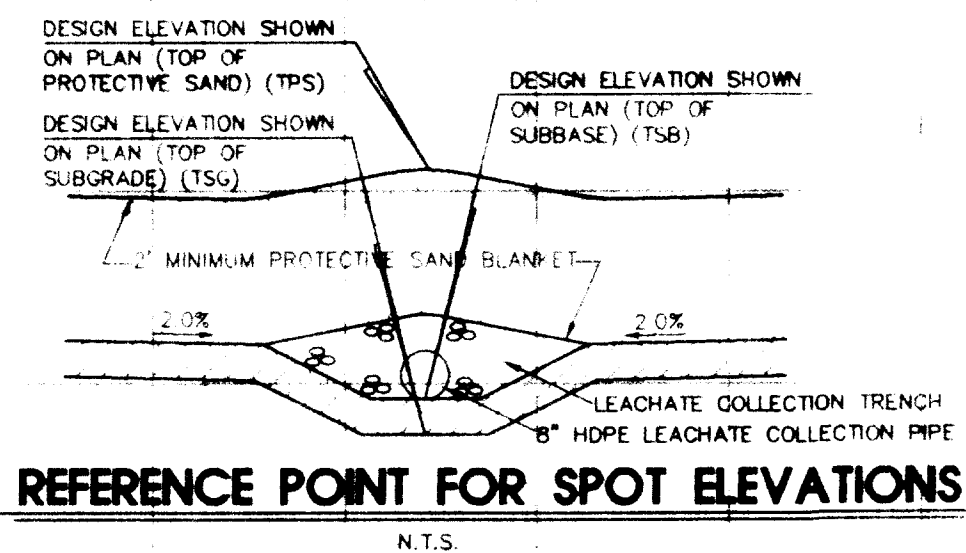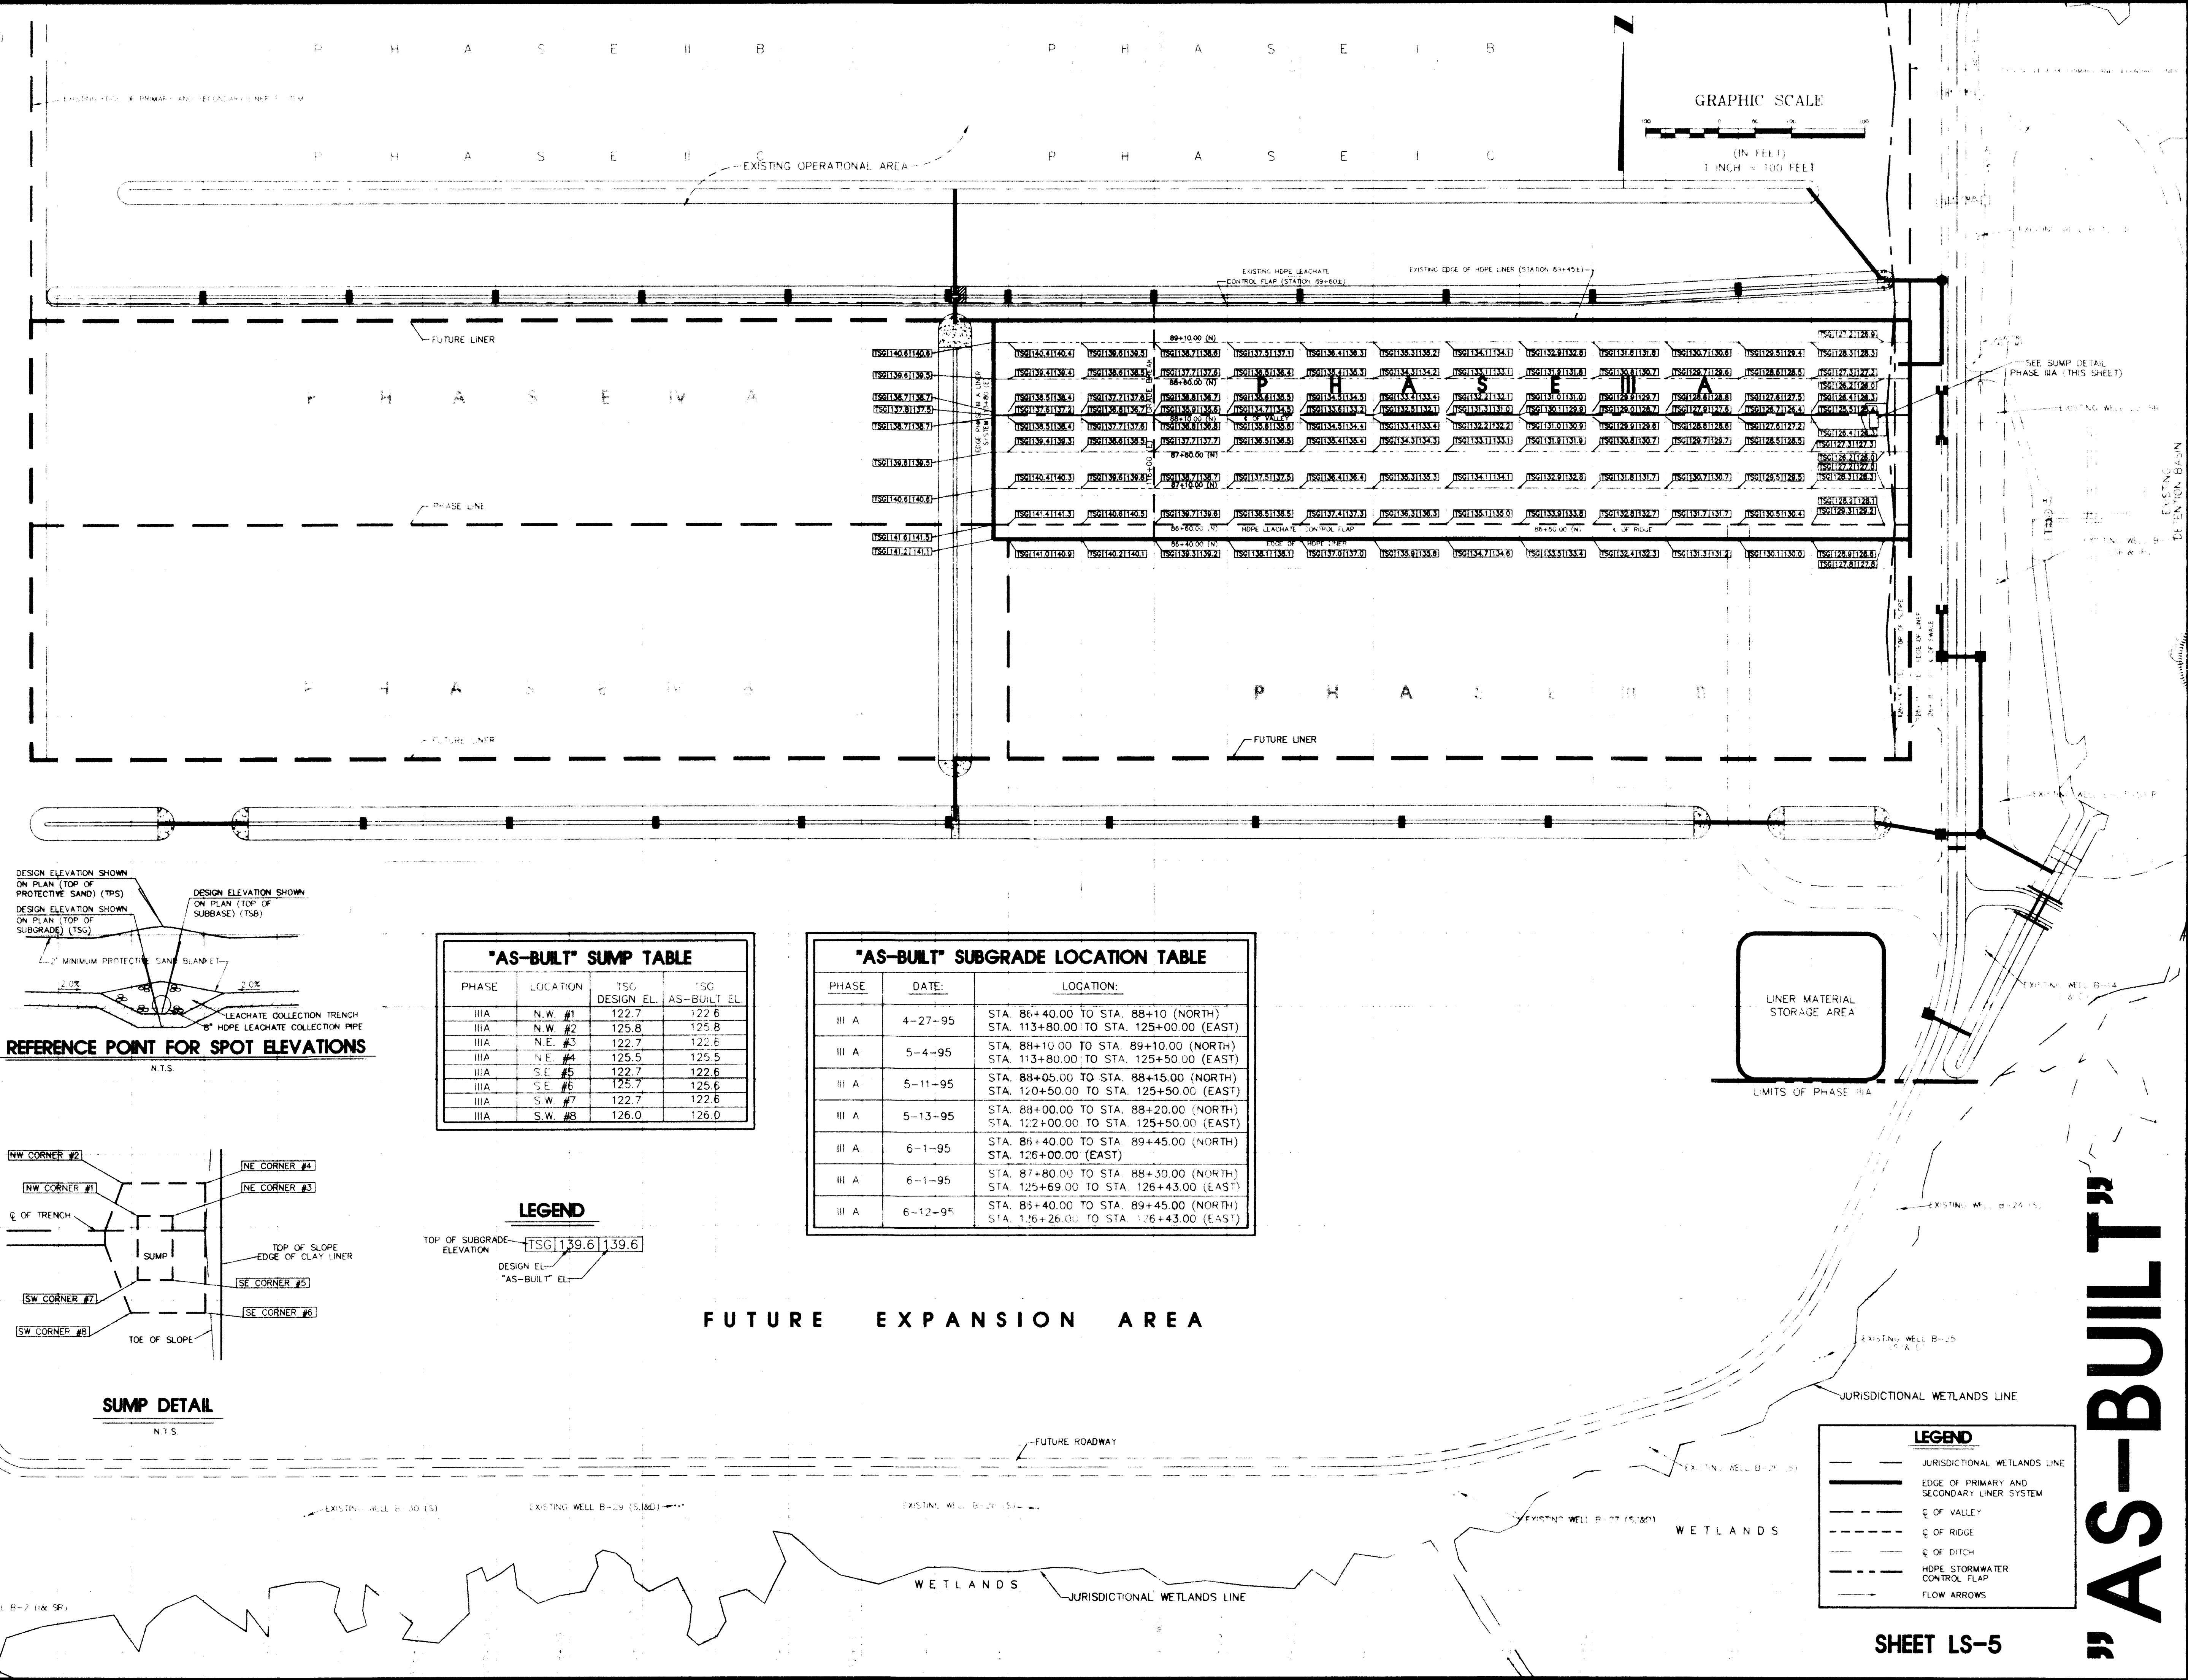

"AS-BUILT" SUMP TABLE				
PHASE	LOCATION	TSG DESIGN EL.	TSG AS-BUILT EL.	
III A	N.W. #1	122.7	122.6	
III A	N.W. #2	125.8	125.8	
III A	N.E. #3	122.7	122.6	
III A	N.E. #4	125.5	125.5	
III A	S.E. #5	122.7	122.6	
III A	S.E. #6	125.7	125.6	
III A	S.W. #7	122.7	122.6	
III A	S.W. #8	126.0	126.0	

LEGEND	
TOP OF SUBGRADE ELEVATION	TSG 139.6 139.6
DESIGN EL.	
"AS-BUILT" EL.	

"AS-BUILT" SUBGRADE LOCATION TABLE		
PHASE	DATE	LOCATION
III A	4-27-95	STA. 86+40.00 TO STA. 88+10.00 (NORTH) STA. 113+80.00 TO STA. 125+00.00 (EAST)
III A	5-4-95	STA. 88+10.00 TO STA. 89+10.00 (NORTH) STA. 113+80.00 TO STA. 125+50.00 (EAST)
III A	5-11-95	STA. 88+05.00 TO STA. 88+15.00 (NORTH) STA. 120+50.00 TO STA. 125+50.00 (EAST)
III A	5-13-95	STA. 88+00.00 TO STA. 88+20.00 (NORTH) STA. 122+00.00 TO STA. 125+50.00 (EAST)
III A	6-1-95	STA. 86+40.00 TO STA. 89+45.00 (NORTH) STA. 126+00.00 (EAST)
III A	6-1-95	STA. 87+80.00 TO STA. 88+30.00 (NORTH) STA. 125+69.00 TO STA. 126+43.00 (EAST)
III A	6-12-95	STA. 83+40.00 TO STA. 89+45.00 (NORTH) STA. 126+26.00 TO STA. 126+43.00 (EAST)

FUTURE EXPANSION AREA

LEGEND	
---	JURISDICTIONAL WETLANDS LINE
---	EDGE OF PRIMARY AND SECONDARY LINER SYSTEM
---	Q OF VALLEY
---	Q OF RIDGE
---	Q OF DITCH
---	HOPE STORMWATER CONTROL FLAP
---	FLOW ARROWS

SHEET LS-5

RECORD
ORDER NO.
CADD FILE NO.
DRAWN BY
CHECKED BY
SCALE
RANGE
COUNTY
FIELD #
FILE #

SUNSHINE STATE
SURVEYORS, INC.
SUNSHINE STATE SURVEYORS, INC.
3131 ST. JOHN BLVD. S.W.
JACKSONVILLE, FLORIDA 32244
PHONE NUMBER (904) 642-1850
FAX NUMBER (904) 642-1840

LINER SYSTEM
PHASE IIIA
FOR TRAIL RIDGE LANDFILL, INC. AND
CITY OF JACKSONVILLE, FLORIDA




APPROVED FOR THE MUNICIPAL ENGINEER
APPROVED FOR THE FLORIDA ADMINISTRATIVE
CODE AND ANNOTATED WITH
FLORIDA STATUTES
DATE 01/19/05 BY [Signature]
K. A. WATSON, P.E., F.L.S. 12476, F.L.S. 12476, F.L.S. 12476

IMAGE QUALITY

AS YOU VIEW THE NEXT PAGE(S), PLEASE
NOTE THAT THE ORIGINAL DOCUMENT
WAS OF POOR QUALITY

K:\ENGINEER\QUANTILAND AS-BUILT.dwg Plot Date: 03/22/2016 15:56

SECTION 24
SECTION 19
BAKER COUNTY
DUVAL COUNTY
PROPERTY BOUNDARY

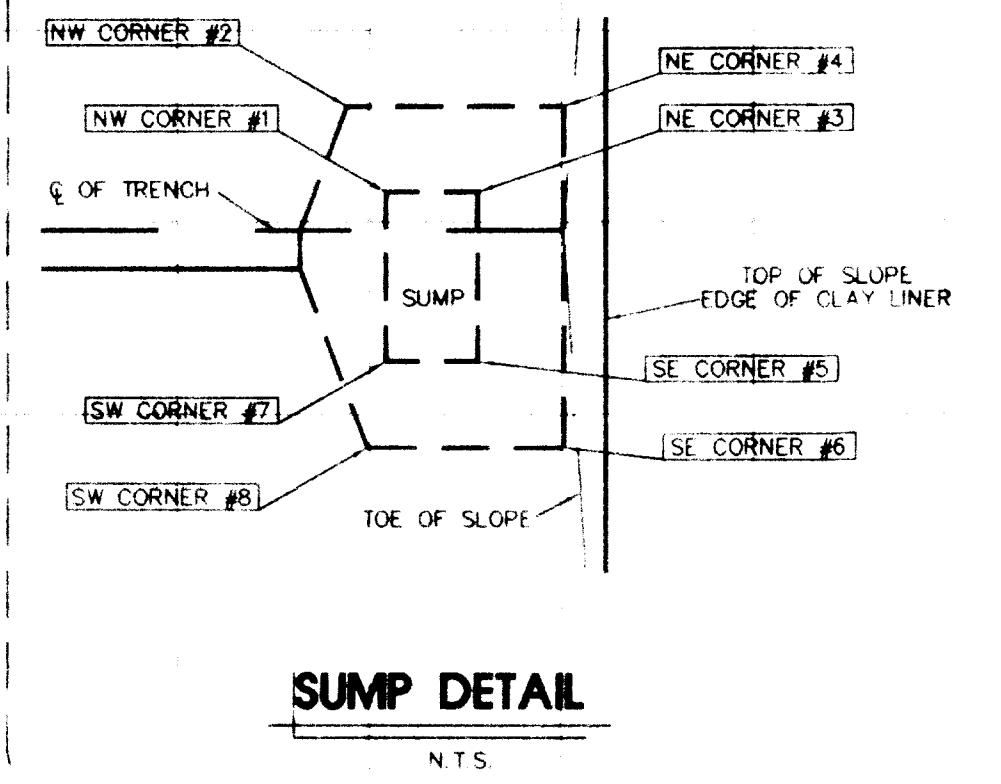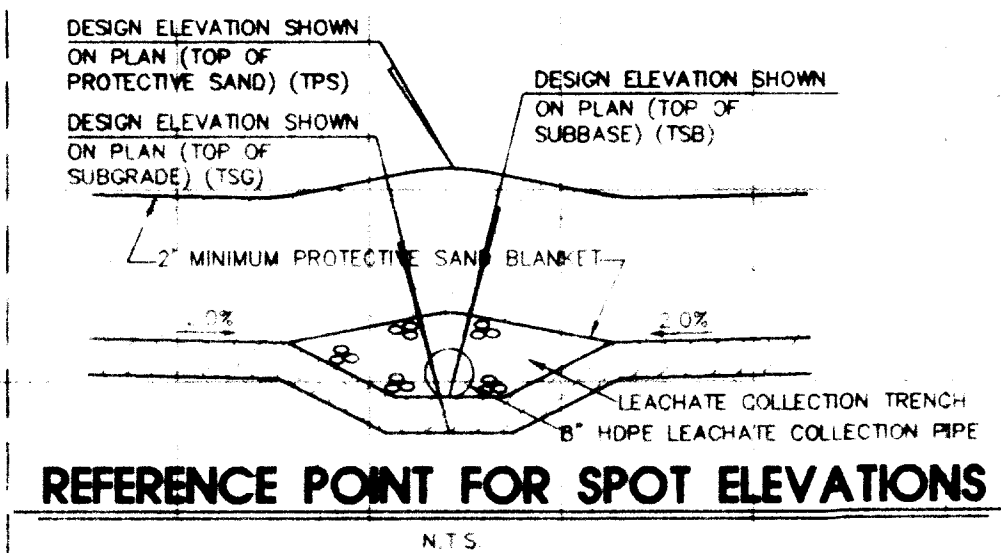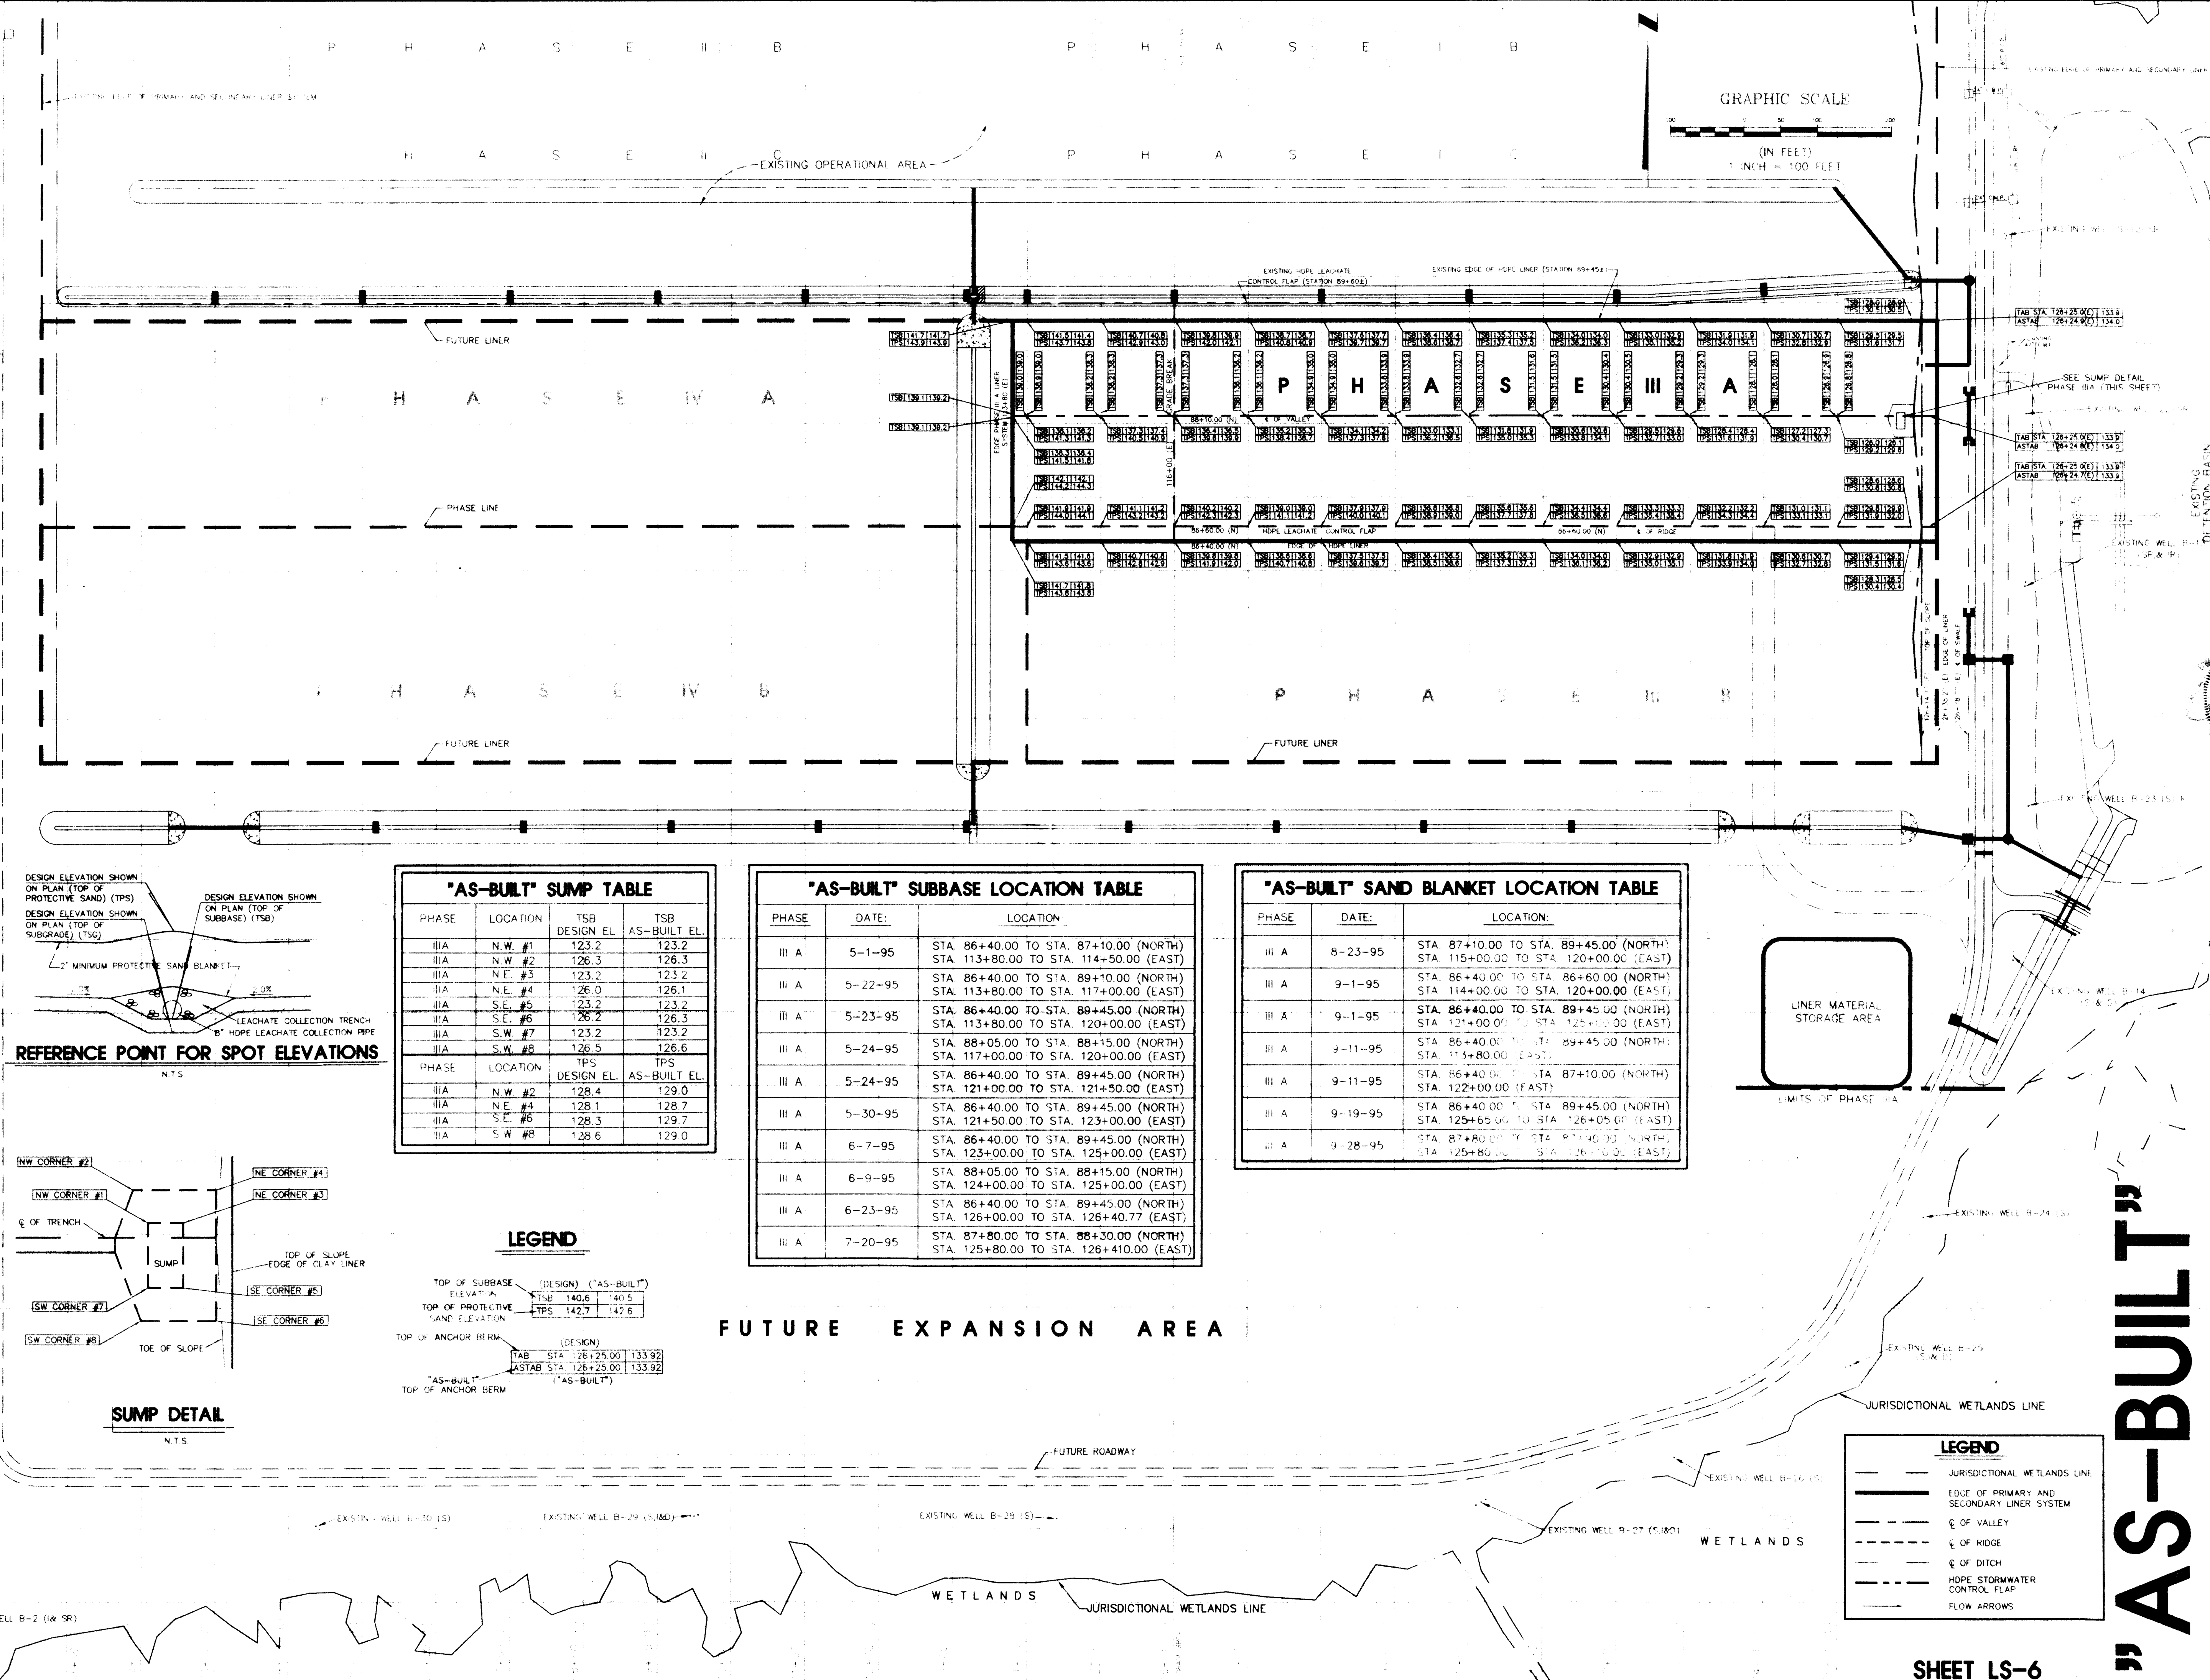

"AS-BUILT" SUMP TABLE				
PHASE	LOCATION	TSB DESIGN EL.	TSB AS-BUILT EL.	
IIIA	N.W. #1	123.2	123.2	
IIIA	N.W. #2	126.3	126.3	
IIIA	N.E. #3	123.2	123.2	
IIIA	N.E. #4	126.0	126.1	
IIIA	S.E. #5	123.2	123.2	
IIIA	S.E. #6	126.2	126.3	
IIIA	S.W. #7	123.2	123.2	
IIIA	S.W. #8	126.5	126.6	
PHASE	LOCATION	TPS DESIGN EL.	TPS AS-BUILT EL.	
IIIA	N.W. #2	128.4	129.0	
IIIA	N.E. #4	128.1	128.7	
IIIA	S.E. #6	128.3	129.7	
IIIA	S.W. #8	128.6	129.0	

LEGEND				
TOP OF SUBBASE ELEVATION (DESIGN) ("AS-BUILT")	TSB	140.6	140.5	
TOP OF PROTECTIVE SAND ELEVATION	TPS	142.7	142.6	
TOP OF ANCHOR BERM (DESIGN) ("AS-BUILT")	TAB	STA. 126+25.00	133.92	
	ASTAB	STA. 126+25.00	133.92	

"AS-BUILT" SUBBASE LOCATION TABLE			
PHASE	DATE	LOCATION	
III A	5-1-95	STA. 86+40.00 TO STA. 87+10.00 (NORTH)	
III A	5-1-95	STA. 113+80.00 TO STA. 114+50.00 (EAST)	
III A	5-22-95	STA. 86+40.00 TO STA. 89+10.00 (NORTH)	
III A	5-22-95	STA. 113+80.00 TO STA. 120+00.00 (EAST)	
III A	5-23-95	STA. 86+40.00 TO STA. 88+45.00 (NORTH)	
III A	5-23-95	STA. 113+80.00 TO STA. 120+00.00 (EAST)	
III A	5-24-95	STA. 88+05.00 TO STA. 88+15.00 (NORTH)	
III A	5-24-95	STA. 121+00.00 TO STA. 121+50.00 (EAST)	
III A	5-30-95	STA. 86+40.00 TO STA. 89+45.00 (NORTH)	
III A	5-30-95	STA. 121+50.00 TO STA. 123+00.00 (EAST)	
III A	6-7-95	STA. 86+40.00 TO STA. 89+45.00 (NORTH)	
III A	6-7-95	STA. 123+00.00 TO STA. 125+00.00 (EAST)	
III A	6-9-95	STA. 88+05.00 TO STA. 88+15.00 (NORTH)	
III A	6-9-95	STA. 124+00.00 TO STA. 125+00.00 (EAST)	
III A	6-23-95	STA. 86+40.00 TO STA. 89+45.00 (NORTH)	
III A	6-23-95	STA. 126+00.00 TO STA. 126+40.77 (EAST)	
III A	7-20-95	STA. 87+80.00 TO STA. 88+30.00 (NORTH)	
III A	7-20-95	STA. 125+80.00 TO STA. 126+410.00 (EAST)	

"AS-BUILT" SAND BLANKET LOCATION TABLE			
PHASE	DATE	LOCATION	
III A	8-23-95	STA. 87+10.00 TO STA. 89+45.00 (NORTH)	
III A	8-23-95	STA. 115+00.00 TO STA. 120+00.00 (EAST)	
III A	9-1-95	STA. 86+40.00 TO STA. 86+60.00 (NORTH)	
III A	9-1-95	STA. 114+00.00 TO STA. 120+00.00 (EAST)	
III A	9-1-95	STA. 86+40.00 TO STA. 89+45.00 (NORTH)	
III A	9-1-95	STA. 121+00.00 TO STA. 125+00.00 (EAST)	
III A	3-11-95	STA. 86+40.00 TO STA. 89+45.00 (NORTH)	
III A	3-11-95	STA. 115+80.00 TO STA. 120+00.00 (EAST)	
III A	9-11-95	STA. 86+40.00 TO STA. 87+10.00 (NORTH)	
III A	9-11-95	STA. 122+00.00 TO STA. 125+00.00 (EAST)	
III A	9-19-95	STA. 86+40.00 TO STA. 89+45.00 (NORTH)	
III A	9-19-95	STA. 125+65.00 TO STA. 126+05.00 (EAST)	
III A	9-28-95	STA. 87+80.00 TO STA. 88+40.00 (NORTH)	
III A	9-28-95	STA. 125+80.00 TO STA. 126+40.00 (EAST)	



LEGEND	
---	JURISDICTIONAL WETLANDS LINE
---	EDGE OF PRIMARY AND SECONDARY LINER SYSTEM
---	Q OF VALLEY
---	Q OF RIDGE
---	Q OF DITCH
---	HDPE STORMWATER CONTROL FLAP
---	FLOW ARROWS

HERBEN A. VASILEVICH, INC. MEETS THE MINIMUM TECHNICAL STANDARDS FOR PROFESSIONAL ENGINEERING AND SURVEYING IN THE STATE OF FLORIDA. DATE: 9-28-2016. AUTHORIZED SIGNATURE: HERBEN A. VASILEVICH, P.E., S.E., S.U.P.E.R.V.I.S.O.R.

LINER SYSTEM
PHASE IIIA
TRAIL RIDGE LANDFILL
FOR TRAIL RIDGE LANDFILL, INC. AND
CITY OF JACKSONVILLE, FLORIDA

SUNSHINE STATE
SURVEYORS, INC.
3333 ST. JOHN AVENUE, SUITE 100
JACKSONVILLE, FLORIDA 32244
PHONE NUMBER (904) 442-8550
FAX NUMBER (904) 442-8550


RECORD
ORDER NO.
DRAWN BY: J. SALMER
CHECKED BY: J. SALMER
SCALE: 1" = 100'
RANGE: 23 EAST
COUNTY: DUVAL
FIELD BOOK:
FILE NUMBER:

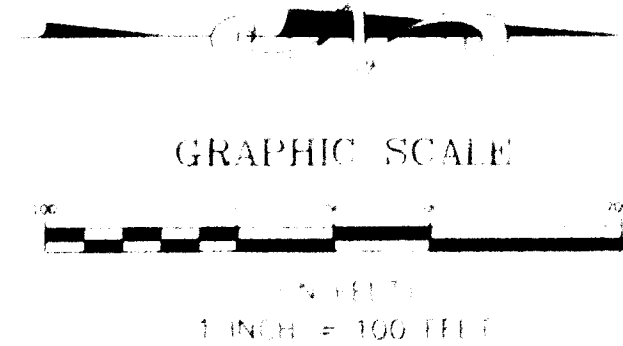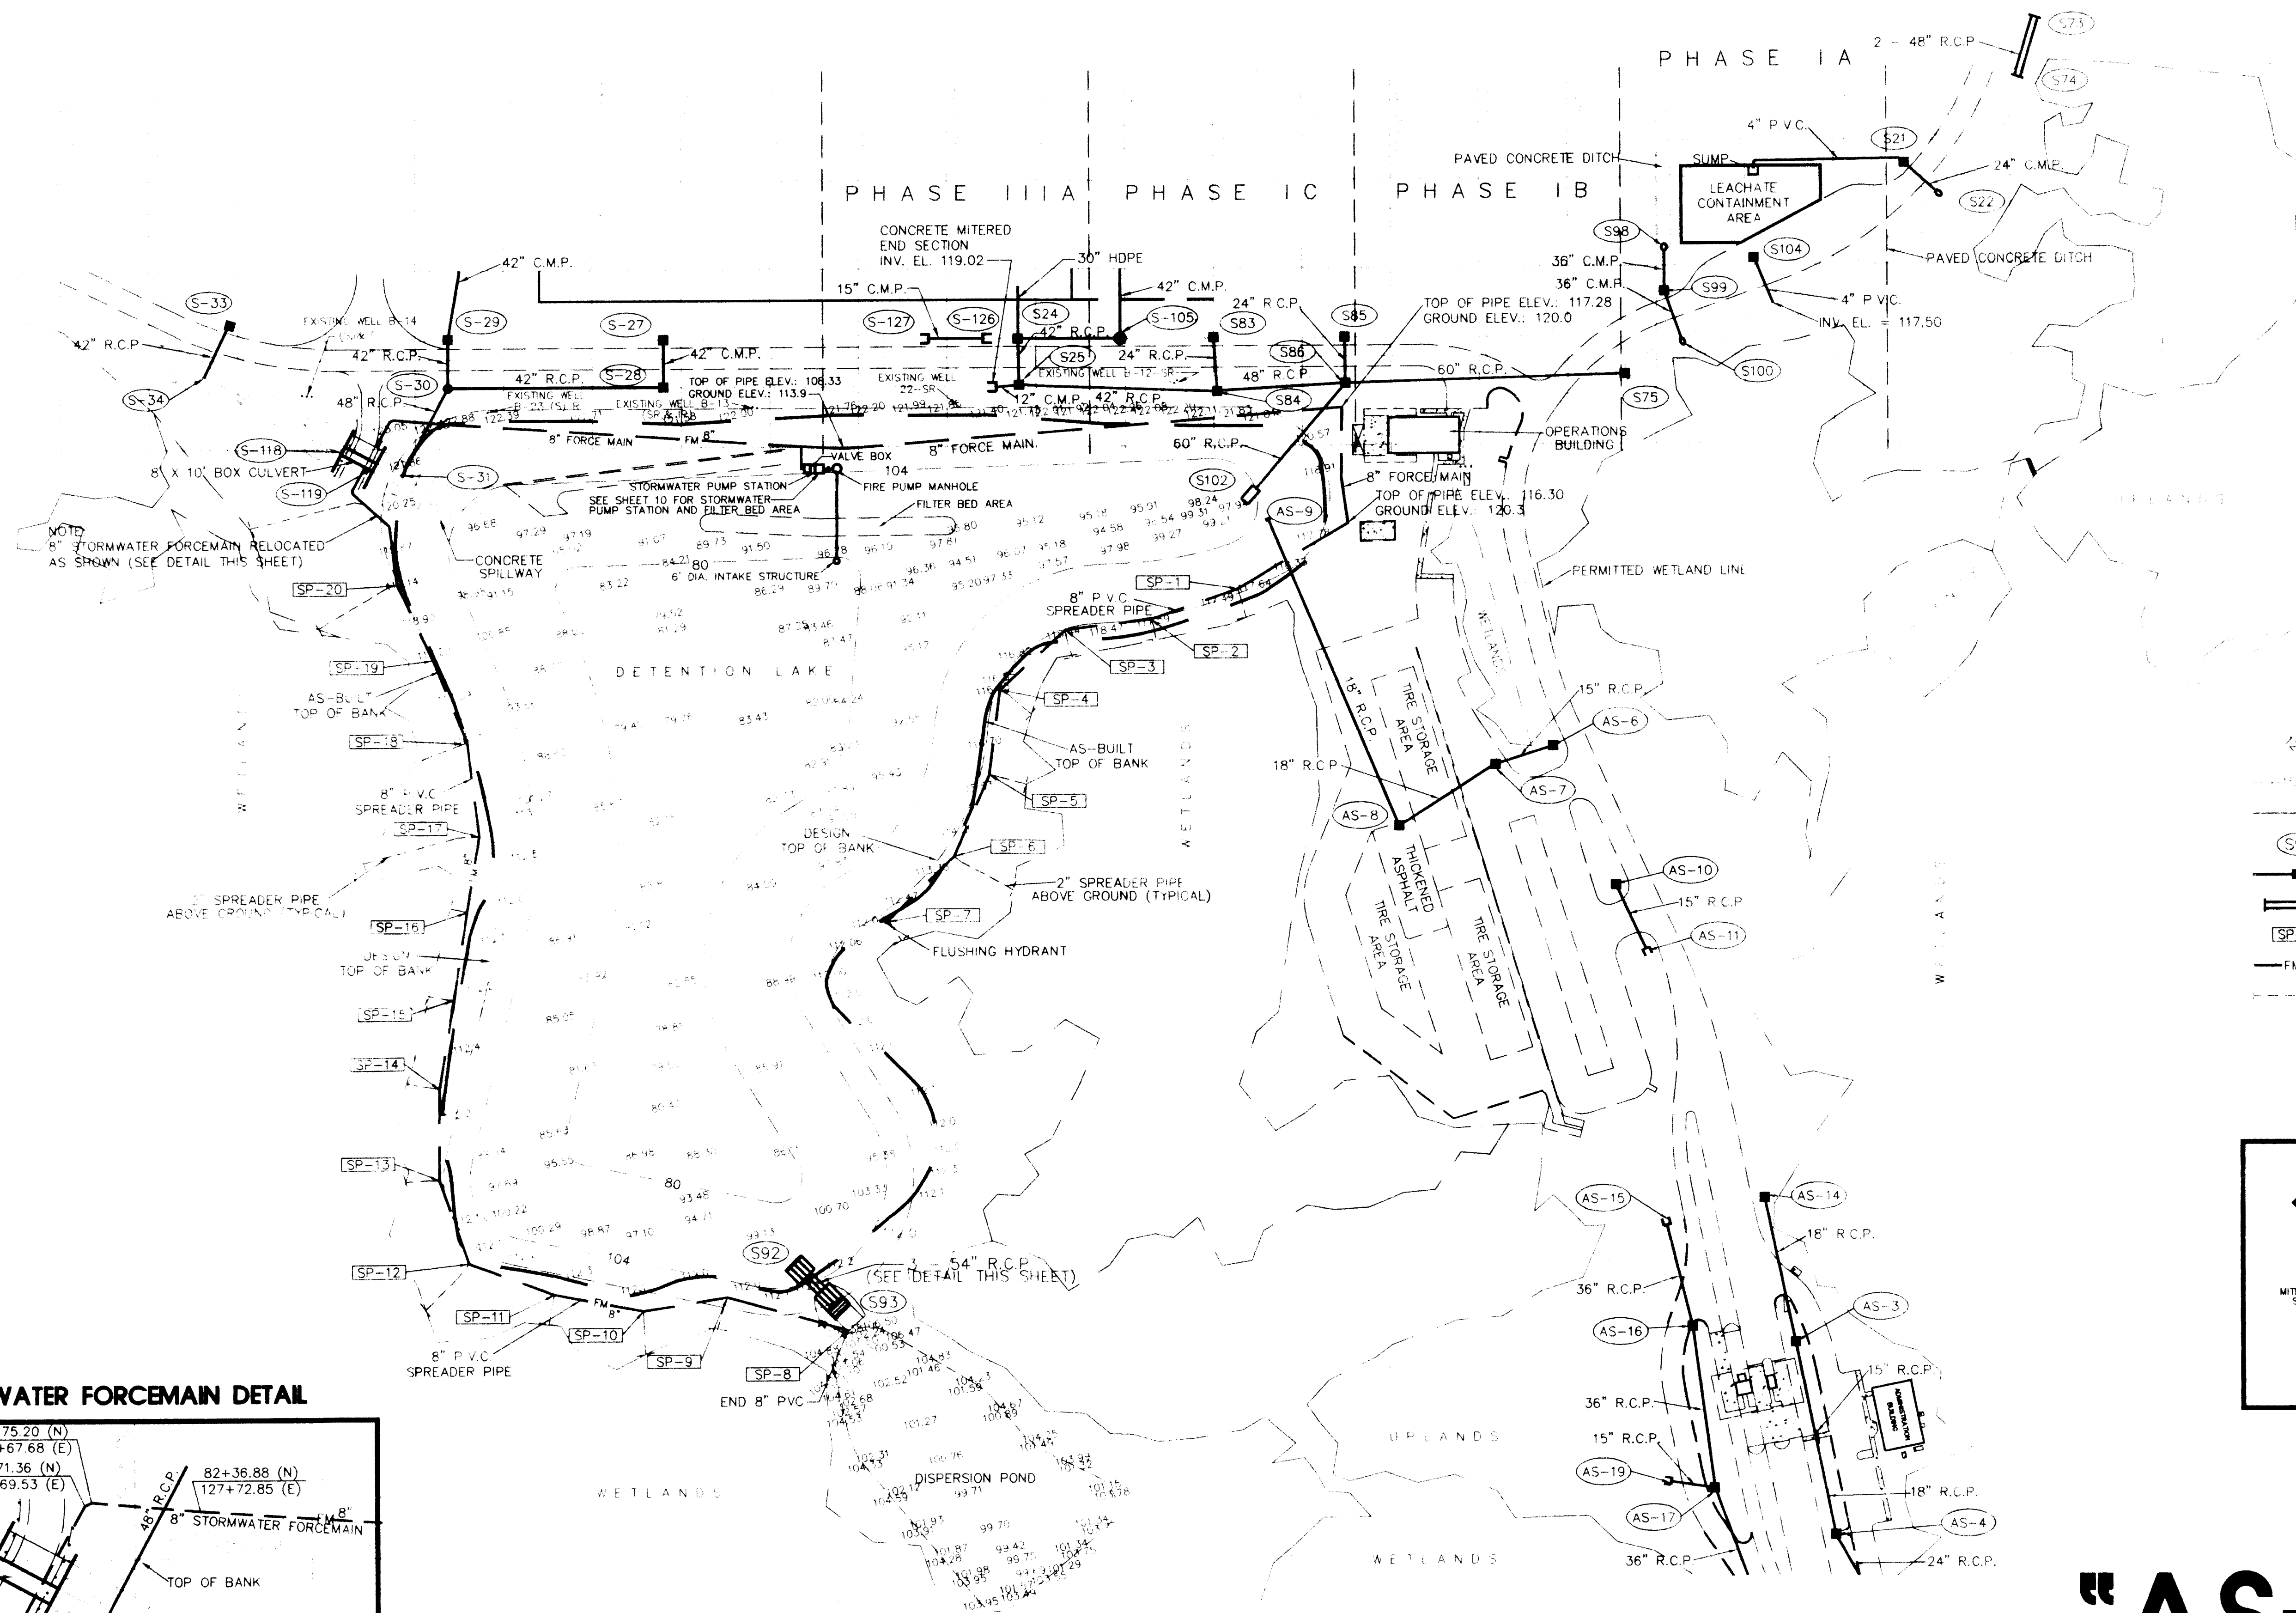


NOTE:
SEE SHEET D-1 FOR AS-BUILT INFORMATION FOR THE STORMWATER CHANAGE STRUCTURES, AND THE 4\"/>

- LEGEND
- 124.0 "AS-BUILT" SPOT ELEVATION
 - DESIGN CONTOUR
 - "AS-BUILT" TOP OF BANK
 - (S93) STRUCTURE NUMBER
 - "AS-BUILT" STORM INLET WITH PIPES
 - "AS-BUILT" STORM CULVERT
 - [SP-13] SPREADER PIPE NUMBER
 - FM 8" "AS-BUILT" 8" P.V.C. STORMWATER FORCEMAIN
 - "AS-BUILT" 2" P.V.C. SPREADER PIPE

DITCH PAVING DETAIL

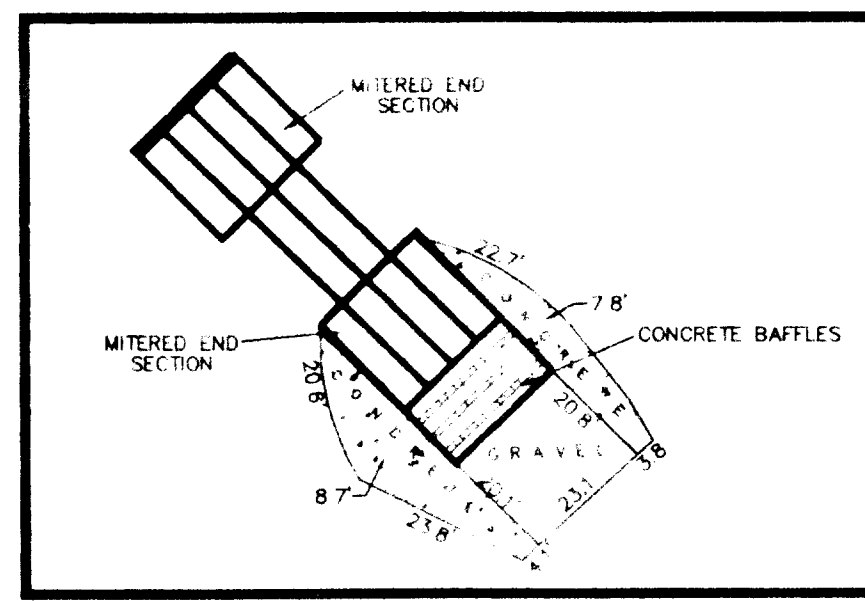

STORMWATER FORCEMAIN DETAIL

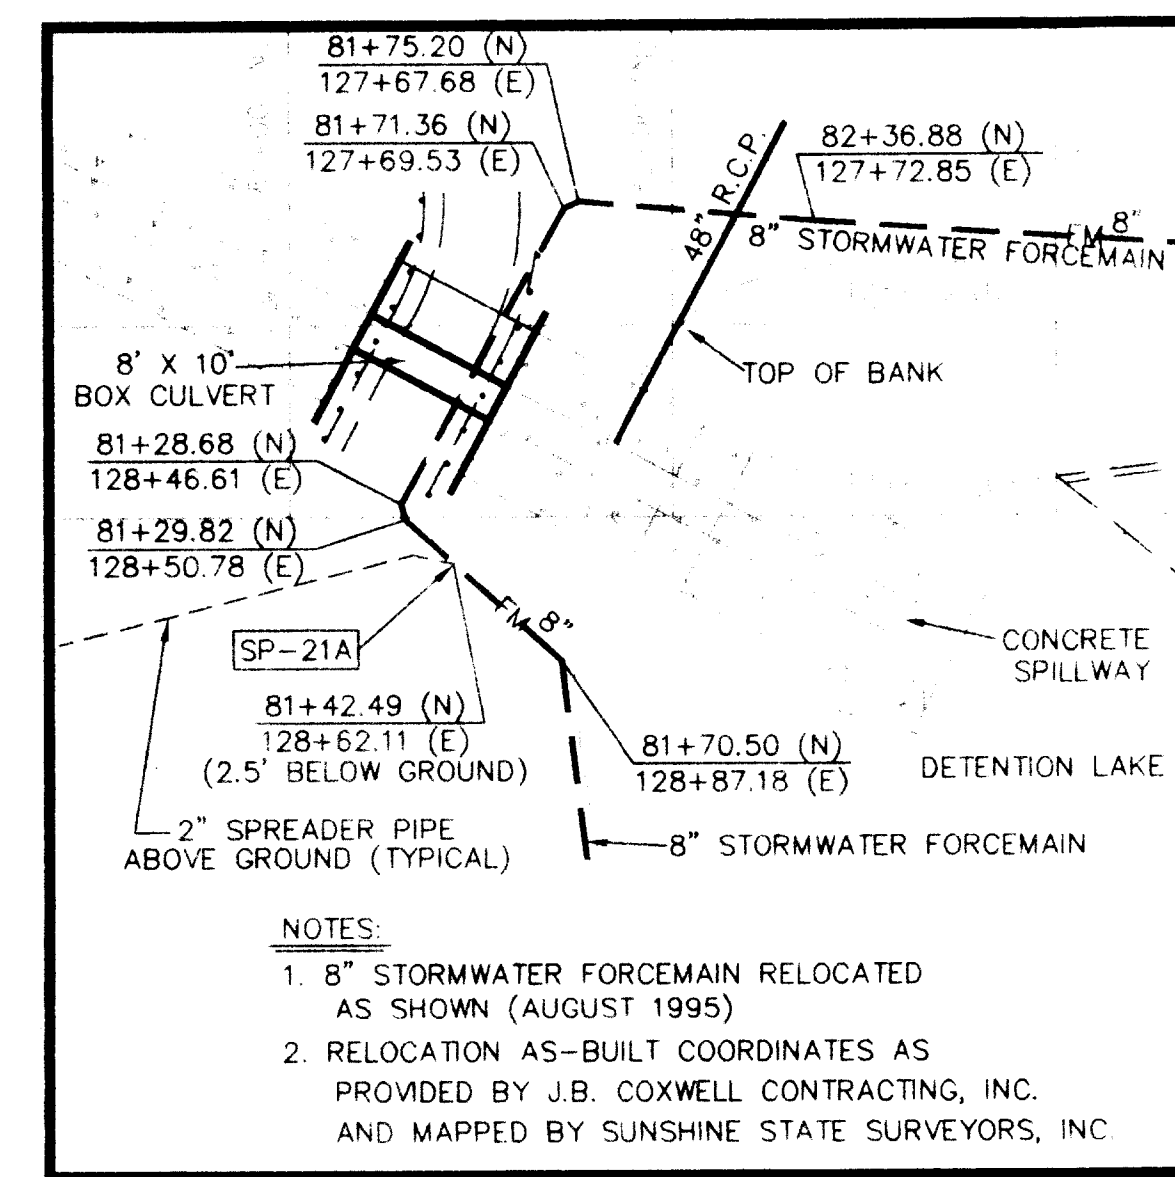

SHEET D-3

DATE	COMMENTS
9-27-95	REVISED TO SHOW RELOCATION OF 8" FORCEMAIN
1-26-93	REVISED TO ADD TIRE STORAGE AREA, BYPASS ROAD AND OPERATIONS BUILDING AS-BUILTS.
12-12-92	REVISE AS-BUILT TOPO ALONG EAST END OF POND
11-24-92	DITCH PAVING AS-BUILT
3-11-92	PHASE IIA AS-BUILT


I HEREBY CERTIFY THAT THIS SURVEY MEETS THE MINIMUM TECHNICAL STANDARDS AS SET FORTH BY THE FLORIDA BOARD OF PROFESSIONAL LAND SURVEYORS IN CHAPTER 61G17-6, FLORIDA ADMINISTRATIVE CODE, AND CHAPTER 472.027, FLORIDA STATUTES.

NOTED AND APPROVED: [Signature] EMBOSSED SEAL

ARTHUR A. [Signature] FLA. REG. SURVEYOR NO. 4166

"AS-BUILT"

DETENTION LAKE
FOR
TRAIL RIDGE LANDFILL, INC. AND
CITY OF JACKSONVILLE, FLORIDA

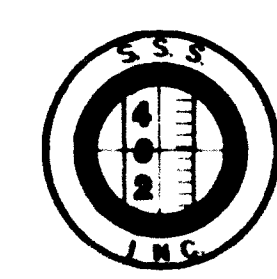


SUNSHINE STATE SURVEYORS, INC.
SURVEYORS & LAND PLANNERS 3131 ST. JOHNS BLUFF RD., SOUTH, JACKSONVILLE, FLORIDA 3
(904) 642-8550

C:\VP\AS-BUILT\... 100 29 15 13 1996

AS-BUILT STORM DRAINAGE DATA
FOR PHASE IIIA

STRUCTURE NUMBER	STRUCTURE DESCRIPTION	TOP ELEVATION		SLOT ELEVATION		INVERT ELEVATION		STATION	
		DESIGN	ASBUILT	DESIGN	ASBUILT	DESIGN	ASBUILT	DESIGN	ASBUILT
S-27	MOD. FDOT TYPE "E" INLET (DETAIL A)	121.50	121.48	118.76 (S)	118.05 (S)	115.26 (30" HDPE W) 115.26 (42" R.C.P. E) 118.76 (15" R.C.P. N)	FUTURE 30" HDPE W 115.23 (42" R.C.P. E) 118.58 (15" R.C.P. N)	84+80.00 (N) 126+78.77 (E)	84+80.18 (N) 126+78.01 (E)
S-28	FDOT TYPE "E" INLET W/ 7" TYPE J BOTTOM (ALTERNATE A)	121.50	121.57	119.50 (N&S)	119.48 (N&S)	115.26 (42" R.C.P. W) 113.00 (42" R.C.P. S)	115.17 (42" R.C.P. W) 112.90 (42" R.C.P. S)	84+80.00 (N) 127+32.27 (E)	84+81.14 (N) 127+33.57 (E)
S-29	FDOT TYPE "E" INLET	121.50	121.52	118.76 (N&S)	118.77 (N&S)	116.26 (42" R.C.P. E) 116.26 (42" C.M.P. W)	116.46 (42" R.C.P. E) 116.50 (42" C.M.P. W)	82+37.00 (N) 126+77.27 (E)	82+37.03 (N) 126+76.89 (E)
S-30	FDOT TYPE "E" INLET W/ 7" TYPE J BOTTOM (ALTERNATE A)	121.50	121.53	120.00 (S)	120.09 (S)	116.26 (42" R.C.P. W) 110.96 (42" R.C.P. N) 110.46 (48" R.C.P. SE)	115.80 (42" R.C.P. W) 110.85 (42" R.C.P. N) 110.50 (48" R.C.P. SE)	82+37.00 (N) 127+32.27 (E)	82+45.61 (N) 127+32.12 (E)
S-31	CONST. 48" MITERED END INTO DITCH PAVING	---	---	---	---	09.10 (48" R.C.P. NW)	108.92 (48" R.C.P. NW)	81+84.60 (N) 128+30.89 (E)	81+84.78 (N) 128+31.13 (E)
S-33	MOD. FDOT TYPE "E" INLET (DETAIL A)	121.75	121.74	118.76 (N&S)	118.68 (N) 118.66 (S)	115.00 (30" HDPE NW) 111.85 (42" R.C.P. SE)	FUTURE 30" HDPE NW 111.96 (42" R.C.P. SE)	79+91.26 (N) 126+60.49 (E)	80+03.41 (N) 126+65.38 (E)
S-34	CONST. MITERED END INTO DITCH PAVING	---	---	---	---	111.85 (42" R.C.P. NW)	111.94 (42" R.C.P. NW)	79+61.92 (N) 127+19.07 (E)	79+63.30 (N) 127+17.66 (E)
S-111	18" C.M.P.	---	---	---	---	143.70 (18" C.M.P. E)	143.64 (18" C.M.P. E)	82+52.50 (N) 102+37.50 (E)	82+51.82 (N) 102+37.63 (E)
S-112	18" C.M.P.	---	---	---	---	142.70 (18" C.M.P. W)	142.64 (18" C.M.P. W)	82+52.50 (N) 103+61.00 (E)	82+52.54 (N) 103+62.61 (E)
S-113	42" C.M.P.	---	---	---	---	123.80 (42" C.M.P. E)	123.76 (42" C.M.P. E)	82+52.50 (N) 123+39.00 (E)	82+52.55 (N) 123+38.09 (E)
S-114	42" C.M.P.	---	---	---	---	122.40 (42" C.M.P. W)	122.32 (42" C.M.P. W)	82+52.50 (N) 124+62.50 (E)	82+52.65 (N) 124+62.44 (E)
S-115	42" C.M.P.	---	---	---	---	121.00 (42" C.M.P. E)	120.95 (42" C.M.P. E)	82+52.50 (N) 125+87.00 (E)	82+52.57 (N) 125+87.11 (E)
S-118	10' X 8' BOX CULVERT BOX CULVERT WITH 9.75' X 54' ENDWALL	---	---	---	---	110.00	110.07	81+18.72 (N) 128+01.47 (E)	81+18.84 (N) 128+01.15 (E)
S-119	10' X 8' BOX CULVERT BOX CULVERT WITH 9.75' X 54' ENDWALL	---	---	---	---	109.30	109.36	81+54.02 (N) 128+20.27 (E)	81+54.88 (N) 128+21.85 (E)
S-126	15" FDOT MITERED END SECTION	---	---	---	---	118.80 (15" R.C.P. S)	118.77 (15" R.C.P. S)	88+40.50 (N) 126+78.77 (E)	88+46.74 (N) 126+79.37 (E)
S-127	15" FDOT MITERED END SECTION	---	---	---	---	119.00 (15" R.C.P. N)	118.94 (15" R.C.P. N)	87+19.50 (N) 126+78.77 (E)	87+67.18 (N) 126+79.47 (E)
S-128	15" FDOT MITERED END SECTION	---	---	---	---	119.00 (15" R.C.P. N)	118.89 (15" R.C.P. N)	85+40.50 (N) 126+78.77 (E)	85+54.74 (N) 126+78.47 (E)

"AS-BUILT"

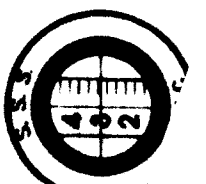

**SUNSHINE STATE
SURVEYORS, INC.**
SURVEYORS & LAND PLANNERS
3131 ST. JOHN BLVD. SUITE 200
JACKSONVILLE, FLORIDA 32246
PHONE NUMBER (904) 642-8550
FAX NUMBER (904) 642-9408




RECORD
ORDER NO. 25-
CAD FILE: 3A-/
DRAWN BY:
CHECKED BY:
SCALE:
RANGE: 2
COUNTY: 1
FIELD NO.
FILE NO.

DRAINAGE STRUCTURE TABLE
PHASE IIIA
TRIAL RIDGE LANDFILL
FOR TRIAL RIDGE LANDFILL, INC. AND
CITY OF JACKSONVILLE, FLORIDA

HEREBY CERTIFY THAT THE INFORMATION CONTAINED HEREIN IS TRUE AND CORRECT TO THE BEST OF MY KNOWLEDGE AND BELIEF. I AM A LICENSED PROFESSIONAL SURVEYOR IN THE STATE OF FLORIDA. I HAVE REVIEWED THE RECORD DRAWING AND THE AS-BUILT DATA AND HAVE FOUND THEM TO BE IN ACCORDANCE WITH THE RECORD DRAWING AND THE AS-BUILT DATA. I HAVE ALSO REVIEWED THE RECORD DRAWING AND THE AS-BUILT DATA AND HAVE FOUND THEM TO BE IN ACCORDANCE WITH THE RECORD DRAWING AND THE AS-BUILT DATA.

DATE: 9/29/95
BY: [Signature]
TITLE: SURVEYOR

DATE: 9/29/95
BY: [Signature]
TITLE: SURVEYOR

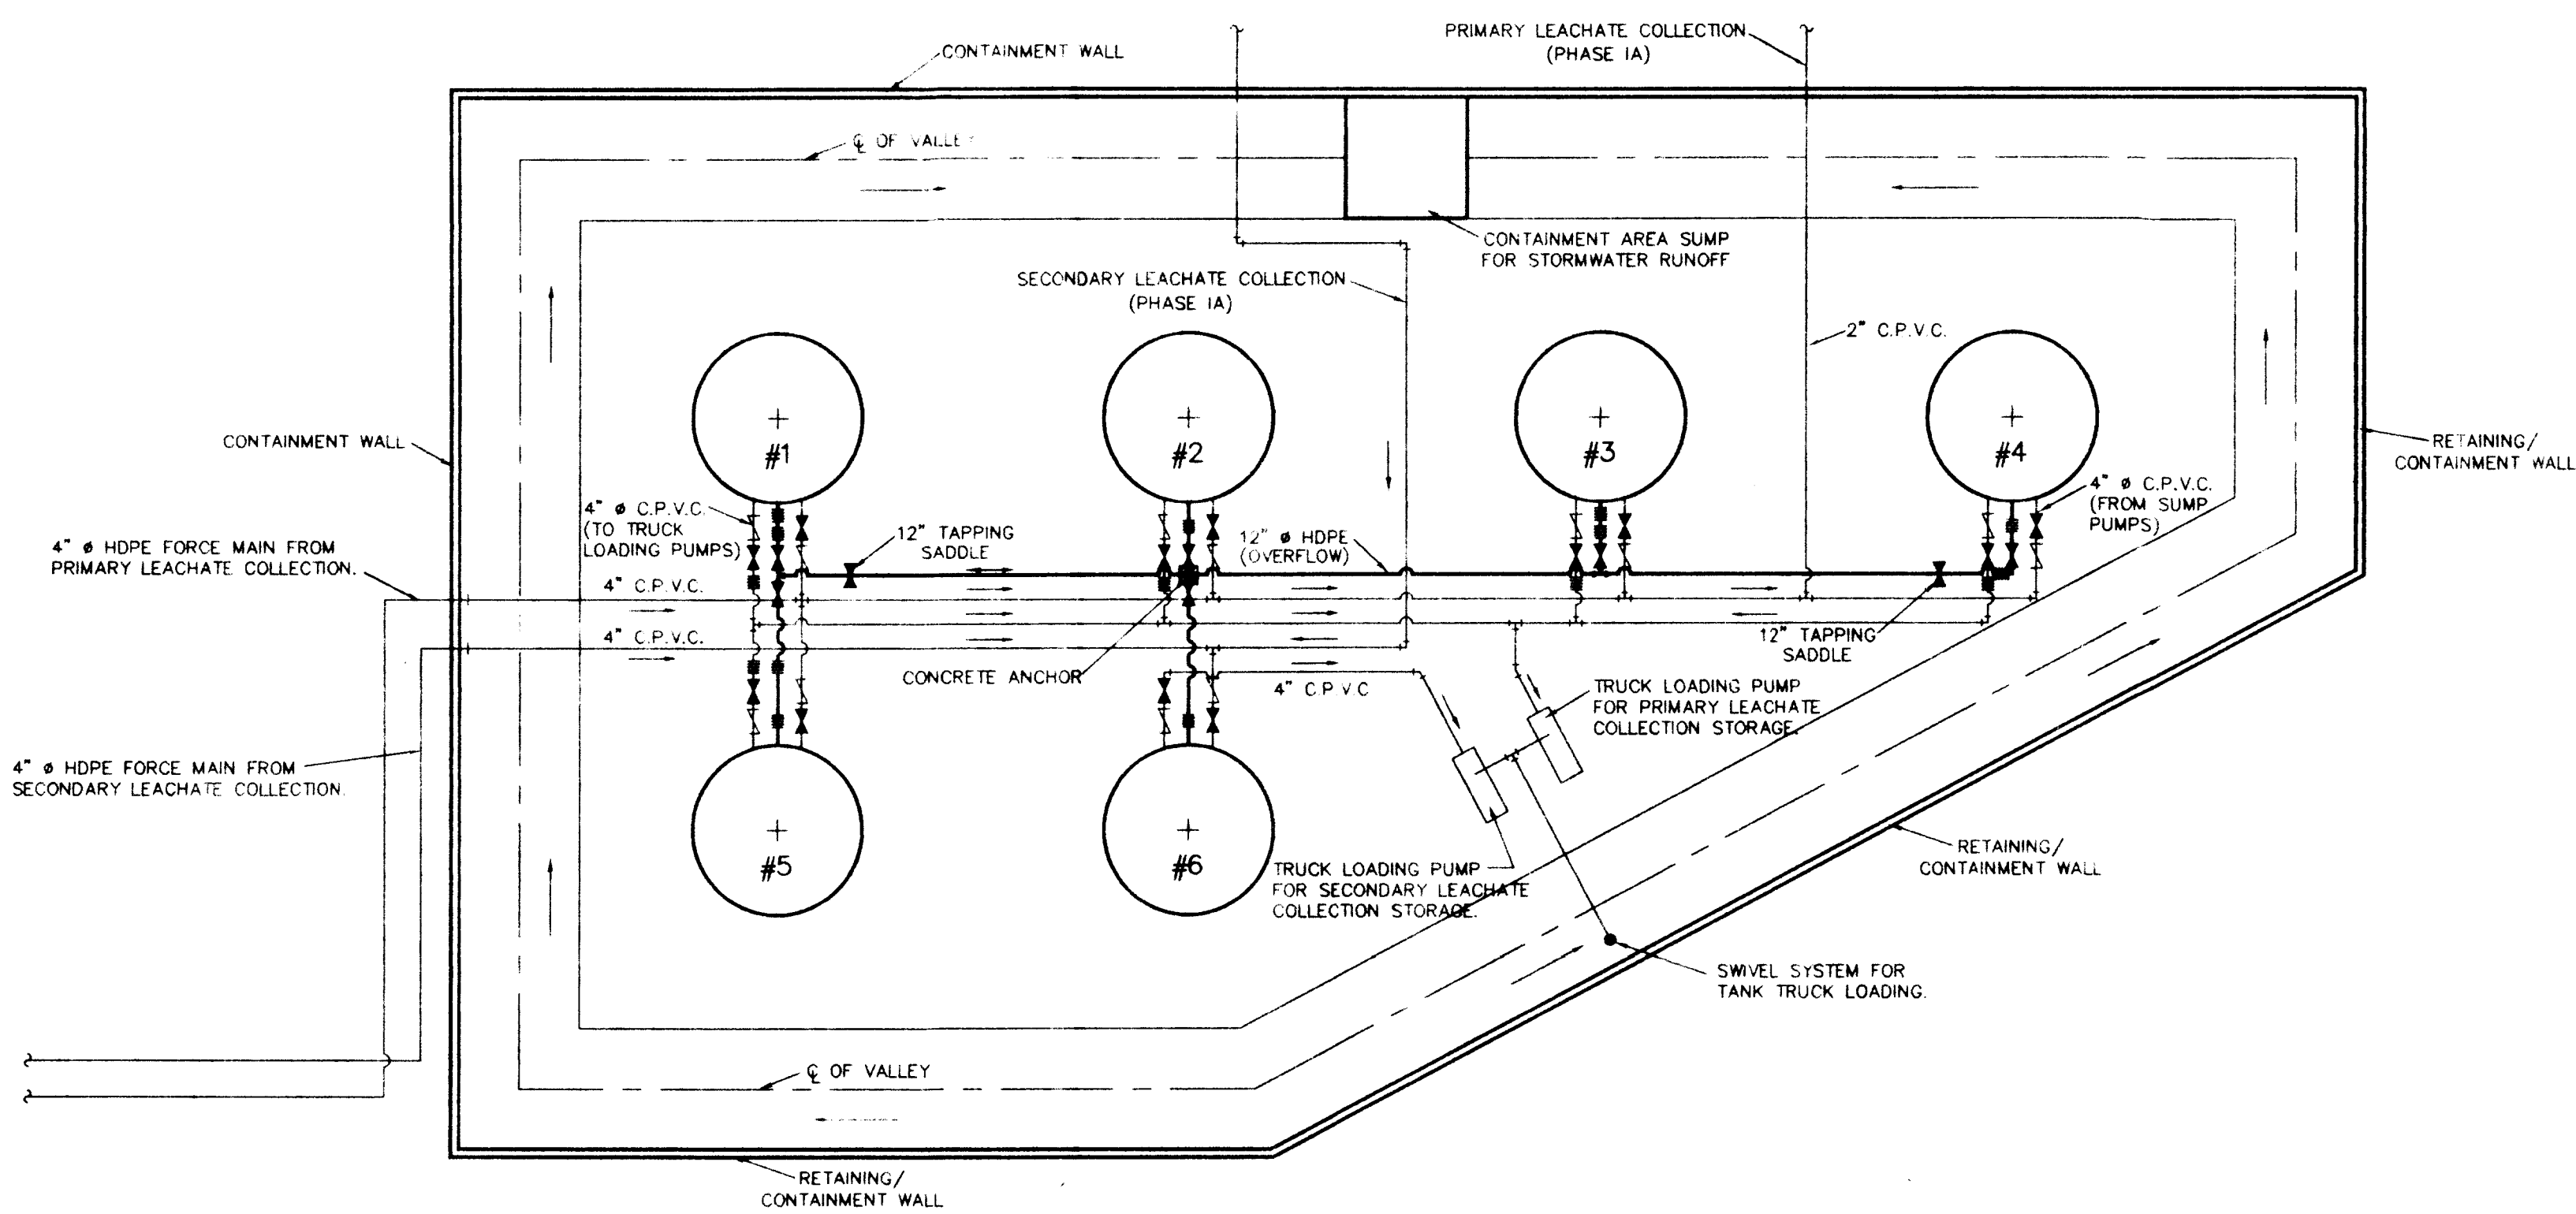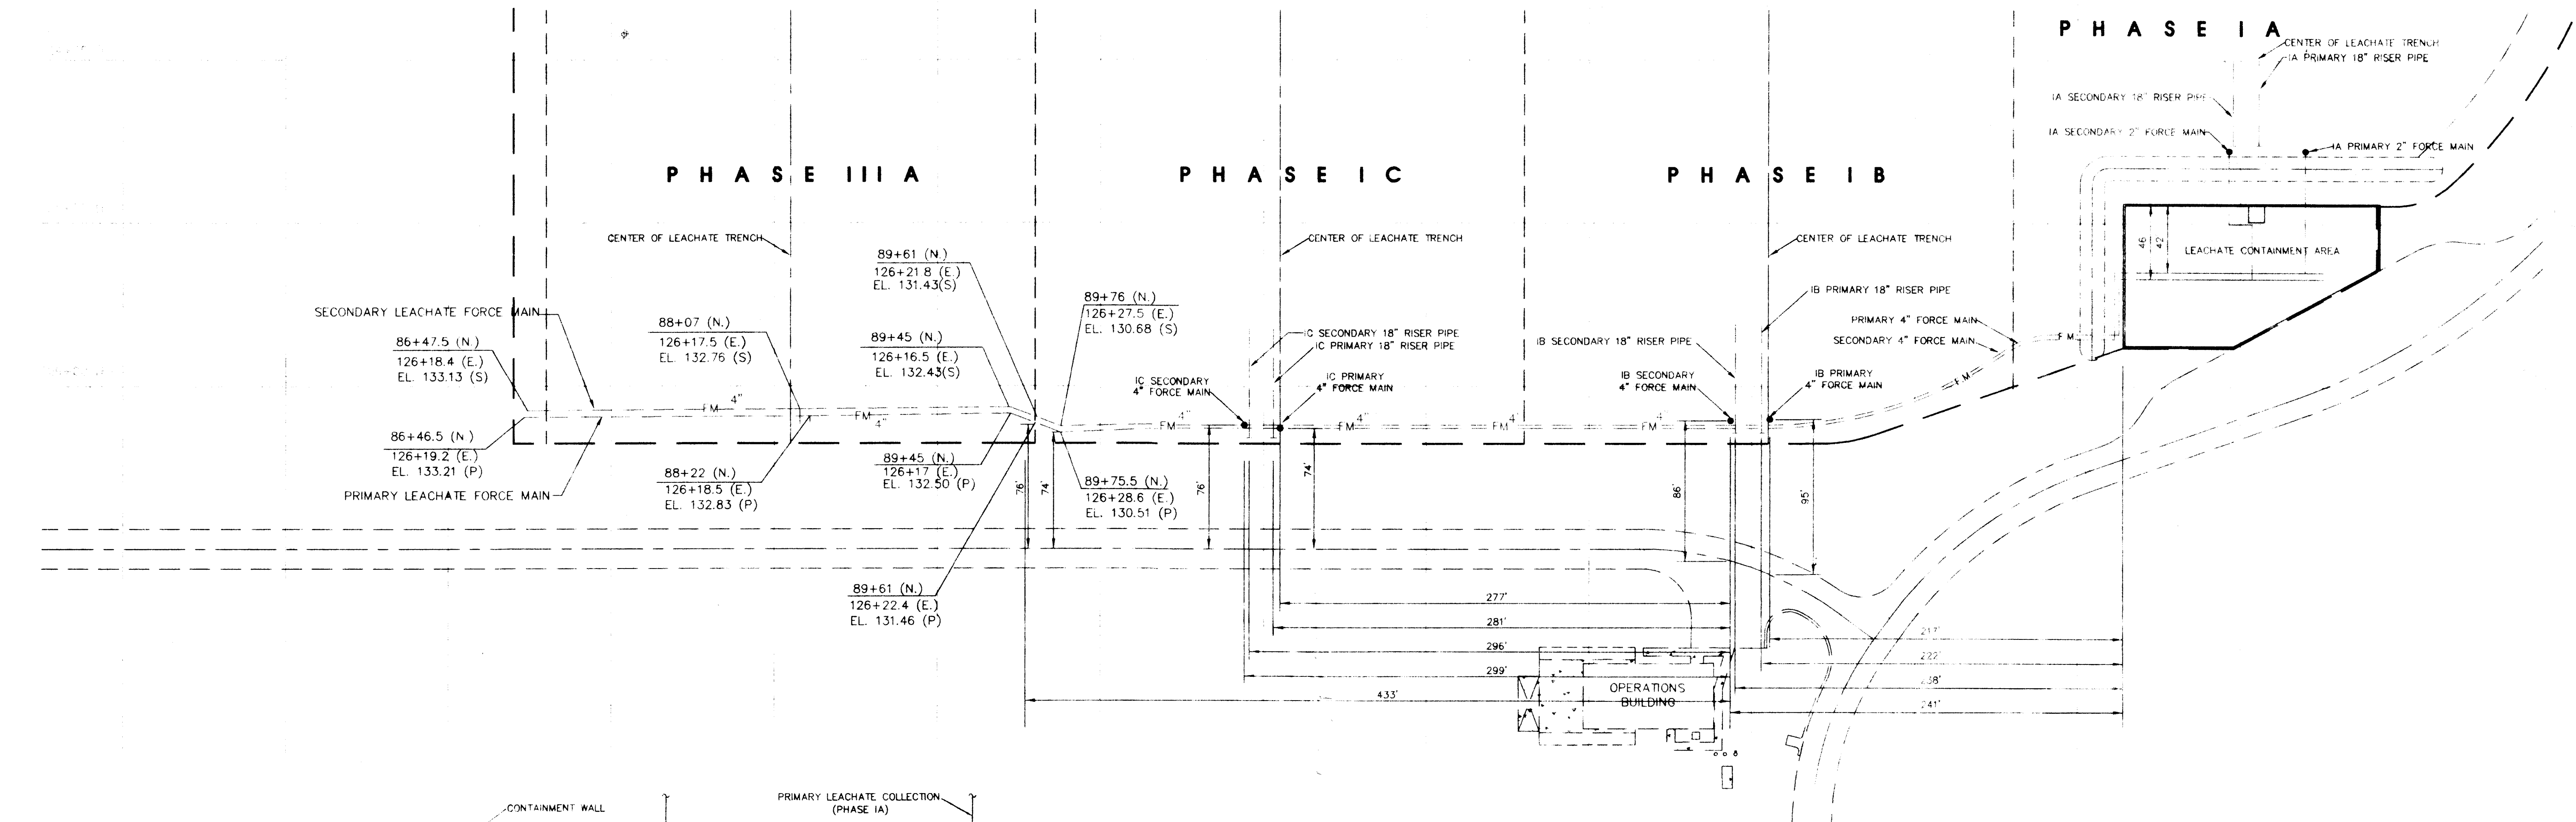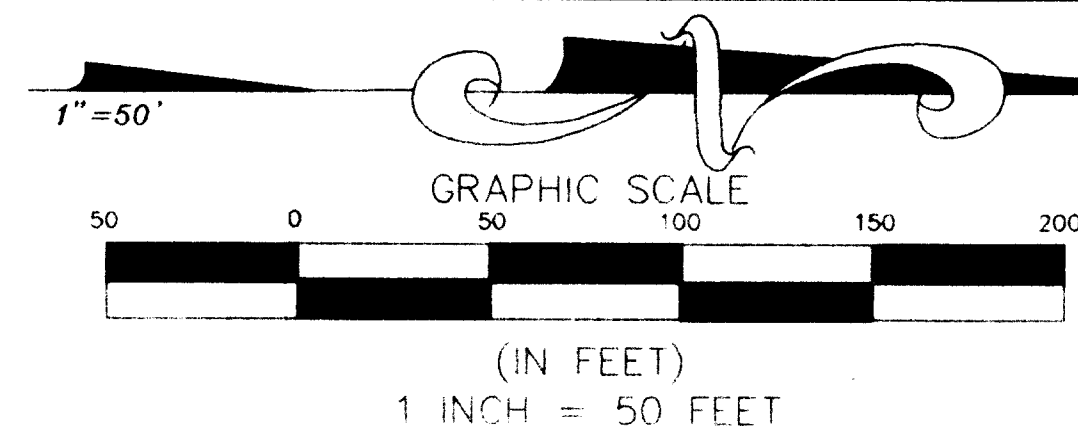

NOTE:
TANKS #1-#5 ARE FOR PRIMARY LEACHATE
COLLECTION STORAGE, TANK #6 IS FOR SECONDARY
LEACHATE COLLECTION STORAGE.

—|—|—|— EXPANSION COUPLING
—|—|—|— SPRING LEVERED CPVC CHECK VALVE
—|—|—|— CPVC BUTTERFLY VALVE

LEACHATE STORAGE, PUMPING AND CONTAINMENT

N.T.S.

LEGEND

- FM — LEACHATE FORCE MAIN
- LIMITS OF LINER SYSTEM
- C OF VALLEY
- C OF RIDGE
- C OF DITCH
- (P) PRIMARY LEACHATE FORCE MAIN
- (S) SECONDARY LEACHATE FORCE MAIN

NOTE

1. ALL DIMENSIONS SHOWN FOR PHASES I AND II WERE PROVIDED BY JAX UTILITIES CONSTRUCTION.
2. ALL COORDINATES SHOWN FOR PHASES IIIA WERE PROVIDED BY J.B. COXWELL CONTRACTING, INC.
3. MAP PREPARED BY SUNSHINE STATE SURVEYORS, INC.

"AS-BUILT"

SHEET LE-1

LEACHATE FORCE MAIN
PRIMARY AND SECONDARY
FOR TRAIL RIDGE LANDFILL
CITY OF JACKSONVILLE, FLORIDA

SUNSHINE STATE
SURVEYORS, INC.



SURVEYORS & LAND PLANNERS
3131 ST. JOHNS BLVD. SUITE 200
JACKSONVILLE, FLORIDA 32216
PHONE: (904) 844-2240
FAX: (904) 844-2440



RECORD
ORDER NO.
DRAWN BY: JAX
CHECKED BY: J.B. COXWELL
SCALE: 1"=50'
RANGE: 23 EA
COUNTY: DUVAL
FIELD BOOK: 1
FILE NUMBER

REVISIONS: PHASE I, AS-BUILT, 1-24-91
PHASE II, AS-BUILT, 1-24-91
PHASE III, AS-BUILT, 1-24-91
PHASE IIIA, AS-BUILT, 9-26-95
PHASE IIB, AS-BUILT, 9-26-95

DATE: 9-11-92

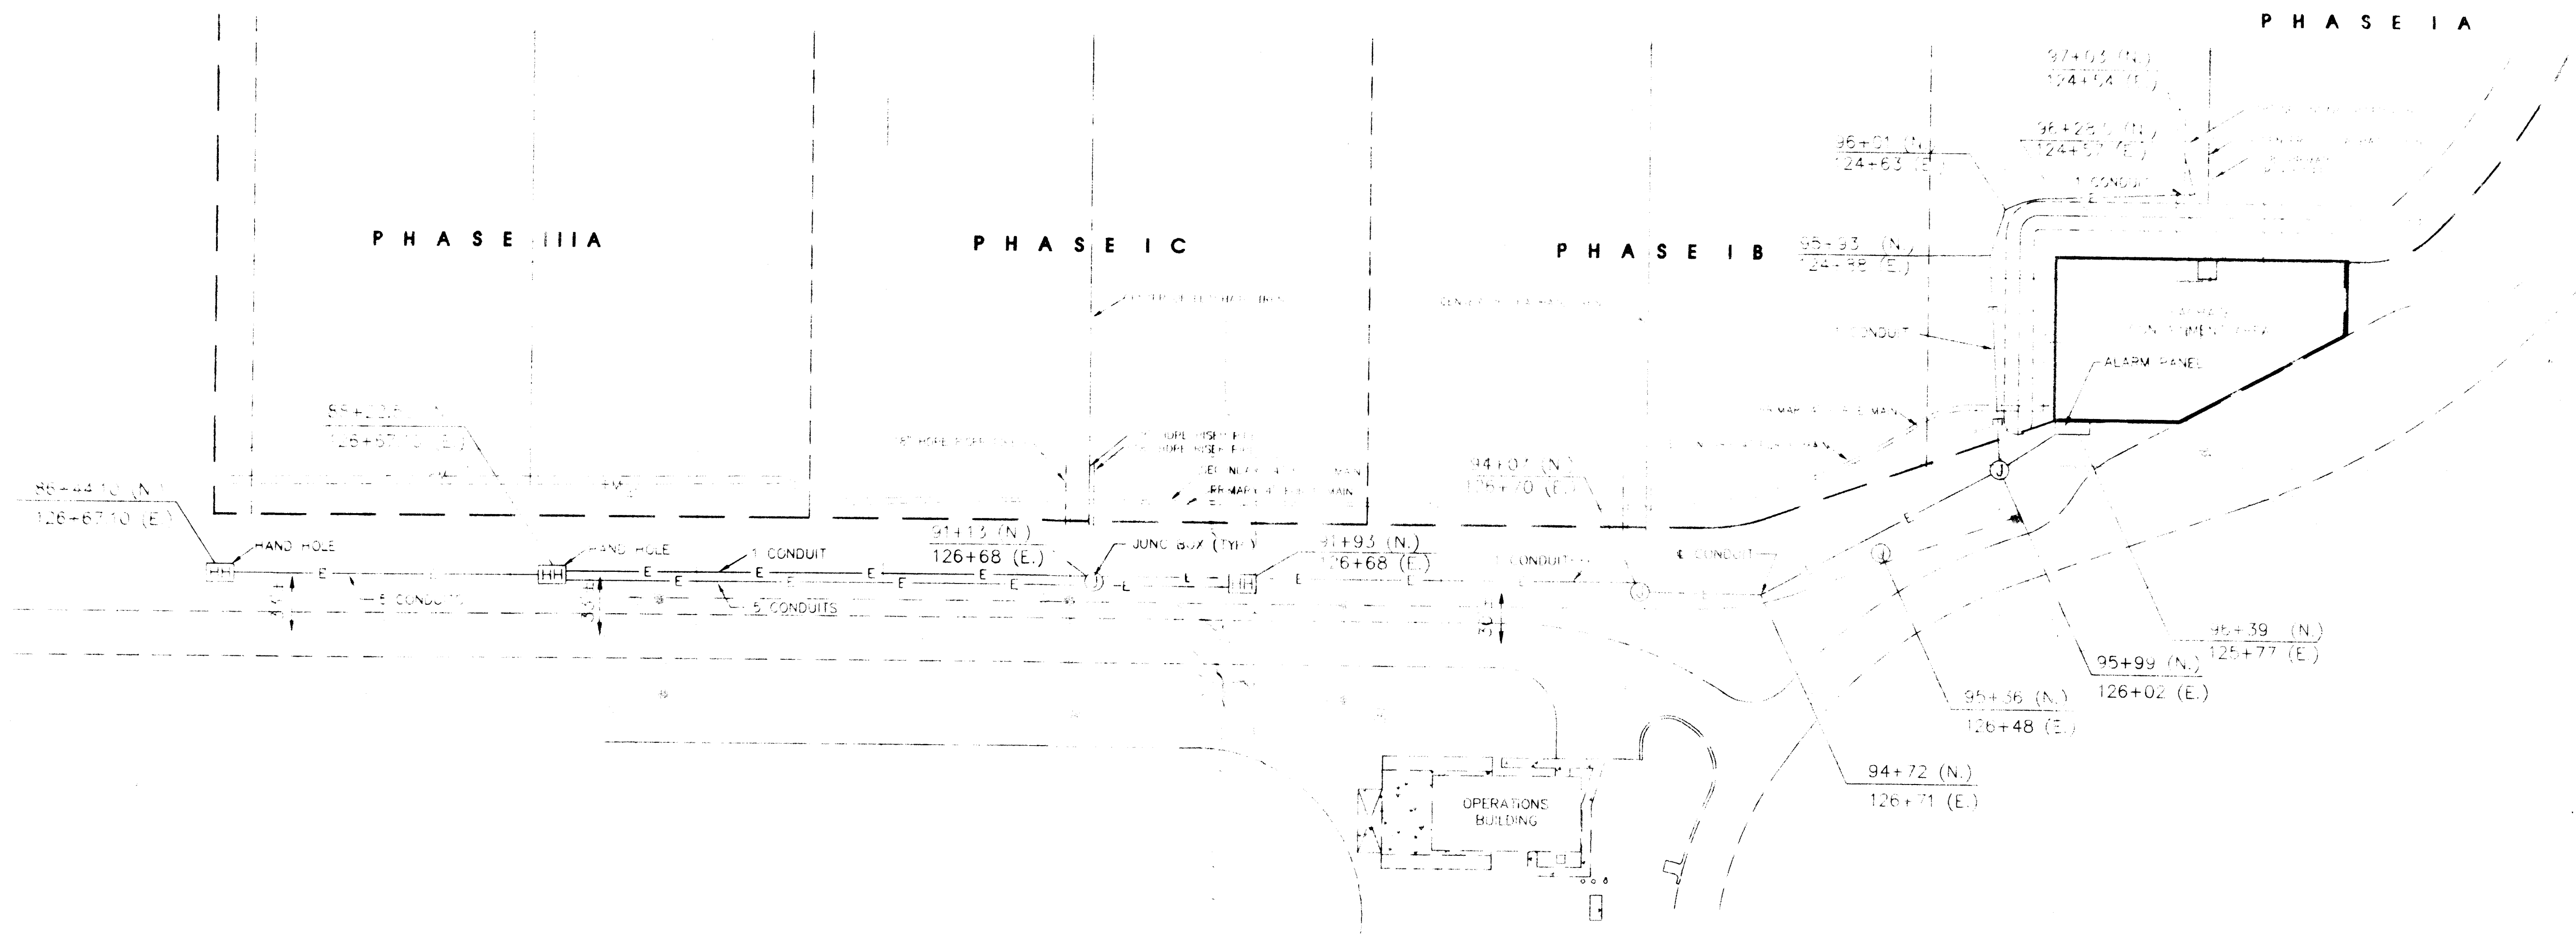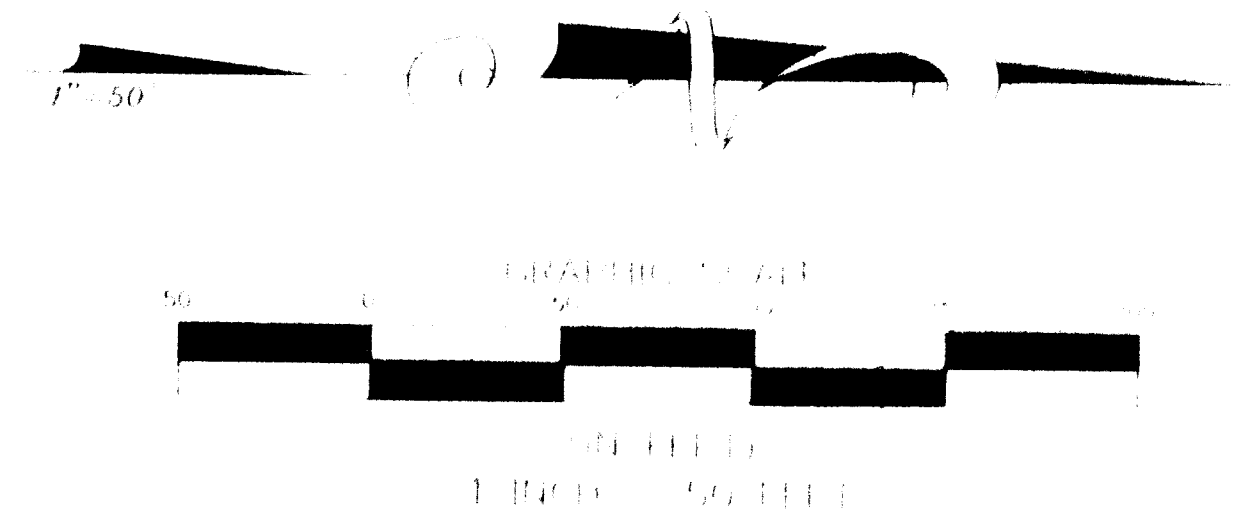

LEGEND

- HH HAND HOLE
- J JUNCTION BOX
- E— PHASE IIIA ELECTRICAL CONDUIT
- LIMITS OF LINER SYSTEM
- - - Q OF VALLEY
- - - Q OF RIDGE
- - - Q OF DITCH

NOTE

1. ALL DIMENSIONS SHOWN FOR PHASES I AND II WERE PROVIDED BY JAY UTILITIES CONSTRUCTION.
2. ALL COORDINATES SHOWN FOR PHASES IIIA WERE PROVIDED BY J.B. COXWELL CONTRACTING, INC.
3. MAP PREPARED BY SUNSHINE STATE SURVEYORS, INC.

"AS-BUILT"

SHEET E-2

SUNSHINE STATE SURVEYORS, INC.

3315 ST. JOHNS BLVD. RD. SOUTH
JACKSONVILLE, FLORIDA 32246
PHONE NUMBER (904) 842-8550
FAX NUMBER (904) 848-8485

ELECTRICAL

TRAIL RIDGE LANDFILL

FOR TRAIL RIDGE LANDFILL, INC. AND

CITY OF JACKSONVILLE, FLORIDA

C:\100\AS-BUILT\Map_E-2.dwg 12/08/97 10:40am