




943292

1

The engineer expressly reserves the exclusive common law copyright and property rights to these drawings which may not be reproduced, changed or copied in any form or manner, nor are they to be assigned to any party without the engineers written consent.

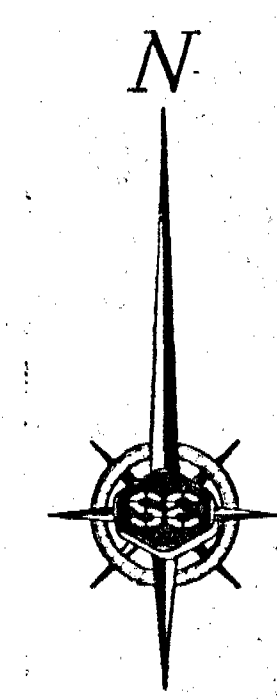

SCALE: 1" = 20'

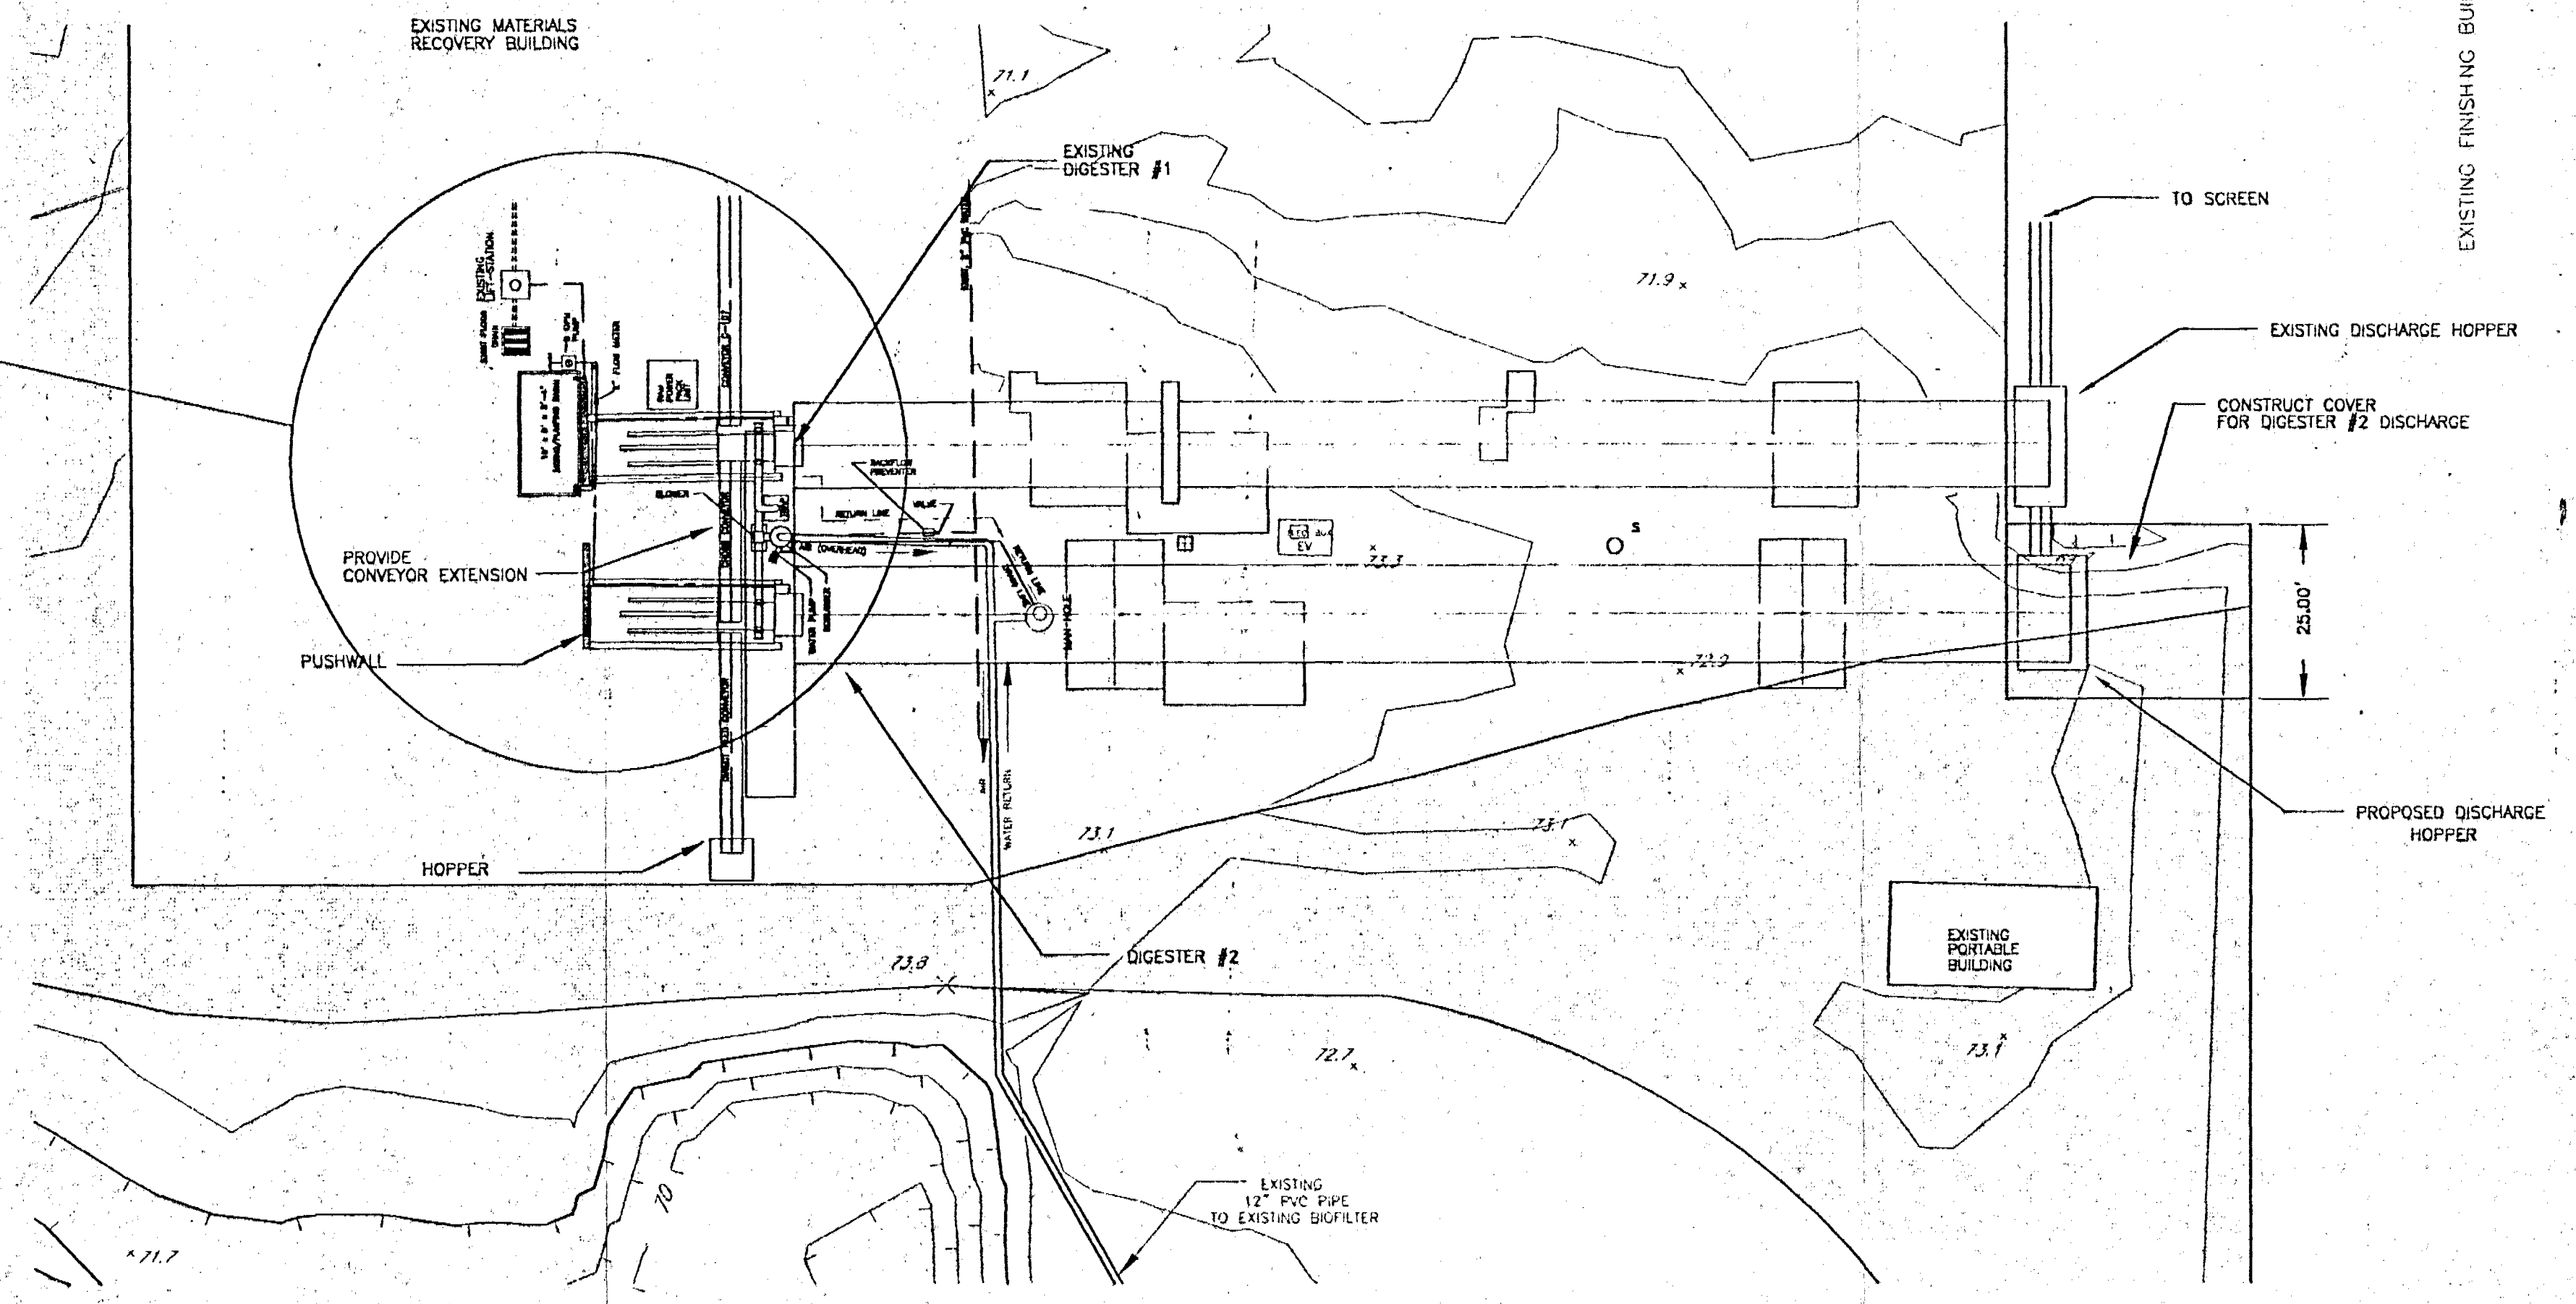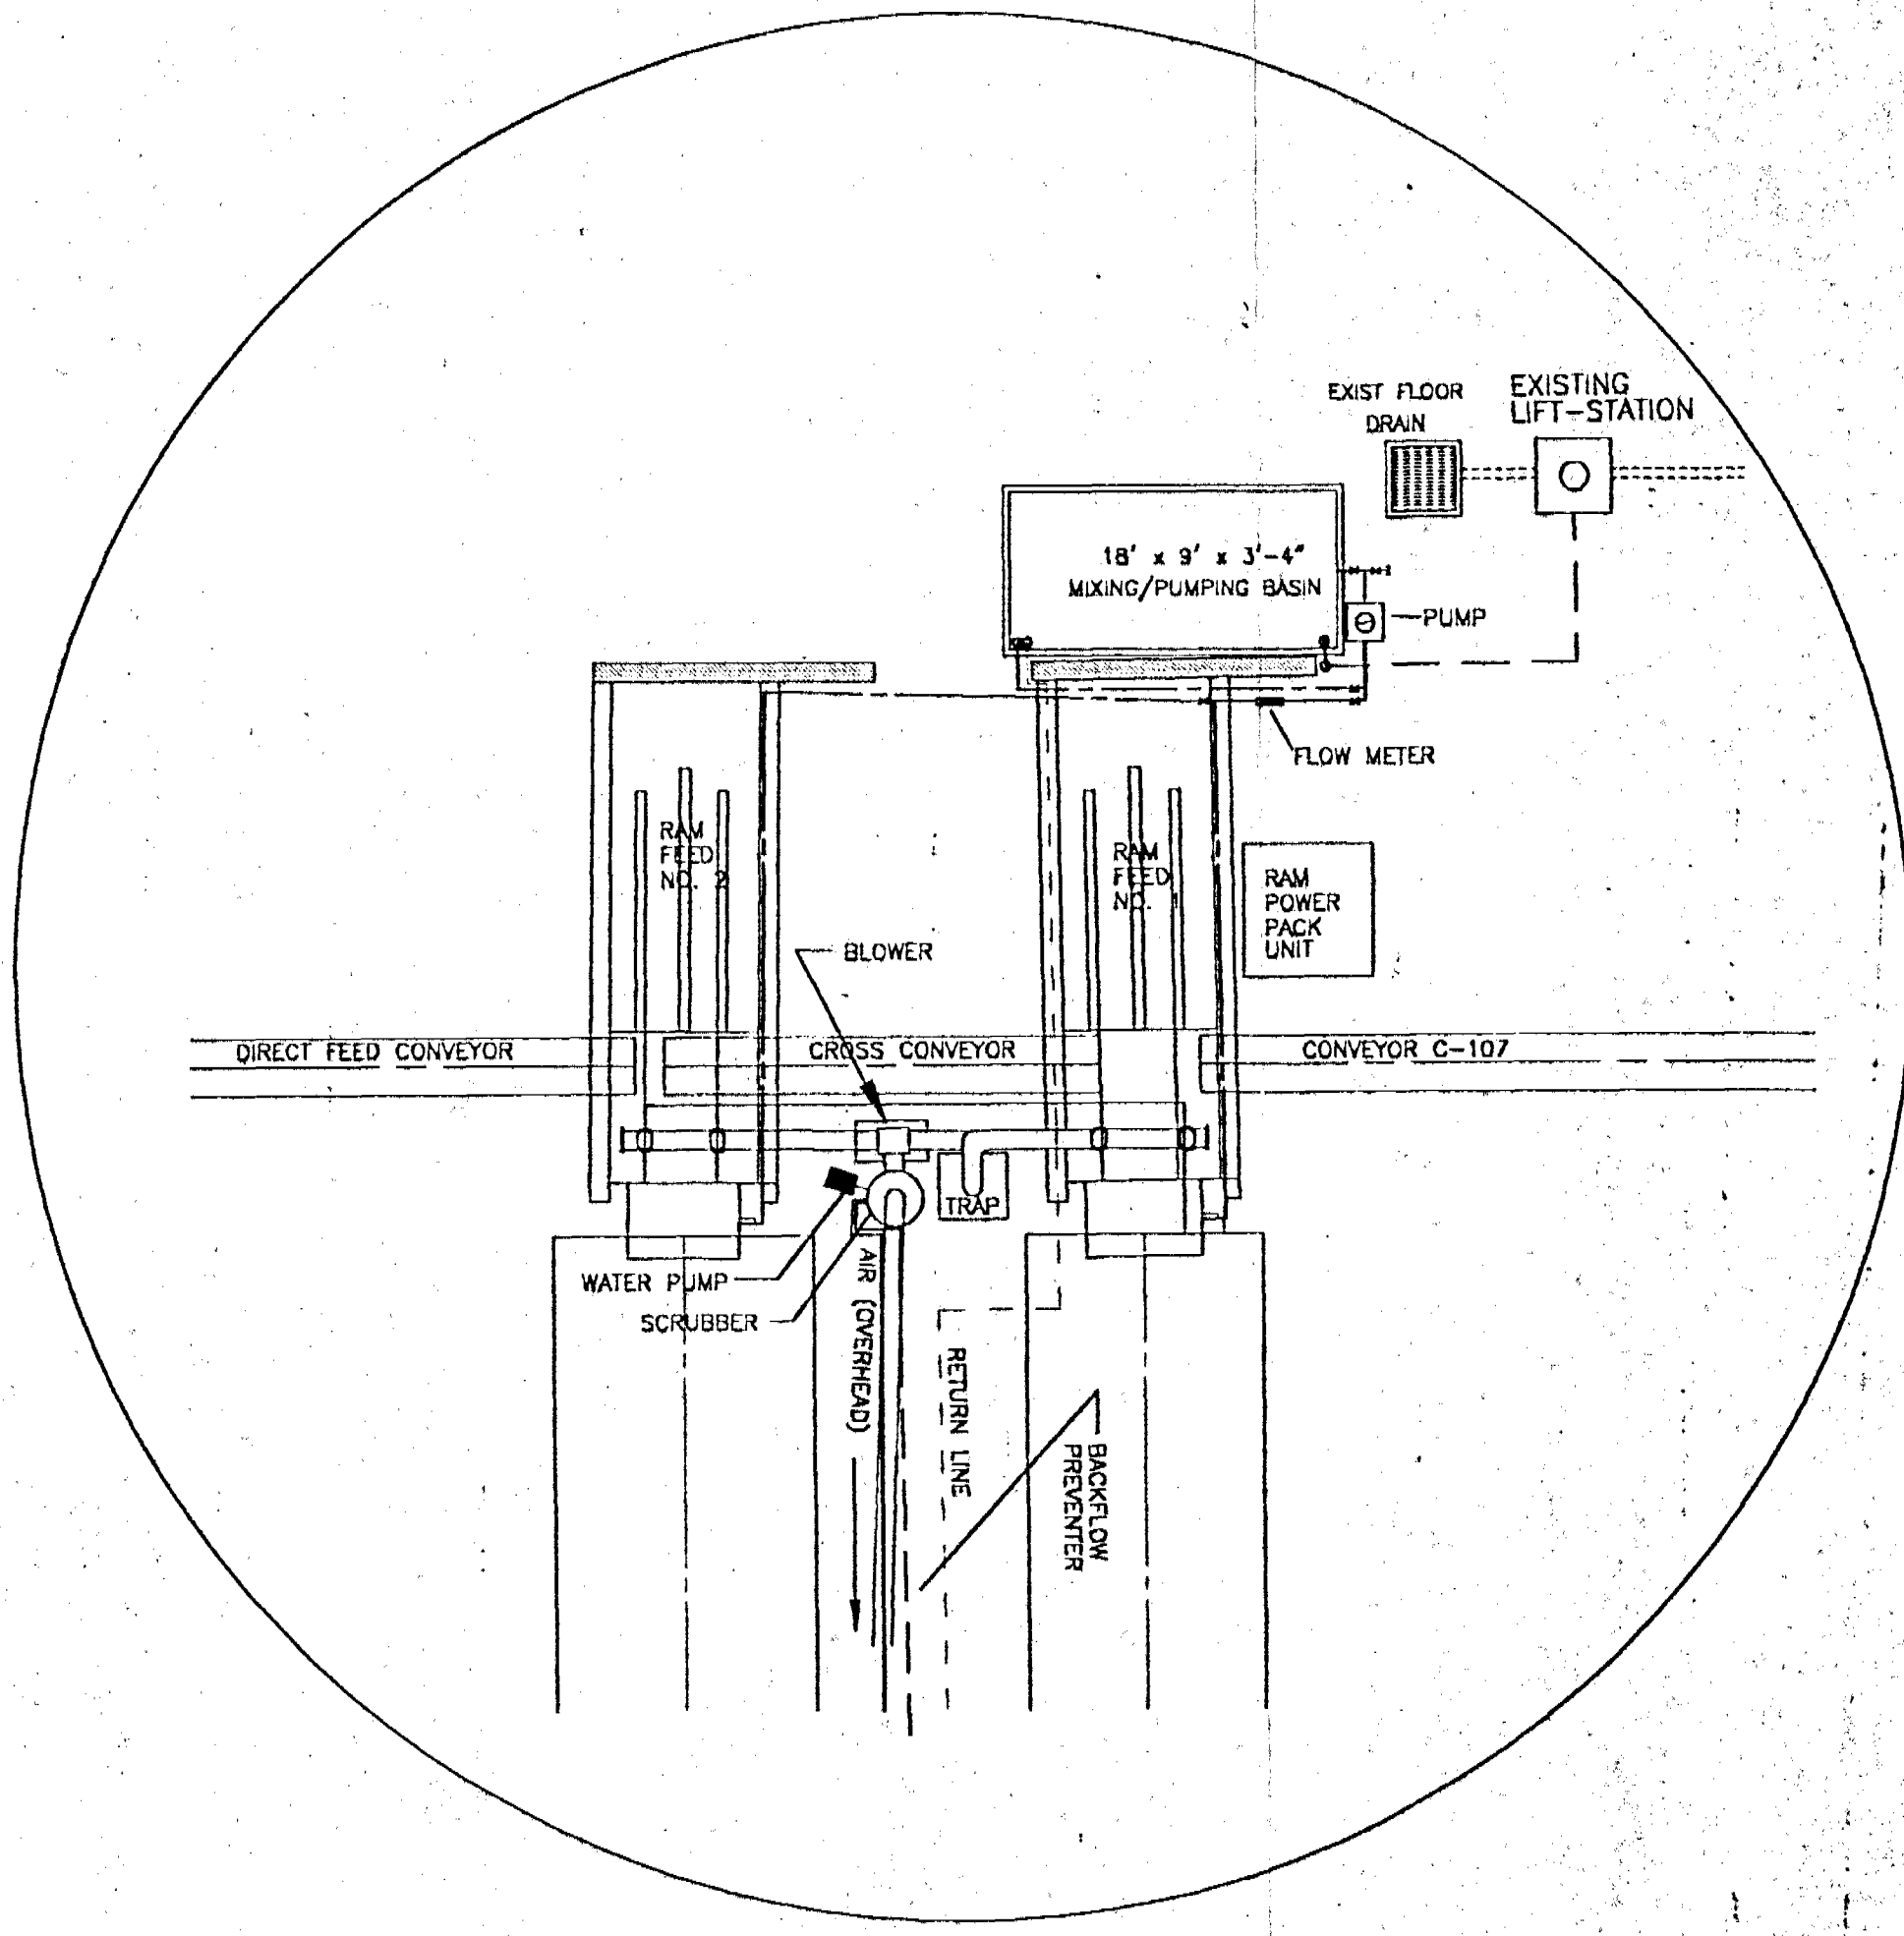

RECORDS DEPARTMENT OF ENVIRONMENTAL PROTECTION
OCT 09 2003
SOUTHWEST DISTRICT TALLAHASSEE

RECORD DRAWING

REV.	BY:	DESCRIPTION	DATE


CLIENT: **SUMTER COUNTY BOARD OF COUNTY COMMISSIONERS**

PROJECT: **SUMTER COUNTY SOLID WASTE FACILITY**

DRAWING: **FORCE INFEEED/DISCHARGE PLAN**

1 of 1

Springstead Engineering, inc.

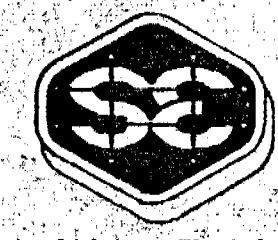

Consulting Engineers
Architects, Planners
Surveyors
EB-0001723
LB-0001723 AA-0002820
727 South 14th Street
Leesburg, FL 34748
(352) 787-1414

SCALE: 1" = 20'	FILE: INFEEED	DATE: 1/30/02
DESIGN: [Signature]	DRAWN: [Signature]	CHECKED: [Signature]

DRAWING: INFEEED/DISCHARGE PLAN

CLIENT: SCBCC

JOB NO.: 921100.015 SHEET: 1 OF: 1

OCT 08 2003