4041 Park Oaks Blvd. Suite 100 Tampa, FL 33610-9501

## SCS ENGINEERS

June 28, 2013 File No. 09199033.23

Mr. Steven G. Morgan Florida Department of Environmental Protection Southwest District Office 13051 North Telecom Parkway Temple Terrace, Florida 33637-0926

Subject: Estimate of Remaining Capacity and Life of Site Hardee County Landfill Phase II Section I Disposal Area Hardee County, Florida

Dear Mr. Morgan:

On behalf of the Hardee County Board of County Commissioners (BOCC), SCS Engineers (SCS) is pleased to submit the remaining capacity estimate and life of site estimate for the Hardee County Landfill Phase II Section I disposal area. The estimates of remaining capacity and life of site are being submitted in fulfillment of Specific Condition No. C.13.f of Operation Permit No. 38414-011-SO/01 for the Hardee County Landfill. As required by Specific Condition No. C.13.f of the Operations Permit, a full aerial topographic survey of the landfill was conducted on March 22, 2013 by Pickett & Associates, Inc. (Pickett). The Pickett survey was used for preparation of the calculations to estimate the remaining capacity and site life. Please refer to Attachment A for a copy of the March 22, 2013 Pickett aerial topographic survey and Survey Report.

## WASTE DISPOSAL PROJECTIONS

Hardee County supplied SCS with waste quantity records for April 2012 through March 2013. This information is provided in Attachment B and is also summarized in this section in Table 1. As shown in the waste quantity reports, the amount of waste disposed in the Phase II Section I disposal area is the total amount of residential, commercial, and construction and demolition waste materials minus the quantity of waste recycled in the Materials Recycling Facility.

SCS used the projected population estimates prepared by the Florida Legislative Office of Economic and Demographic Research (FLOEDR) for Hardee County to estimate the waste quantity disposal rate per capita for the period from April 2012 through March 2013. Using the FLOEDR population projections and the actual tonnages disposed in the Phase II Section I disposal area, SCS estimated a waste disposal tonnage per capita of approximately 0.586 tons per person.

TIME PERIOD (MONTHS)	WASTE DISPOSED OF IN CLASS I LANDFILL <sup>2</sup> (tons/month)	
April 12	1,399	
May 12	1,387	
June 12	1,674	
July 12	1,288	
August 12	1,286	
September 12	1,131	
October 12	1,423	
November 12	1,191	
December 12	1,346	
January 13	1,458	
February 13	1,299	
March 13	1,370	
Total	16,250	
Population <sup>1</sup>		27,725
Waste Tonnage Per Capita <sup>3</sup>		0.586

#### TABLE 1. WASTE DISPOSAL IN PHASE II SECTION I

Notes:

<sup>1</sup> Florida Legislative Office of Economic and Demographic Research

<sup>2</sup> Actual Waste Quantity disposed in landfill provided by Hardee County.

<sup>3</sup> Waste disposed based upon population.

## ESTIMATED REMAINING DISPOSAL CAPACITY AND SITE LIFE

To estimate the airspace volume utilized during the time period, SCS compared the aerial topographic survey conducted by Pickett dated March 22, 2013 with the previous aerial topographic survey conducted by Pickett dated April 3, 2012. The difference between the two topographies represents the airspace volume consumed for the recorded quantity of waste disposed by the County. Please refer to Attachment C for the airspace volume consumed drawing. Based on the difference of the two topographic surveys, approximately 27,698 CY of airspace was consumed for placement of 16,250 tons of waste. Based on these values, SCS estimated the in-place waste density to be approximately 43 pounds per cubic foot or approximately 1,173 pounds per cubic yard. Table 2 provided below represents the available and

Mr. Steven G. Morgan June 28, 2013 Page 3

consumed airspace based on the waste disposal tonnage per capita of approximately 0.586 tons per person as calculated from April 2012 through March 2013.

To estimate the remaining available airspace for placement of waste materials and daily cover soils, SCS compared the Phase II Section I disposal area build out through Sequence 7 of the Operations Plans with the aerial topographic survey conducted by Pickett dated March 22, 2013. The difference between the two topographies represents the remaining volume available for landfill operations as currently permitted. Please refer to Attachment D for the remaining volume estimate drawing. The gross remaining available airspace for placement of waste materials and daily cover soils was estimated to be 55,213 cubic yards (CY). SCS assumed that 5 percent of the gross available airspace would be used for daily cover material (2,761 CY) which would leave approximately 52,452 CY of airspace available in the Phase II Section I area for waste disposal.

TIME PERIOD	POPULATION	WASTE DISPOSED (tons) <sup>2</sup>	CUMULATIVE WASTE DISPOSED (tons/month)	AIRSPACE CONSUMED (CY)	CUMULATIVE AIRSPACE CONSUMED (CY)	AVAILABLE AIRSPACE (CY)
April 40 March 44	07.077	40.000		07.050		52,452
April 13 - March 14	,	16,339		27,850		24,602
April 14 - March 15	28,021	16,424		27,994		-3,392
April 14	28,021	1,369	1,369	2,333	2,333	22,269
May 14	28,021	1,369	2,737	2,333	4,666	19,937
June 14	28,021	1,369	4,106	2,333	6,998	17,604
July 14	28,021	1,369	5,475	2,333	9,331	15,271
August 14	28,021	1,369	6,843	2,333	11,664	12,938
September 14	28,021	1,369	8,212	2,333	13,997	10,605
October 14	28,021	1,369	9,581	2,333	16,330	8,273
November 14	28,021	1,369	10,949	2,333	18,663	5,940
December 14	28,021	1,369	12,318	2,333	20,995	3,607
January 15	28,021	1,369	13,686	2,333	23,328	1,274
February 15	28,021	1,369	15,055	2,333	25,661	-1,059

#### TABLE 2. AVAILABLE AND CONSUMED AIRSPACE

As shown in Table 2, SCS estimates the remaining available airspace in the Phase II Section I disposal area through Fill Sequence No. 7 will be exhausted by approximately mid February 2015. Please refer to Attachment E for a further breakdown of the site life calculations.

Mr. Steven G. Morgan June 28, 2013 Page 4

Please do not hesitate to call should you have any questions or require additional information.

Sincerely,

Shane R. Fischer, P.E. Project Manager SCS ENGINEERS

For di Hom

C. Ed Hilton, P.E. Vice President/Solid Waste Division Director SCS ENGINEERS

cc: Teresa Carver, Hardee County Solid Waste Director

Attachments

SRF/CEH:srf



### ATTACHMENT A

PICKETT & ASSOCIATES, INC. AERIAL TOPOGRAPHIC SURVEY March 22, 2013 AND SURVEY REPORT



NOTE: THIS REPORT AND ACCOMPANYING MAP TITLED HARDEE COUNTY LANDFILL ARE NOT FULL AND COMPLETE WITHOUT THE OTHER AND ARE NOT VALID WITHOUT THE SIGNATURE AND ORIGINAL RAISED SEAL OF A FLORIDA LICENSED SURVEYOR AND MAPPER

PICKETT & ASSOCIATES PROJECT NO.: 14198-11 TITLE/TYPE OF SURVEY: Topographic Survey DATE OF SURVEY: This Map is based on aerial data flown 3/22/13 SUBJECT: Hardee County Landfill CLIENT: Hardee County

**ACCURACY STATEMENT:** The following stated plus or minus tolerances encompass a minimum of 90% of the difference between photogrammetrically measured values and any ground truth of all well-identified features. Mapped features meet or exceed the Florida Minimum Technical Standards.

**VERTICAL:** Contours have been measured to an estimated vertical positional accuracy of 0.5'. Spot elevations and well-identified features have been measured to an estimated vertical positional accuracy of 0.25'.

**HORIZONTAL:** Well-identified features have been measured to an estimated horizontal positional accuracy of 1.66'.

**MAP PLOTTING:** This map is intended to be displayed at a scale of 1'' = 50' (1:600) or smaller.

#### DATUM:

**HORIZONTAL:** Coordinates are referenced to the West Zone of the Florida State Plane Coordinate System, NAD 83/90. Pickett & Associates provided the horizontal coordinates.

**VERTICAL:** Elevations are to National Geodetic Vertical Datum of 1929. Pickett & Associates provided the vertical elevations.

#### **Control Points Used:**

<u>Pt#</u>	Easting	Northing	Elevation
701	728524.20	1177590.85	85.66
703	728588.65	1174942.96	79.15
706	727169.10	1176229.17	83.19
708	725944.18	1177595.96	84.55
711	725819.93	1174927.65	79.04

## PICKETT & ASSOCIATES, INC.

#### **Feature List**

			LEGE	IND:	
	FEATURES ARE REPRESE BY SYMBOLS NOT TO S		(THESE FEATUR	RES ARE TO SCALE)	 PIPELINE RECREATION EDGE OF GROVE
<ul> <li>△ CONTROL</li> <li>PT# TARGET NUMBER</li> <li>N NORTHING</li> <li>E EASTING</li> <li>EL ELEVATION</li> <li>-O- UTILITY POLE</li> <li>☆ LIGHT POLE</li> <li>△ SIGN</li> <li>-Ò- TRAFFIC LIGHT</li> <li>○ POST</li> <li>♥ VALVE</li> </ul>	MAIL BOX —) GUYWIRE (MANHOLE (MANHOLE	TREE PALM SHRUB SWAMP/MARSH TOWER		PAVED SURFACE CONCRETE SURFACE UNPAVED ROAD FENCE GUARDRAIL WALL RAILROAD STRUCTURE TREE LINE SHRUB LINE	EDGE OF WATER SWAMPLINE OBSCURED CONTOUR DEPRESSION CONTOUR RMATIVE LABELS IOT SCALE DEPENDENT) WATER ELEVATION SPOT ELEVATION OBSCURED SPOT MISCELLANEOUS

------

#### **Measurement Methods:**

This map is limited to those features visible on aerial imagery. Color digital imagery was acquired at an altitude of 3000' using a metric precision digital camera whose focal length is 70.3mm. Mapping was performed using LiDAR and softcopy photogrammetric techniques. The LiDAR data for the final ground surface has a Ground Sample Distance of 0.92 foot and a density of 1.19 points per square foot (±13 points per square meter). For a vertical accuracy check, the LiDAR data was compared to five (5) points set as targets for aerial imagery. The Root Mean Square Error of the Elevations (RMSEZ) is 0.06 foot, being the equivalent of 0.2' FGDC/NSSDA Vertical Accuracy. All measurements are in U.S. Survey Feet.

#### Limitations:


This mapping should be used for preliminary design work only and should not replace an actual field survey where the required accuracy is greater than the accuracy stated in this report. No responsibility is assumed for areas outside the contracted scope.


T. JEFFREY YOUNG, PSM, CP FLORIDA REGISTRATION NO. 5440 PICKETT AND ASSOCIATES, INC. FLORIDA REGISTRATION NO. 364

3 22

SURVEY DATE



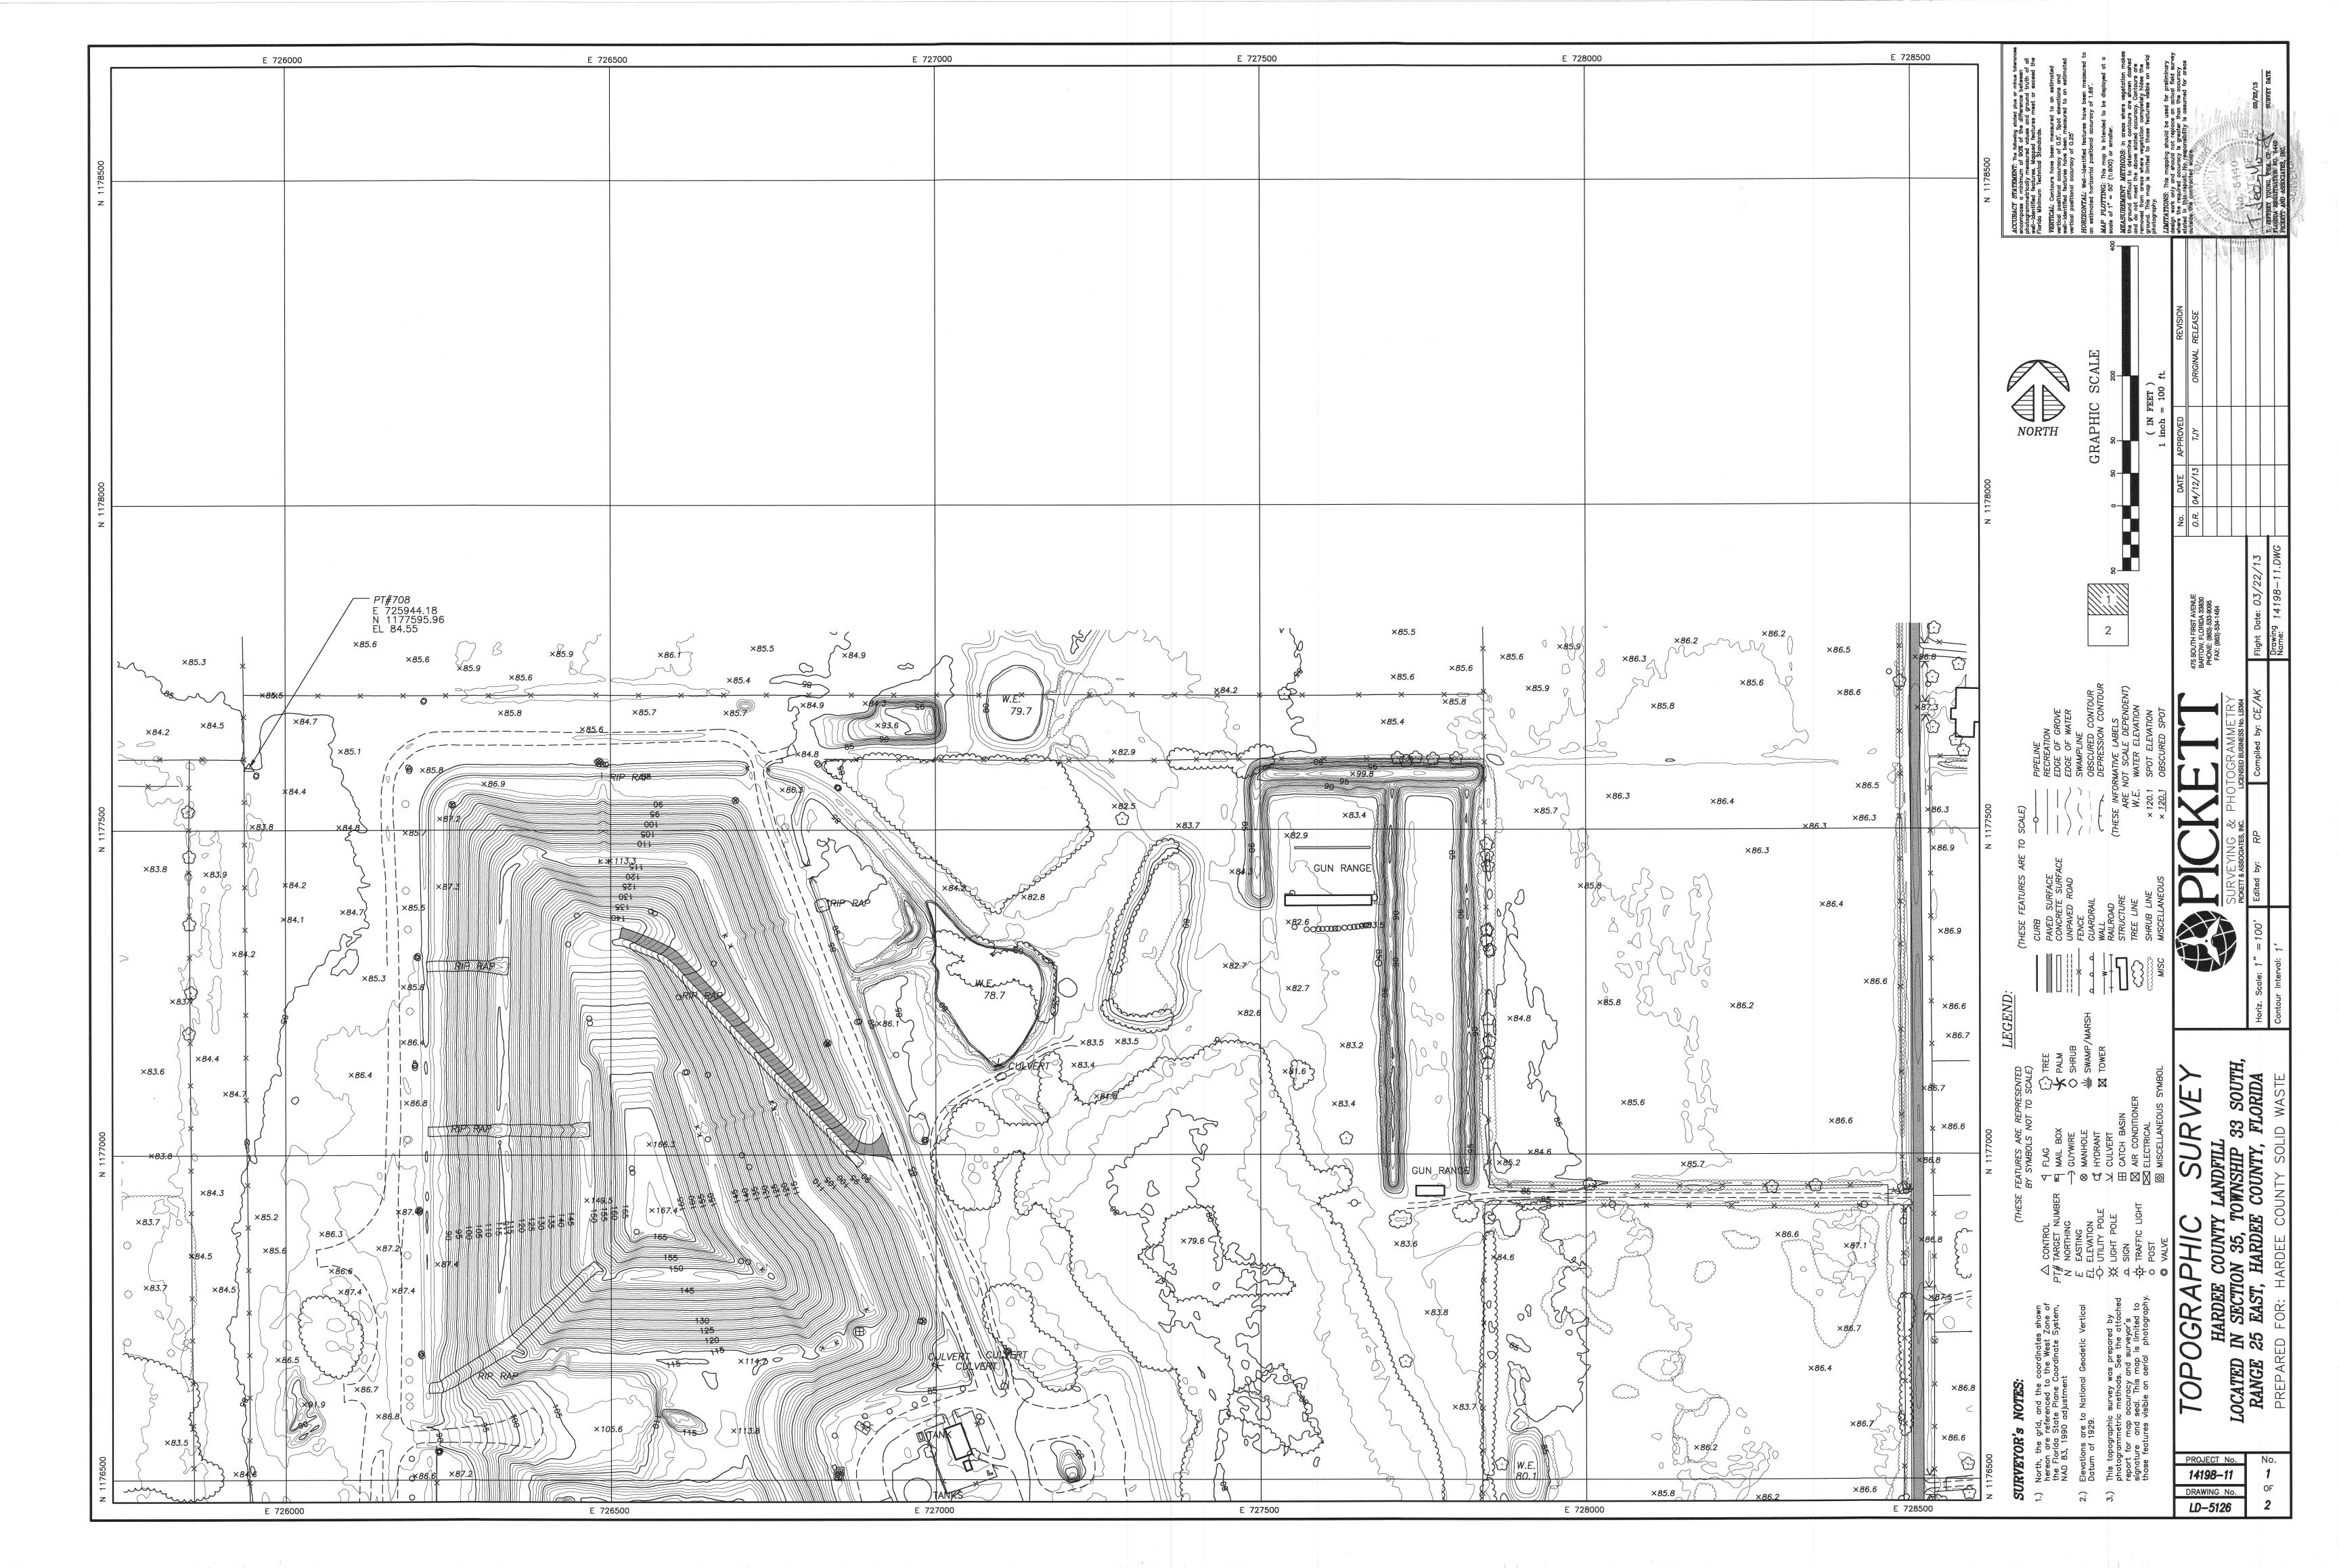

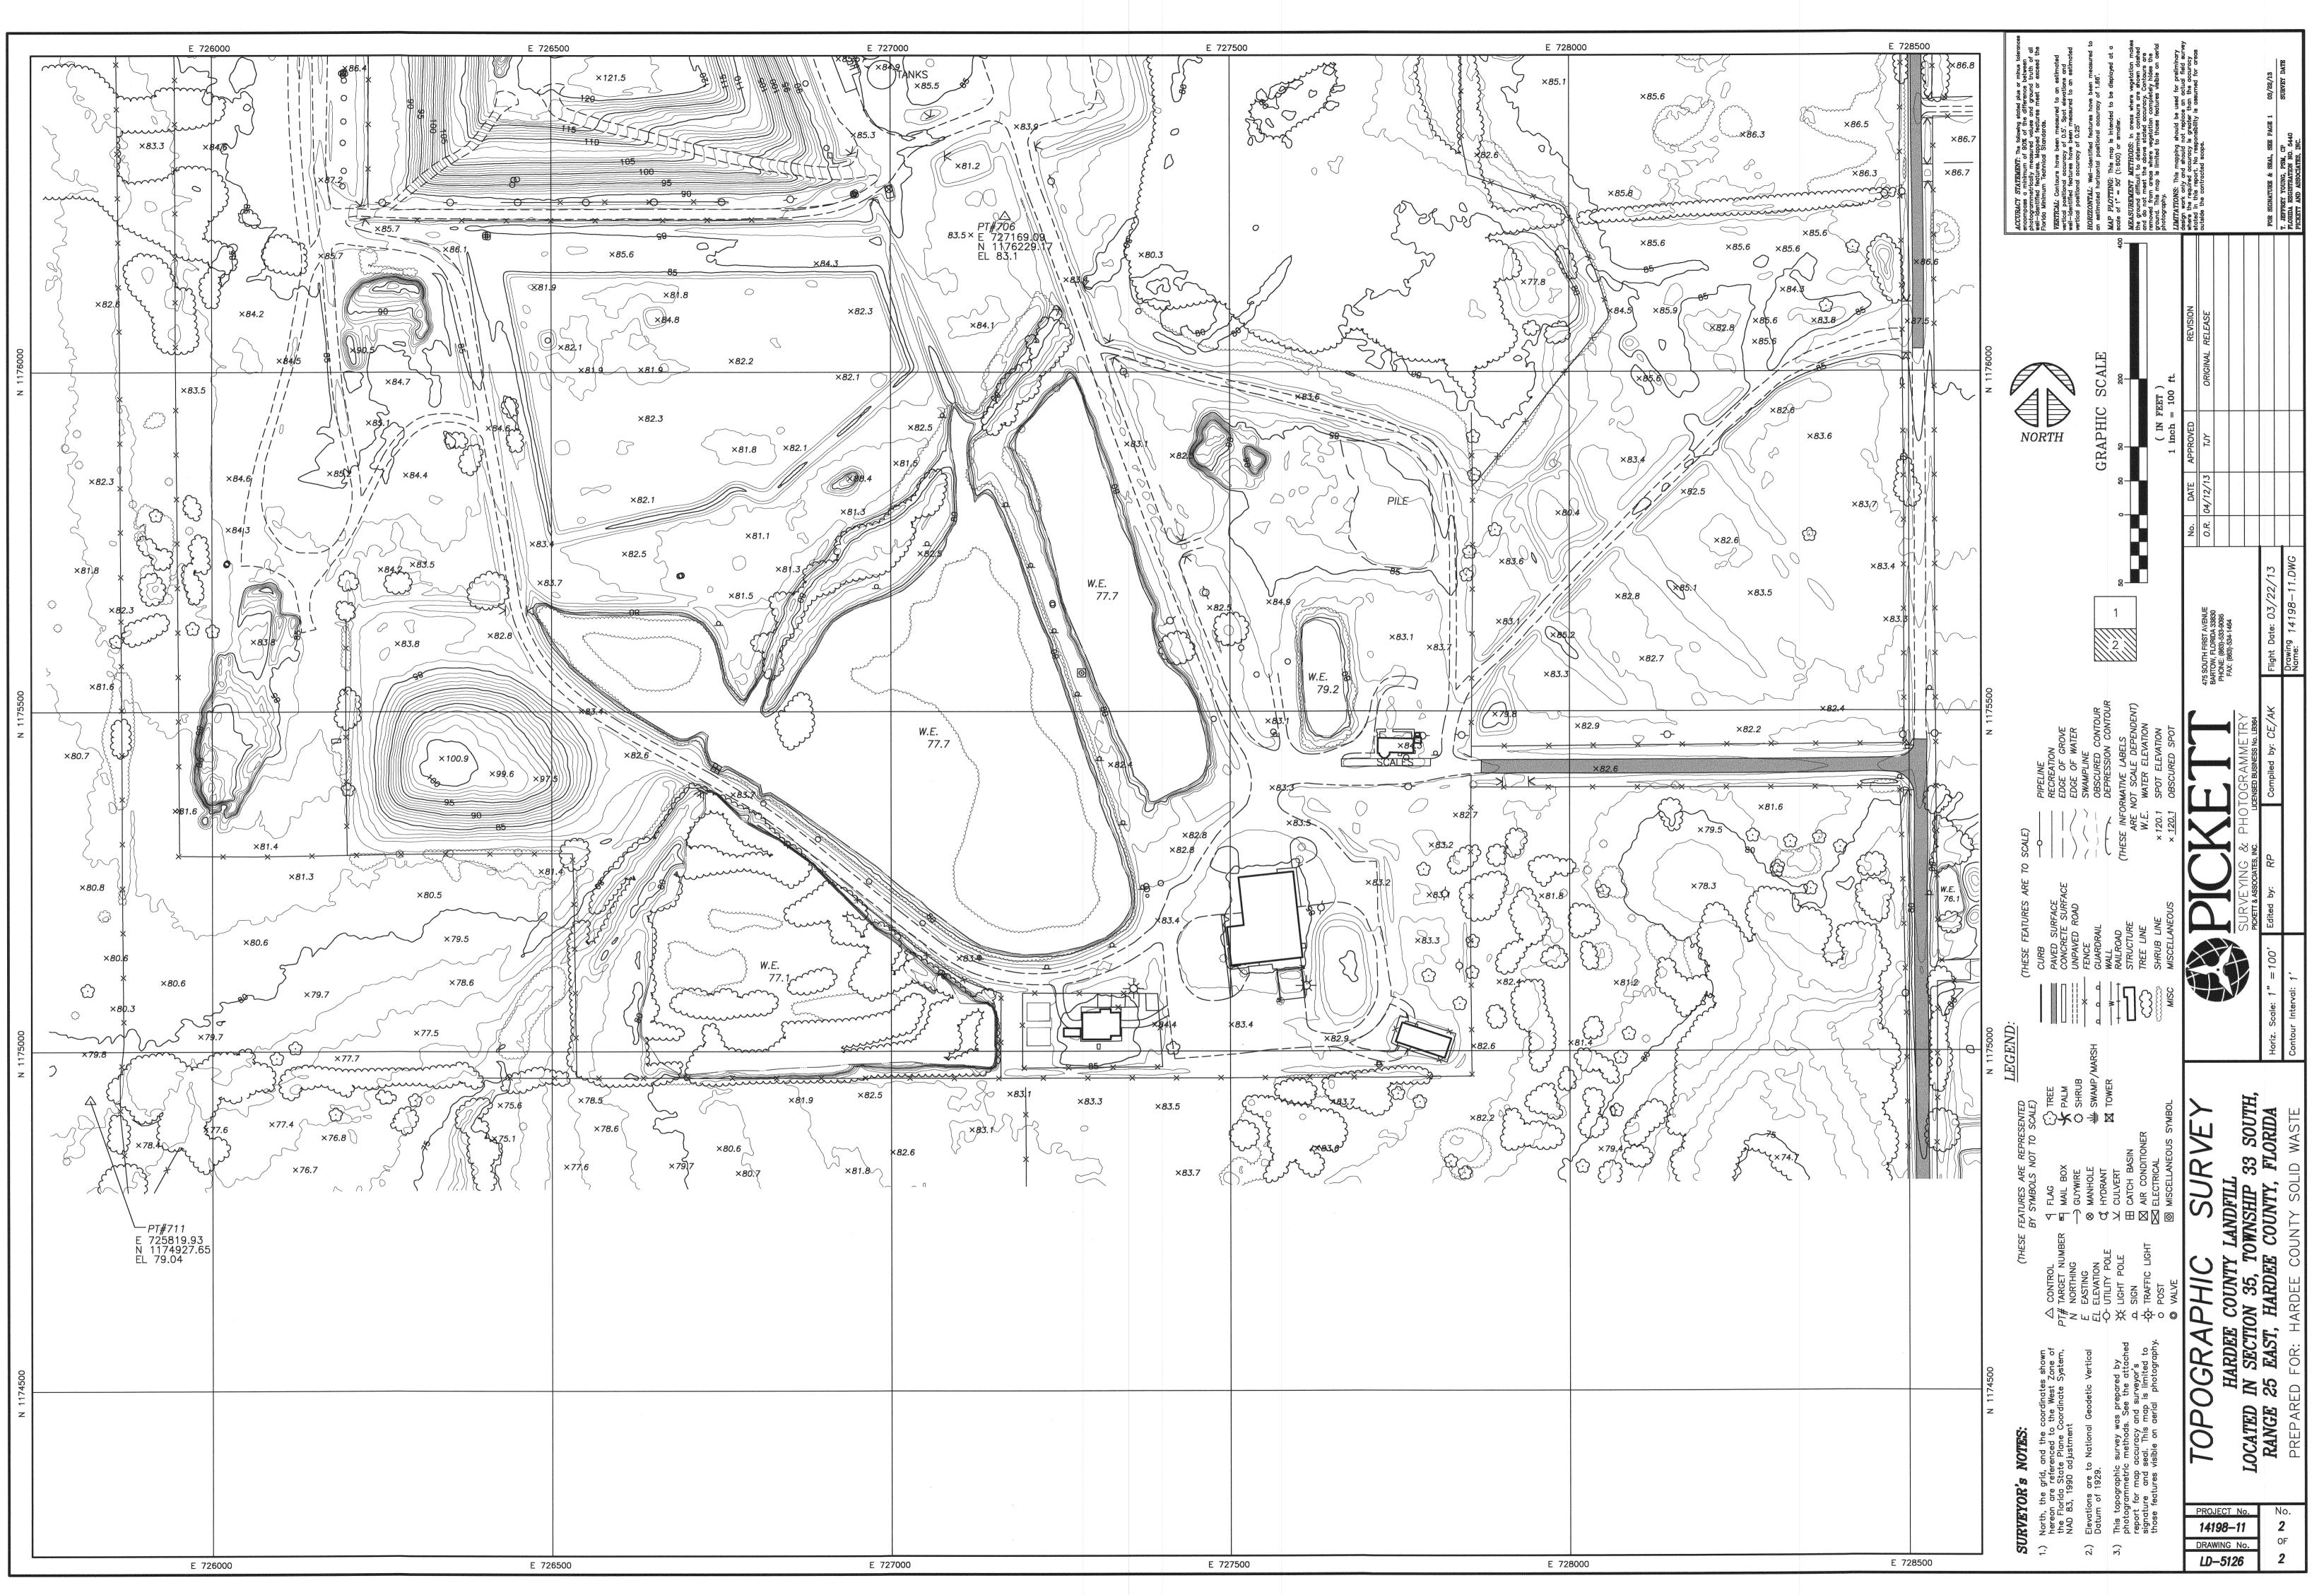

96 - Y


### ATTACHMENT B

APRIL 2012 THROUGH MARCH 2013 WASTE QUANTITY REPORTS HARDEE COUNTY LANDFILL

				SCS	ENGINEERS				
							SHEET	1	OF
CLIENT					PROJECT			JOB NO.	
Hardee County					Site Life Estima	tes		09199033.24	
SUBJECT							BY		DATE
Site Life Estima	tes			SRF		6/28/13			
Vaste Quantity	Reports						CHECKED		DATE
Reported in Tor	าร								
	RIOD								
MONTH	RESIDENTIAL	COMMERCIAL	CONSTRUCTION AND DEMOLITION DEBRIS	WOOD AND YARD WASTE	SCRAP METAL	TIRES	TOTAL		
Apr-12	681.69	736.94	8.65	86.54	2.19	15.35	1531.36		
May-12	722.05	663.39	12.04	100.88	1.44	9.88	1509.68	1	
Jun-12	871.57	795.35	18.07	59.27	5.30	17.70	1767.26	1	
Jul-12	668.34	603.23	21.87	97.00	1.09	41.86	1433.39	1	
Aug-12	647.35	634.49	16.76	93.82	4.10	12.08	1408.60	1	
Sep-12	538.70	569.10	23.46	88.35	0.79	10.29	1230.69	1	
Oct-12	692.85	727.23	16.32	68.01	1.99	17.88	1524.28		
Nov-12	646.34	588.69	10.42	59.52	2.21	8.50	1315.68		
Dec-12	700.28	646.19	15.54	22.82	0.50	17.69	1403.02		
Jan-13	700.18	757.42	13.10	104.79	2.22	7.63	1585.34		
Feb-13	646.98	619.59	32.43	93.08	0.51	8.12	1400.71		
Feb-13 Mar-13	646.98 645.04	619.59 708.73	32.43 24.58	93.08 83.73	0.51 0.33	8.12 11.15	1400.71 1473.56		
Mar-13									
Mar-13	645.04	708.73	24.58	83.73	0.33	11.15	1473.56		
Mar-13	645.04	708.73 8050.35	24.58	83.73 957.81	0.33	11.15 178.13	1473.56	WASTE TIRES REMOVED	
Mar-13 OTAL	645.04 8161.37 PROCESSED THROUGH	708.73 8050.35 BALED WASTE DISPOSED OF	24.58 213.24 LOOSE WASTE DISPOSED OF IN	83.73 957.81 TOTAL WASTE DISPOSED OF	0.33 22.67 RECYCLED THROUGH	11.15 178.13 SCRAP METAL	1473.56 17583.57 WOOD AND YARD TRASH	REMOVED FOR	
Mar-13 OTAL MONTH	645.04 8161.37 PROCESSED THROUGH MRF	708.73 8050.35 BALED WASTE DISPOSED OF IN CLASS I	24.58 213.24 LOOSE WASTE DISPOSED OF IN CLASS I	83.73 957.81 TOTAL WASTE DISPOSED OF IN CLASS I	0.33 22.67 RECYCLED THROUGH MRF	11.15 178.13 SCRAP METAL RECYCLED	1473.56 17583.57 WOOD AND YARD TRASH PROCESSED	REMOVED FOR RECYCLING	
Mar-13 OTAL MONTH Apr-12	645.04 8161.37 PROCESSED THROUGH MRF 28.67	708.73 8050.35 BALED WASTE DISPOSED OF IN CLASS I 0.00	24.58 213.24 LOOSE WASTE DISPOSED OF IN CLASS I 1398.61	83.73 957.81 TOTAL WASTE DISPOSED OF IN CLASS I 1398.61	0.33 22.67 RECYCLED THROUGH MRF 28.67	11.15 178.13 SCRAP METAL RECYCLED 0.00	1473.56 17583.57 WOOD AND YARD TRASH PROCESSED 900.64	REMOVED FOR RECYCLING 6.48	
Mar-13 DTAL MONTH Apr-12 May-12	645.04 8161.37 PROCESSED THROUGH MRF 28.67 10.09	708.73 8050.35 BALED WASTE DISPOSED OF IN CLASS I 0.00 0.00	24.58 213.24 LOOSE WASTE DISPOSED OF IN CLASS I 1398.61 1387.39	83.73 957.81 TOTAL WASTE DISPOSED OF IN CLASS I 1398.61 1387.39	0.33 22.67 RECYCLED THROUGH MRF 28.67 10.09	11.15 178.13 SCRAP METAL RECYCLED 0.00 0.00	1473.56 17583.57 WOOD AND YARD TRASH PROCESSED 900.64 0.00	REMOVED FOR RECYCLING 6.48 11.66	
Mar-13 DTAL MONTH Apr-12 May-12 Jun-12	645.04 8161.37 PROCESSED THROUGH MRF 28.67 10.09 11.44	708.73 8050.35 BALED WASTE DISPOSED OF IN CLASS I 0.00 0.00 0.00	24.58 213.24 LOOSE WASTE DISPOSED OF IN CLASS I 1398.61 1387.39 1673.55	83.73 957.81 DISPOSED OF IN CLASS I 1398.61 1387.39 1673.55	0.33 22.67 RECYCLED THROUGH MRF 28.67 10.09 11.44	11.15 178.13 SCRAP METAL RECYCLED 0.00 0.00 0.00	1473.56 17583.57 WOOD AND YARD TRASH PROCESSED 900.64 0.00 0.00	REMOVED FOR RECYCLING 6.48 11.66 12.21	
Mar-13 OTAL MONTH Apr-12 May-12 Jun-12 Jun-12	645.04 8161.37 PROCESSED THROUGH MRF 28.67 10.09 11.44 5.83	708.73 8050.35 BALED WASTE DISPOSED OF IN CLASS I 0.00 0.00 0.00 0.00	24.58 213.24 LOOSE WASTE DISPOSED OF IN CLASS I 1398.61 1387.39 1673.55 1287.61	83.73 957.81 TOTAL WASTE DISPOSED OF IN CLASS I 1398.61 1387.39 1673.55 1287.61	0.33 22.67 RECYCLED THROUGH MRF 28.67 10.09 11.44 5.83	11.15 178.13 SCRAP METAL RECYCLED 0.00 0.00 0.00 0.00	1473.56 17583.57 WOOD AND YARD TRASH PROCESSED 900.64 0.00 0.00 0.00	REMOVED FOR RECYCLING 6.48 11.66 12.21 15.39	
Mar-13 OTAL MONTH Apr-12 May-12 Jun-12 Jul-12 Aug-12	645.04 8161.37 PROCESSED THROUGH MRF 28.67 10.09 11.44 5.83 12.29	708.73 8050.35 BALED WASTE DISPOSED OF IN CLASS I 0.00 0.00 0.00 0.00 0.00	24.58 213.24 LOOSE WASTE DISPOSED OF IN CLASS I 1398.61 1387.39 1673.55 1287.61 1286.31	83.73 957.81 TOTAL WASTE DISPOSED OF IN CLASS I 1398.61 1387.39 1673.55 1287.61 1286.31	0.33 22.67 RECYCLED THROUGH MRF 28.67 10.09 11.44 5.83 12.29	11.15 178.13 SCRAP METAL RECYCLED 0.00 0.00 0.00 0.00 0.00	1473.56 17583.57 WOOD AND YARD TRASH PROCESSED 900.64 0.00 0.00 0.00 0.00	REMOVED FOR RECYCLING 6.48 11.66 12.21 15.39 11.61	
Mar-13 OTAL MONTH Apr-12 Jun-12 Jul-12 Jul-12 Aug-12 Sep-12	645.04 8161.37 PROCESSED THROUGH MRF 28.67 10.09 11.44 5.83 12.29 0.00	708.73 8050.35 BALED WASTE DISPOSED OF IN CLASS I 0.00 0.00 0.00 0.00 0.00 0.00	24.58 213.24 LOOSE WASTE DISPOSED OF IN CLASS I 1398.61 1387.39 1673.55 1287.61 1286.31 1131.26	83.73 957.81 TOTAL WASTE DISPOSED OF IN CLASS I 1398.61 1387.39 1673.55 1287.61 1286.31 1131.26	0.33 22.67 RECYCLED THROUGH MRF 28.67 10.09 11.44 5.83 12.29 0.00	11.15 178.13 SCRAP METAL RECYCLED 0.00 0.00 0.00 0.00 0.00 0.00	1473.56 17583.57 WOOD AND YARD TRASH PROCESSED 900.64 0.00 0.00 0.00 0.00 0.00	REMOVED FOR RECYCLING 6.48 11.66 12.21 15.39 11.61 11.86	
Mar-13 OTAL MONTH Apr-12 Jun-12 Jun-12 Jul-12 Aug-12 Sep-12 Oct-12	645.04 8161.37 PROCESSED THROUGH MRF 28.67 10.09 11.44 5.83 12.29 0.00 13.67	708.73 8050.35 BALED WASTE DISPOSED OF IN CLASS I 0.00 0.00 0.00 0.00 0.00 0.00 0.00	24.58 213.24 LOOSE WASTE DISPOSED OF IN CLASS I 1398.61 1387.39 1673.55 1287.61 1286.31 1131.26 1422.73	83.73 957.81 TOTAL WASTE DISPOSED OF IN CLASS I 1398.61 1387.39 1673.55 1287.61 1286.31 1131.26 1422.73	0.33 22.67 RECYCLED THROUGH MRF 28.67 10.09 11.44 5.83 12.29 0.00 13.67	11.15 178.13 SCRAP METAL RECYCLED 0.00 0.00 0.00 0.00 0.00 0.00 0.00 0.	1473.56 17583.57 WOOD AND YARD TRASH PROCESSED 900.64 0.00 0.00 0.00 0.00 0.00	REMOVED FOR RECYCLING 6.48 11.66 12.21 15.39 11.61 11.86 27.28	
Mar-13 OTAL MONTH Apr-12 Jun-12 Jun-12 Jun-12 Jun-12 Jun-12 Sep-12 Oct-12 Nov-12	645.04 8161.37 PROCESSED THROUGH MRF 28.67 10.09 11.44 5.83 12.29 0.00 13.67 54.58	708.73 8050.35 BALED WASTE DISPOSED OF IN CLASS I 0.00 0.00 0.00 0.00 0.00 0.00 0.00 0.	24.58 213.24 LOOSE WASTE DISPOSED OF IN CLASS I 1398.61 1387.39 1673.55 1287.61 1286.31 1131.26 1422.73 1190.87	83.73 957.81 TOTAL WASTE DISPOSED OF IN CLASS I 1398.61 1387.39 1673.55 1287.61 1286.31 1131.26 1422.73 1190.87	0.33 22.67 RECYCLED THROUGH MRF 28.67 10.09 11.44 5.83 12.29 0.00 13.67 54.58	11.15 178.13 SCRAP METAL RECYCLED 0.00 0.00 0.00 0.00 0.00 0.00 0.00 0.	1473.56 17583.57 WOOD AND YARD TRASH PROCESSED 900.64 0.00 0.00 0.00 0.00 0.00 0.00 0.00	REMOVED FOR RECYCLING 6.48 11.66 12.21 15.39 11.61 11.86 27.28 11.19	
Mar-13 OTAL MONTH Apr-12 May-12 Jun-12 Jun-12 Jun-12 Sep-12 Oct-12 Nov-12 Dec-12	645.04 8161.37 PROCESSED THROUGH MRF 28.67 10.09 11.44 5.83 12.29 0.00 13.67 54.58 16.18	708.73 8050.35 BALED WASTE DISPOSED OF IN CLASS I 0.00 0.00 0.00 0.00 0.00 0.00 0.00 0.	24.58 213.24 LOOSE WASTE DISPOSED OF IN CLASS I 1398.61 1387.39 1673.55 1287.61 1286.61 1286.31 1131.26 1422.73 1190.87 1345.83	83.73 957.81 TOTAL WASTE DISPOSED OF IN CLASS I 1398.61 1387.39 1673.55 1287.61 1286.31 1131.26 1422.73 1190.87 1345.83	0.33 22.67 RECYCLED THROUGH MRF 28.67 10.09 11.44 5.83 12.29 0.00 13.67 54.58 16.18	11.15 178.13 SCRAP METAL RECYCLED 0.00 0.00 0.00 0.00 0.00 0.00 0.00 0.	1473.56 17583.57 WOOD AND YARD TRASH PROCESSED 900.64 0.00 0.00 0.00 0.00 0.00 0.00 0.00	REMOVED FOR RECYCLING 6.48 11.66 12.21 1.5.39 11.61 11.86 27.28 11.19 11.52	
Mar-13 OTAL MONTH Apr-12 May-12 Jun-12 Jun-12 Jul-12 Aug-12 Sep-12 Oct-12 Nov-12 Dec-12 Jan-13	645.04 8161.37 PROCESSED THROUGH MRF 28.67 10.09 11.44 5.83 12.29 0.00 13.67 54.58 16.18 13.15	708.73 8050.35 BALED WASTE DISPOSED OF IN CLASS I 0.00 0.00 0.00 0.00 0.00 0.00 0.00 0.	24.58 213.24 LOOSE WASTE DISPOSED OF IN CLASS I 1398.61 1387.39 1673.55 1287.61 1286.31 1131.26 1422.73 1190.87 1345.83 1457.55	83.73 957.81 TOTAL WASTE DISPOSED OF IN CLASS I 1398.61 1387.39 1673.55 1287.61 1286.31 1131.26 1422.73 1190.87 1345.83 1457.55	0.33 22.67 RECYCLED THROUGH MRF 28.67 10.09 11.44 5.83 12.29 0.00 13.67 54.58 16.18 13.15	11.15 178.13 SCRAP METAL RECYCLED 0.00 0.00 0.00 0.00 0.00 0.00 0.00 0.	1473.56 17583.57 WOOD AND YARD TRASH PROCESSED 900.64 0.00 0.00 0.00 0.00 0.00 0.00 0.00	REMOVED FOR RECYCLING 6.48 11.66 12.21 1.5.39 11.61 11.86 27.28 11.19 11.52 11.52	
Mar-13 OTAL MONTH Apr-12 May-12 Jun-12 Jun-12 Jun-12 Sep-12 Oct-12 Nov-12 Dec-12	645.04 8161.37 PROCESSED THROUGH MRF 28.67 10.09 11.44 5.83 12.29 0.00 13.67 54.58 16.18	708.73 8050.35 BALED WASTE DISPOSED OF IN CLASS I 0.00 0.00 0.00 0.00 0.00 0.00 0.00 0.	24.58 213.24 LOOSE WASTE DISPOSED OF IN CLASS I 1398.61 1387.39 1673.55 1287.61 1286.61 1286.31 1131.26 1422.73 1190.87 1345.83	83.73 957.81 TOTAL WASTE DISPOSED OF IN CLASS I 1398.61 1387.39 1673.55 1287.61 1286.31 1131.26 1422.73 1190.87 1345.83	0.33 22.67 RECYCLED THROUGH MRF 28.67 10.09 11.44 5.83 12.29 0.00 13.67 54.58 16.18	11.15 178.13 SCRAP METAL RECYCLED 0.00 0.00 0.00 0.00 0.00 0.00 0.00 0.	1473.56 17583.57 WOOD AND YARD TRASH PROCESSED 900.64 0.00 0.00 0.00 0.00 0.00 0.00 0.00	REMOVED FOR RECYCLING 6.48 11.66 12.21 1.5.39 11.61 11.86 27.28 11.19 11.52	

## ATTACHMENT C

DRAWING 1 OF 2 VOLUME CONSUMED 3/22/13 SURVEY TO 4/03/12 SURVEY

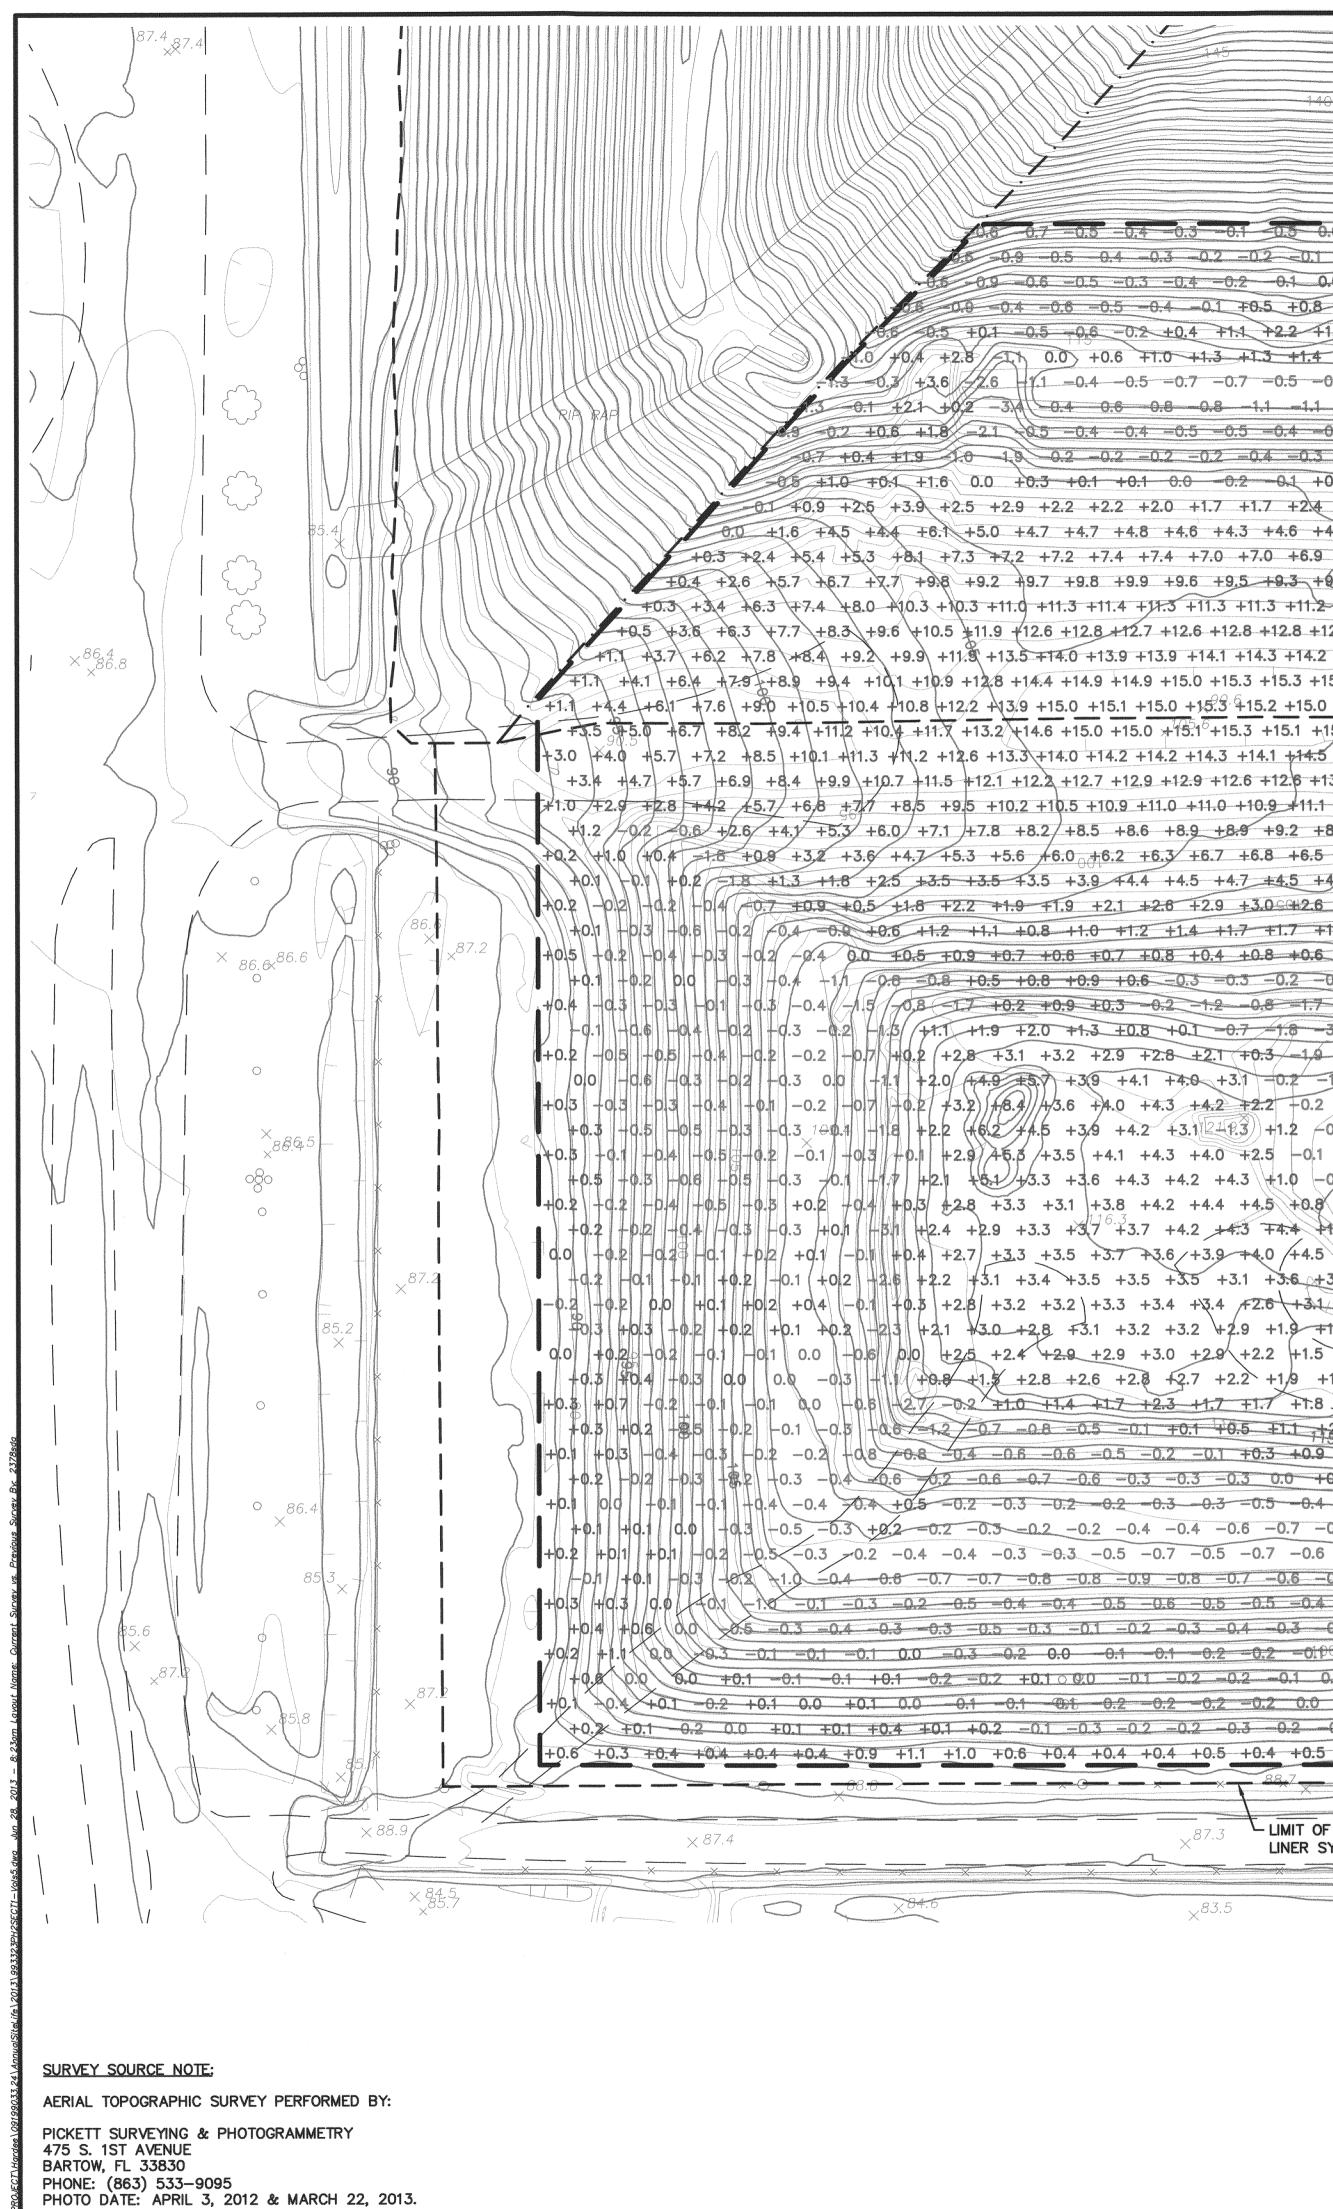


+0.2 -0.3 -0.2 -0.2 -0.4 -0.2 -0.1 -0.3 -0.5 -0.3 -0.2 0.0-0.5 -0.5 -0.4 +0.1 +1.0 +0.4 +0.5 +0.2 -0.2 +0.3 +22+1.3+0.4-0.2-0.3-0.0+0.7 +0.8 +0.3 0.0 -0.4 -0.3 +1.0 +1.3 +1.3 +1.4 +0.5 0.0 =0.3 -0.4 -0.1 -0.4 -0.2 -0.2 -0.7 -0.7 -0.7 -0.7 -0.6 -0.6 +0.3 -0.8× -0.2 +0.3 +0.8 +1.0 +1.1 +1.4 +0 -0.4 -0.4 -0.5 -0.5 -0.4 -0.3 -0.8 -0.3 +0.8 +1.4 +1.9 +1.8 +1.8 +1.8 +1.8 +1.7 +1.8 +2.7 +2.9 +2.5 +2.2 +2.0 +1.5 +1.0 +0.1 +1.6 0.0 +0.3 +0.1 +0.1 0.0 -0.2 -0.1 +0.5 +1.2 +2.8 +4.5 +5.8 +6.7 +7.0 +6.9 +7.2 +6.9 +6.8 +6.8 +7.6 +6.7 +7.1 +2.7 +2.3 +1.2 10.9 +2.5 +3.9 +2.5 +2.9 +2.2 +2.2 +2.2 +2.0 +1.7 +1.7 +2.4 +2.8 +4.2 +6.105+7.9 +8.9 +9.4 +9.5 +9.7 +9.4 +9.3 +9.6 +9.3 +6.3 +4.5 +3.9 +3.3 0.0 +1.6 +4.5 +4.4 +6. +5.0 +4.7 +4.7 +4.8 +4.6 +4.3 +4.6 +4.8 +4.9 +5.2 +10.0 +11.3 +11.7 +11.9 +11.9 +11.9 +11.9 +12.0 +11.8 +17.9 + 9.2 +6.8 +5.8 +4.6 +1.5 +0.3 +2.4 +5.4 +5.3 +8.1 +7.3 +7.2 +7.2 +7.4 +7.4 +7.0 +7.0 +6.9 +6.7 +6.9 +6.7 +6.9 +6.7 +4.3 +14.3 +14.2 +13.9 +13.9 +13.9 +14.0 +14.3 +14.5 +12.5 +9.3 +8.3 +6.6 +4.3 +0.4 +2.6 +5.7 +6.7 +7.7 +9.8 +9.2 +9.7 +9.8 +9.9 +9.6 +9.5 +9.3 +9.2 +9.1 +9.7 #16.0 +16.8 +16.5 +16.1 +16.0 +15.8 +16.2 +16.6 +15.6 +17.6 +10.7 +9.3 /+7.0 +2.8 +0.3 +3.4 +6.3 +7.4 +8.0 +10.3 +10.3 +11.0 +11.3 +11.4 +11.3 +11.3 +11.2 +11.0 +18.9 +18.7 +18.3 +18.0 +17.9 +18.0 +18.3 +18.4 +14.6 +12.5 +12.0 +9.0 +5.8 +0.5 +3.6 +6.3 +7.7 +8.3 +9.6 +10.5 +11.9 +12.6 +12.8 +12.7 +12.6 +12.8 +12.7 +12.7 +12.7 +12.9 +20.4 +21.2 +20.8 +20.5 +20.1 +20.1 +19.8 +20.1 +20.9 +18.5 +14.6 +14.2 +11.6 /+8.3 /+3.4 +1.1 +3.7 +6.2 +7.8 +8.4 +9.2 +9.9 +11.9 +13.5 +14.0 +13.9 +13.9 +13.9 +14.1 +14.3 +14.2 +14.4 +14.3)+10.11 +26.2 +27.2 +24.8 +22.4 +22.4 +22.4 +22.4 +22.0 +22.3 +22.0 +17.8 +16.0 +14.4 +10.9 +6.1 +4.1 +6.4 +7.9 ++8.9 +9.4 +10.1 +10.9 +12.8 +14.4 +14.9 +14.9 +15.0 +15.3 +15.2 +15.1 +15.7 +15.2 +15.1 +23.8 +23.5 +23.8 +23.5 +23.1 +23.0 +24.0 +20.9 +17.5 +16.8 +13.4 +9.2 +3.1 +4.4 ++6.1 +7.6 +9.0 +10.5 +10.4 +10.8 +12.2 +13.9 +15.0 +15.1 +15.0 +15.3 +15.2 +15.0 +15.2 +15.7 +15.7 +15. +3.5 +5.0 +6.7 +82 +9.4 +11.2 +10.4 +11.2 +10.4 +11.2 +10.4 +11.2 +10.4 +11.2 +10.4 +15.0 +15.0 +15.1 +15.7 +18.3 +21.0 +25.8 +25.9 +25.4 +23.5 +23.3 +23.1 +23.6 +21.0 +17.7 +17.0 +13.5 +9.3 +3 +5.7 + 7.2 +8.5 +10.1 +11.3 +11.2 +12.6 +13.3 +14.0 +14.2 +14.2 +14.2 +14.3 +14.1 +14.5 +15.1 +16.5 +18.7 +20.5 +22.0 +22.75+23.2 +22.8 +22.3 +22.1 +22.3 +21.7 +18.1 +16.1 +14.8 +11.3 +7.3 +4.7 +5.7 +6.9 +8.4 +9.9 +10.7 +11.5 +12.1 +12.2 +12.7 +12.9 +12.9 +12.6 +13.0 +14.8 +16.7 +18.9 +19.6 +20.6 +20.9 +20.4 +20.1 +20.3 +20.8 +18.5 +14.8 +14.3 +14.6 +8.2 +1.0 /+2.9 +2.8 +42 /5.7/ +6,8 +7/7 +8,5 +9.5 +10.2 +10.5 +10.9 +11.0 +11.0 +10.9 +11.1 +11.4 +16.4 +17.7 +17.9 +18.3 +18.4 +17.8 +18.3 +18.1 +18.2 +14.7 +12.1 +11.7 +8.0 +1.2 1-0.2 -0.6 +2.6 +4.1 +5.3 +6.0 +7.1 +7.8 +8.2 +8.5 +8.6 +8.9 +9.2 +8.7 +10.6 +12.9 +15.1 +15.1 +15.1 +15.7 +16.0 +15.7 +16.0 +15.7 +16.1 +14.5 +11.3 +10.2 +8.3 -1.8 +0.8 +3.2 +3.6 +4.7 +5.3 +5.6 +6.0 +6.2 +6.3 +6.7 +6.8 +6.5 +6.8 +9.2 +11.4 +12.8 +12.9 +13.0 +13.1 +13.4 +13.1 +13.0 +13.5 +10.4 +7.6 +7.1 +4.2 0.2 -18 +1.3 +1.8 +2.5 +3.5 +3.5 +3.5 +3.5 +3.5 +3.5 +3.9 +4.4 +4.5 +4.7 +4.5 +4.0 +5.6 +7.8 +9.4 +9.8 +10.1 +10.0 +10.2 +10.6 +10.6 10.7 ±0.9 ±0.5 ±1.8 ±2.2 ±1.9 ±1.9 ±2.1 ±2.8 ±2.9 ±3.0 ±4.3/±6,0 ±7.2 ±7.1 ±7.1 ±7.3 ±7.7 ±7.8 ±8.0 ±7.8 ±8.5 ±6.4 ±3.2 ±2.6 ±0.5 FO.4 -0.9 +0.6 +1.2 +1.1 +0.8 +1.0 +1.2 +1.4 +1.7 +1.7 +1.3 +2.0 +3.1 +3.9 +4.1 +4.6 +4.5 +4.7 +5.0 +5.1 +5.0 +5.1 +5.0 +5.3 +2.5 0.0 +0.5 +0.9 +0.7 +0.6 +0.7 +0.8 +0.4 +0.8 +0.6 -0.3 -1.0 /+0.4 +0.8 +1.1 /+1.8 +1.7 +1.6 +2.0 +2.4 +2.9 +3.8 +1.7 -0.8 -0.8 +0.5 +0.8 +0.9 +0.6 -0.3 -0.2 -0.8 -1.9 -2.2 -1.5 -1.4 -0.5 -0.2 -0.7 -0.8 -0.2 +0.5 +1.2 +1.2 +0.2 +0.9 +0.3 -0.2 -1.2 -0.8 = 17 -25 -47 -31 -26 -22 -20 -2.3 -24 -24 -1.9 -11 +1.1 +1.9 +2.0 +1.3 +0.8 +0.1 -0.7 -1.8 -3.0 -2.8 -4.3 =4.7 -3.1 = 3.2 -3.3 -3.2 -3.5 -3.5 -3.2 -2.3 -1.4 (+2,8 +3.1 +3.2 +2.9 +2.8 +2.1 +0.3 -1.9 -2.4 -2.4 -3.5 - 6.0 = 6.0 +4.5 -2.8 -2.9 -3.2 -3.1 -2.1 -1.3 2.0 + 4.9 + 5.7 + 3.9 + 4.1 + 4.9 + 3.1 = 0.2 = 1.1 - 1.2 - 2.1 + 4.0 = 1.6 - 3.4 - 1.4 - 1.2 = 1.8 - 2.1 - 1.9 = 1.5-0.7 +0.2 +3.2 +8.4 //4/3.6 +4.0 +4.3 +4.2 +2.2 +0.2 -0.2 -0.3 -1.2 -1.5 -1.2 -1.0 +0.8 -1.1 -1.3 -1.5 -1.4 +1.6 -1.9 +1.6 +1.6 +1.6+0.3 +0.1 +2.9 +5.5 +4.1 +4.3 +4.0 +2.5 -0.1 -0.9 -0.7 -1.3 -1.1 +1.2 +1.2 -1.3 -1.5 -1.6 -1.8 +2.0 +1.5 +0.7 +0.7 +0.1 +0.6 +1.7 +2.1 +3.3 +3.6 +4.3 +4.2 +4.3 +1.0 -0.9 -0.9 -1.2 -1.2 -1.2 -1.2 -1.2 -1.2 -1.3 -1.5 -1.4 -1.6 -2.0 +0.3 +0.5 +0.1 +0.4 +0.4-0.61 +0.8 +1.0/// (-0.1 + 0.4 + 2.7) + 3.3 + 3.5 + 3.7 + 3.6 + 3.9 + 4.0 + 4.5 + 1.6 - 0.2 - 1.4 - 1.4 - 1+0.1(+0.2) +2.2 +3.1 +3.4 +3.5 +3.5 +3.5 +3.5 +3.5 +3.5 +3.5 +3.5 +3.6 +3.8 +1.9 +0.9 -1.8 -1.4 -1.0 -0.5 -0.3 -0.5 -0.3 -0.5 -0.4 -0.6 +0.2 +0.3 +0.8 +0.6 +0.4 +0.8-0.1 +0.3 +2.8 +3.2 +3.2 +3.3 +3.4 +3.4 +3.4 +2.6 +3.1 +2.5 +1.5 +1.5 -0.9 -1.0 -0.3 -0.8 +0.8 +0.4 +0.3 +0.3 +0.3 +1.1 +1.1 |+0.2| |+0.1| +0.2| |+2.3| |+2.1| +3.0| +2.8| +3.1| +3.2| +3.2| +2.9| +1.9| +1.7| +1.1| +1.5| +0.1| -0.4| -0.3| -1.5| +0.5| +0.3| +0.3| -0.3| -0.2| +0.2| +0.2| +0.9| +1.0| +0.4| -0.3| -0.3| -1.5| +0.5| +0.3| +0.3| +0.3| -0.2| +0.2| +0.9| +1.0| +0.4| -0.3| -0.3| -1.5| +0.5| +0.3| +0.3| +0.3| -0.3| -0.2| +0.2| +0.2| +0.4| -0.3| +0.4| -0.3| +0.5| +0.5| +0.3| +0.3| -0.3| +0.5| +0.3| +0.3| +0.4| -0.3| +0.4| -0.3| +0.5| +0.5| +0.3| +0.3| +0.3| +0.4| -0.3| +0.4| +0.4| +0.4| -0.3| +0.5| +0.5| +0.5| +0.3| +0.5| +0.5| +2/5 +2.4 +2.9 +3.0 +2.9 +2.2 +1.5 +0.9 +0.6 +0.4 0.0 -0.5 -1.3 1.9 -1.4 -0.2 -0.6 0.0 -0.1 -0.7 -0.8 -0.1 +1.0 +0.9/ +0.3 +0.8 +1.5 +2.8 +2.6 +2.8 +2.7 +2.2 +1/9 +1.1/ +0.2 0.0 -0.3 -0.8 =0.8 =1.4 -2.0 -0.9 -0.1 -0.7 0.0 -0.3 -0.7 -0.5 +0.4 +1.0 +0.4 +0.2 -0.8 -1.2 -1.1 =1.4 -0.5 0.0 -0.4 -0.7 -0.7 -0.8 -0.3 +0.5 +1.2 +0.5 / +0.1 -0.1 HO.6 H2.7 -0.2 +1.0 +1.4 +1.7 +2.3 +1.7 +1.7 +1.8 +0.9 0/0 -0,8 -0,5 -0.5 +0.6 -0.7 -0.8 = 0.5 = 0.1 +0.1 +0.5 +1.1 +2.1 +2.0 +1.4 +0.3 -0.6 -0.7 -0.9 = 0.9 -1.4 = 0.9 -0.6 -0.4 -0.1 +0.9 +1.2 +0.8 +0.4 +0.4 +0.1 +0.1 +0.8 +0.8 -0.4 -0.6 -0.6 -0.5 -0.2 -0.1 +0.3 +0.9 +1.5 +2.2 +2.2 +1.1 -0.2 -0.9 -0.4 -1.3 -1.1 -0.7 -0.3 -0.3 +0.1 -0.2 -0.4 +0.2 -0.4 +0.3 - 0.4 - 0.6 - 0.2 - 0.6 - 0.7 - 0.6 - 0.3 - 0.3 - 0.3 - 0.3 - 0.3 + 0.4 + 0.7 + 1.2 + 1.6 + 1.7 + 0.9 - 0.3 + 0.3 - 0.1 - 0.3 - 0.5 - 0.5 - 0.5 - 0.6 - 1.2 - 0.6 - 0.3 + 0.3 + 0.8 - 0.4 + 0.7 + 0.8 - 0.4 + 0.7 + 0.8 - 0.4 + 0.7 + 0.8 - 0.3 + 0.3 + 0.3 - 0.1 - 0.5 - 0.5 - 0.5-0.5 -0.3 +0.2 -0.2 -0.2 -0.4 -0.4 -0.6 -0.7 -0.7 -0.7 -0.7 -0.7 -0.4 -0.2 -0.1 +0.3 +0.2 +0.2 +0.2 +0.2 +0.2 +0.3 +0.3 +0.3 +0.5 +0.5 +0.4 +0.1 02 +0.5 -0.3 -0.2 -0.4 -0.4 -0.3 -0.3 -0.5 -0.7 -0.5 -0.7 -0.6 -0.6 -0.6 -0.7 -0.8 -0.9 -0.7 -0.4 -0.5 -0.1 +0.2 0.0 +0.1 0.0 -0.2 +0.8 +0.7/+0.4 +0.4 +0.5 10 -0.4 -0.8 -0.7 -0.7 -0.8 -0.8 -0.9 -0.8 -0.7 -0.6 -0.5 -0.5 -0.5 -0.7 -0.8 -0.9 -0.8 -0.9 -0.5 -0.4 +0.3 0.2 0.0 +0.2 0.0 +0.1 -0.3 -0.8 -0.0 -1.2 -0.1 -0.3 -0.2 -0.5 -0.4 -0.4 -0.5 -0.6 -0.5 -0.5 -0.4 -0.5 -0.4 -0.3 -0.5 -0.5 -0.7 -0.6 -0.6 -0.4 -0.4 +0.2 -0.1 -0.3 -0.6 -0.2 00 -0.5 -0.3 -0.4 -0.3 -0.5 -0.3 -0.1 -0.2 -0.3 -0.4 -0.3 -0.3 -0.4 -0.4 -0.5 -0.4 -0.5 -0.4 -0.5 -0.4 -0.5 -0.4 -0.5 -0.3 0.0 +0.2 +0.3 -0.2 +0.3 -0.4 +0.1 -0.6 -0.1 - 0.1 - 0.1 - 0.1 - 0.1 - 0.2 - 0.2 - 0.1 - 0.1 - 0.2 - 0.2 - 0.1 - 0.2 - 0.2 - 0.2 - 0.3 - 0.3 - 0.1 + 0.3 - 0.1 - 0.2 - 0.2 - 0.3 - 0.3 - 0.3-0.2 -0.2 -0.1 0.0 -0.2 -0.2 -0.1 -0.1 -0.1 +0.2 +0.7 +0.2 0.0 -0.1 -0.3 -0.3 -0.3 -0.1 -0.1 -0.3 +0.2 +0.9 +0.5 +0.5 -0.3 -0.1 -0.2 -0.3 -0.1 +0.1 +0.8 +1.0 +1.0 +0.8 +0.9 +0.8 +0.8 +0.8 +0.9 +0.9 +0.9 +0.9 +0.8 +0.8 +0.8 +0.8 +0.8 +0.8 +0.1 -0.2 0.0 +0.1 +0.1 +0.4 +0.1 +0.2 -0.1 -0.3 -0.2 -0.2 -0.2 -0.3 0.2 -0.1 -0.1 0.0 0.0 +0.1 +0.2 +1.7 +1.5 +1.4 +1.2 +1.1 +1.2 +1.2 +1.2 +1.0 +1.0 +1.0 +0.8 +0.8 +0.6 +0.5 +0.6 +0.3 +0.4 +0.4 +0.4 +0.4 +0.9 +1.1 +1.0 +0.6 +0.4 +0.4 +0.4 +0.5 +0.4 +0.5 +0.6 +0.5 +0.7 +1.1 +1.1 +1.9 +1.8 +1.8 +1.7 +1.6 +1.5 +1.5 +1.5 +1.4 +1.3 +1.4 +1.3 LIMIT OF PHASE II SECTION I LINER SYSTEM (APPROXIMATE) - LIMIT OF VOLUME CALCULATION 87.4

## **VOLUME ESTIMATE RESULTS CUT/FILL VOLUME BETWEEN**

83.5


04/03/2012 AND 03/22/2013 SURVEYS

ExistGrade_04-03-2012
ExistGrade_03-22-2013
2,876.17 Cu. Yd.
30,574.29 Cu. Yd.
27,698.12 Cu. Yd. <fill></fill>

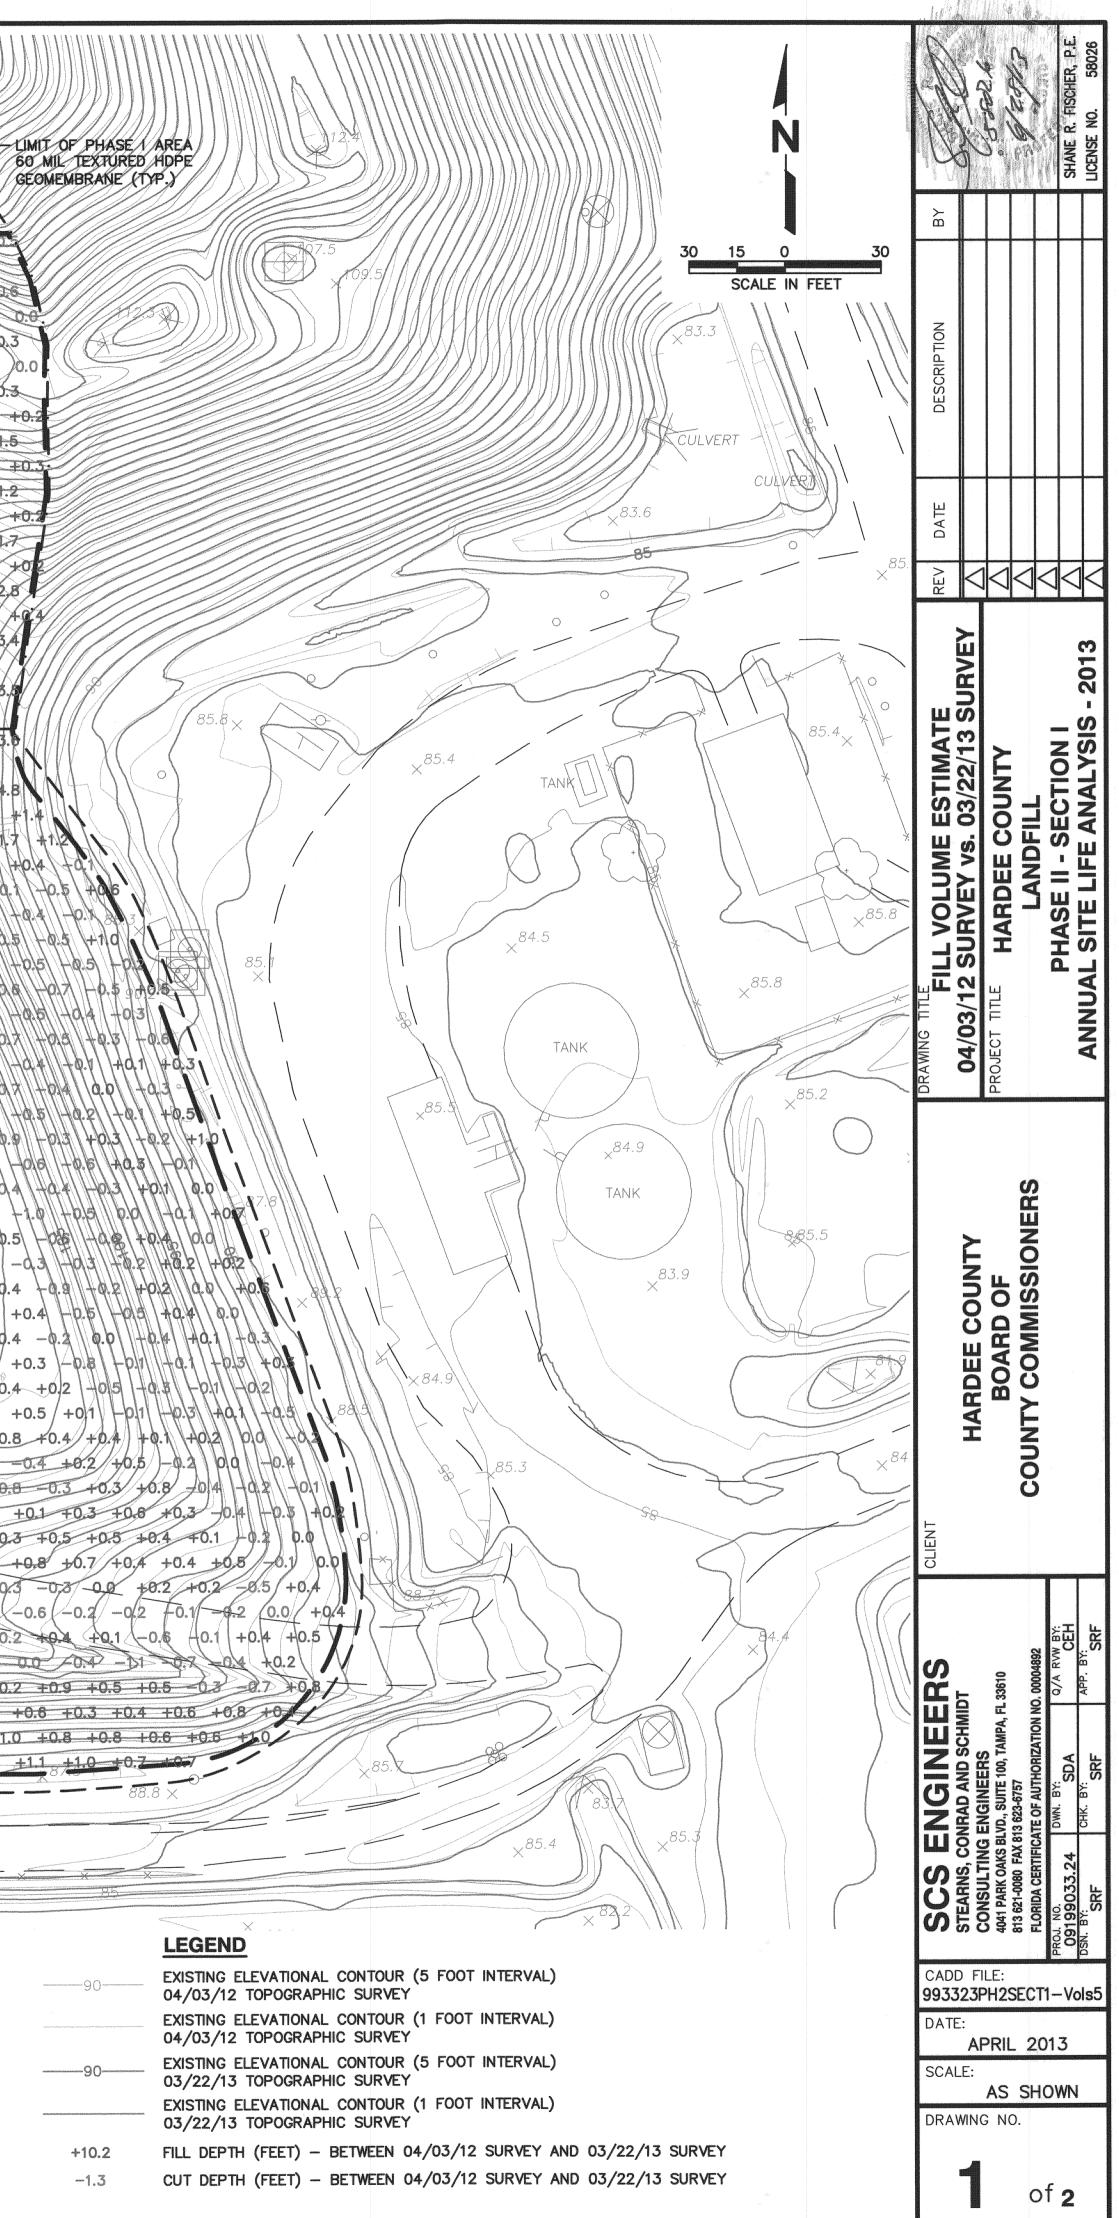

## ATTACHMENT D

# DRAWING 2 OF 2 REMAINING VOLUME ESTIMATE PHASE II SECTION I TOP AREA TO 3/22/13 SURVEY

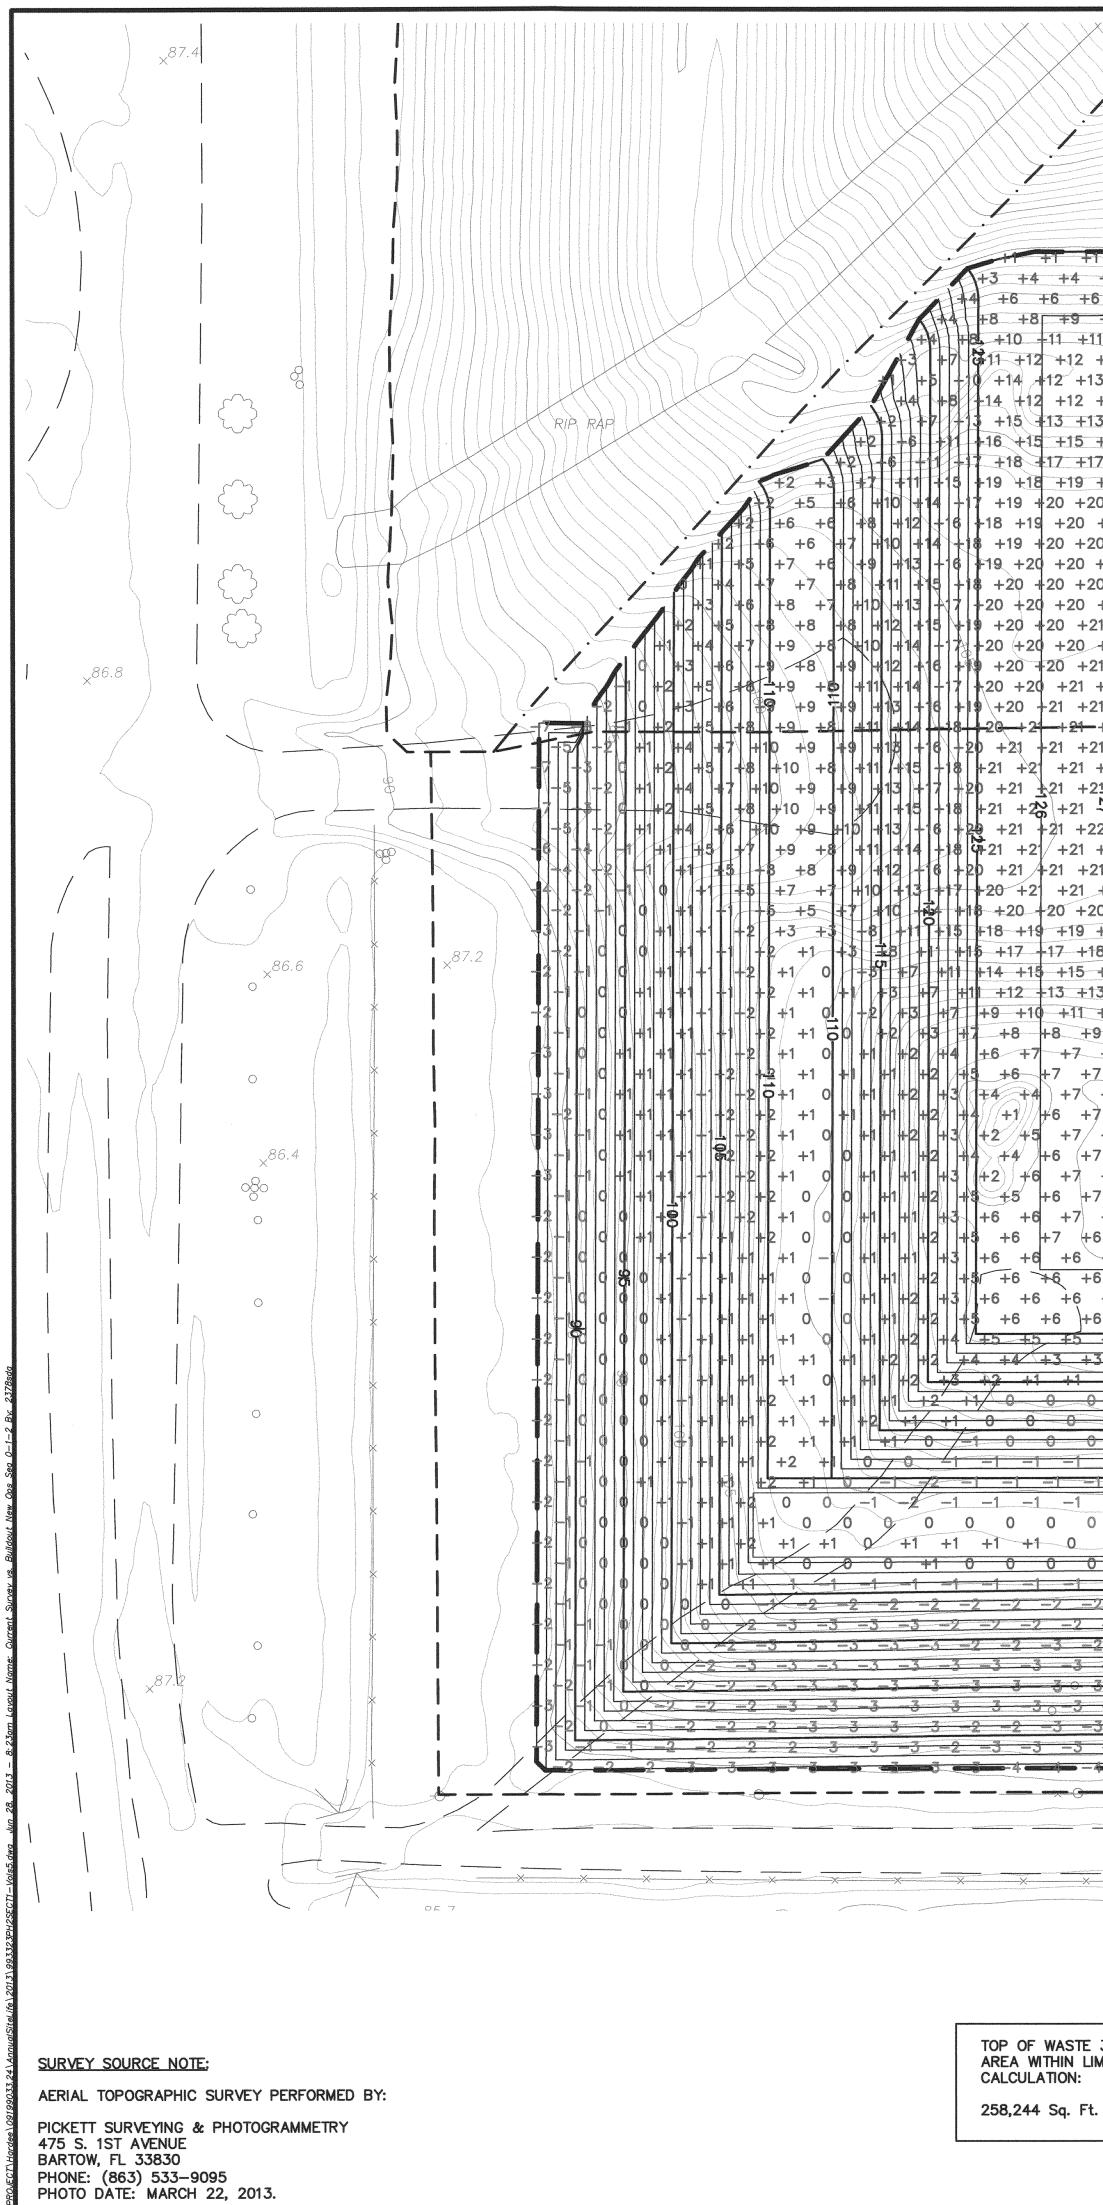


	14	5		
PHASE I ARE	A (CLOSED)			LIMIT OF 60 MIL GEOMEM
		130		
$\begin{array}{cccccccccccccccccccccccccccccccccccc$	+3 +3 +3 +3 +3 +2			
6 +6 +6 +6 +6 +5 +5 +5 +5 +9 +9 +8 +8 +8 +7 +7 +7 11 +11 +10 +10 +9 +8 +9 +9	<b>+9871 +8 +8 +7 +7 +7</b> +10 +10 +10 +9 +10	+7 +7 +7 +7 +7 +8 +10 +10 +10 +10 +10 +10	+87 +8 +8 +7 +8 +4 +3 +10 +9 +9 +8 +6 +4 +3	
+12 +12 +12 +11 +11 +10 +10 +11 12 +13 +13 +13 +13 +13 +12 +12 +12 +12 +12 +13 +13 +13 +13 +12 ;	<b>27+12 +12 +12 +12 +12</b>	+12 +12 +12 +12 +13 +12 /	412 +11 410 +30 44 +1	
13 +13 +14 +14 +14 +14 +14 +14 +14 +14 +15 +15 +16 +16 +16 +16 +16 +16 + 17 +17 +18 +18 +18 +19 +19 +18 +18	0 (+13 +13 +13 +12 +12 +12 +13 +13 +13 +13 +13	+12 +13 +13 +12 +12 +11 3 +13 +13 +12/+12 +11 +1	+11 +10 +6 +3 +3 +3 +1 +10 +72	
+19 $+19$ $+20$ $+20$ $+21$ $+21$ $+21$ $+20$ $+20$ $+20$ $+21$ $+22$ $+22$ $+23$ $+22$ $+21$ $+23$	+19 +18 +16 +15 +14 +14 +19 +17 +16 +15 +14 -	4 +13 +13 +12 +11 +11 +1 +14 +13 +12 +11 +11 +11	1 + 9 + 4 + 7 + 0 + 0 + 1 + 19 + 6 + 7 + 7 + 1 + 1 + 1 + 1	
$\begin{array}{rrrrrrrrrrrrrrrrrrrrrrrrrrrrrrrrrrrr$	3 +22 +19 +15 +15 +14 + +23 +22 +17 +16 +15 +14	+14 +13 +12 +11 +11 +11 4 +13 +12 +12 +11 +11 +1	AB +A + A +1 +1 +1 +2 / +1	
$\begin{array}{rrrrrrrrrrrrrrrrrrrrrrrrrrrrrrrrrrrr$	4 + 23 + 20 + 1/5 + 1/5 + 1/4 + 24 + 23 + 16 + 15 + 15 + 15 + 14	414 +13/ +12 +11 +11 +10/ 4 +13 +12 +12 +11 +11/ +1	A6//+2//+1 +1 +2//9///+	
+20 +21 +22 +23 +23 +24 +24 +25 - 20 +21 +22 +22 +23 +23 +24 +24 +25 +21 +22 +22 +23 +23 +24 +24 +25 +	$\begin{array}{rrrrrrrrrrrrrrrrrrrrrrrrrrrrrrrrrrrr$	4 +13 +12 +12 +11 +10 +6 +12 +13 +12 +11 +11 +7		
21 +21 +22 +22 +23 +23 +24 +21NFILL -+ <del>21 +21 +22 -23 +23 +24 +24</del> + <del>25</del> =	AREA1 +20 +16 +10 +9	+8 +10 +12 +11 +10 +6		
$\begin{array}{c ccccccccccccccccccccccccccccccccccc$	30.7+20 +18 +16 +14 +1		4 -1 -3 -2 -1 0 -1 -2 -3 -4 -4 +1 -1 -3 -2 0 -1 +4 -4 -5 +1 -3 -2 0 -3 -4 +5 -	-6 7-6
+21 $22$ $+226$ $+23$ $+23$ $+24$ $+24$ $+24$ $+21$ $+22$ $+22$ $+22$ $+23$ $+23$ $+24$ $+24$ $+23$ $+21$ $+22$ $+22$ $+22$ $+23$ $+23$ $+23$ $+24$ $+24$ $+24$ $+24$ $+21$ $+22$ $+22$ $+22$ $+23$ $+23$ $+24$ $+24$ 3 +20 +18 +17 +16 +14	+13 +13 +12 +11 +10 +16	$\begin{array}{c ccccccccccccccccccccccccccccccccccc$	
$\begin{array}{rrrrrrrrrrrrrrrrrrrrrrrrrrrrrrrrrrrr$	2 +20 +18 +16 +16 +15 +21 +9 +17 +16 +15 +14	+14 +13 +12 +11 +10 +6 4 +14 +13 +12 +112 +8 +8		
+19 +20 +20 +20 +21 +21 +21 +21 - 17 +18 +18 +19 +19 +19 +20 +20 +20	+20 +18 +17 +16 +15 +14 0 +19 +17 +17 +16 +15	4 +13 +13 +12 +11 +9 +75 +14 +13 +12 +11 +10 +8	$\frac{3}{4} + \frac{3}{5} + \frac{3}{5} + \frac{3}{5} + \frac{3}{5} - \frac{3}{5} + \frac{3}{5} + \frac{3}{5} - \frac{3}{5} + \frac{3}$	
+15 +16 +17 +17 +18 +18 +19 +20 - 13 +13 +14 +15 +16 +17 +17 +18 +18 +11 +12 +13 +14 +15 +16 +16 +16 -	<b>30+18 +1</b> 7 +16 +15 +14 +16 +16 +15 +14 +13 +1;	+13 +13 +12 +11 +10 +9 +13 +12 +12 +11 +10 +9 +1		
8 +9 +10 +12 +13 +14 +14 +14 +14 + +7 +8 +9 +11 +12 +12 +12 +12 - 7 +7 +8 +9 +10 +10 +11 +10 - (	+12 +12 +11 +11 +10 +1 -129 +10 +9 +9 +9	1 +10 +9 +9 +8 +7 +6 +9 +8 +8 +7 +X +6		
+7 +7 +7 +8 +9 +9 +9 +9 6 +7 +7 +8 +8 +8 +8 +8 8 +7 +7 +7 +8 +8 +8 +7 +7	8 +7 +7 +7 +7 +7	+7 +7 +6 +6 +6 +6	+5 +4 +4 +4 +2 +3 -1 +	
6 (+7) +7 +7 +7 +7 +7 +7 7 +7 +7 +7 +7 +7 +7 +7 +7	+7 +7 +6 +6 +6 +6 +6 +6 +6 +6	+6 +6 +7 +6 +6 +6 +6 5 +6 +6 +6 +6 +6 +6	+5 $+5$ $+2$ $0$ $+1$ $+2$ $+16$ $+5$ $+5$ $+1$ $p$ $+2$ $+2$ $-1$	
$\begin{array}{c ccccccccccccccccccccccccccccccccccc$	SECTION AREA +5 +5	+5 +5 +5 +6 +6 +6	+6 +5 +5 +2 +2 +0 ++1 ++2 -	
6 + 6 + 6 + 6 + 6 + 6 + 6 + 5 + 5 + $6 + 6 + 6 + 6 + 6 + 6 + 5 + 5$	$5 +5 +5^{20}+5 +5 +5 +5 +5 +5 +5 +5 +5 +5 +5 +5 +5 +$	+5 +5 +5 +5 +5 +6 5 +5 +6 +6 +6 +7	$\begin{array}{cccccccccccccccccccccccccccccccccccc$	
$\begin{array}{c} 6 \\ +6 \\ +5 \\ +5 \\ +5 \\ +5 \\ +5 \\ +5 \\ $	+7 +6 -125 +7 +7 +7 -+6 +6 +6 +6 +7	+7 +8 +9 +9 +9 +9 +7 +7 +8 +9 +9 +9	9 +10 +10 +8 47 +5 +2 41 +9 +10 +10 +9 +7 +5 +1	
	2 + 12 + 3 + 4 + 4 + 5 = 0 + 1 + 15 + 4 + 5 + 4 + 5 + 4 + 5 + 4 + 5 + 4 + 5 + 4 + 4	<del>45 +6 +6 +6 +7 +7</del> +4 +4 +5 +5 +6 +6	+8 +8 +8 +8 +8 +6 +2	
	-3 $-3$ $-2$ $-2$ $-1$ $0$ $+1$ $+1$ $-3$ $-3$ $-3$ $-3$ $-3$ $-3$ $-3$ $-3$	+2 +3 +3 +4 +4 +5 +1 +1 +2 +3 +3 +4 -2 -1 0 +1 +1 +2	$\begin{array}{cccccccccccccccccccccccccccccccccccc$	+3 +3 +4
	0 1 -1 -1 -1	=1 -1 -1 +1 +1	$\begin{array}{cccccccccccccccccccccccccccccccccccc$	+5 +6 +6
$\begin{array}{cccccccccccccccccccccccccccccccccccc$			+2 +3 +3 +4 +5 +6 +6 + 0 +1 +2 +3 +3 +4 +5 -1 -1 0 +1 +1 +2 +	+5 +6 +7
<u>-2 -2 -2 -2 -2 -2 -2 -2 -2 -2 -2 -2 -2 -</u>	$\begin{array}{c ccccccccccccccccccccccccccccccccccc$			
$3 \circ 3 - 3 - 2 - 2 - 2 - 2 - 2 - 2 - 2 - 2 -$	-2 $-2$ $-2$ $-2$ $-2$ $-2$ $-2$ $-2$	$\begin{array}{c ccccccccccccccccccccccccccccccccccc$	$\frac{1}{2} + \frac{1}{2} + \frac{1}$	
$\begin{array}{cccccccccccccccccccccccccccccccccccc$	-32-2-2-2-2	<u></u> <u></u> <u></u> <u></u>		
				<ul> <li>anapproximation</li> <li>anapproximation</li> <li>anapproximation</li> <li>anapproximation</li> </ul>
XXXX			LIMIT OF PHASE II SECTION I LINER SYSTEM (APPROXIMATE)	)
	AND FILL SEQUENCE 7			90
	ase Surface	ExistGrade_03-22-2013		

AREA WITHIN LIMITS OF VOLUME

PROP-P2S2-FILL-SEQ-0-1-2 Comparison Surface 5,194.77 Cu. Yd. Cut volume (unadjusted) Fill volume (unadjusted) 55,212.88 Cu. Yd. Net volume (unadjusted) 50,018.11 Cu. Yd.<Fill>

+10 -2

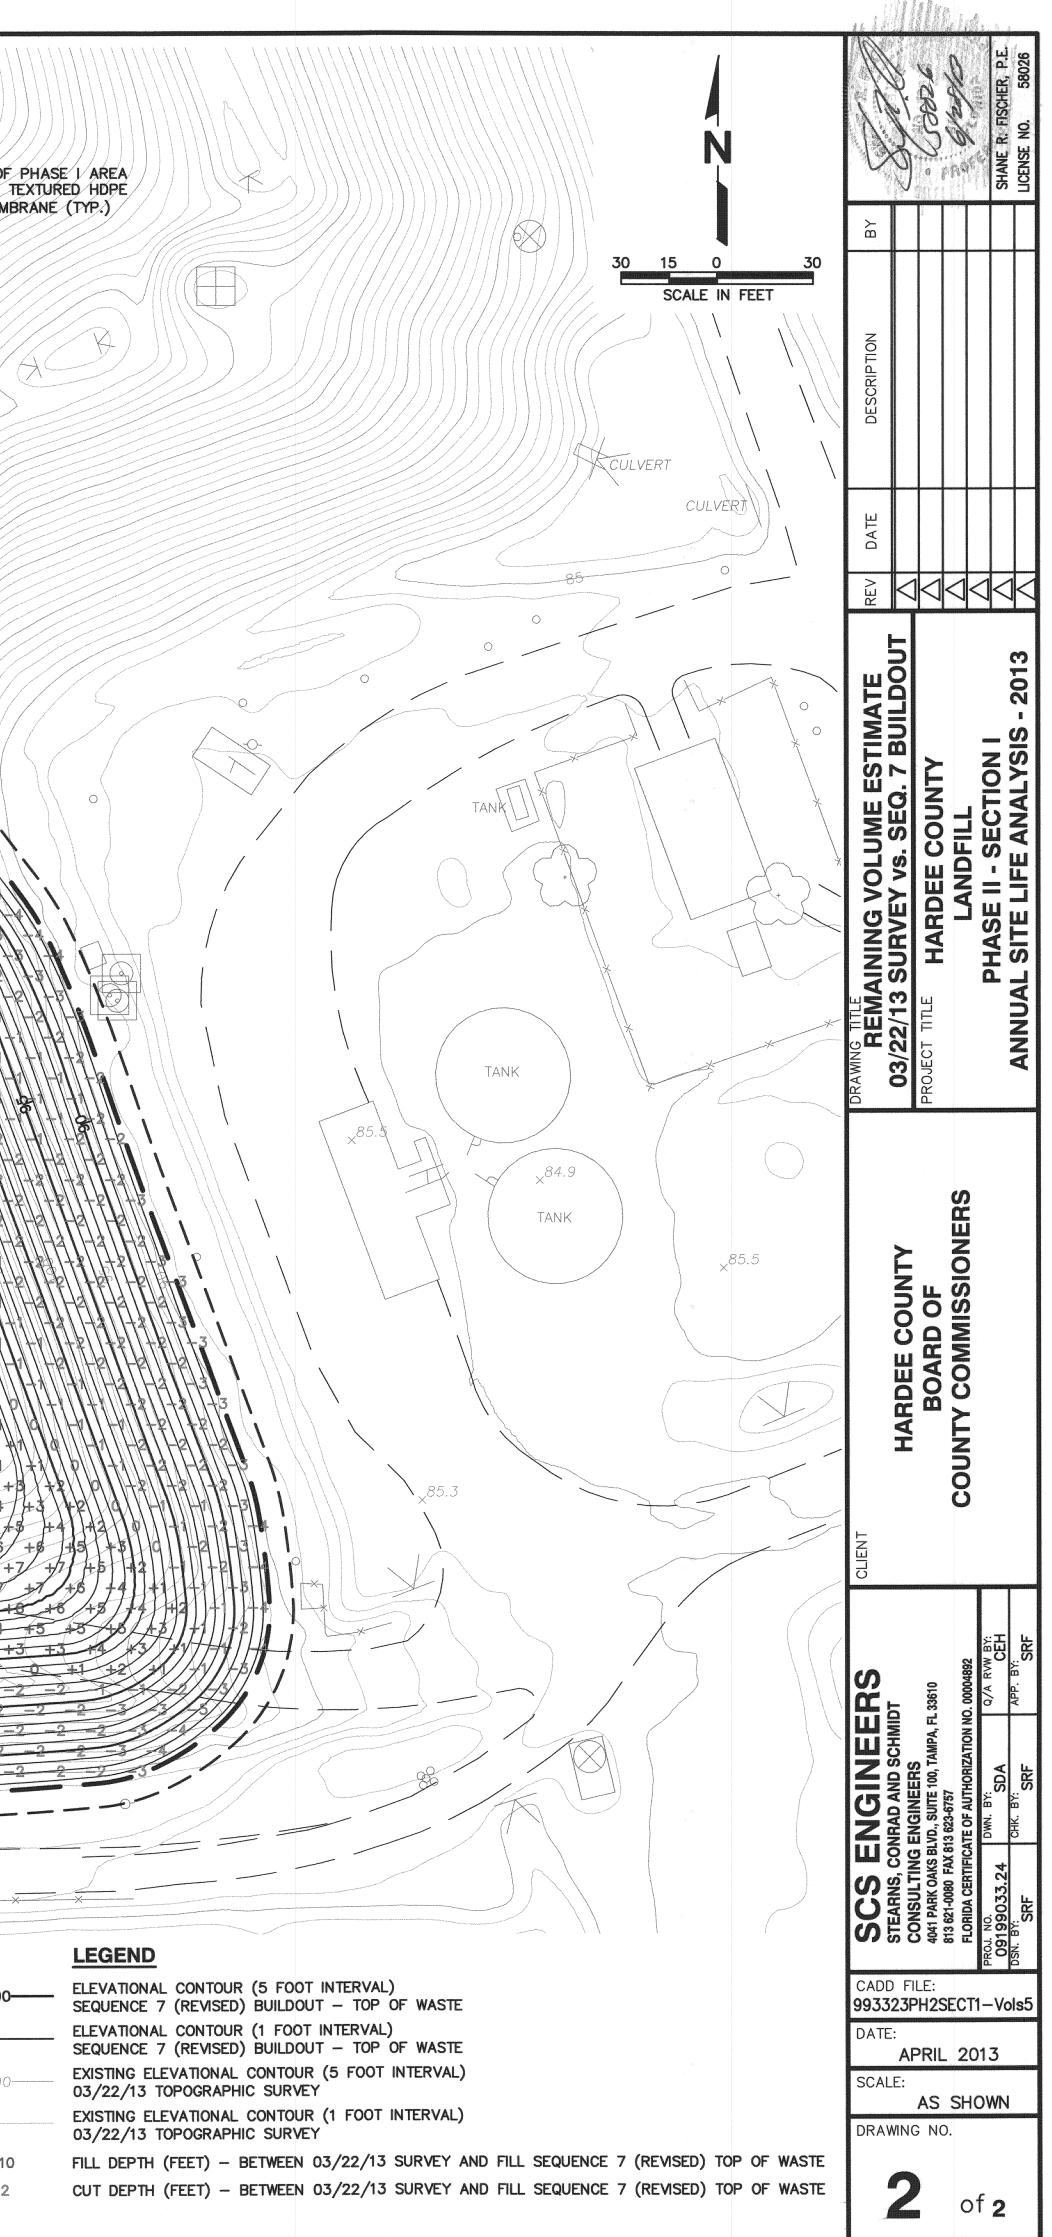

## ATTACHMENT E

## SITE LIFE CALCULATIONS

SCS ENGINEERS								
					SHEET	1	OF <u>1</u>	
CLIENT			PROJECT			JOB NO.		
Hardee County			Site Life Estima	ites	DV/	09199033.23	D + TE	
SUBJECT	0:1-	Life Estimates			BY		DATE	
		Life Estimates			SRF		06/28/13	
	waste	Quantity Estimat	es		CHECKED		DATE	
					CEH		06/28/13	
	WASTE	]						
TIME PERIOD	DISPOSED							
(MONTHS)								
	(tons/month) <sup>2</sup>							
Apr-12	1,399							
May-12 Jun-12	1,387 1,674							
Jul-12	1,288							
Aug-12	1,286							
Sep-12	1,131							
Oct-12	1,423							
Nov-12	1,191							
Dec-12 Jan-13	1,346 1,458							
Feb-13	1,458							
Mar-13	1,370							
TOTAL	16,250							
		u .						
		WASTE	WASTE	Ţ				
TIME PERIOD	POPULATION <sup>1</sup>	DISPOSED	TONNAGE					
	1 OF OLAHOIN	(tons/year) <sup>2</sup>	PER CAPITA					
April 12 - March 13	27,725	16,250	0.586	+				
	TONS PER CAP		0.586	1				
			0.000	<u>1</u>				
Gross Airs	bace Available Ma	arch 22. $2013^4 =$	55,213	СҮ				
	Estimated Percer		5%					
		or Daily Cover =	2,761	CY				
	ace Available Ma		52,452	CY				
	Airspace Available	-	84,385	CY				
	ce Consumed 4/3		27,698	CY				
	Waste Density 4/ Waste Density 4/		43 1,173	lbs/CF lbs/CY				
	Waste Density 4/	5/12 - 5/22/13 -	1,175					
			CUMULATIVE		CUMULATIVE		]	
		WASTE	WASTE	AIRSPACE	AIRSPACE	AVAILABLE		
TIME PERIOD	POPULATION	DISPOSED	DISPOSED	CONSUMED	CONSUMED	AIRSPACE		
		(tons) <sup>2</sup>	(tons/month)	(CY)	(CY)	(CY)		
			,, <b>,</b>		V 1	52,452	4	
April 13 - March 14	27,877	16,339		27,850		24,602	1	
April 14 - March 15	28,021	16,424		27,994		-3,392	27,994 CY/12 months	
April 14		1,369	1,369	2,333	2,333	22,269	2,333 CY/month	
May 14		1,369	2,737	2,333	4,666	19,937	1,369 tons/month	
June 14 July 14	,	1,369 1,369	4,106 5,475	2,333 2,333	6,998 9,331	17,604 15,271	4	
August 14		1,369	5,475 6,843	2,333	11,664	12,938	4	
September 14		1,369	8,212	2,333	13,997	10,605	1	
October 14		1,369	9,581	2,333	16,330	8,273		
November 14	28,021	1,369	10,949	2,333	18,663	5,940		
December 14		1,369	12,318	2,333	20,995	3,607		
January 15		1,369	13,686	2,333	23,328	1,274	4	
February 15	28,021	1,369	15,055	2,333	25,661	-1,059	Available airspace utilized	
NOTES							in mid February 2015.	
NOTES:								

Source : Florida Legislative Office of Economic and Demographic Research.

Waste quantity disposed in Phase II Section I provided by Hardee County refer to Attachment B.

Airspace consumed computed using March 22, 2013 topographic survey vs April 3, 2012 topographic survey

survey, refer to Attachment C.

Airspace available computed using Phase II Section I landfill area up through Fill Sequence No. 7 vs March 22, 2013 topographic survey, refer to Attachment D.

County / State	2007	2008	2009	2010	2011	2012	2013	2014	2015
Alachua	241,462	244,106	246,074	247,336	247,337	248,482	251,372	255,116	258,861
Baker	26,035	26,596	27,015	27,115	26,927	27,143	27,819	28,716	29,596
Вау	165,952	168,297	168,424	168,852	169,278	170,417	172,558	175,187	177,809
Bradford	28,790	28,908	29,021	28,520	28,662	28,977	29,293	29,586	29,840
Brevard	538,211	541,331	542,239	543,376	545,184	548,660	554,507	561,516	568,561
Broward	1,741,657	1,739,708	1,738,093	1,748,066	1,753,162	1,757,650	1,766,582	1,777,481	1,788,172
Calhoun	14,278	14,339	14,656	14,625	14,685	14,792	14,915	15,045	15,172
Charlotte	160,083	160,412	159,860	159,978	160,463	161,484	163,234	165,339	167,453
Citrus	140,279	141,852	141,696	141,236	140,956	142,002	144,471	147,656	150,876
Clay	185,427	187,657	188,814	190,865	191,143	193,627	198,966	205,766	212,656
Collier	313,657	315,928	318,120	321,520	323,785	327,771	334,299	342,162	350,194
Columbia	66,198	66,999	67,259	67,531	67,528	68,032	69,189	70,662	72,122
DeSoto	34,170	34,459	34,709	34,862	34,708	34,760	35,129	35,650	36,168
Dixie	15,921	16,108	16,280	16,422	16,385	16,535	16,919	17,410	17,882
Duval	847,384	853,077	858,291	864,263	864,601	867,985	877,098	889,028	901,001
Escambia	300,184	299,993	298,845	297,619	299,261	300,388	300,858	300,922	300,883
Flagler Franklin	90,604	93,430	94,600	95,696 11,549	96,241	98,752	103,396	109,149	114,996
Gadsden	11,597 46,139	<u>11,606</u> 46,850	<u>11,617</u> 46,341	46,389	<u>11,527</u> 48,200	11,603 47,894	11,765 47,590	11,954 47,287	12,115 46,987
Gilchrist	16,548	16,695	16,806	16,939	48,200	47,894	47,590	47,287	18,211
Glades	12,379	12,649	10,800	12,884	10,985	12,860	13,081	13,390	13,702
Gulf	12,379	12,049	16,014	12,884	12,812	12,800	15,081	15,874	15,702
Hamilton	14,650	14 776	14 854	14 799	14 744	14 769	14 882	15,039	15,924
Hardee	27,384	27,620	27,691	27,731	27,653	27,627	27,725	27,877	28,021
Hendry	38,970	39,169	39,095	39,140	38,908	38,897	39,233	39,739	40,244
Hernando	168,170	171,316	171,878	172,778	173,078	175,250	179,650	185,182	190,775
Highlands	98,907	99,686	99,274	98,786	98,712	99,279	100,511	102,067	103,619
Hillsborough	1,194,436	1,206,084	1,215,216	1,229,226	1,238,951	1,252,841	1,274,216	1,299,497	1,325,278
Holmes	19,893	20,057	20,126	19,927	19,901	19,972	20,108	20,271	20,428
Indian River	135,494	137,420	137,557	138,028	138,694	140,214	142,760	145,819	148,897
Jackson	48,488	50,221	50,139	49,746	49,964	49,920	49,876	49,832	49,789
Jefferson	14,555	14,650	14,772	14,761	14,666	14,684	14,842	15,070	15,295
Lafayette	8,318	8,509	8,418	8,870	8,752	8,874	9,393	10,076	10,695
Lake	288,419	292,154	294,456	297,052	298,265	302,888	311,536	322,254	333,122
Lee	597,156	608,210	612,169	618,754	625,310	636,637	653,748	673,849	694,224
Leon	270,544	273,155	274,241	275,487	276,278	277,672	280,256	283,421	286,608
Levy	39,856	40,500	40,682	40,801	40,767	41,063	41,776	42,696	43,625
Liberty	8,033	8,260	8,334	8,365	8,370	8,485	8,716	8,994	9,254
Madison	19,220	19,300	19,405	19,224	19,298	19,318	19,338	19,358	19,379
Manatee	317,899	319,970	321,035	322,833	325,905	329,873	335,004	340,743	346,581
Marion	322,610	328,356	330,507	331,298	331,745	335,697	343,483	353,202	362,992
Martin	144,022	144,911	145,657	146,318	146,689	147,655	149,492	151,764	154,060
Miami-Dade	2,448,806	2,472,387	2,480,537	2,496,435	2,516,515	2,536,404	2,557,672	2,579,365	2,600,932
Monroe	75,125	74,094	73,773	73,090	72,670	72,421	72,341	72,316	72,248
Nassau	69,335	71,081	72,349	73,314	73,684	74,616	76,329	78,437	80,568
Okaloosa	182,760	181,880	181,281	180,822	181,679	182,674	183,793	184,951	186,087
Okeechobee	39,681	40,013	39,973	39,996	39,870	40,030	40,560	41,261	41,940
Orange Osceola	1,111,307	<u>1,125,822</u> 260,071	<u>1,133,453</u> 264,768	1,145,956	1,157,342	1,173,516 280,964	1,196,929	1,224,183 300,153	1,252,033 310,436
Palm Beach	251,598 1,302,451	1,307,784	1,312,016	268,685 1,320,134	273,867 1,325,758	1,335,648	290,032 1,352,697	1,373,360	1,394,293
Pain Beach Pasco	452,140	459,070	461,777	464,697	466,533	473,007	484,895	499,535	514,333
Pinellas	927,882	923,266	918,725	916,542	918,496	918,825	918,328	917,139	915,562
Polk	580,352	591,659	597,560	602,095	604,792	611,778	624,192	639,335	654,591
Putnam	74,863	75,028	74,714	74,364	74,052	74,068	74,501	75,128	75,736
St. Johns	176,032	182,504	186,383	190,039	192,852	197,422	204,195	212,122	220,172
St. Lucie	263,261	270,903	274,108	277,789	279,696	284,654	293,445	304,212	315,122
Santa Rosa	145,231	147,730	149,279	151,372	154,901	158,206	161,265	164,158	166,987
Sarasota	373,928	376,390	377,360	379,448	381,319	384,220	388,896	394,464	400,099
Seminole	419,049	420,468	421,130	422,718	424,587	427,778	432,933	439,071	445,270
Sumter	82,297	86,494	90,129	93,420	96,615	99,902	103,470	107,214	111,036
Suwannee	40,109	40,959	41,097	41,551	43,215	44,559	45,393	45,911	46,310
Taylor	21,747	22,387	22,508	22,570	22,500	22,515	22,680	22,916	23,147
Union	15,376	15,643	15,358	15,535	15,473	15,460	15,617	15,858	16,104
Volusia	498,480	499,273	496,456	494,593	495,400	497,978	502,489	507,911	513,303
Wakulla	28,333	28,944	30,155	30,776	30,877	31,168	31,766	32,522	33,290
Walton	52,874	54,066	54,696	55,043	55,450	56,344	57,763	59,454	61,169
		24,669	24,769						
Washington	23,694	24.009	24.709	24,896	24,638	24,668	25,112	25,755	26,384

Source: Florida Demographic Estimating Conference, July 2011 and the Florida Demographic Database, January 2012.