


REVISIONS
A-1/15/93 PRELIMINARY 30% ISSUE FOR CLIENT REVIEW AND COMMENTS
B-1/29/93 70% ISSUE FOR CLIENT REVIEW AND COMMENTS
C-4/01/93 ISSUE FOR CLIENT REVIEW AND COMMENTS
D-6/01/93 FOR CONSTRUCTION
1-11/08/93 REV. 'ANTIQUE BRICK' TO READ 'PATTERNED', CHANGED GLASS COLOR FROM BRONZE TO BLUE REMOVED HOLD ON LOUVERS, ADDED REF. NOTE TO ROBERTSON DRAWINGS.
2-05/26/94 ADDED STUCCO EXPANSION JOINTS AND CONTROL JOINTS PER N.O.M. 119, ITEM 17 (OMS 21) ADDED NOTE AT SMALL ROUND WINDOW, CHANGED 1/4" TINTED GLASS TO INSULATING GLASS. RELOCATED R.U.D. AND MAN DOOR AT A.P.C. PER RF1550
RECORD SET

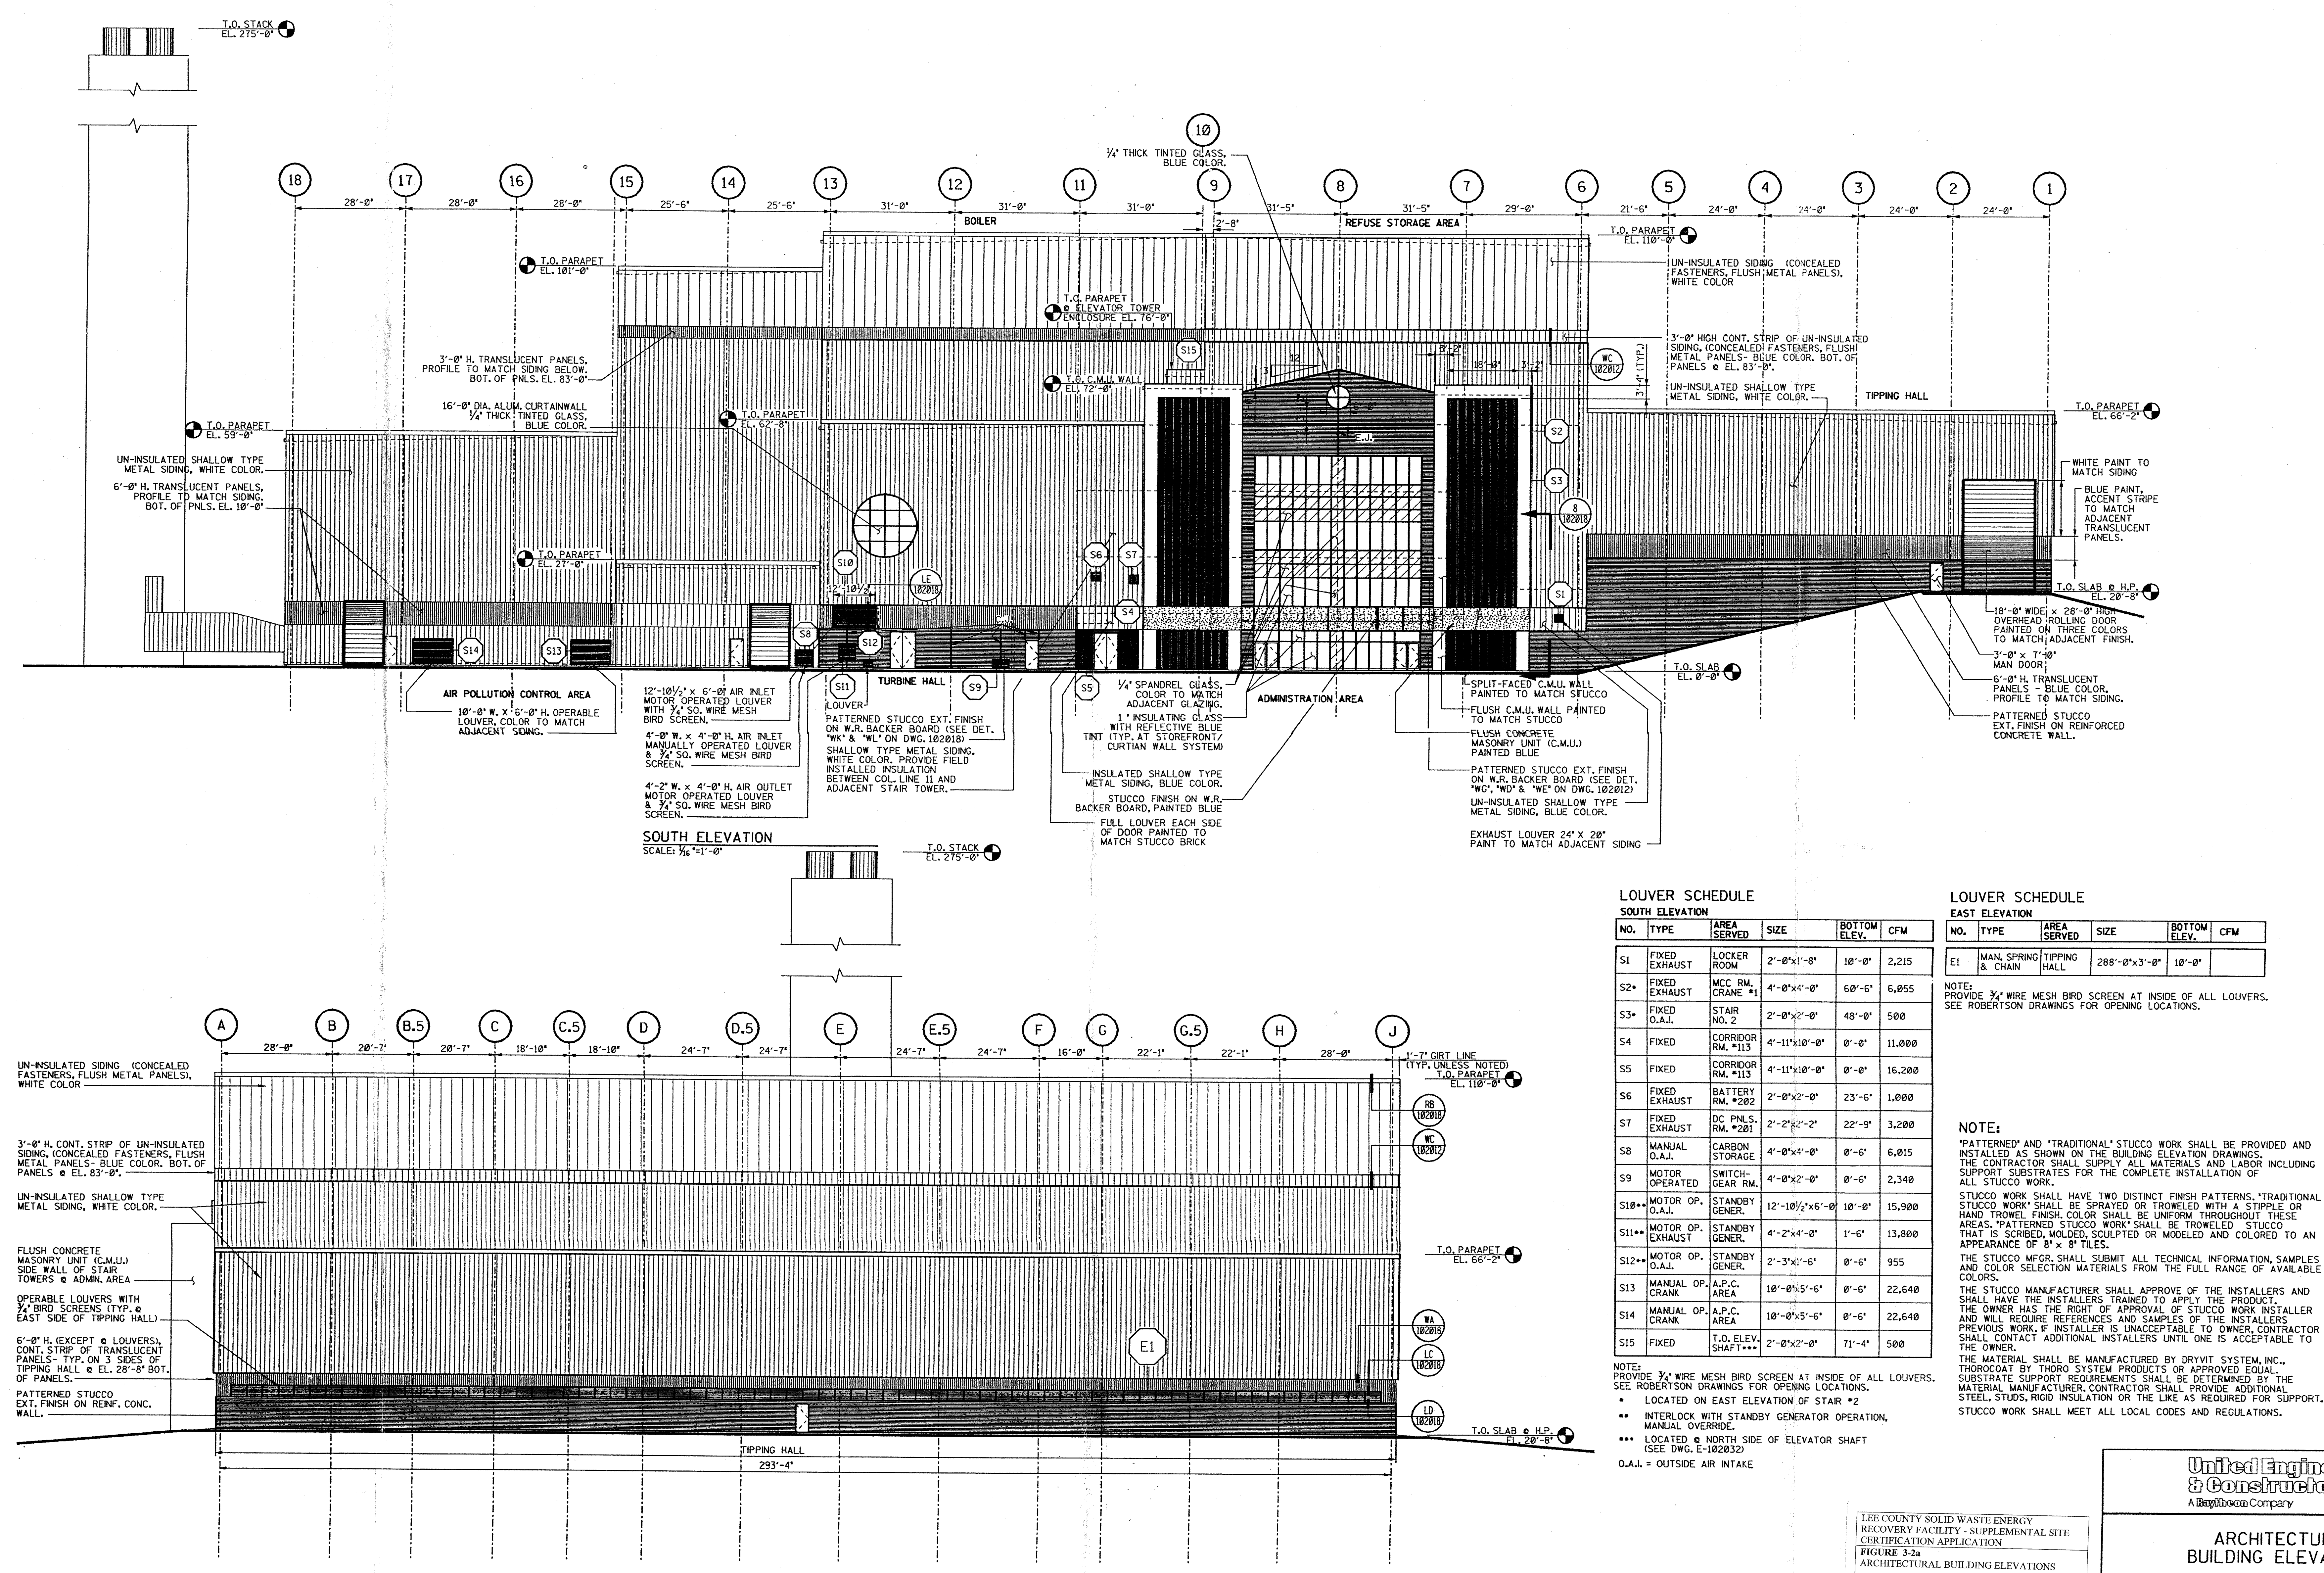

STRUCTURAL	MECH. POWER	ELECTRICAL	PROCESS
2			

COMPANY CONFIDENTIAL

This drawing and all information contained herein are the property of Ogdan Martin Systems, Inc. and are not to be used except as expressly authorized in writing by said company.

SUBCONTRACT OR PURCHASE ORDER	FOR BIDDING	FOR AWARD	FOR CONSTRUCTION
-------------------------------	-------------	-----------	------------------

DATE: 05/26/94

PROJECT NO: C-1033

DRAWING NO: 7102-E-102009

SCALE: 1/8"=1'-0"

SHEET: 2

United Engineers & Constructors
A Bechtel Company

ARCHITECTURAL BUILDING ELEVATIONS

LEE COUNTY SOLID WASTE RESOURCE RECOVERY FACILITY

OGDEN MARTIN SYSTEMS OF LEE, INC.

DATE: 05/26/94

PROJECT NO: C-1033

DRAWING NO: 7102-E-102009

SCALE: 1/8"=1'-0"

SHEET: 2