

03/25/91 06:51:00 VPL
12/06/90 15:08:26 ATS

951956
①

DRAWINGS FOR

SUMTER COUNTY BOARD OF COUNTY COMMISSIONERS SUMTER COUNTY, FLORIDA COMPOSTING FACILITY SITE IMPROVEMENTS

SHEET LIST

<u>SH. NO.</u>	<u>DESIG.</u>	<u>TITLE</u>
		COVER SHEET
1 OF 4	S-1	SITE PLAN
2 OF 4	SD-1	SECTIONS AND DETAILS
3 OF 4	SD-2	SECTIONS AND DETAILS
4 OF 4	G-1	STANDARD CONCRETE DETAILS

BLACK&VEATCH
PROJECT NUMBER
17239
APRIL, 1991




Black & Veatch
Tampa, Florida

CONFORMED TO CONSTRUCTION RECORDS
DATE: MARCH 1992
FIELD CHANGES NOTED: G.L.P.
DETAILED: T.C.R.
APPROVED: G.L.P. *[Signature]*

D.E.R.

MAR 30 1992


SOUTHWEST DISTRICT
TAMPA

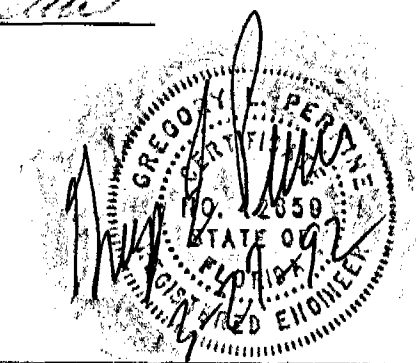


CCC. DWG. N.Y.

3




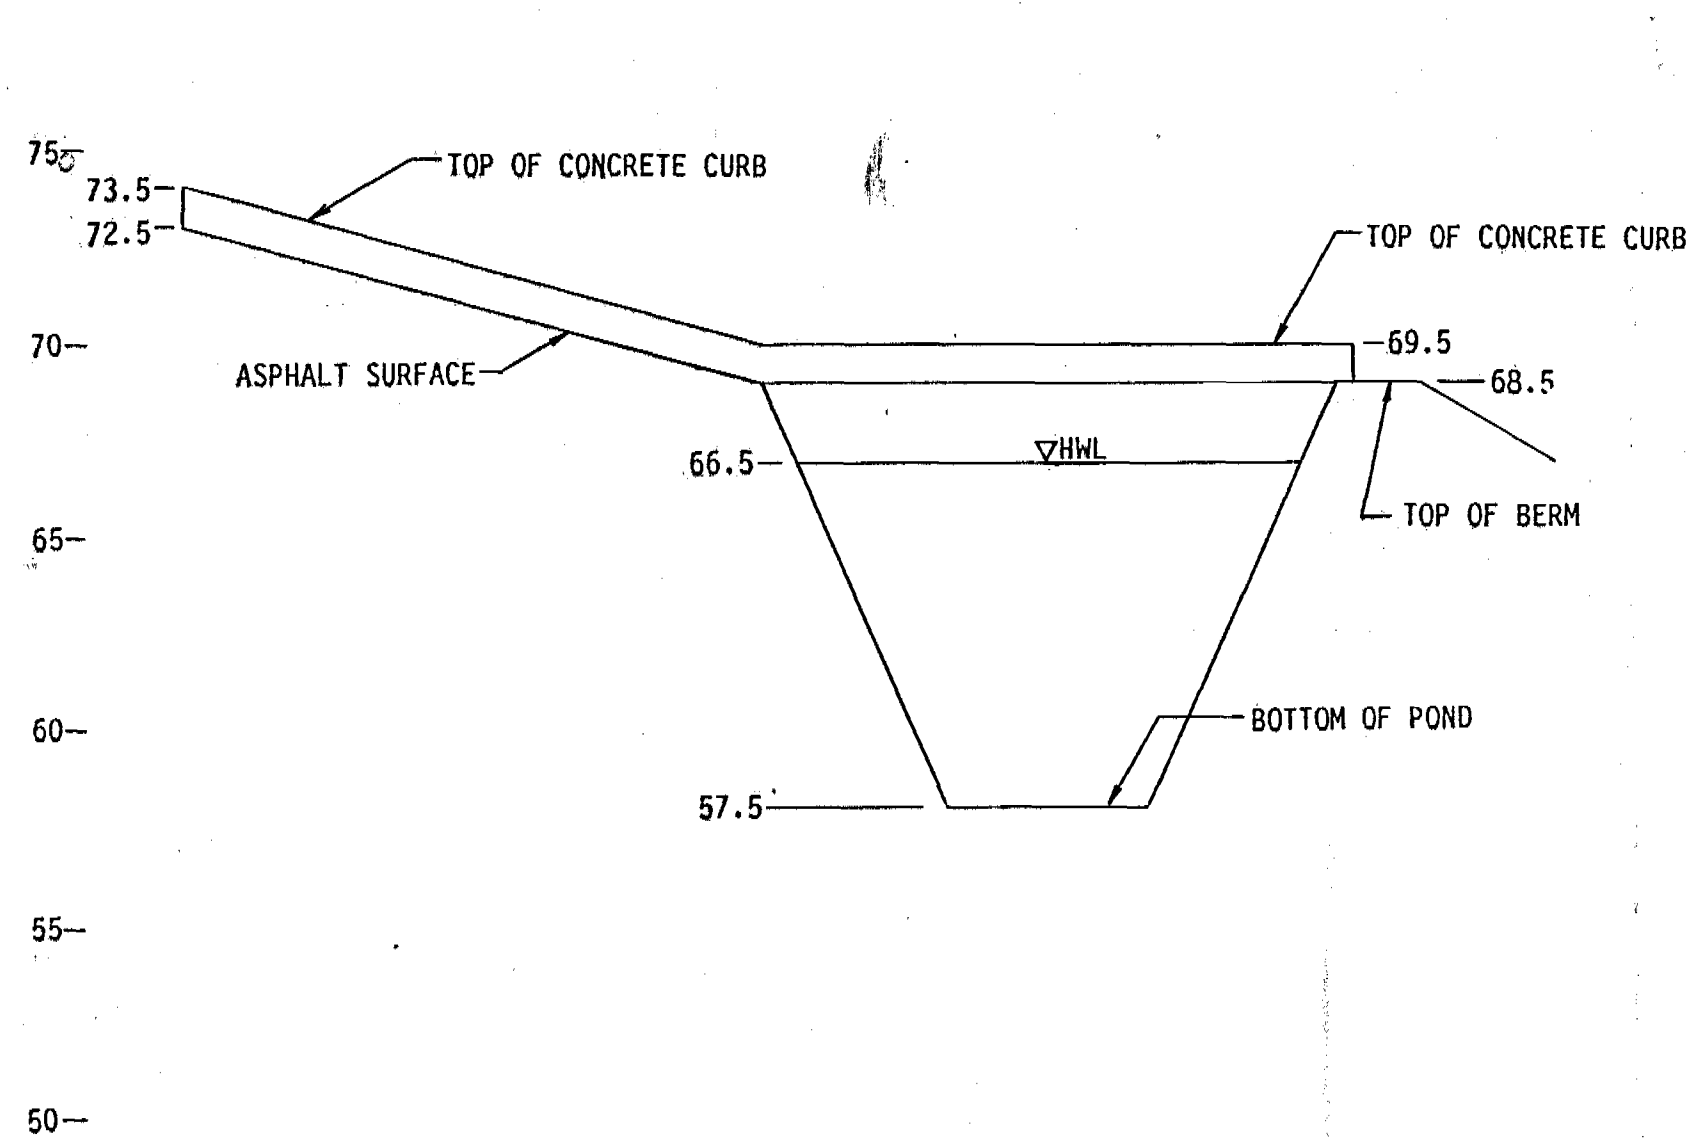


HYDRAULIC PROFILE - NORTH FACILITIES

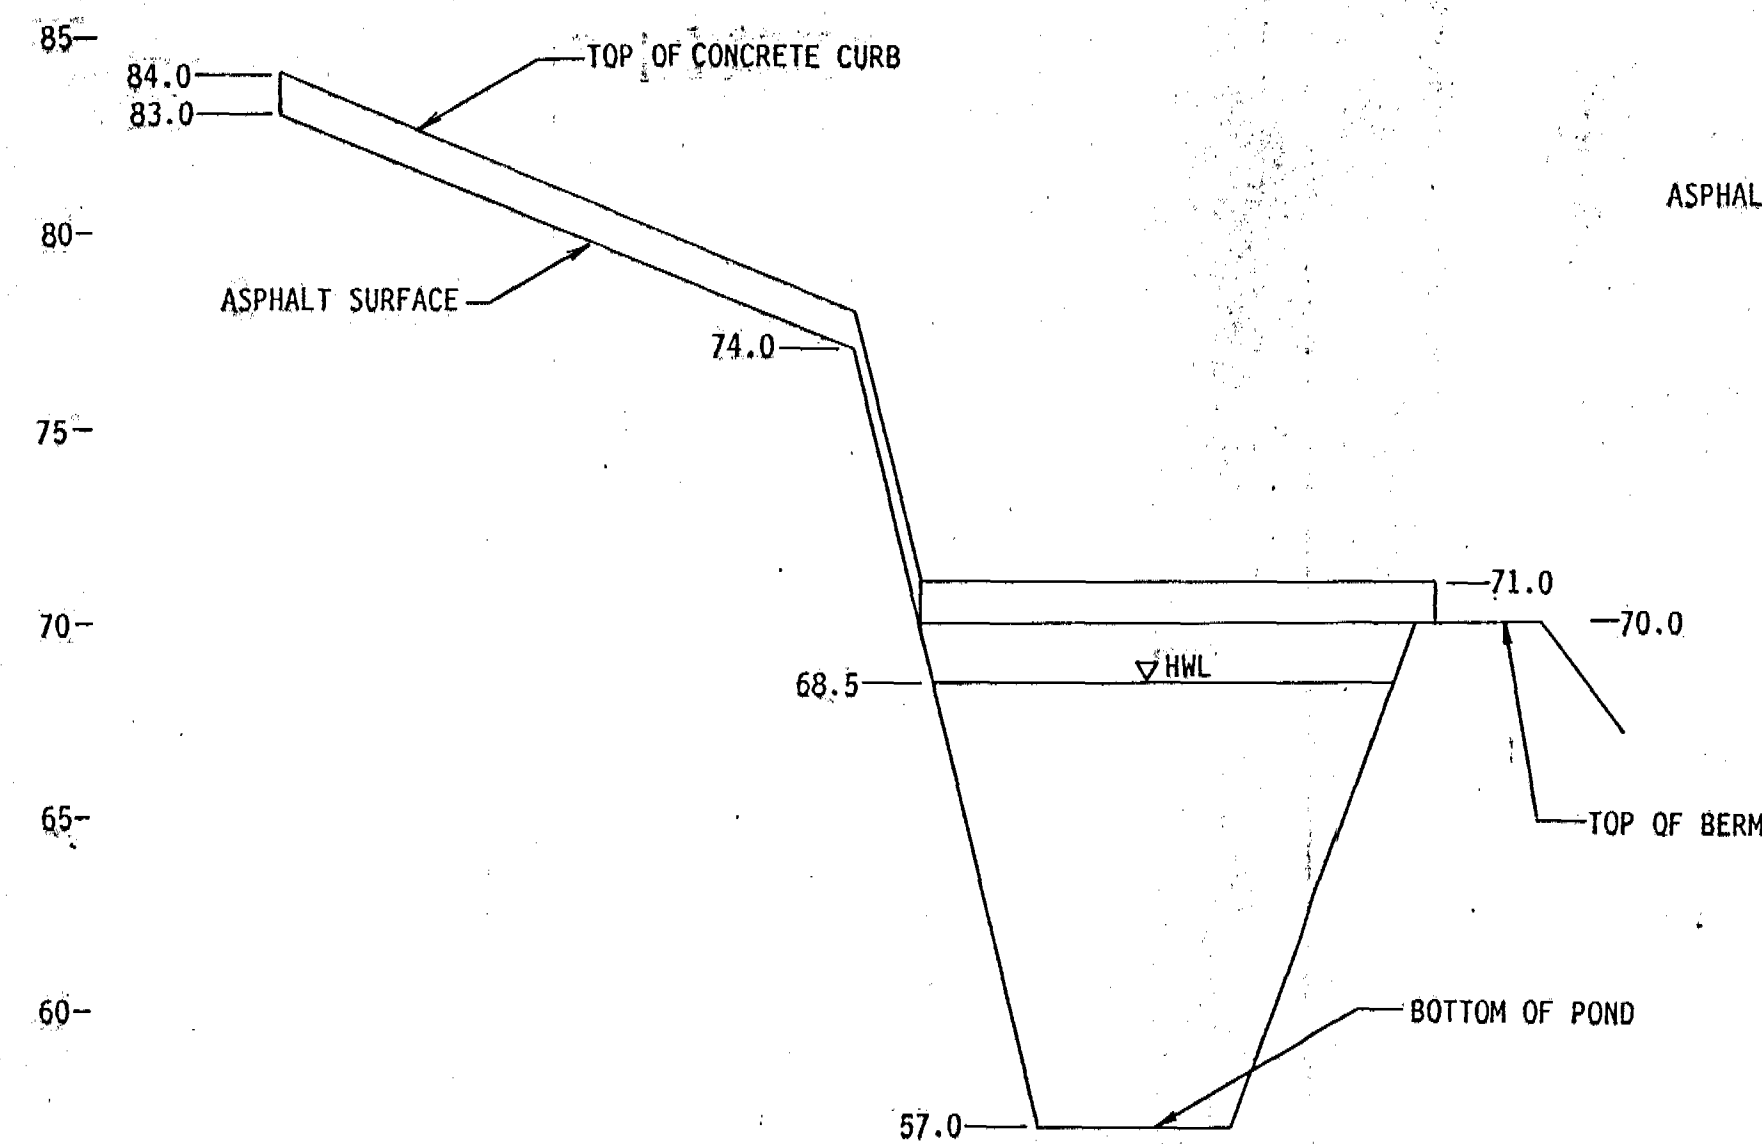


HYDRAULIC PROFILE - SOUTH FACILITIES

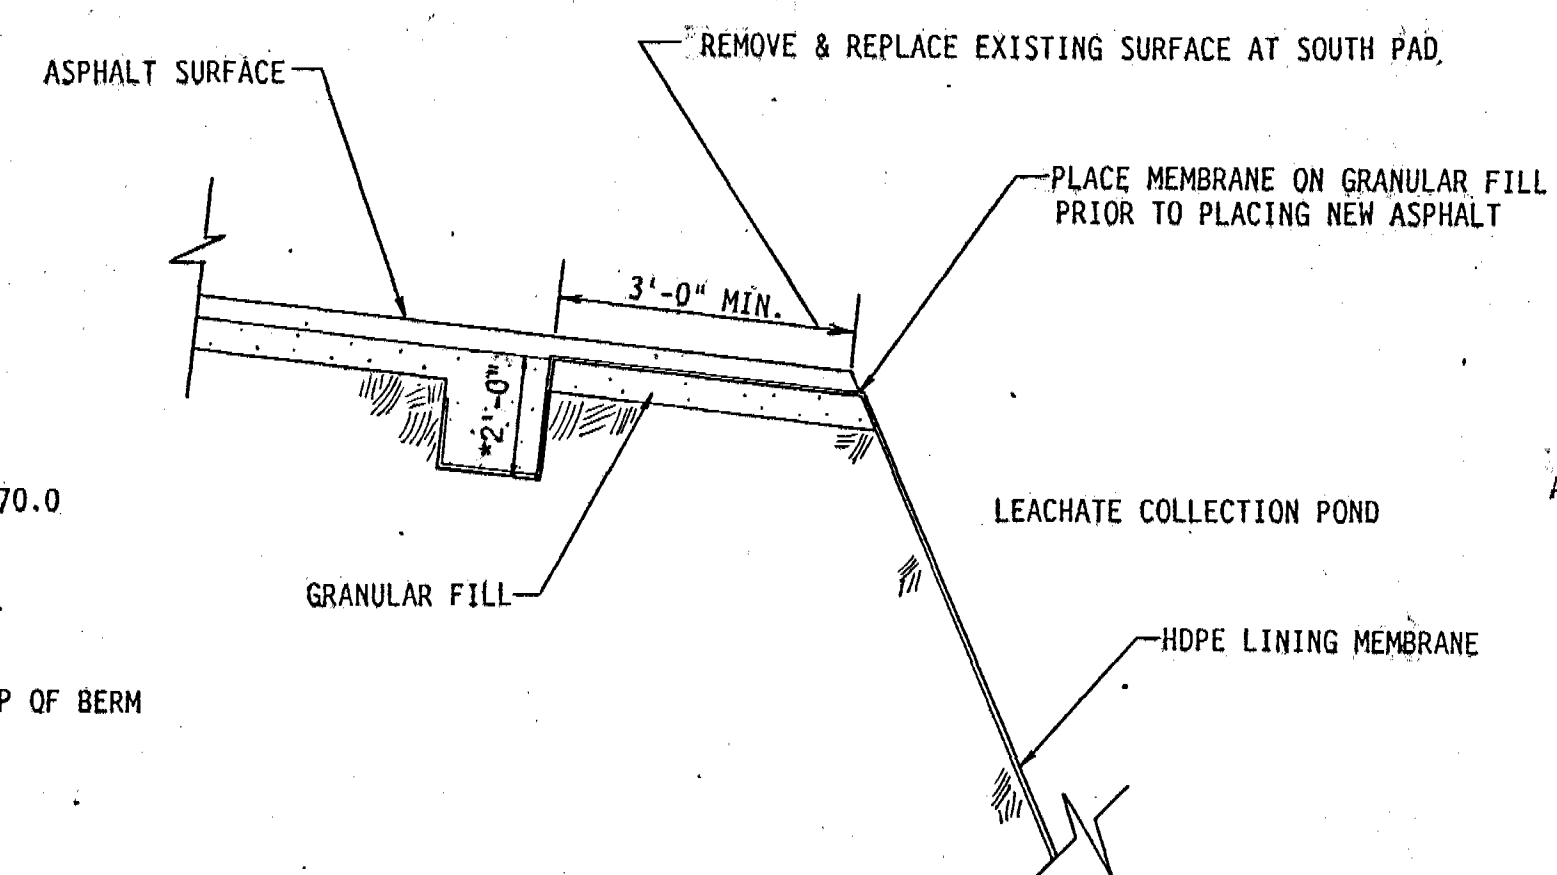


DETAIL A
LINING MEMBRANE - ASPHALT CONNECTION
NO SCALE

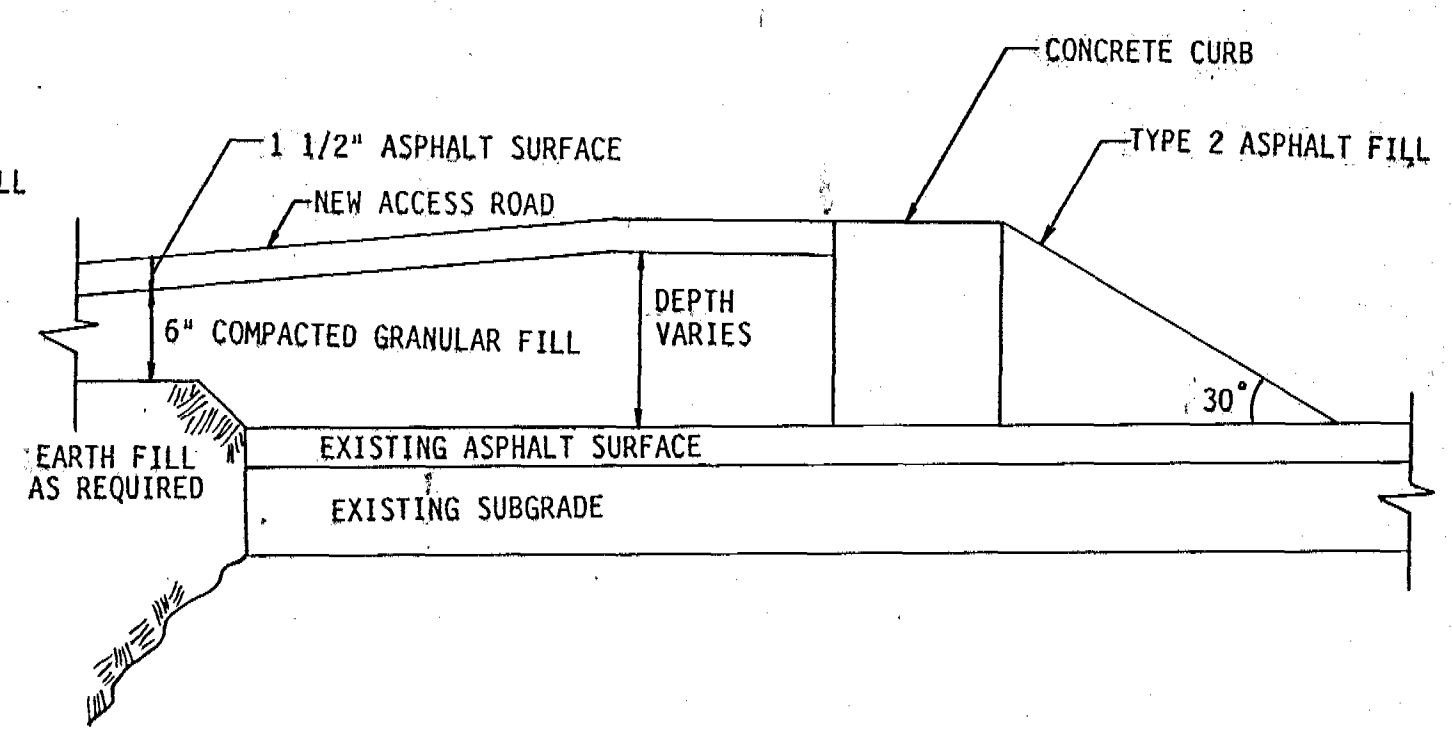


DETAIL B
NO SCALE

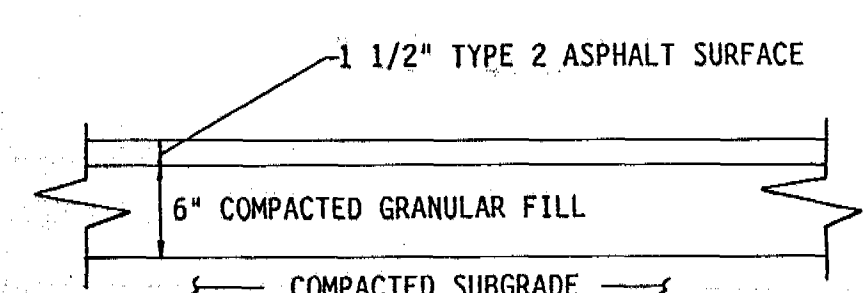


ASPHALT SURFACE DETAIL
SCALE 1" = 1'-0"

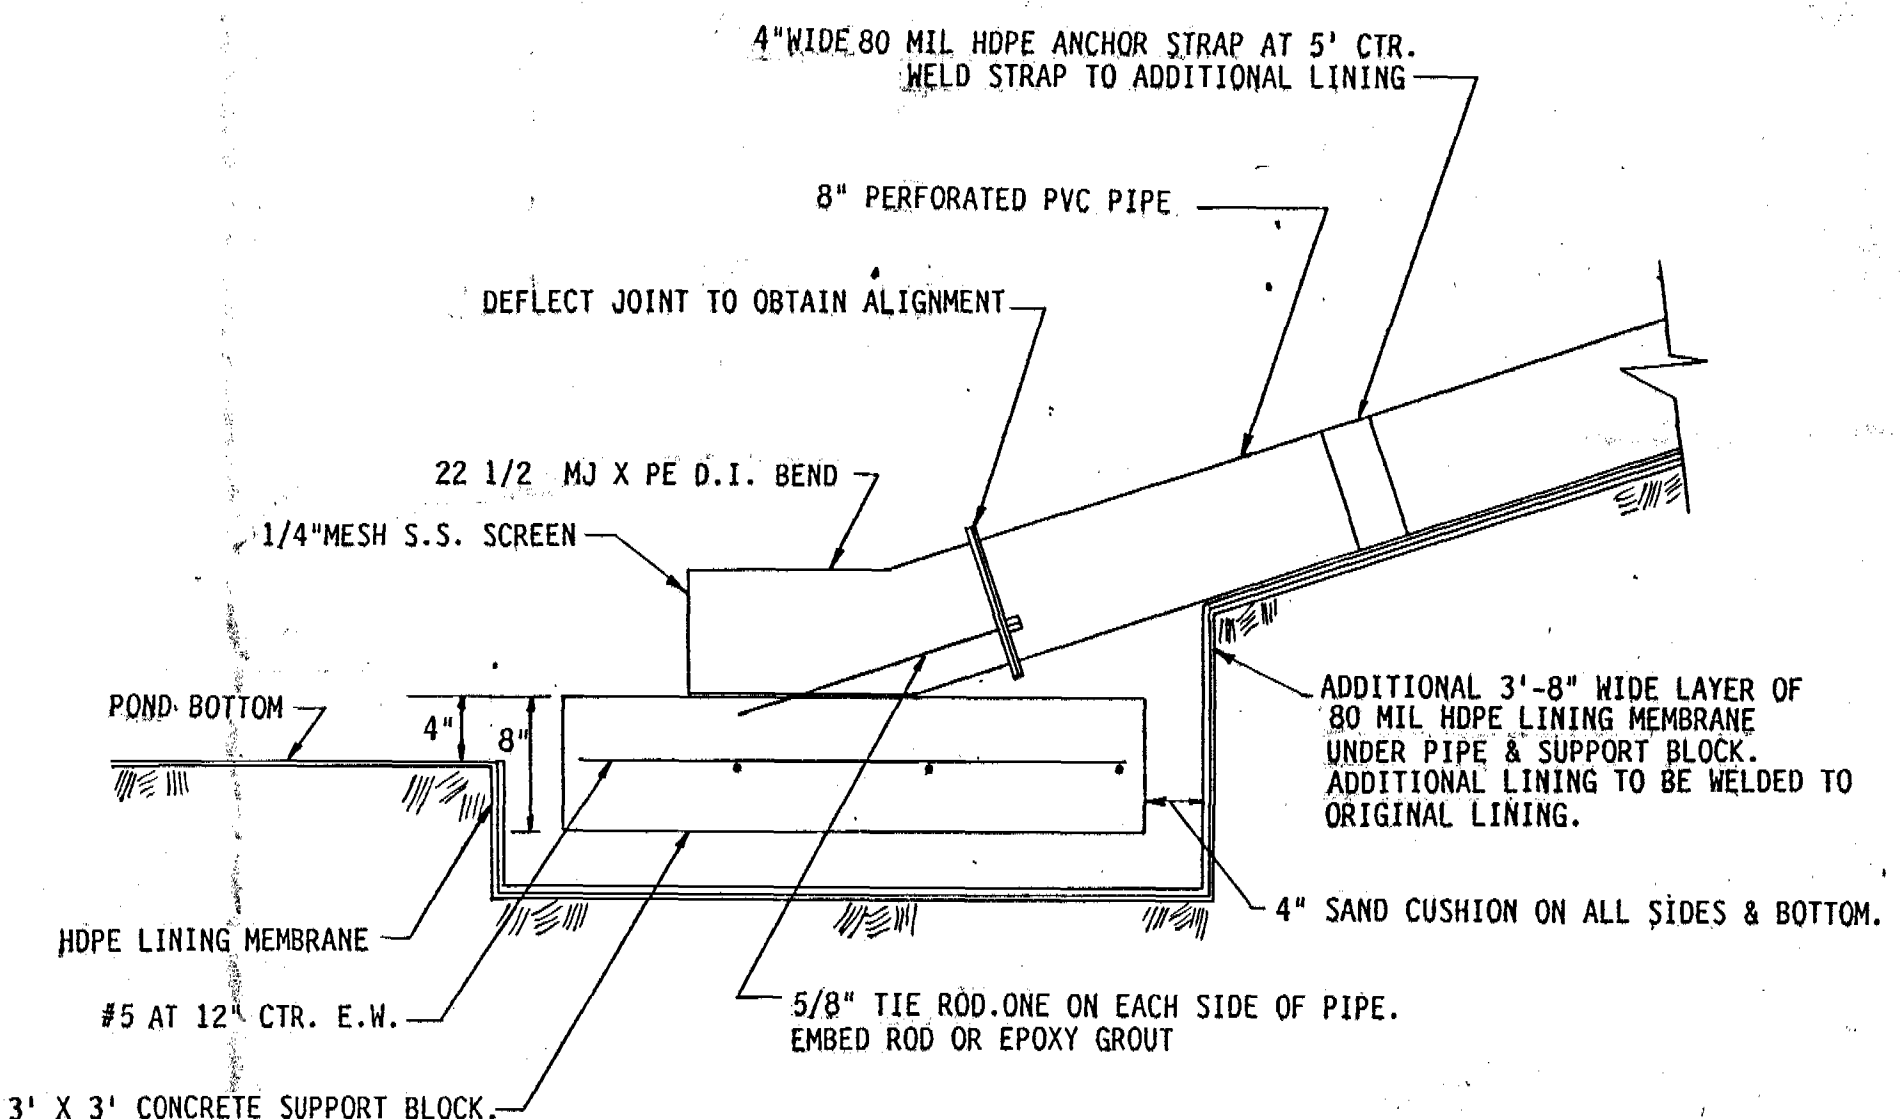


PVC PIPE SUPPORT
SCALE 1" = 1'-0"

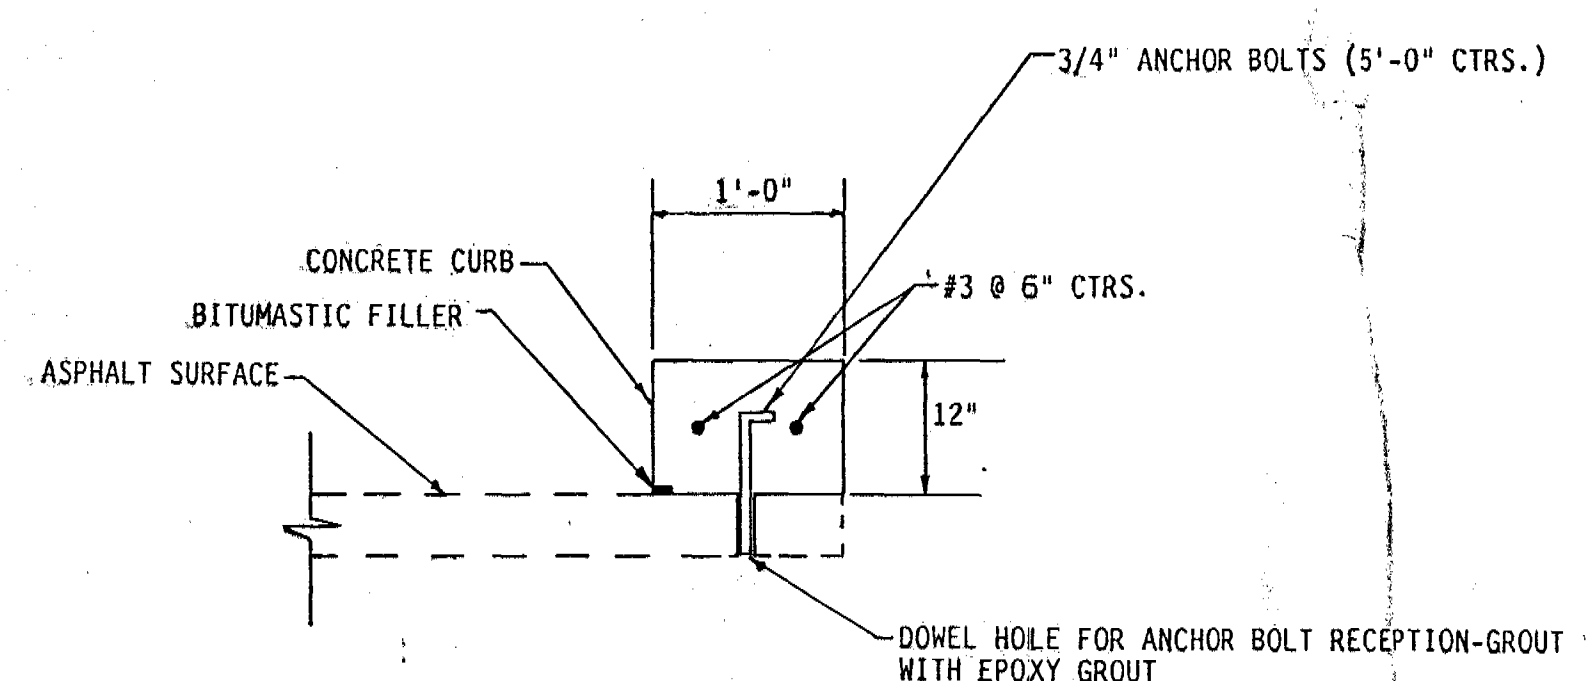


CONCRETE CURB ON ASPHALT
SCALE 1" = 1'-0"

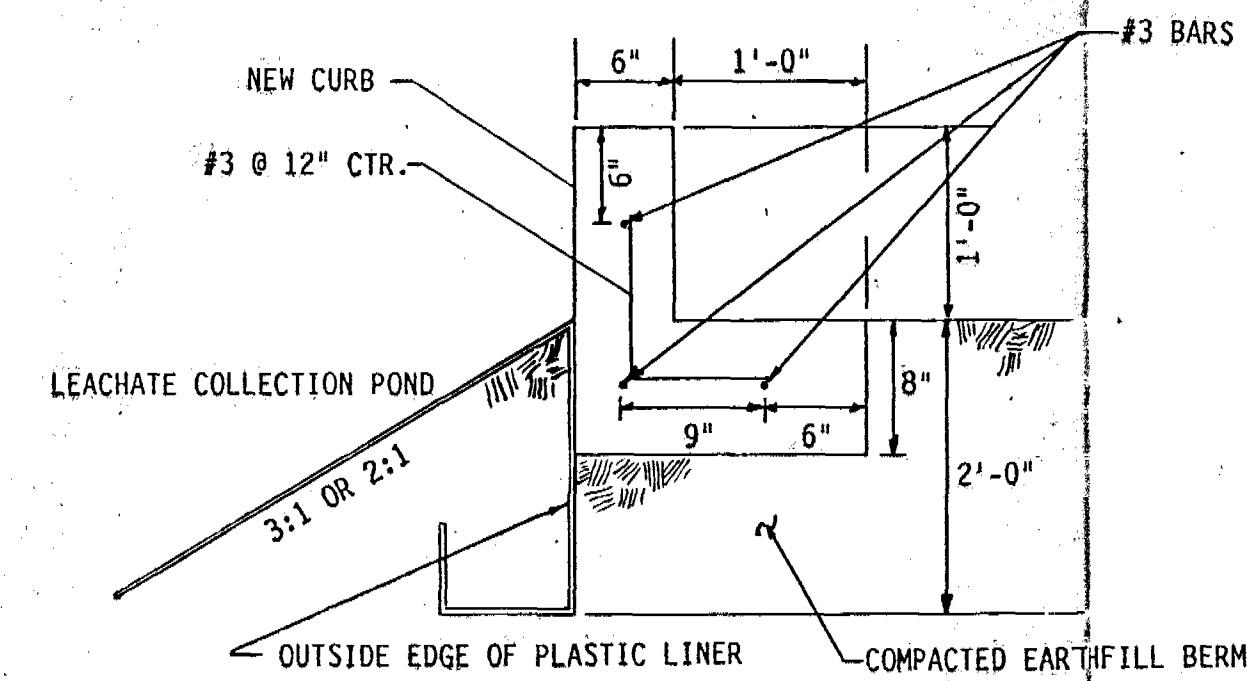


CONCRETE CURB ON SOIL
SCALE 1" = 1'-0"

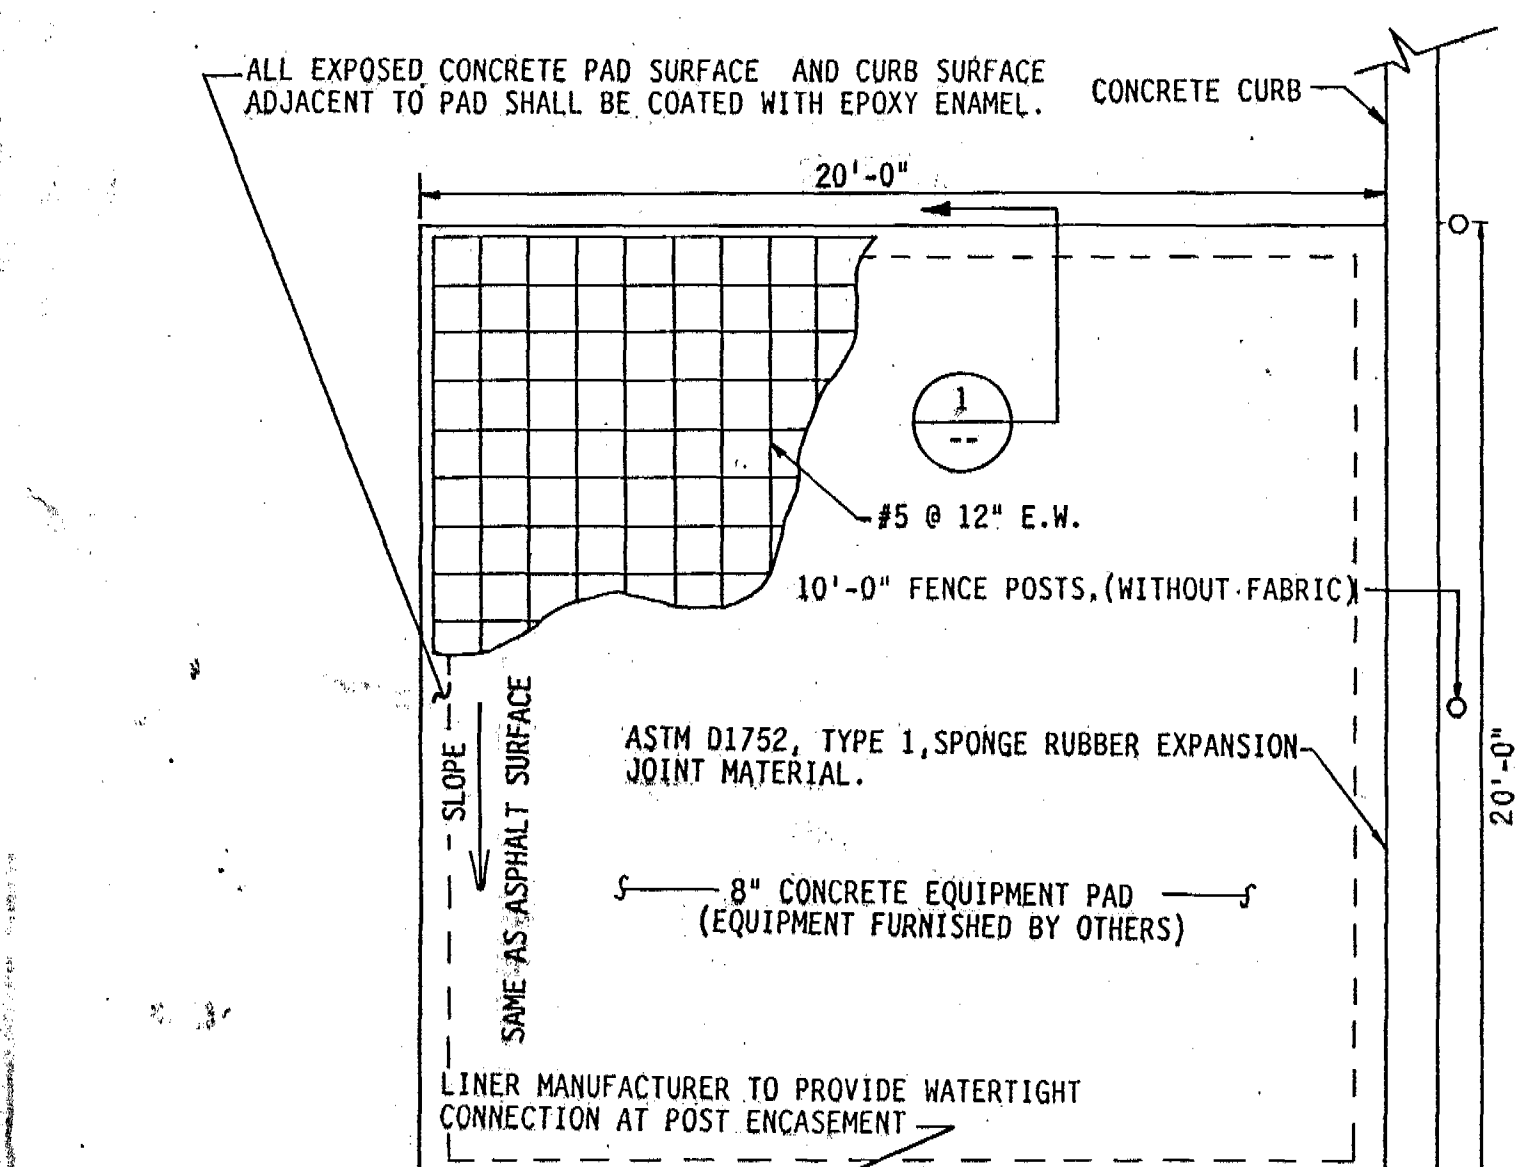

EQUIPMENT PAD
SCALE 1/4" = 1'-0"

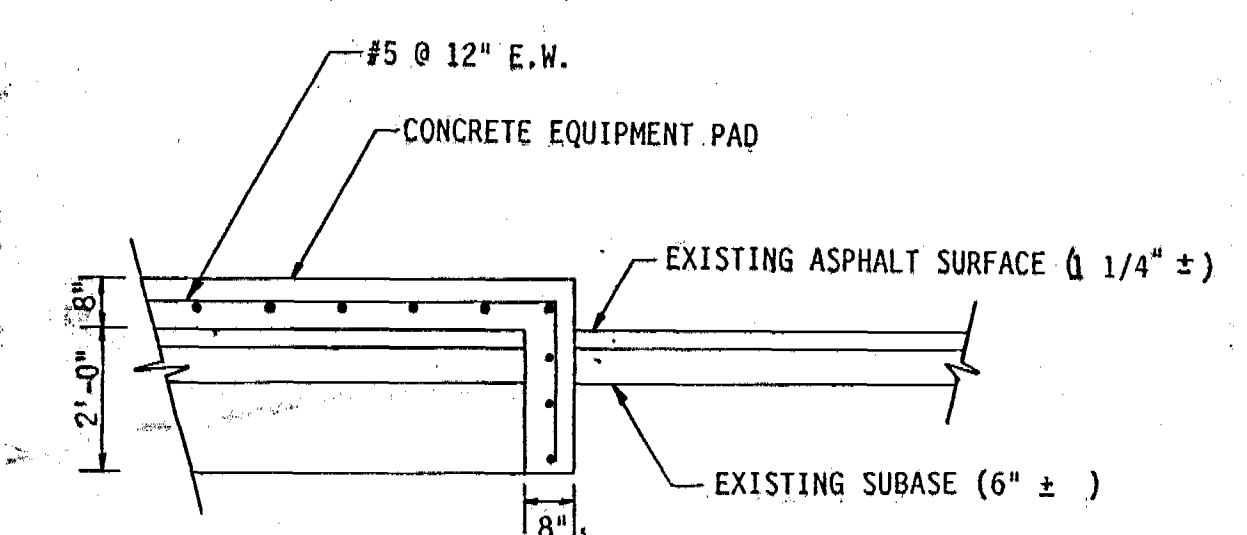

SECTION
SCALE 3/8" = 1'-0"

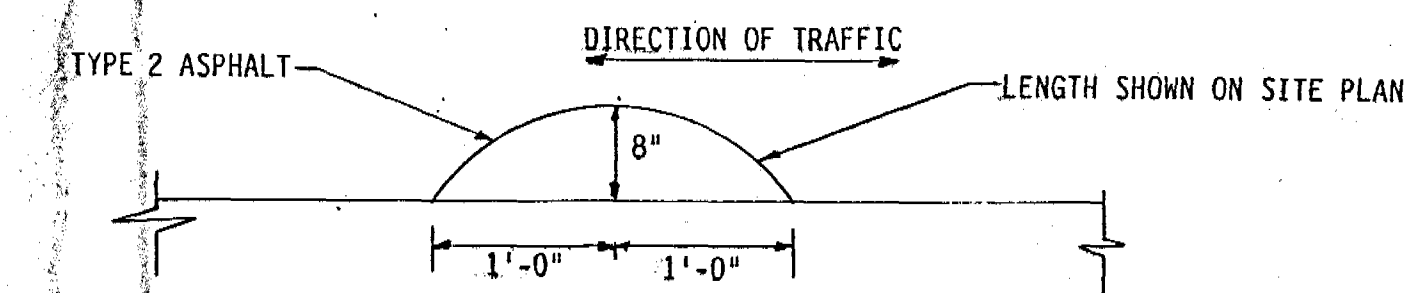


DETAIL
SCALE 1" = 1'-0"

NOTE: CONCRETE CURBS MAY BE CAST-IN-PLACE OR PRECAST UNITS. IF PRECAST UNITS ARE USED CONCRETE SHALL BE AS SPECIFIED FOR CAST-IN PLACE AND ALL JOINTS SHALL BE WATERTIGHT AND ACCEPTABLE TO THE ENGINEER.

CONFORMED TO CONSTRUCTION RECORDS
DATE: MARCH 1992
FIELD CHANGES NOTED: GLP
DETAILED: TCR
APPROVED: GLP

DATE	REVISIONS AND RECORD OF ISSUE	NO.	BY	CK	APP

DESIGNED: GLP
DETAILED: TCR
CHECKED: TAC
APPROVED: GLP
DATE: APRIL 19, 1991

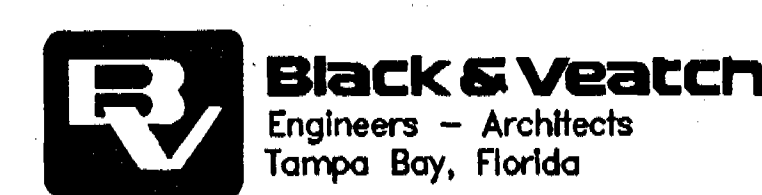


PROJECT NO.
17239.202

SUMTER COUNTY
BOARD OF COUNTY COMMISSIONERS
SUMTER COUNTY, FLORIDA
COMPOSTING FACILITY SITE IMPROVEMENTS


SECTIONS AND DETAILS






SD-1
SHEET
2 OF 4

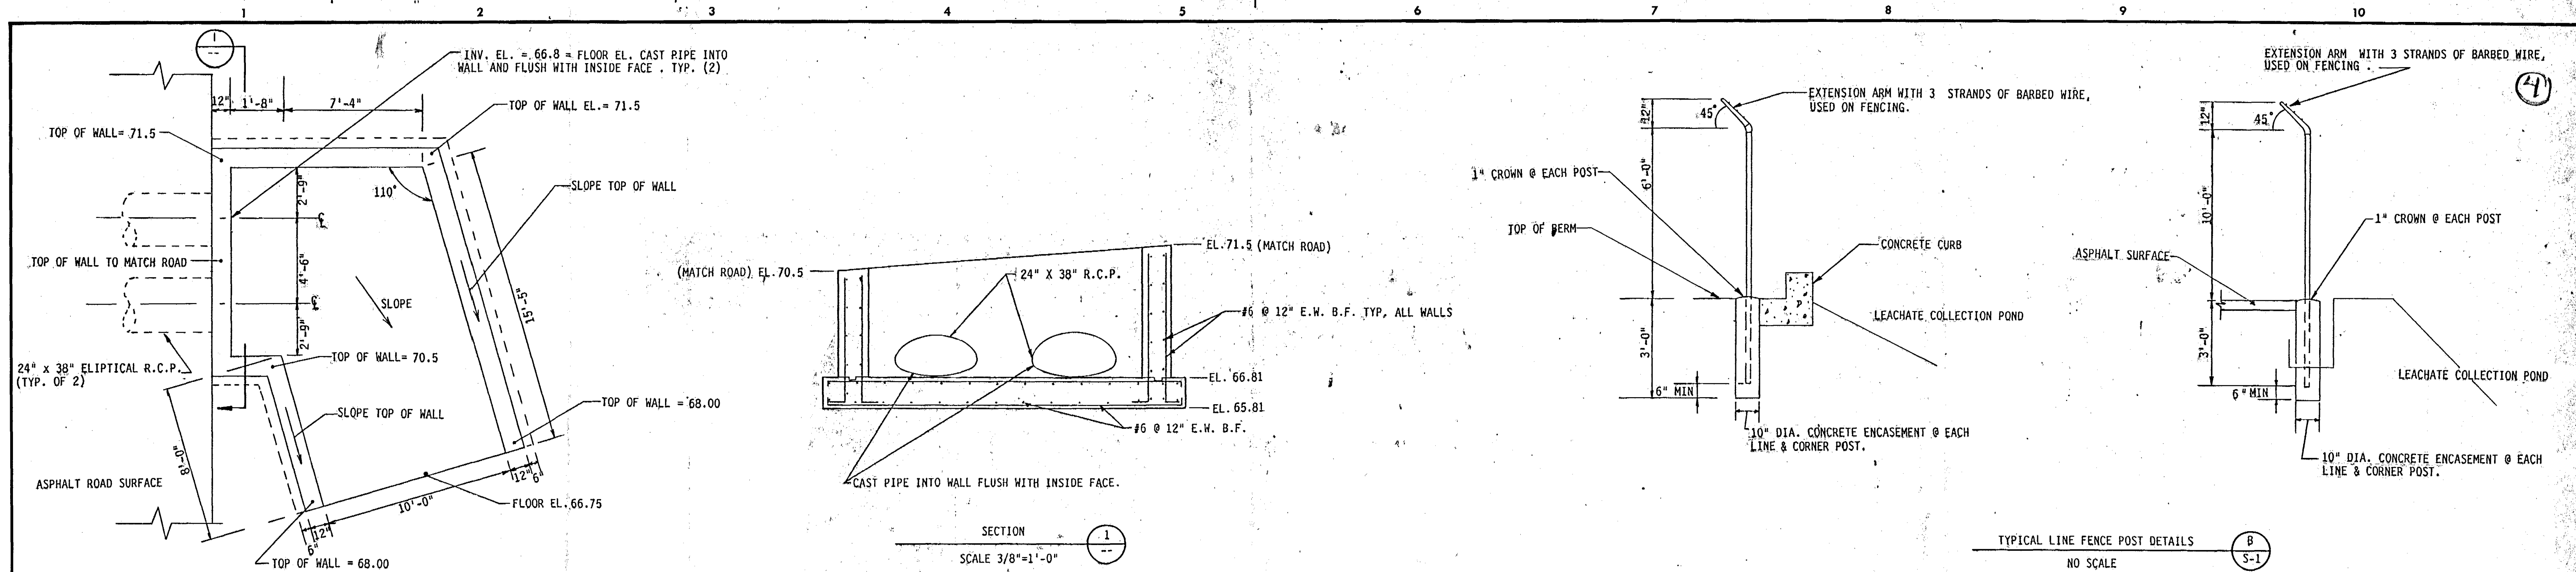

CONCRETE PIPE HEADWALL
SCALE 1/4"=1'-0"

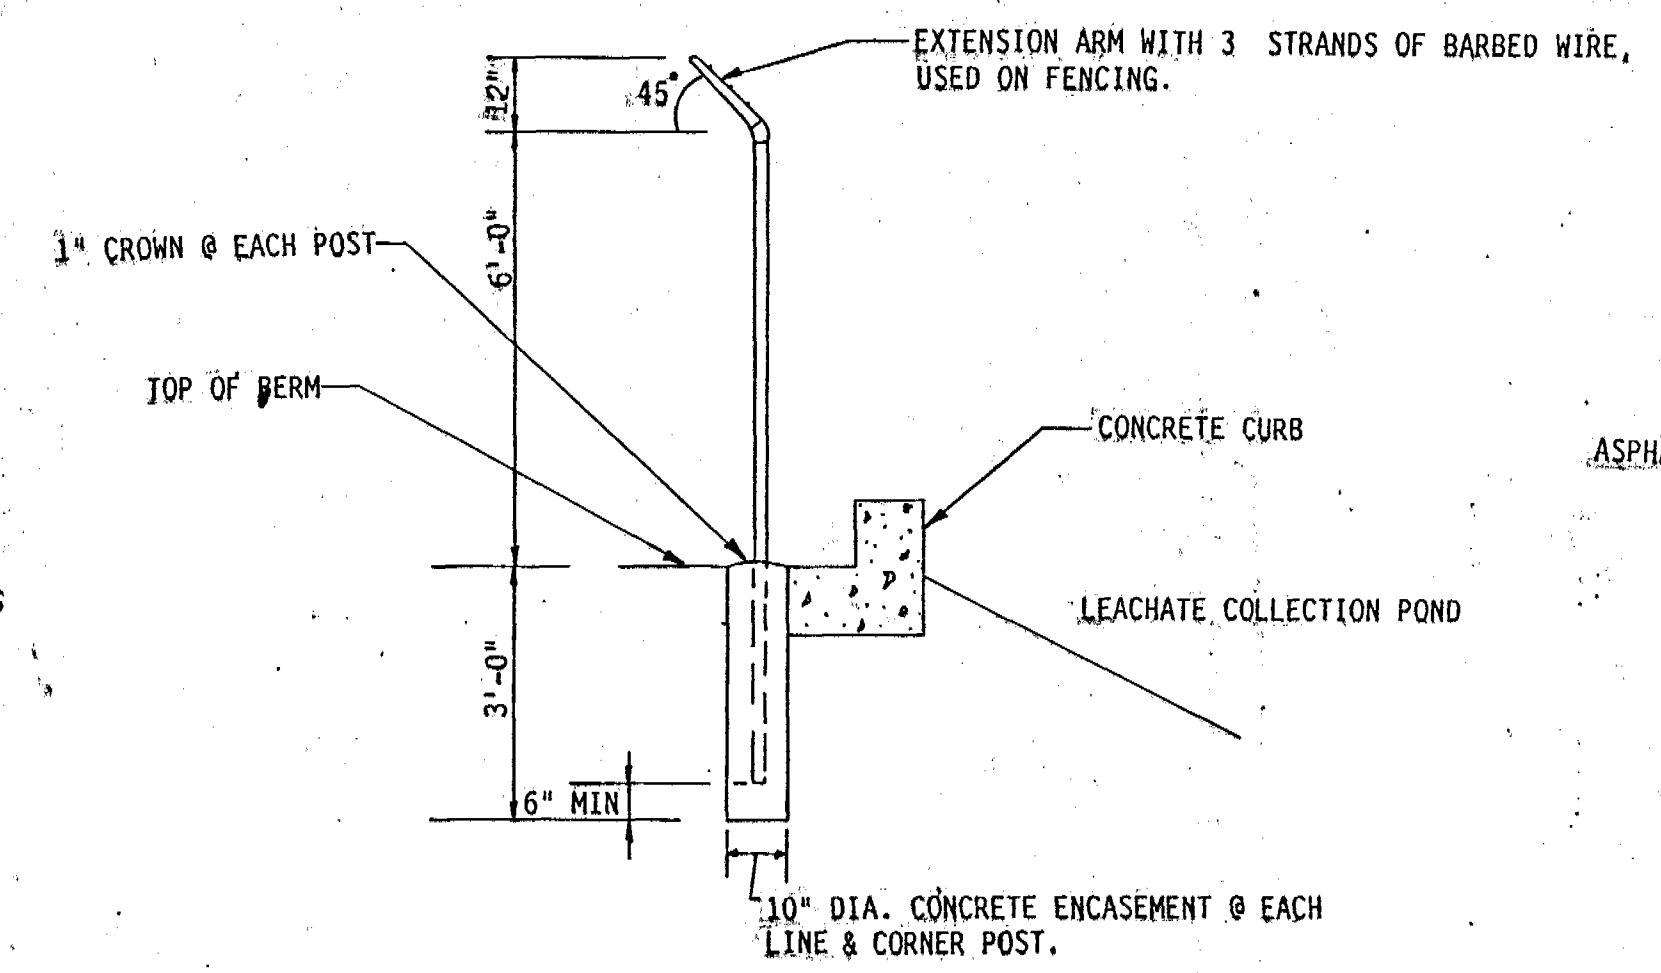


TYPICAL LINE FENCE POST DETAILS
NO SCALE

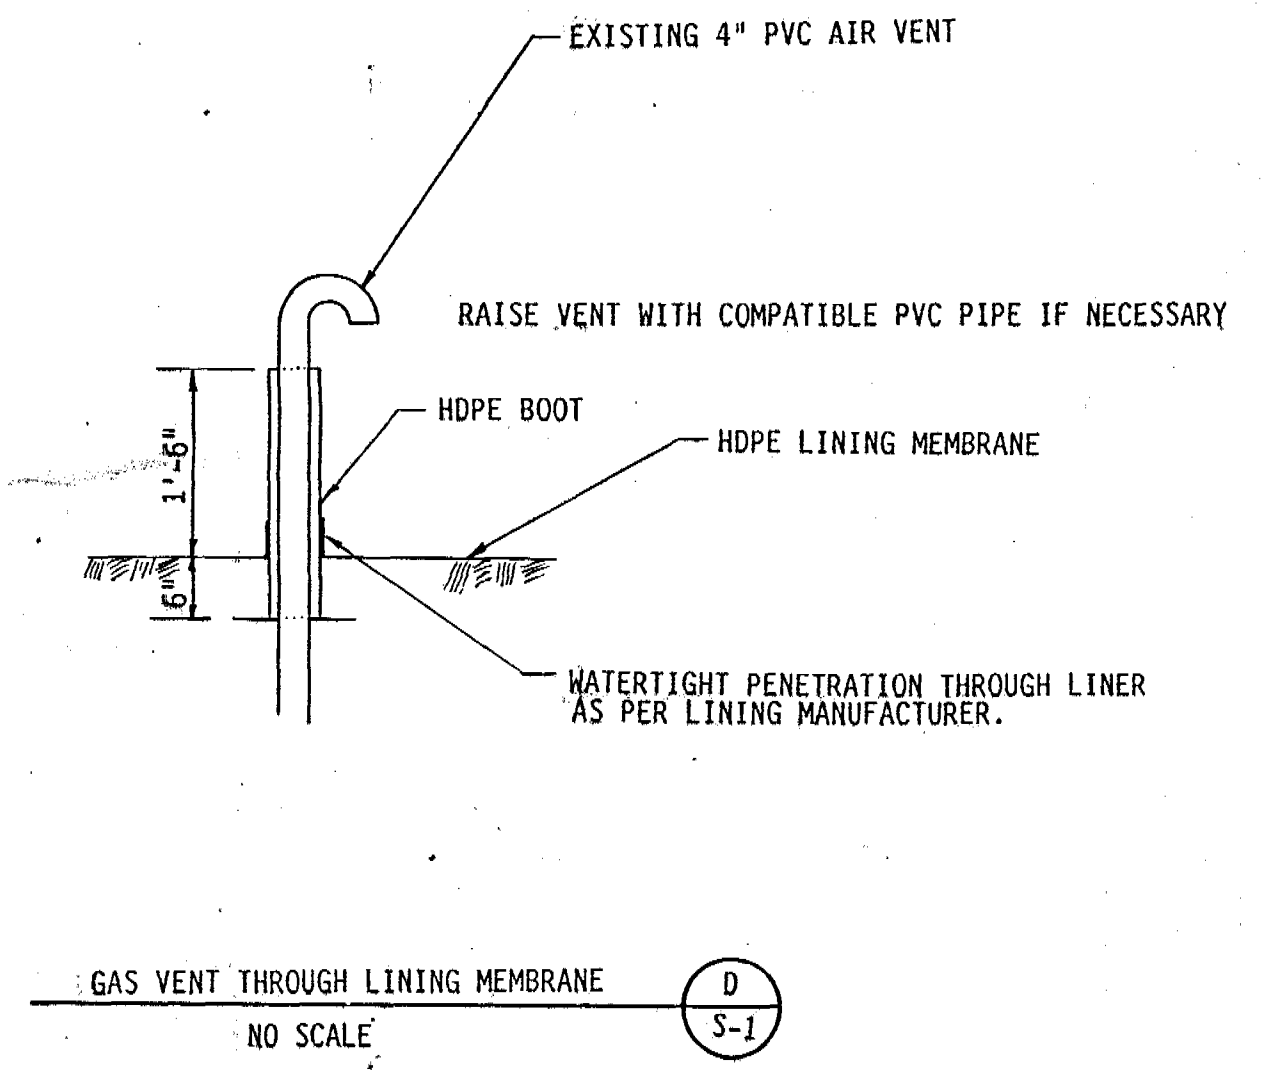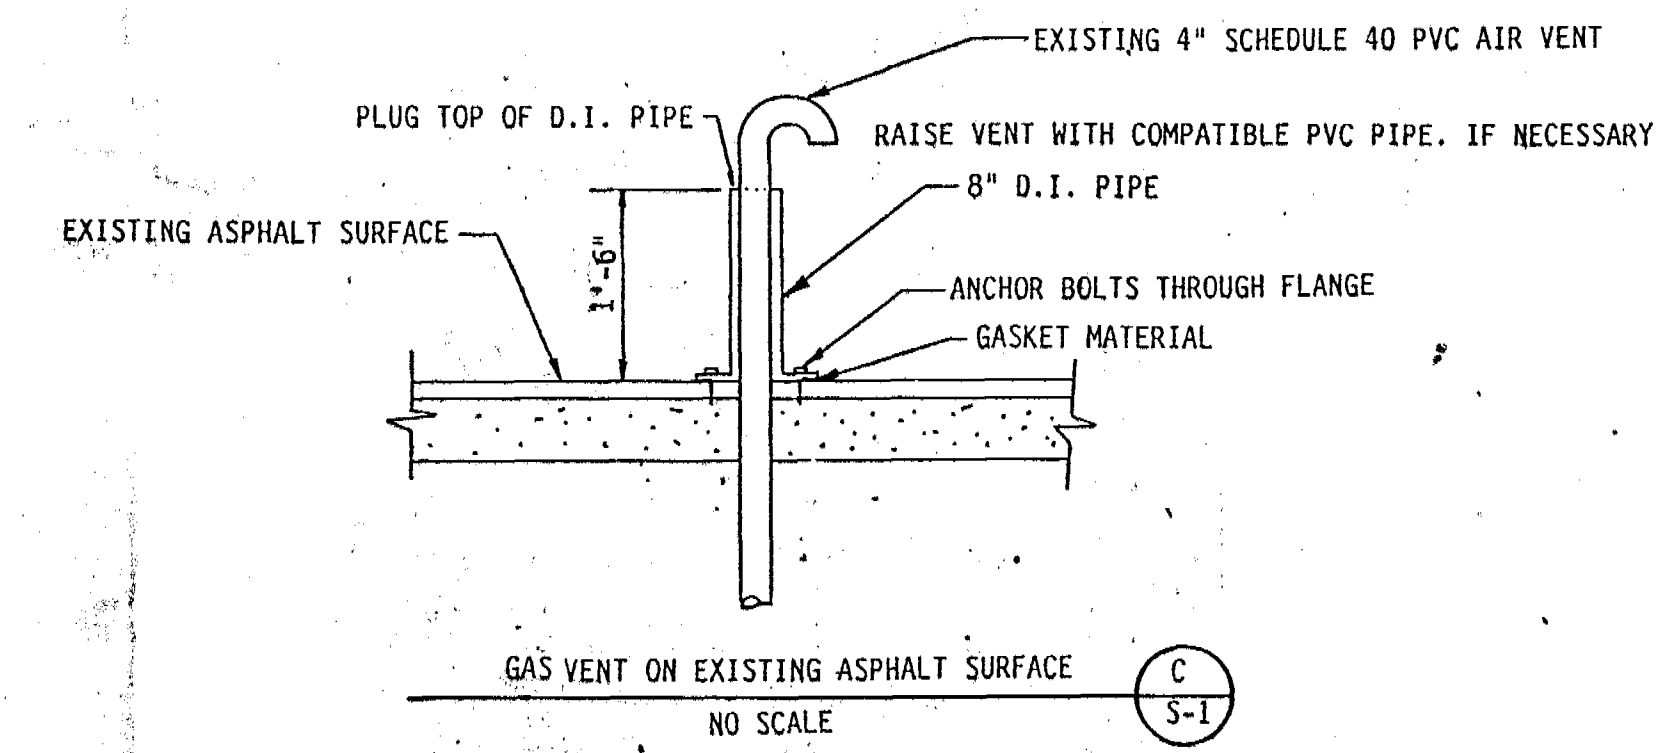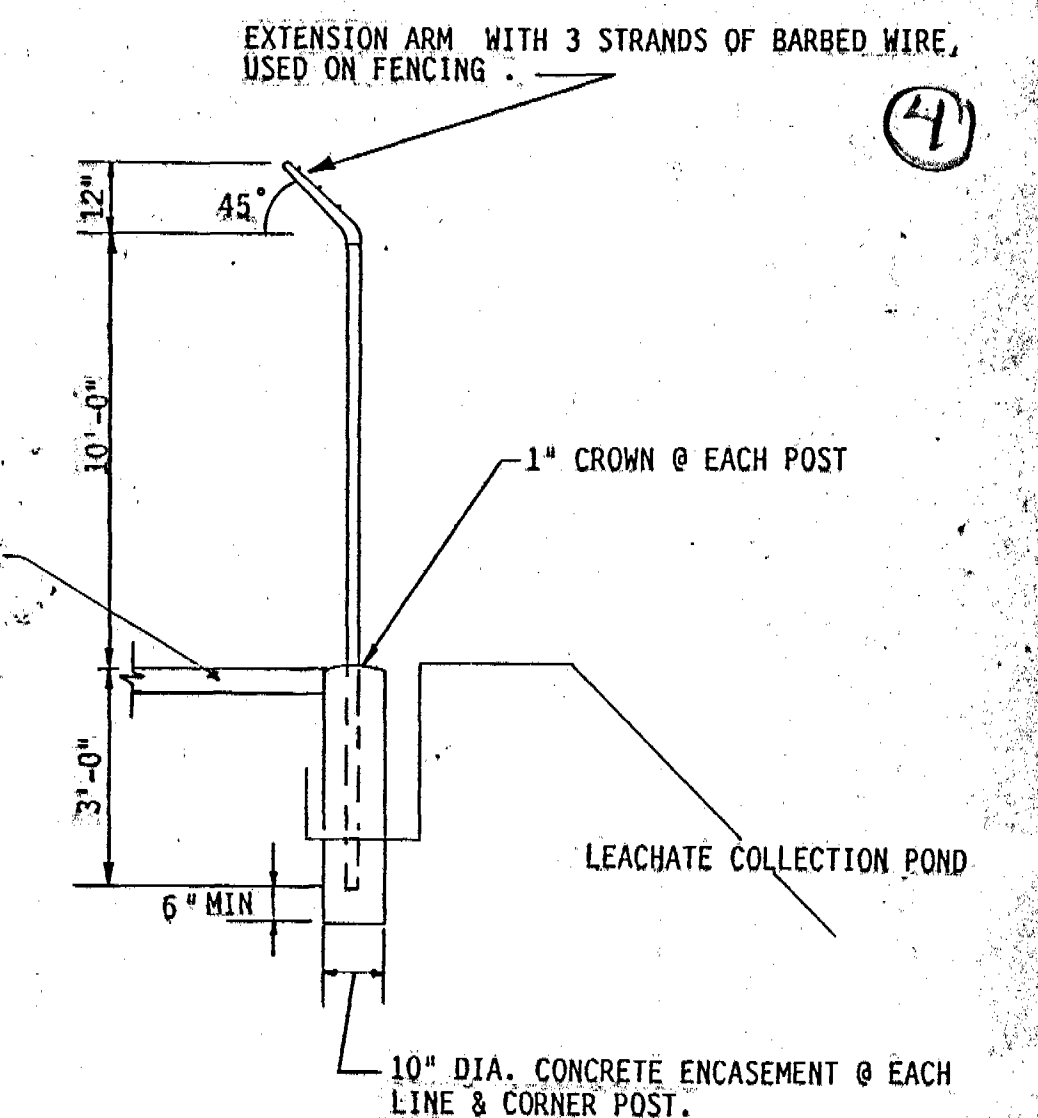

CONFORMED TO CONSTRUCTION RECORDS
DATE: MARCH 1992
FIELD CHANGES NOTED: GLP
DETAILED: TCR
APPROVED: GLP *Gregory L. P.*

NO.	BY	CHK	APP	DATE	REVISIONS AND RECORD OF ISSUE
1					
2					
3					
4					
5					
6					
7					
8					
9					
10					


DESIGNED: GLP
DETAILED: TCR
CHECKED: TAC
APPROVED: GLP
DATE: APRIL 19, 1991

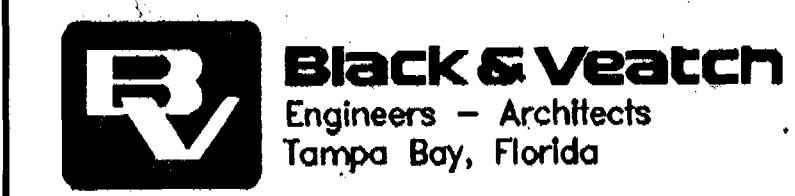


PROJECT NO.
17239.202

SUMTER COUNTY
BOARD OF COUNTY COMMISSIONERS
SUMTER COUNTY, FLORIDA
COMPOSTING FACILITY SITE IMPROVEMENTS

SECTIONS AND DETAILS

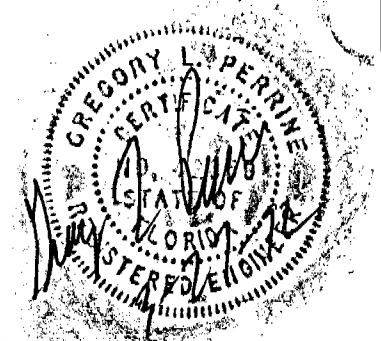

SD-2
SHEET
3 OF 4

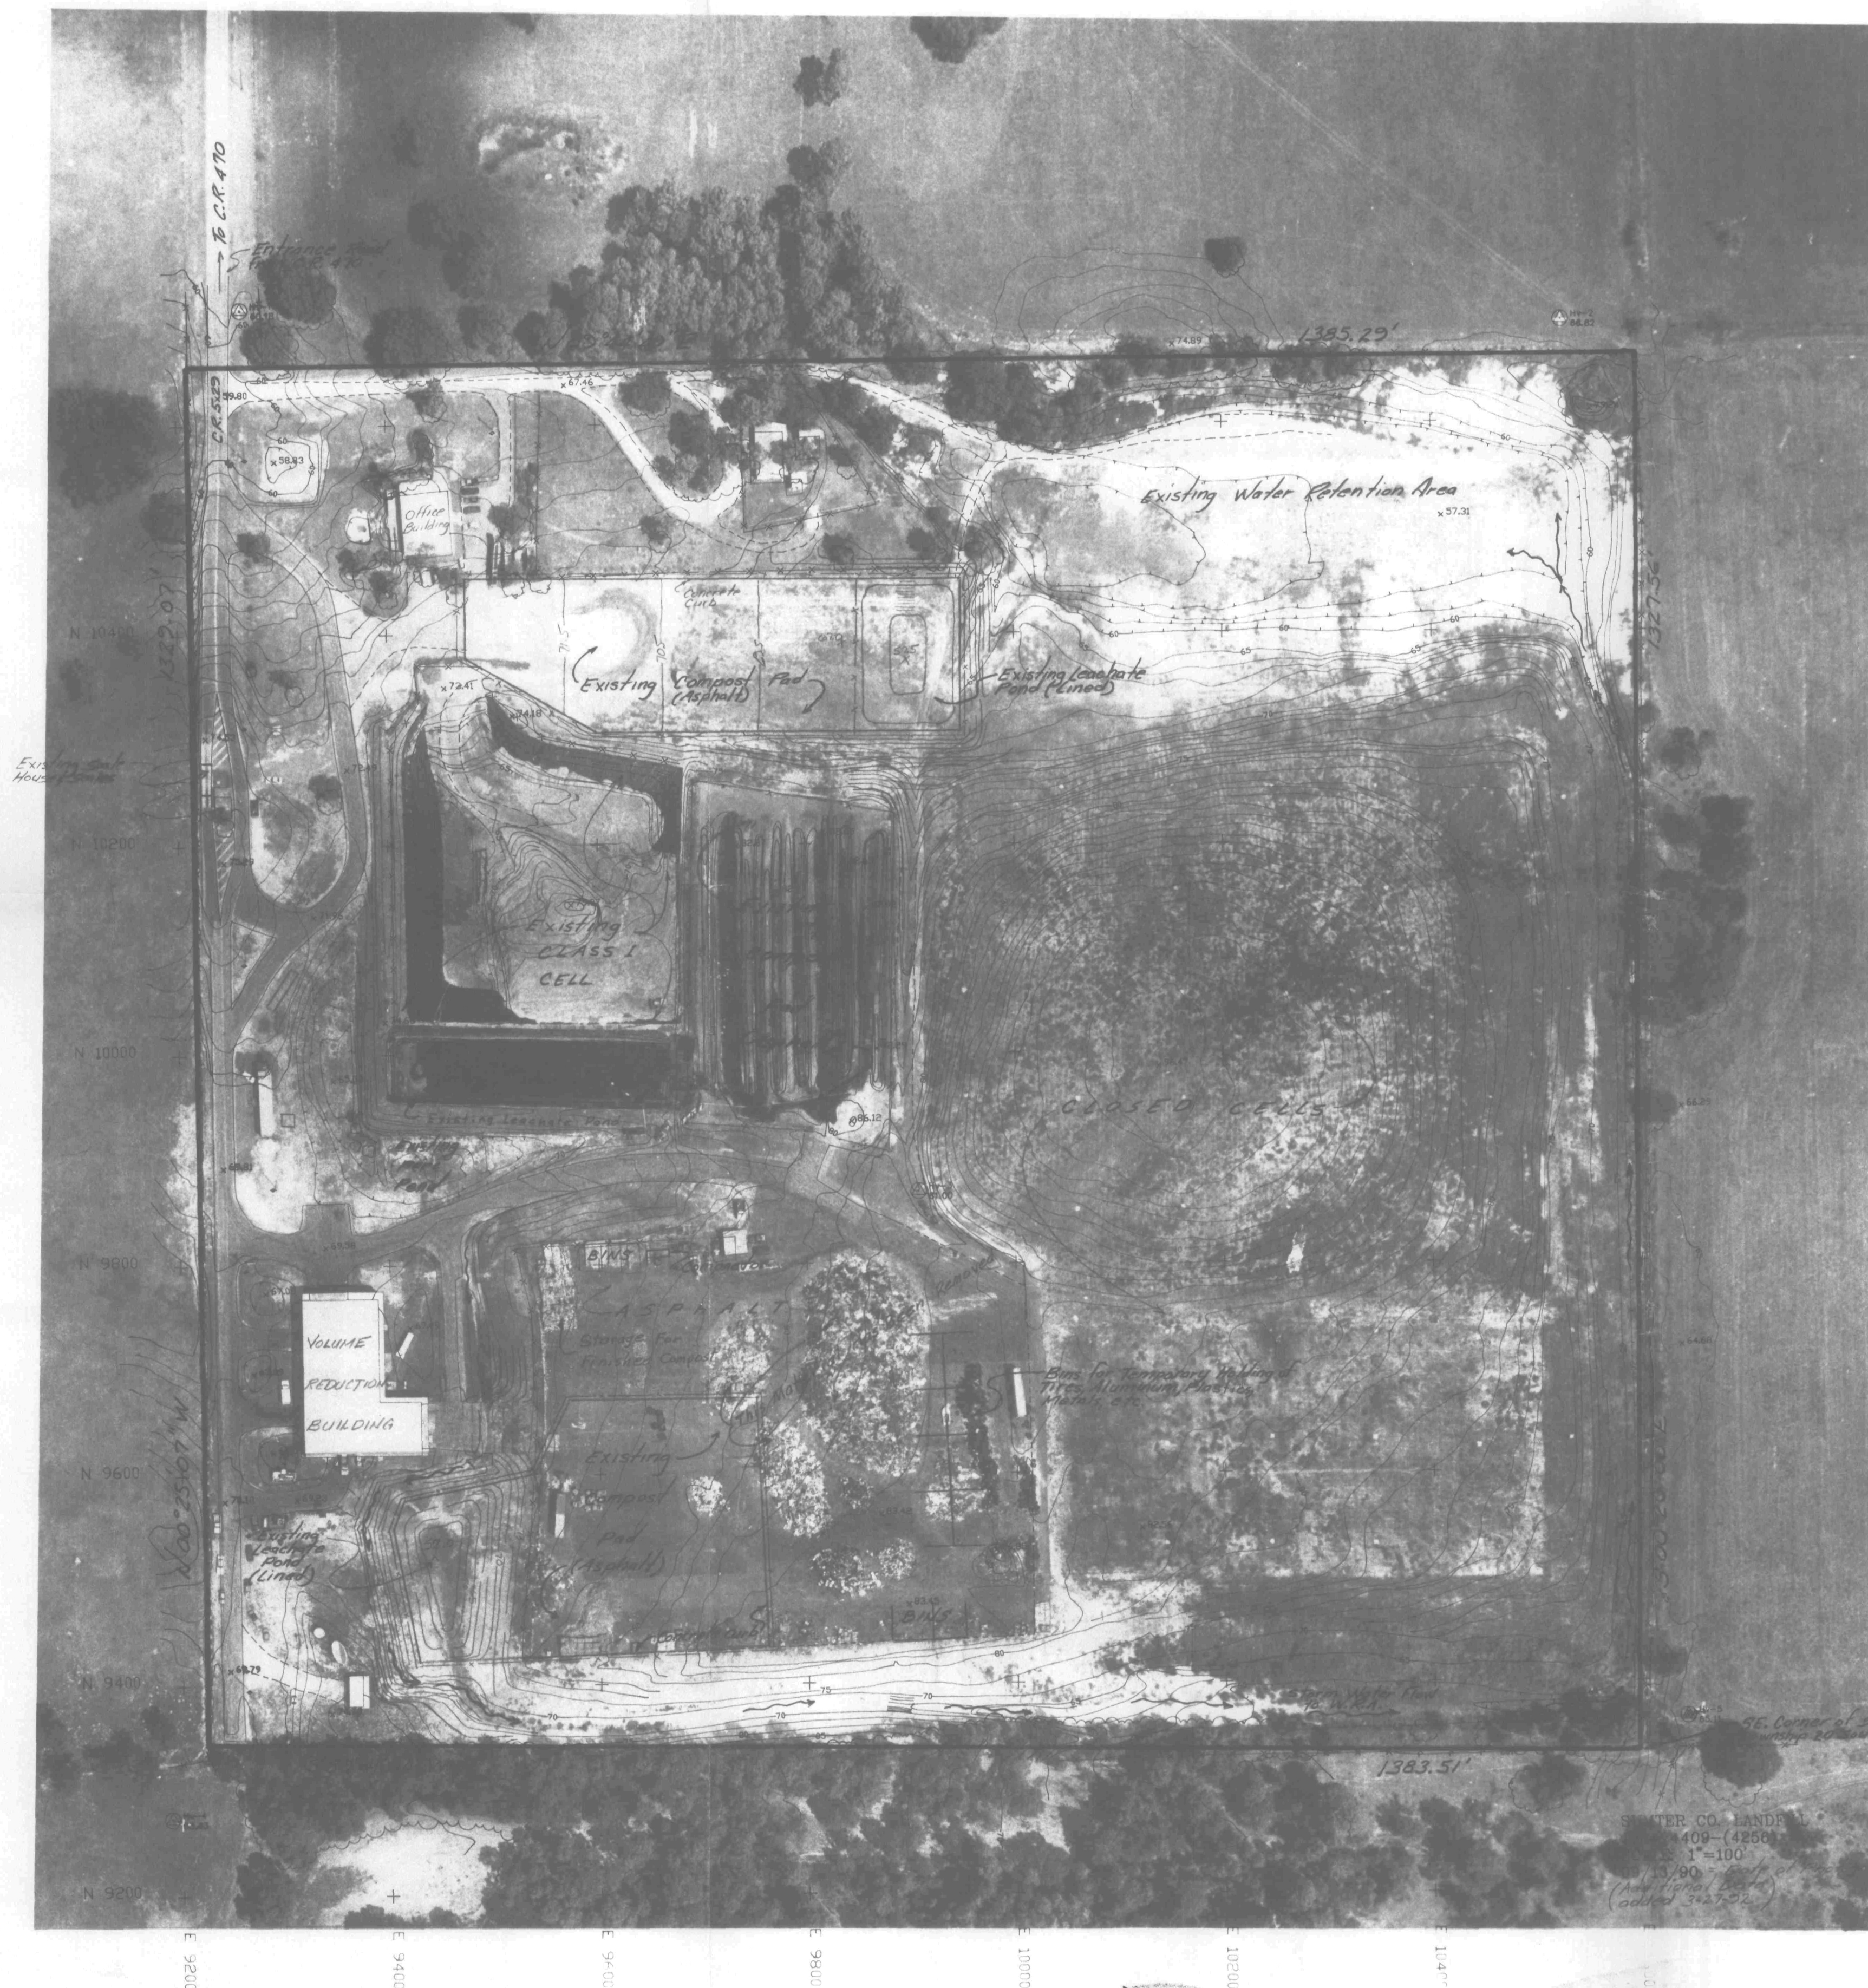

Scale: 1" = 100'

- Legend:
- = Asphalt Pavement
 - = Flow Direction
 - = Fence
 - = Spot Elevation
 - = Contour

REV. BY:		DESCRIPTION:		DATE:	
Springstead Engineering, Inc.		SITE PLAN FOR SUMTER COUNTY SOLID WASTE MANAGEMENT FACILITY		DATE: 03/27/92	
Consulting Engineers		Planners		Surveyors	
DESIGN: RWW	DRAWN: R.L.F.	CHECKED: JWS	SHEET: 1 OF: 1	FILE: 921100	JOB NO: 921100