

1564493 ①

LEGEND

- BRUSHLINE
- CABLE MARKER
- CATCH BASIN
- DROP INLET
- FENCE
- GUARD RAIL
- LIGHT POLE
- MISCELLANEOUS POLE
- MONITORING WELL
- CENTERLINE OF EXIST. S.W.A.L.E.
- SUMP
- STORMWATER FILTRATION C/D

- MONUMENT
- POST
- RAILROAD TRACKS
- SIGN
- SWAMP
- TRAFFIC LIGHT
- TREE
- TREELINE
- UNIDENTIFIED OBJECT
- UTILITY POLE
- VALVE
- WATER LINE
- DRAINAGE FLOW DIRECTION
- LEACHATE COLLECTION SYSTEM C/D

ABBREVIATIONS


- AASPH
- A/C
- BR
- CB
- CONE
- DI
- HDWL
- HC
- HM
- TRANS
- U/C
- VD
- WOOD
- AIR CONDITIONER
- BRICK
- CATCH BASIN
- CONCRETE
- DROP INLET
- HEAD VALL
- METAL COVER
- MANHOLE
- TRANSFORMER
- UNDER CONSTRUCTION
- WALL

CONTROL LEGEND

POINT	DESCRIPTION	NORTH	EAST	ELEV.
1A	PANEL TARGET	1249252.2388	438212.4226	127.57
2A	PANEL TARGET	1249368.4921	439183.3644	125.52
3	PANEL TARGET	1249245.2818	440427.7973	126.66
4	PANEL TARGET	1249123.1526	441960.7618	130.04
5	PANEL TARGET	1249215.9069	442490.6826	125.91
6	PANEL TARGET	1251752.6548	439263.6526	128.74
7B	PANEL TARGET	1251467.706	440681.573	141.87
8	PANEL TARGET	1251440.3349	441914.9603	137.76
9	PANEL TARGET	1251415.3182	443469.7110	134.72
10	PANEL TARGET	1251971.6539	444410.6075	147.57
11	PANEL TARGET	1254193.5549	438946.0680	97.08
12	PANEL TARGET	1254225.9970	440388.4090	108.09
13	PANEL TARGET	1254257.2909	441873.9292	114.64
14	PANEL TARGET	1254255.4851	443345.6208	117.57
15	PANEL TARGET	1254232.4500	444864.5679	122.77
16	PANEL TARGET	1249941.6523	441795.3615	171.57

This map compiled by photogrammetric methods
From aerial photography dated 3-18-94
Vertical datum based on MGS Mean Sea Level
Contour interval 1 ft
Grid based on Florida State Plane
Coordinate System NAD 1987
Air Survey Corp. Project NO.7940226

Dashed contours indicate that ground is
partially obscured by vegetation or shadows.
These areas may not meet standard accuracy
and require field testing/completion.

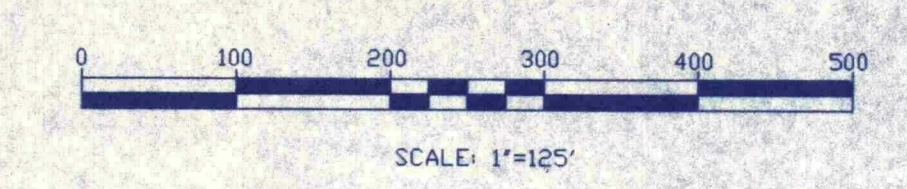

NOTE:
ALL TEMPORARY AND PERMANENT DRAINAGE STRUCTURES
ARE IDENTIFIED ON THE FINAL DRAINAGE PLAN DRAWING
NO. 3, APPENDIX E.

REV	DATE	DESCRIPTION	DES BY	APP BY
PROJECT NO.				
DATE				
DES BY		SOUTHEAST COUNTY LANDFILL		
DRN BY		EXISTING TOPOGRAPHY		
CHK BY		PERMIT RENEWAL-APPENDIX D		
APP BY		Waste Management of North America, Inc.		
			SOUTHEAST REGION	
			SHEET 1 OF 5	
			DRAWING NO.	

APPROXIMATE 100-YEAR FLOODPLAIN FROM FLOOD
INSURANCE RATE MAP REVISED APRIL 17, 1984

STORMWATER
DETENTION FILTRATION
BASIN 'D'

RISER

PROPERTY LINE

APPROXIMATE LIMITS OF
BORROW AREA

10,000 GAL LEACHATE STORAGE TANK
PERMANENT PUMP STATION 'A'

APPROXIMATE LANDFILL LIMITS

PHASE V

PHASE III

MATCH SHEET 4

CADD PRODUCED DRAWING

FILE NAME: 1564493.DWG
FILE PATH: C:\1564493\1564493.DWG

REFERENCE FILES: R14
R15
R16
R17
R100

ABBREVIATIONS

ASPH	ASPHALT	AC	AIR CONDITIONER
BR	BRICK	CB	CATCH BASIN
C.C.M.C.	CONCRETE	DI	DROP INLET
HDWL	HEAD WALL	MC	METAL COVER
MH	MANHOLE	TRANS	TRANSFORMER
U/C	UNDER CONSTRUCTION	V	WALL
VD	VOID		

LEGEND



BRUSHLINE	MONUMENT
CABLE MARKER	RAILROAD TRACKS
CATCH BASIN	SIGN
DROP INLET	SWAMP
FENCE	TRAFFIC LIGHT
FIRE HYDRANT	TREE
GUARD RAIL	TREELINE
LIGHT POLE	UNIDENTIFIED OBJECT
MISCELLANEOUS POLE	UTILITY POLE
MONITORING WELL	VALVE
CENTERLINE OF EXIST. SWALE	WATER LINE
SUMP	DRAINAGE FLOW DIRECTION
STORMWATER FILTRATION C/D	LEACHATE COLLECTION SYSTEM C/D

CONTROL LEGEND

POINT	DESCRIPTION	NORTH	EAST	ELEV.
1A	PANEL TARGET	1249252.2388	438212.4226	127.57
2A	PANEL TARGET	1249368.4921	439183.3644	125.52
3	PANEL TARGET	1249245.2818	440427.7973	126.66
4	PANEL TARGET	1249123.1526	441960.7618	130.04
5	PANEL TARGET	1249215.9069	442480.6826	125.91
6	PANEL TARGET	1251752.6848	439269.6626	128.74
7B	PANEL TARGET	1251467.706	440881.573	141.87
8	PANEL TARGET	1251440.3349	441914.9603	137.76
9	PANEL TARGET	1251415.3182	443469.7110	134.72
10	PANEL TARGET	1251971.6538	444410.6875	147.97
11	PANEL TARGET	1254155.5549	438946.0680	97.08
12	PANEL TARGET	1254225.9970	440388.4090	108.09
13	PANEL TARGET	1254257.2909	441873.9292	114.64
14	PANEL TARGET	1254252.4951	443345.6208	117.57
15	PANEL TARGET	1254232.4300	444864.5673	122.77
16	PANEL TARGET	1249941.6523	441795.3615	171.57

This map compiled by photogrammetric methods from aerial photography dated 3/19/94. Vertical datum based on NGS Mean Sea Level. Contour interval 1 ft. Grid based on Florida State Plane Coordinate System NAD 1983. Air Survey Corp. Project ND7940226.

Dashed contours indicate that ground is partially obscured by vegetation or shadows. These areas may not meet standard accuracy and require field testing/completion.

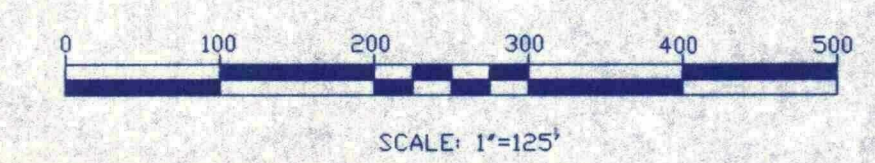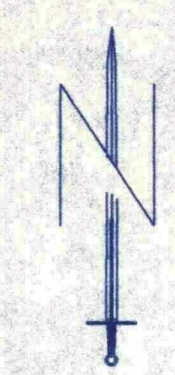

NOTE: ALL TEMPORARY AND PERMANENT DRAINAGE STRUCTURES ARE IDENTIFIED ON THE FINAL DRAINAGE PLAN DRAWING NO. 3, APPENDIX E.

REV	DATE	DESCRIPTION	DES. BY	APP. BY
PROJECT NO.				
DATE				
DES. BY				
DRN. BY				
CHK. BY				
APP. BY				
SOUTHEAST COUNTY LANDFILL EXISTING TOPOGRAPHY PERMIT RENEWAL-APPENDIX D				
Waste Management of North America, Inc. SOUTH/EAST REGION				
SHEET 4 OF 5				
DRAWING NO.				

CADD PRODUCED DRAWING

LEGEND

- | | |
|----------------------------|--------------------------------|
| BRUSHLINE | MONUMENT |
| CABLE MARKER | POST |
| CATCH BASIN | RAILROAD TRACKS |
| DROP INLET | SIGN |
| FENCE | SWAMP |
| FIRE HYDRANT | TRAFFIC LIGHT |
| GUARD RAIL | TREE |
| LIGHT POLE | TREELINE |
| MISCELLANEOUS POLE | UNIDENTIFIED OBJECT |
| MONITORING WELL | UTILITY POLE |
| CENTERLINE OF EXIST. C/ALE | VALVE |
| SUMP | WATER LINE |
| STORMWATER FILTRATION C/D | DRAINAGE FLOW DIRECTION |
| | LEACHATE COLLECTION SYSTEM C/D |

ABBREVIATIONS



- | | |
|--------|--------------------|
| AASPH | ASPHALT |
| A/C | AIR CONDITIONER |
| BR | BRICK |
| CB | CATCH BASIN |
| C.CONC | CONCRETE |
| DI | DROP INLET |
| H.W. | HEAD WALL |
| MC | METAL COVER |
| MH | MANHOLE |
| TRANS | TRANSFORMER |
| U/C | UNDER CONSTRUCTION |
| V | WALL |
| VD | WOOD |

CONTROL LEGEND

POINT	DESCRIPTION	NORTH	EAST	ELEV.
1A	PANEL TARGET	1249252.2388	438212.4226	127.57
2A	PANEL TARGET	1249368.4921	439183.3644	125.52
3	PANEL TARGET	1249245.2818	440427.7973	126.66
4	PANEL TARGET	1249123.1526	441960.7618	130.04
5	PANEL TARGET	1249215.9069	442480.6826	125.91
6	PANEL TARGET	1251752.6848	439269.6626	128.74
7B	PANEL TARGET	1251467.7060	440681.3730	141.87
8	PANEL TARGET	1251440.3349	441914.9603	137.76
9	PANEL TARGET	1251415.3102	443449.7110	134.72
10	PANEL TARGET	1251971.6538	444410.6075	147.97
11	PANEL TARGET	1254155.5549	438946.0680	97.08
12	PANEL TARGET	1254225.9970	440388.4090	108.09
13	PANEL TARGET	1254257.2909	441873.9592	114.64
14	PANEL TARGET	1254252.4851	443345.6208	117.57
15	PANEL TARGET	1254232.4500	444864.5679	122.77
16	PANEL TARGET	1249941.6523	441795.3615	171.57

This map compiled by photogrammetric methods from aerial photography dated 3-18-94. Vertical datum based on NGS Mean Sea Level. Contour interval 1 ft. Grid based on Florida State Plane Coordinate System NAD 1927. Air Survey Corp. Project NO.7940226.

Dashed contours indicate that ground is partially obscured by vegetation or shadows. These areas may not meet standard accuracy and require field testing/completion.

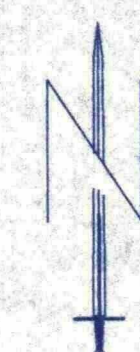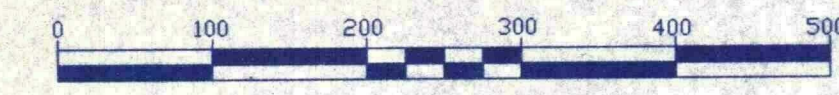


NOTE: ALL TEMPORARY AND PERMANENT DRAINAGE STRUCTURES ARE IDENTIFIED ON THE FINAL DRAINAGE PLAN DRAWING NO. 3, APPENDIX E.

REV	DATE	DESCRIPTION	DES. BY	APP. BY
PROJECT NO.				
DATE				
DES. BY				
DWN. BY				
CHK. BY				
APP. BY				
SOUTHEAST COUNTY LANDFILL EXISTING TOPOGRAPHY PERMIT RENEWAL-APPENDIX D				SHEET 5 OF 5
Waste Management of North America, Inc. SOUTHEAST REGION				DRAWING NO.

CADD PRODUCED DRAWING

FILE NAME: 990808.SHA, 990808.CAD, 990808.DWG
PROJECT: LANDFILL EXISTING TOPOGRAPHY
TITLE: 990808.LV4-43
DATE: 10/1/99
BY: JRM
CHECKED: JRM
APPROVED: JRM

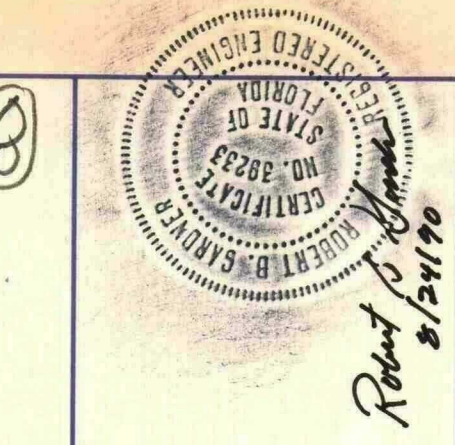


NO.	REVISION	DATE
1	Added Proposed Service Road and Sections A, B and C. Moved Sections and Details to Dwg. No. 2.	6/90
2	Modified Stormwater Discharge System.	8/90

SHEET TITLE	PLAN
PROJECT TITLE	SOUTHEAST LANDFILL PROPOSED MODIFICATIONS TO PHASE V AND VI

HILLSBOROUGH COUNTY DEPARTMENT OF SOLID WASTE TAMPA, FLORIDA
--

SCS ENGINEERS					
ENVIRONMENTAL CONSULTANT					
302 U.S. HWY. 301 N. SUITE 700					
TAMPA, FLORIDA 33618					
(813) 621-0080					
PROJ. NO.	098502715	OWN. BY:	VDR	Q/A R/W BY:	GAF
DSN. BY:	RBG	CHK. BY:	LER	APP. BY:	RBG

CAD FILE:	PH5PLAN
DATE:	04/18/90
SCALE:	1"=100'
DRAWING NO.	1 of 2

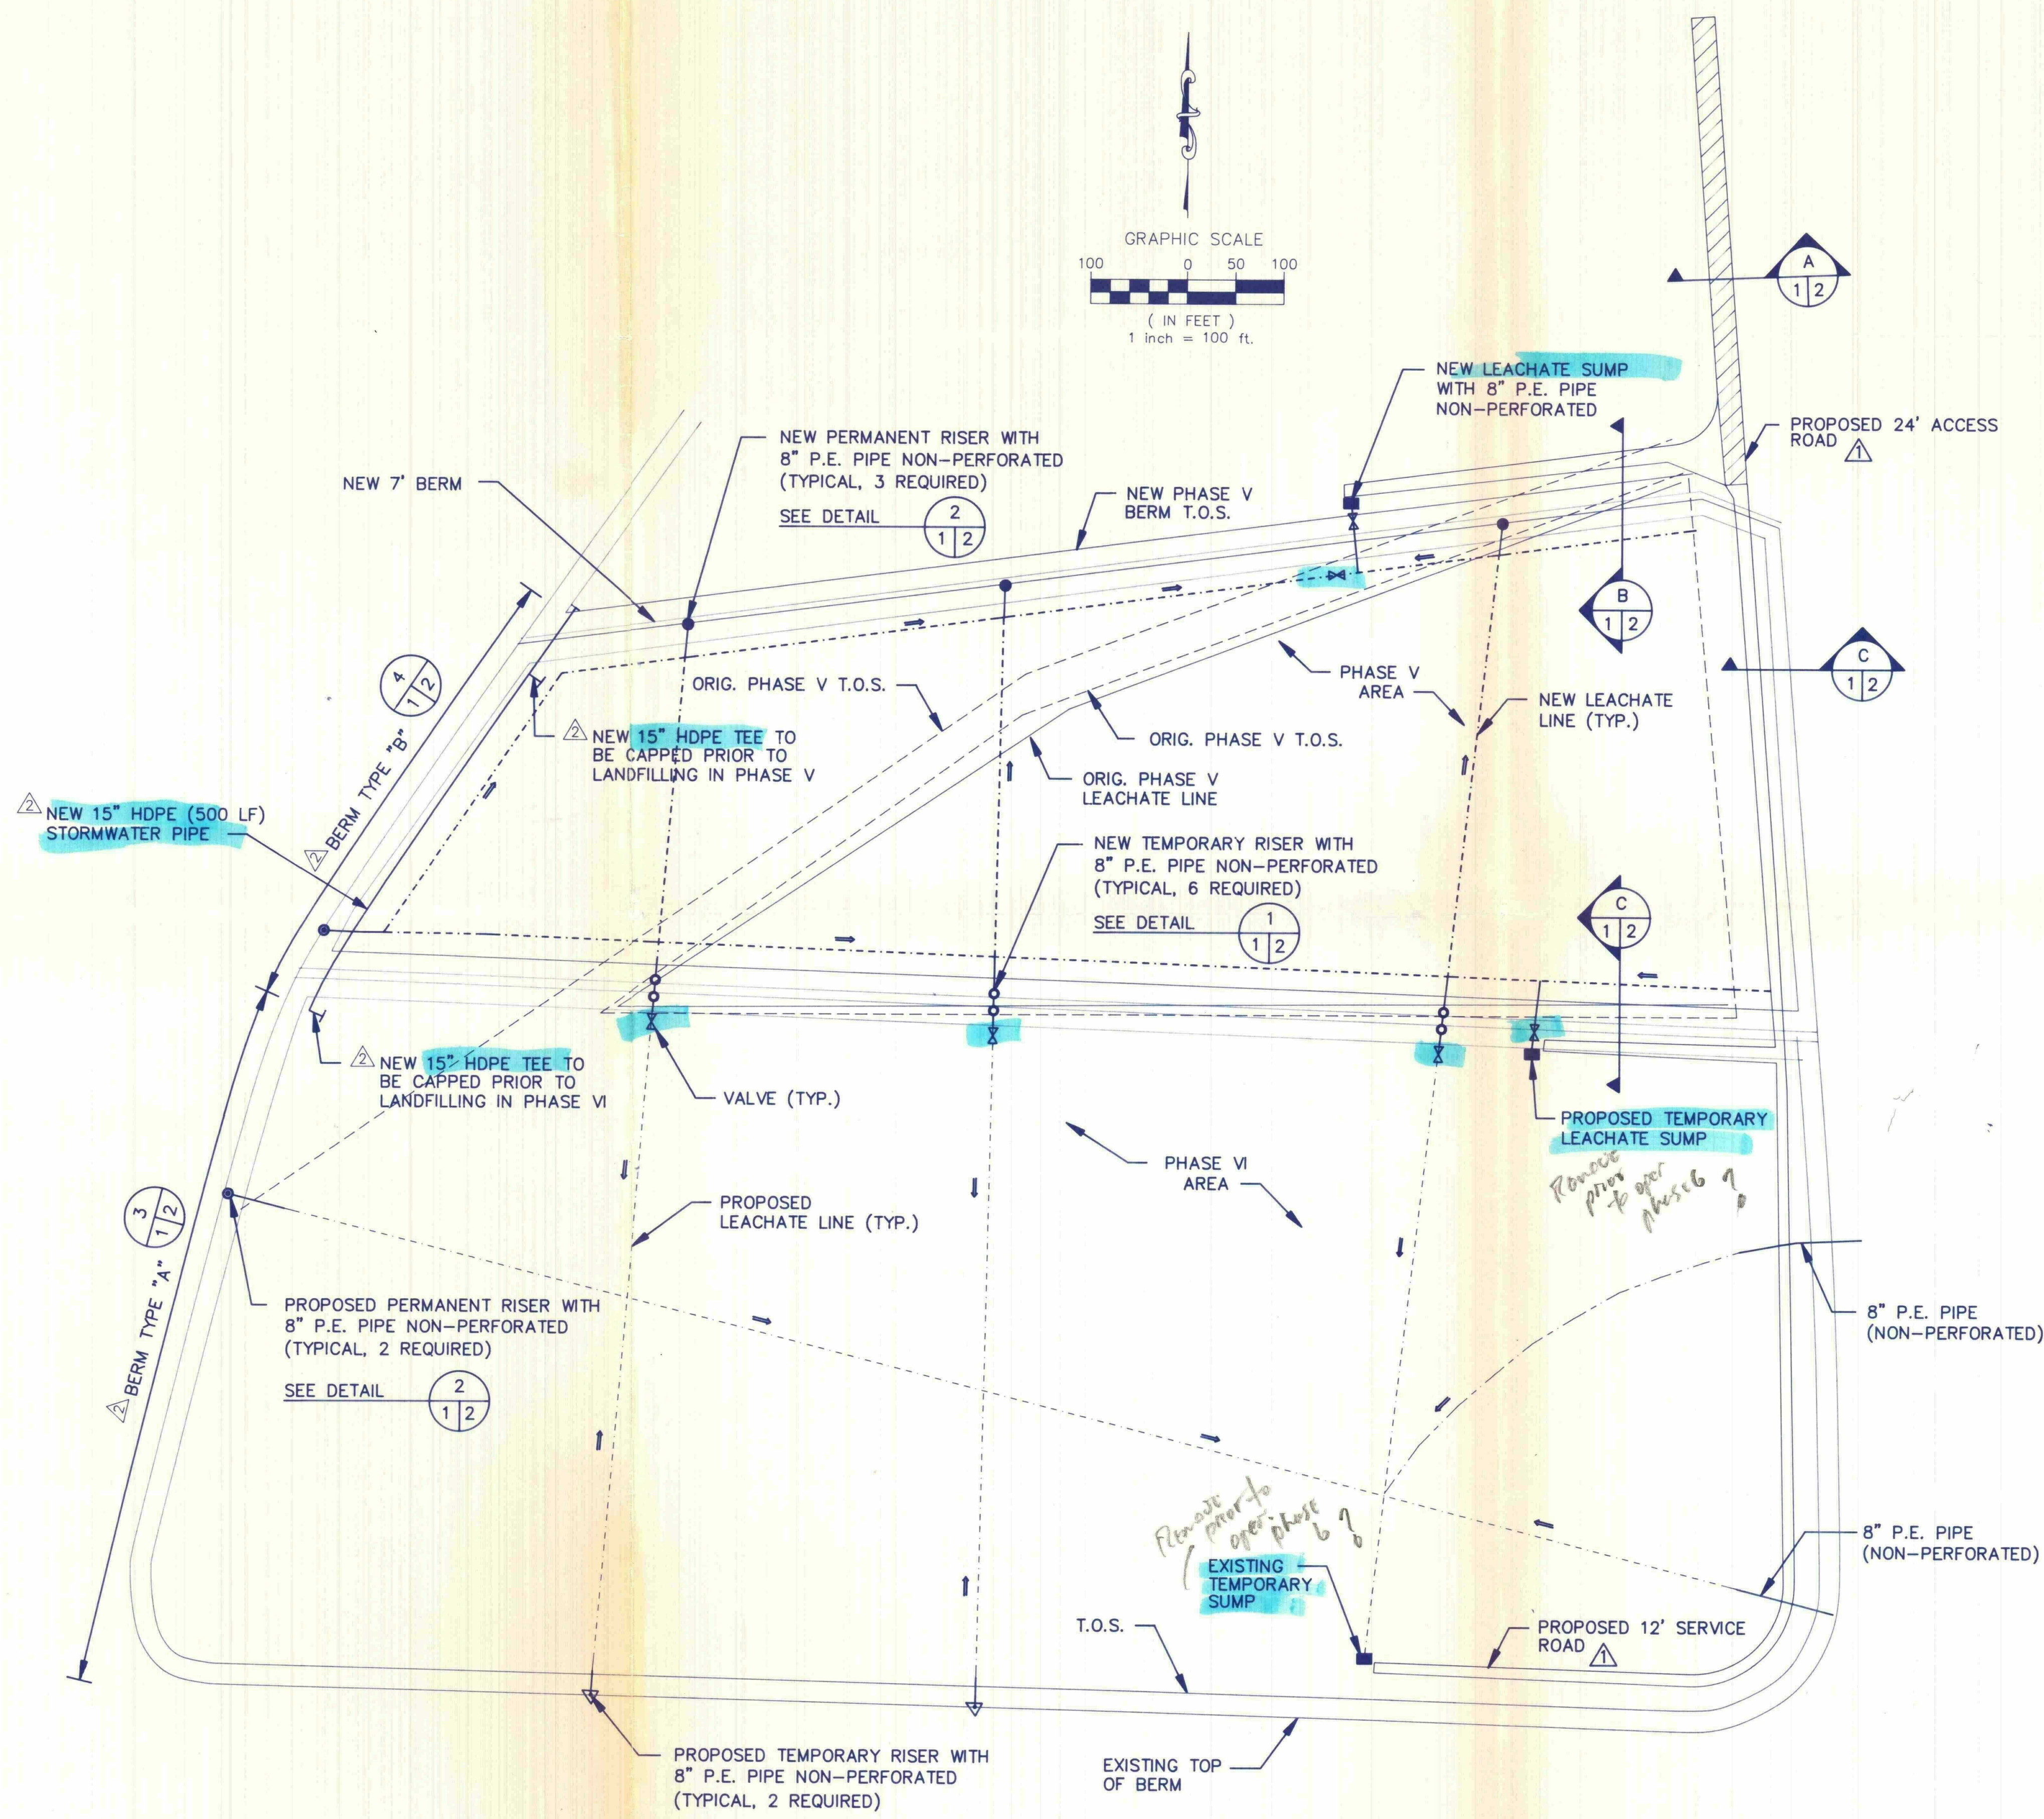

SUMMARY OF PROPOSED MODIFICATIONS



1. EXTEND PHASE V NORTHERN BOUNDARY TO THE NORTH.
2. ADD NEW LEACHATE LATERALS IN PHASE V.
3. ADD NEW RISER CLEAN-OUTS IN PHASE V.
4. RELOCATE PHASE V SUMP.
5. ADD DRAINAGE PIPE BETWEEN PHASE V & VI AND IN PHASE V TO DISCHARGE STORMWATER PRIOR TO FILLING.

NOTE:


1. FOR CONSTRUCTION DETAILS SEE CDM PHASE V & VI DRAWINGS DATED 4-19-89 AND TOMASINO & ASSOCIATES DRAWINGS DATED 1-15-90.




9

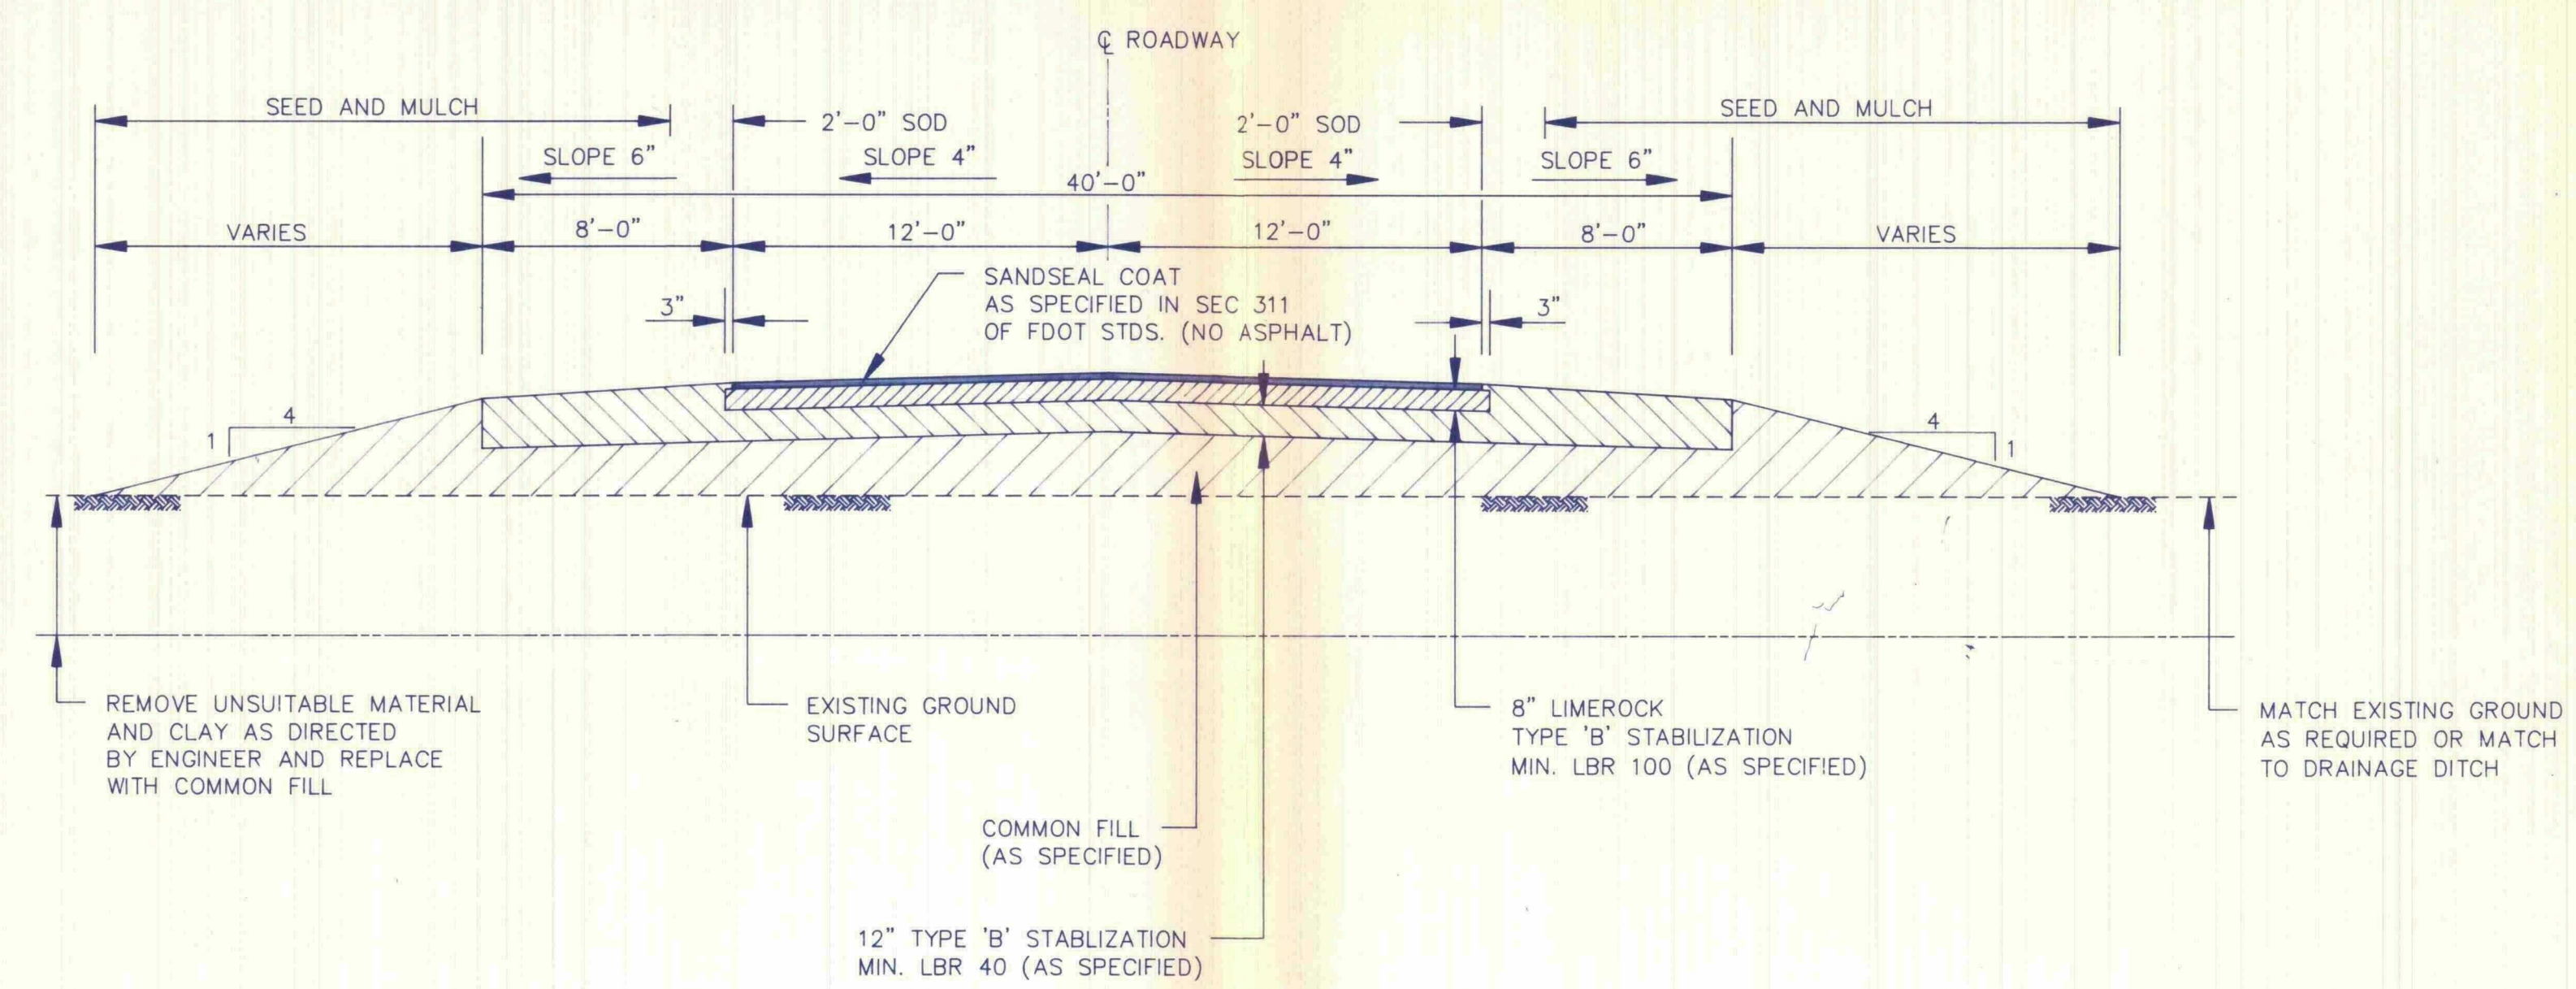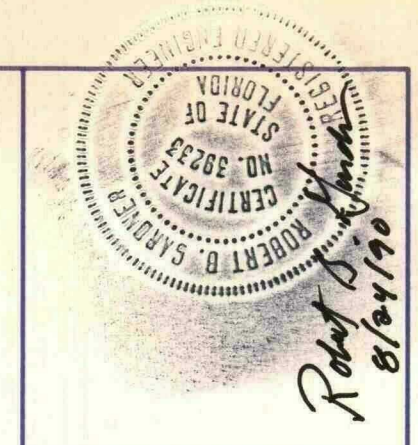

ACCESS ROADWAY CROSS SECTION
NOT TO SCALE

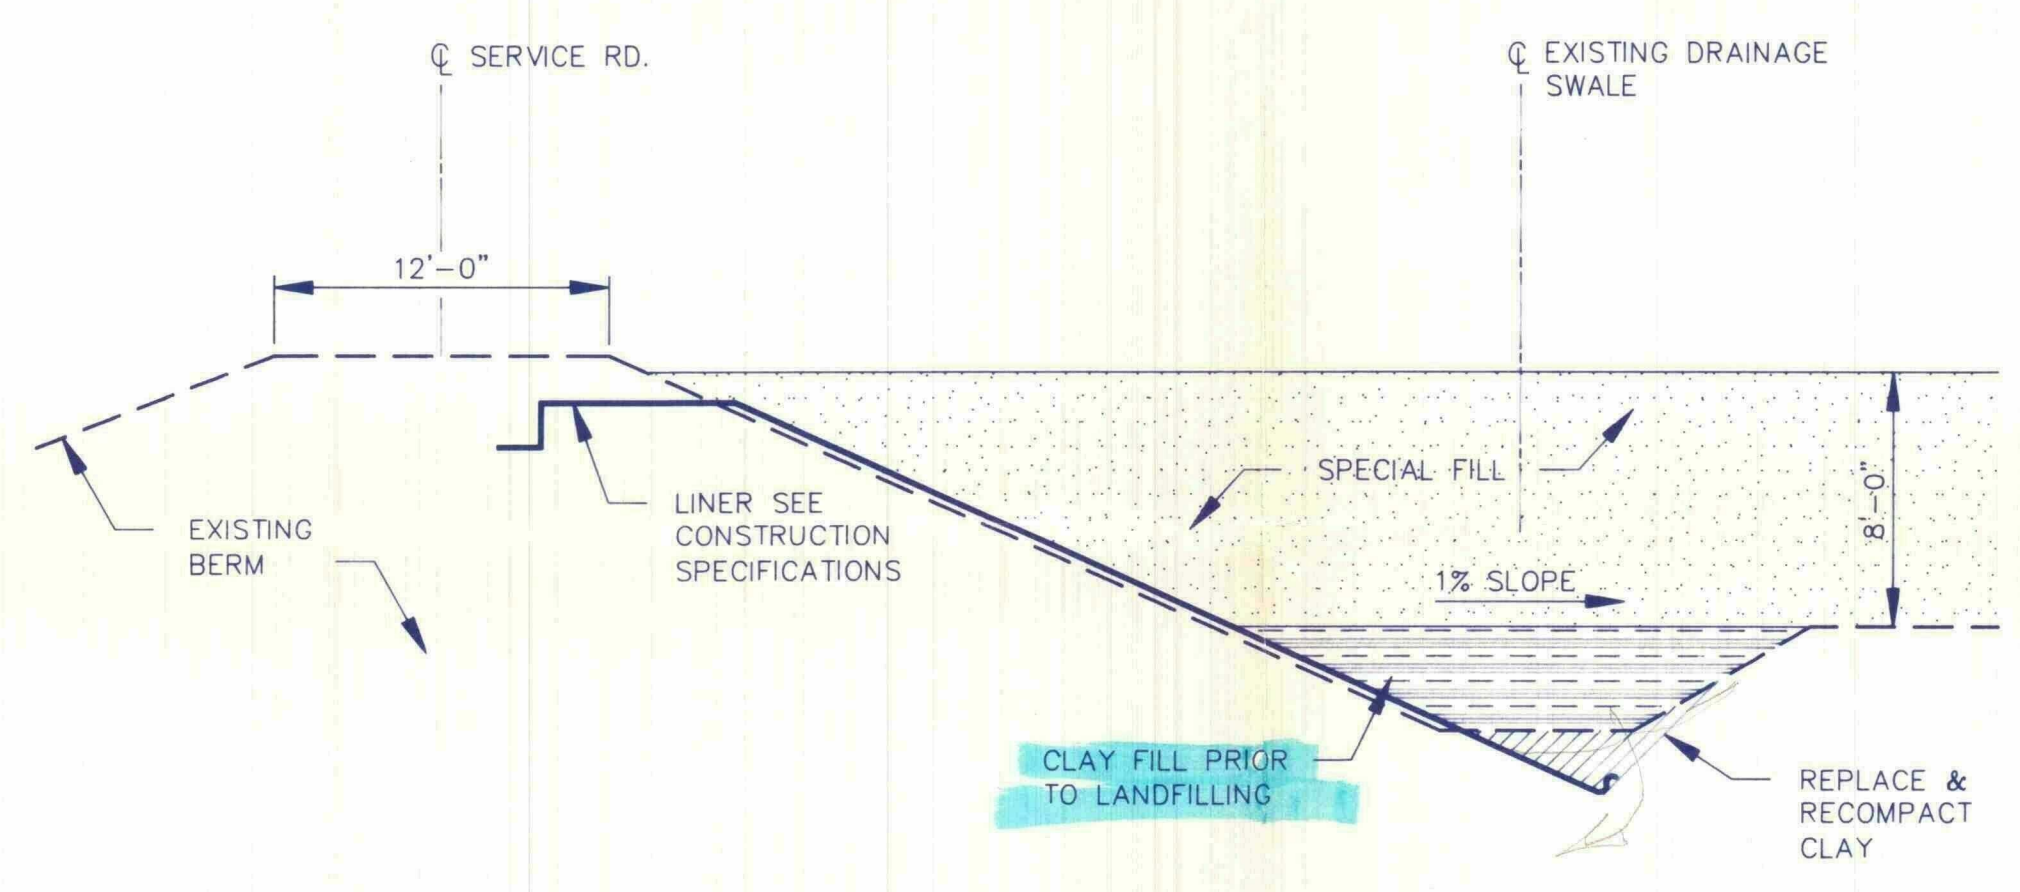


TYPE 'A' BERM
NOT TO SCALE

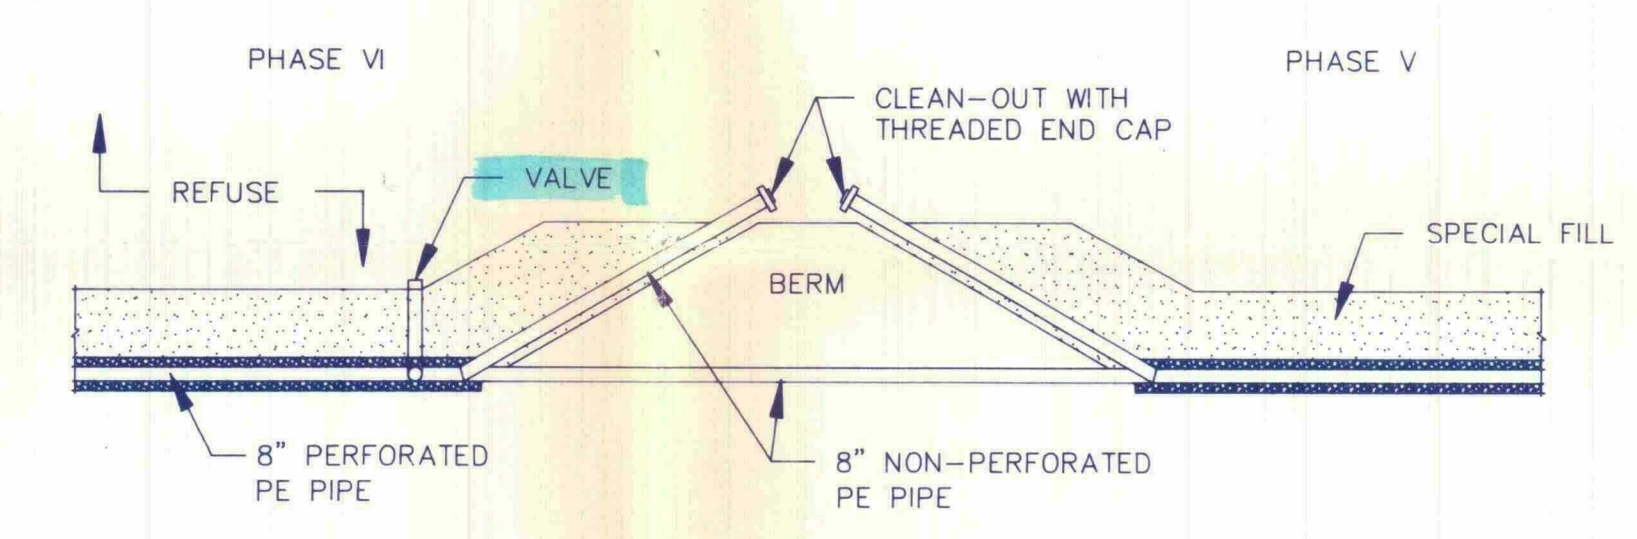


TYPICAL TEMPORARY RISER CLEAN-OUT DETAIL
NOT TO SCALE


NOTE:
SYNTHETIC LINER NOT SHOWN FOR CLARITY.
SEE CDM PHASE V AND VI DRAWINGS
DETAILS "E" AND "H" SHEET NO. 4.

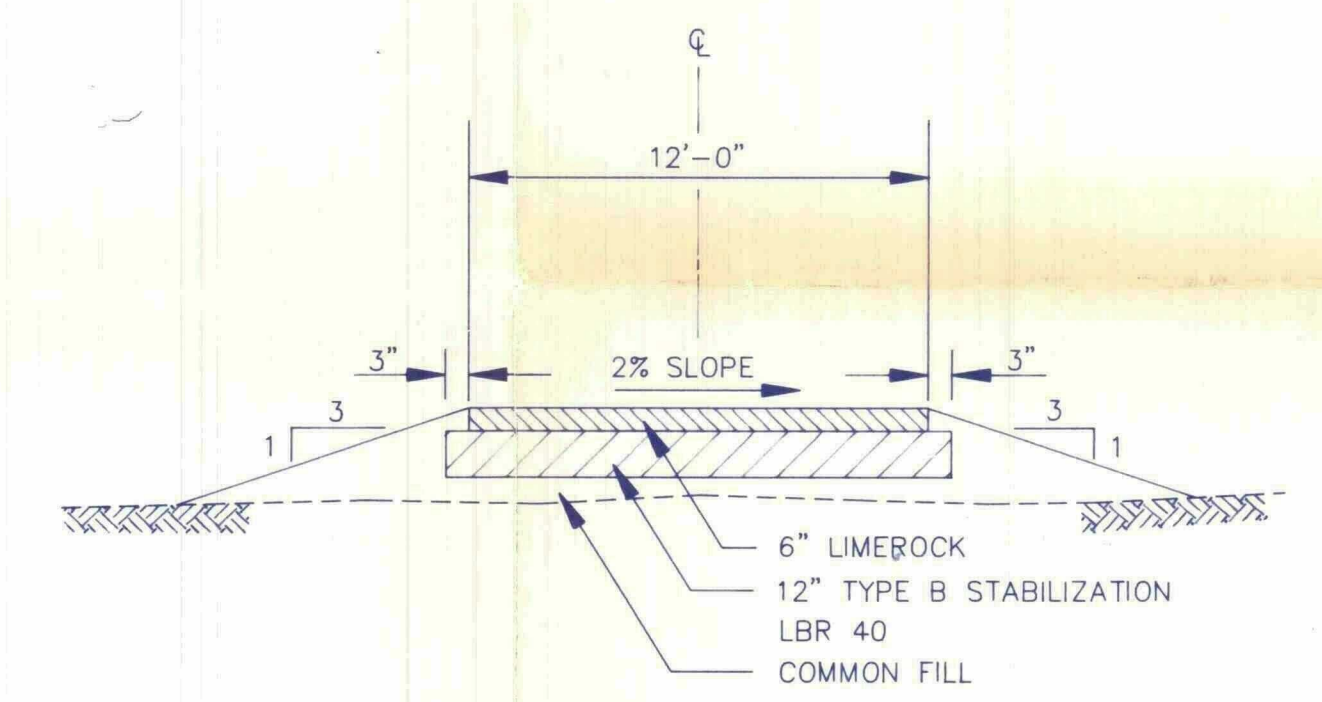


TYPICAL PERIMETER ROAD CROSS SECTION
NOT TO SCALE

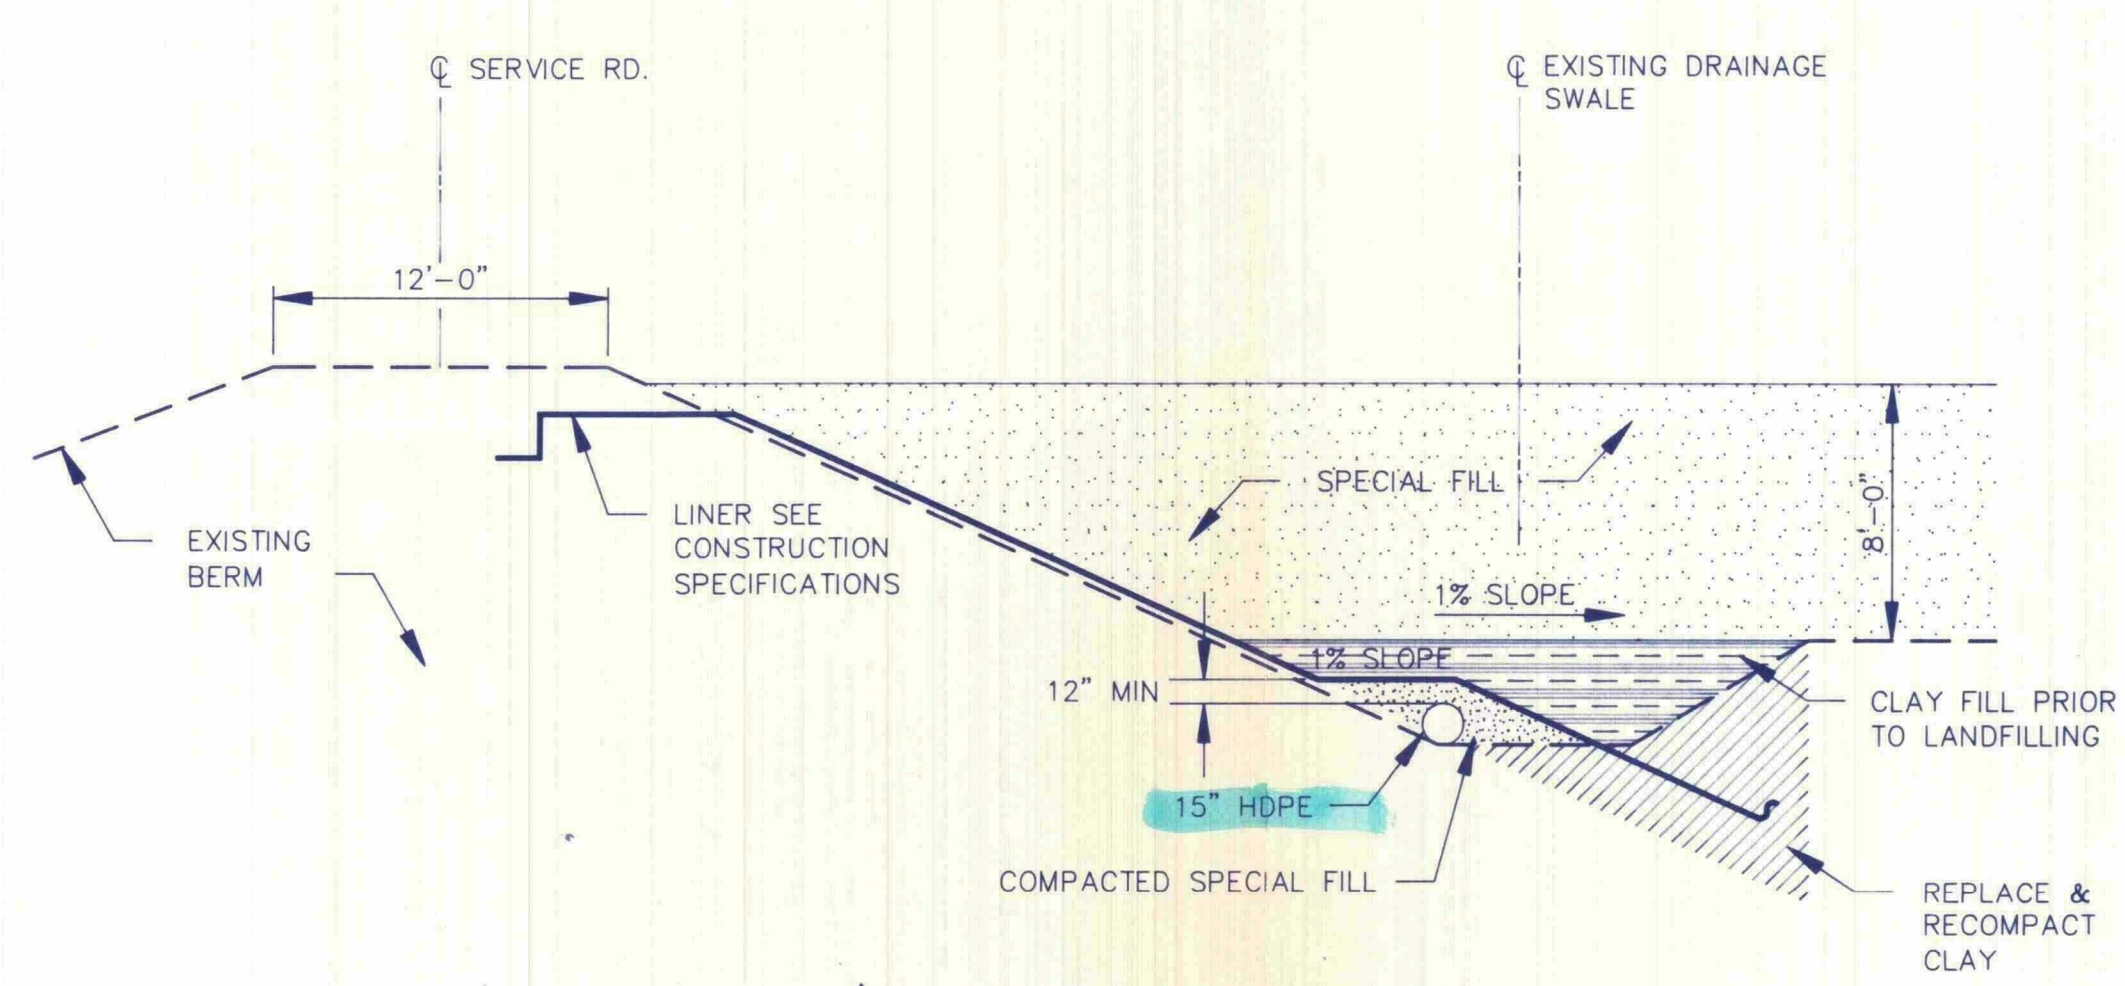

TYPE 'B' BERM
NOT TO SCALE

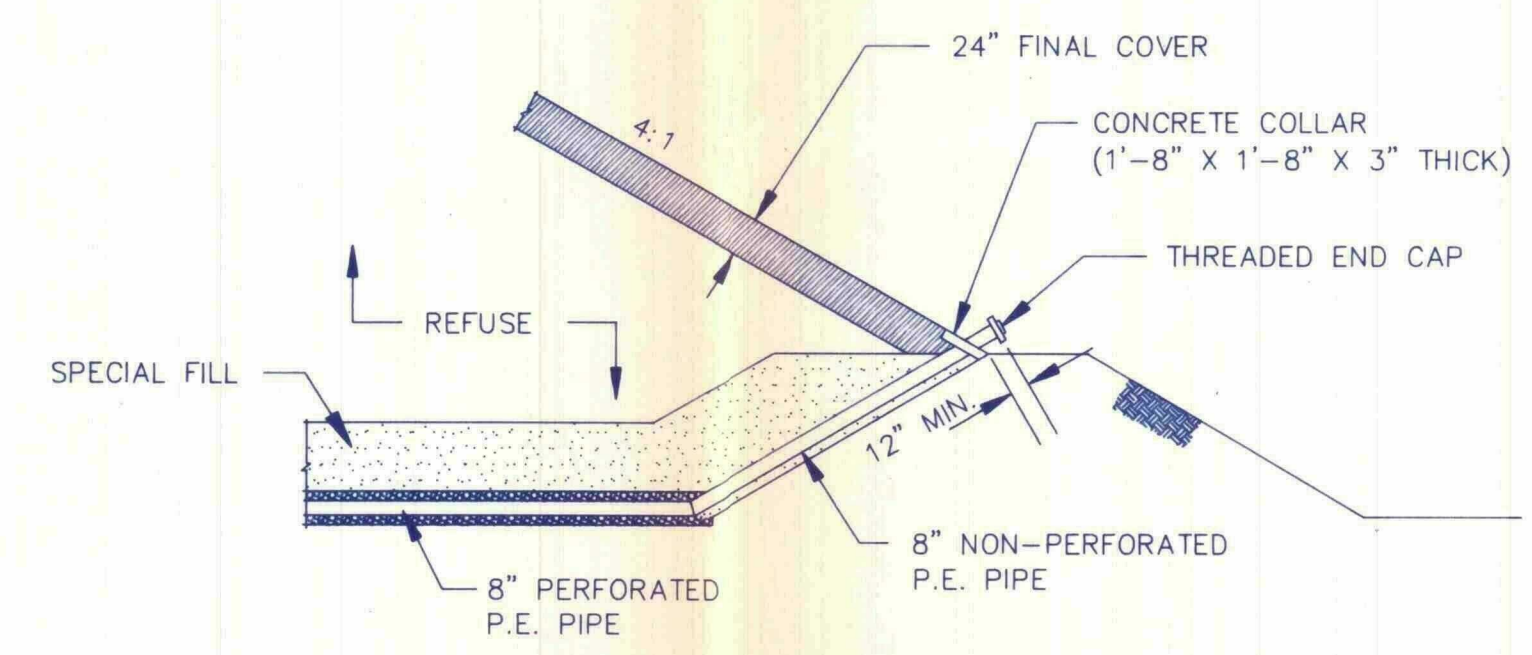

TYPICAL PERMANENT RISER CLEAN-OUT DETAIL
NOT TO SCALE

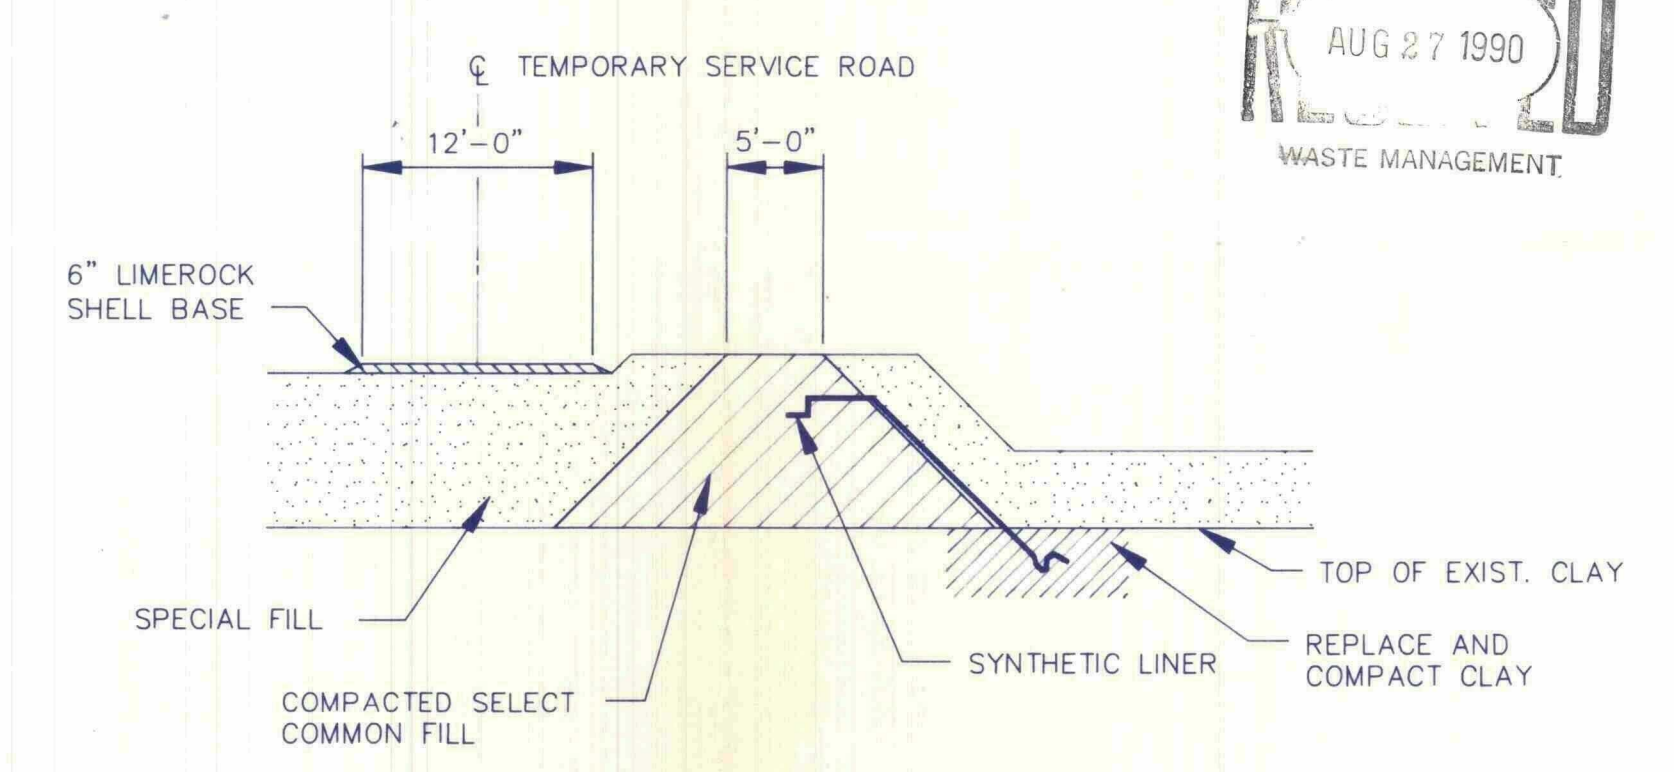

INTERIOR LANDFILL BERM SECTION
NOT TO SCALE


GENERAL NOTE:
SECTIONS A, B AND C WERE COMPILED FROM
CONSTRUCTION-PHASE V AND VI DRAWINGS
BY CDM, SHEETS 4 AND 5, DATED APRIL 1989.

SECTIONS AND DETAILS
SOUTHEAST LANDFILL
PROPOSED MODIFICATIONS
TO PHASE V AND VI

HILLSBOROUGH COUNTY
DEPARTMENT OF SOLID WASTE
TAMPA, FLORIDA

SCS ENGINEERS
ENVIRONMENTAL CONSULTANT
3015 U.S. HWY. 301 N. SUITE 700
TAMPA, FLORIDA 33618
(813) 621-0080

CAD FILE: PH5DET
DATE: JUNE 1990
SCALE: NOT TO SCALE
DRAWING NO. 2 of 2

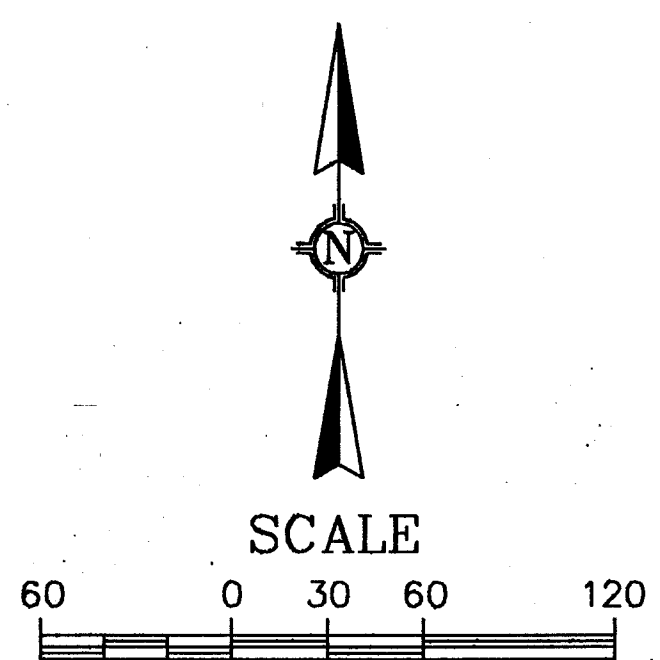


(IN FEET)

LEGEND

- 20 GEOMEMBRANE PANEL NUMBER
- DS 2 PASSED DESTRUCTIVE TEST SAMPLE
- DS 2 FAILED DESTRUCTIVE TEST SAMPLE
- PATCH REPAIR LOCATION
- ▨ CAPPED SEAM
- ANCHOR TRENCH
- TOE OF SLOPE
- CREST OF SLOPE
- 16" Ø STORM WATER COLLECTION PIPE INLETS (SEE DETAIL 5/4)
- 8" Ø HDPE PIPE PENETRATIONS (SEE DETAIL 6/4)

TIE-IN WITH
PHASE IV
EXISTING LINER

TIE IN WITH
PHASE III
EXISTING LINER

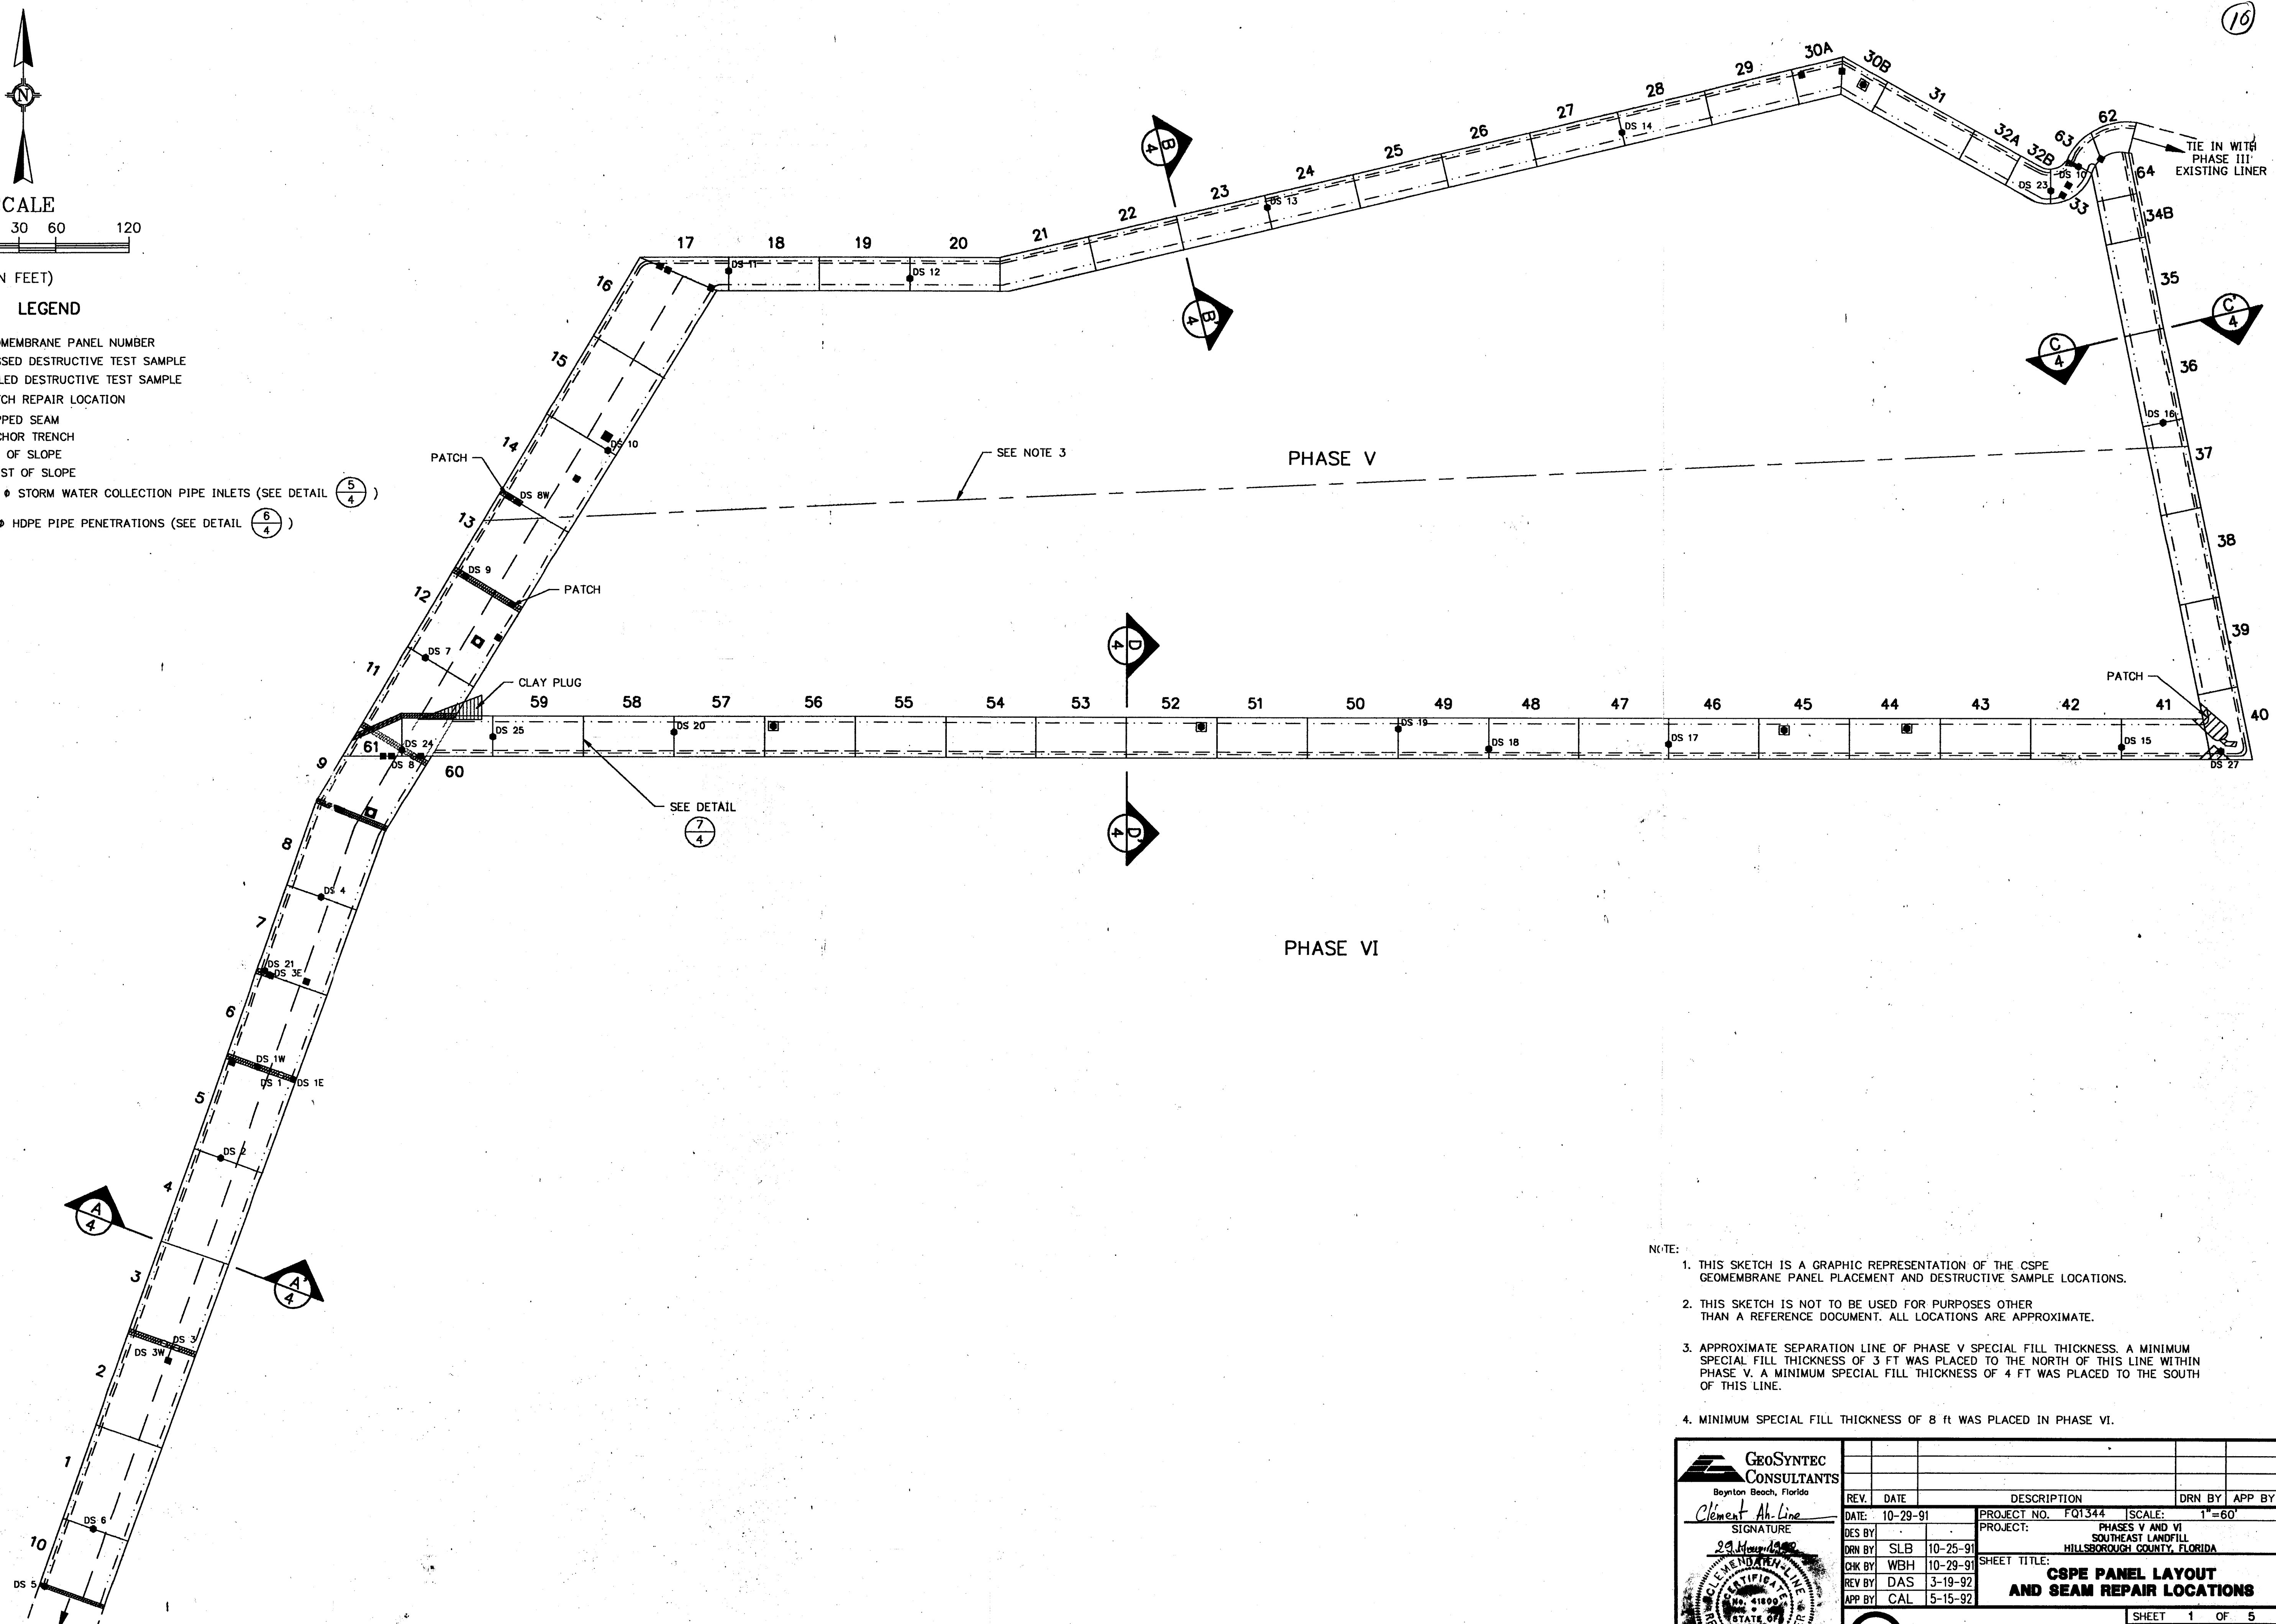

- NOTE:
1. THIS SKETCH IS A GRAPHIC REPRESENTATION OF THE CSPE GEOMEMBRANE PANEL PLACEMENT AND DESTRUCTIVE SAMPLE LOCATIONS.
 2. THIS SKETCH IS NOT TO BE USED FOR PURPOSES OTHER THAN A REFERENCE DOCUMENT. ALL LOCATIONS ARE APPROXIMATE.
 3. APPROXIMATE SEPARATION LINE OF PHASE V SPECIAL FILL THICKNESS. A MINIMUM SPECIAL FILL THICKNESS OF 3 FT WAS PLACED TO THE NORTH OF THIS LINE WITHIN PHASE V. A MINIMUM SPECIAL FILL THICKNESS OF 4 FT WAS PLACED TO THE SOUTH OF THIS LINE.
 4. MINIMUM SPECIAL FILL THICKNESS OF 8 FT WAS PLACED IN PHASE VI.

Boynston Beach, Florida

Clement Ah-Line

SIGNATURE

29 May 1992


REV.	DATE	DESCRIPTION	DRN BY	APP BY
DATE	10-29-91	PROJECT NO. F01344	SCALE: 1"=60'	
DES BY	SLB	PROJECT: PHASES V AND VI		
DRN BY	SLB	SOUTHEAST LANDFILL		
CHK BY	WBH	HILLSBOROUGH COUNTY, FLORIDA		
REV BY	DAS	SHEET TITLE:		
APP BY	CAL	CSPE PANEL LAYOUT AND SEAM REPAIR LOCATIONS		

Waste Management, Inc.
of Florida

SHEET 1 OF 5

DRAWING NO.

1

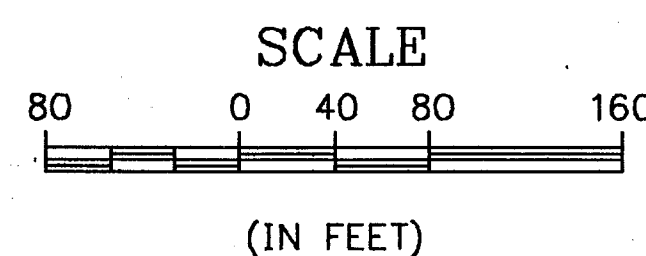

LEGEND

- 20 GEOMEMBRANE PANEL NUMBER
- STORM WATER COLLECTION PIPE
- 8" PIPE (NON-PERFORATED) BOOTS AND PENETRATIONS
- CROSS FLANGE CONNECTION
- || FLANGE CONNECTION
- ~ FUSION COUPLING
- ⋈ VALVE
- 8" PERFORATED HDPE PIPE
- 8" SOLID HDPE PIPE

Where are these shown on previously approved plans?

16" HDPE STORM WATER PIPE INLET (TYPICAL) SEE DETAIL (A 4)

What kind of liner penetration or booting etc?

FLANGE (TYPICAL)

INTERIOR BERM HDPE RISER PIPE SEE DETAIL (13 5)

8" PERMANENT HDPE RISER PIPE (TYPICAL) SEE DETAIL (14 5)

PHASE V

PHASE VI

HDPE CROSS FLANGE CONNECTION (TYPICAL) SEE DETAIL (15 5)

PERFORATED END CAP

TEMPORARY SUMP (SEE DETAIL (10 5))

PERFORATED END CAPS (TYP.)

EXISTING SUMP

10,000 GAL. LEACHATE STORAGE TANK (SEE NOTE 2)

PERMANENT SUMP (SEE DETAIL (10 5))

TIE IN WITH PHASE III EXISTING LINER

what kind of liner penetration?

How was Phase 3 leachate contained prior to construction of this berm?


what kind of penetration boot, etc?

perforated?


? where are force mains?

Compare with Aug 27, 1990 SCS plans


- NOTE:
- THIS SKETCH IS NOT TO BE USED FOR PURPOSES OTHER THAN A REFERENCE DOCUMENT. ALL LOCATIONS ARE APPROXIMATE.
 - WMIF DID NOT REQUIRE GEOSYNTEC CONSULTANTS TO MONITOR INSTALLATION OF THE 10,000 GALLON LEACHATE STORAGE TANK.

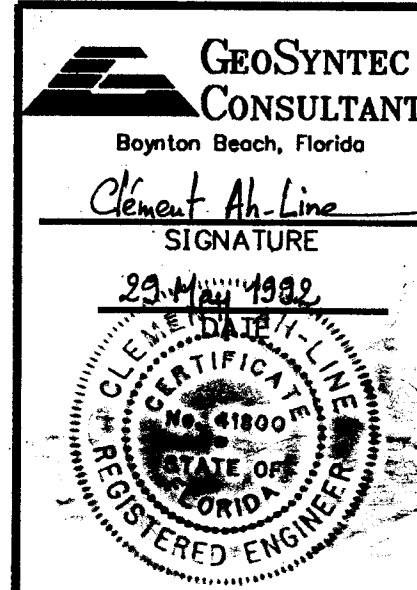

REV.	DATE	DESCRIPTION	DRN BY	APP BY
DATE:	10-29-91	PROJECT NO. F01344	SCALE: 1"=80'	
DES BY:		PROJECT:	PHASES V AND VI	
DRN BY:	SLB 10-25-91		SOUTHEAST LANDFILL	
CHK BY:	WBH 10-29-91		HILLSBOROUGH COUNTY, FLORIDA	
REV BY:	DAS 3-19-92	SHEET TITLE:	LEACHATE MANAGEMENT	
APP BY:	CAL 5-15-92		SYSTEM LAYOUT	
			SHEET 2 OF 5	
			DRAWING NO.	
			2	

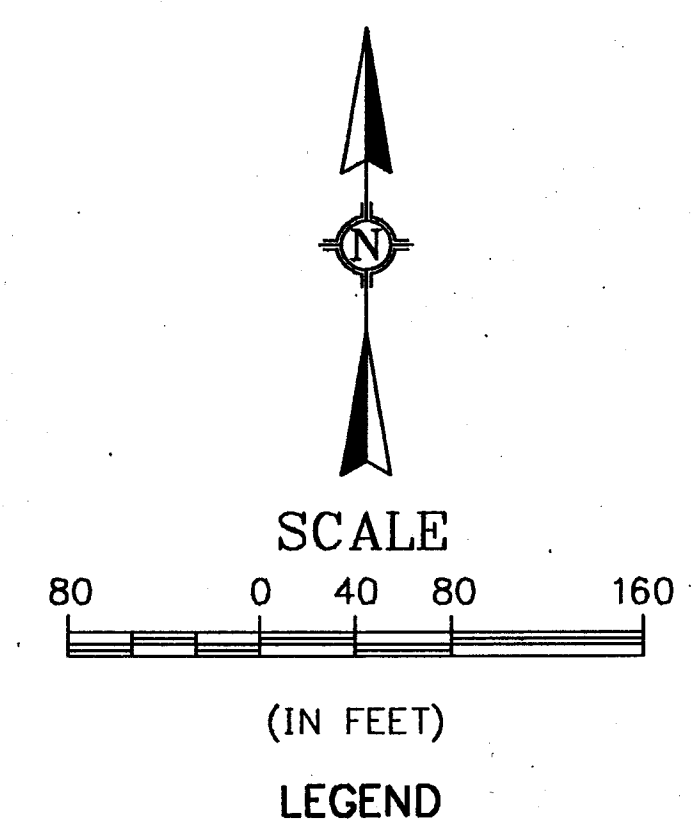

- LEGEND**
- 20 GEOMEMBRANE PANEL NUMBER
 - ELECTRICAL PULL BOXES
 - ELECTRICAL PVC CONDUITS
 - 4'X4' CONCRETE SLAB

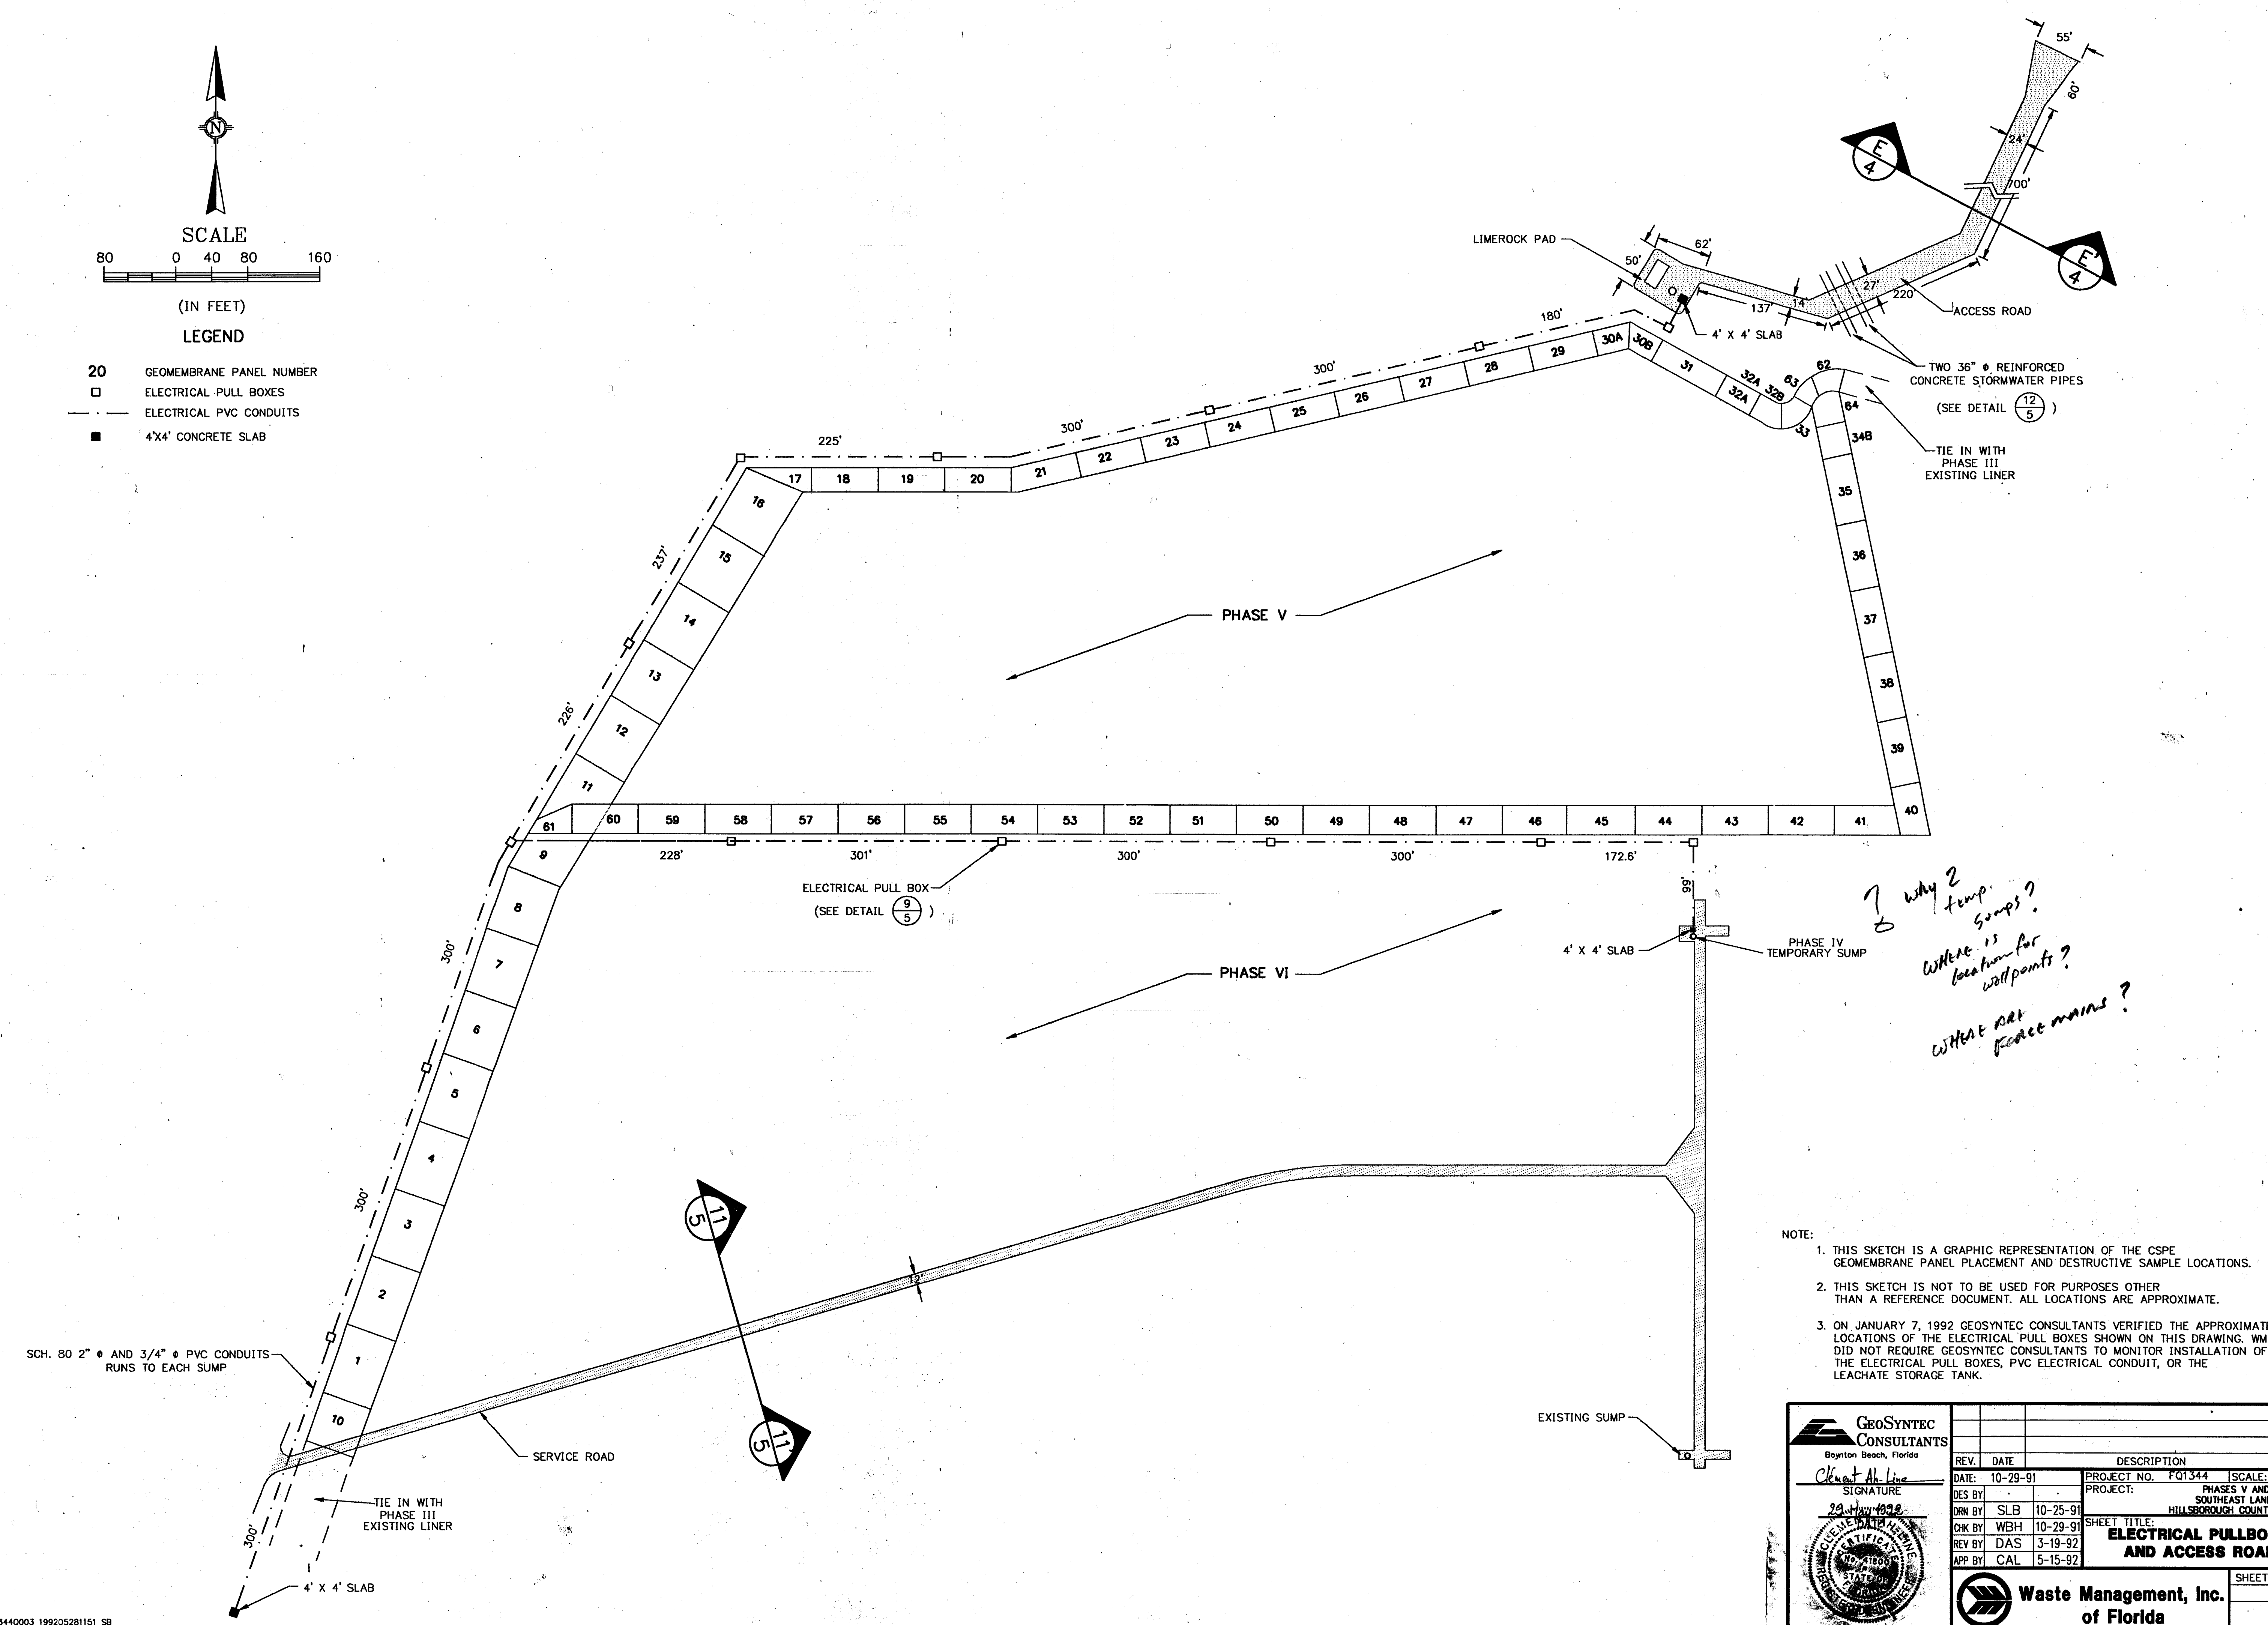

*Why 2 temp. sumps?
Where is location for well points?
Where are force mains?*

- NOTE:**
- THIS SKETCH IS A GRAPHIC REPRESENTATION OF THE CSPE GEOMEMBRANE PANEL PLACEMENT AND DESTRUCTIVE SAMPLE LOCATIONS.
 - THIS SKETCH IS NOT TO BE USED FOR PURPOSES OTHER THAN A REFERENCE DOCUMENT. ALL LOCATIONS ARE APPROXIMATE.
 - ON JANUARY 7, 1992 GEOSYNTEC CONSULTANTS VERIFIED THE APPROXIMATE LOCATIONS OF THE ELECTRICAL PULL BOXES SHOWN ON THIS DRAWING. WMIF DID NOT REQUIRE GEOSYNTEC CONSULTANTS TO MONITOR INSTALLATION OF THE ELECTRICAL PULL BOXES, PVC ELECTRICAL CONDUIT, OR THE LEACHATE STORAGE TANK.

GeoSyntec Consultants
Boynton Beach, Florida

Chen M. Line
SIGNATURE

29 May 1992
DATE










REV.	DATE	DESCRIPTION	DRN BY	APP BY
1	10-29-91	PROJECT NO. F01344		
2	10-25-91	SCALE: 1"=80'		
3	10-29-91	PROJECT: PHASES V AND VI		
4	10-29-91	SOUTHEAST LANDFILL		
5	3-19-92	HILLSBOROUGH COUNTY, FLORIDA		
6	5-15-92			

SHEET TITLE:
**ELECTRICAL PULLBOX, CONDUIT,
AND ACCESS ROAD LAYOUT**

Waste Management, Inc.
of Florida


SHEET 3 OF 5

DRAWING NO. **3**

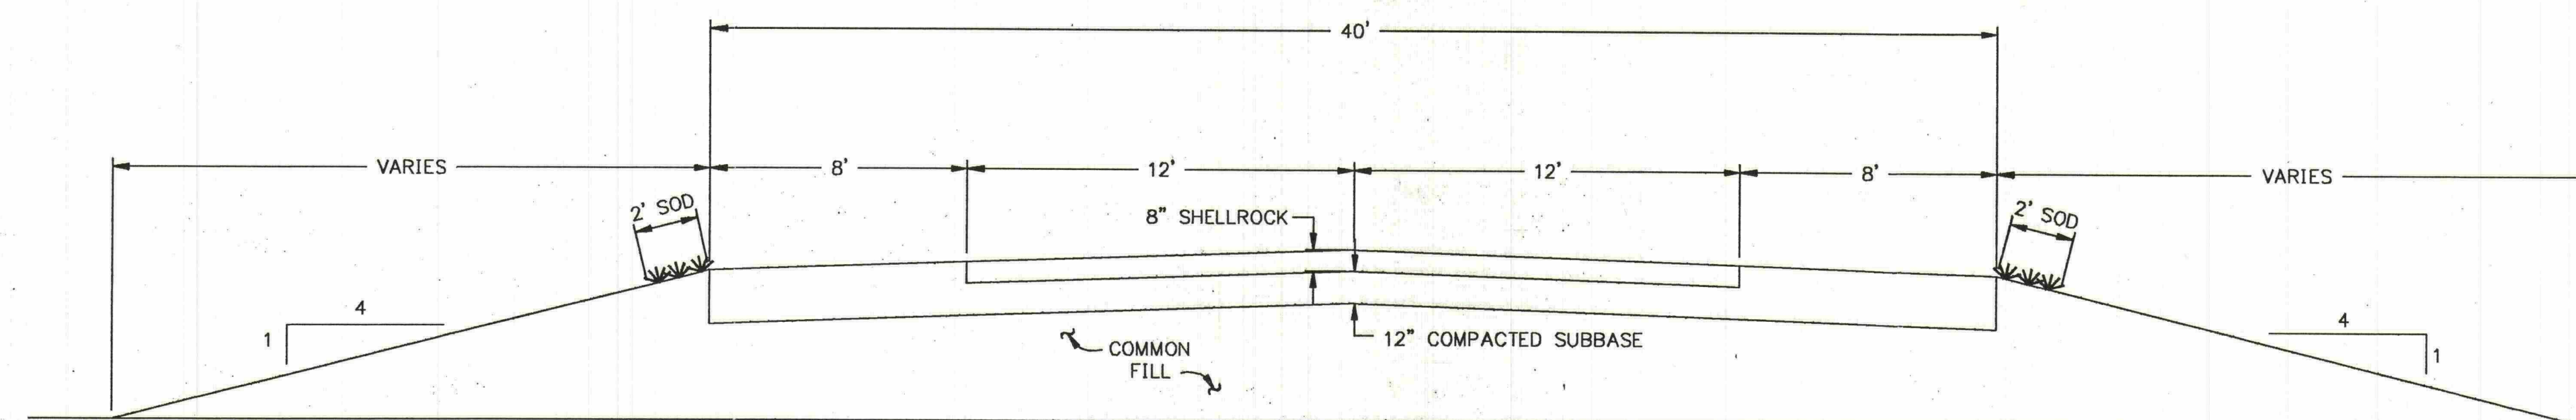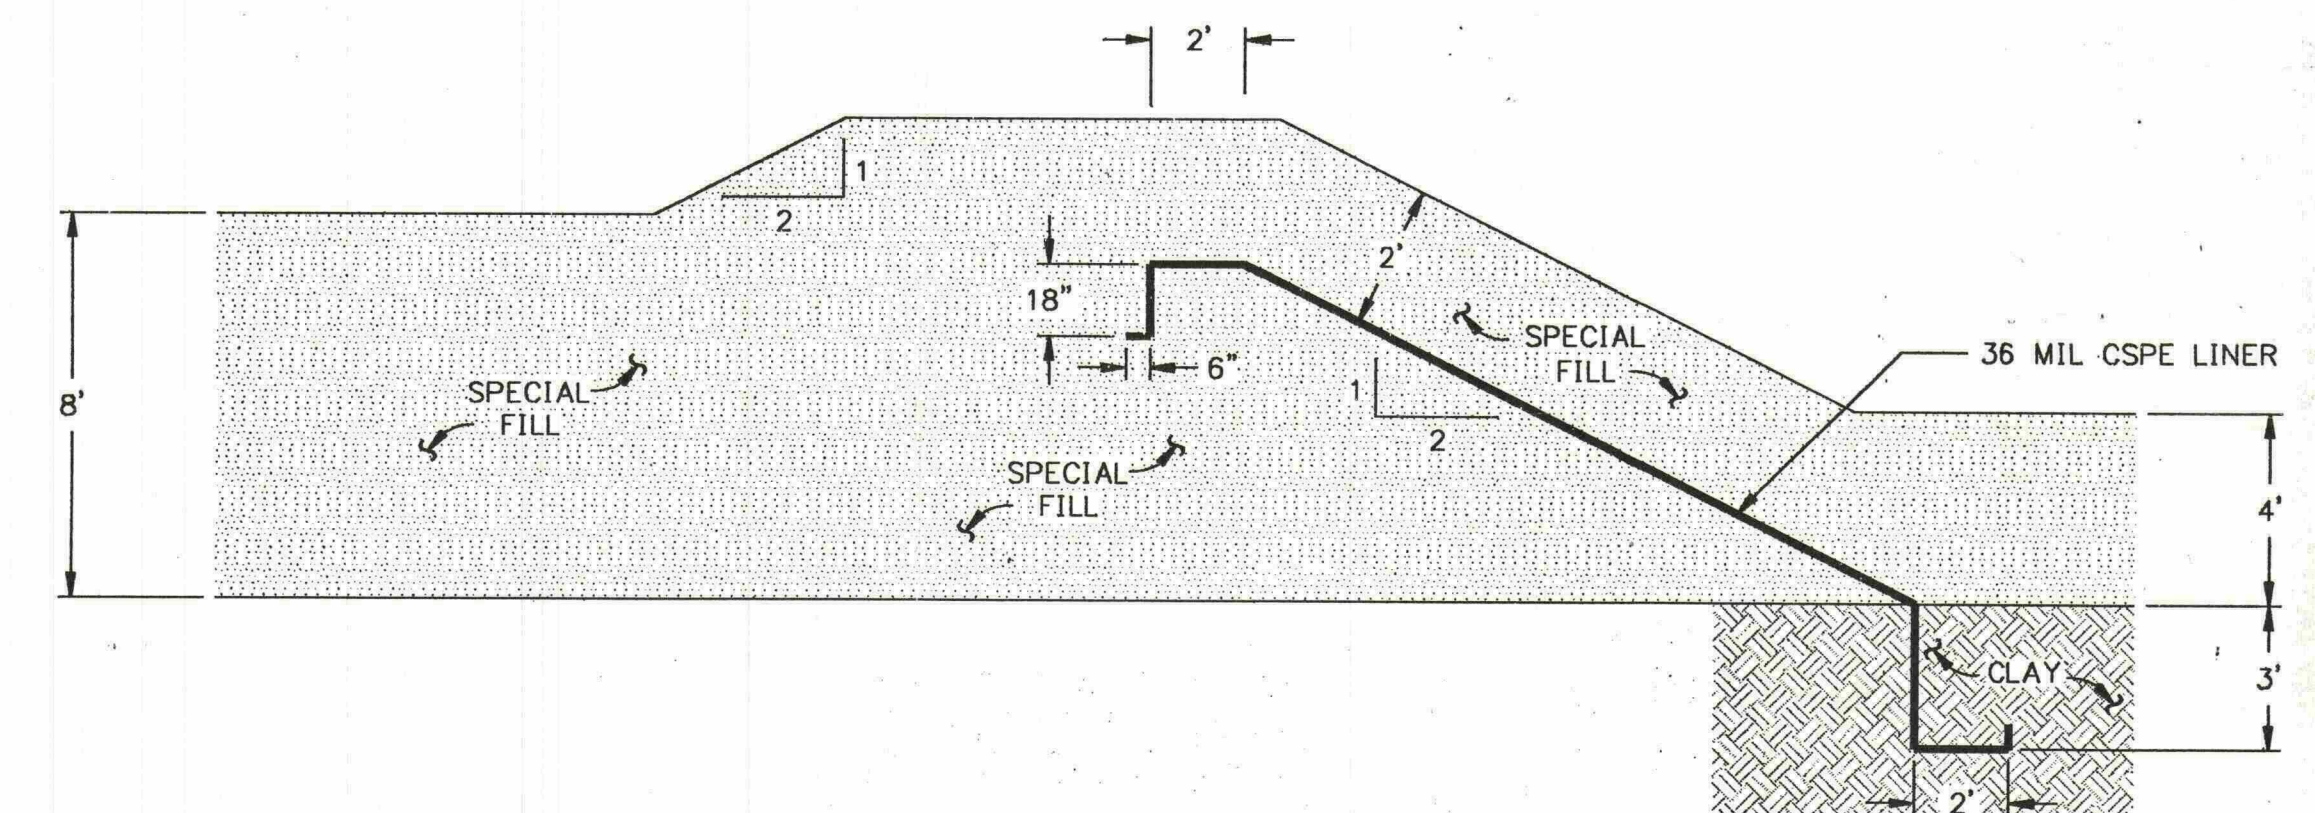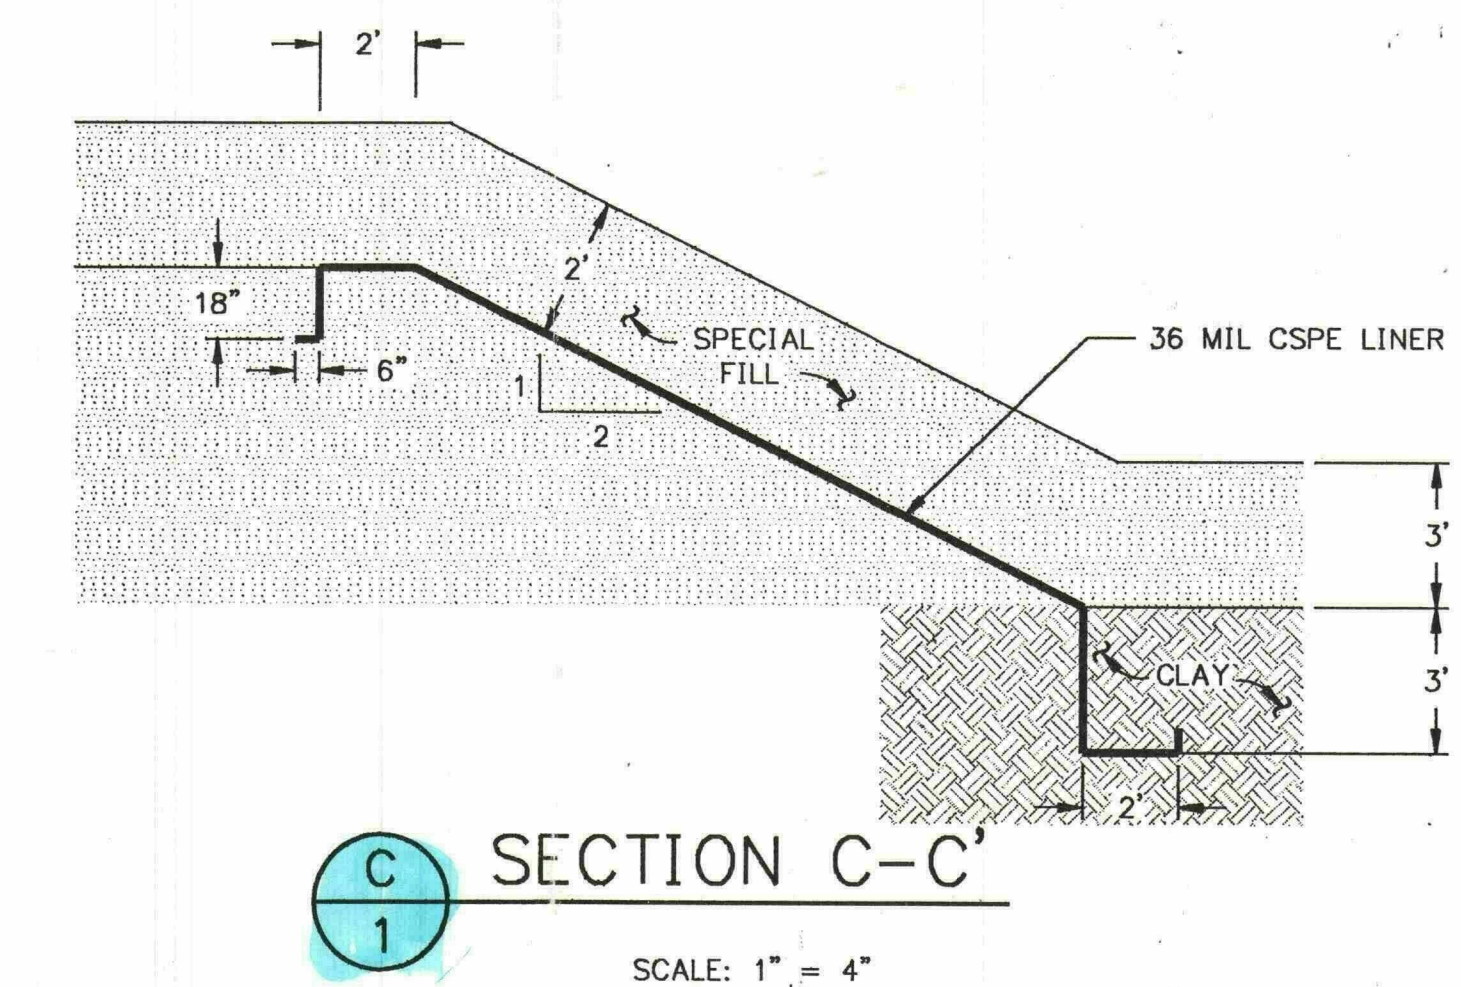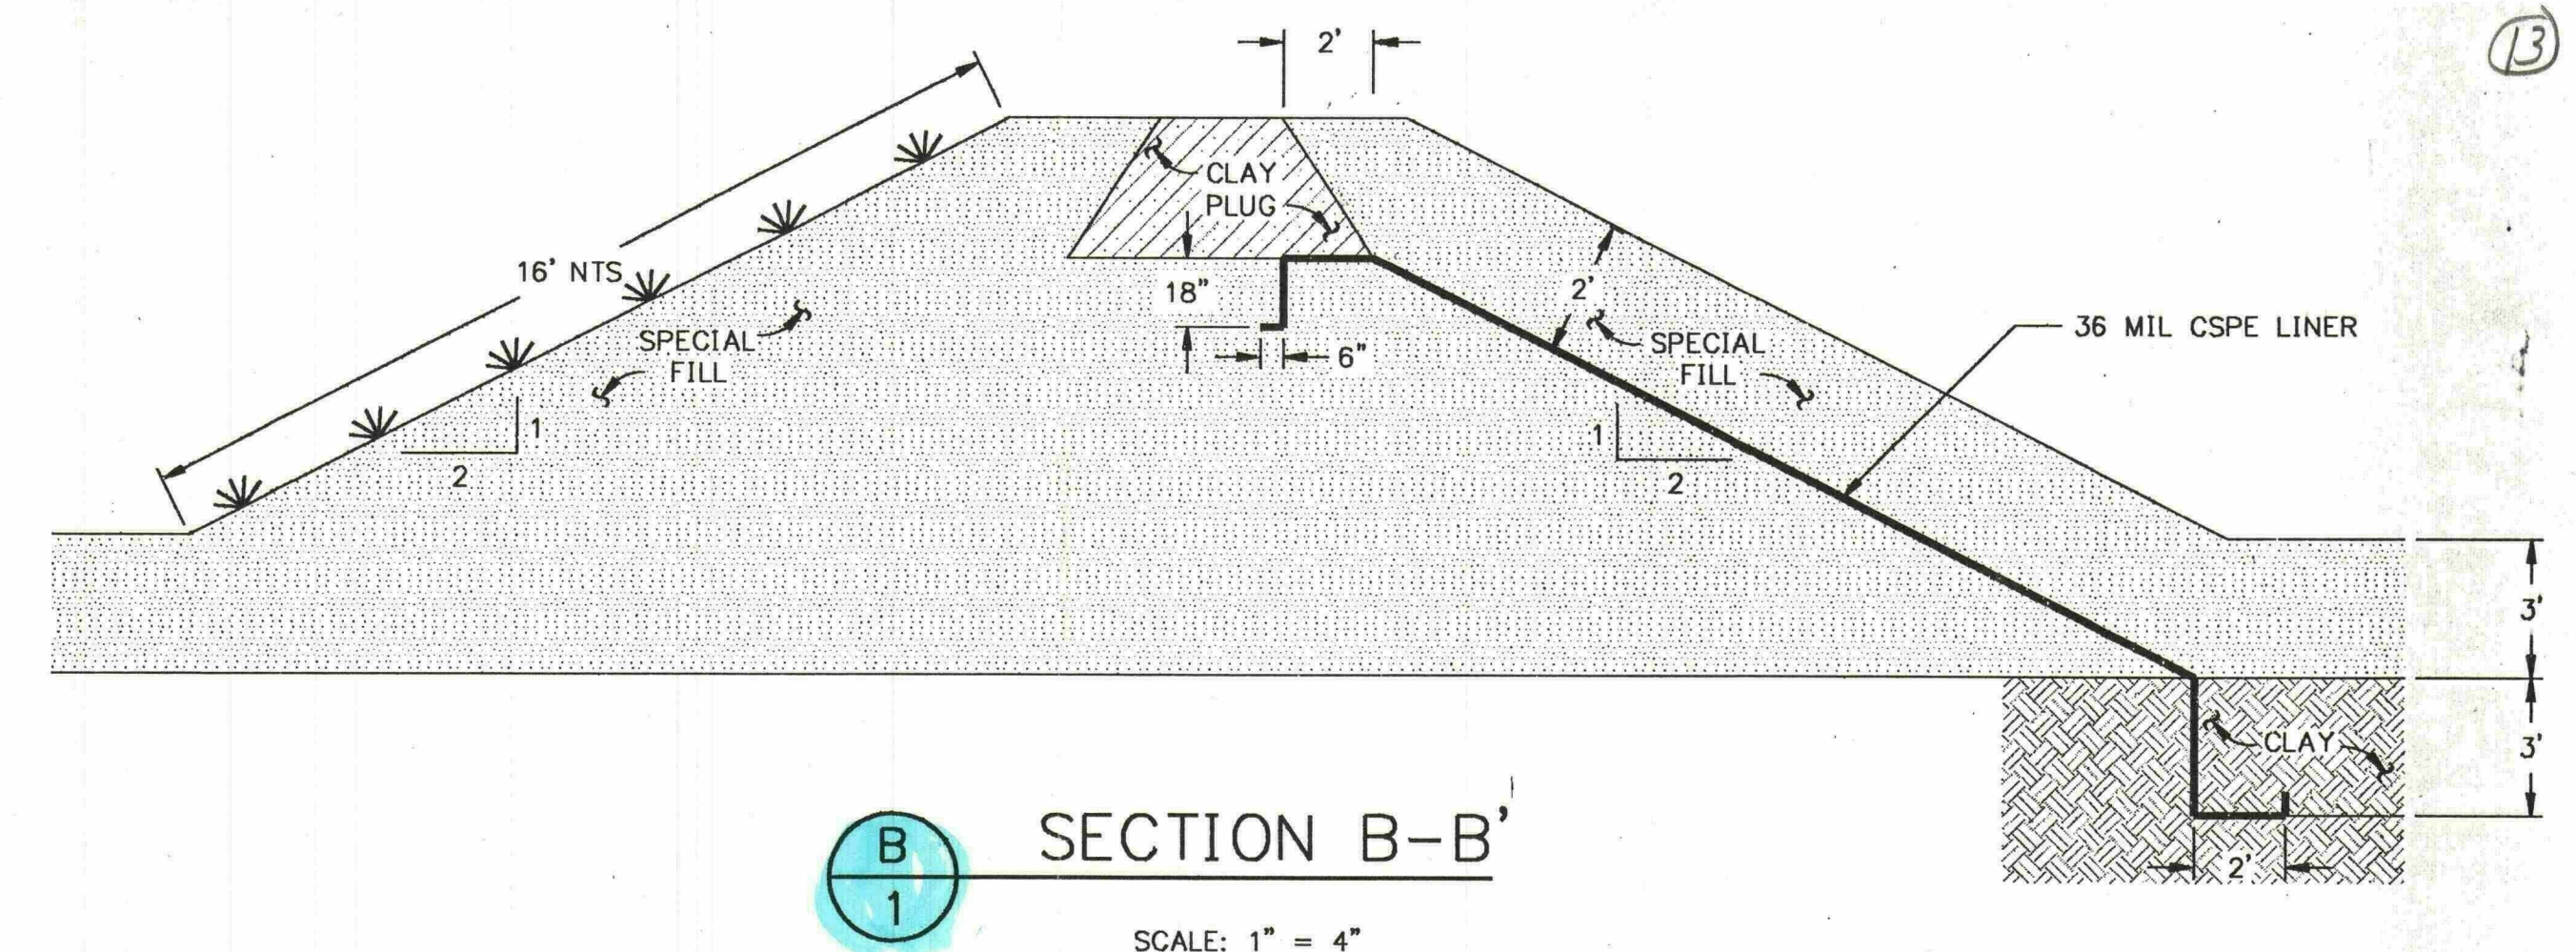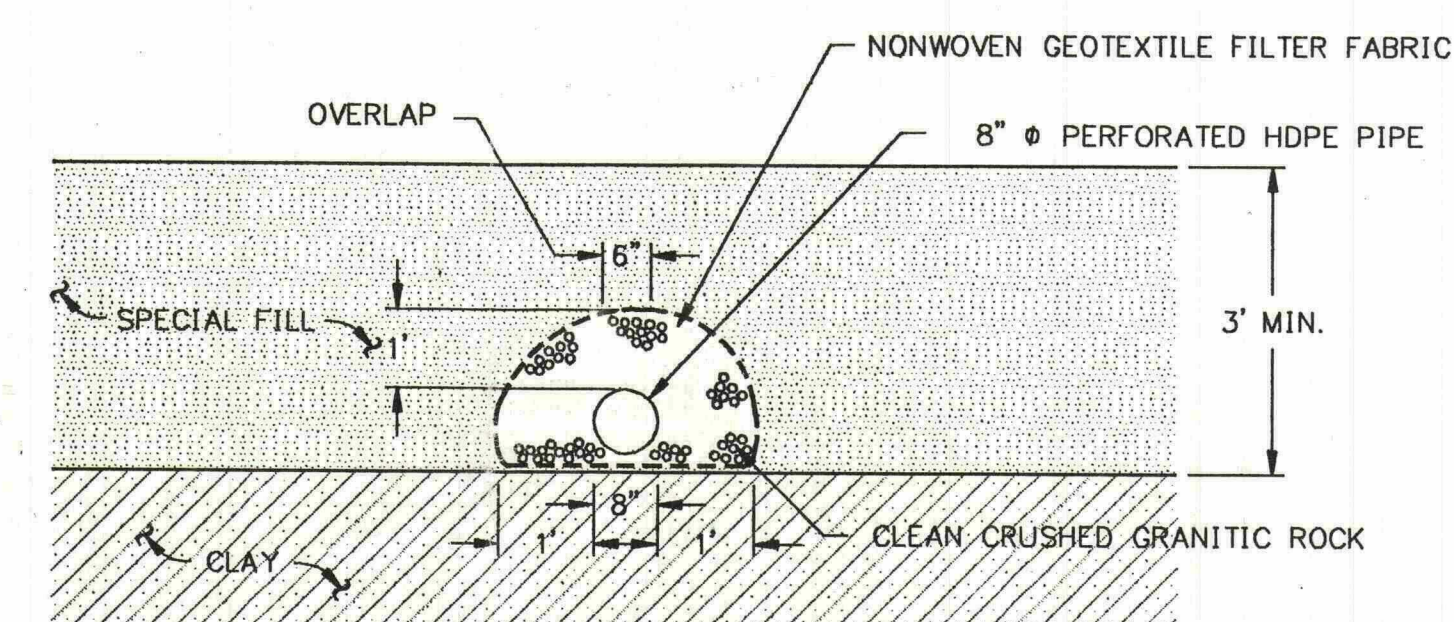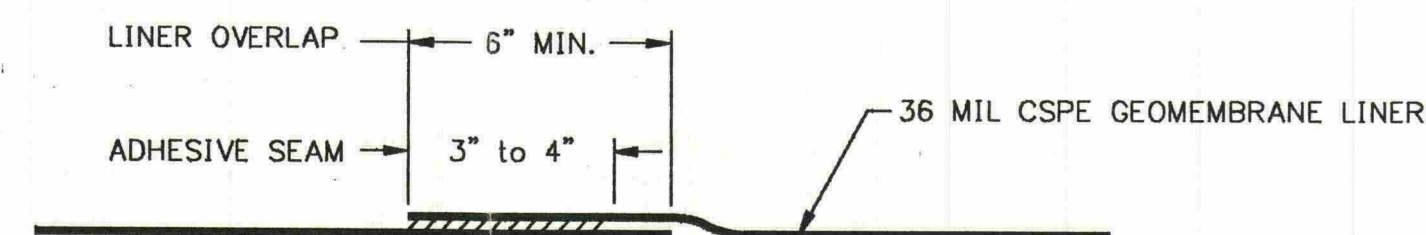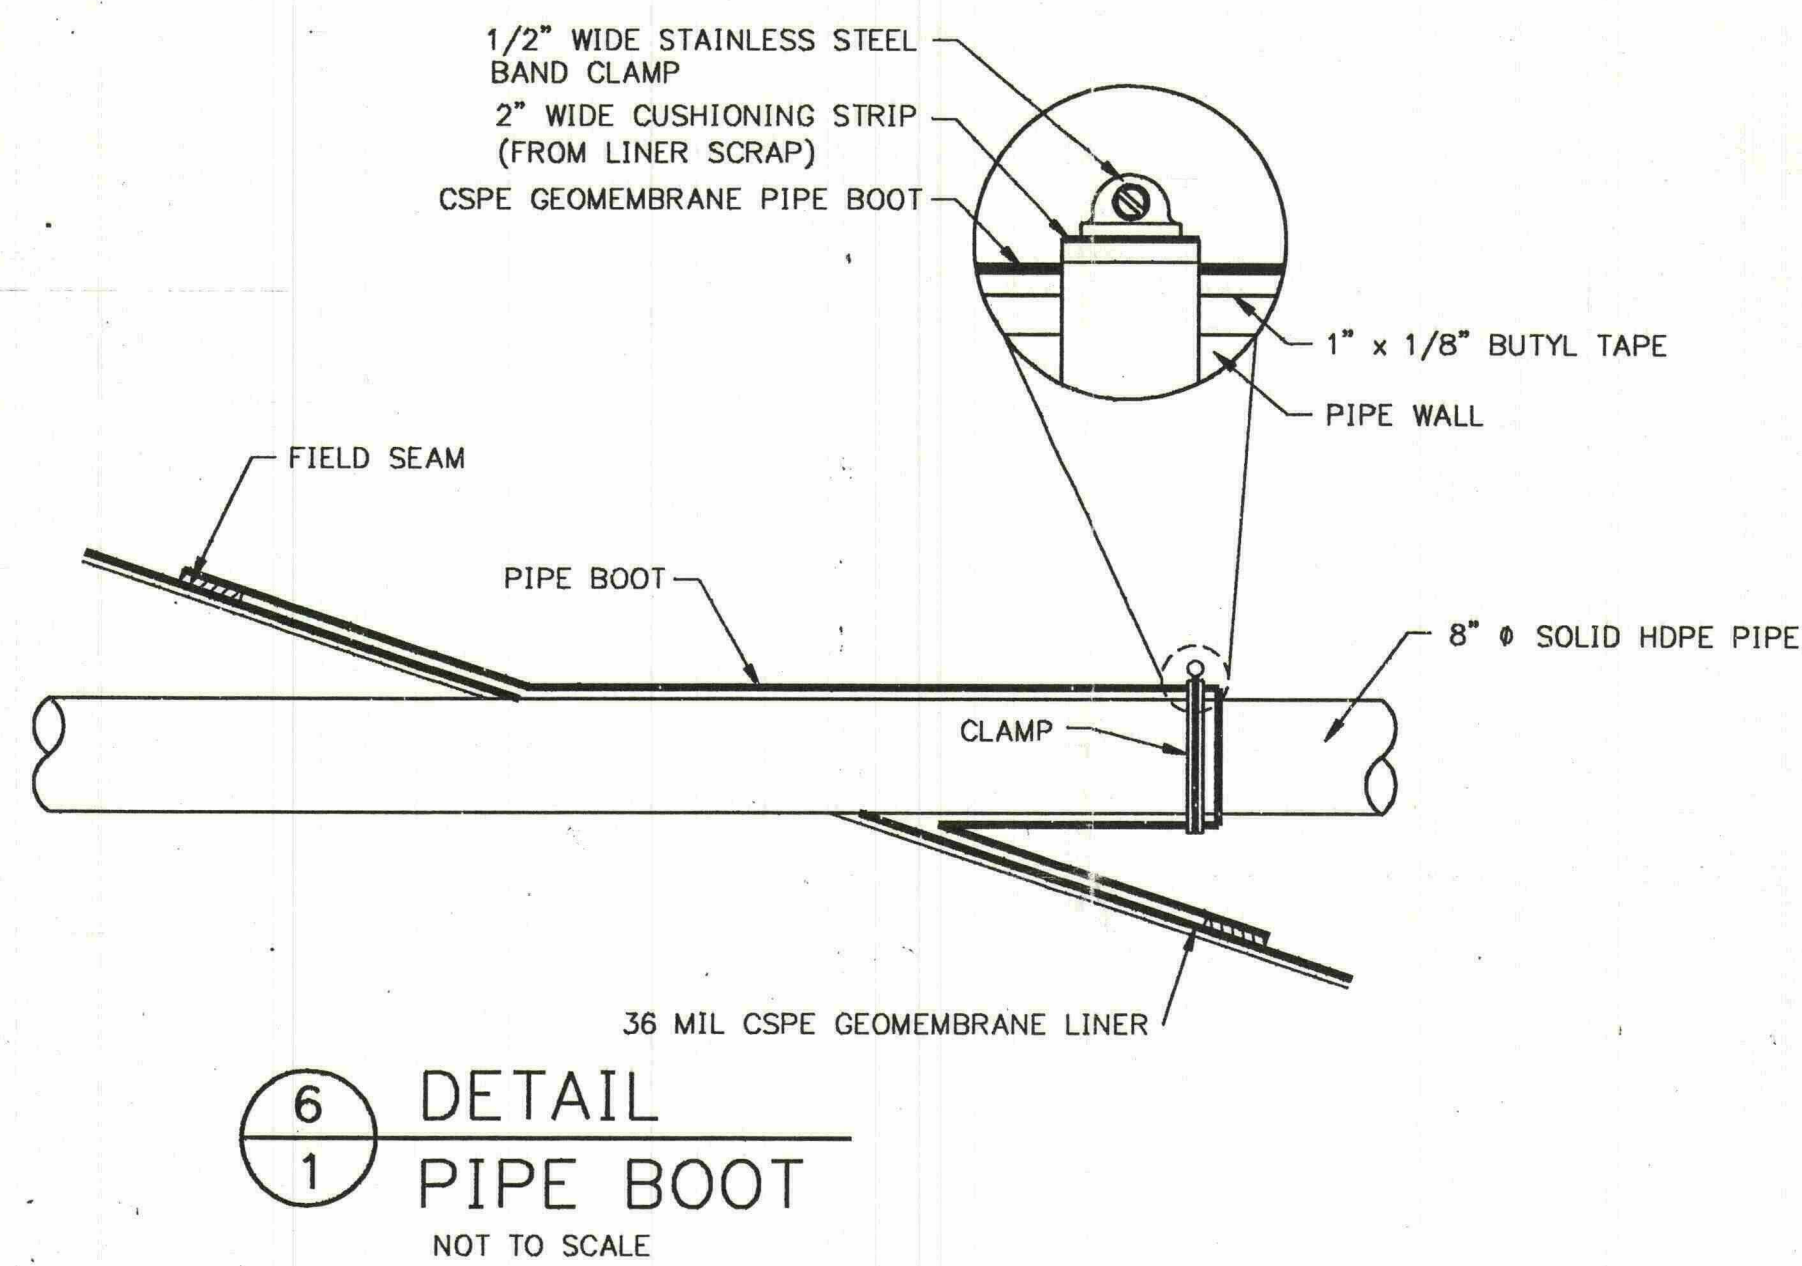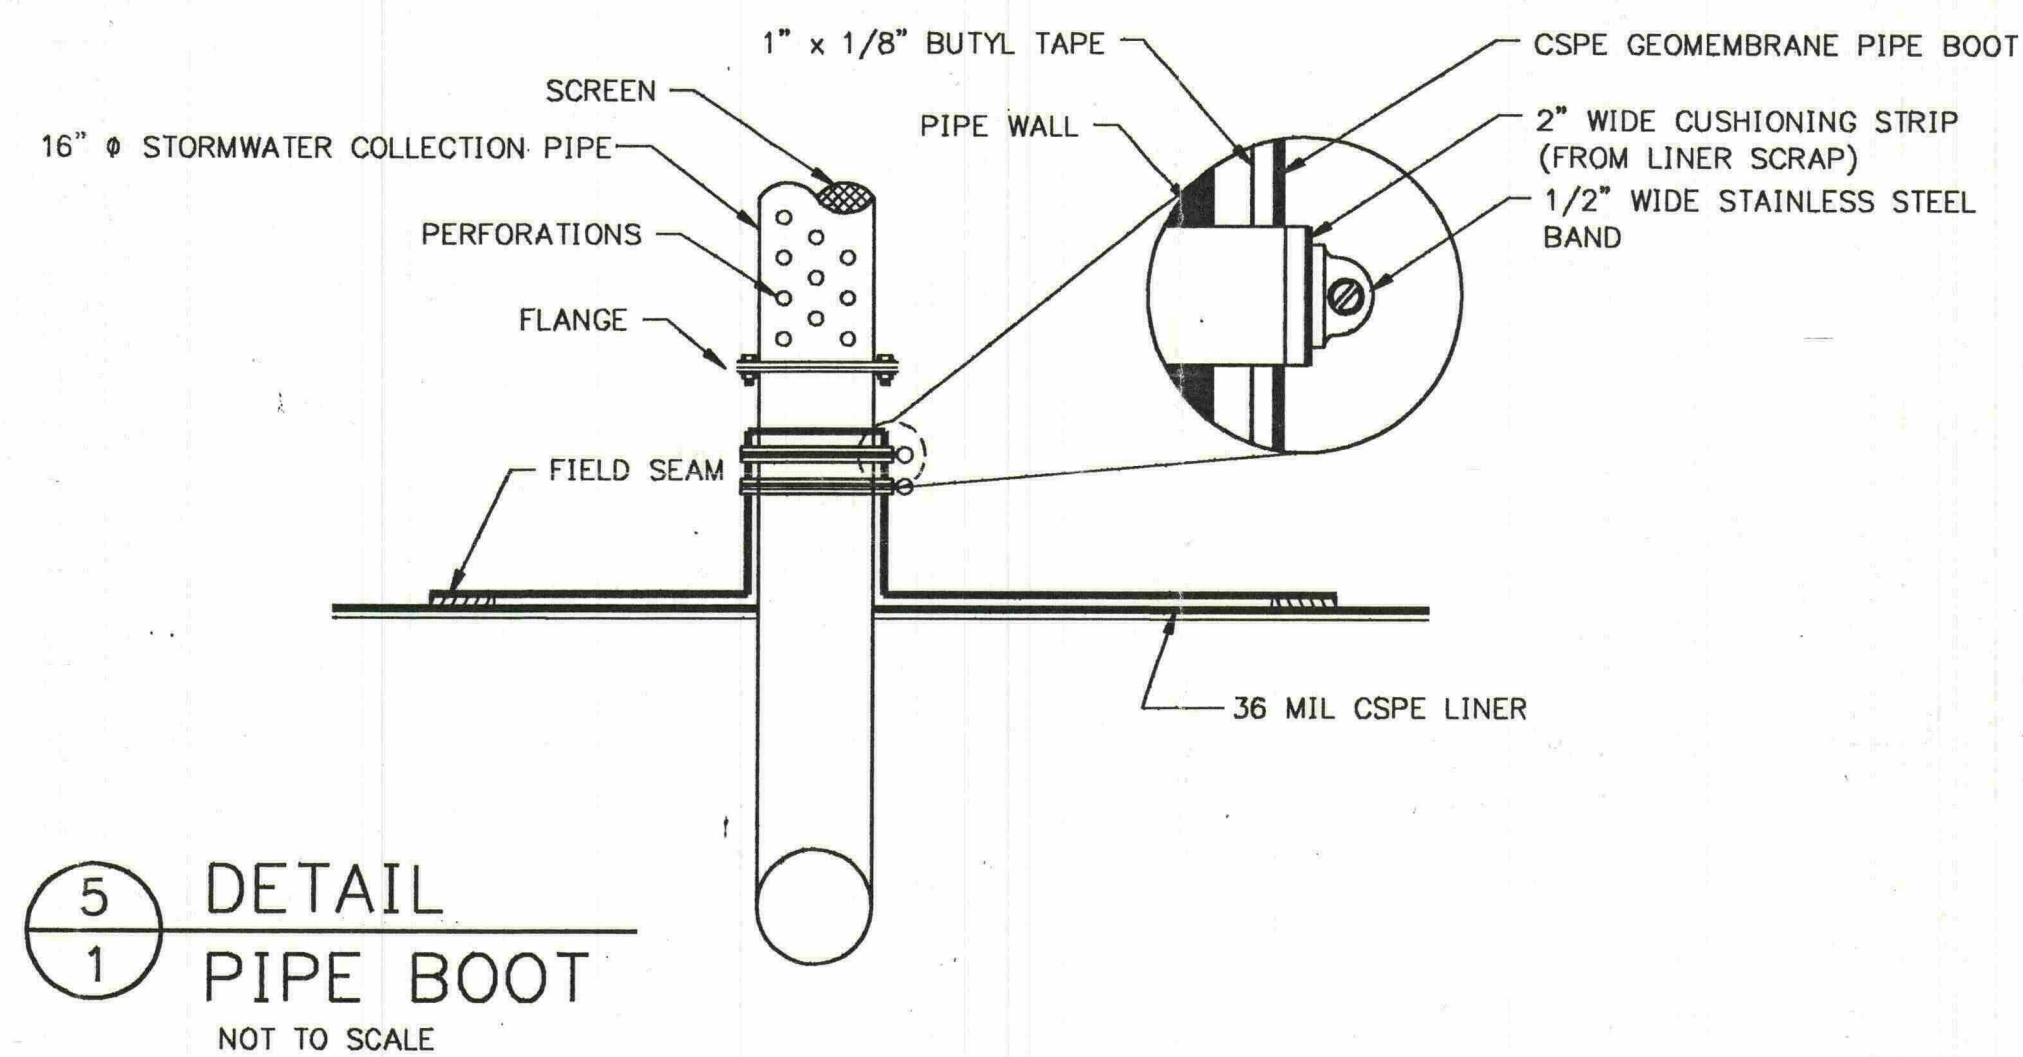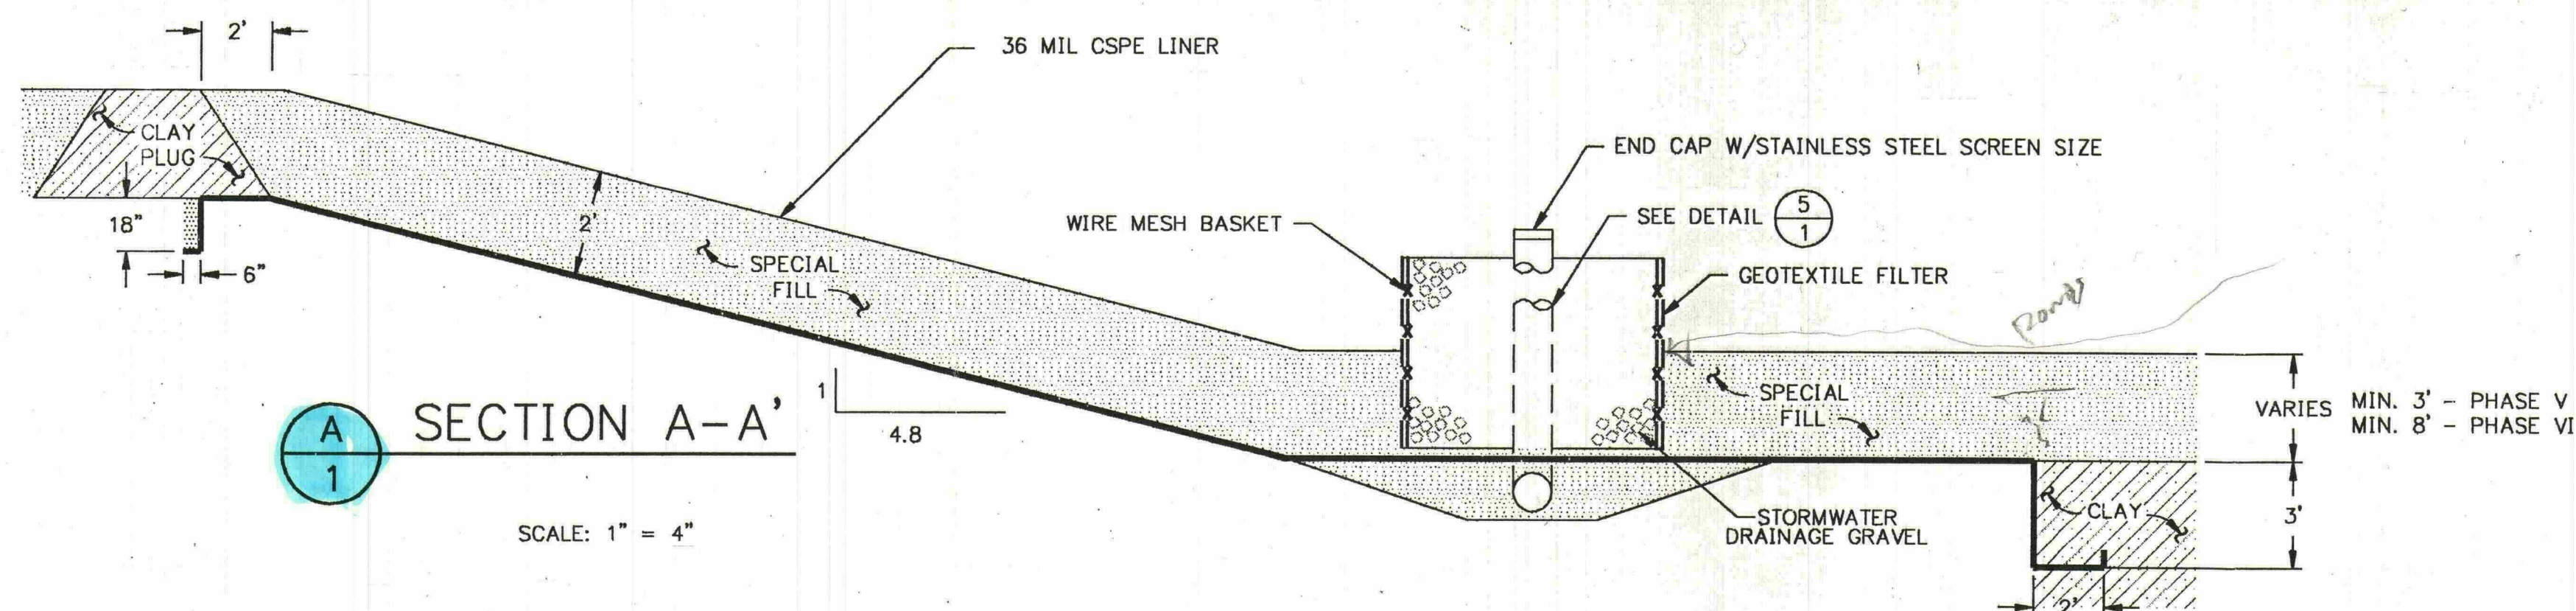


NOTE: TESTING OF THE 12" THICK COMPACTED SUBBASE LAYER AND THE 8" THICK SHELLROCK CONDUCTED BY OTHERS


GeoSYNTEC CONSULTANTS Boynton Beach, Florida		REV.	DATE	DESCRIPTION	DRN BY	APP BY
SIGNATURE 20 MAR 1992 No. 41800 STATE OF FLORIDA REGISTERED ENGINEER		DATE	10-29-91	PROJECT NO. F01344	SCALE: AS SHOWN	
DES BY		SLB	10-25-91	PROJECT: PHASES V AND VI SOUTHEAST LANDFILL HILLSBOROUGH COUNTY, FLORIDA		
DRN BY		WBH	10-29-91	SHEET TITLE: DETAILS I		
CHK BY		DAS	3-19-92	SHEET 4 OF 5		
REV BY		CAL	5-15-92	DRAWING NO. 4		
APP BY				Waste Management, Inc. of Florida		

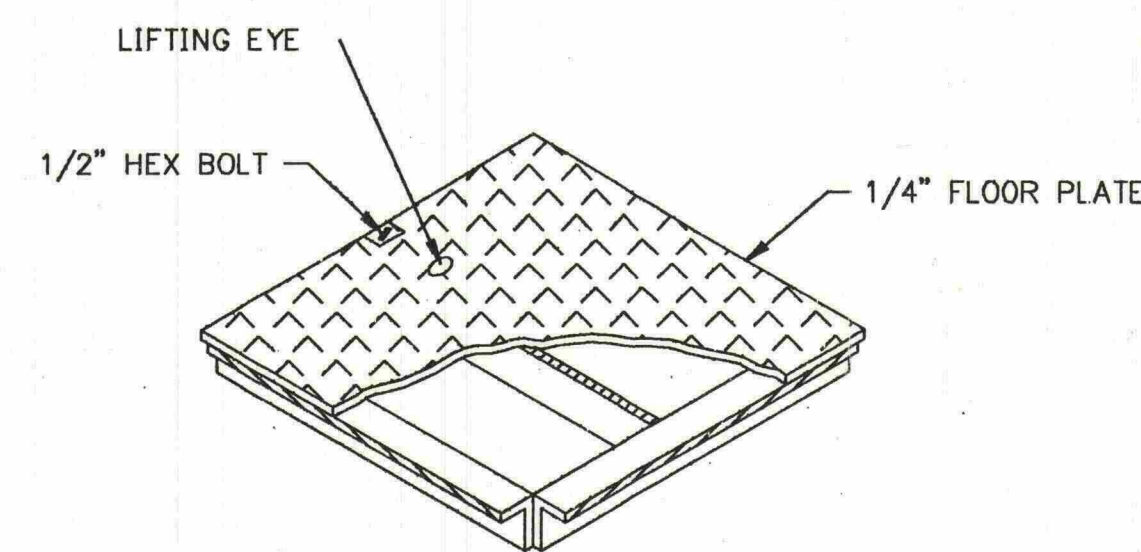


STEEL TRAFFIC COVER

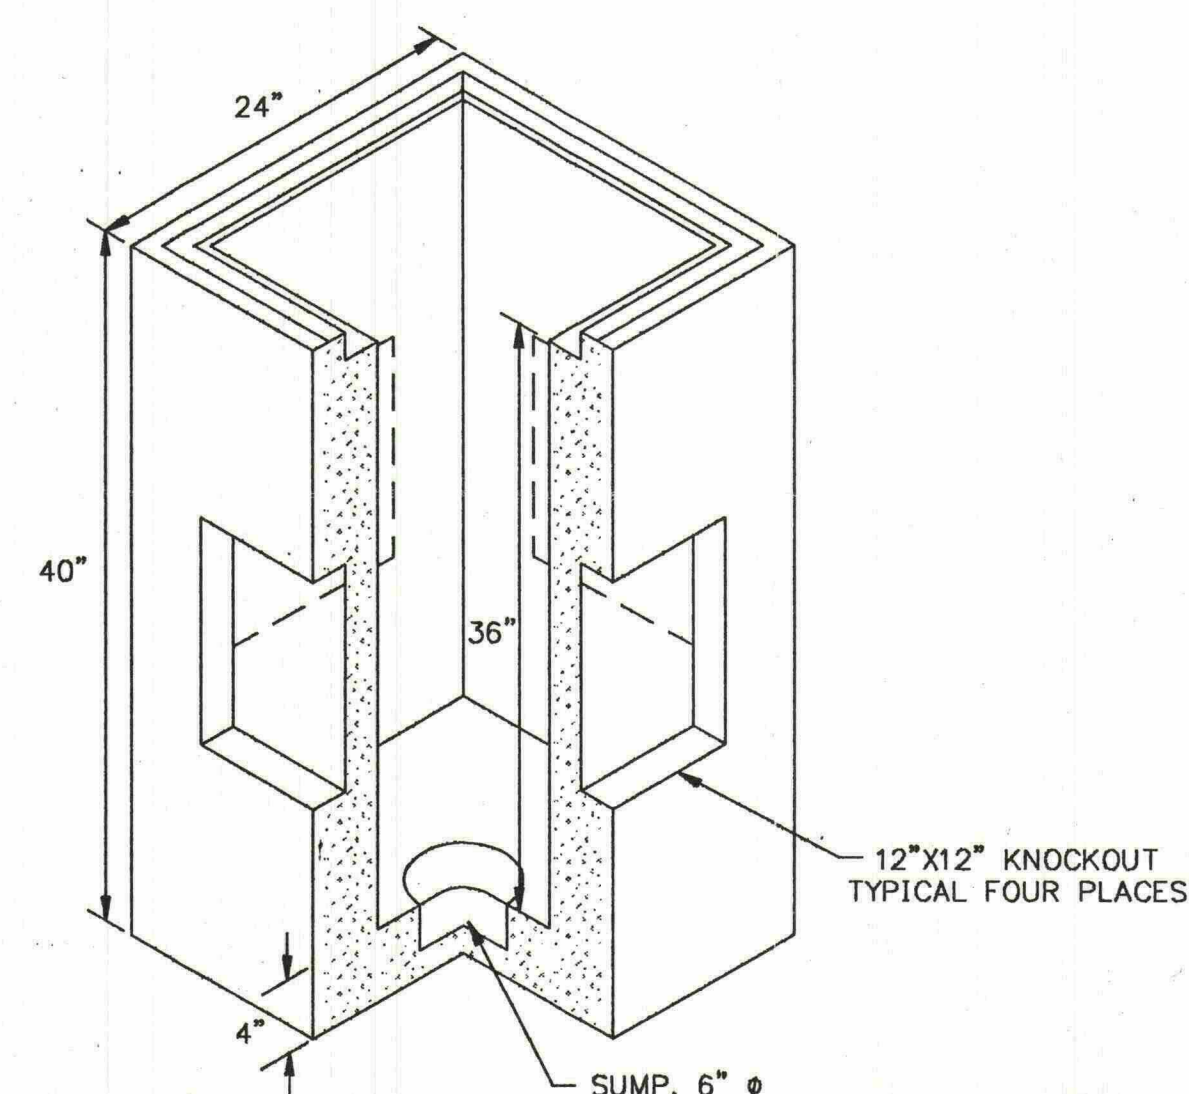



9
3
DETAIL
TYPICAL ELECTRICAL PULL BOX
SCALE: 1" = 1'

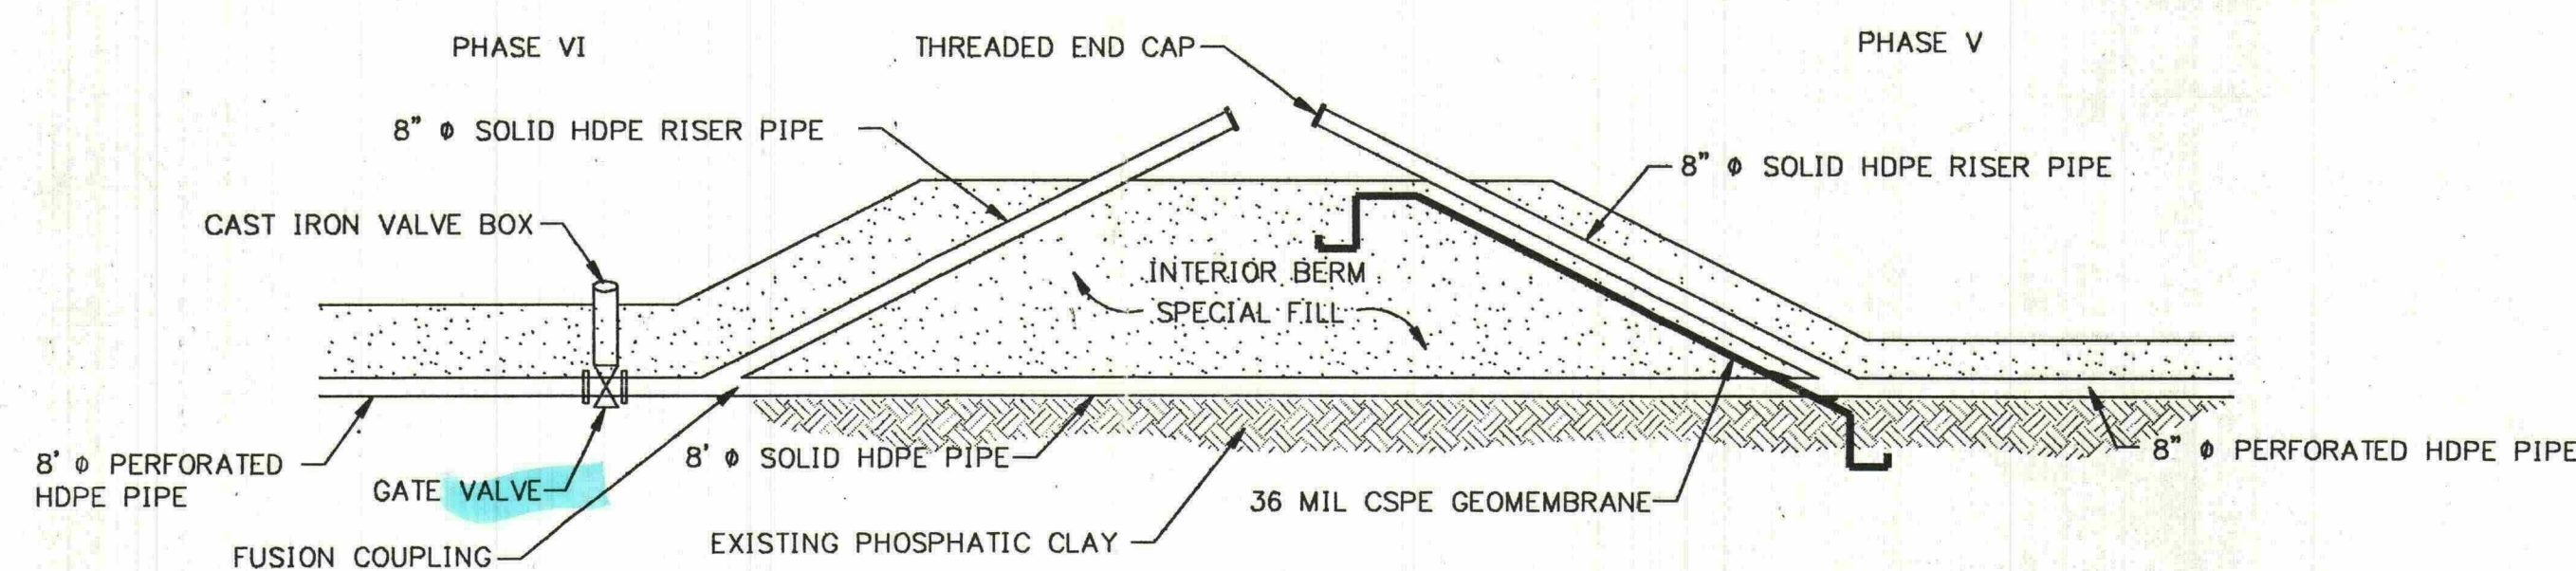

13
2
DETAIL
TYPICAL INTERIOR BERM RISER
SCALE: NTS

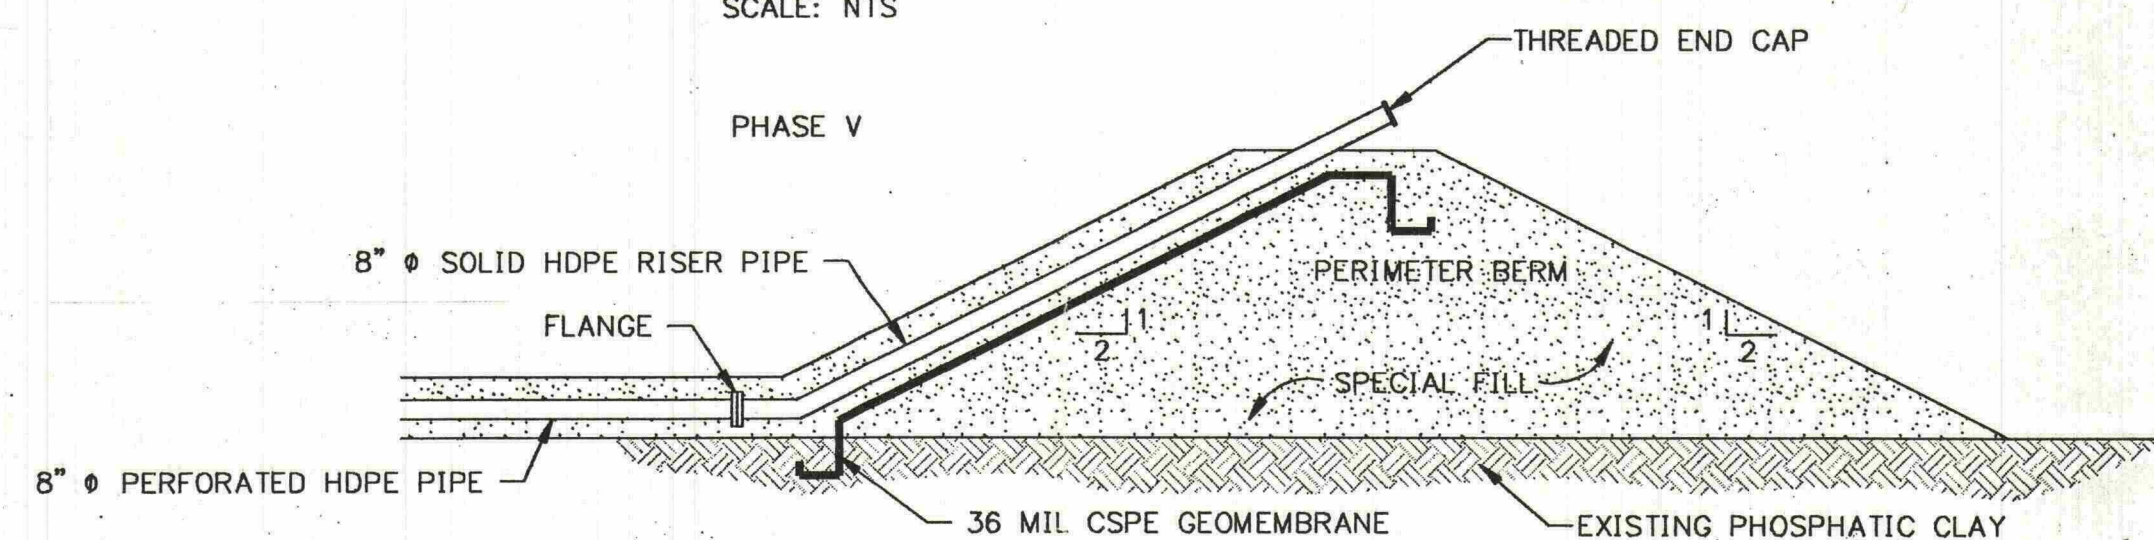


14
2
DETAIL
TYPICAL PERMANENT RISER
SCALE: NTS

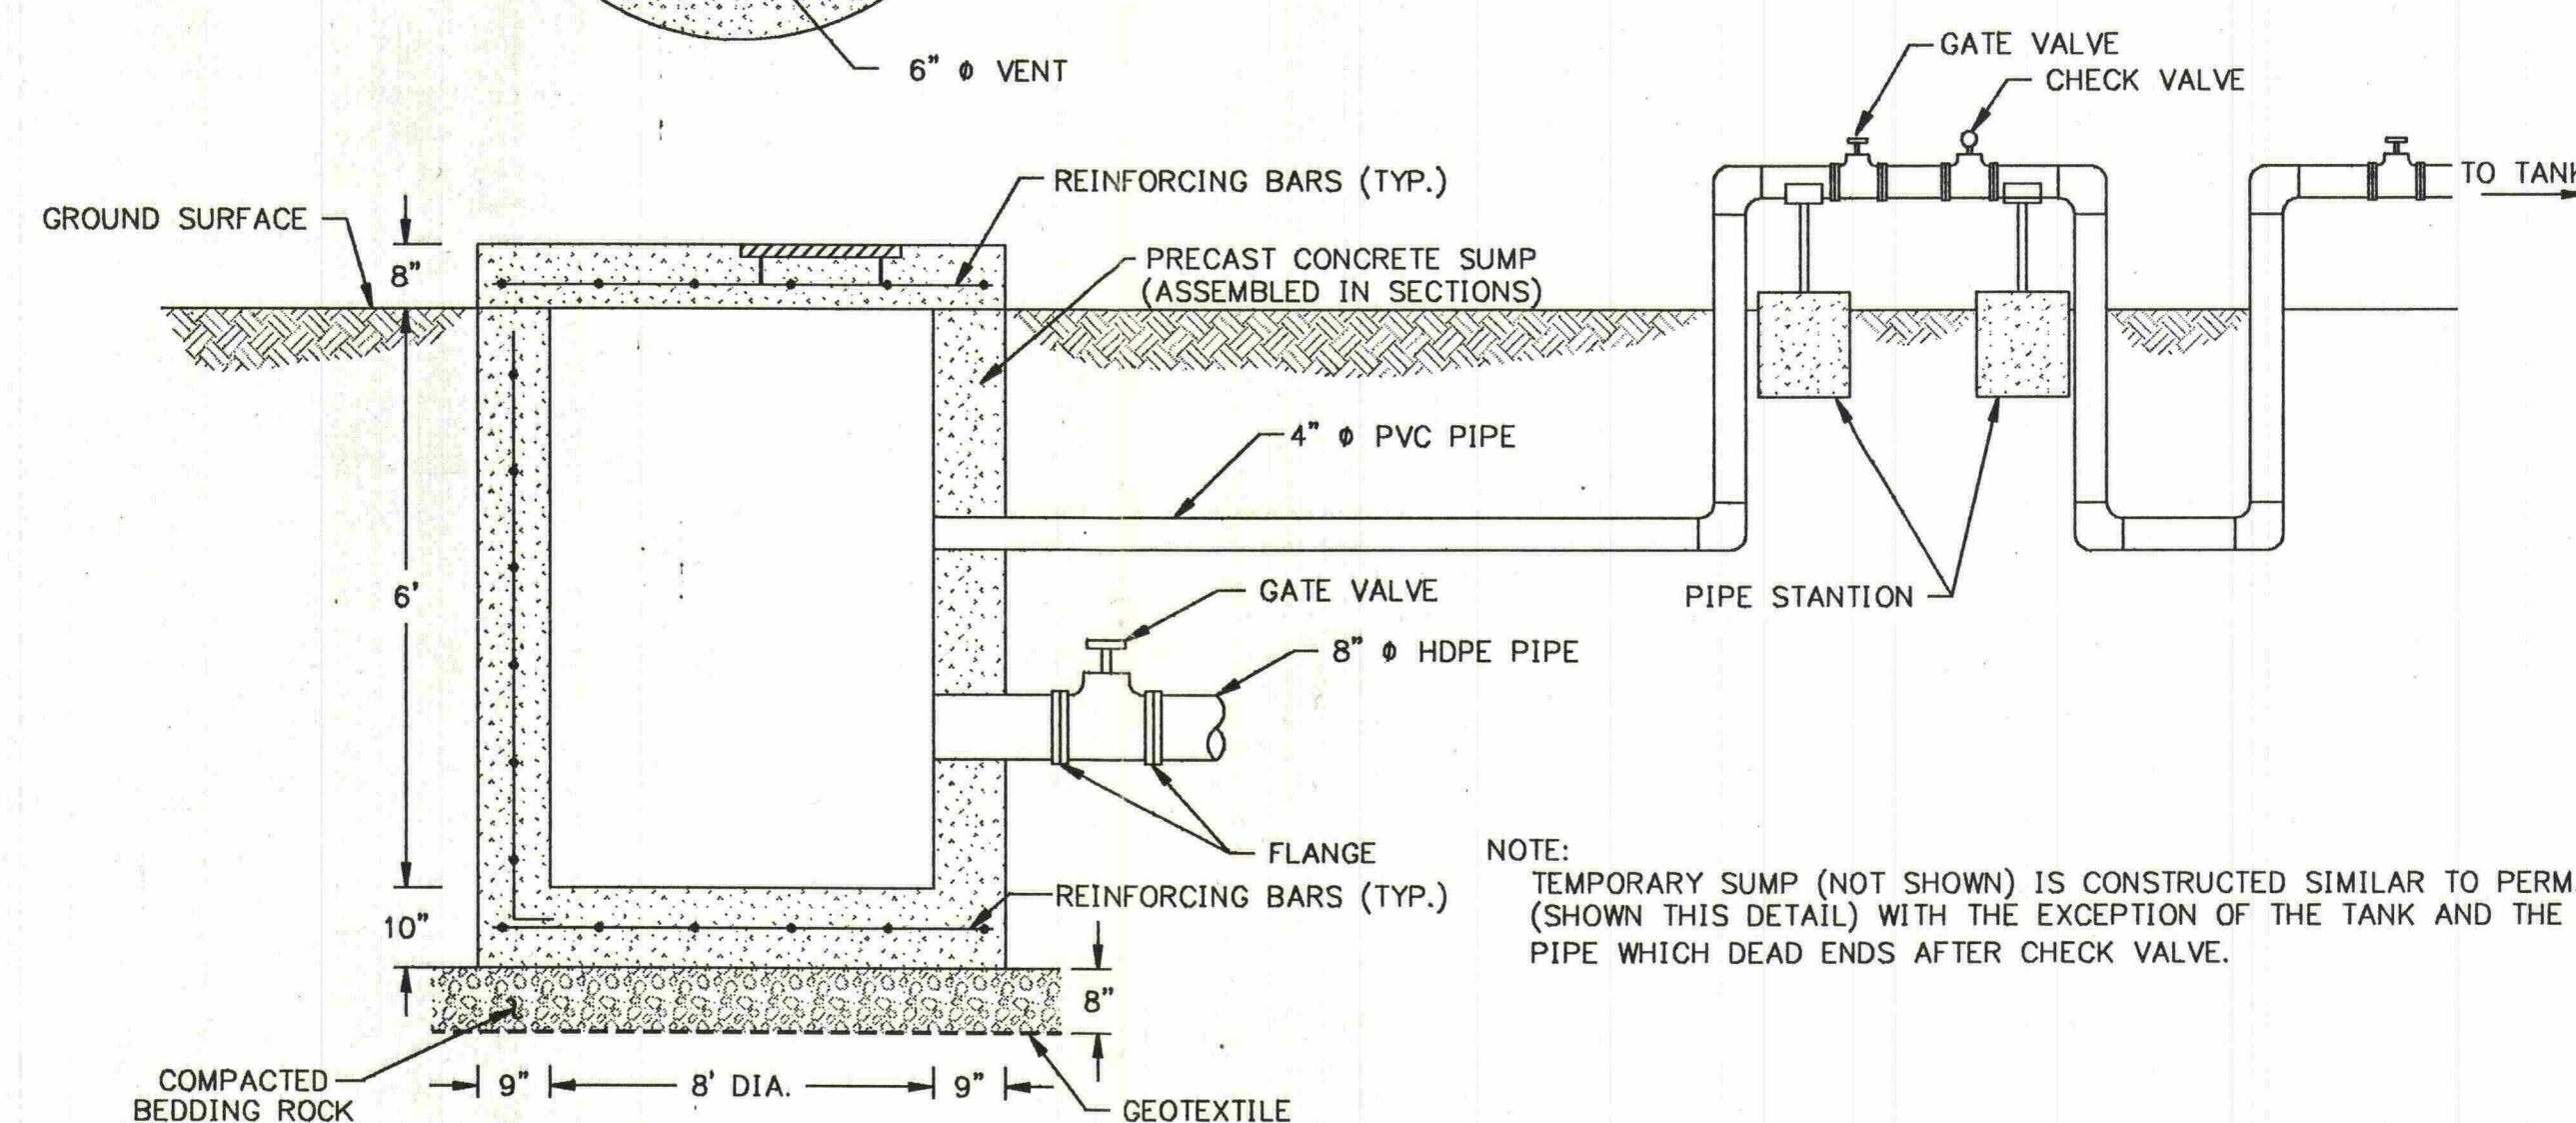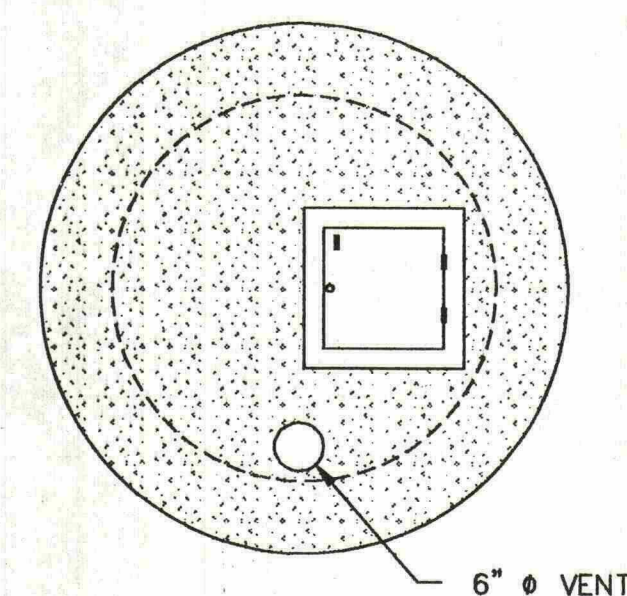


NOTE: TEMPORARY SUMP (NOT SHOWN) IS CONSTRUCTED SIMILAR TO PERMANENT SUMP (SHOWN THIS DETAIL) WITH THE EXCEPTION OF THE TANK AND THE 4" PVC PIPE WHICH DEAD ENDS AFTER CHECK VALVE.


10
2
DETAIL
TYPICAL SUMP
SCALE: 1" = 2'

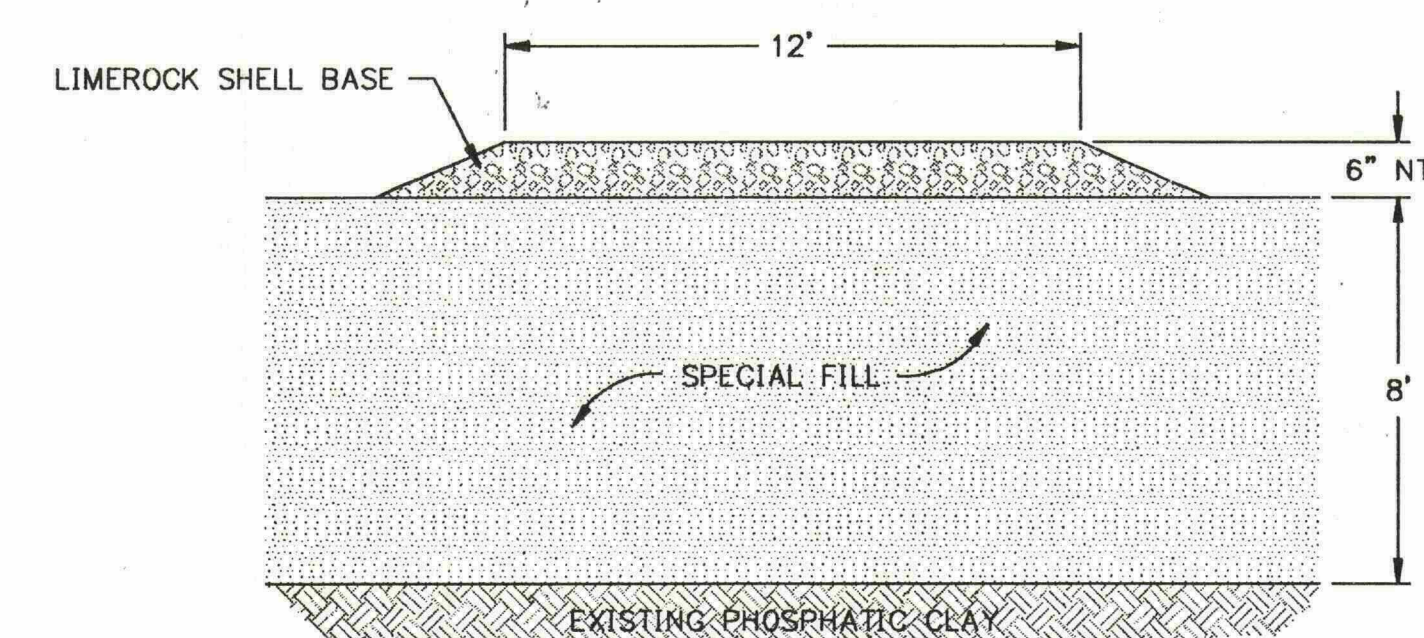


11
3
SECTION
TEMPORARY SERVICE ROAD
SCALE: 1" = 4'

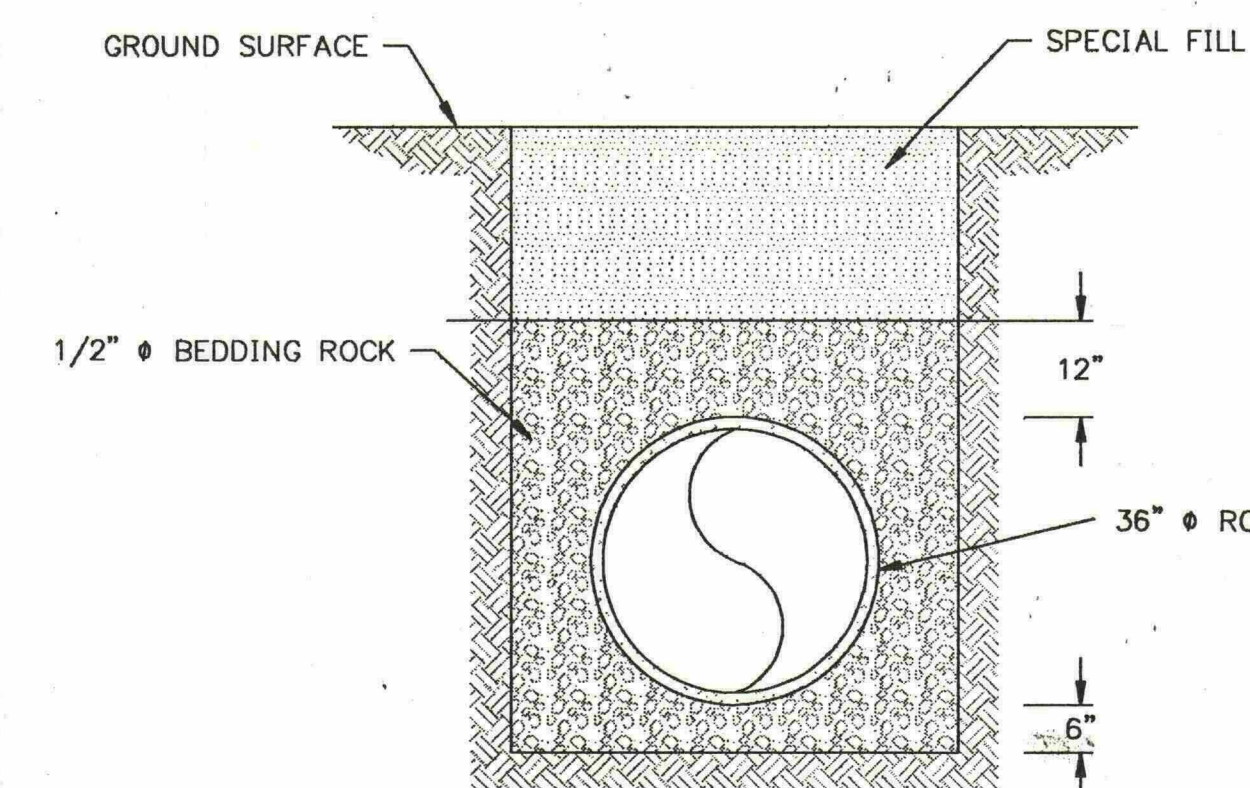

12
2
SECTION
REINFORCED CONCRETE STORMWATER PIPE
SCALE: 1" = 2'

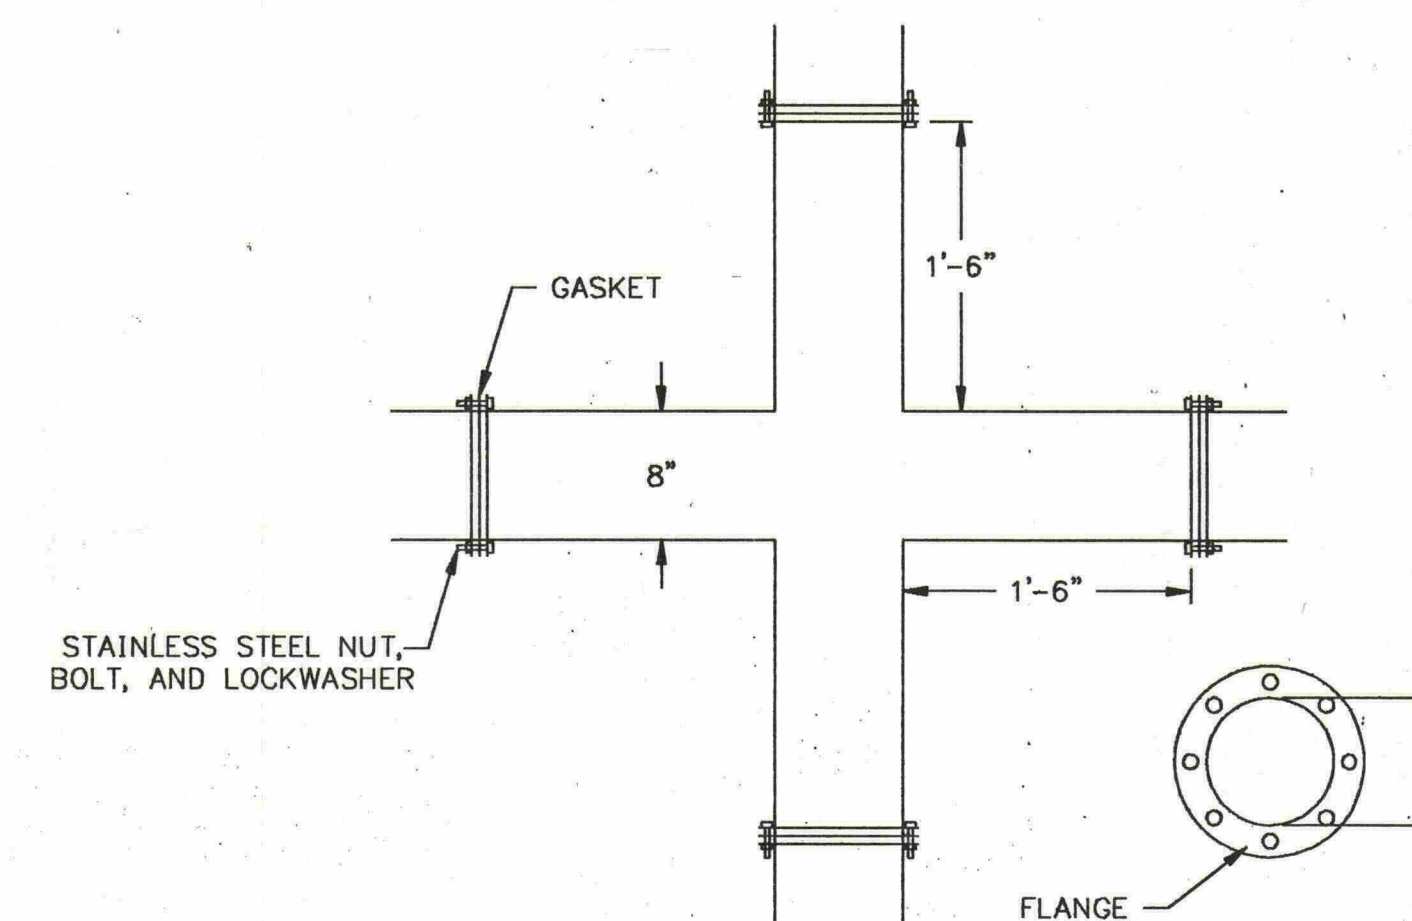


15
2
DETAIL
TYPICAL CROSS FLANGE
SCALE: 1" = 1'

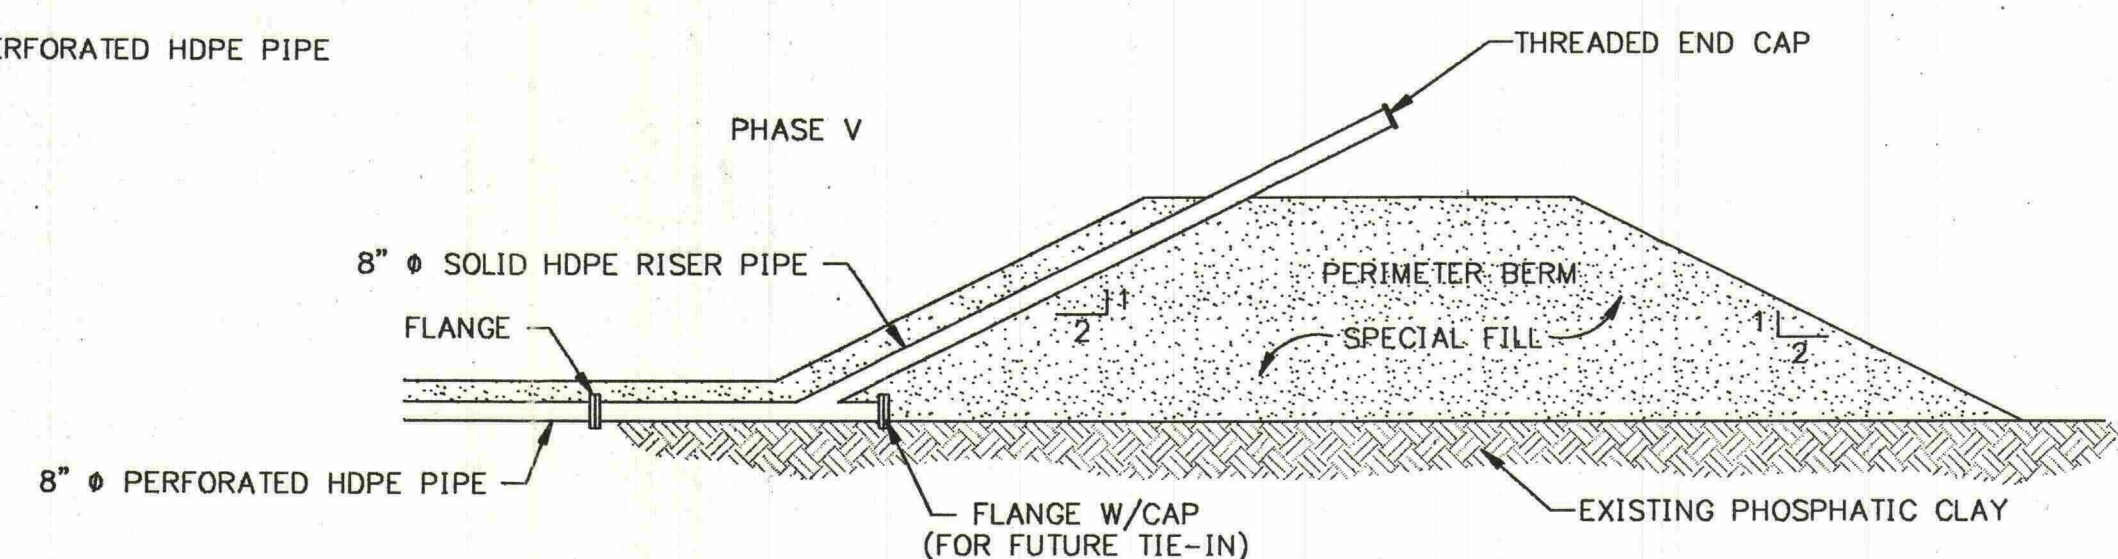

16
2
DETAIL
TYPICAL TEMPORARY RISER
SCALE: NTS

GEO SYNTec CONSULTANTS Boynton Beach, Florida <i>Clement An Line</i> SIGNATURE 29 MAY 1992 CERTIFICATE No. 41800 STATE OF FLORIDA REGISTERED ENGINEER		REV. DATE DESCRIPTION DRN BY APP BY DATE: 10-29-91 DES BY: SLB 3-9-92 DRN BY: SLB 3-9-92 CHK BY: DAS 5-13-92 REV BY: DAS 5-14-92 APP BY: CAL 5-15-92	PROJECT NO. F01344 SCALE: AS SHOWN PROJECT: PHASES V AND VI SOUTHEAST LANDFILL HILLSBOROUGH COUNTY, FLORIDA SHEET TITLE: DETAILS II	SHEET 5 OF 5 DRAWING NO. 5
--	--	--	--	--------------------------------------


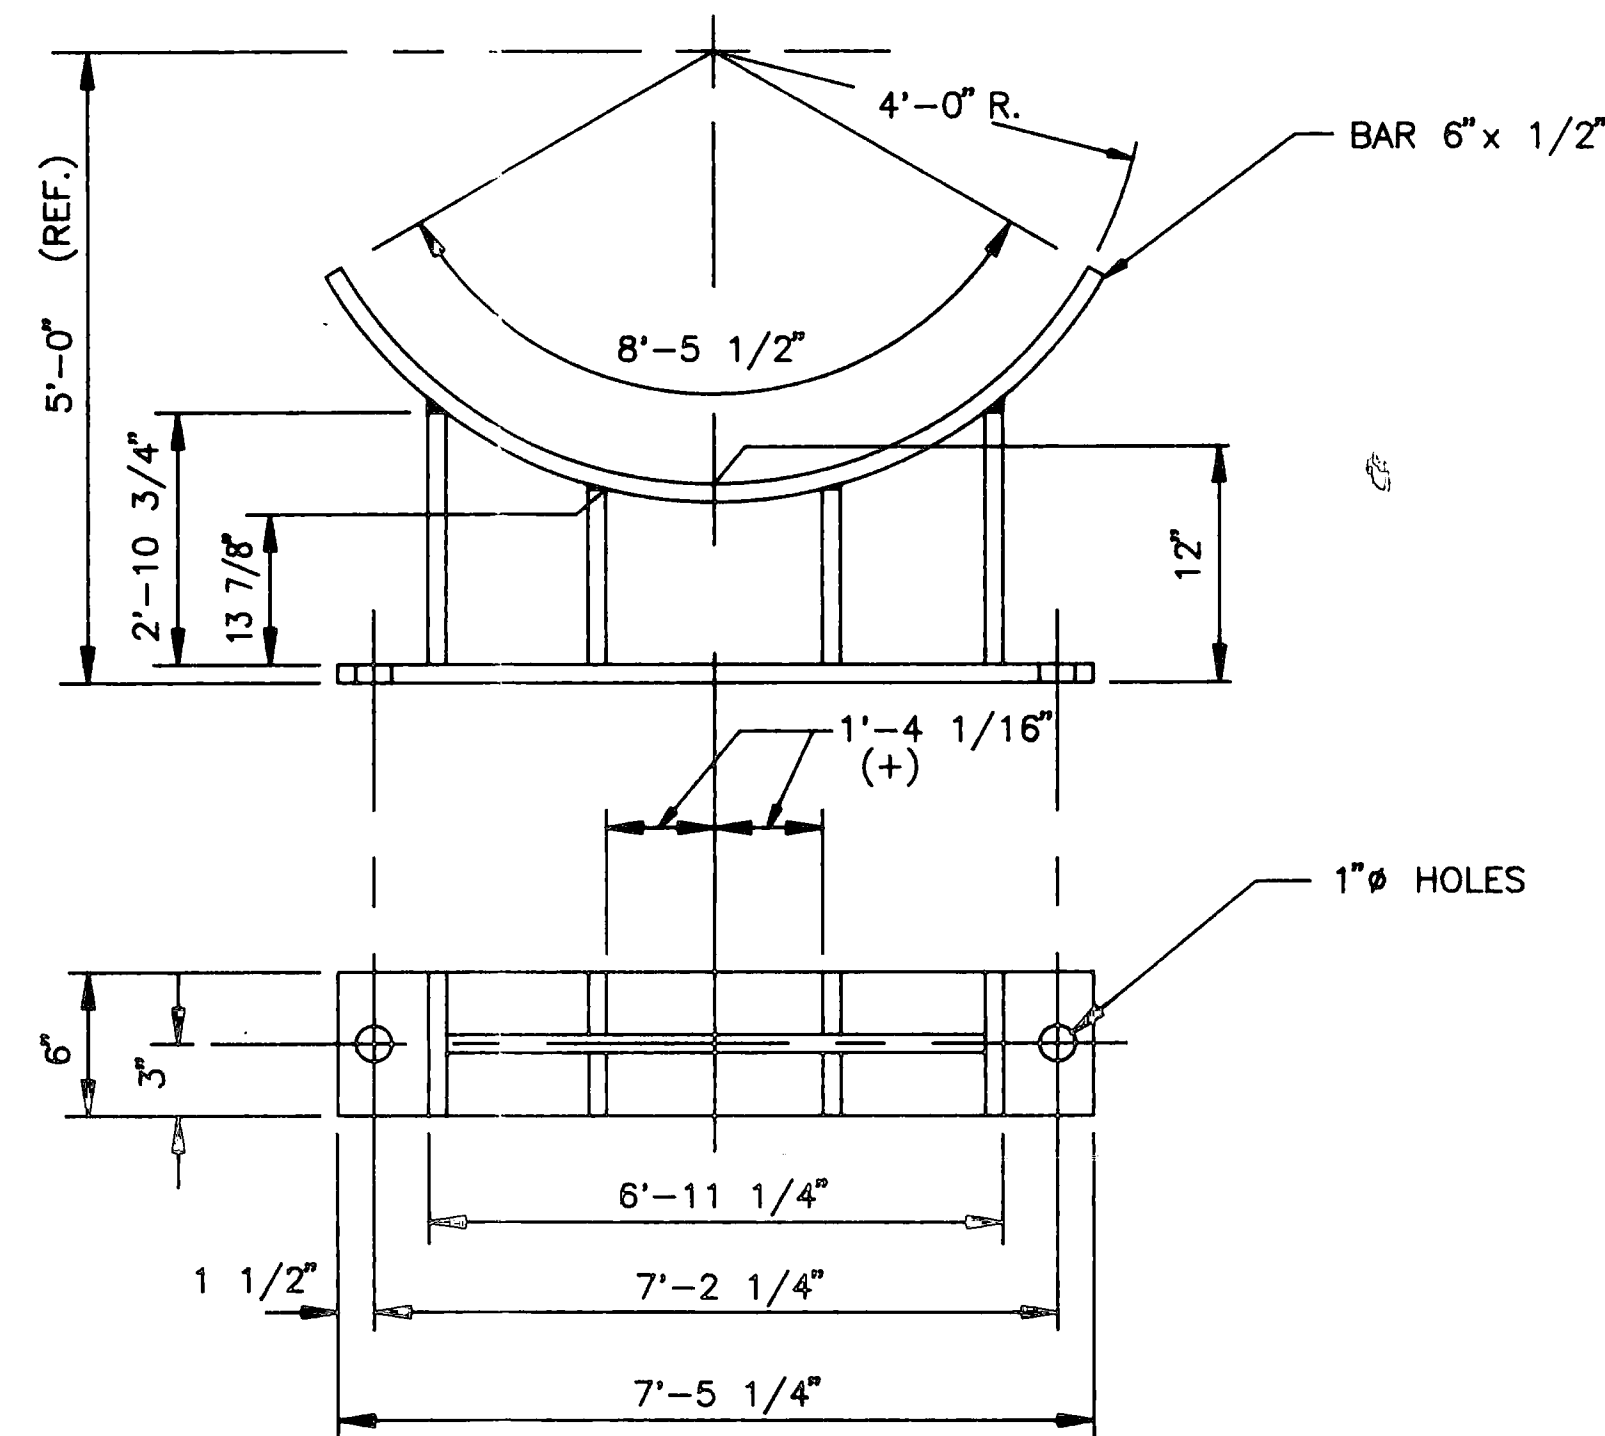


SADDLE DETAIL

(3) REQ'D.
SHIP LOOSE

NOTE:

ALL PLATE 3/8"
EXCEPT 1/2" ROLLED BAR

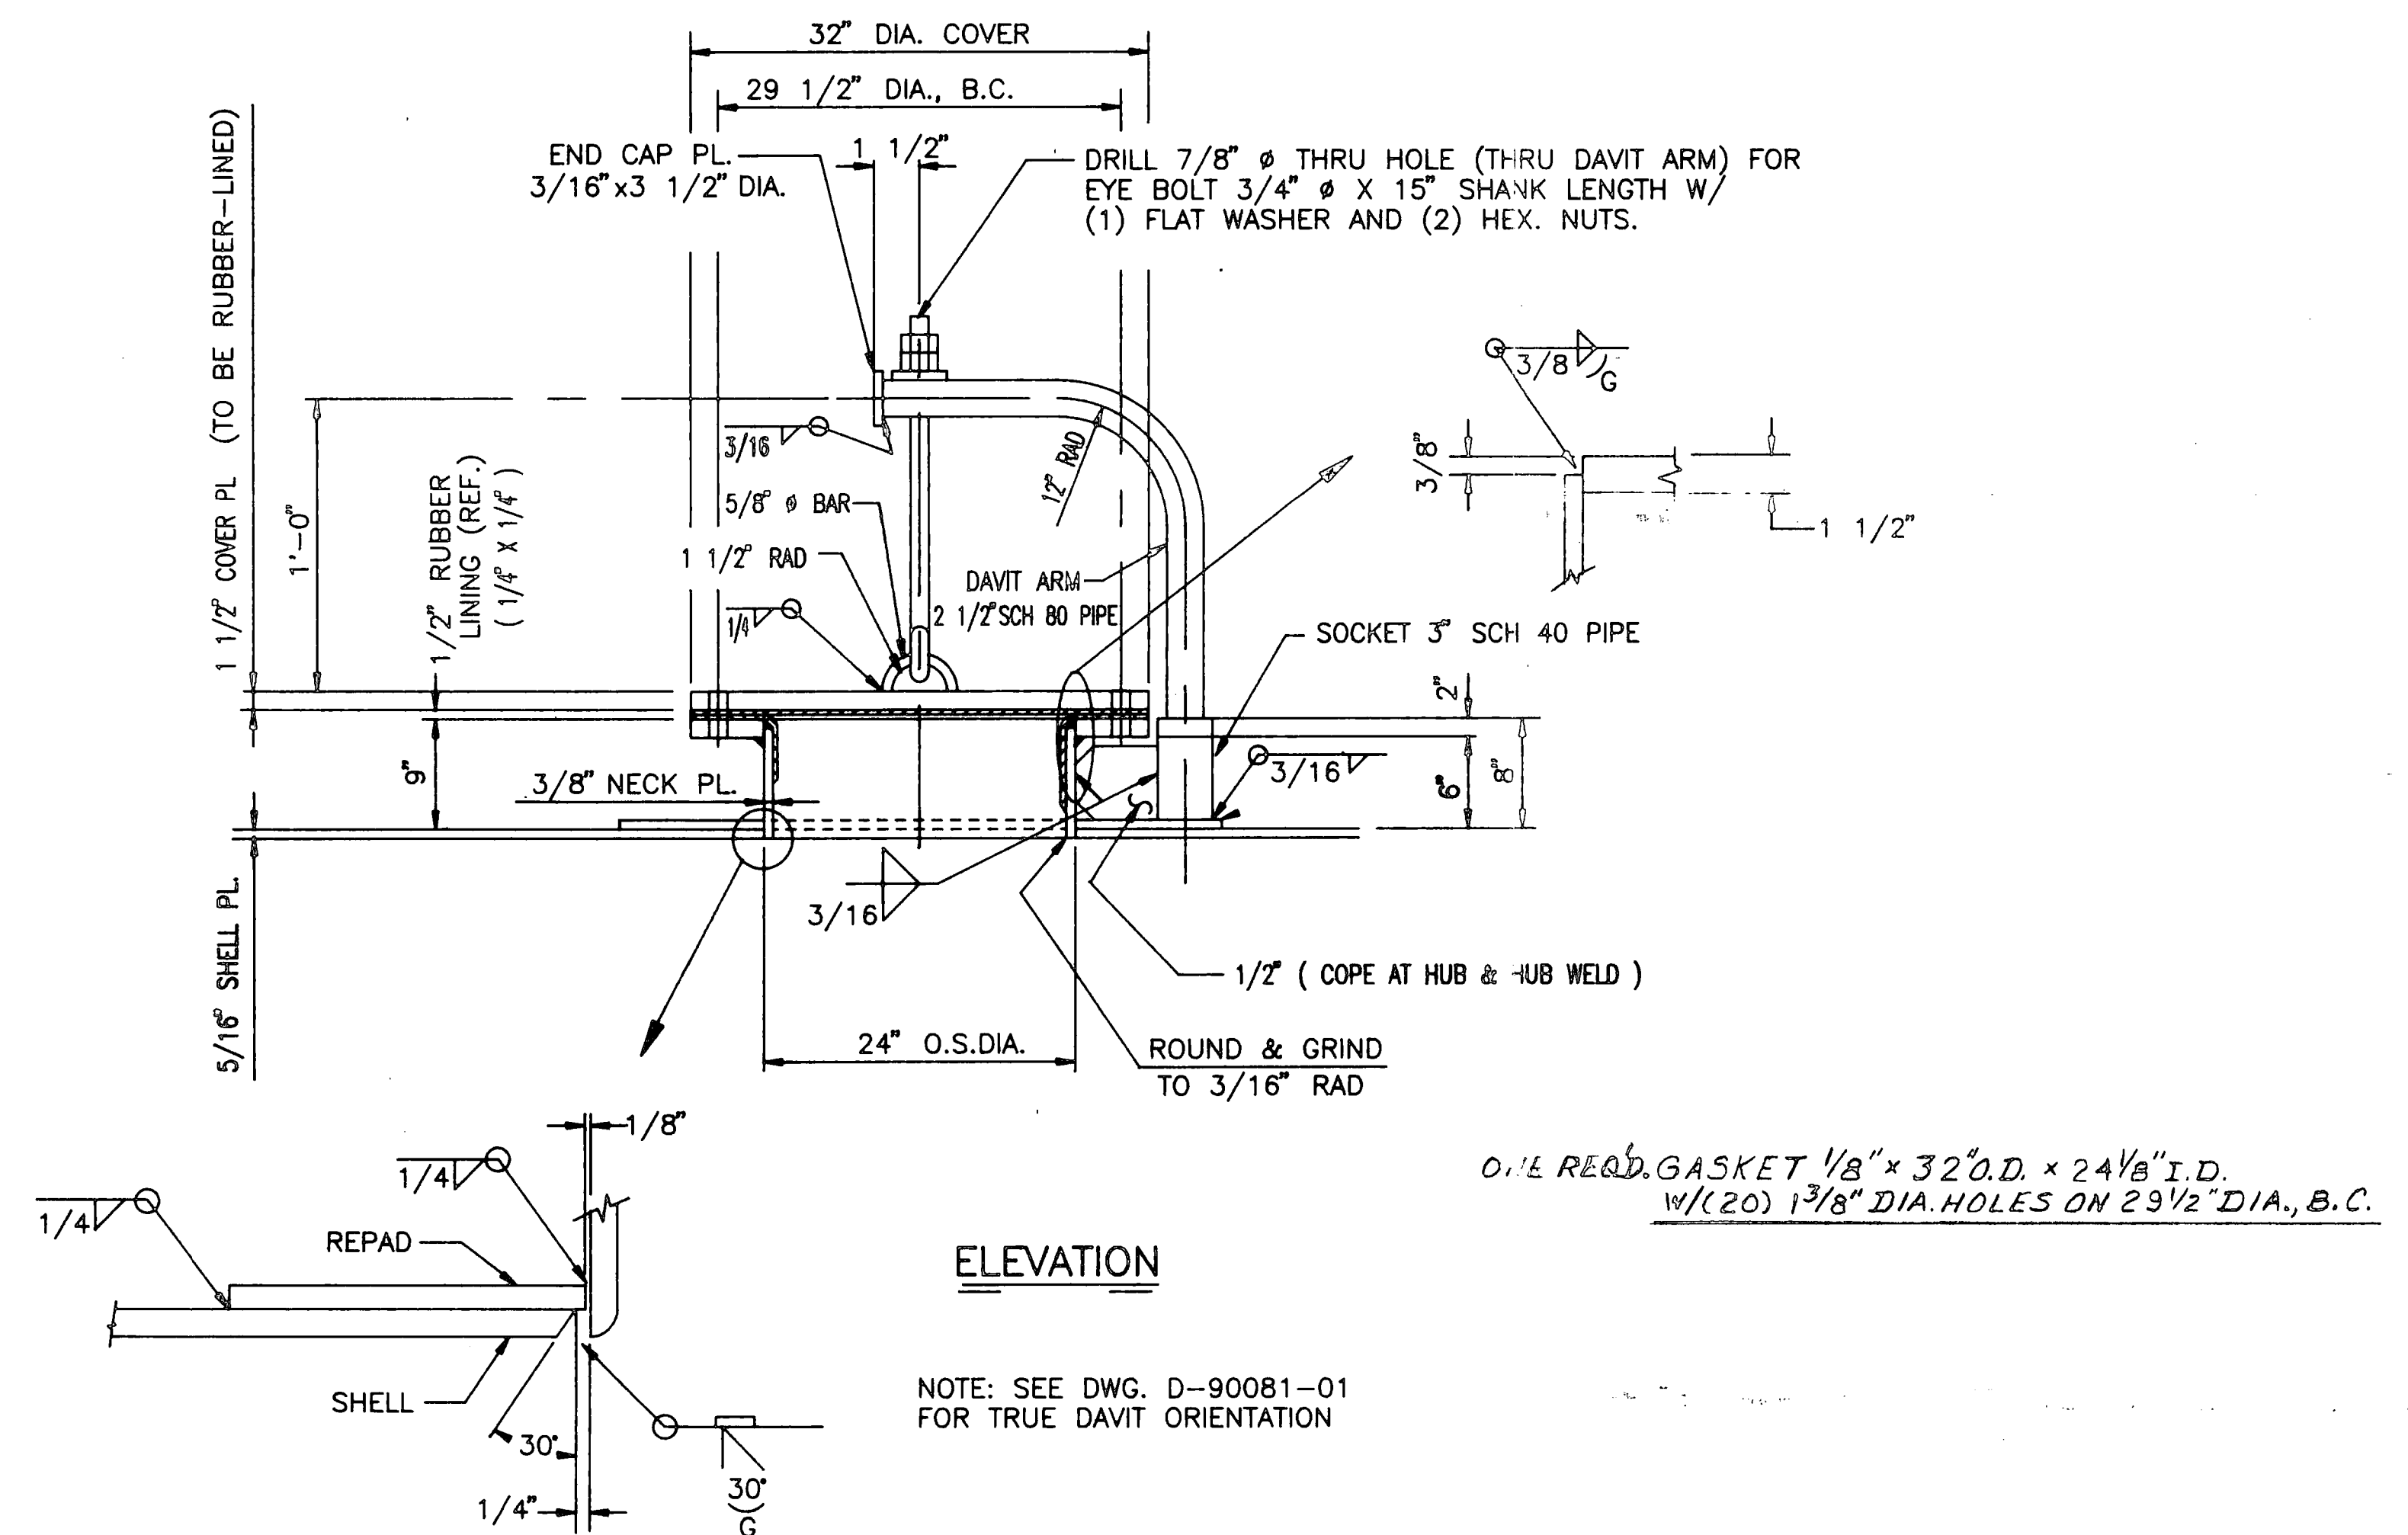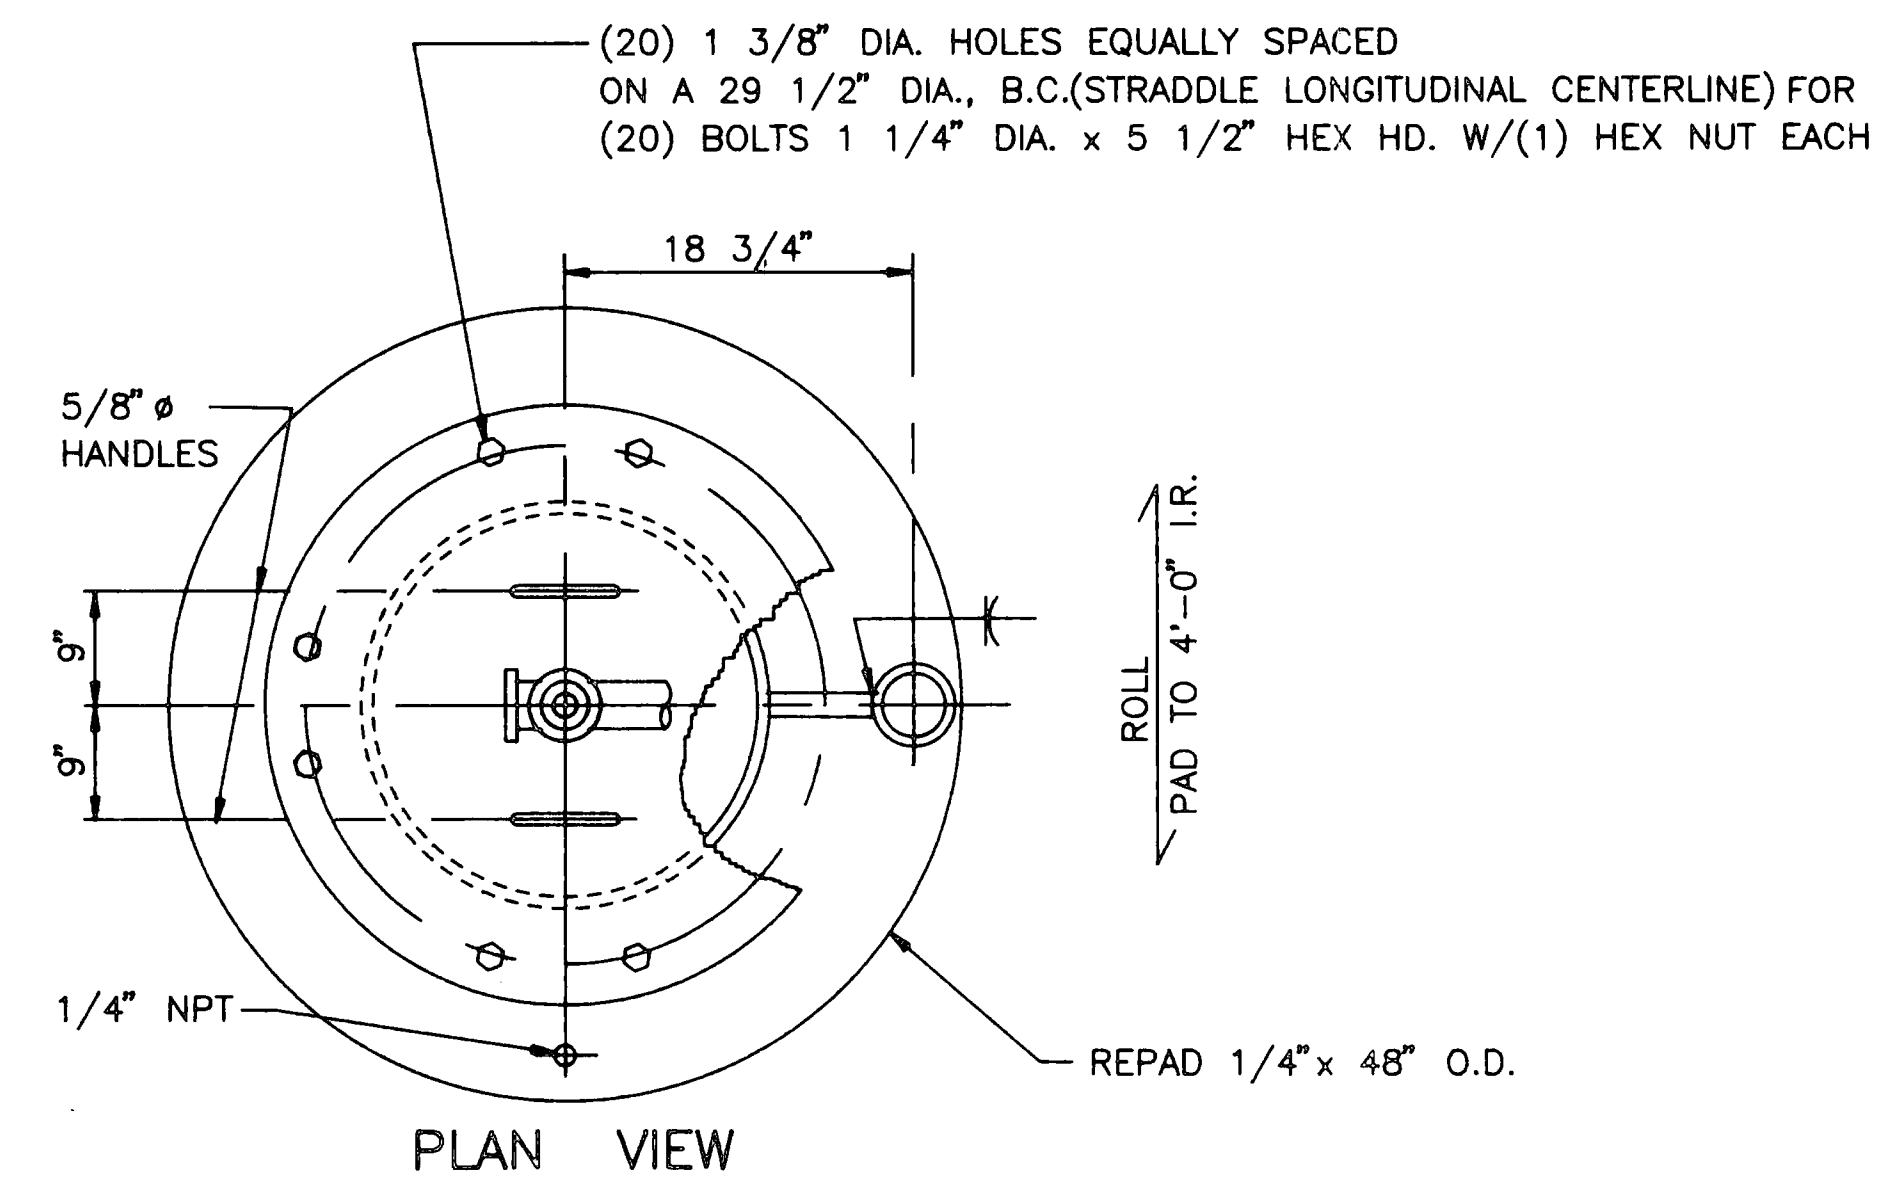



ONE REAR GASKET $\frac{1}{8}" \times 32" \text{O.D.} \times 24\frac{1}{8}" \text{I.D.}$
W/(20) $1\frac{3}{8}" \text{DIA. HOLES ON } 29\frac{1}{2}" \text{DIA., B.C.}$

NOTE: SEE DWG. D-90081-01
FOR TRUE DAVIT ORIENTATION

("AS BUILT" JUNE 22, 1932)

[illegible]

SPECIFIC PURPOSE SURVEY
SOUTHEAST COUNTY LANDFILL

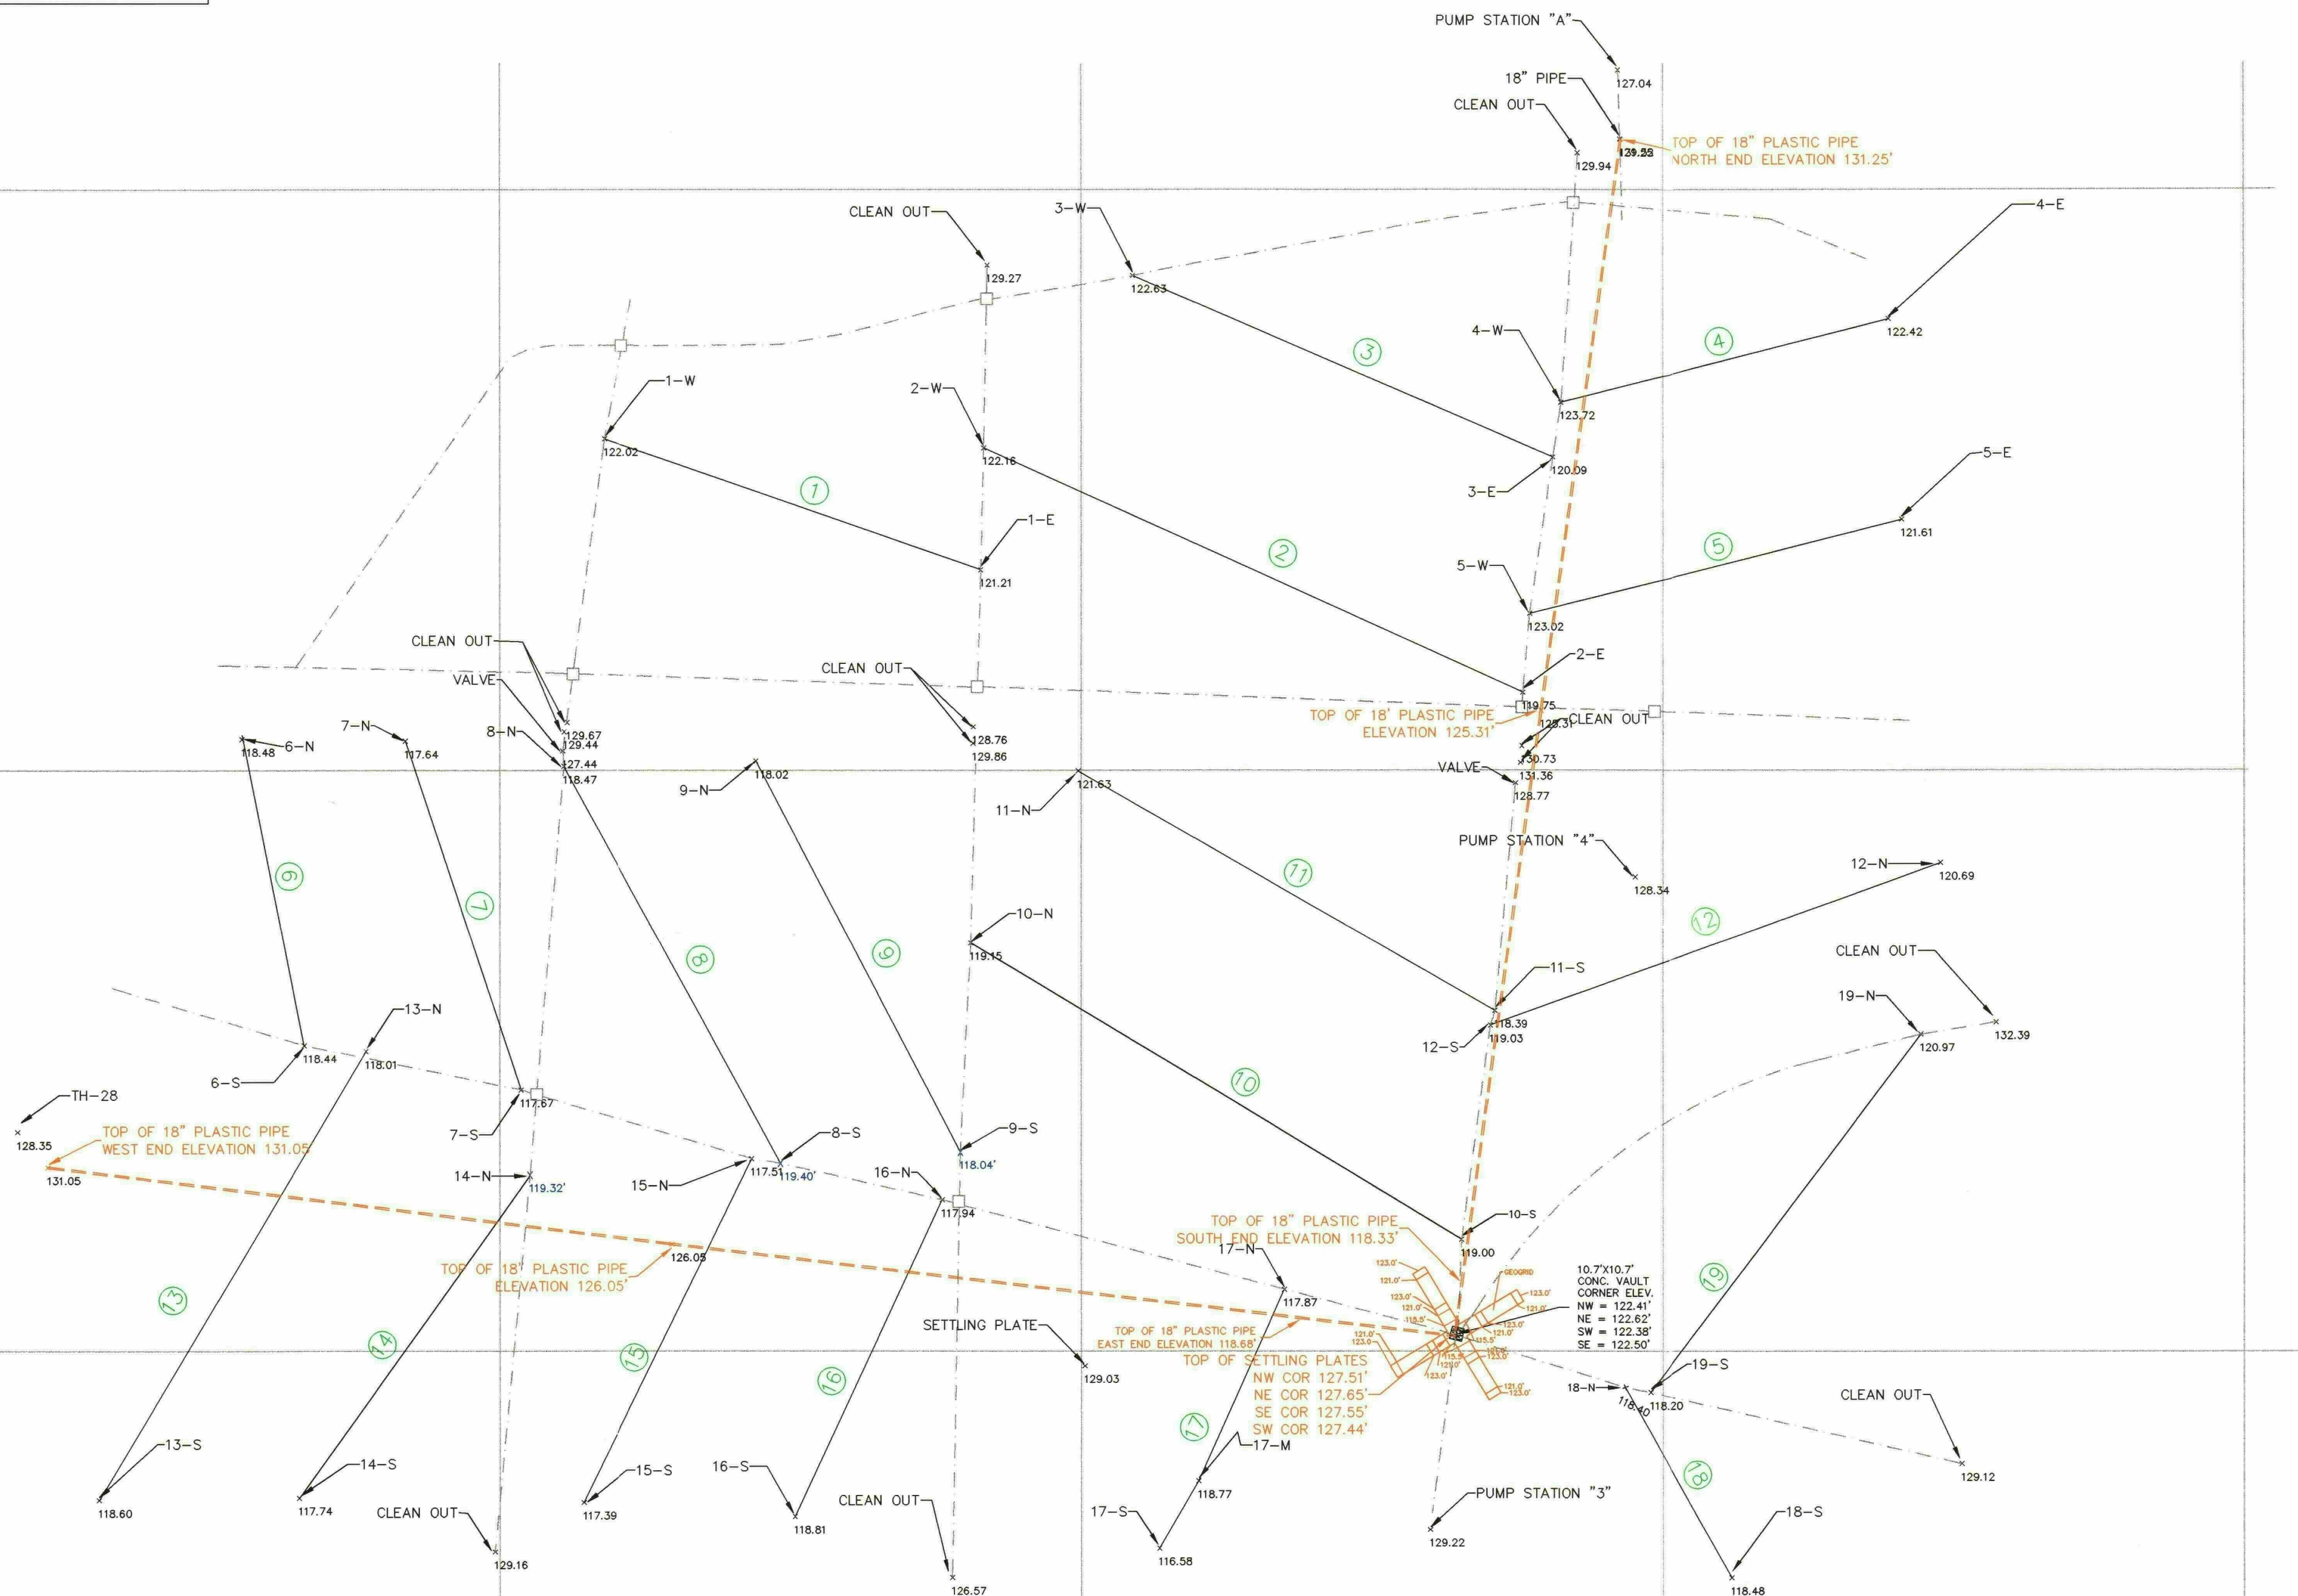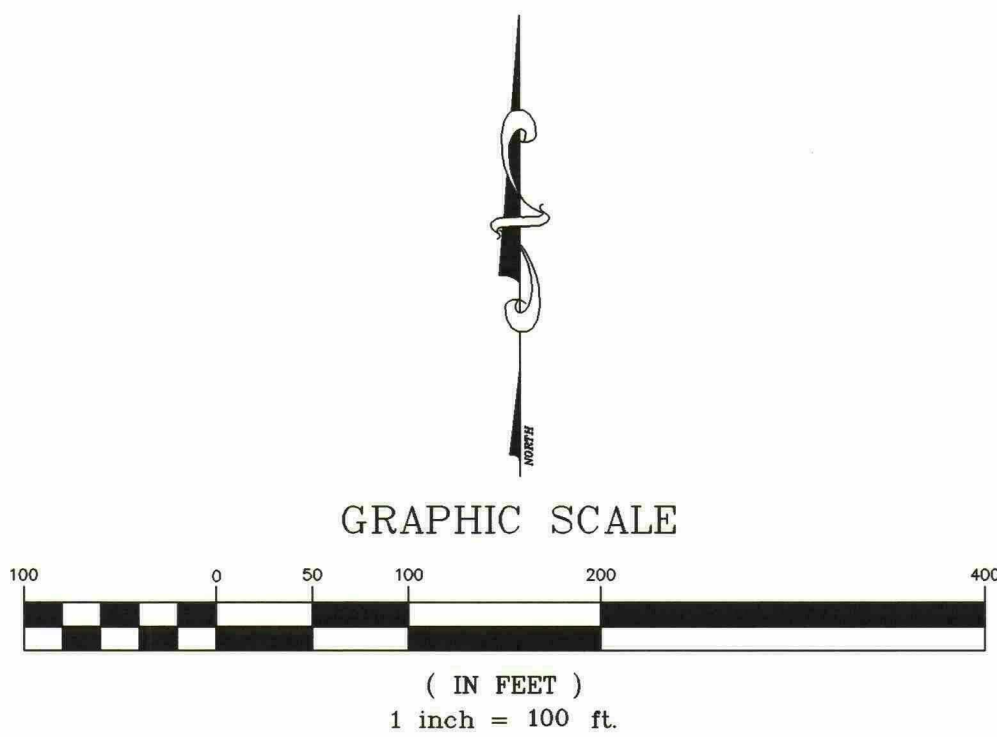

Point	Northing	Easting	Elevation	Description
28	1251188.51	595085.81	128.35	TH-28
30	1252423.26	595915.33		TH-30
100	1252021.31	596461.28	127.04	PUMP STATION "A"
101	1252031.42	596426.53	129.94	CLEAN OUT
102	1252043.24	596462.99	129.32	18\"/>
103	1251888.31	596694.92	122.42	4-E
104	1251616.12	596412.23	123.12	5-W
105	1251768.82	596405.30	120.09	3-E
106	1251634.35	596385.97	123.32	4-W
107	1251566.48	596379.49	119.75	2-E
108	1251715.30	596706.09	121.41	3-W
109	1251925.57	596044.35	122.63	
110	1251934.52	595919.34	129.27	CLEAN OUT
111	1251777.11	595916.14	122.16	2-W
112	1251672.12	595913.70	121.21	1-E
113	1251537.22	595907.35	128.76	CLEAN OUT
114	1251523.09	595907.12	129.86	CLEAN OUT
115	1251784.99	595902.12	122.32	1-W
116	1251541.13	595558.02	129.67	CLEAN OUT
117	1251513.13	595555.26	127.44	CLEAN OUT
118	1251616.35	595554.17	127.44	VALVE
119	1251503.27	595555.09	118.47	8-N
120	1251524.99	595418.87	117.64	7-N
121	1251526.79	595278.53	118.48	6-N
122	1251507.68	595202.26	118.02	9-N
123	1251499.33	595997.39	121.63	11-N
124	1251350.87	595905.03	119.15	10-N
125	1251520.66	596378.69	130.73	CLEAN OUT
126	1251506.23	596377.50	131.36	CLEAN OUT
127	1251486.84	596373.08	128.77	VALVE
128	1251407.99	596476.20	128.34	PUMP STATION "A"
129	1251420.31	596739.06	120.69	12-N
130	1251271.99	596722.13	120.97	CLEAN OUT
131	1251282.42	596786.73	132.39	CLEAN OUT
132	1251279.74	596351.64	119.03	12-S
133	1251292.32	596359.59	118.39	11-S
134	1250902.99	596757.50	129.12	CLEAN OUT
135	1250944.42	596694.40	118.40	18-N
136	1250968.59	596467.54	118.40	18-N
137	1250804.61	596559.52	118.48	18-N
138	1250846.19	596939.91	129.22	PUMP STATION "A"
139	1250830.87	596067.32	116.58	17-S
140	1250898.00	596100.77	118.77	17-S
141	1250887.19	596003.16	129.03	SETTLING PLATE
142	1250894.43	595889.09	126.57	CLEAN OUT
143	1250857.34	595753.94	118.81	16-S
144	1250869.54	595972.07	117.39	15-S
145	1250826.90	595495.78	129.16	CLEAN OUT
146	1250873.45	595327.58	117.74	14-S
147	1250871.51	595155.92	118.60	PROPOSED 18\"/>
148	1251156.71	595121.13	128.71	
149	1251262.68	595331.74	118.44	6-S
150	1251257.37	595384.97	118.01	13-N
151	1251224.12	595328.16	117.47	7-S
152	1251151.26	595525.89	121.37	15-N
153	1251165.13	595716.68	117.51	
154	1251161.22	595741.47	119.55	
155	1251170.96	595885.97	119.13	
156	1251130.05	595880.43	117.94	16-N
157	1251053.14	596174.46	117.87	17-N
158	1251035.02	596326.85	119.00	10-S
159	1251019.26	596329.37	122.62	VAULT
160	1251008.28	596326.64	122.50	VAULT
161	1251010.89	596315.97	122.38	VAULT
162	1251021.10	596318.87	122.43	VAULT
163	1251017.99	596306.93	119.88	INVERT OF 8\"/>
164	1251034.44	596338.16	119.44	TOP OF 8\"/>
165	1251007.60	596341.56	119.71	TOP OF 8\"/>
166	1250963.44	596348.01	121.00	STUD
167	1250976.86	596279.73	120.05	STUD
168	1251059.18	596283.05	120.26	STUD
169	1251031.36	596340.15	120.88	STUD
170	1251034.23	596340.12	120.92	TOP OF GRID
171	1251039.19	596311.86	120.30	TOP OF GRID
172	1250859.56	598983.42	137.56	PLS 3840/124417
173	1250556.67	598828.08	138.10	RIP-RAP
174	1250568.67	598840.60	138.77	RIP-RAP
175	1250584.62	598818.35	136.94	RIP-RAP
176	1250572.48	598822.86	133.61	CL SWALE
177	1250624.50	598742.04	132.60	CL SWALE
178	1250682.33	598666.67	132.20	CL SWALE
179	1250729.38	598886.43	131.03	CL SWALE
180	1250733.54	598900.63	130.72	CL SWALE
181	1250833.14	598424.80	129.77	CL SWALE
182	1250886.81	598339.87	129.74	CL SWALE
183	1250927.38	598263.29	129.38	CL SWALE
184	1250969.50	598185.53	128.90	CL SWALE
185	1251021.84	598118.39	128.84	CL SWALE
186	1251083.90	598037.90	128.31	CL SWALE
187	1251129.42	597950.28	128.10	CL SWALE
188	1251444.30	597536.91	127.02	RIP-RAP
189	1251495.47	597447.67	130.52	RIP-RAP
190	1251522.54	597513.53	132.22	RIP-RAP
191	1251513.09	597502.27	127.71	INVERT OF 36\"/>
192	1251510.25	597499.03	127.58	INVERT OF 36\"/>
193	1251500.39	597492.56	129.68	RIP-RAP
194	1251474.03	597330.85	128.49	RIP-RAP
195	1251570.73	597432.55	126.74	INVERT 36\"/>
196	1251567.06	597429.86	126.68	INVERT 36\"/>
197				

* ELEVATIONS FOR POINT NUMBERS 104 AND 106 REPRESENT TOP OF TIRE TRENCH.



Point	Northing	Easting	Elevation	Description
250	1251158.19	595111.76	131.05	top 18\"/>
251	1251091.88	595648.17	126.05	top 18\"/>
252	1251012.83	596321.82	118.68	top 18\"/>
253	1251018.91	596321.23	118.33	top 18\"/>
254	1251014.90	596321.33	122.31	top vault
255	1251020.30	596319.06	127.51	top settling plate
256	1251017.73	596316.45	127.44	top settling plate
257	1251008.83	596305.01	127.55	top settling plate
258	1251017.75	596328.39	127.65	top settling plate
259	1251551.05	596305.09	125.31	top 18\"/>
260	1252042.81	596463.71	131.25	top 18\"/>
261	1251228.30	597846.54	127.92	cl swale
262	1251330.22	597726.44	127.90	cl swale
263	1251433.85	597596.83	127.72	cl swale
264	1251464.50	597556.91	127.70	cl swale

SURVEYOR'S NOTES
1.) THIS IS A SPECIFIC PURPOSE SURVEY, THE PURPOSE OF WHICH IS TO DEPICT THE FIELD LOCATIONS OF THE ENDS OF PROPOSED TRENCHES, CLEAN OUTS, VALVES, PIPES. THE LOCATIONS AND ELEVATIONS OF THE CENTERLINE OF AN EXISTING SWALE AND 36\"/>

MAILED 05 1999
D.E.P.
PAUL F. AKERS
PROFESSIONAL SURVEYOR AND MAPPER #5733
NOT VALID UNLESS SIGNED AND SEALED WITH THE ORIGINAL RAISED SEAL OF A FLORIDA LICENSED SURVEYOR AND MAPPER

DRAWING TITLE	SPECIFIC PURPOSE SURVEY
PROJECT TITLE	SOUTHEAST COUNTY LANDFILL PHASES V AND VI LEACHATE COLLECTION REMOVAL SYSTEMS IMPROVEMENTS
CLIENT	PAUL F. AKERS PROFESSIONAL SURVEYOR AND MAPPER 5502 LAKE MARY LESS SHORES COURT ORLANDO, FLORIDA 32839 PH# (407) 850-9266
CADD FILE:	EAST.DWG
DATE:	OCT. 3, 1998
SCALE:	1"=100'
DRAWING NO.	1 of 1

SPECIFIC PURPOSE SURVEY
SOUTHEAST COUNTY LANDFILL

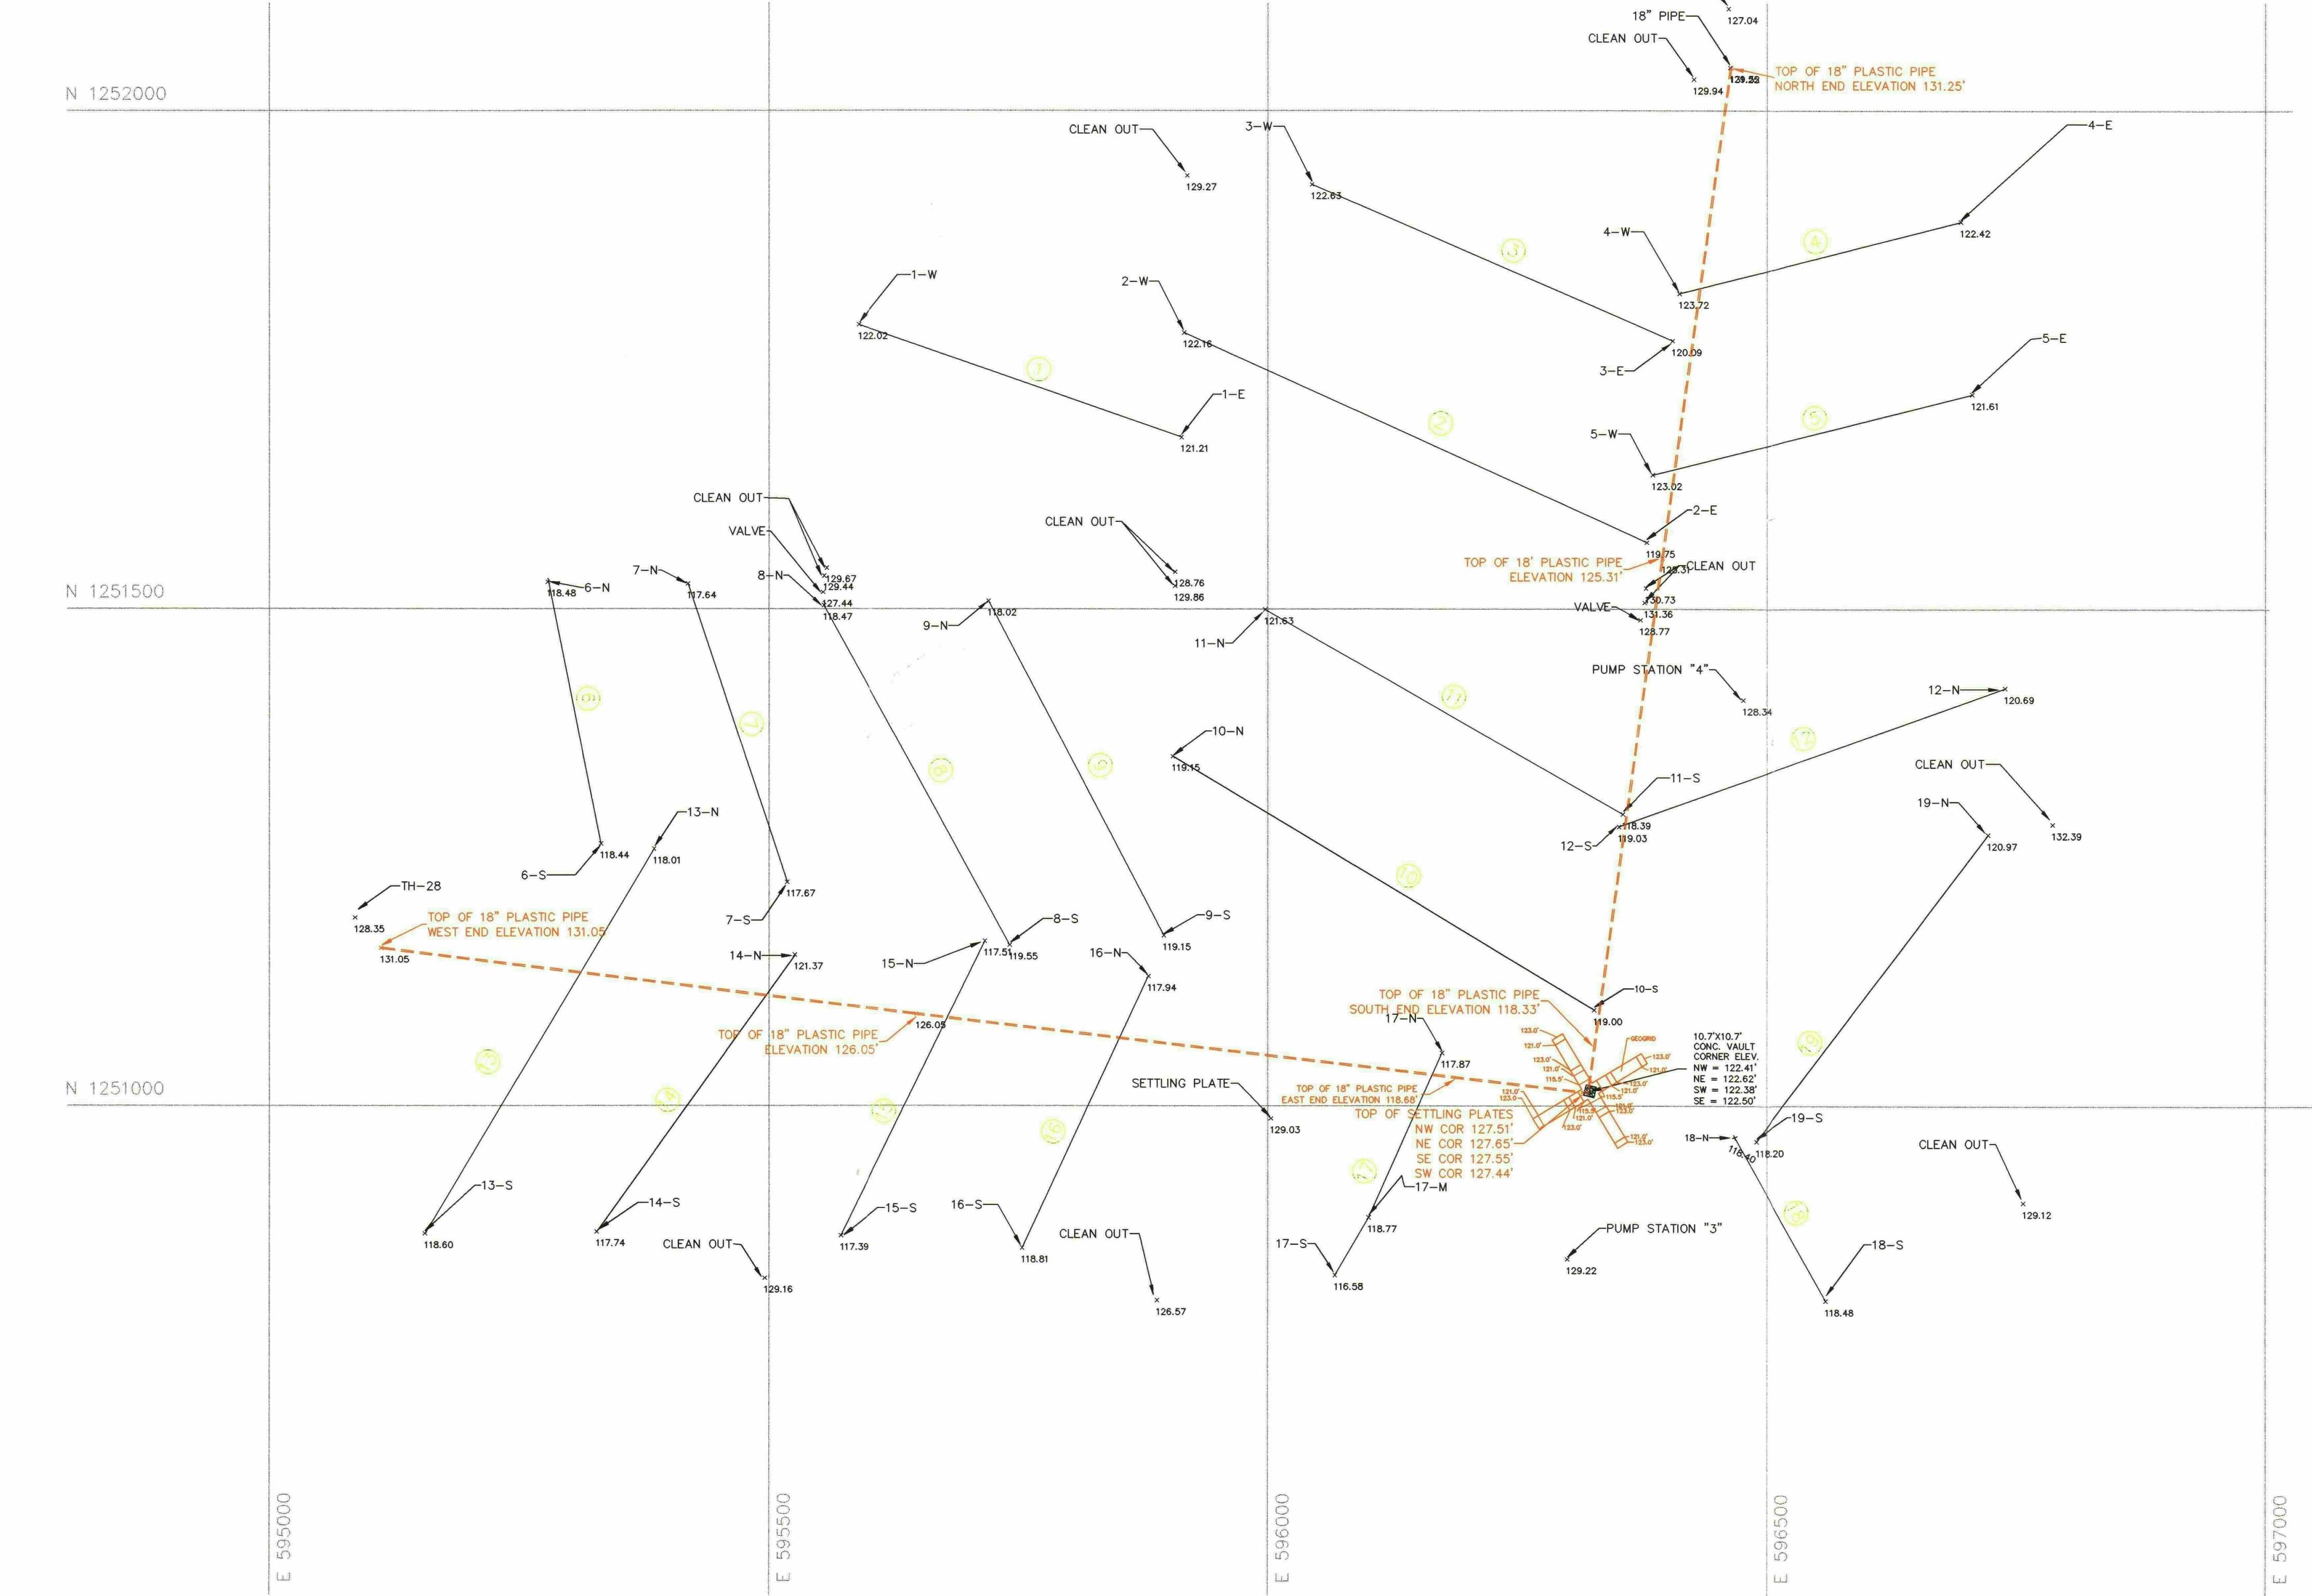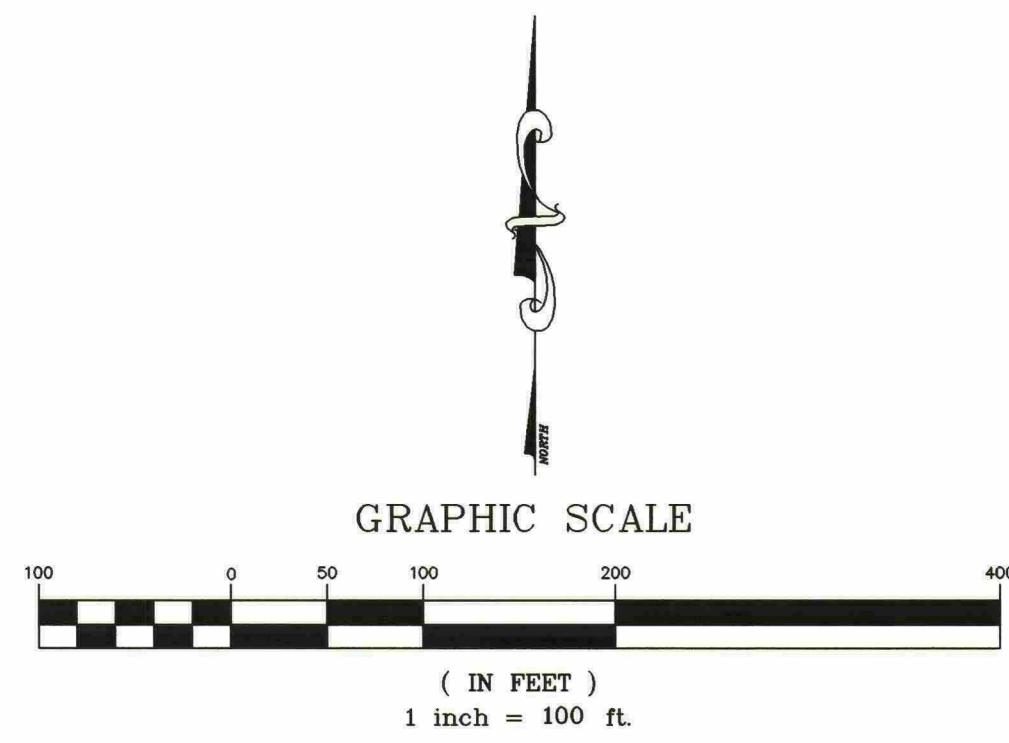

Point	Northing	Easting	Elevation	Description
28	125188.51	595085.81	128.35	TR-28
29	125242.24	595915.33	127.04	PUMP STATION "A"
100	125203.31	596461.28	129.94	CLEAN OUT
101	125203.42	596426.53	129.94	18\"/>
102	125242.24	596461.28	129.94	18\"/>
103	125188.51	596694.92	122.42	4-E
104	125188.51	596412.25	123.72	4-W
105	1251766.82	596405.30	120.09	3-E
106	125188.51	596395.37	123.02	3-W
107	1251566.48	596379.49	119.75	2-E
108	1251715.30	596706.09	121.61	2-W
109	1251525.57	596044.35	122.63	1-E
110	1251934.52	595919.34	129.27	CLEAN OUT
111	1251777.11	595916.14	122.16	2-W
112	1251672.12	595913.70	121.21	2-E
113	1251537.22	595907.35	128.76	CLEAN OUT
114	1251523.09	595907.12	129.86	CLEAN OUT
115	1251784.99	595590.12	122.02	1-W
116	1251541.13	595558.02	129.67	CLEAN OUT
117	1251533.13	595555.28	129.44	CLEAN OUT
118	1251516.55	595554.17	127.44	VALVE
119	1251503.27	595555.09	118.47	8-N
120	1251524.89	595418.87	117.64	8-W
121	1251526.79	595278.53	118.48	6-N
122	1251507.69	595720.26	118.02	6-W
123	1251499.33	595997.39	121.63	11-N
124	1251500.87	595905.01	119.15	10-N
125	1251520.66	596378.69	130.73	CLEAN OUT
126	1251506.23	596377.50	131.36	CLEAN OUT
127	1251488.84	596373.08	128.77	VALVE
128	1251407.99	596476.20	128.34	PUMP STATION "A"
129	1251420.31	596739.06	120.69	12-E
130	1251271.99	596722.13	120.97	15-N
131	1251282.42	596786.73	132.39	CLEAN OUT
132	1251279.74	596351.64	119.03	12-S
133	1251292.57	596355.49	118.39	13-E
134	1250902.59	596757.50	129.12	CLEAN OUT
135	1250968.59	596467.54	118.40	18-N
136	1250804.61	596559.52	118.48	18-S
137	1250846.13	596559.52	129.22	PUMP STATION "A"
138	1250880.07	596676.32	116.58	17-S
139	1250880.07	596676.32	116.58	17-E
140	1250880.07	596676.32	116.58	17-W
141	1250880.07	596676.32	116.58	17-N
142	1250880.07	596676.32	116.58	17-E
143	1250880.07	596676.32	116.58	17-S
144	1250880.07	596676.32	116.58	17-W
145	1250880.07	596676.32	116.58	17-N
146	1250880.07	596676.32	116.58	17-E
147	1250880.07	596676.32	116.58	17-S
148	1251156.71	595121.13	128.71	PROPOSED 18\"/>
149	1251262.68	595331.74	118.49	6-E
150	1251257.37	595384.97	118.01	13-N
151	1251254.16	595384.97	117.67	13-W
152	1251151.26	595525.89	121.37	14-N
153	1251151.26	595525.89	121.37	14-W
154	1251161.22	595741.47	119.55	8-S
155	1251170.96	595890.97	119.13	9-S
156	1251130.03	595880.43	117.94	16-N
157	1251053.14	596174.46	117.87	17-N
158	1251036.85	596326.85	119.00	10-S
159	1251019.26	596329.37	122.62	VAULT
160	1251008.28	596326.84	122.50	VAULT
161	1251010.89	596315.97	122.38	VAULT
162	1251010.89	596315.97	122.38	VAULT
163	1251017.99	596306.93	119.88	INVERT OF 8\"/>
164	1251034.44	596306.93	119.88	INVERT OF 8\"/>
165	1251007.60	596341.56	119.71	TOP OF 8\"/>
166	1250965.44	596348.01	121.00	STUD
167	1250976.86	596279.73	120.05	STUD
168	1250959.18	596283.05	120.26	STUD
169	1250951.36	596361.15	120.88	STUD
170	1251034.23	596340.12	120.92	TOP OF GRID
171	1251039.19	596311.86	120.30	TOP OF GRID
172	1250859.56	598983.42	137.96	PLS 3840/128417
173	1250859.56	598983.42	137.96	RIP-RAP
174	1250859.56	598983.42	137.96	RIP-RAP
Point	Northing	Easting	Elevation	Description
250	1251158.19	595111.76	131.05	top 18\"/>
251	1251091.88	595448.17	128.05	top 18\"/>
252	1251012.83	596321.62	118.88	top 18\"/>
253	1251016.91	596321.62	118.33	top 18\"/>
254	1251014.90	596321.62	122.31	top vault
255	1251000.39	596318.06	127.51	top settling plate
256	1251011.73	596316.45	127.44	top settling plate
257	1251008.53	596326.01	127.55	top settling plate
258	1251017.75	596328.39	127.65	top settling plate
259	1251000.05	596305.09	126.31	top 18\"/>
260	1250242.81	596463.71	131.25	top 18\"/>
261	1251229.32	597846.54	127.92	cl swale
262	1251330.22	597728.44	127.90	cl swale
263	1251443.86	597596.63	127.72	cl swale
264	1251464.50	597556.91	127.70	cl swale

SURVEYOR'S NOTES
1.) THIS IS A SPECIFIC PURPOSE SURVEY, THE PURPOSE OF WHICH IS TO DEPICT THE FIELD LOCATIONS OF THE ENDS OF PROPOSED TRENCHES, CLEAN OUTS, VALVES, PIPES. THE LOCATIONS AND ELEVATIONS OF THE CENTERLINE OF AN EXISTING SWALE AND 36\"/>

D.E.R.

DEC 31 1998

SOUTHWEST DISTRICT
TAMPA

PAUL F. AKERS
PROFESSIONAL SURVEYOR AND MAPPER
5502 LAKE MARY LESS SHORES COURT
ORLANDO, FLORIDA 32839 PH# (407) 850-9266



CADD FILE:
EAST.DWG

DATE:
OCT. 3, 1998

SCALE:
1"=100'

DRAWING NO.

SPECIFIC PURPOSE SURVEY
SOUTHEAST COUNTY LANDFILL

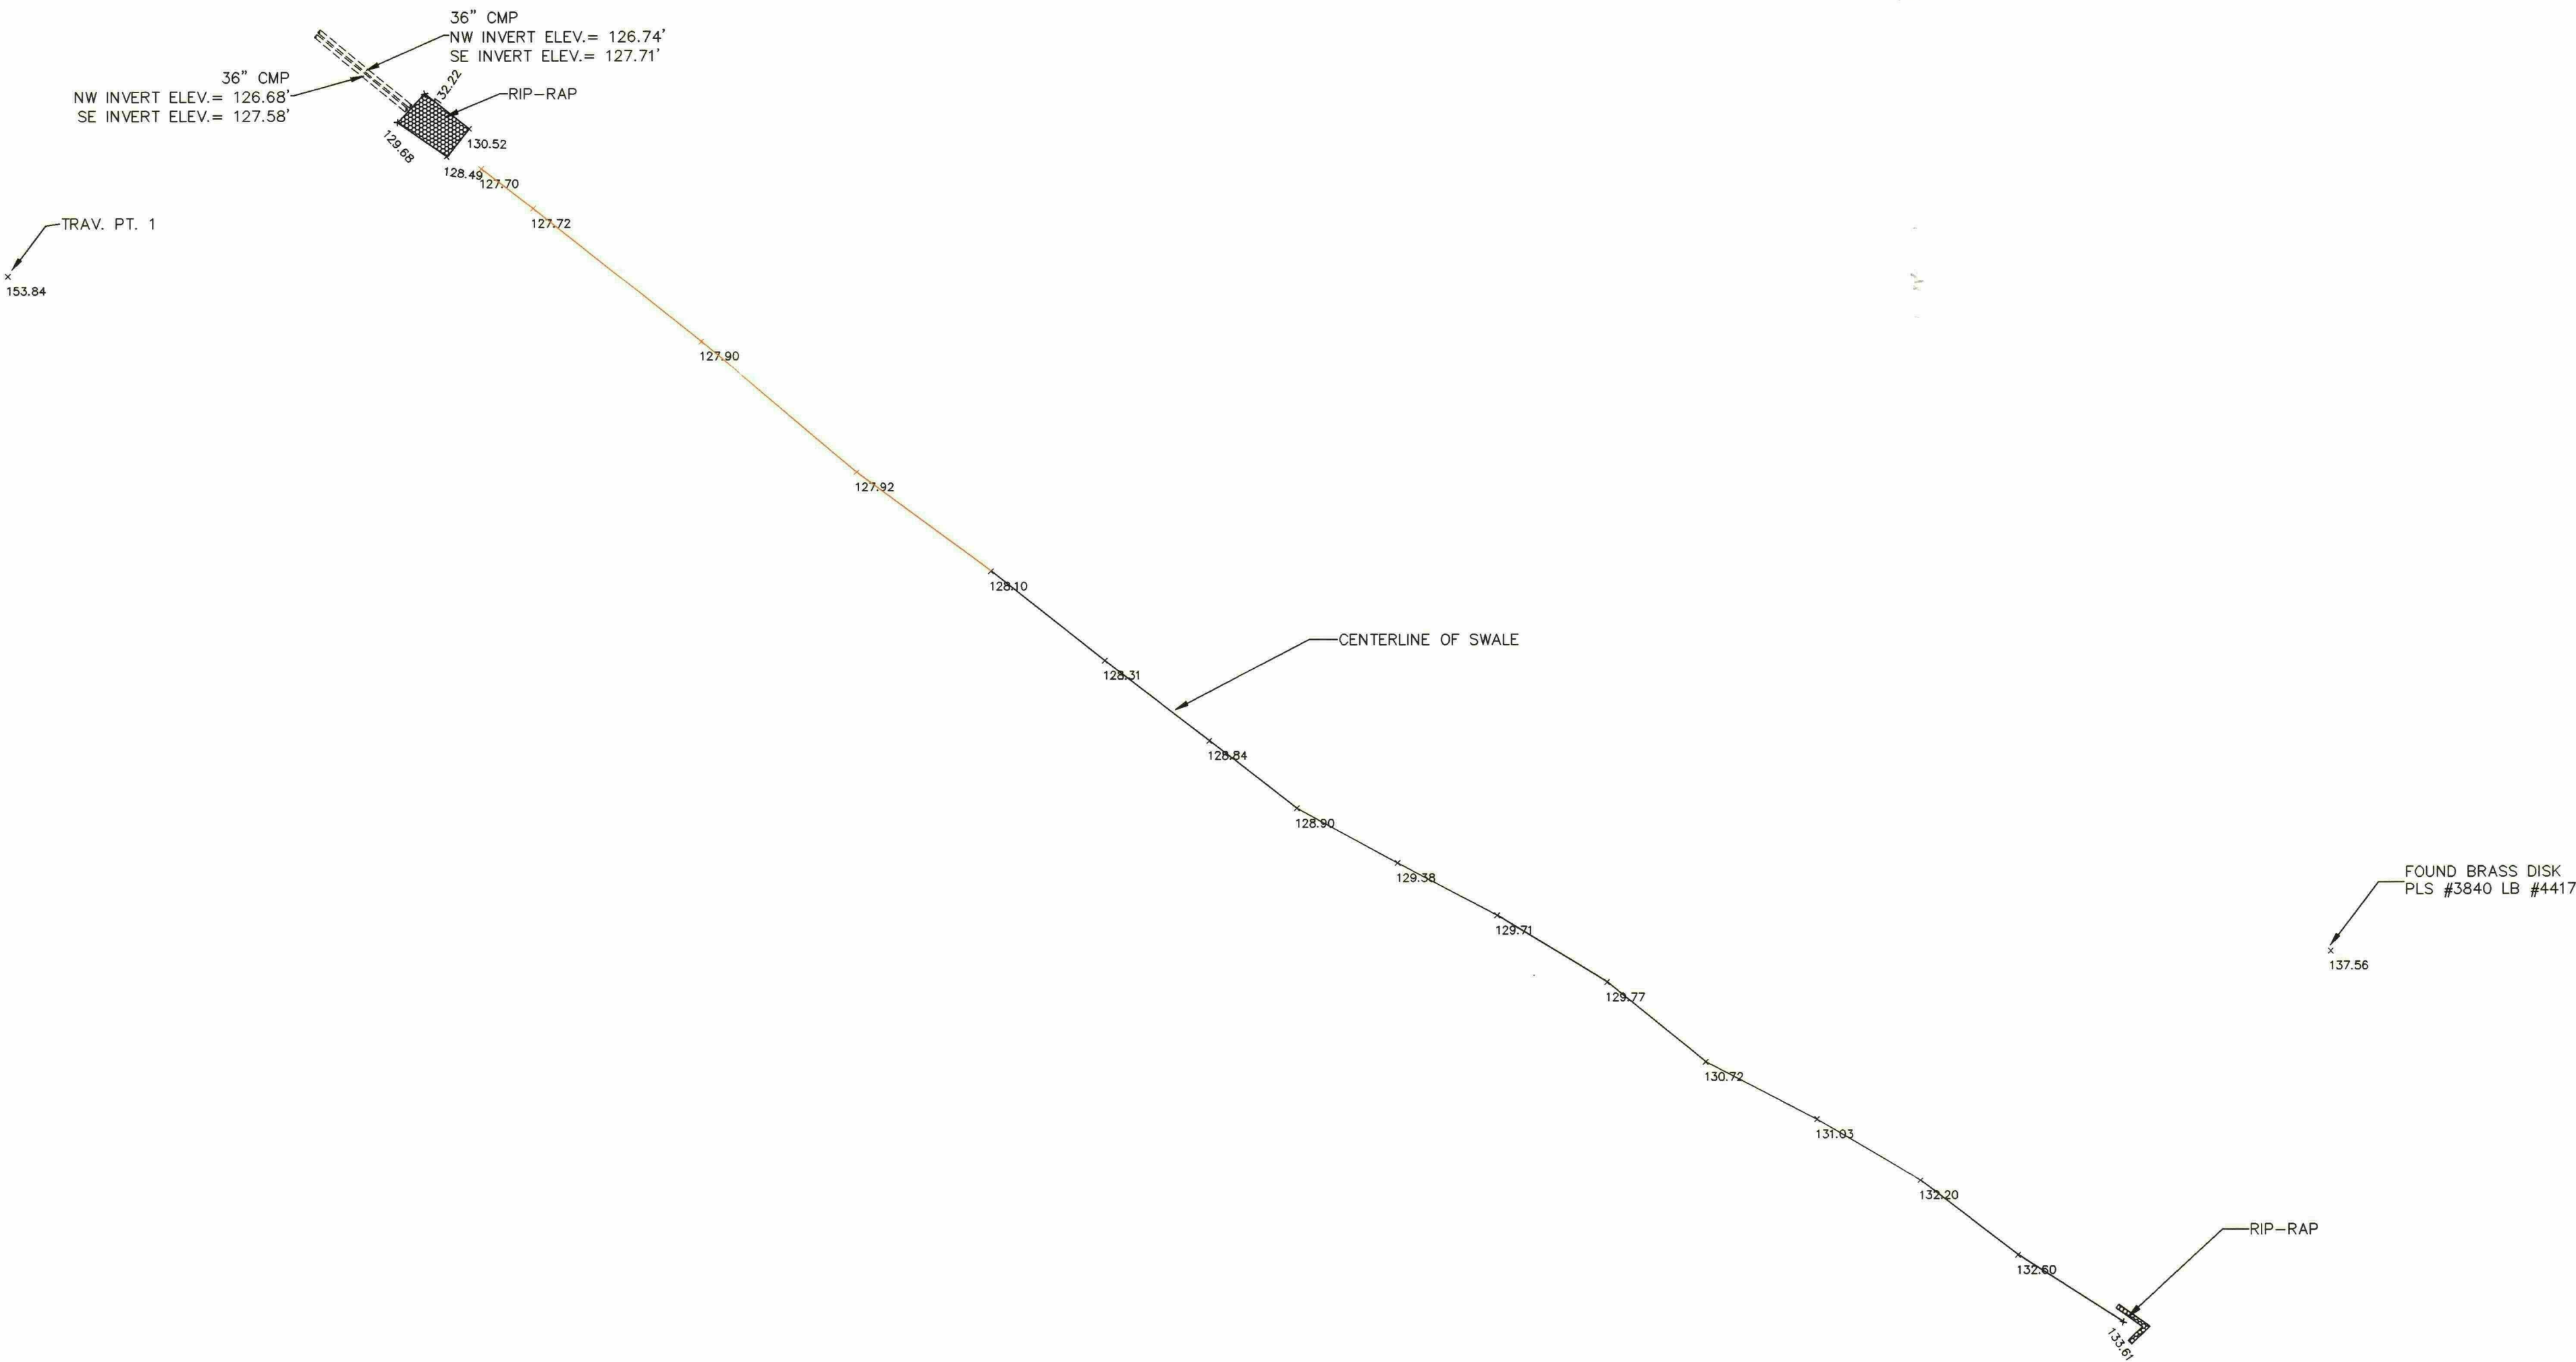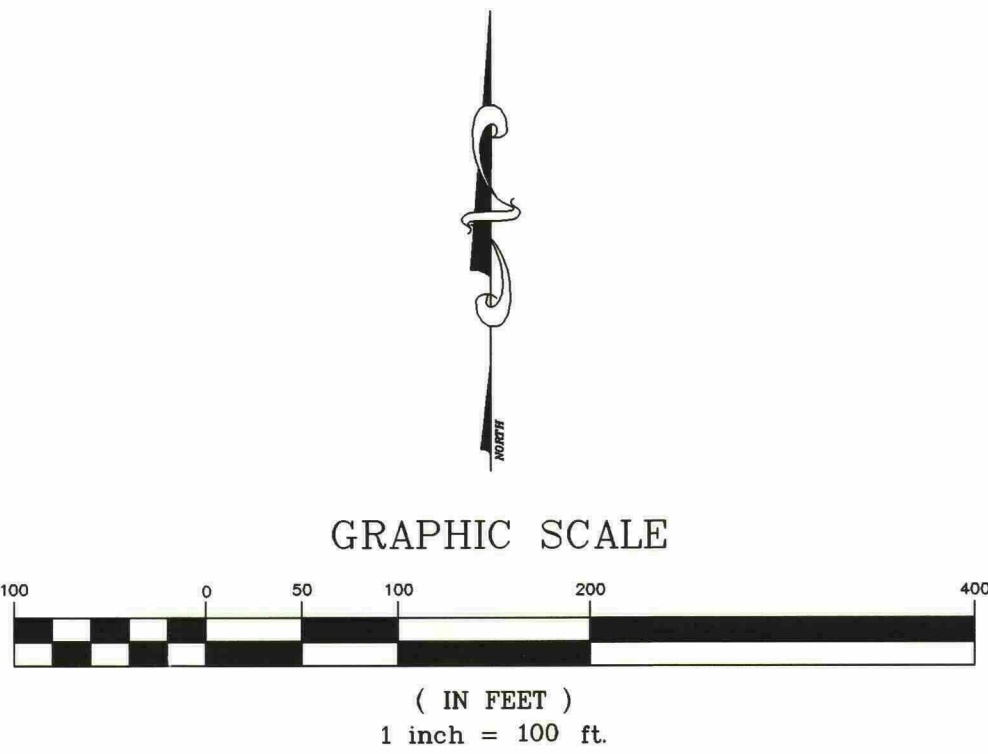

D.E.R.
DEC 3 1 1998
SOUTHWEST DISTRICT
TAMPA

DRAWING TITLE		SPECIFIC PURPOSE SURVEY		REV.	DATE	DESCRIPTION	CK.	BY
PROJECT TITLE		SOUTHEAST COUNTY LANDFILL PHASES V AND VI LEACHATE COLLECTION REMOVAL SYSTEMS IMPROVEMENTS						
CLIENT		ERC CONTRACTORS						
PAUL F. AKERS PROFESSIONAL SURVEYOR AND MAPPER 5502 LAKE MARY LESS SHORES COURT ORLANDO, FLORIDA 32835 PH# (407) 850-9266		PROJ. NO.	506-15	DWN. BY:	PFA	Q/A R/W BY:		
		TSN. BY:		CHK. BY:	PFA	APP. BY:		
CADD FILE:		EAST.DWG						
DATE:		OCT. 3, 1998						
SCALE:		1"=100'						
DRAWING NO.								
2		of		2				