

1565454

①

SOUTHEAST COUNTY LANDFILL

SECTION 8

CAPACITY EXPANSION

CONSTRUCTION DRAWINGS

FEBRUARY 28, 2006

HILLSBOROUGH COUNTY

SOLID WASTE MANAGEMENT DEPARTMENT

TAMPA, FLORIDA

SECTION AND DETAIL DESIGNATION

DESIGNATION LETTER
INDICATES SECTION,
NUMBER INDICATES
DETAIL OR ELEVATION

INDICATES DIRECTION
OF CUTTING PLANE

SHEET NUMBER WHERE
SECTION IS TAKEN


SHEET NUMBER WHERE
SECTION IS SHOWN

LEGEND

- SHEET FLOW DRAINAGE DIRECTION
- CONCENTRATED DRAINAGE FLOW DIRECTION
- FILL PROGRESSION
- DAILY PROGRESSION
- ZONE/PHASE BOUNDARY
- CENTERLINE OF SWALE
- CENTERLINE OF TEMPORARY SWALE
- EXISTING CONTOUR
- PROPOSED CONTOUR
- PROJECTED EXISTING CONTOUR
- REINFORCED CONCRETE PIPE
- DOWNCHUTE
- LIMITS OF EXCAVATION OF ORGANIC MATERIAL
- PROPERTY LINE
- FENCELINE
- LANDFILL GAS MONITORING WELL
- EXISTING POWER POLE
- EXISTING GROUNDWATER MONITORING WELL
- PROPOSED GROUNDWATER MONITORING WELL
- SOIL BORING
- VEGETATION


ABBREVIATIONS

- | | |
|---------|--------------------------------------|
| APPROX. | APPROXIMATE |
| CTRD | CENTERED |
| ERCP | ELLIPTICAL REINFORCED CONCRETE PIPE |
| ELEV. | ELEVATION |
| I.E. | INVERT ELEVATION |
| LF | LINEAR FEET |
| EXIST. | EXISTING |
| SCH. | SCHEDULE |
| TYP. | TYPICAL |
| Ø | DIAMETER |
| CONC. | CONCRETE |
| W/ | WITH |
| CMP | CORRUGATED METAL PIPE |
| MIN. | MINIMUM |
| MAX. | MAXIMUM |
| HDPE | HIGH DENSITY POLYETHYLENE |
| FDOT | FLORIDA DEPARTMENT OF TRANSPORTATION |
| NO. | NUMBER |

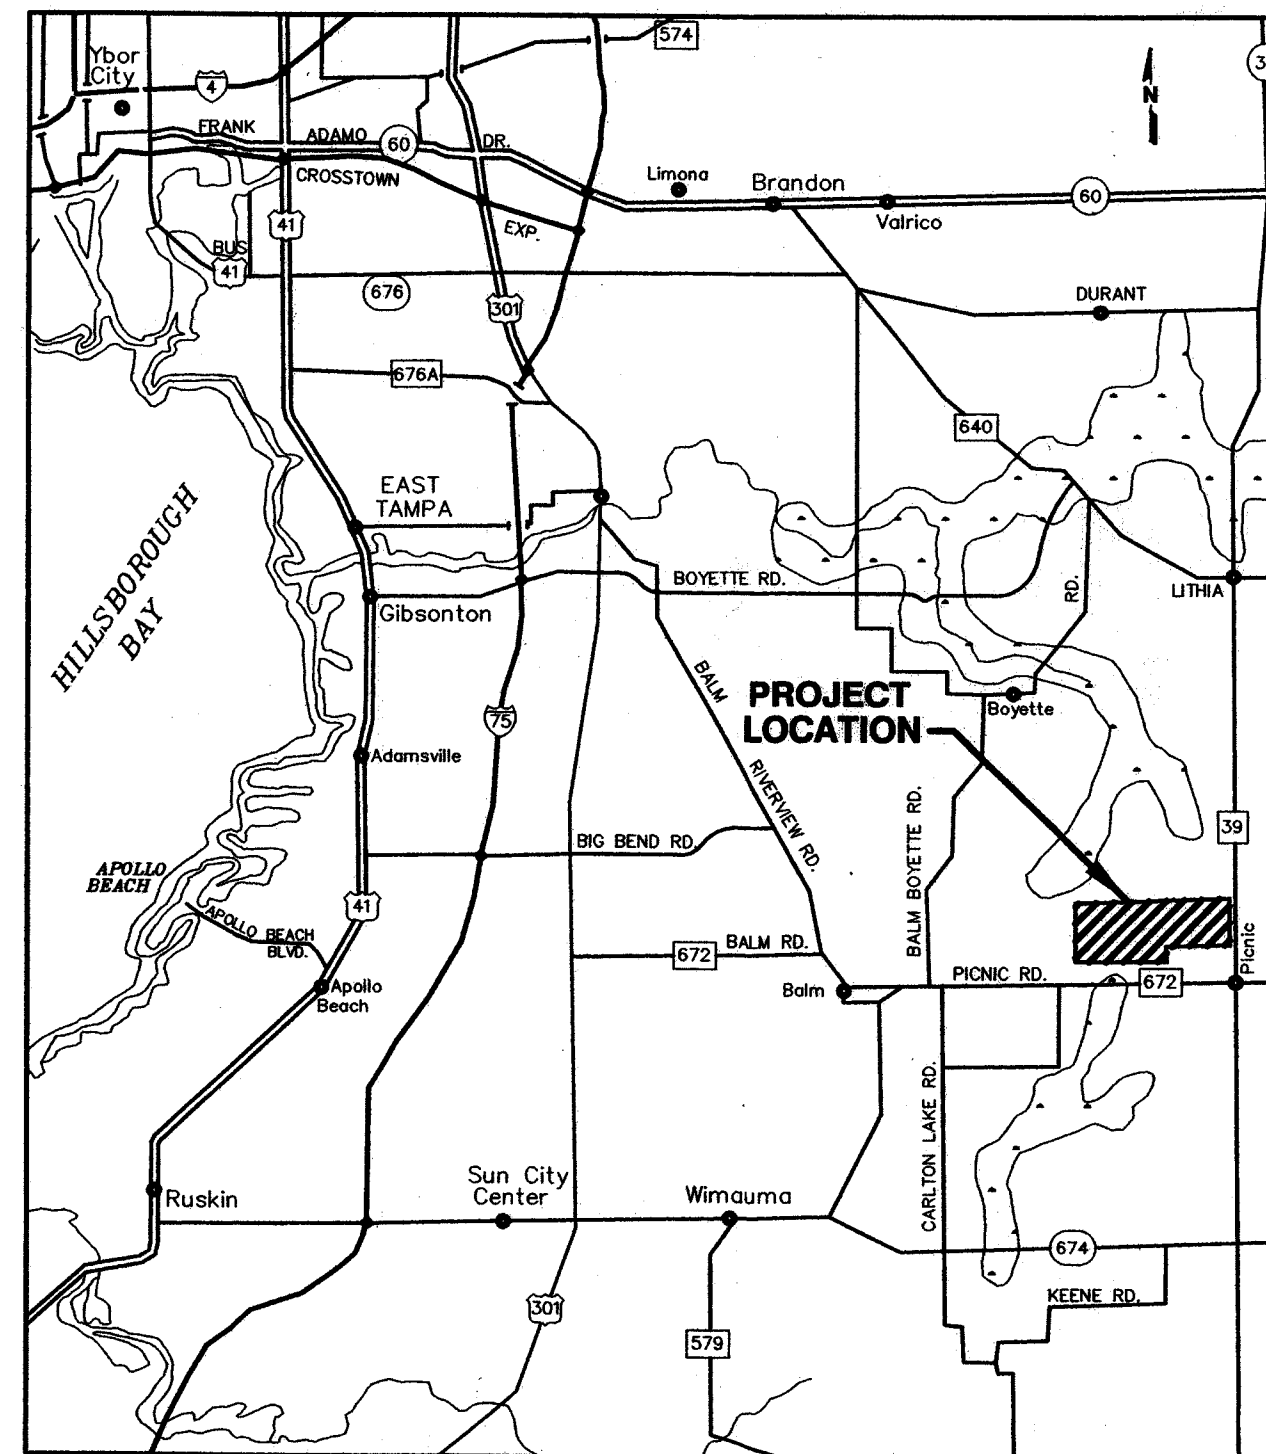

LOCATION MAP

JONES EDMUNDS
730 NE WALDO ROAD, GAINESVILLE, FLORIDA 32641 / (352) 377-5821
324 S HYDE PARK AVE, TAMPA, FLORIDA 33606 / (813) 258-0703

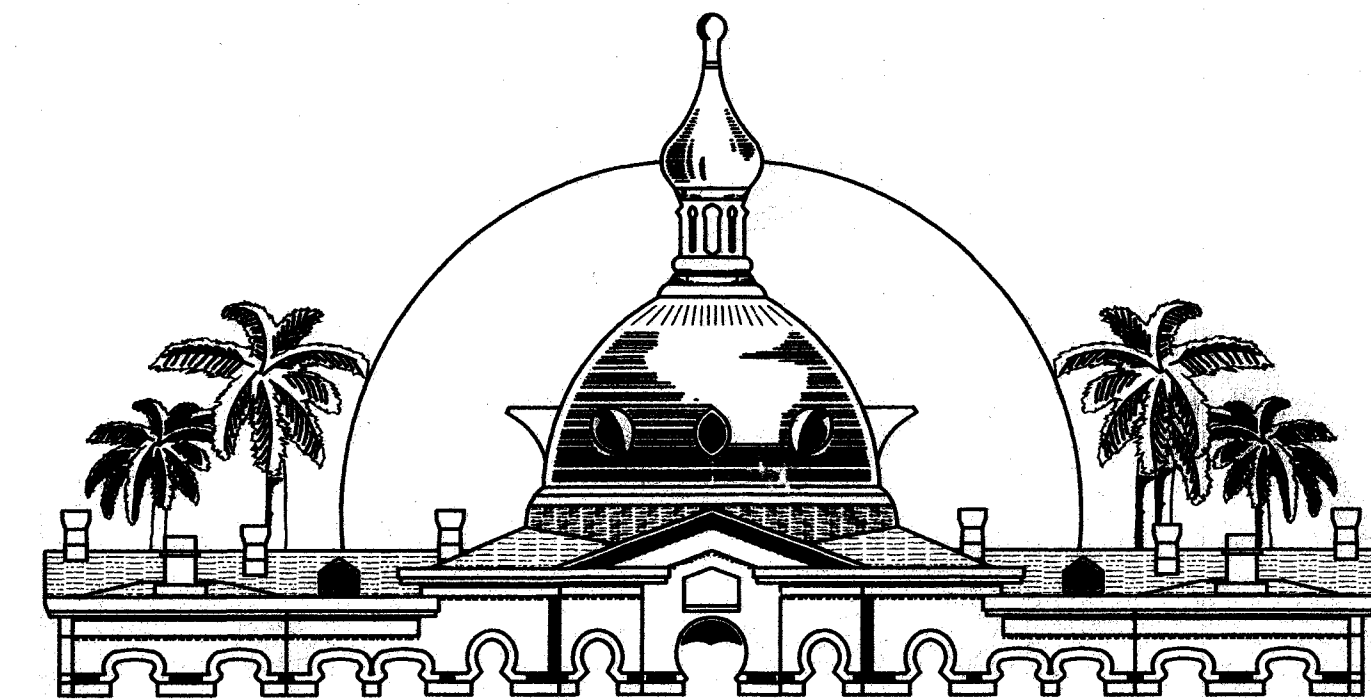


BOARD OF COUNTY COMMISSIONERS

KATHY CASTOR, Commissioner
KEN HAGAN, Commissioner
THOMAS SCOTT, Commissioner
RONDA STORMS, Commissioner
JIM NORMAN, Commissioner
PAT FRANK, Commissioner
JAN PLATT, Commissioner

DRAWING NO.	DRAWING TITLE
1	COVER SHEET
2	FACILITY SITE PLAN AND EXISTING TOPOGRAPHY
3	EXCAVATION PLAN
4	BACKFILL PLAN
5	LCRS GRADING PLAN (TOP OF CLAY SUBBASE)
6	TOP OF PROTECTIVE LAYER GRADING PLAN
7	SECTIONS AND SOIL BORING PROFILES
8	DETAILS - 1
9	DETAILS - 2

RECORD DRAWINGS

JONES EDMUNDS HAS PREPARED THESE RECORD DRAWINGS BASED UPON INFORMATION SUPPLIED BY THE CONTRACTOR DURING THE CONSTRUCTION OF THE PROJECT. THE ORIGINAL DESIGN DRAWINGS WERE PREPARED BY SCS ENGINEERS. JONES EDMUNDS REVIEW OF THE RECORD DRAWINGS INDICATES THAT THE CONSTRUCTION WAS COMPLETED AS PER THE ORIGINAL DESIGN.

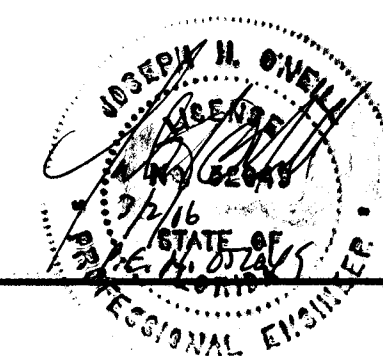



MAR - 9 2006
SOUTHERN REGIONAL ENGINEER

FILE

Plotted: 2/28/06 11:06am rdemint

\\Tpa-srv\Drafting\08449 Hillsborough County\020-SELF Section 8\Certification Drawings\0844902001-C-02-site1.DWG

Edited: 00/00/00 0:00 login

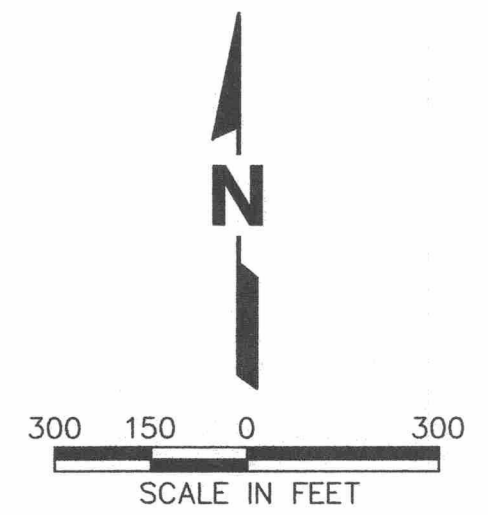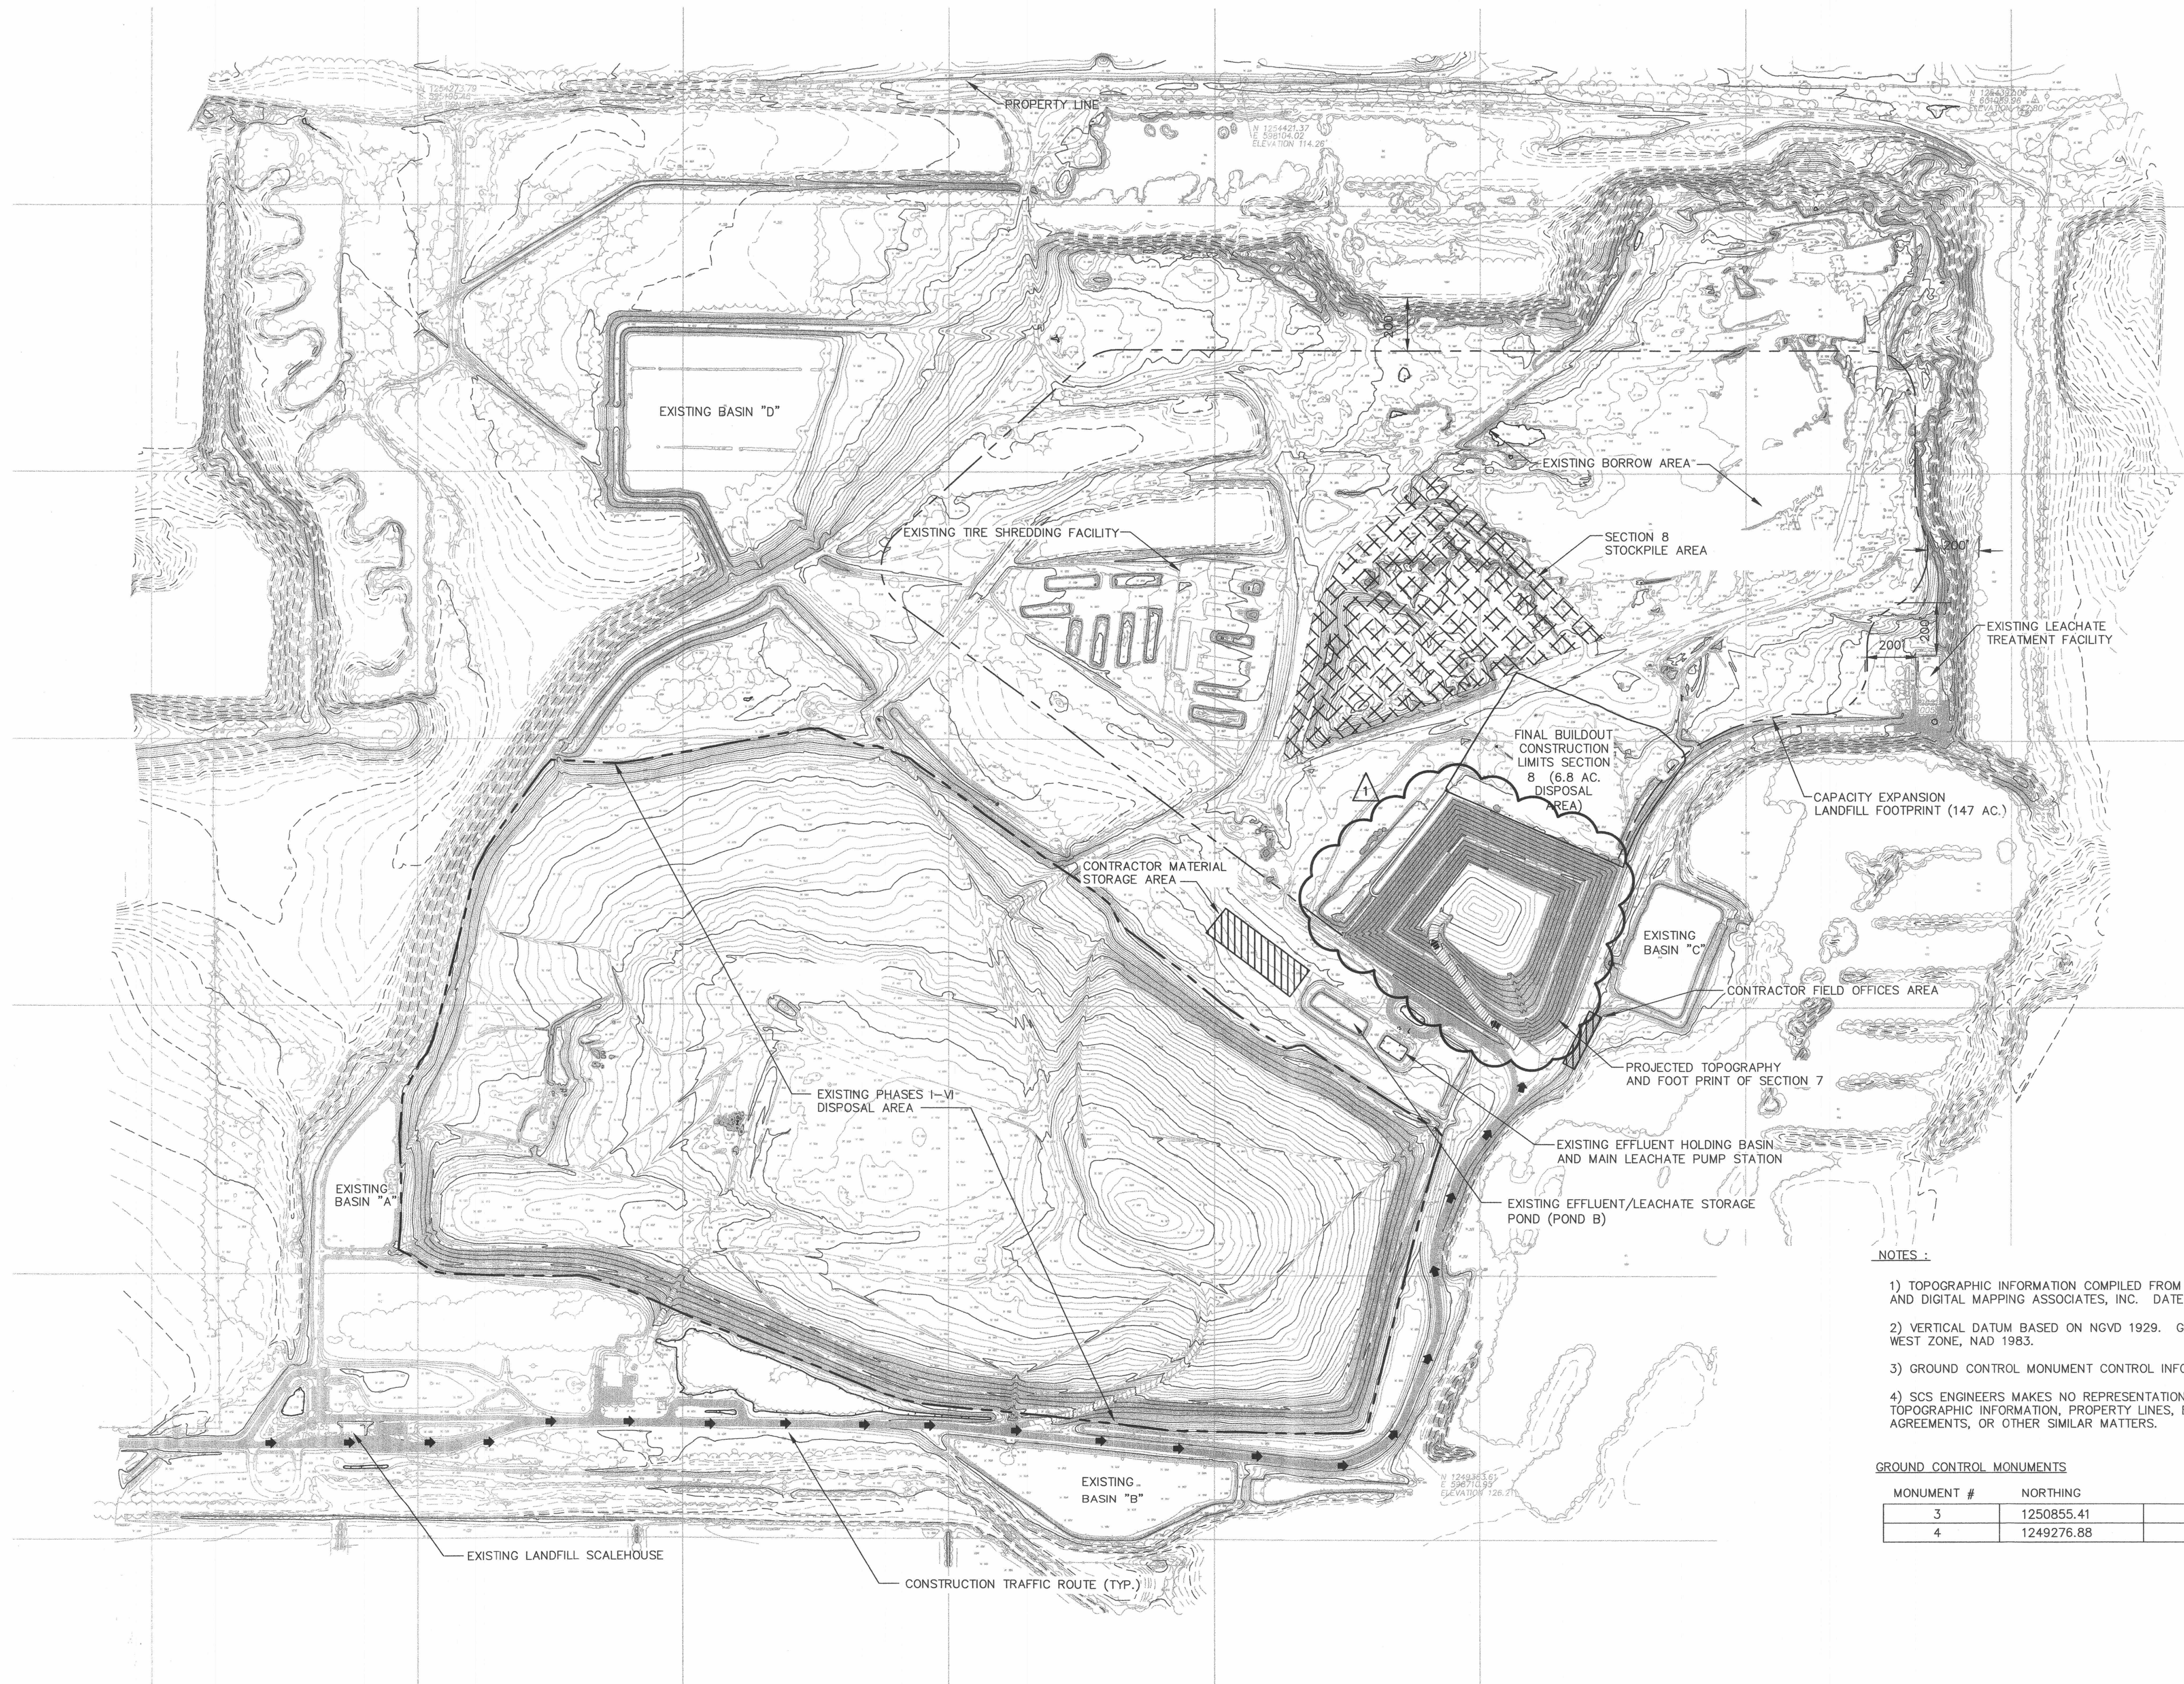

NOTES :

- 1) TOPOGRAPHIC INFORMATION COMPILED FROM AERIAL PHOTOGRAPHY BY LANDAIR AERIAL SURVEYING AND DIGITAL MAPPING ASSOCIATES, INC. DATE OF AERIAL PHOTOGRAPHY JULY 7, 2002.
- 2) VERTICAL DATUM BASED ON NGVD 1929. GRID BASED ON FLORIDA STATE PLANE COORDINATE SYSTEM, WEST ZONE, NAD 1983.
- 3) GROUND CONTROL MONUMENT CONTROL INFORMATION PROVIDED BY RED MAN CONSULTANTS INC.
- 4) SCS ENGINEERS MAKES NO REPRESENTATION OR GUARANTEES PERTAINING TO THE ACCURACY OF TOPOGRAPHIC INFORMATION, PROPERTY LINES, EASEMENTS, RIGHT-OF-WAYS, SETBACKS, RESERVATIONS, AGREEMENTS, OR OTHER SIMILAR MATTERS.

GROUND CONTROL MONUMENTS

MONUMENT #	NORTHING	EASTING	ELEV.
3	1250855.41	598998.83	137.56
4	1249276.88	598535.88	129.88



RECORD DRAWINGS

LTR.	DATE	REVISIONS	BY	APPROD.
1	2/28/06	RECORD DRAWING ADDITIONS / REVISIONS	JHV	JHO

DESIGNED	SCS ENGINEERS
DRAWN	GRD
CHECKED	JHO/JPA


JONES EDMUNDS
730 NE WALDO ROAD, GAINESVILLE, FLORIDA 32641 / (352) 377-5821
324 S HYDE PARK AVE, TAMPA, FLORIDA 33606 / (813) 258-0703

HILLSBOROUGH COUNTY
SOLID WASTE MANAGEMENT DEPARTMENT
SOUTHEAST COUNTY LANDFILL

SECTION 8 CAPACITY EXPANSION
FACILITY SITE PLAN & EXISTING TOPOGRAPHY
CONSTRUCTION DRAWINGS

CERTIFICATE OF AUTHORIZATION #1814
APPROVED BY [Signature]
JOSEPH H. O'NEILL P.E.
P.E. # 052049, FLORIDA

DATE	2/28/06	PROJECT NO.	08449-020-01
SCALE	AS SHOWN	DWG. NO.	2

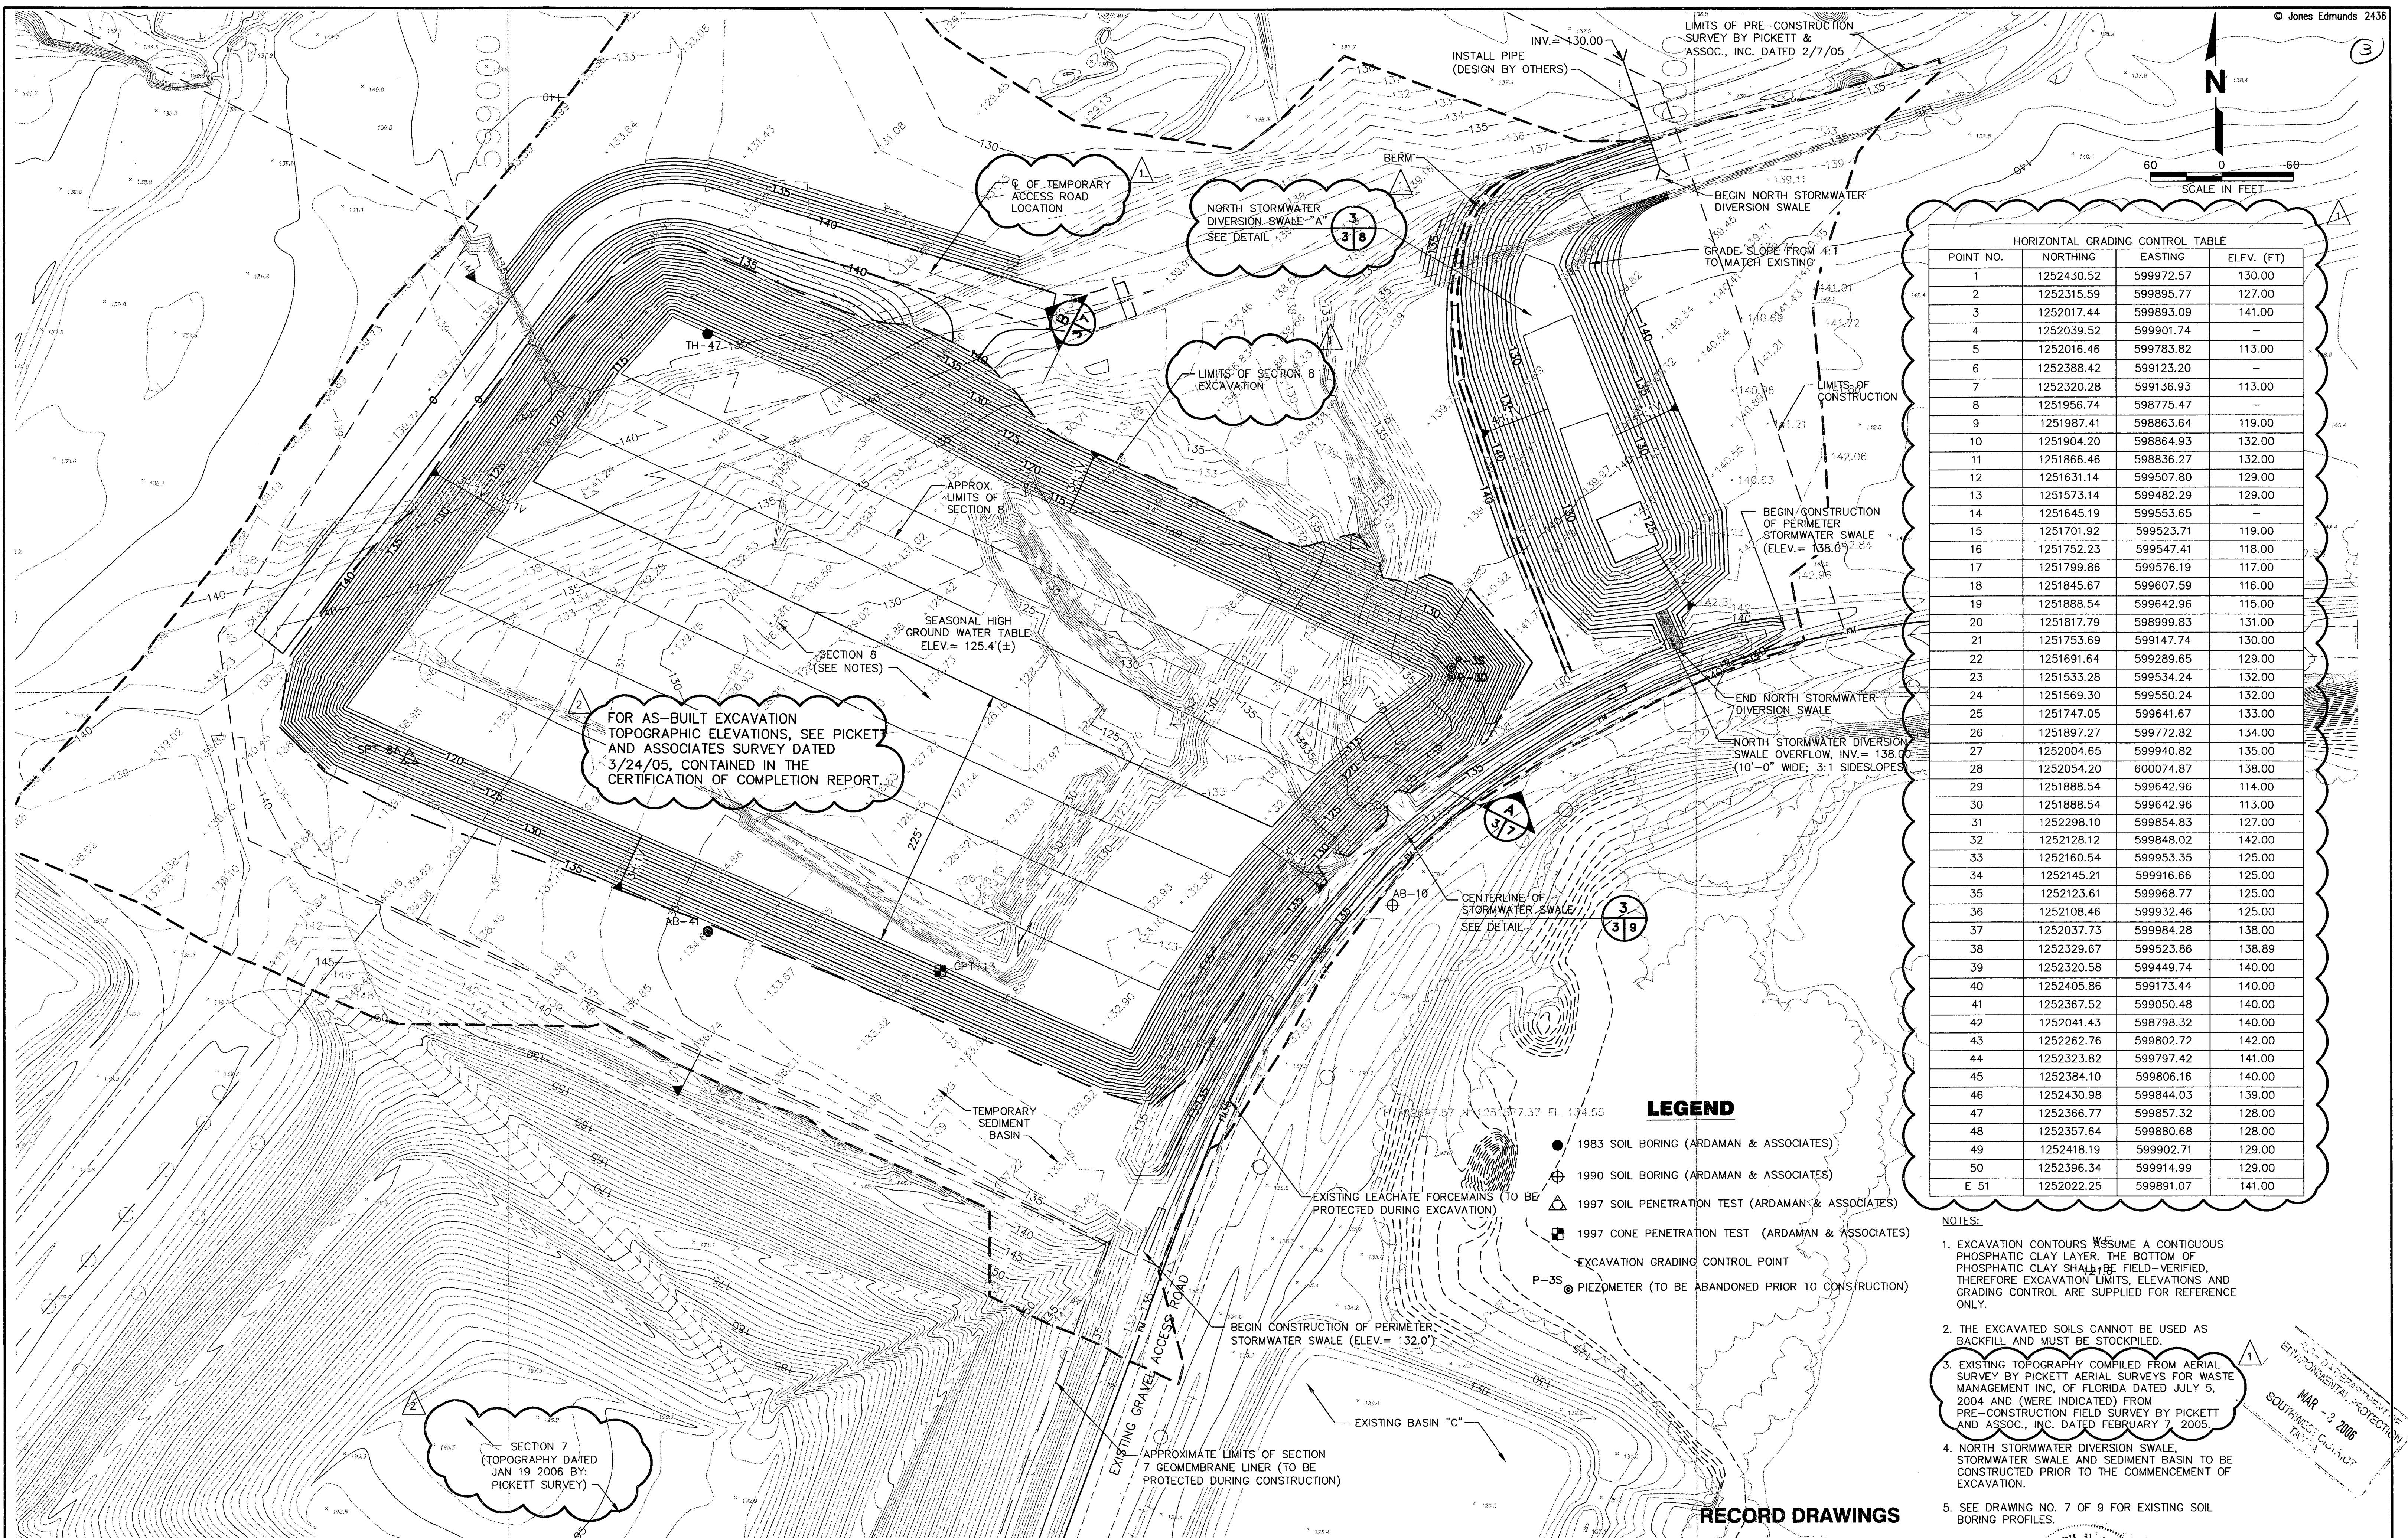


1	SCS REVISION - ALIGNMENT OF ROAD CHANGED;			DESIGNED	SCS ENGINEERS
2	TOPOGRAPHIC SURVEY INSERTED, NORTH SWALE MODIFIED;			DRAWN	GRD
2	EXCAVATION MODIFIED			CHECKED	JHO/JPA
2/28/06	RECORD DRAWING ADDITIONS // TOPOGRAPHY REVISIONS	JHV	JHO		
LTR.	DATE	REVISIONS	BY	APPRD.	

JONES EDMUNDS
 730 NE WALDO ROAD, GAINESVILLE, FLORIDA 32641 / (352) 377-5821
 324 S HYDE PARK AVE, TAMPA, FLORIDA 33606 / (813) 258-0703

**HILLSBOROUGH COUNTY
 SOLID WASTE MANAGEMENT DEPARTMENT
 SOUTHEAST COUNTY LANDFILL**

**SECTION 8 CAPACITY EXPANSION
 EXCAVATION PLAN
 CONSTRUCTION DRAWINGS**

CERTIFICATE OF AUTHORIZATION #1814	DATE	PROJECT NO.
APPROVED BY: [Signature]	2/28/06	08449-020-01
JOSEPH H. O'NEILL, P.E.	SCALE	DWG. NO.
P.E. # 052043-PRIV	AS SHOWN	3

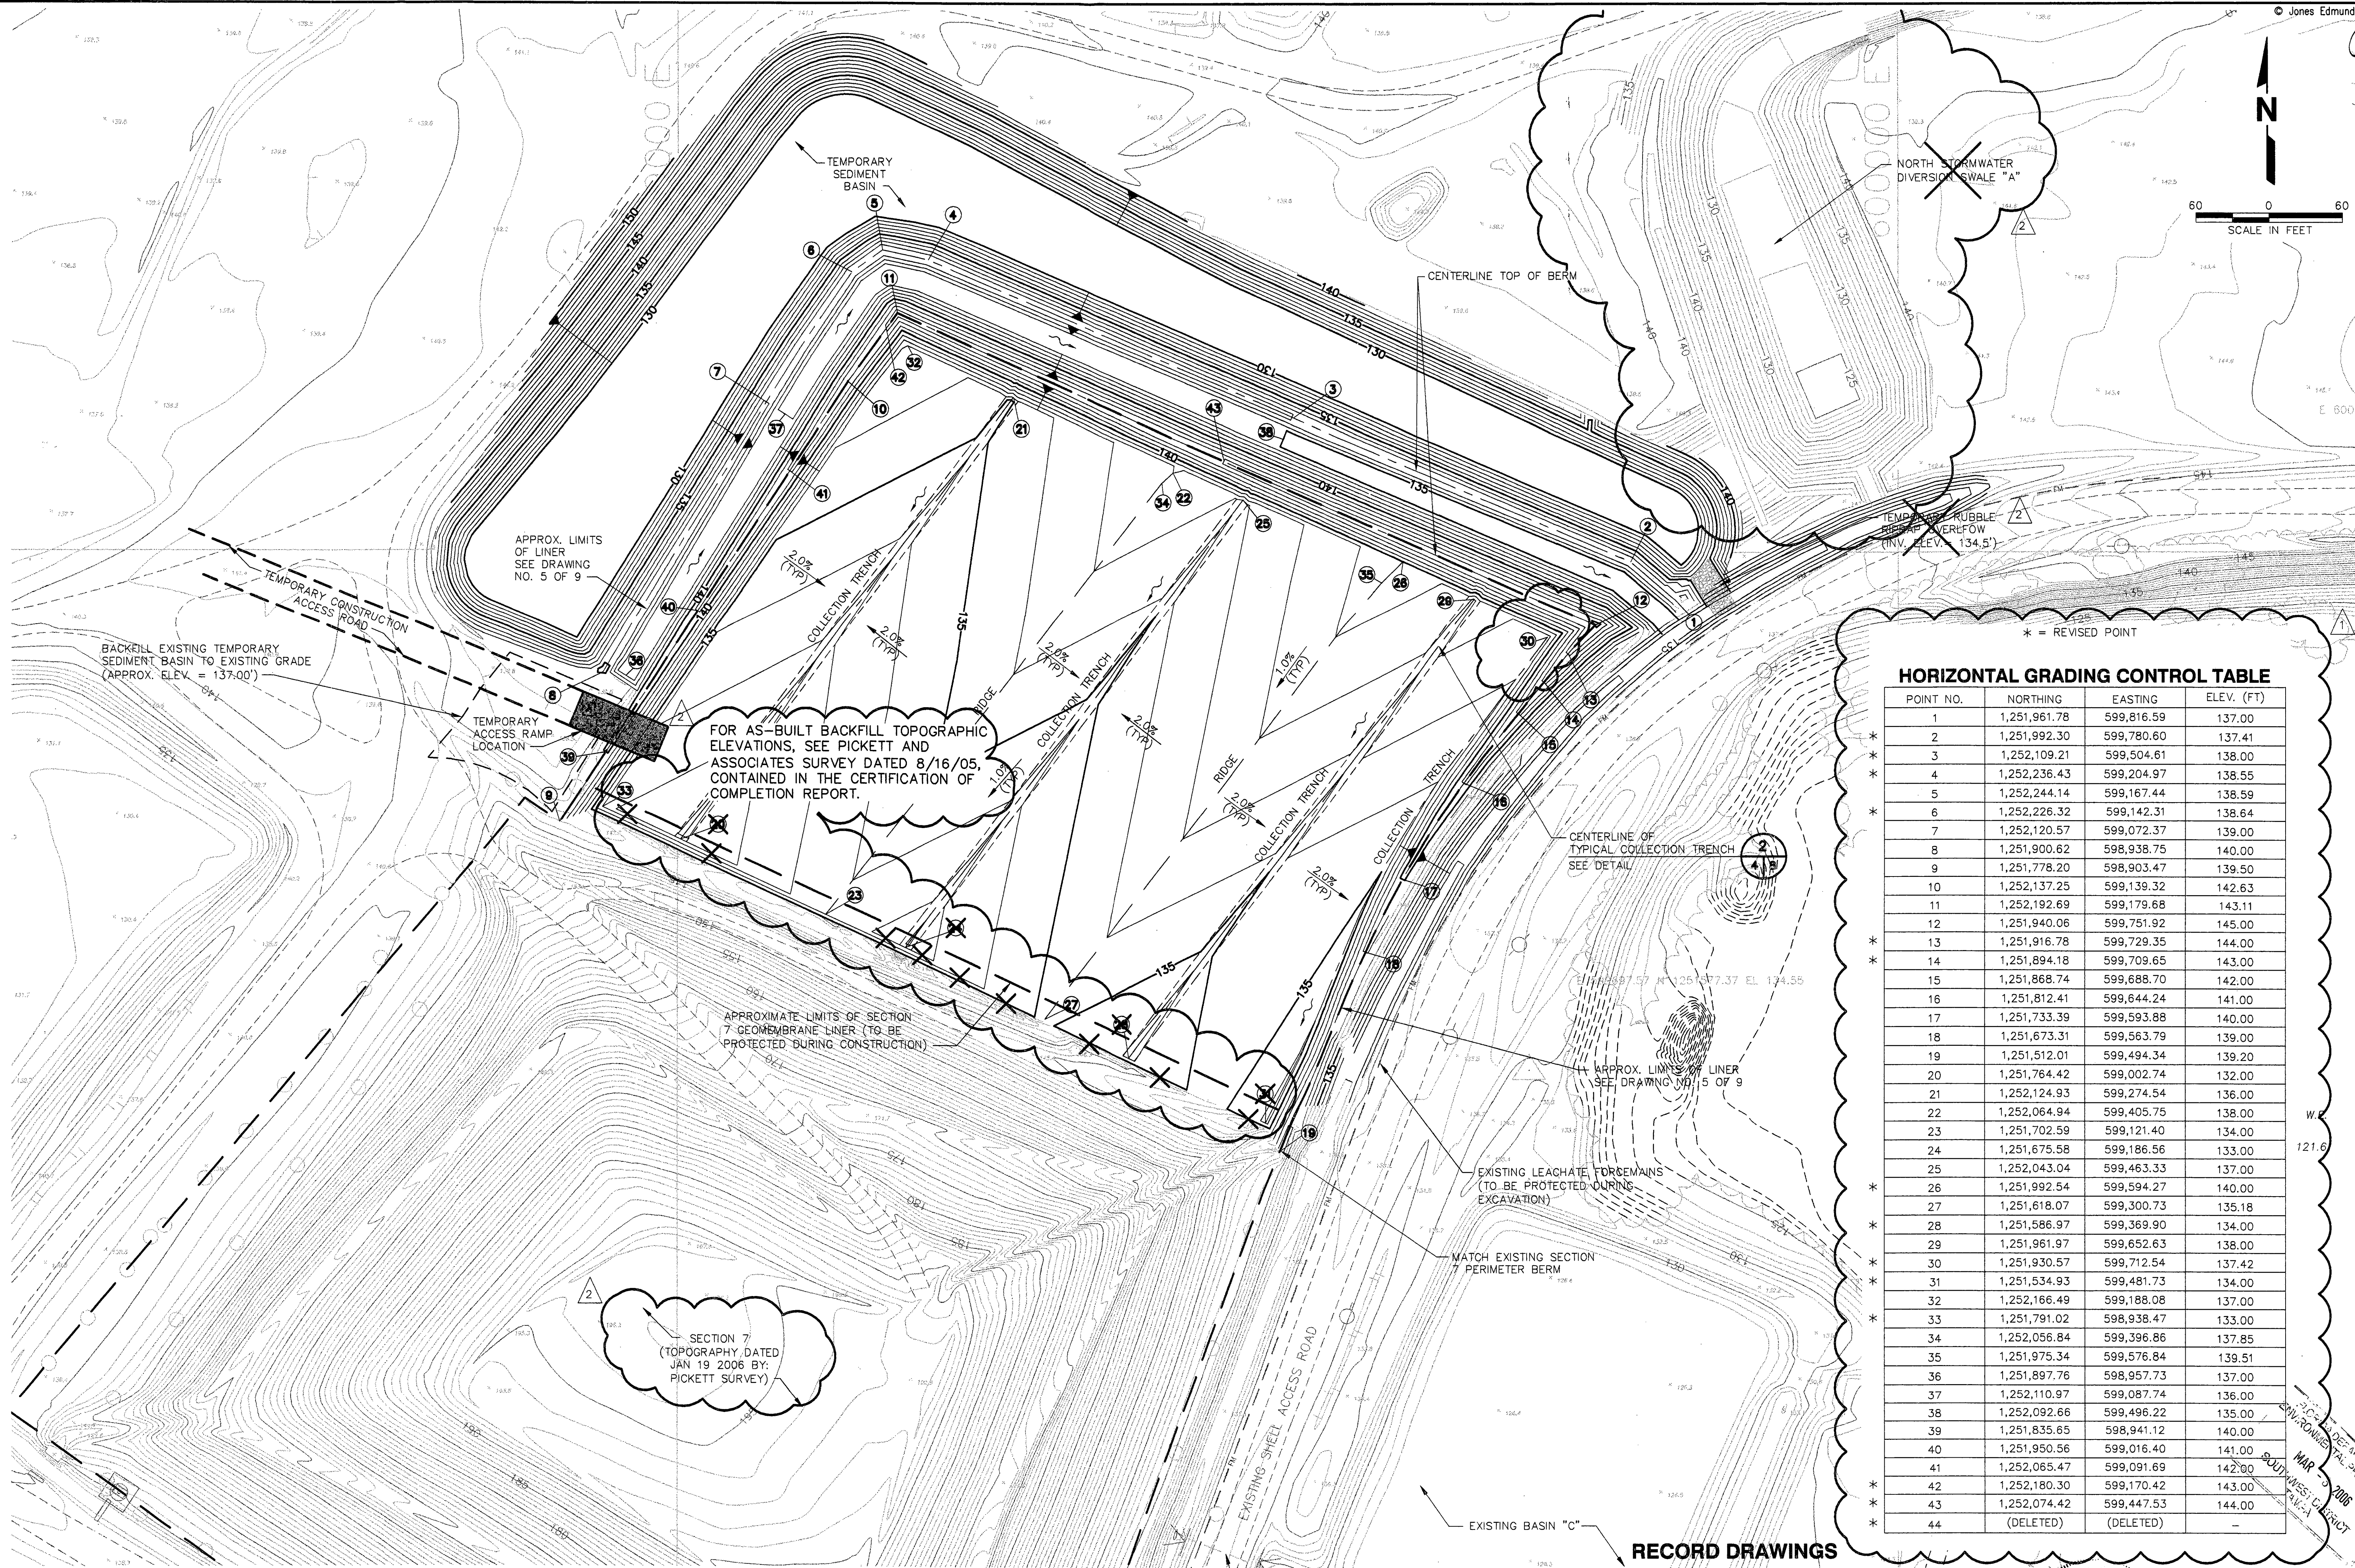

* = REVISED POINT

HORIZONTAL GRADING CONTROL TABLE

POINT NO.	NORTHING	EASTING	ELEV. (FT)
1	1,251,961.78	599,816.59	137.00
2	1,251,992.30	599,780.60	137.41
3	1,252,109.21	599,504.61	138.00
4	1,252,236.43	599,204.97	138.55
5	1,252,244.14	599,167.44	138.59
6	1,252,226.32	599,142.31	138.64
7	1,252,120.57	599,072.37	139.00
8	1,251,900.62	598,938.75	140.00
9	1,251,778.20	598,903.47	139.50
10	1,252,137.25	599,139.32	142.63
11	1,252,192.69	599,179.68	143.11
12	1,251,940.06	599,751.92	145.00
13	1,251,916.78	599,729.35	144.00
14	1,251,894.18	599,709.65	143.00
15	1,251,868.74	599,688.70	142.00
16	1,251,812.41	599,644.24	141.00
17	1,251,733.39	599,593.88	140.00
18	1,251,673.31	599,563.79	139.00
19	1,251,512.01	599,494.34	139.20
20	1,251,764.42	599,002.74	132.00
21	1,252,124.93	599,274.54	136.00
22	1,252,064.94	599,405.75	138.00
23	1,251,702.59	599,121.40	134.00
24	1,251,675.58	599,186.56	133.00
25	1,252,043.04	599,463.33	137.00
26	1,251,992.54	599,594.27	140.00
27	1,251,618.07	599,300.73	135.18
28	1,251,586.97	599,369.90	134.00
29	1,251,961.97	599,652.63	138.00
30	1,251,930.57	599,712.54	137.42
31	1,251,534.93	599,481.73	134.00
32	1,252,166.49	599,188.08	137.00
33	1,251,791.02	598,938.47	133.00
34	1,252,056.84	599,396.86	137.85
35	1,251,975.34	599,576.84	139.51
36	1,251,897.76	598,957.73	137.00
37	1,252,110.97	599,087.74	136.00
38	1,252,092.66	599,496.22	135.00
39	1,251,835.65	598,941.12	140.00
40	1,251,950.56	599,016.40	141.00
41	1,252,065.47	599,091.69	142.00
42	1,252,180.30	599,170.42	143.00
43	1,252,074.42	599,447.53	144.00
44	(DELETED)	(DELETED)	-

RECORD DRAWINGS

1	SCS REVISION - REGRADE OF SLOPE, RIPRAP OVERFLOW REMOVED, GRADING POINTS MODIFIED	JHV	JHO
2	2/28/06 RECORD DRAWING - OMISSIONS AND TOPOGRAPHY MODIFIED		
LTR	DATE	REVISIONS	BY
DESIGNED	SCS ENGINEERS		
DRAWN	GRD		
CHECKED	JHO/JPA		

JONES EDMUNDS
730 NE WALDO ROAD, GAINESVILLE, FLORIDA 32641 / (352) 377-5821
324 S HYDE PARK AVE, TAMPA, FLORIDA 33606 / (813) 258-0703

HILLSBOROUGH COUNTY
SOLID WASTE MANAGEMENT DEPARTMENT
SOUTHEAST COUNTY LANDFILL


SECTION 8 CAPACITY EXPANSION
BACKFILL PLAN
CONSTRUCTION DRAWINGS

CERTIFICATE OF AUTHORIZATION 0814	DATE	PROJECT NO.
APPROVED BY: [Signature]	2/28/06	08449-020-01
JOSPH H. O'NEILL P.E.	SCALE	DWG. NO.
P.E. # 052348	AS SHOWN	4

Plotted: 3/02/06 7:37am rdemint

\\Tpo-srv\Drafting\08449 Hillsborough County\020-SELF Section 8\Certification Drawings\0844902001-C-05-LCRS2.dwg

Edited: 00/00/00 0:00 login

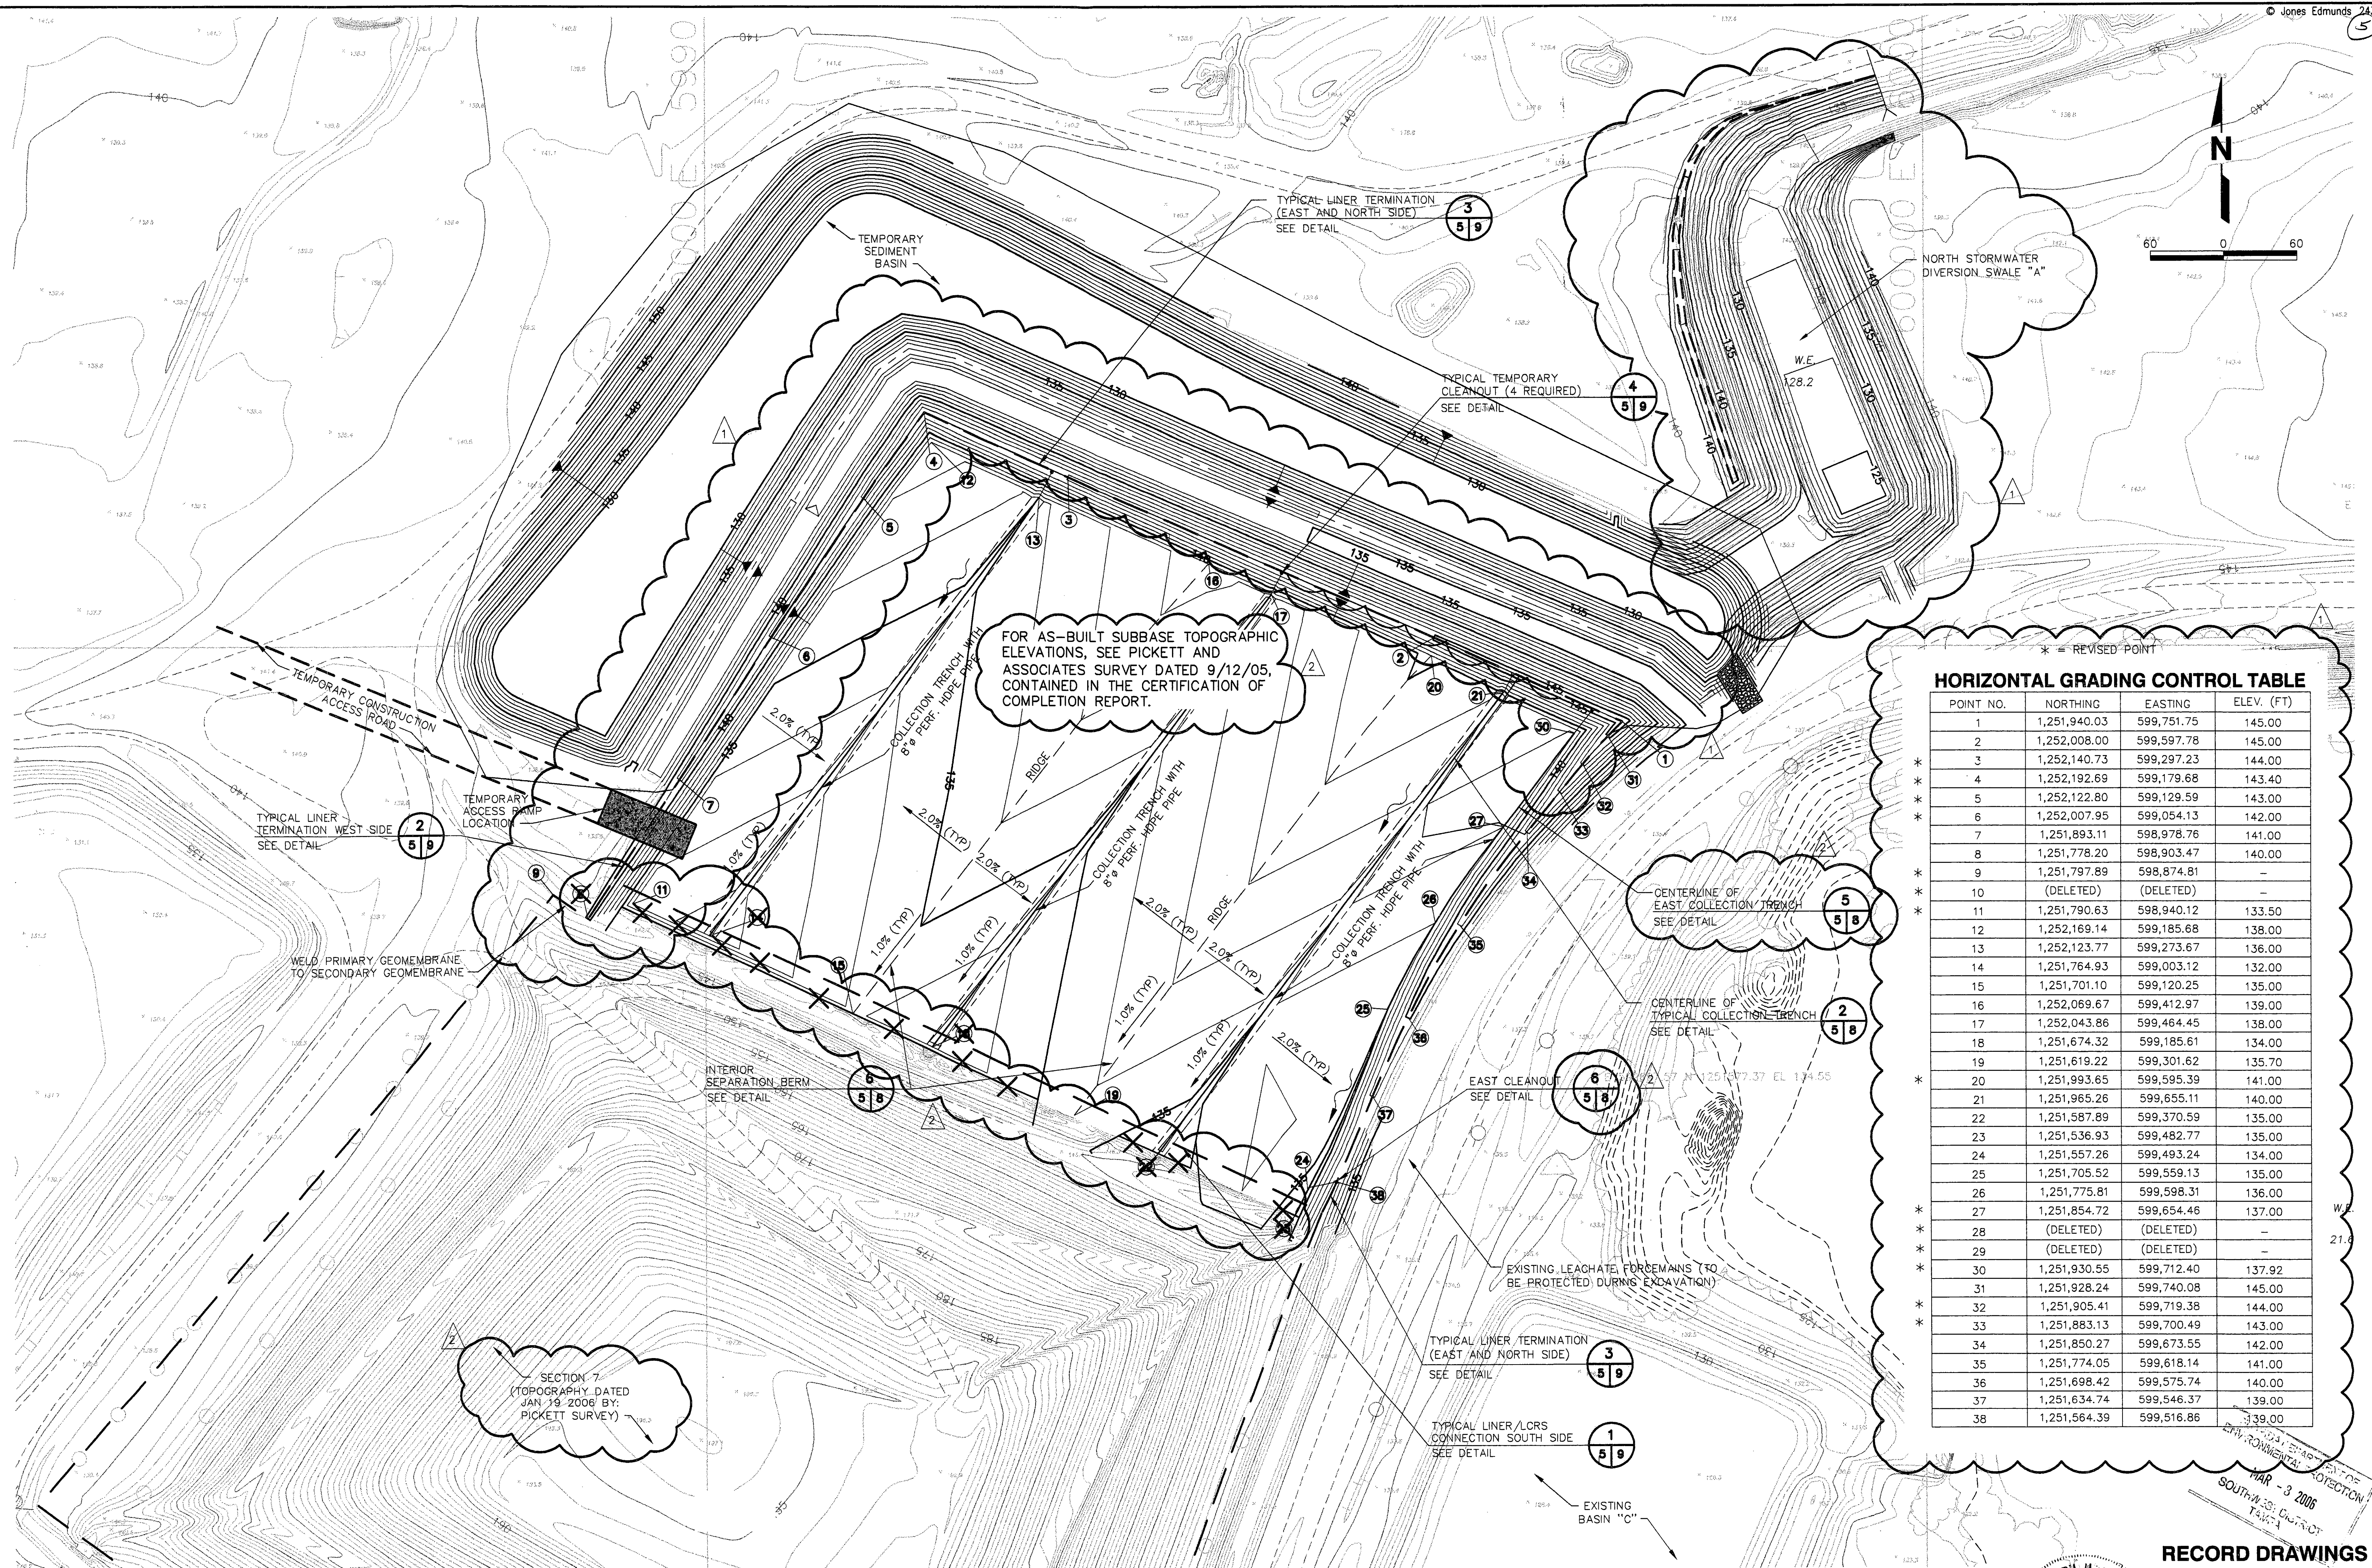

HORIZONTAL GRADING CONTROL TABLE

POINT NO.	NORTHING	EASTING	ELEV. (FT)
1	1,251,940.03	599,751.75	145.00
2	1,252,008.00	599,597.78	145.00
3	1,252,140.73	599,297.23	144.00
4	1,252,192.69	599,179.68	143.40
5	1,252,122.80	599,129.59	143.00
6	1,252,007.95	599,054.13	142.00
7	1,251,893.11	598,978.76	141.00
8	1,251,778.20	598,903.47	140.00
9	1,251,797.89	598,874.81	-
10	(DELETED)	(DELETED)	-
11	1,251,790.63	598,940.12	133.50
12	1,252,169.14	599,185.68	138.00
13	1,252,123.77	599,273.67	136.00
14	1,251,764.93	599,003.12	132.00
15	1,251,701.10	599,120.25	135.00
16	1,252,069.67	599,412.97	139.00
17	1,252,043.86	599,464.45	138.00
18	1,251,674.32	599,185.61	134.00
19	1,251,619.22	599,301.62	135.70
20	1,251,993.65	599,595.39	141.00
21	1,251,965.26	599,655.11	140.00
22	1,251,587.89	599,370.59	135.00
23	1,251,536.93	599,482.77	135.00
24	1,251,557.26	599,493.24	134.00
25	1,251,705.52	599,559.13	135.00
26	1,251,775.81	599,598.31	136.00
27	1,251,854.72	599,654.46	137.00
28	(DELETED)	(DELETED)	-
29	(DELETED)	(DELETED)	-
30	1,251,930.55	599,712.40	137.92
31	1,251,928.24	599,740.08	145.00
32	1,251,905.41	599,719.38	144.00
33	1,251,883.13	599,700.49	143.00
34	1,251,850.27	599,673.55	142.00
35	1,251,774.05	599,618.14	141.00
36	1,251,698.42	599,575.74	140.00
37	1,251,634.74	599,546.37	139.00
38	1,251,564.39	599,516.86	139.00

RECORD DRAWINGS


1	SCS REVISION - ALIGNMENT OF TOP OF BERM MODIFIED;	DESIGNED	SCS ENGINEERS
2	NORTH SWALE MODIFIED; GRADING POINTS MODIFIED	DRAWN	GRD
2/28/06	RECORD DRAWING TOPOGRAPHY MODIFIED	CHECKED	JHO/JPA
LTR.	DATE	REVISIONS	BY

JONES EDMUNDS
730 NE WALDO ROAD, GAINESVILLE, FLORIDA 32641 / (352) 377-5821
324 S HYDE PARK AVE, TAMPA, FLORIDA 33606 / (813) 258-0703

HILLSBOROUGH COUNTY
SOLID WASTE MANAGEMENT DEPARTMENT
SOUTHEAST COUNTY LANDFILL

SECTION 8 CAPACITY EXPANSION
LCR GRADING PLAN (TOP OF CLAY SUBBASE)
CONSTRUCTION DRAWINGS

CERTIFICATE OF AUTHORIZATION 1814 APPROVED BY: [Signature] JOSEPH J. VANCELL, P.E. P.E. # 052049	DATE 2/28/06	PROJECT NO. 08449-020-01
SCALE AS SHOWN	DWG. NO. 5	

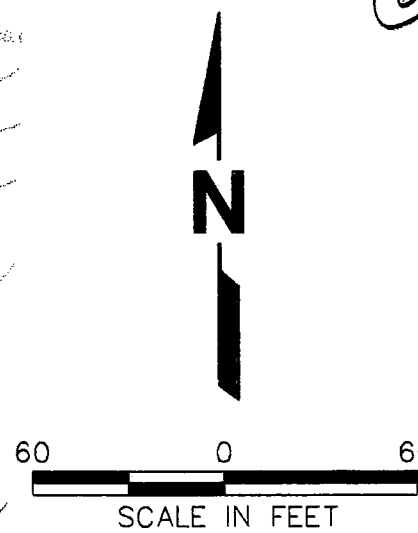

* = REVISED POINT
HORIZONTAL GRADING CONTROL TABLE

POINT NO.	NORTHING	EASTING	ELEV. (FT)
1	1,251,940.03	599,751.75	147.51
2	1,252,008.00	599,597.78	147.00
3	1,252,140.78	599,297.26	146.00
4	1,252,192.69	599,179.68	145.60
5	1,252,122.76	599,129.65	145.00
6	1,252,008.01	599,054.04	144.00
7	1,251,893.11	598,978.76	143.00
8	1,251,777.95	598,903.31	142.00
9	1,251,760.02	598,999.42	134.00
10	1,252,122.76	599,272.91	138.00
11	1,252,069.35	599,412.69	141.00
12	1,251,696.24	599,116.46	137.00
13	1,251,669.42	599,181.91	136.00
14	1,252,042.97	599,463.78	140.00
15	1,251,993.34	599,595.08	143.00
16	1,251,614.33	599,297.88	137.64
17	1,251,582.98	599,366.89	137.00
18	1,251,963.54	599,653.82	142.00
19	1,251,930.42	599,711.92	139.92
20	1,251,912.10	599,697.86	139.70
21	1,251,531.59	599,480.01	135.00
22	1,251,855.40	599,655.80	139.00
23	1,251,776.37	599,599.41	138.00
24	1,251,706.01	599,560.08	137.00
25	1,251,640.28	599,529.88	136.00
26	1,251,592.09	599,508.69	135.26
27	1,251,574.19	599,498.96	135.00
28	1,251,532.93	599,477.06	137.00
29	1,251,512.01	599,494.34	141.70
30	1,251,564.35	599,516.94	141.00
31	1,251,634.70	599,546.45	141.00
32	1,251,698.42	599,575.74	142.00
33	1,251,774.00	599,618.23	143.00
34	1,251,850.21	599,673.62	144.00
35	1,251,883.12	599,700.50	145.00
36	1,251,905.44	599,719.35	146.00
37	1,251,928.17	599,740.15	147.00
38	1,251,937.70	599,819.34	134.30
39	1,251,979.77	599,772.89	134.41
40	1,252,096.36	599,497.65	135.00
41	1,252,222.48	599,200.62	135.55
42	1,252,228.62	599,170.70	135.59
43	1,252,215.96	599,152.85	135.65
44	1,252,164.46	599,117.62	135.83
45	1,252,113.36	599,085.19	136.00
46	1,251,899.39	598,955.02	137.00

FOR AS-BUILT FINAL SITE TOPOGRAPHIC ELEVATIONS, SEE PICKETT AND ASSOCIATES SURVEY DATED 12/07/05, CONTAINED IN THE CERTIFICATION OF COMPLETION REPORT.

SECTION 7 (TOPOGRAPHY DATED JAN. 19, 2006 BY PICKETT SURVEY)

APPROXIMATE LIMITS OF SECTION 7 AND 8 GEOMEMBRANE LINER SYSTEM (EXISTING SECTION 7 GEOMEMBRANE LINER SYSTEM TO BE PROTECTED DURING CONSTRUCTION)

SEE DETAIL 6 FOR GEOMEMBRANE TIE-IN

INVERT ELEV. = 137.00'

INVERT ELEV. = 134.40'

EXISTING LEACHATE FORCEMAINS (TO BE PROTECTED DURING EXCAVATION)

EXISTING SHELL ACCESS ROAD

EXISTING BASIN "C"

CENTERLINE OF PERIMETER BERM

CENTERLINE OF STORMWATER SWALE

NORTH STORMWATER DIVERSION SWALE "A"

W.E. 128.2

COLLECTION TRENCH

COLLECTION TRENCH

1	SCS REVISION - ALIGNMENT OF TOP OF BERM MODIFIED; NORTH SWALE MODIFIED; GRADING POINTS MODIFIED	DESIGNED	SCS ENGINEERS
2	2/28/06 RECORD DRAWING EXCESS GEOMEMBRANE REMOVED FROM SECTION 7 AND TOPOGRAPHY MODIFIED	DRAWN	GRD
LTR.	DATE	REVISIONS	BY
			APPR.
		CHECKED	JHO/JPA

JONES EDMUNDS
730 NE WALDO ROAD, GAINESVILLE, FLORIDA 32641 / (352) 377-5821
324 S HYDE PARK AVE, TAMPA, FLORIDA 33606 / (813) 258-0703

**HILLSBOROUGH COUNTY
SOLID WASTE MANAGEMENT DEPARTMENT
SOUTHEAST COUNTY LANDFILL**

**SECTION 8 CAPACITY EXPANSION
TOP OF PROTECTIVE LAYER GRADING PLAN
CONSTRUCTION DRAWINGS**


CERTIFICATE OF AUTHORIZATION #1814
APPROVED BY: [Signature]
DATE: 2/28/06
SCALE: AS SHOWN
PROJECT NO.: 08449-020-01
DWG. NO.: 6

RECORD DRAWINGS



ENVIRONMENTAL PROTECTION
MAR - 3 2006
SOUTHWEST DISTRICT
TAMPA

SOIL LEGEND


1	SAND TAILINGS	5	LIGHT BROWN SAND WITH SILT TO SILTY SAND OCCASIONALLY CEMENTED (SP-SM TO SM)
1A	GRAYISH BROWN SAND WITH SILT TO SILTY SAND WITH CLAY (SP-SM TO SM-SC) TAILING SAND	5A	LIGHT TO DARK GRAY SLIGHTLY SILTY TO SILTY FINE SANDS WITH OCCASIONAL TRACES OF ROOTS AND OTHER ORGANIC MATTER
1B	GRAYISH BROWN CLAYEY SAND (SC) TAILING SAND AND PHOSPHATIC WASTE CLAY MIX	6	GRAY SAND WITH CEMENTED SAND PARTICLES (SP)
1C	BROWN SAND	6A	LIGHT TO DARK BROWN SLIGHTLY SILTY TO SILTY FINE SANDS WITH OCCASIONAL SEAMS OF CEMENTED SANDS (HARDPAN)
2A	GREENISH GRAY PHOSPHATIC WASTE CLAY (CH)	7	GRAY SANDY CLAY WITH PHOSPHATE (CH)
2B	GREENISH GRAY SANDY PHOSPHATIC WASTE CLAY (CH-CL) PHOSPHATIC WASTE CLAY AND TAILING SAND MIX	9	GRAY CLAYEY SAND WITH PHOSPHATE (SC)
3	BROWNISH GRAY SAND WITH SILT (SP-SM)	10	LIGHT BROWN CLAYEY SAND WITH SILT AND PHOSPHATE, CEMENTED (SC)
3A	DARK BROWN SAND WITH SILT AND GRAY CLAY LAYER	12	GRAY CLAYEY SAND (SC)
3B	SAND TAILINGS MIXED WITH WASTE PHOSPHATIC CLAYS	12A	BROWN AND ORANGISH-BROWN CLAYEY SAND
4	DARK BROWN SILTY SAND (SM) HARD PAN		

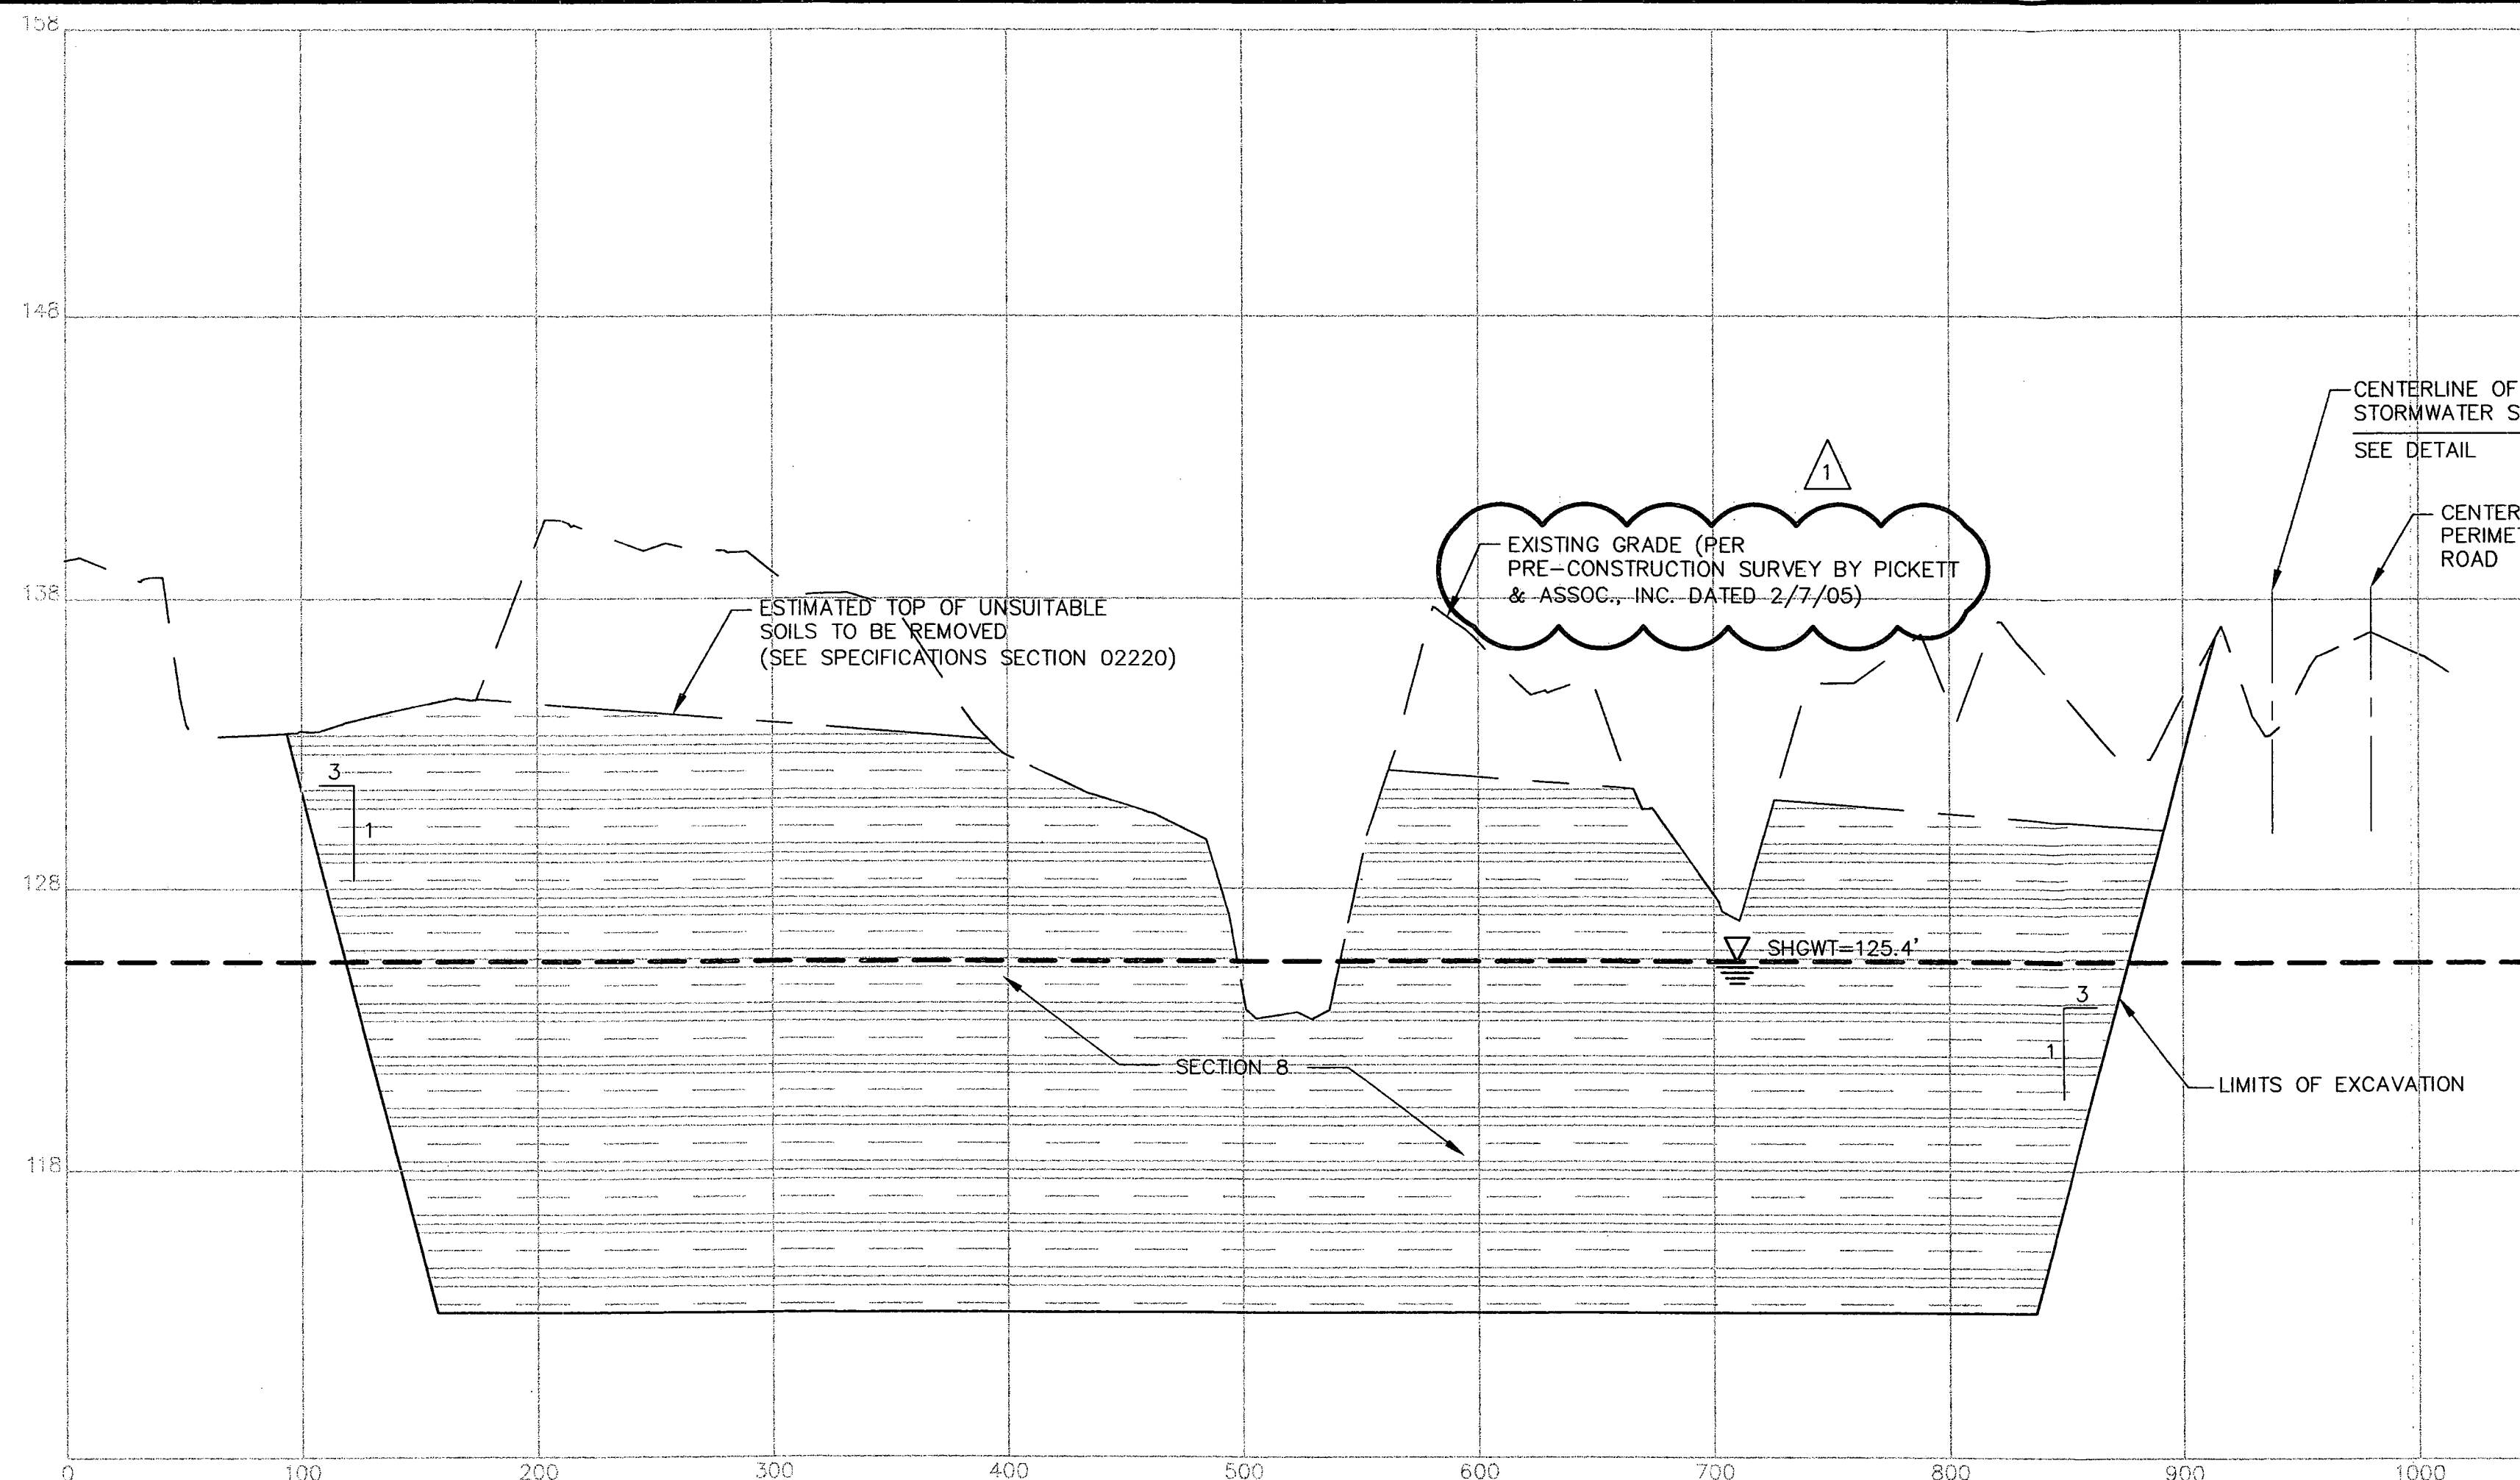


EXCAVATION SECTION A
SCALE 1" = 60' HORIZ
1" = 5' VERT

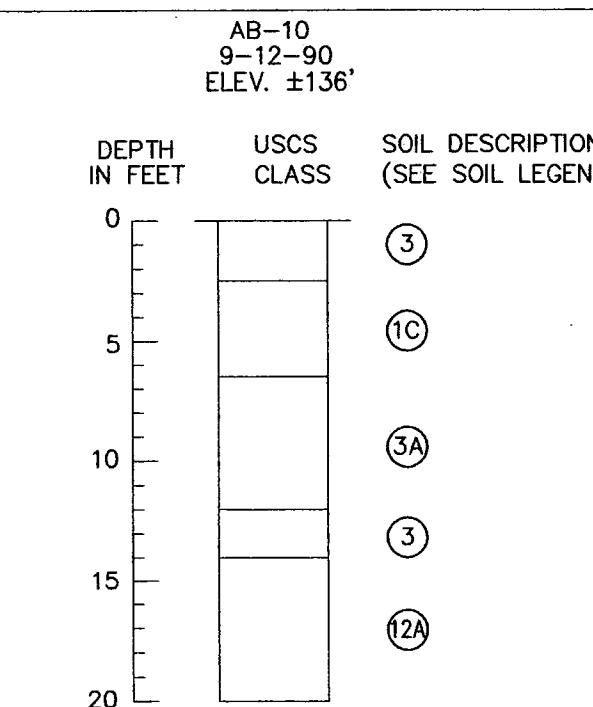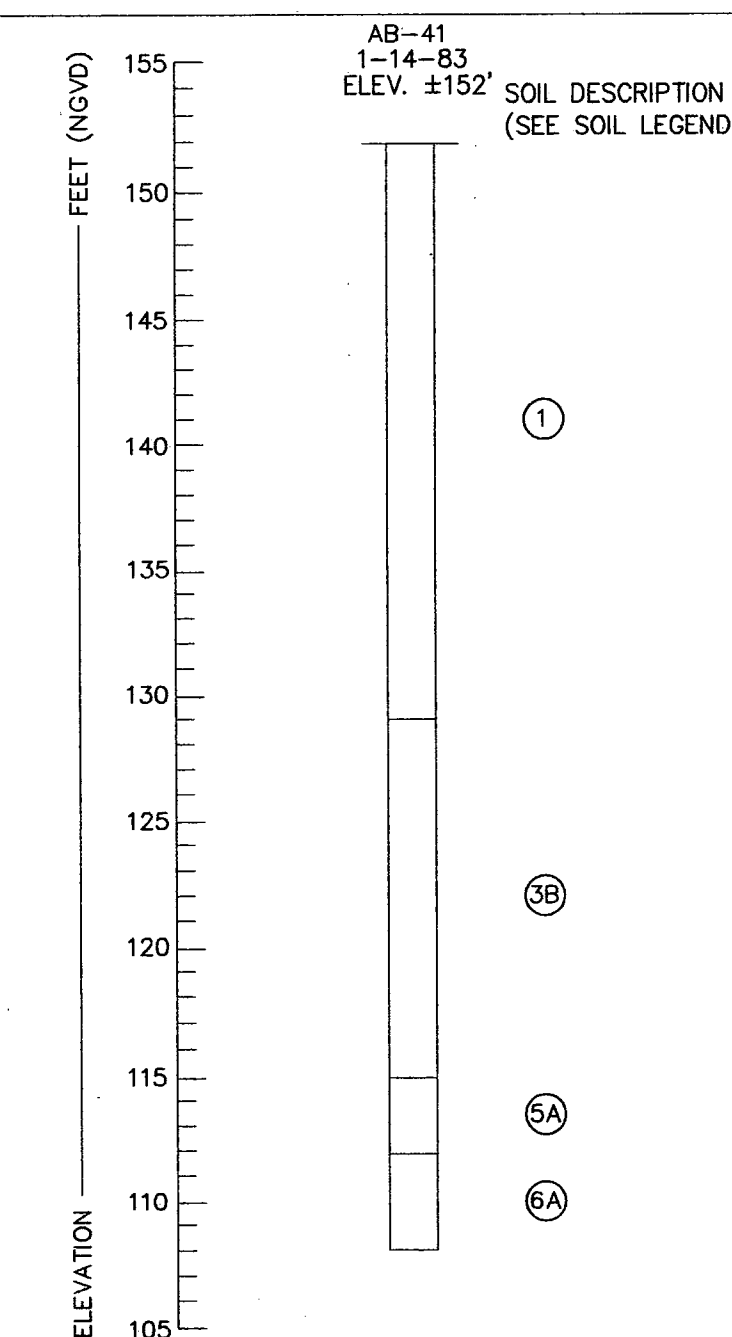

BORING PROFILE AUGER BORING (AB-10)
NTS

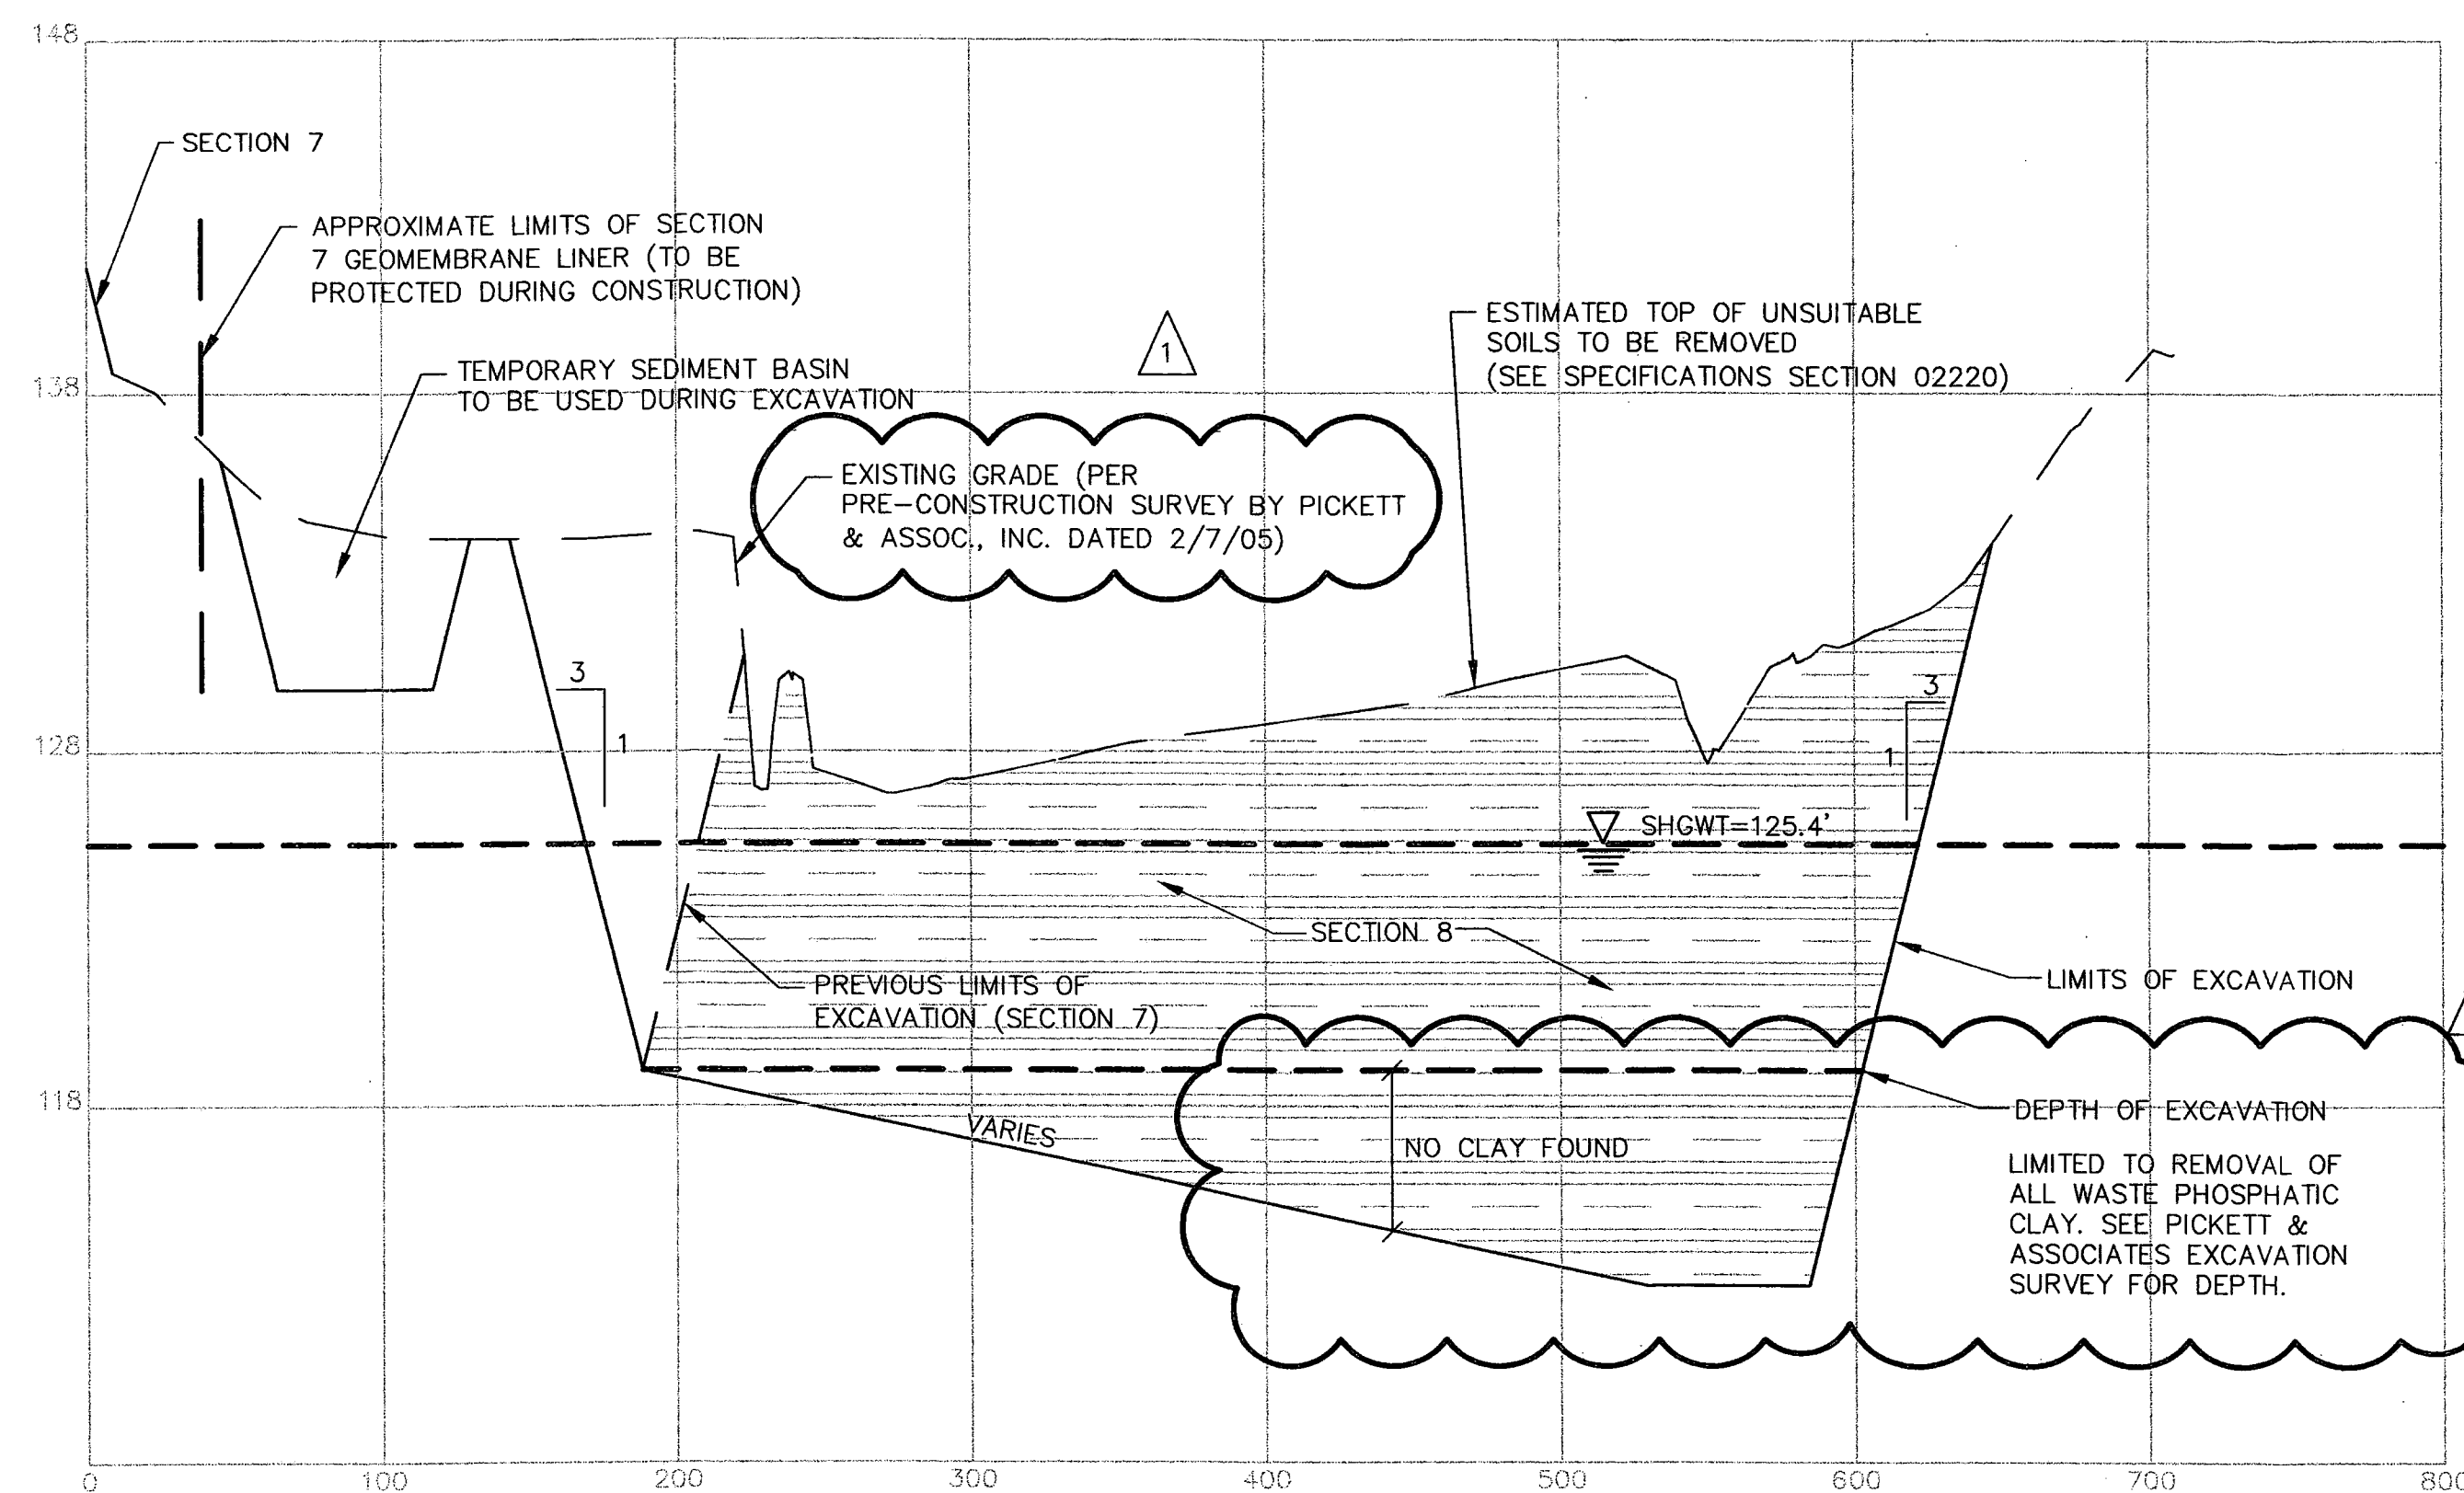


EXCAVATION SECTION B
SCALE 1" = 60' HORIZ
1" = 5' VERT

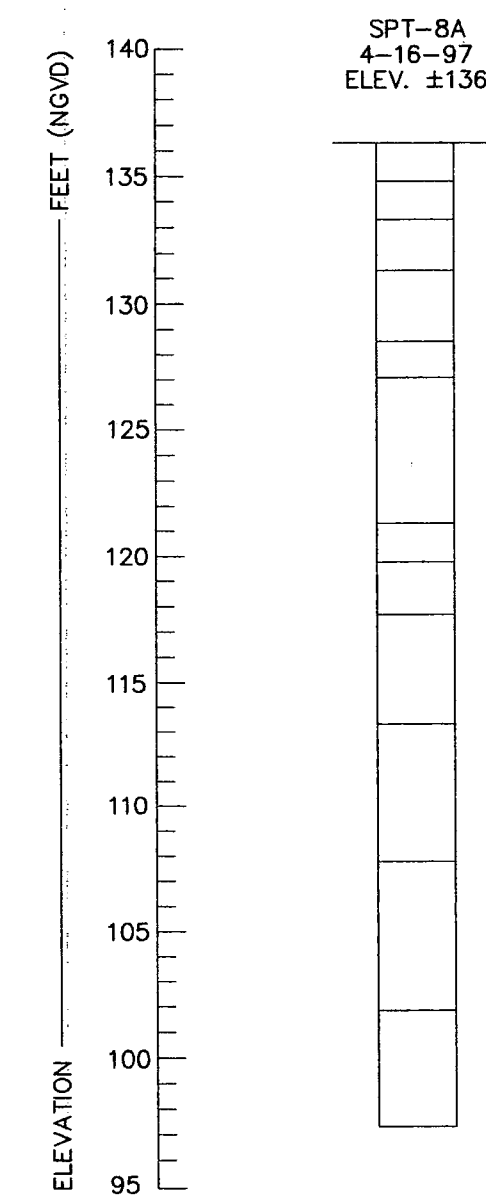


BORING PROFILE STANDARD PENETRATION TEST (SPT-8A)
NTS

BORING PROFILE AUGER BORING (AB-41)
NTS

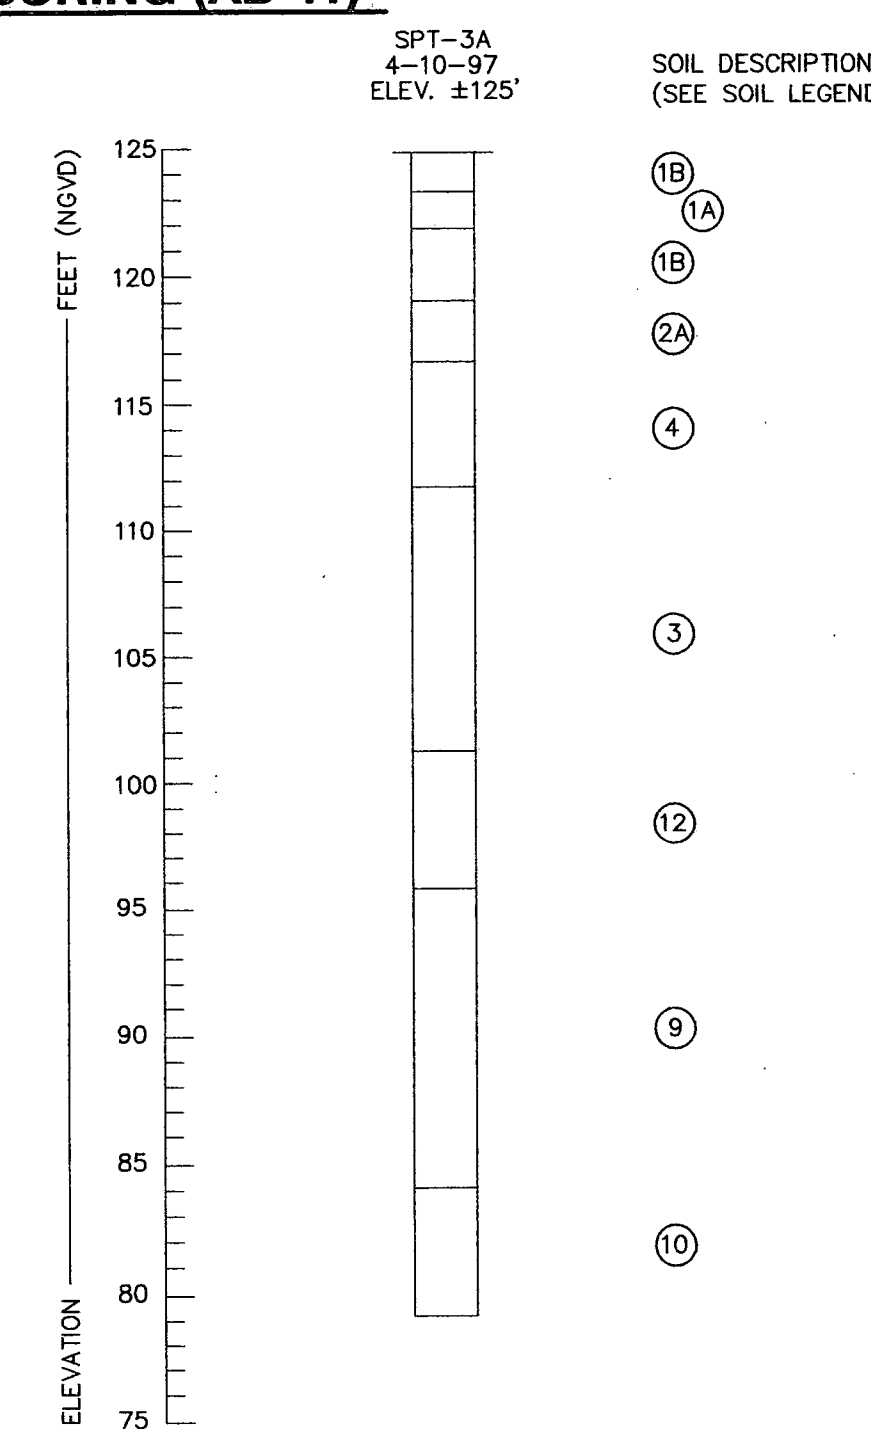

BORING PROFILE STANDARD PENETRATION TEST (SPT-3A)
NTS

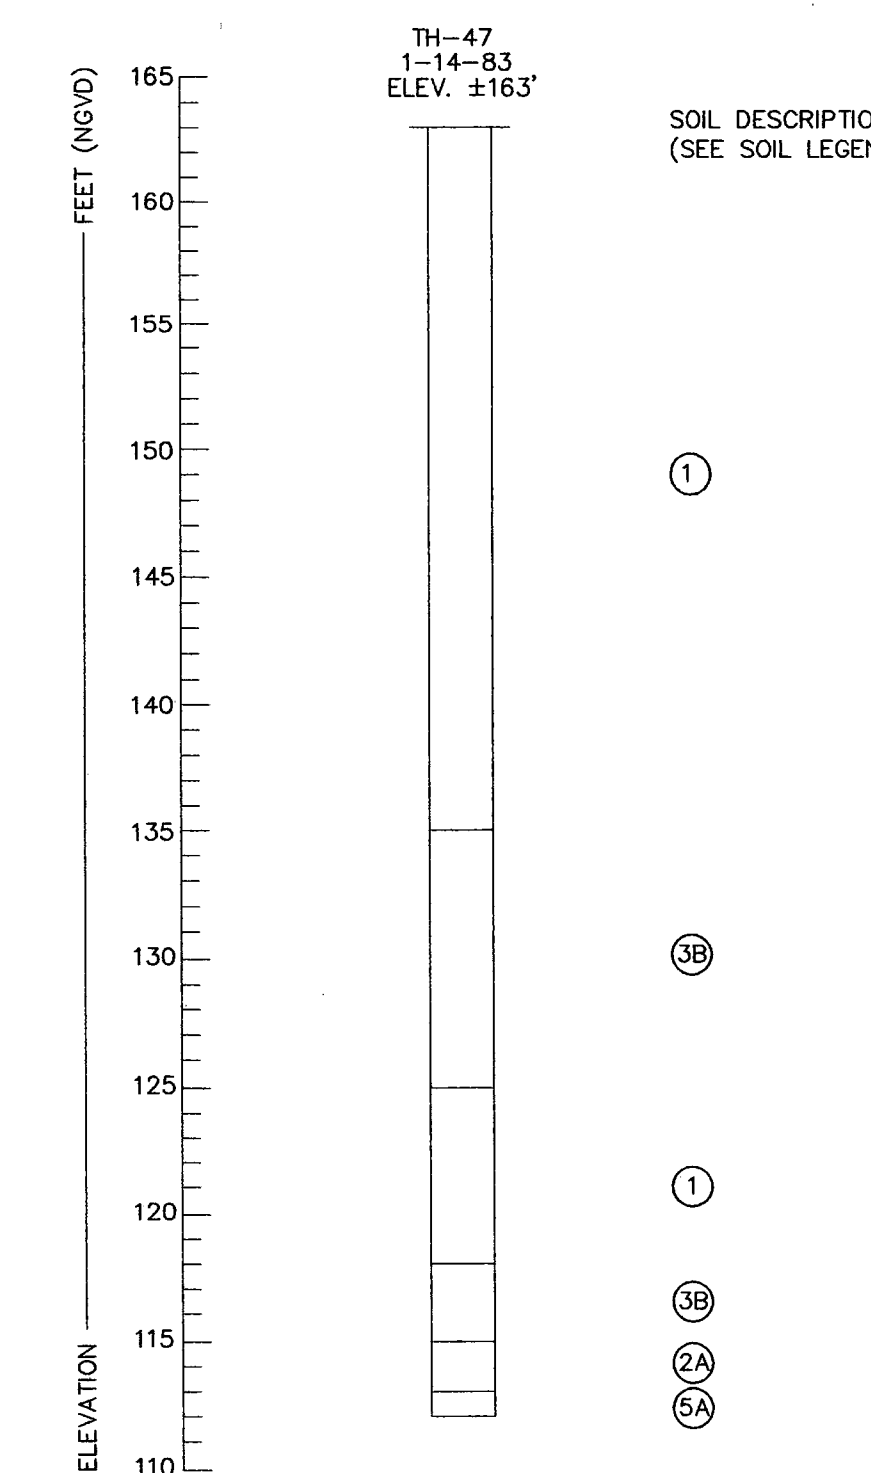

BORING PROFILE STANDARD PENETRATION TEST (TH-47)
NTS

RECORD DRAWINGS

1	SCS REVISION - EXCAVATION DEPTH MODIFIED; EXISTING TOPOGRAPHY INSERTED	DESIGNED	SCS ENGINEERS
		DRAWN	GRD
		CHECKED	JHO/JPA
LTR.	DATE	REVISIONS	BY APPRD.

JONES EDMUNDS
730 NE WALDO ROAD, GAINESVILLE, FLORIDA 32641 / (352) 377-5821
324 S HYDE PARK AVE, TAMPA, FLORIDA 33606 / (813) 258-0703

**HILLSBOROUGH COUNTY
SOLID WASTE MANAGEMENT DEPARTMENT
SOUTHEAST COUNTY LANDFILL**


**SECTION 8 CAPACITY EXPANSION
SECTIONS & SOIL BORING PROFILES
CONSTRUCTION DRAWINGS**

CERTIFICATE OF AUTHORIZATION #1814 APPROVED BY: [Signature] DATE: 2/28/06 P.E. # 052048	PROJECT NO. 08449-020-01
DATE: 2/28/06 SCALE: AS SHOWN	DWG. NO. 7


Plotted: 3/02/06 6:59am rdemint

\\Top-srv\Drafting\08449 Hillsborough County\020-SLF Section 8\Certification Drawings\0844902001-C-08-Det1a.dwg


Edited: 00/00/00 0:00 login

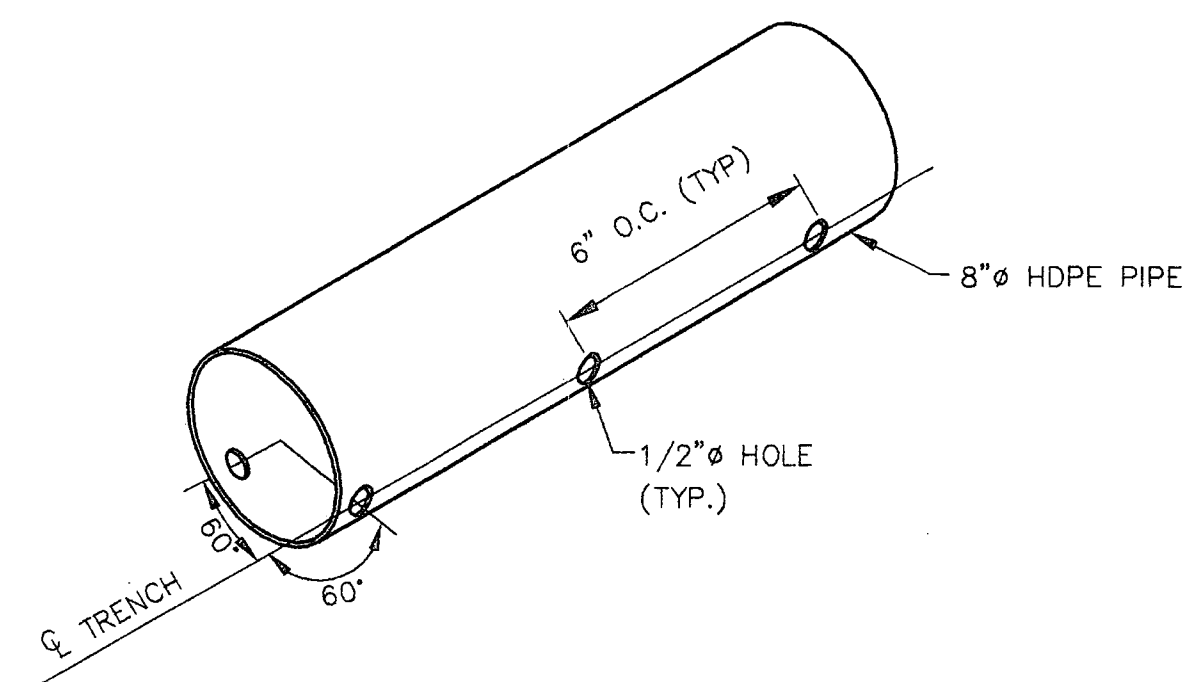**PIPE PERFORATION DETAIL** 4


NOT TO SCALE

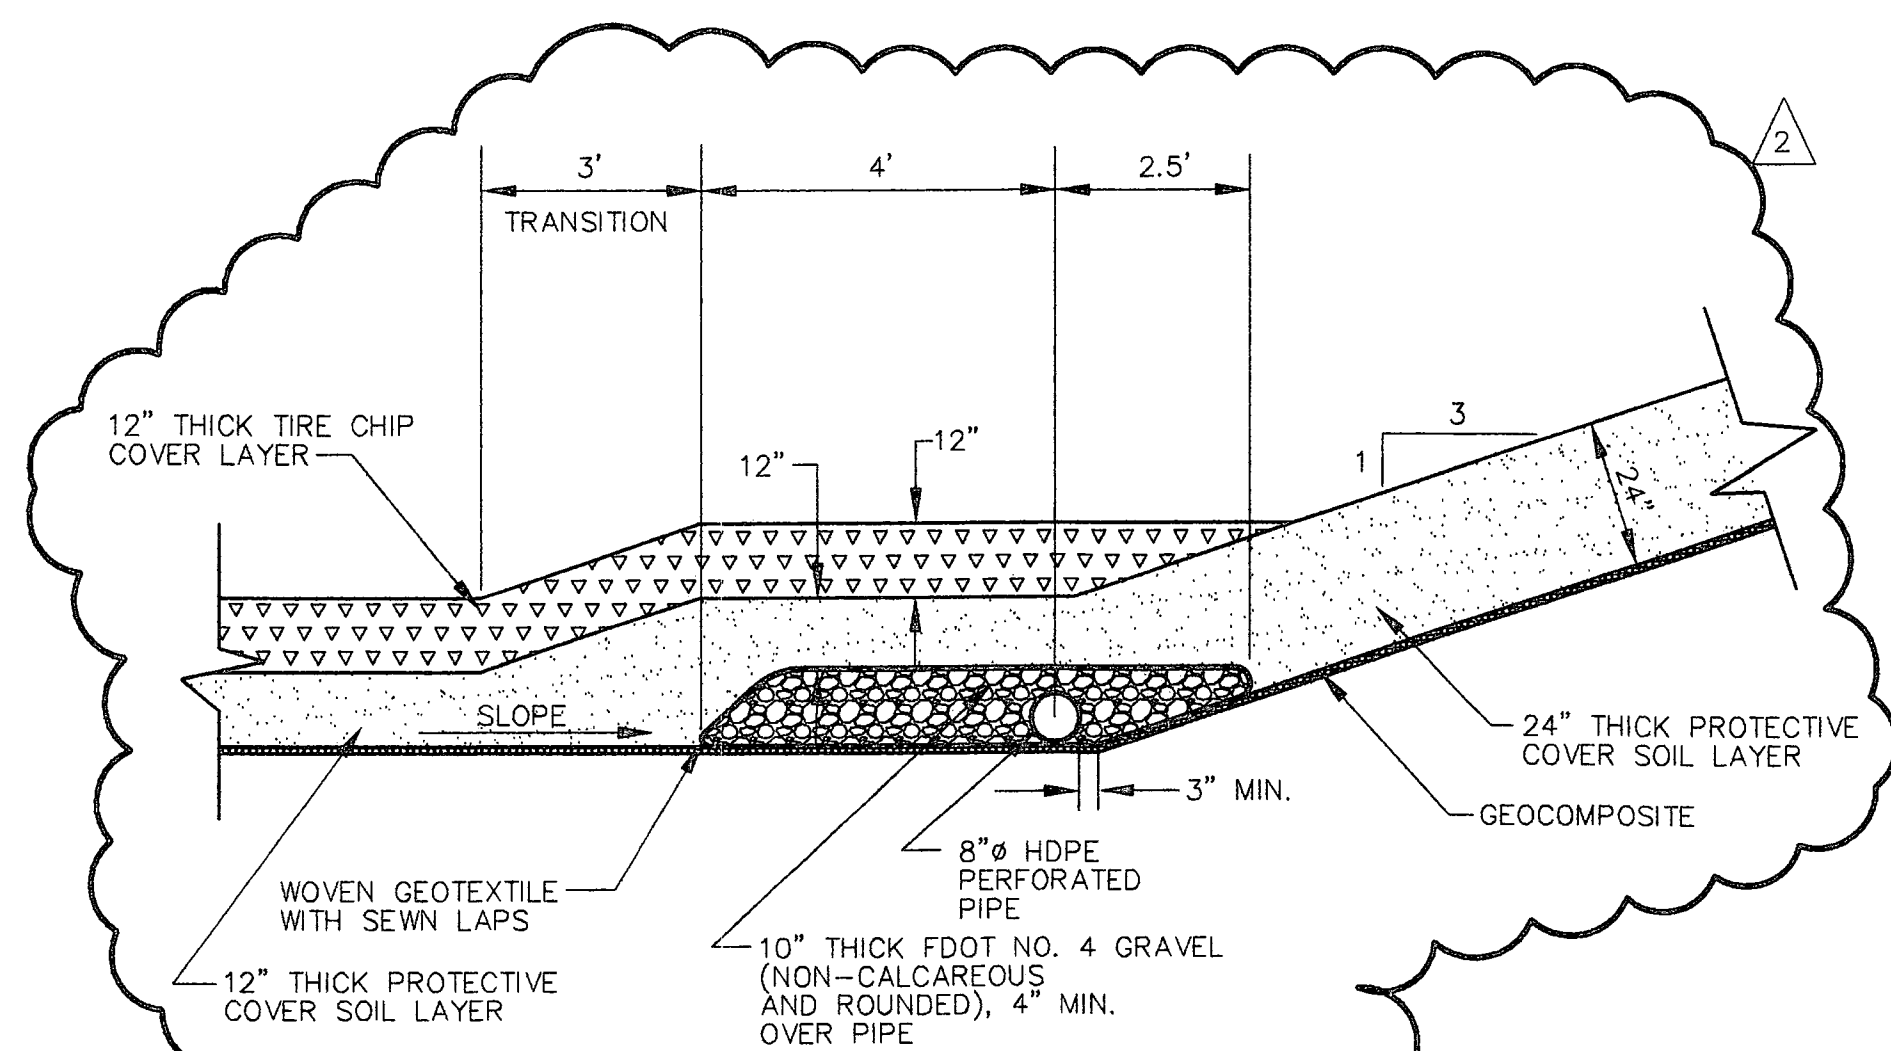**EAST COLLECTION TRENCH DETAIL** 5


NOT TO SCALE

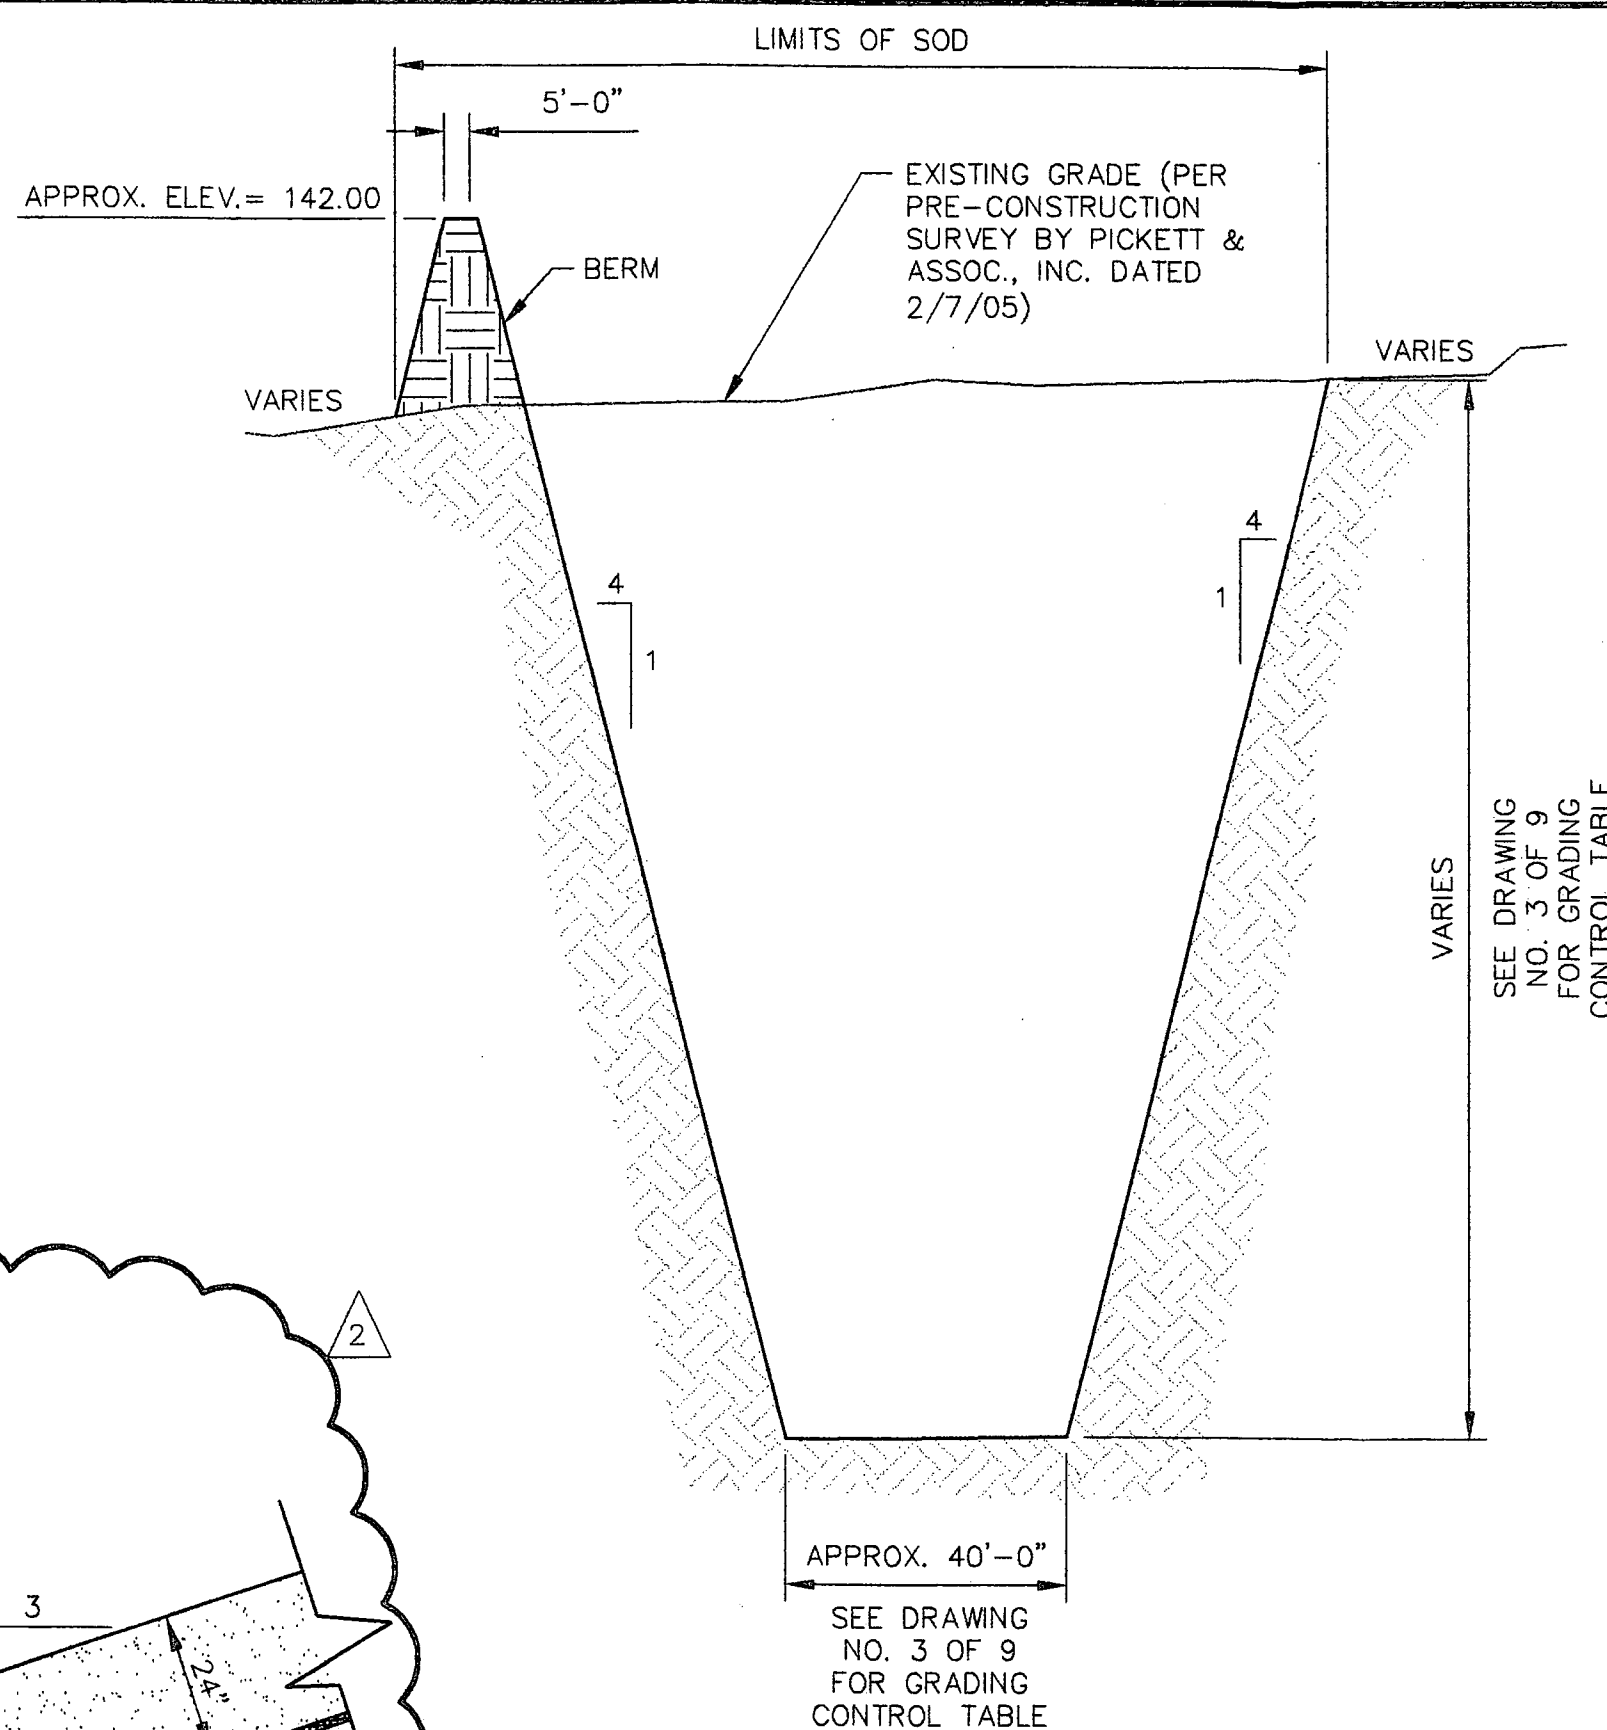**NORTH STORMWATER DIVERSION SWALE "A" DETAIL** 3


NOT TO SCALE

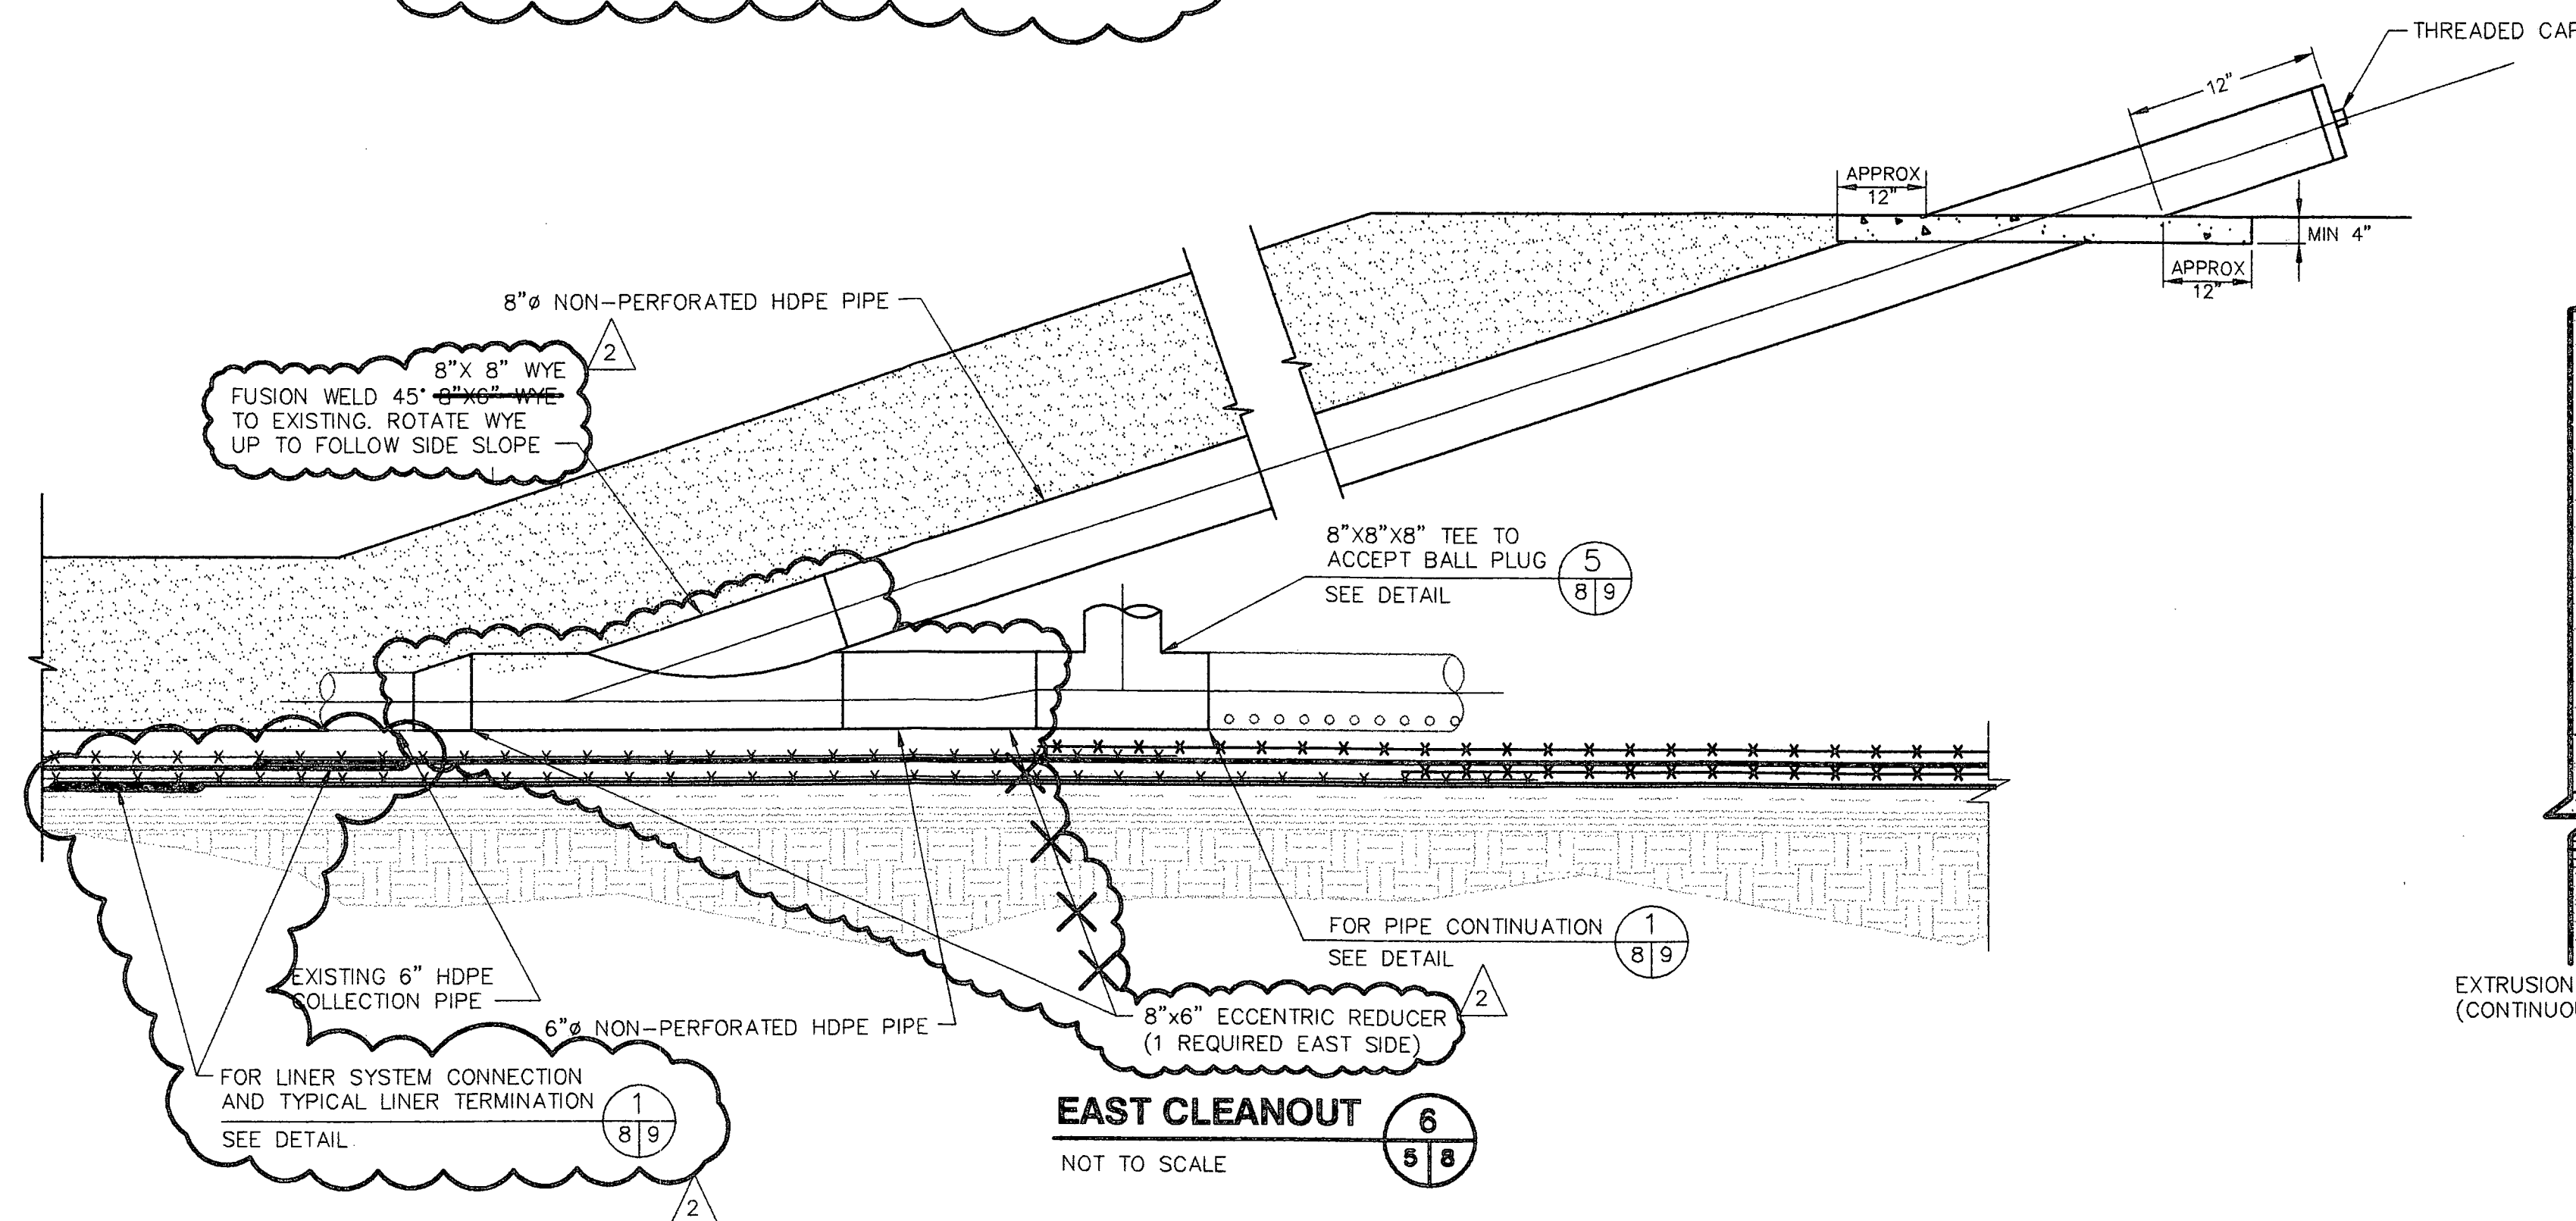**EAST CLEANOUT** 6


NOT TO SCALE

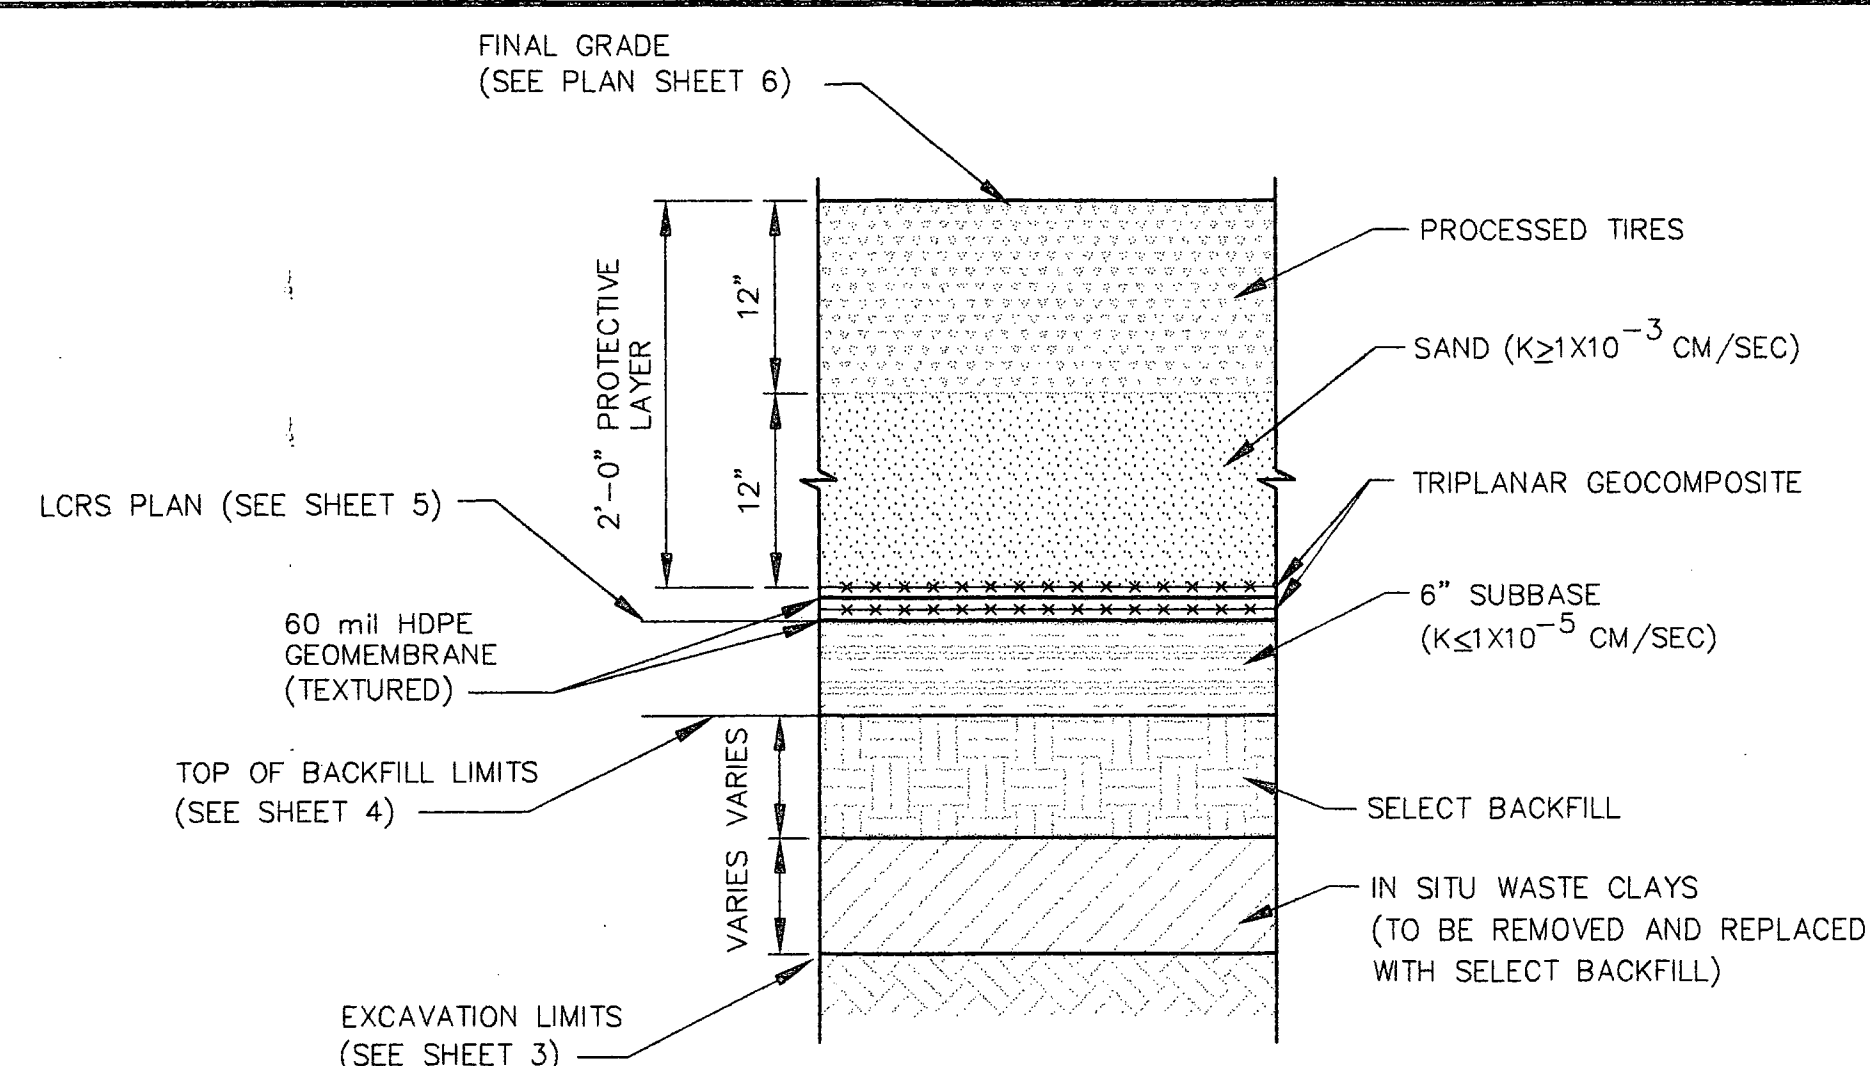**LINER SYSTEM DETAIL** 1

NOT TO SCALE

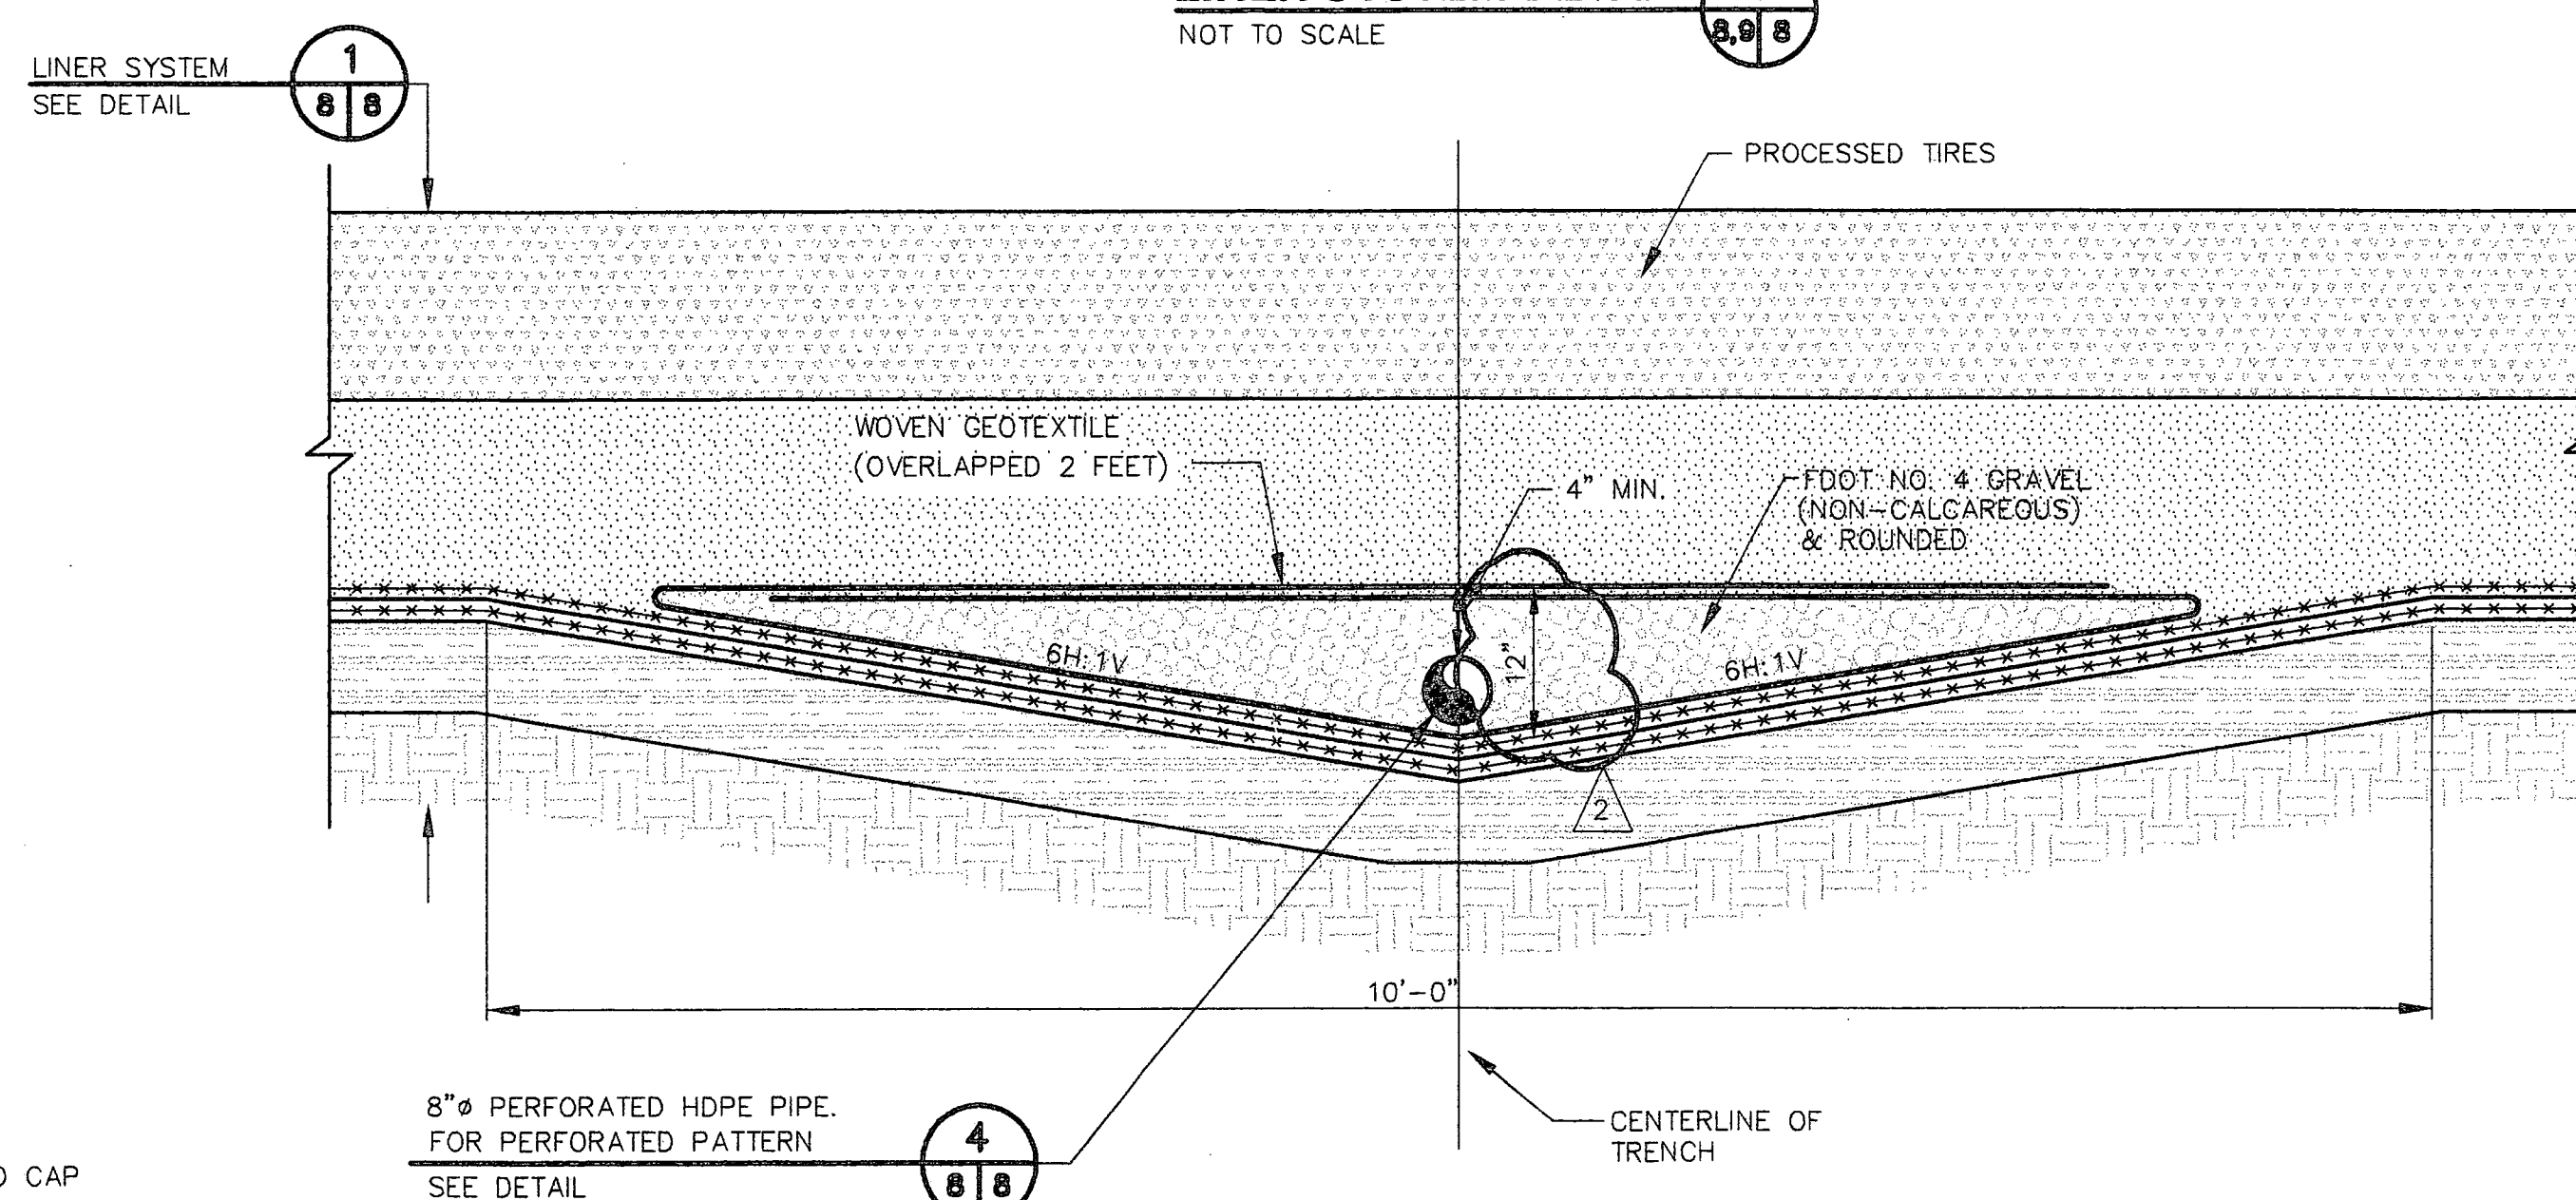**TYPICAL COLLECTION TRENCH DETAIL** 2

NOT TO SCALE

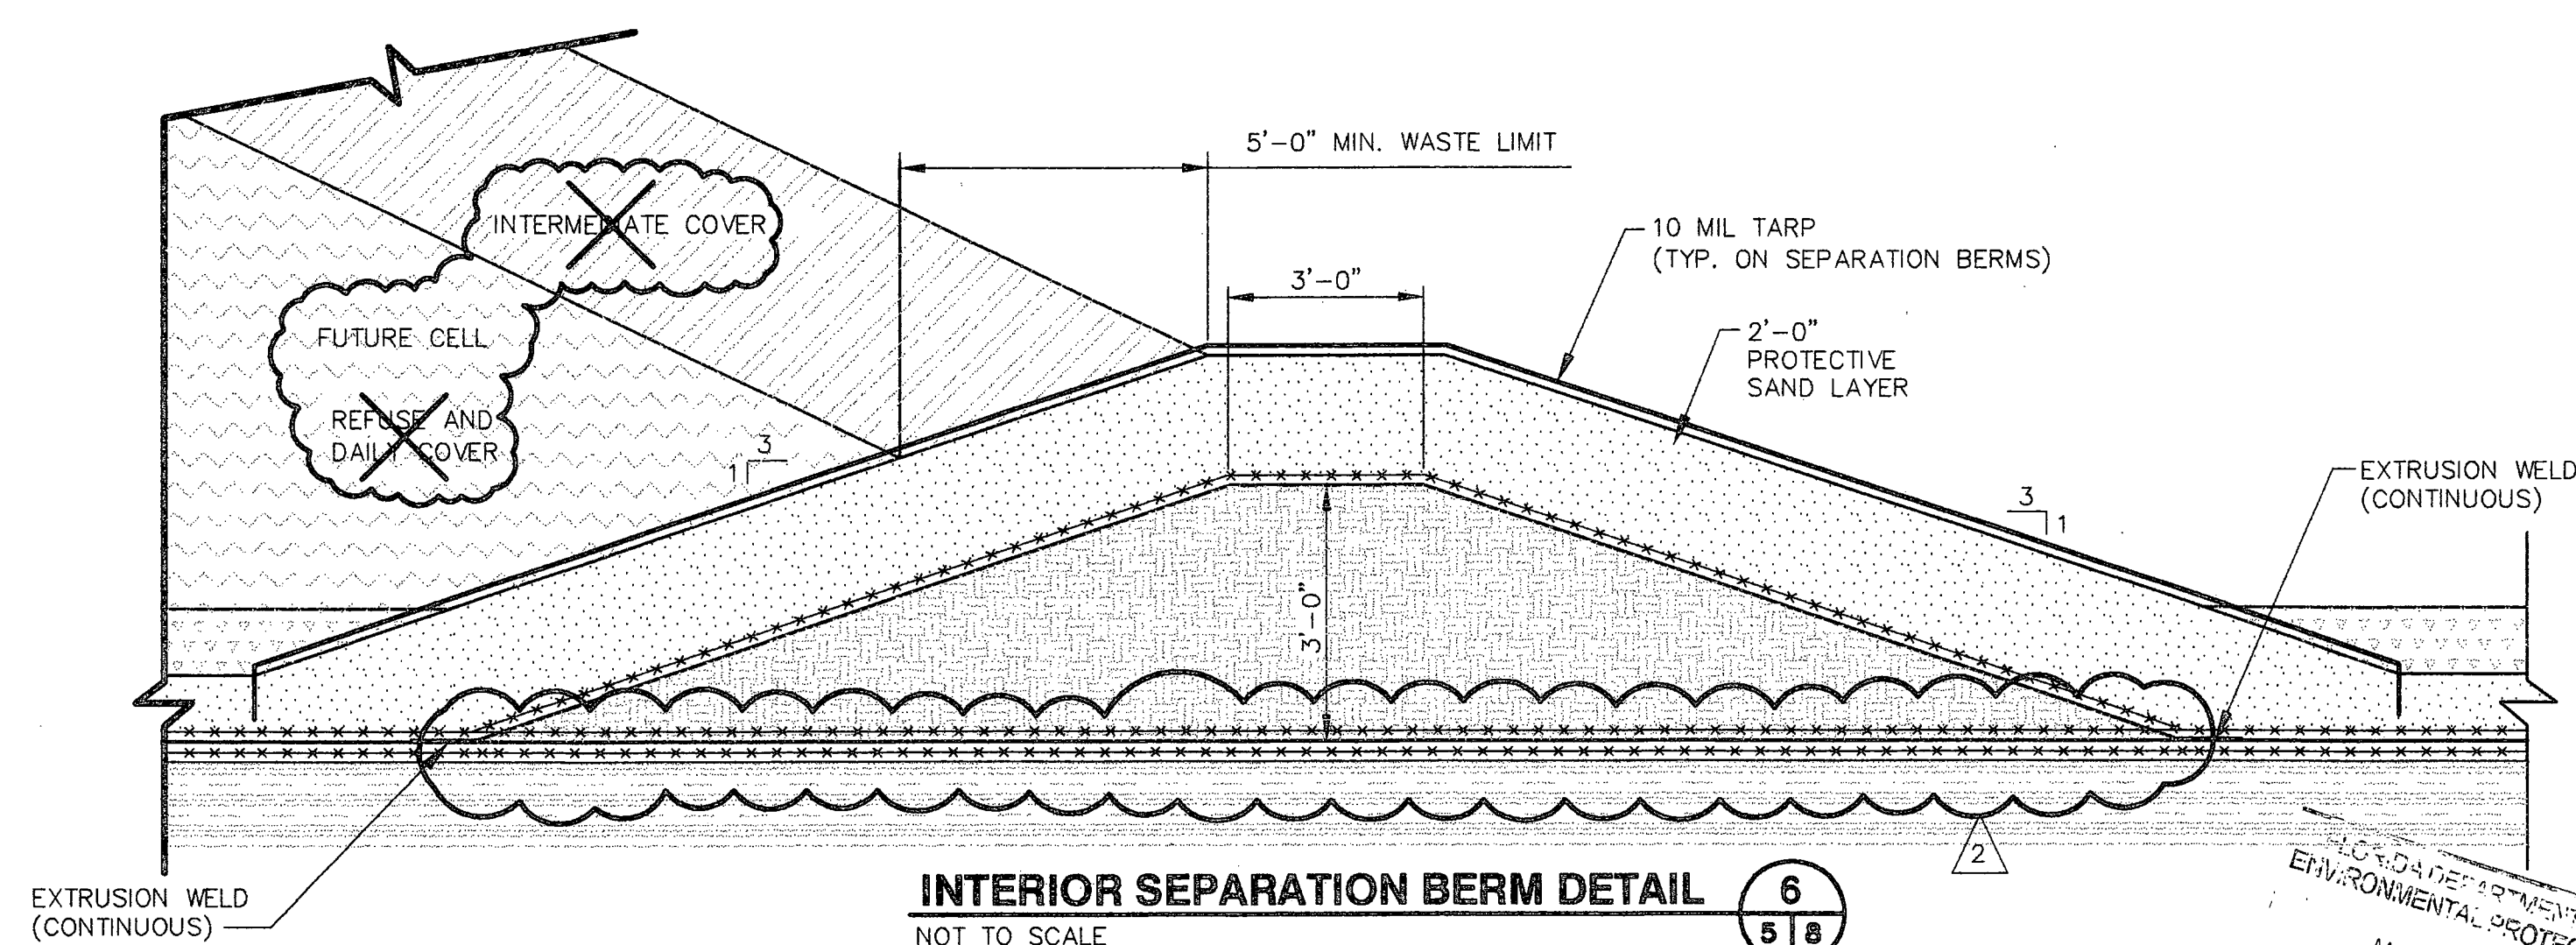**INTERIOR SEPARATION BERM DETAIL** 6

NOT TO SCALE

LTR.	DATE	REVISIONS	BY	APPROD.
1		SCS REVISIONS - NORTH SWALE MODIFIED		
2	2/28/06	EAST COLLECTION TRENCH DETAIL ADDED;		
		ADDITIONAL ROCK PLACED OVER PIPES;		
		8x8 WYE ADDED; GEOCOMPOSITE ADDED	JHV	JHO

DESIGNED	SCS ENGINEERS
DRAWN	GRD
CHECKED	JHO/JPA

JONES EDMUNDS
 730 NE WALDO ROAD, GAINESVILLE, FLORIDA 32641 / (352) 377-5821
 324 S HYDE PARK AVE, TAMPA, FLORIDA 33606 / (813) 258-0703







**HILLSBOROUGH COUNTY
 SOLID WASTE MANAGEMENT DEPARTMENT
 SOUTHEAST COUNTY LANDFILL**

**SECTION 8 CAPACITY EXPANSION
 DETAILS -1
 CONSTRUCTION DRAWINGS**

CERTIFICATE OF AUTHORIZATION 1814 APPROVED BY <i>Joseph H. O'Brien, P.E.</i> JOSEPH H. O'BRIEN, P.E. P.E. #052049, CORID 1814	DATE 2/28/06	PROJECT NO. 08449-020-01
SCALE AS SHOWN	DWG. NO. 8	

RECORD DRAWINGS

FLORIDA DEPARTMENT OF
 ENVIRONMENTAL PROTECTION
 MAR - 3 2006
 SOUTHWEST DISTRICT
 TAMPA

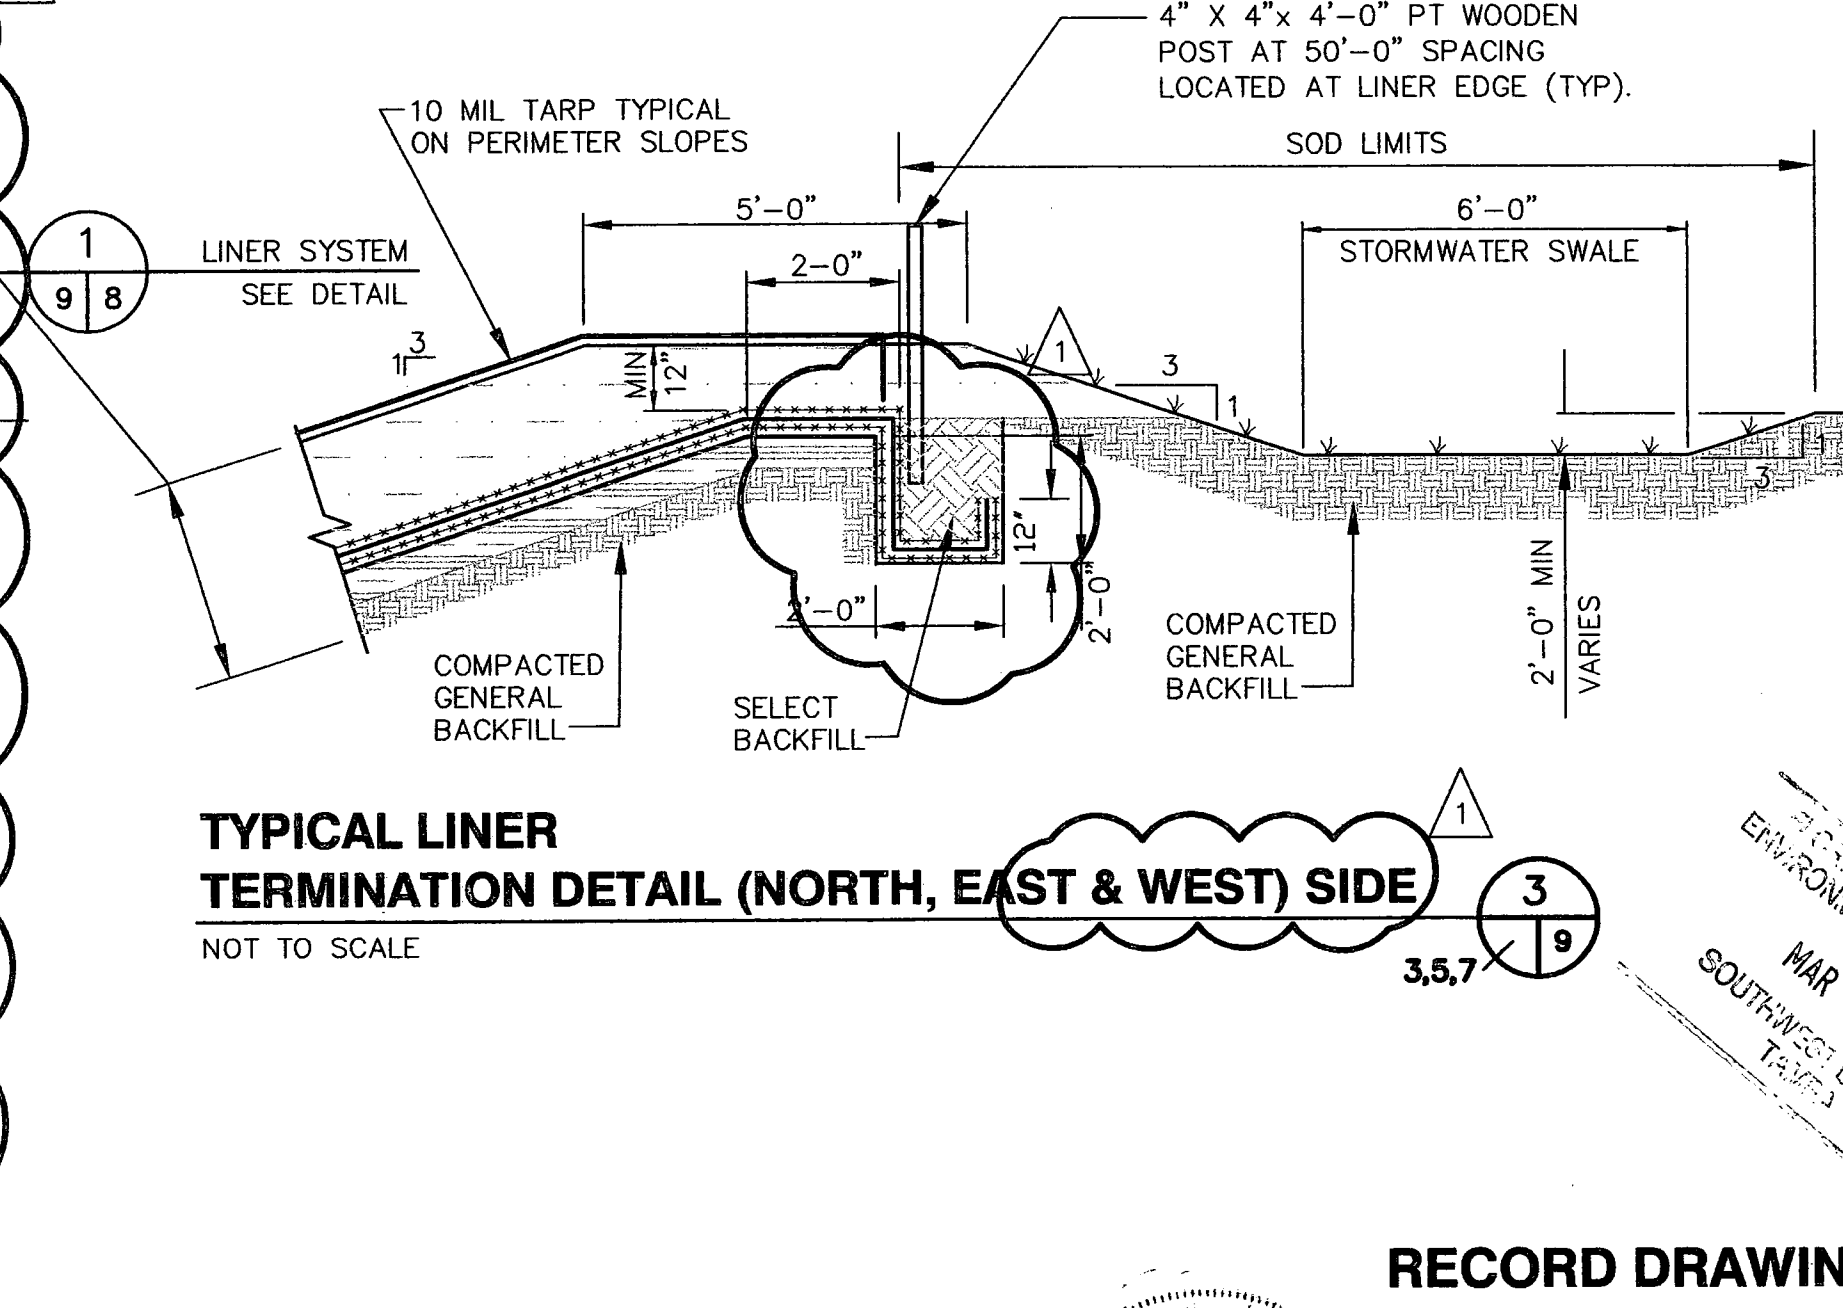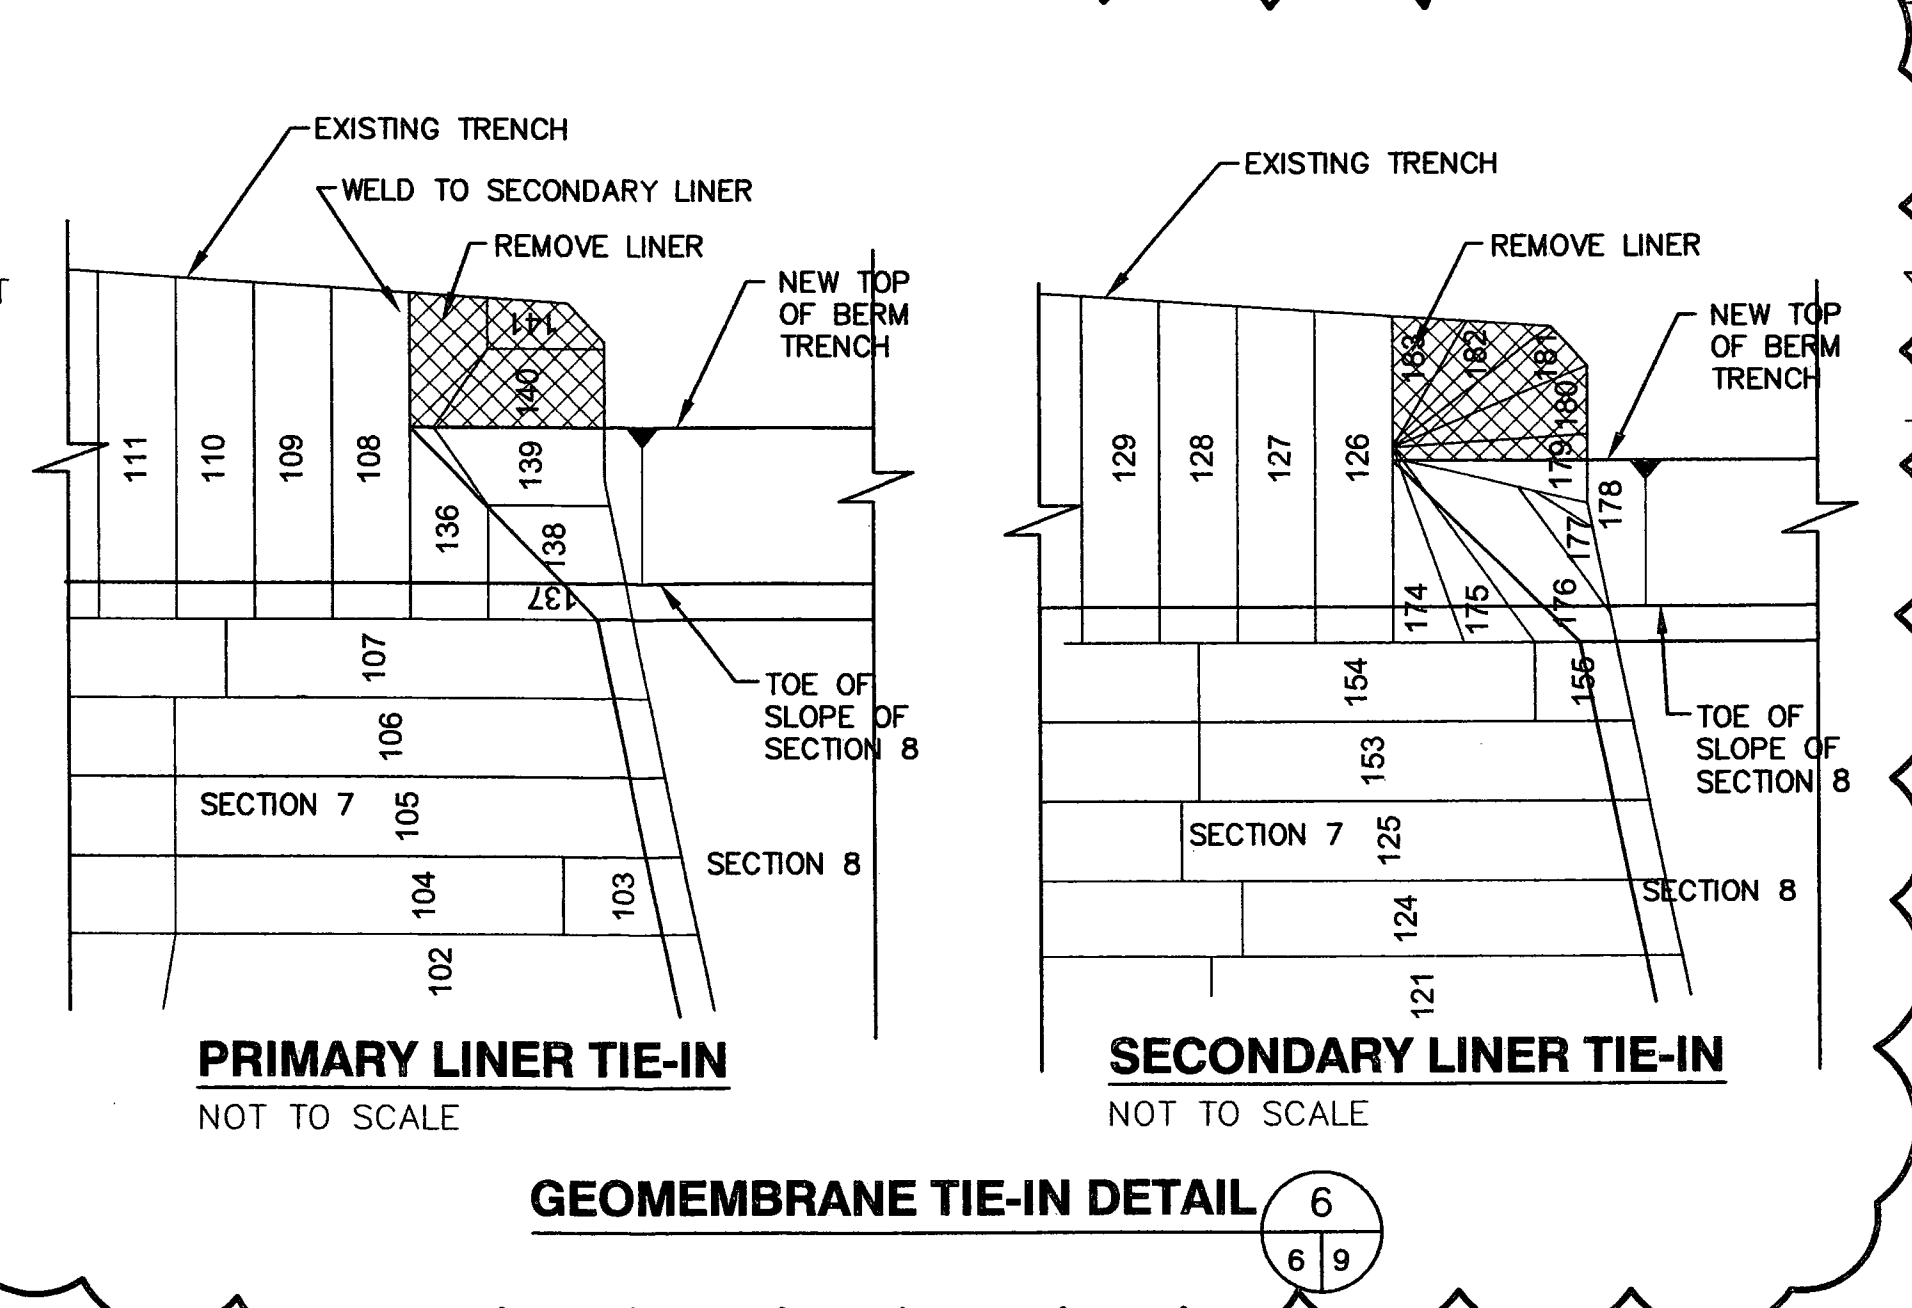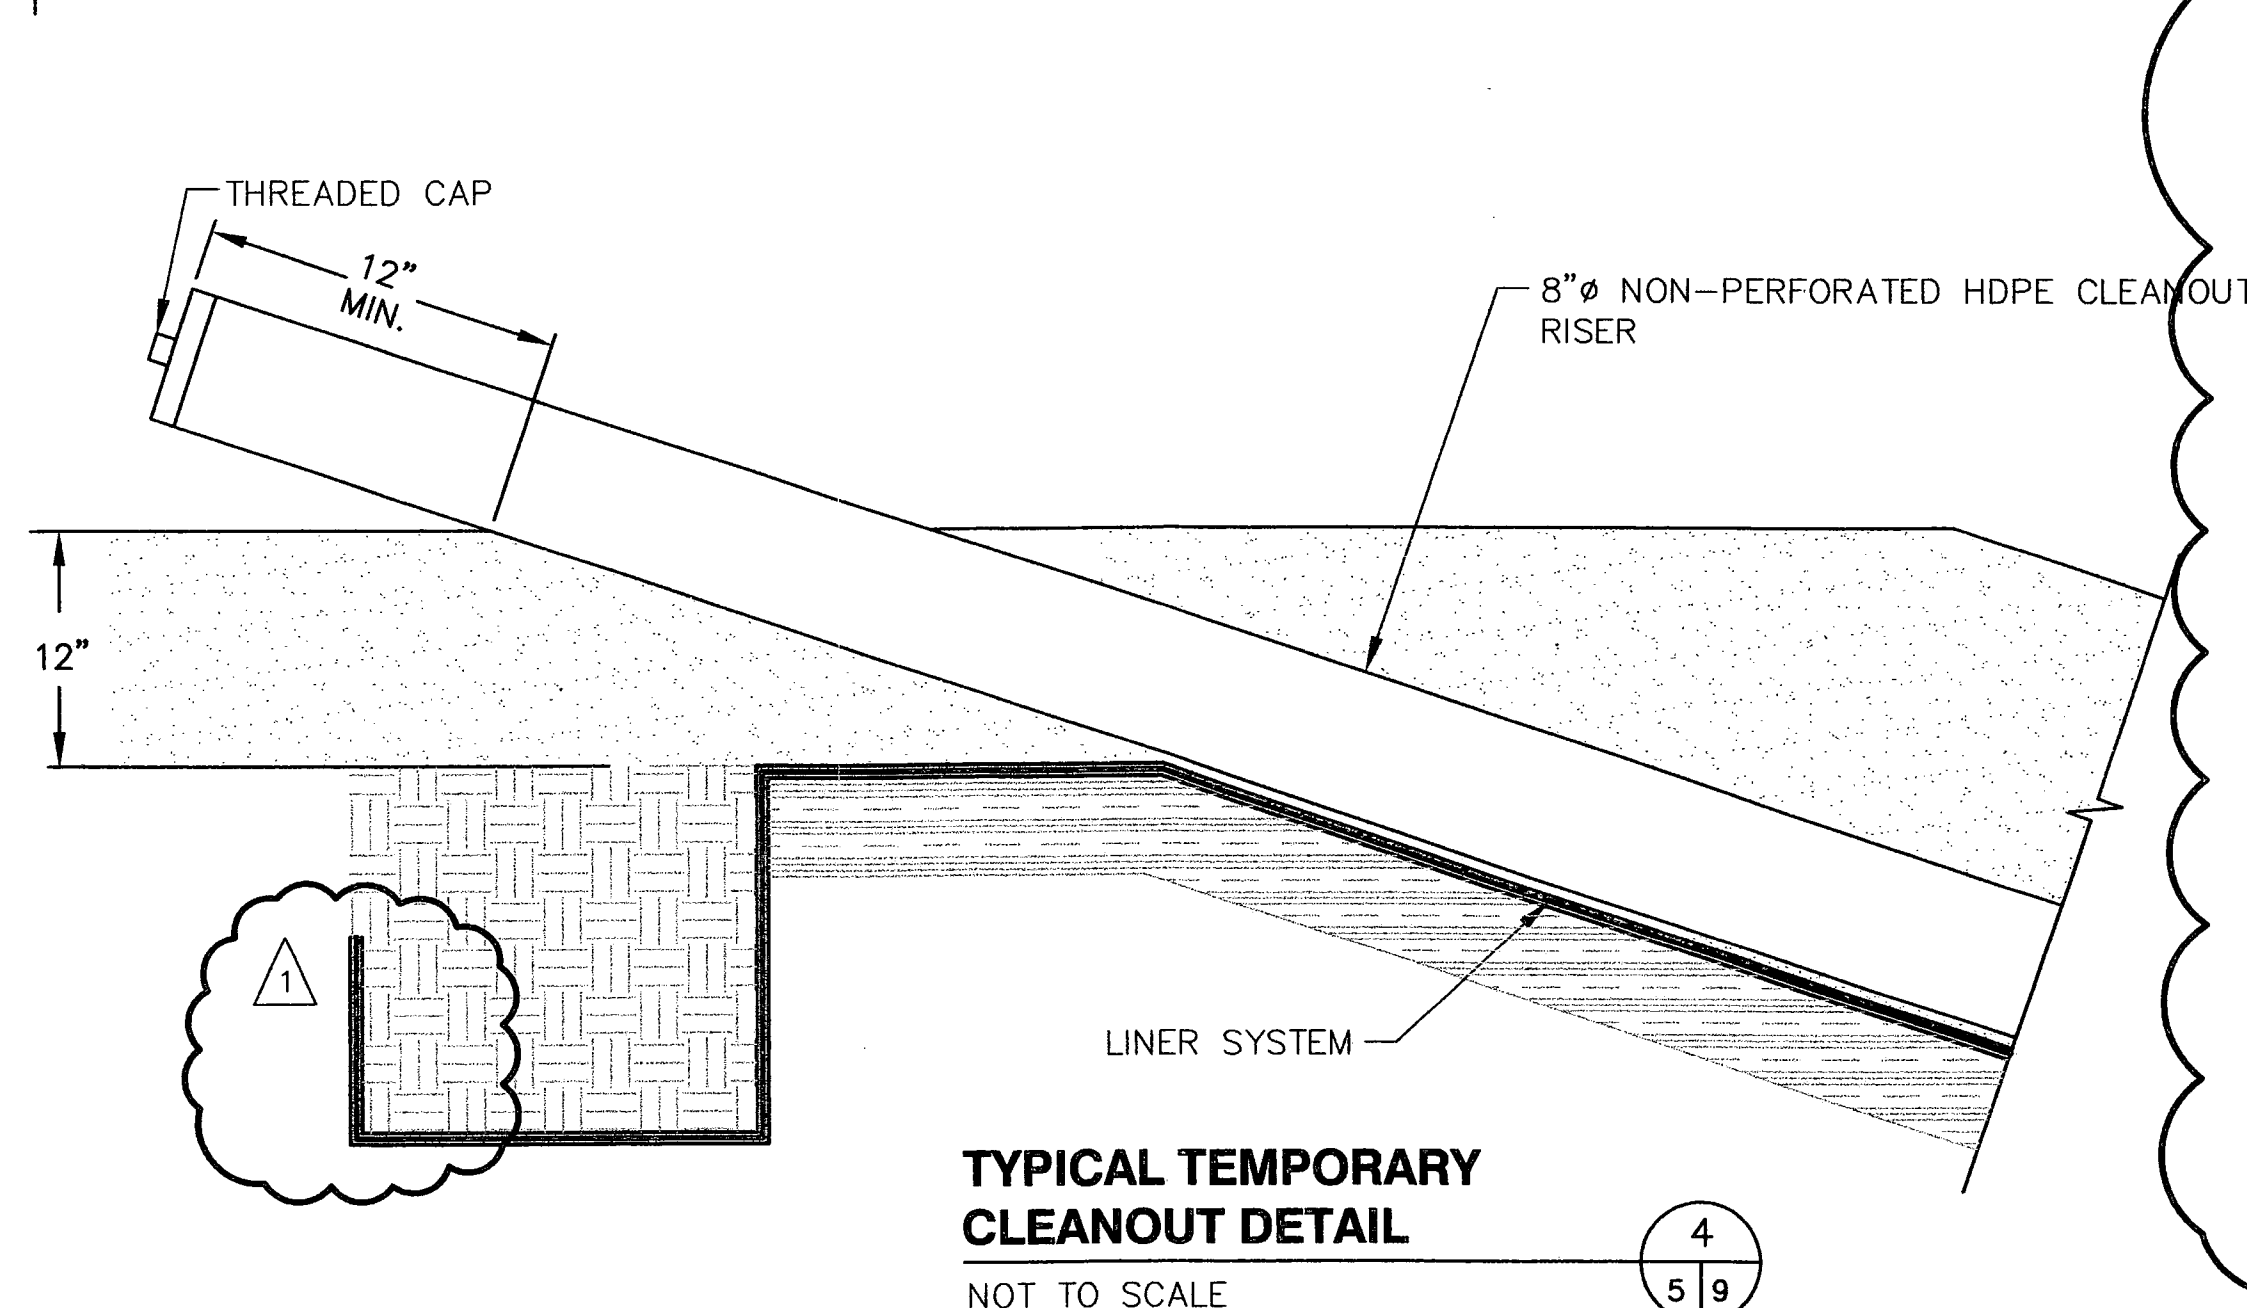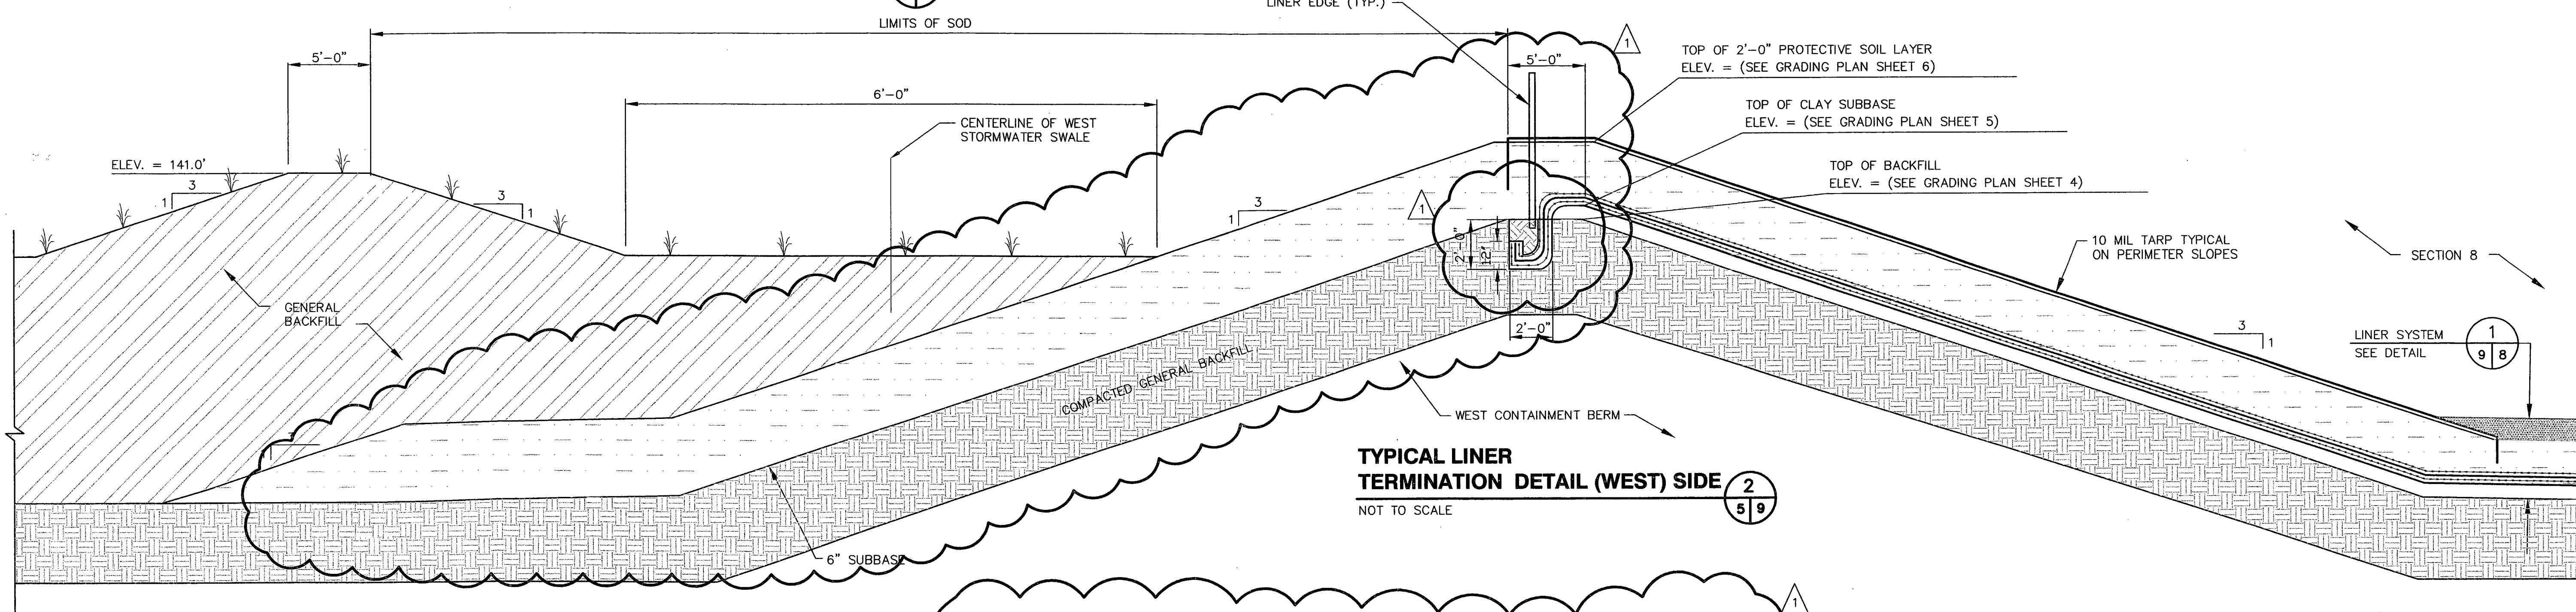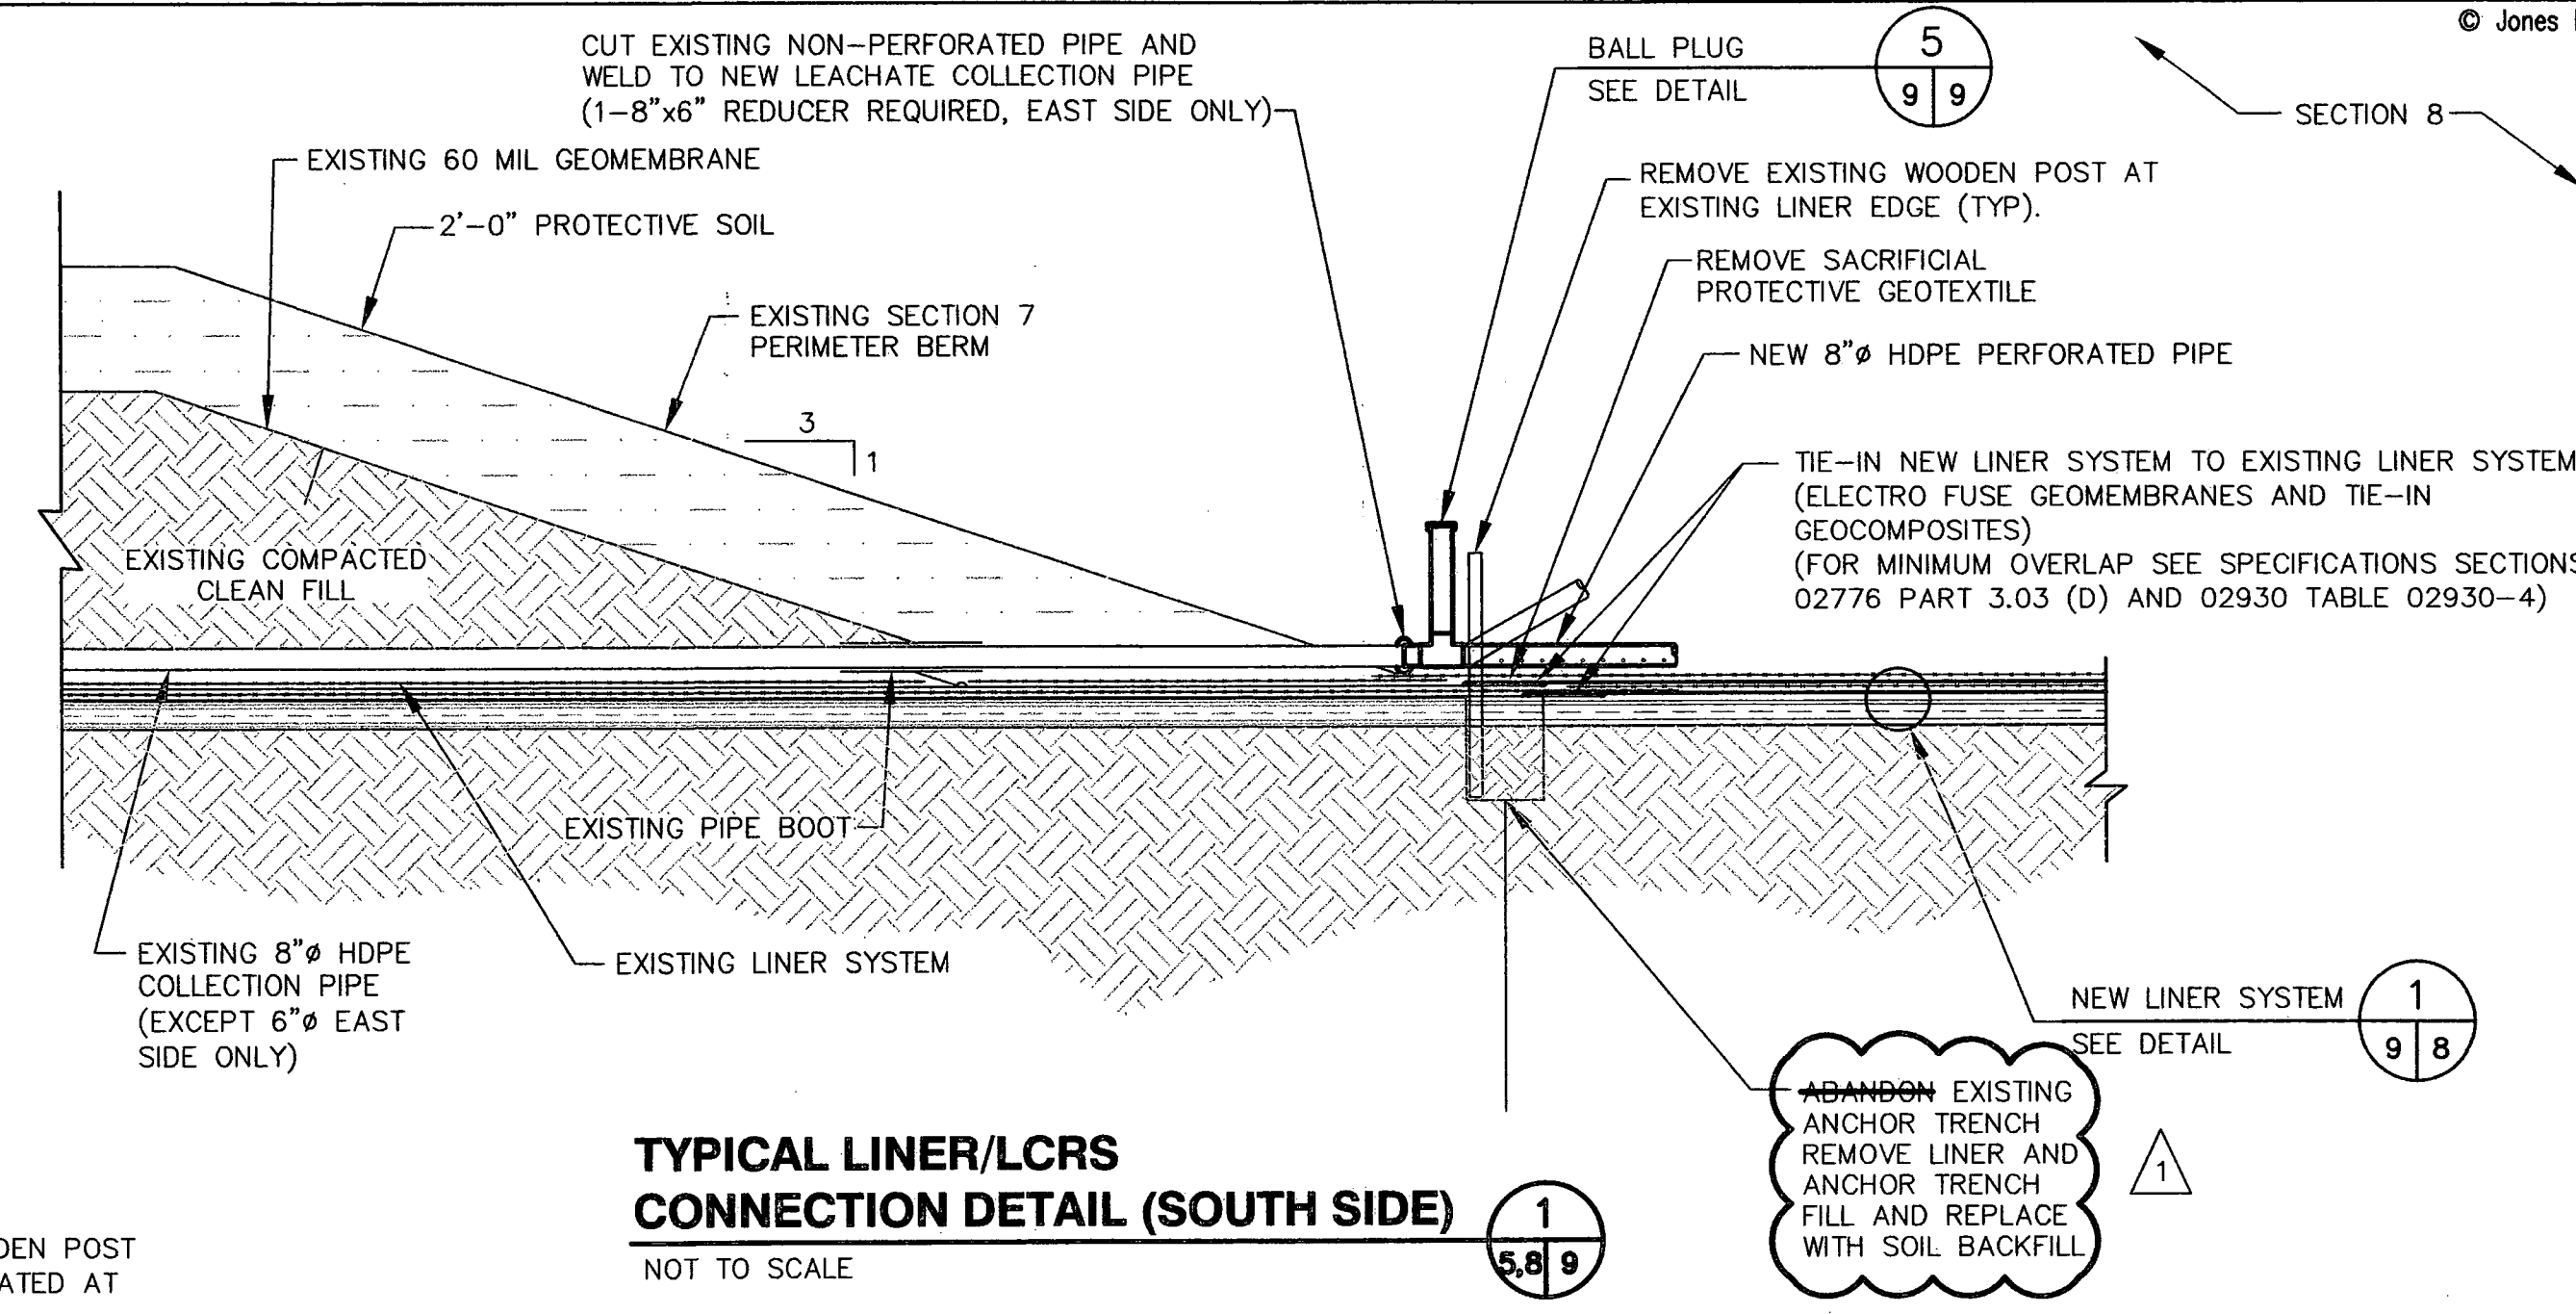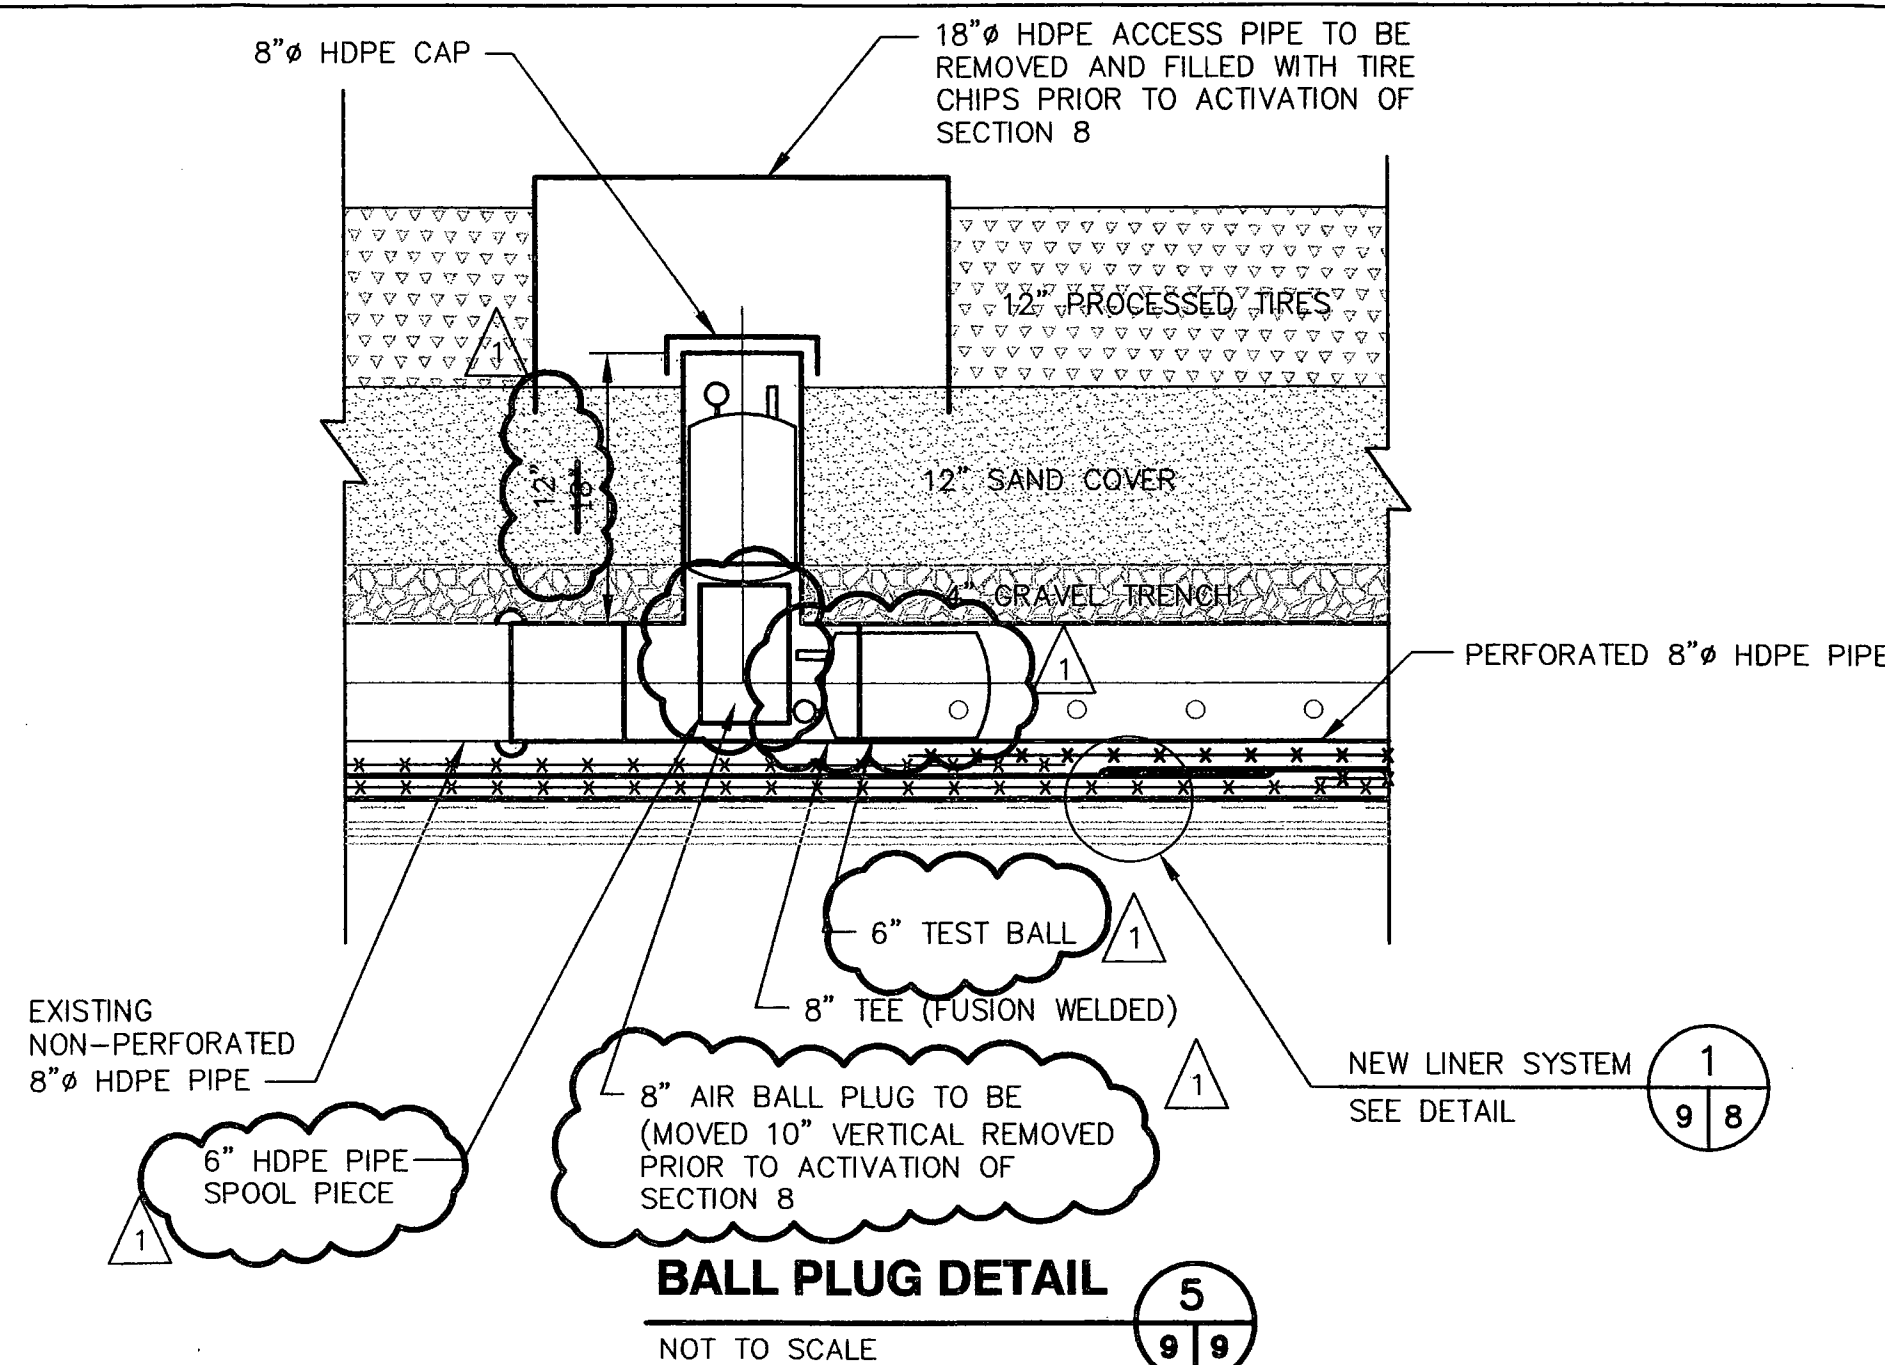

LTR.	DATE	REVISIONS	BY	APPRD.	CHECKED
1	2/28/06	PLUG VALVE PLACEMENT CHANGED; ADDITIONAL MATERIAL			
		ADDED TO ANCHOR TRENCH; GEOMEMBRANE REMOVED			
		FROM WEST BERM; EXCESS GEOMEMBRANE			
		REMOVED FROM SECTION 7	JHV	JHO	

JONES EDMUNDS
730 NE WALDO ROAD, GAINESVILLE, FLORIDA 32641 / (352) 377-5821
324 S HYDE PARK AVE, TAMPA, FLORIDA 33606 / (813) 258-0703

**HILLSBOROUGH COUNTY
SOLID WASTE MANAGEMENT DEPARTMENT
SOUTHEAST COUNTY LANDFILL**

**SECTION 8 CAPACITY EXPANSION
DETAILS - 2
CONSTRUCTION DRAWINGS**

RECORD DRAWINGS

CERTIFICATE OF AUTHORIZATION #1814 APPROVED BY JOSEPH H. O'NEILL P.E. P.E. #082049	DATE 2/28/06 SCALE AS SHOWN	PROJECT NO. 08449-020-01 DWG. NO. 9
---	--------------------------------------	--

SOUTHEAST COUNTY LANDFILL

SECTION 8

CAPACITY EXPANSION

CONSTRUCTION DRAWINGS

FEBRUARY 28, 2006


HILLSBOROUGH COUNTY

SOLID WASTE MANAGEMENT DEPARTMENT

TAMPA, FLORIDA

SECTION AND DETAIL DESIGNATION

DESIGNATION LETTER
INDICATES SECTION,
NUMBER INDICATES
DETAIL OR ELEVATION

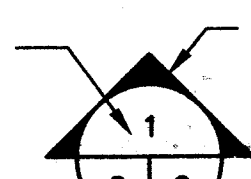

INDICATES DIRECTION
OF CUTTING PLANE

SHEET NUMBER WHERE
SECTION IS TAKEN


SHEET NUMBER WHERE
SECTION IS SHOWN

LEGEND

- SHEET FLOW DRAINAGE DIRECTION
- CONCENTRATED DRAINAGE FLOW DIRECTION
- FILL PROGRESSION
- DAILY PROGRESSION
- ZONE/PHASE BOUNDARY
- CENTERLINE OF SWALE
- CENTERLINE OF TEMPORARY SWALE
- EXISTING CONTOUR
- PROPOSED CONTOUR
- PROJECTED EXISTING CONTOUR
- REINFORCED CONCRETE PIPE
- DOWNCHUTE
- LIMITS OF EXCAVATION OF ORGANIC MATERIAL
- PROPERTY LINE
- FENCELINE
- LANDFILL GAS MONITORING WELL
- EXISTING POWER POLE
- EXISTING GROUNDWATER MONITORING WELL
- PROPOSED GROUNDWATER MONITORING WELL
- SOIL BORING
- VEGETATION


ABBREVIATIONS

- | | |
|---------|--------------------------------------|
| APPROX. | APPROXIMATE |
| CTRD | CENTERED |
| ERCP | ELLIPTICAL REINFORCED CONCRETE PIPE |
| ELEV. | ELEVATION |
| I.E. | INVERT ELEVATION |
| LF | LINEAR FEET |
| EXIST. | EXISTING |
| SCH. | SCHEDULE |
| TYP. | TYPICAL |
| Ø | DIAMETER |
| CONC. | CONCRETE |
| W/ | WITH |
| CMP | CORRUGATED METAL PIPE |
| MIN. | MINIMUM |
| MAX. | MAXIMUM |
| HDPE | HIGH DENSITY POLYETHYLENE |
| FDOT | FLORIDA DEPARTMENT OF TRANSPORTATION |
| NO. | NUMBER |

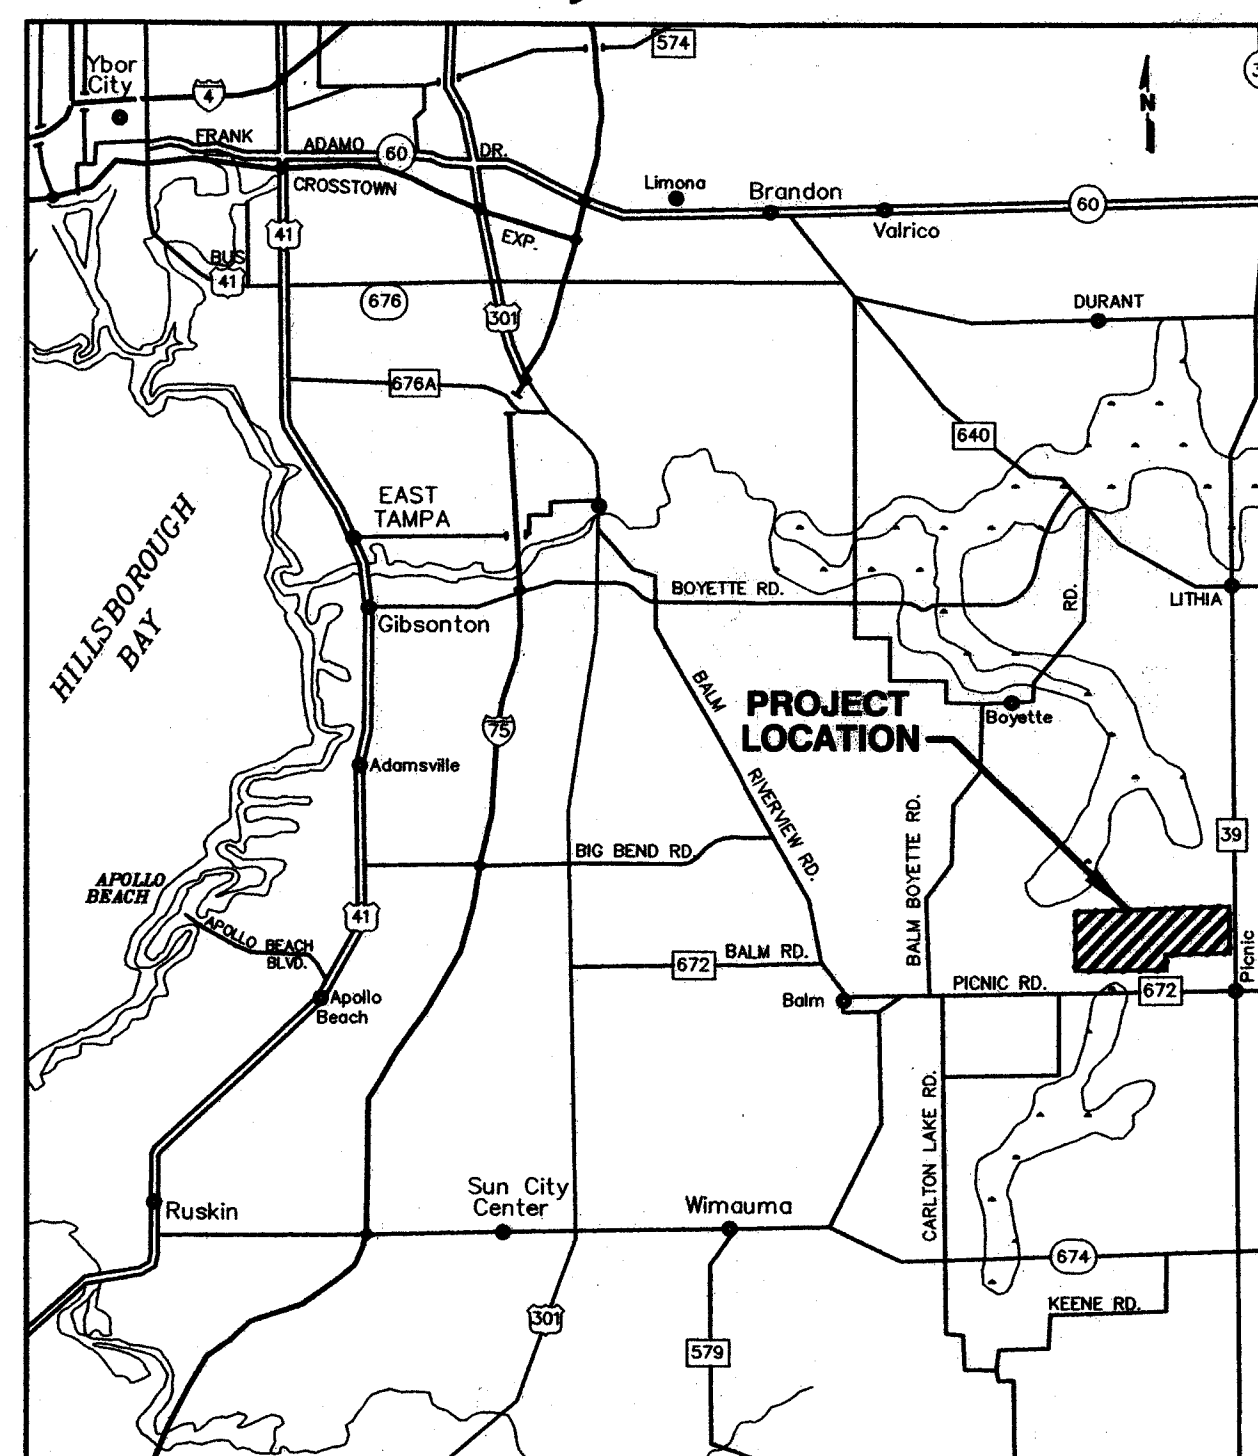

LOCATION MAP

JONES EDMUNDS
730 NE WALDO ROAD, GAINESVILLE, FLORIDA 32641 / (352) 377-5821
324 S HYDE PARK AVE, TAMPA, FLORIDA 33606 / (813) 258-0703

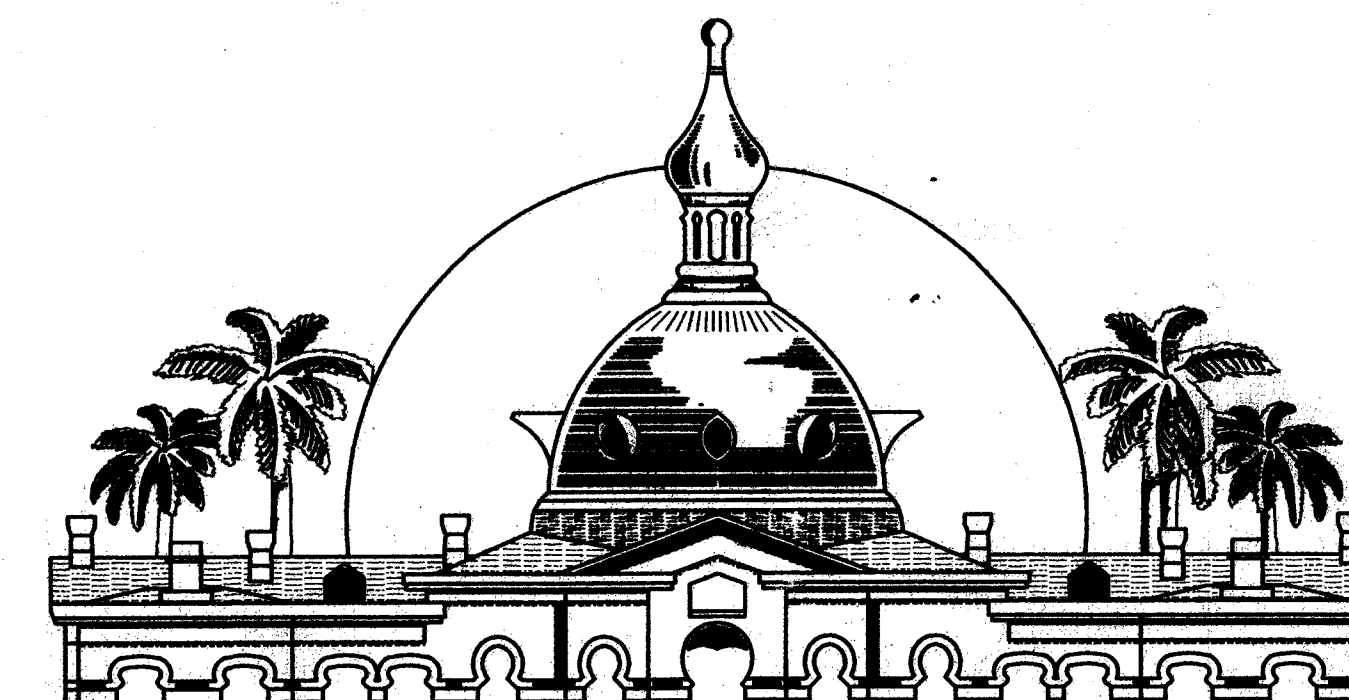





BOARD OF COUNTY COMMISSIONERS

KATHY CASTOR, Commissioner
KEN HAGAN, Commissioner
THOMAS SCOTT, Commissioner
RONDA STORMS, Commissioner
JIM NORMAN, Commissioner
PAT FRANK, Commissioner
JAN PLATT, Commissioner

DRAWING NO.	DRAWING TITLE
1	COVER SHEET
2	FACILITY SITE PLAN AND EXISTING TOPOGRAPHY
3	EXCAVATION PLAN
4	BACKFILL PLAN
5	LCRS GRADING PLAN (TOP OF CLAY SUBBASE)
6	TOP OF PROTECTIVE LAYER GRADING PLAN
7	SECTIONS AND SOIL BORING PROFILES
8	DETAILS - 1
9	DETAILS - 2

RECORD DRAWINGS



JONES EDMUNDS HAS PREPARED THESE RECORD DRAWINGS BASED UPON INFORMATION SUPPLIED BY THE CONTRACTOR DURING THE CONSTRUCTION OF THE PROJECT. THE ORIGINAL DESIGN DRAWINGS WERE PREPARED BY SCS ENGINEERS. JONES EDMUNDS REVIEW OF THE RECORD DRAWINGS INDICATES THAT THE CONSTRUCTION WAS COMPLETED AS PER THE ORIGINAL DESIGN.

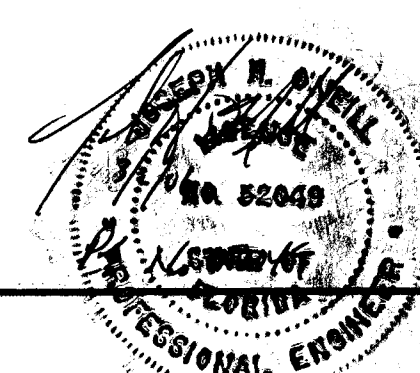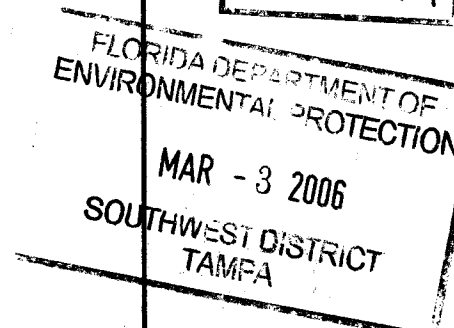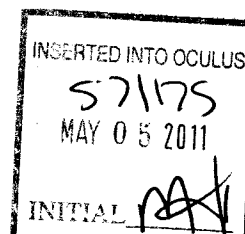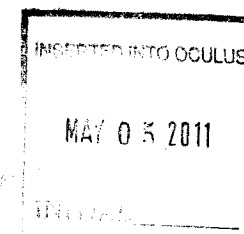

Plotted: 2/28/06 11:06am rdemint


\\Tpa-srv\Drafting\08449 Hillsborough County\020-SELF Section 8\Certification Drawings\0844902001-C-02-site1.DWG

Edited: 00/00/00 0:00 login

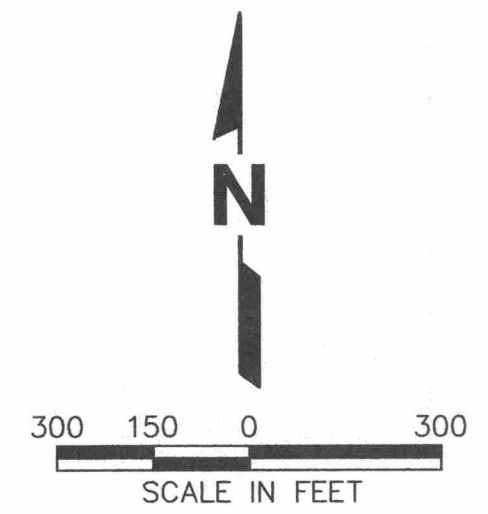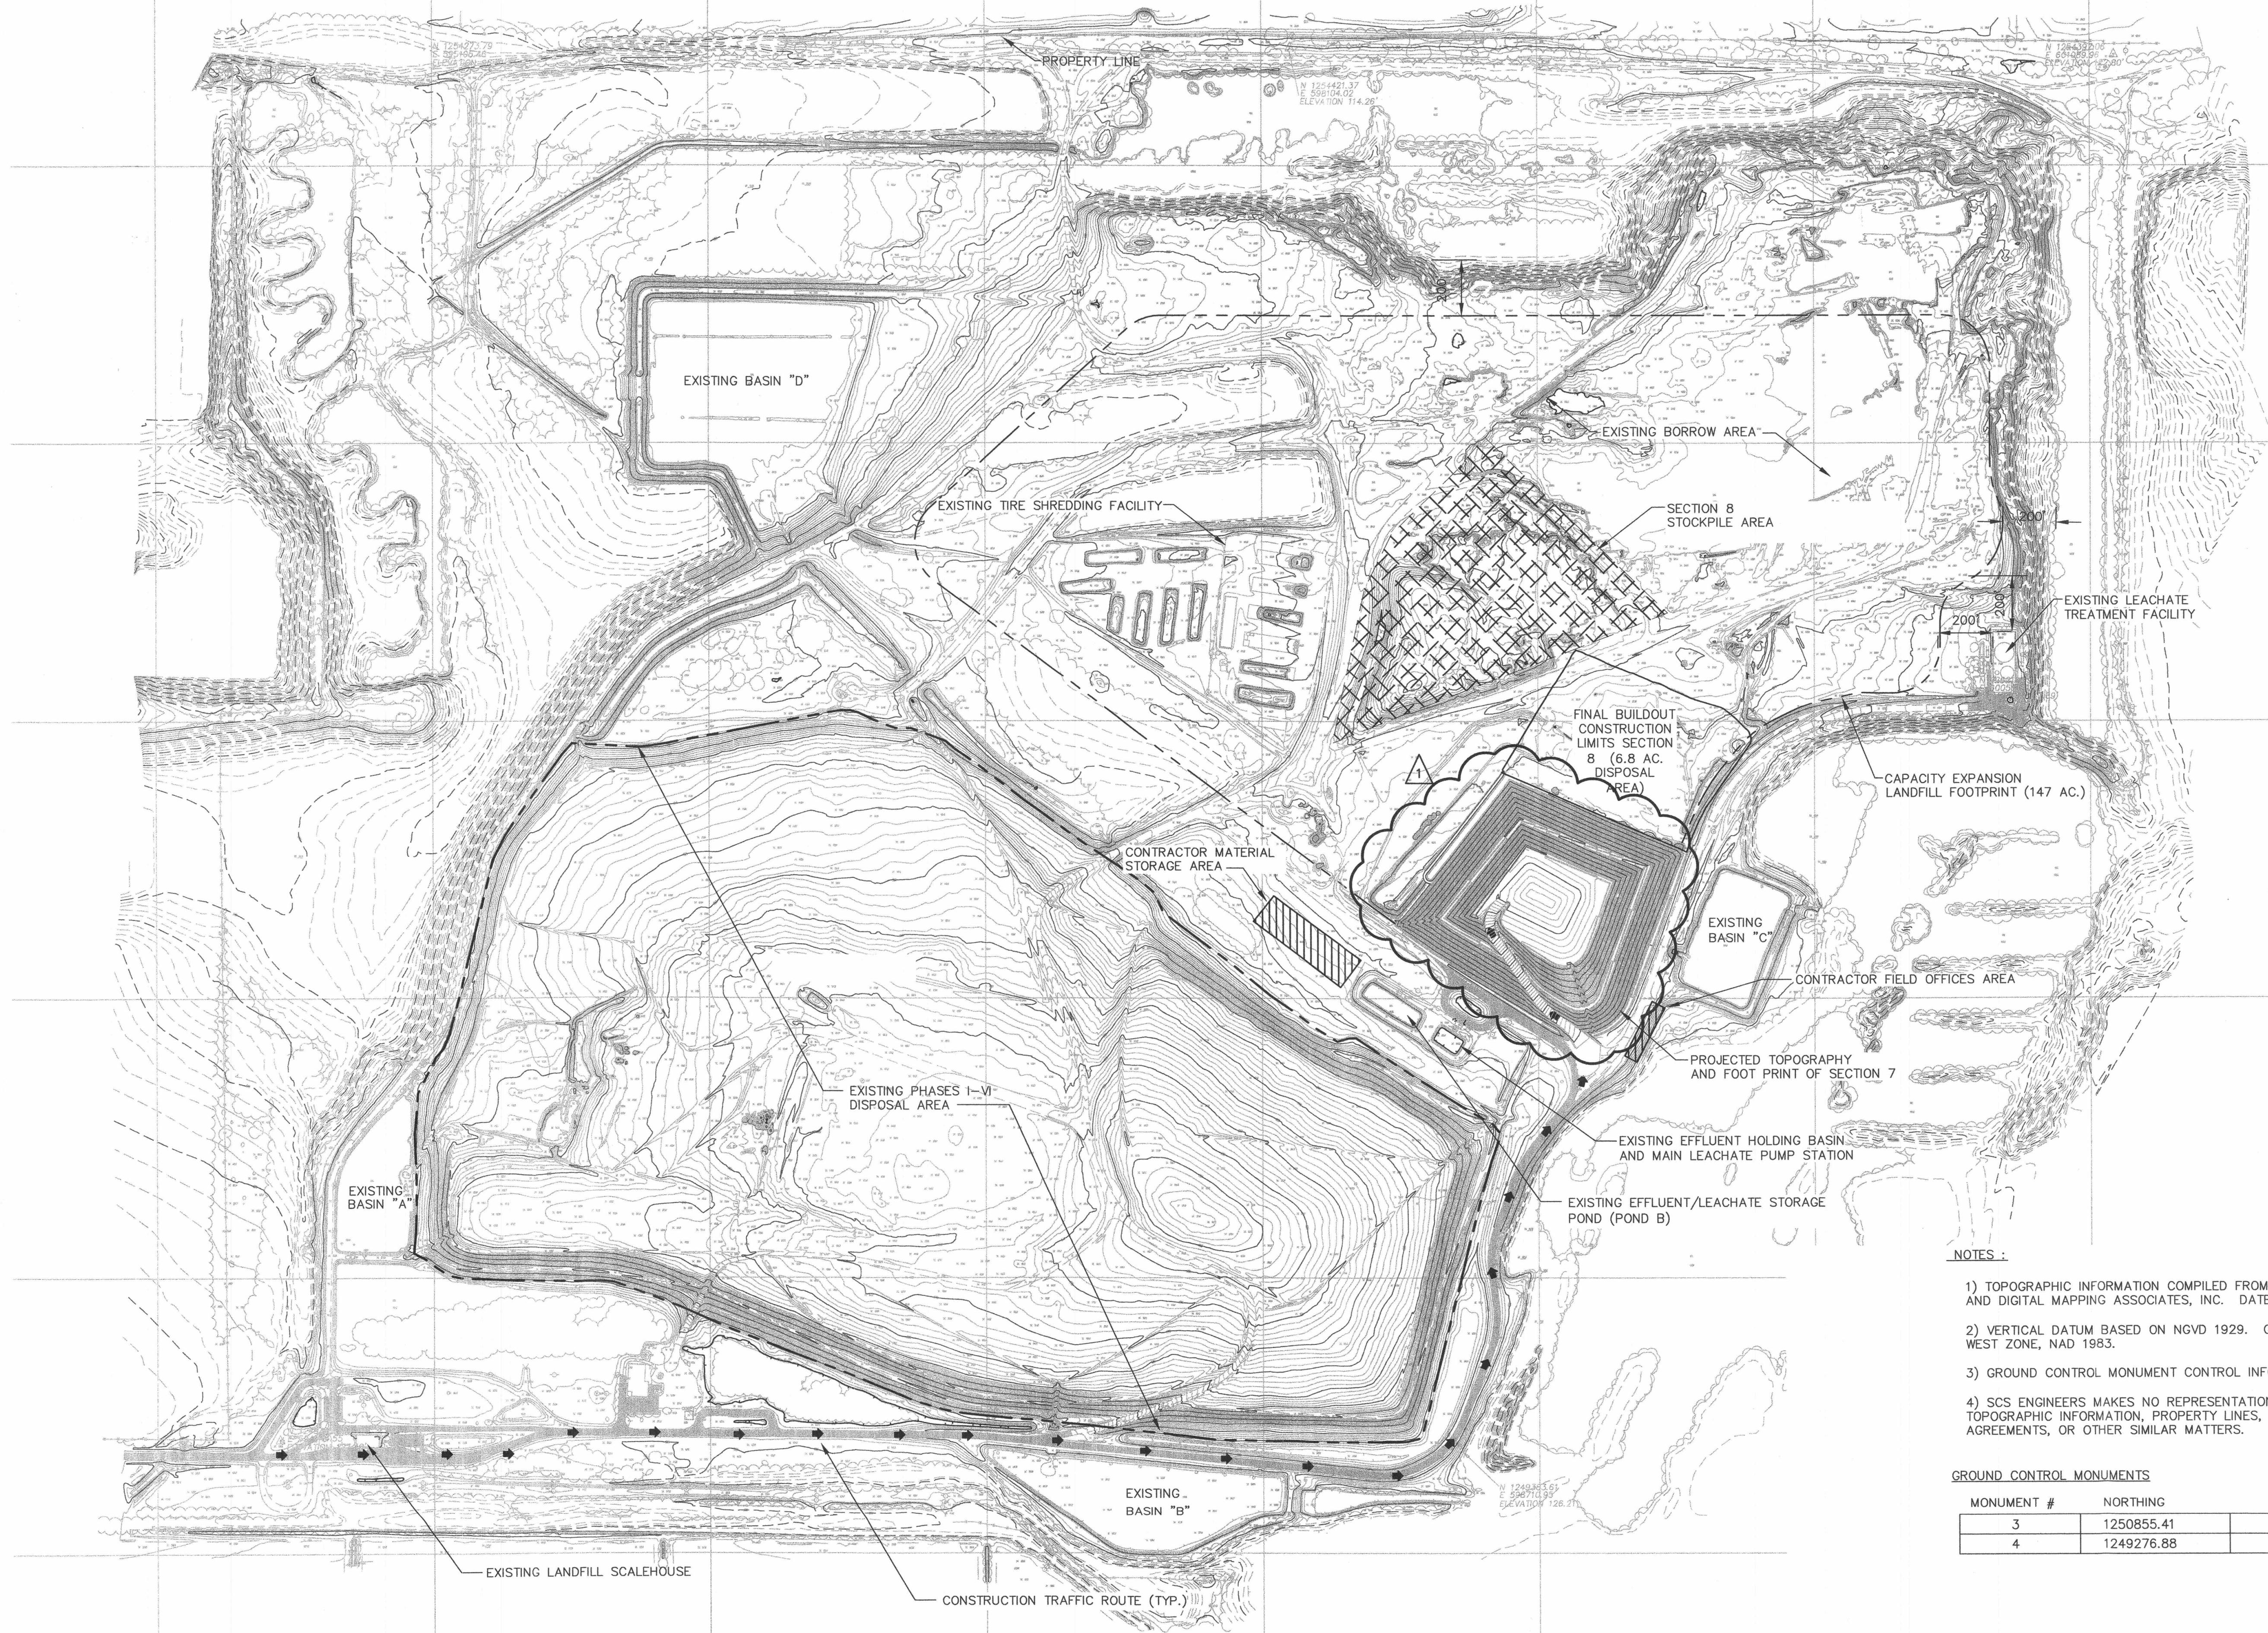

- NOTES:
- 1) TOPOGRAPHIC INFORMATION COMPILED FROM AERIAL PHOTOGRAPHY BY LANDAIR AERIAL SURVEYING AND DIGITAL MAPPING ASSOCIATES, INC. DATE OF AERIAL PHOTOGRAPHY JULY 7, 2002.
 - 2) VERTICAL DATUM BASED ON NGVD 1929. GRID BASED ON FLORIDA STATE PLANE COORDINATE SYSTEM, WEST ZONE, NAD 1983.
 - 3) GROUND CONTROL MONUMENT CONTROL INFORMATION PROVIDED BY RED MAN CONSULTANTS INC.
 - 4) SCS ENGINEERS MAKES NO REPRESENTATION OR GUARANTEES PERTAINING TO THE ACCURACY OF TOPOGRAPHIC INFORMATION, PROPERTY LINES, EASEMENTS, RIGHT-OF-WAYS, SETBACKS, RESERVATIONS, AGREEMENTS, OR OTHER SIMILAR MATTERS.

GROUND CONTROL MONUMENTS			
MONUMENT #	NORTHING	EASTING	ELEV.
3	1250855.41	598998.83	137.56
4	1249276.88	598535.88	129.88

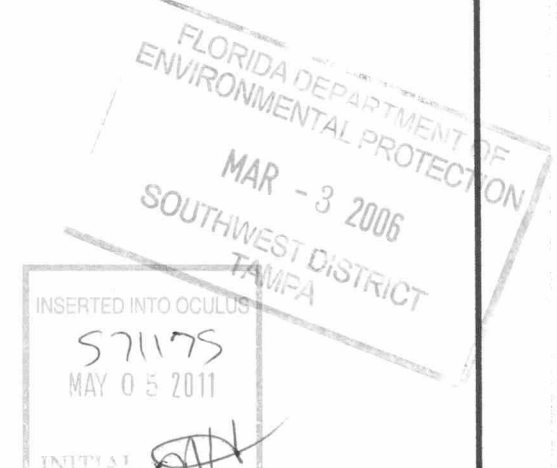

1		2/28/06	RECORD DRAWING ADDITIONS / REVISIONS	JHV	JHO
LTR.	DATE	REVISIONS		BY	APPRD.

DESIGNED SCS ENGINEERS
DRAWN GRD
CHECKED JHO/JPA


JONES EDMUNDS
730 NE WALDO ROAD, GAINESVILLE, FLORIDA 32641 / (352) 377-5821
324 S HYDE PARK AVE, TAMPA, FLORIDA 33606 / (813) 258-0703

HILLSBOROUGH COUNTY
SOLID WASTE MANAGEMENT DEPARTMENT
SOUTHEAST COUNTY LANDFILL

SECTION 8 CAPACITY EXPANSION
FACILITY SITE PLAN & EXISTING TOPOGRAPHY
CONSTRUCTION DRAWINGS

CERTIFICATE OF AUTHORIZATION #1814
APPROVED BY: [Signature]
DATE: 2/28/06
P.E. # 052049

RECORD DRAWINGS	
DATE	PROJECT NO.
2/28/06	08449-020-01
SCALE	DWG. NO.
AS SHOWN	2

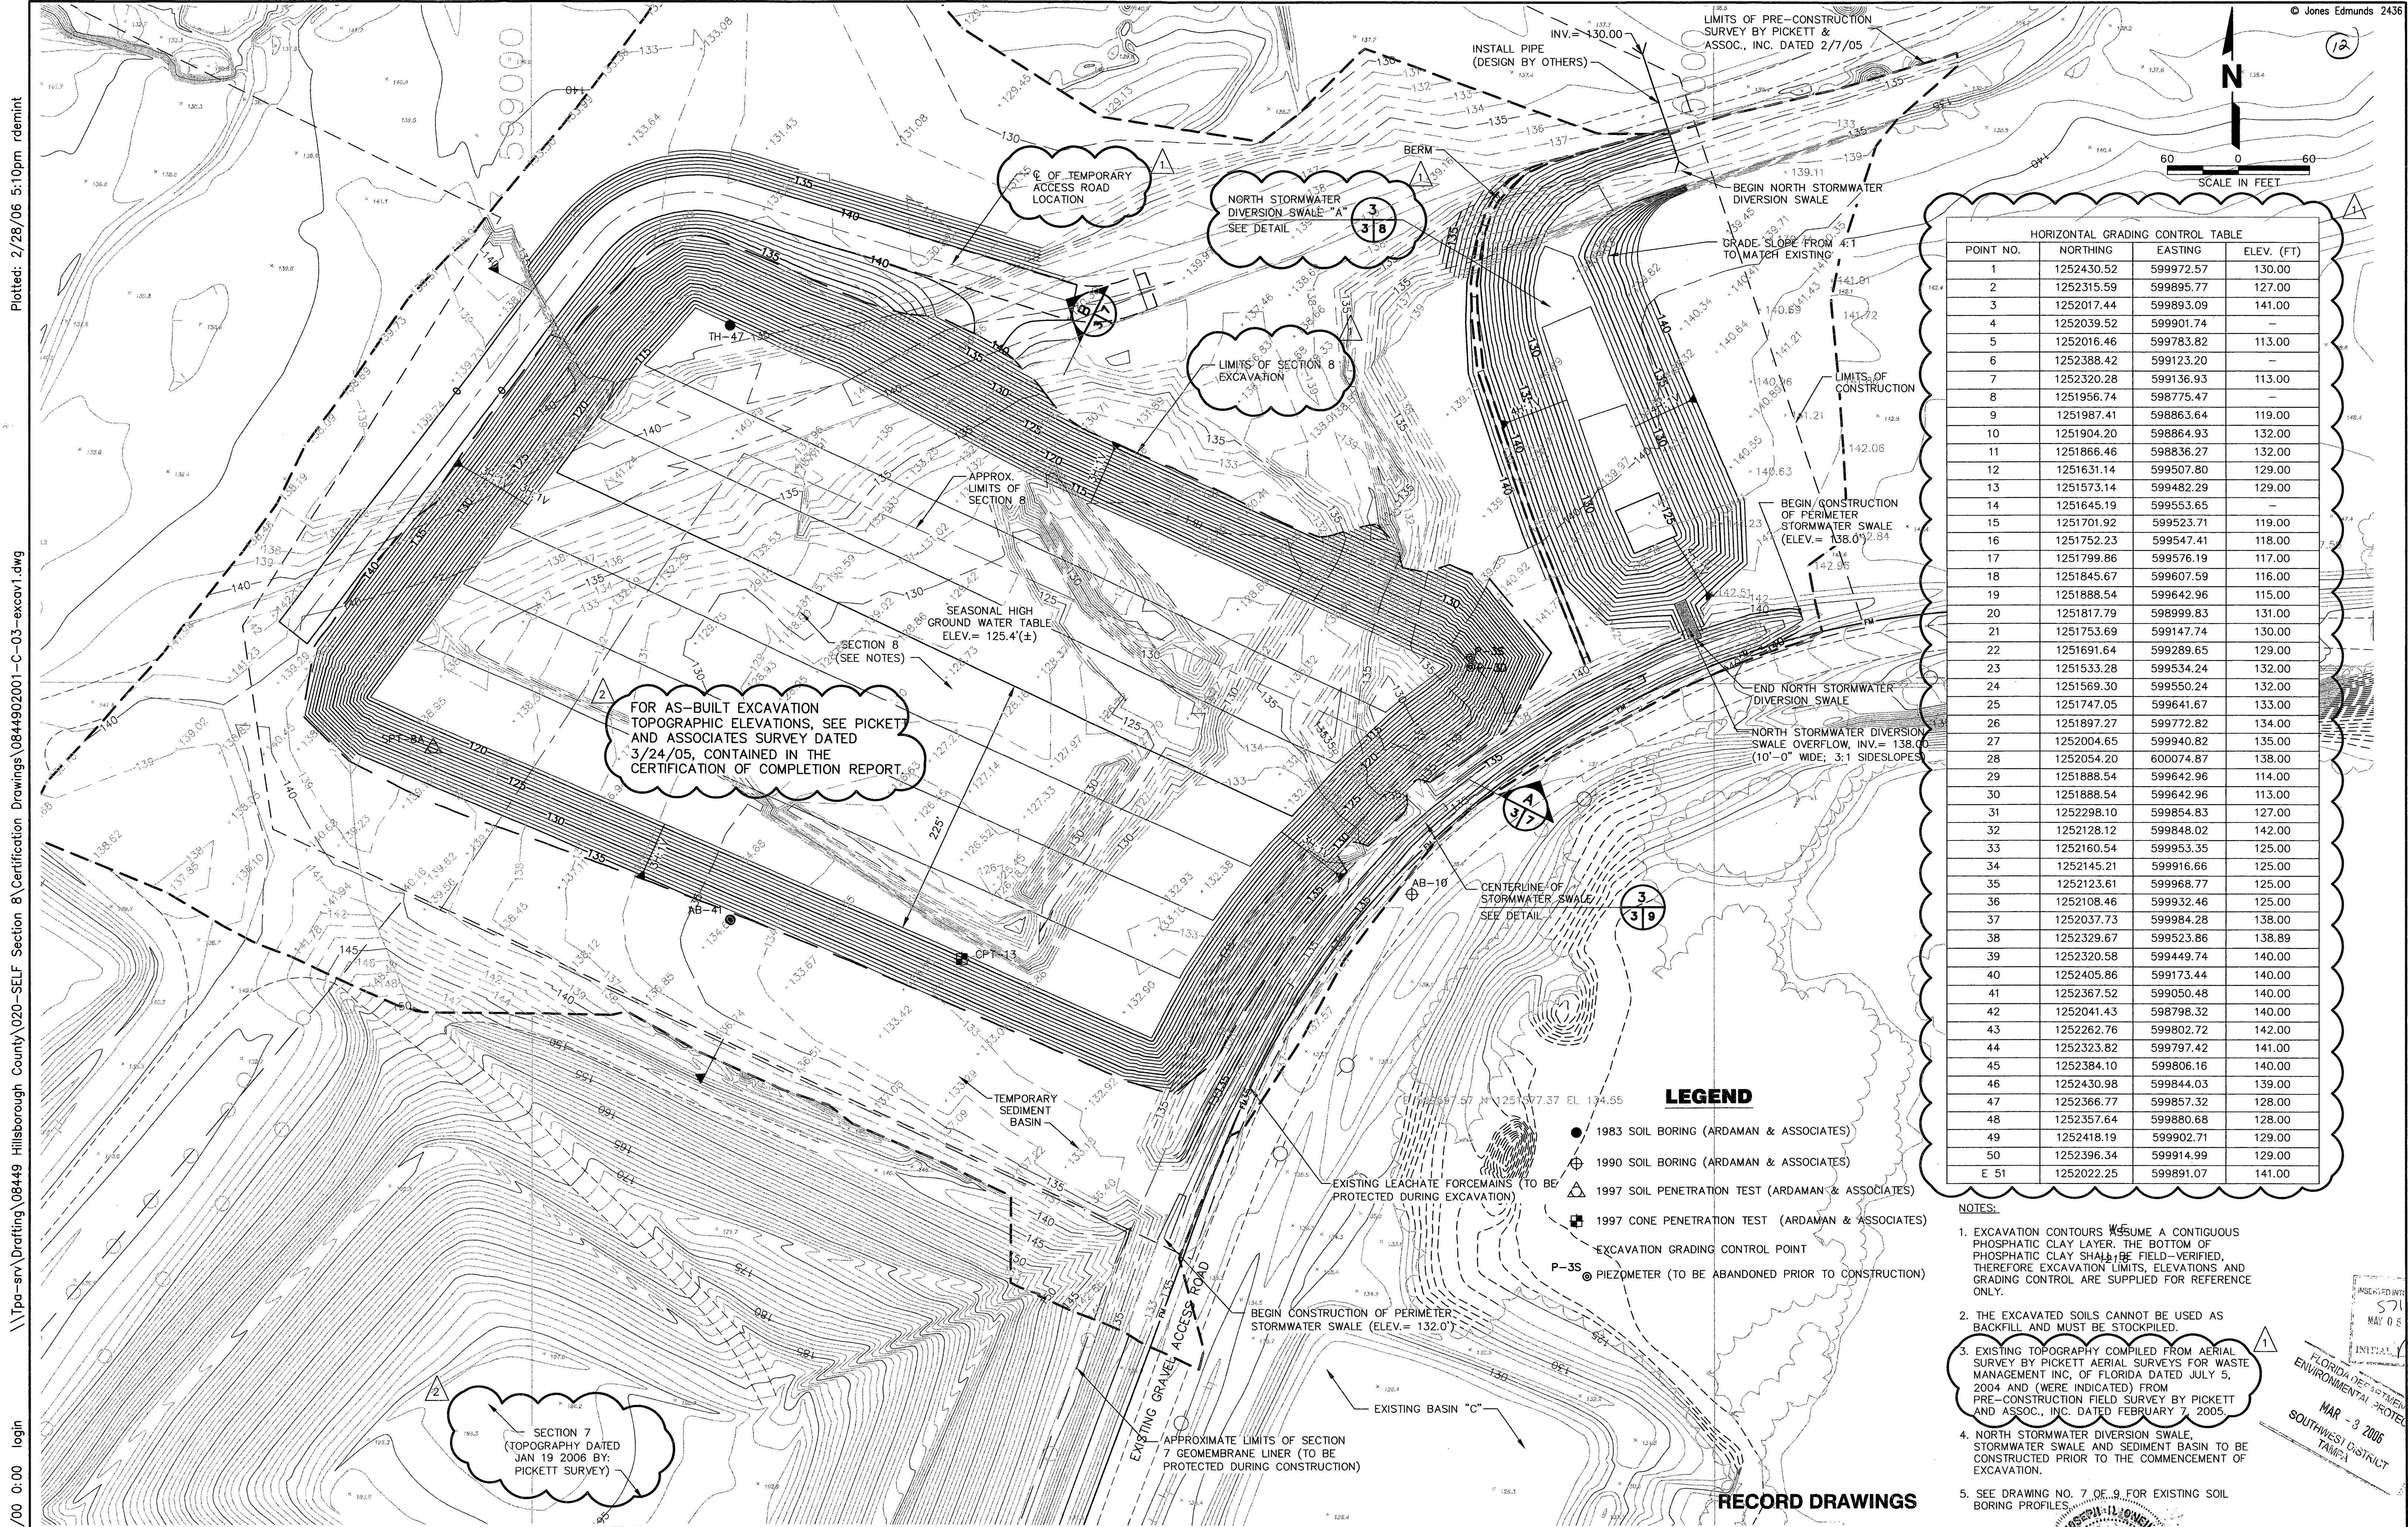

HORIZONTAL GRADING CONTROL TABLE			
POINT NO.	NORTHING	EASTING	ELEV. (FT)
1	1252430.52	599972.57	130.00
2	1252315.59	599895.77	127.00
3	1252017.44	599893.09	141.00
4	1252039.52	599901.74	-
5	1252016.46	599783.82	113.00
6	1252388.42	599123.20	-
7	1252320.28	599136.93	113.00
8	1251956.74	598775.47	-
9	1251987.41	598863.64	119.00
10	1251904.20	598864.93	132.00
11	1251866.46	598836.27	132.00
12	1251631.14	599507.80	129.00
13	1251573.14	599482.29	129.00
14	1251645.19	599553.65	-
15	1251701.92	599523.71	119.00
16	1251752.23	599547.41	118.00
17	1251799.86	599576.19	117.00
18	1251845.67	599607.59	116.00
19	1251888.54	599642.96	115.00
20	1251817.79	598999.83	131.00
21	1251753.69	599147.74	130.00
22	1251691.64	599289.65	129.00
23	1251533.28	599534.24	132.00
24	1251569.30	599550.24	132.00
25	1251747.05	599641.67	133.00
26	1251897.27	599772.82	134.00
27	1252004.65	599940.82	135.00
28	1252054.20	600074.87	138.00
29	1251888.54	599642.96	114.00
30	1251888.54	599642.96	113.00
31	1252298.10	599854.83	127.00
32	1252128.12	599848.02	142.00
33	1252160.54	599953.35	125.00
34	1252145.21	599916.66	125.00
35	1252123.61	599968.77	125.00
36	1252108.46	599932.46	125.00
37	1252037.73	599984.28	138.00
38	1252329.67	599523.86	138.89
39	1252320.58	599449.74	140.00
40	1252405.86	599173.44	140.00
41	1252367.52	599050.48	140.00
42	1252041.43	598798.32	140.00
43	1252262.76	599802.72	142.00
44	1252323.82	599797.42	141.00
45	1252384.10	599806.16	140.00
46	1252430.98	599844.03	139.00
47	1252366.77	599857.32	128.00
48	1252357.64	599880.68	128.00
49	1252418.19	599902.71	129.00
50	1252396.34	599914.99	129.00
E 51	1252022.25	599891.07	141.00

LEGEND

- 1983 SOIL BORING (ARDAMAN & ASSOCIATES)
- 1990 SOIL BORING (ARDAMAN & ASSOCIATES)
- 1997 SOIL PENETRATION TEST (ARDAMAN & ASSOCIATES)
- 1997 CONE PENETRATION TEST (ARDAMAN & ASSOCIATES)
- EXCAVATION GRADING CONTROL POINT
- PIEZOMETER (TO BE ABANDONED PRIOR TO CONSTRUCTION)

NOTES

- EXCAVATION CONTOURS RESUME A CONTIGUOUS PHOSPHATIC CLAY LAYER. THE BOTTOM OF PHOSPHATIC CLAY SHALL BE FIELD-VERIFIED, THEREFORE EXCAVATION LIMITS, ELEVATIONS AND GRADING CONTROL ARE SUPPLIED FOR REFERENCE ONLY.
- THE EXCAVATED SOILS CANNOT BE USED AS BACKFILL AND MUST BE STOCKPILED.
- EXISTING TOPOGRAPHY COMPILED FROM AERIAL SURVEY BY PICKETT AERIAL SURVEYS FOR WASTE MANAGEMENT INC. OF FLORIDA DATED JULY 5, 2004 AND (WERE INDICATED) FROM PRE-CONSTRUCTION FIELD SURVEY BY PICKETT AND ASSOC., INC. DATED FEBRUARY 7, 2005.
- NORTH STORMWATER DIVERSION SWALE, STORMWATER SWALE AND SEDIMENT BASIN TO BE CONSTRUCTED PRIOR TO THE COMMENCEMENT OF EXCAVATION.
- SEE DRAWING NO. 7 OF 9 FOR EXISTING SOIL BORING PROFILES.

RECORD DRAWINGS

1

SCS REVISION - ALIGNMENT OF ROAD CHANGED;
TOPOGRAPHIC SURVEY INSERTED, NORTH SWALE MODIFIED;
EXCAVATION MODIFIED

2

2/28/06

RECORD DRAWING ADDITIONS / TOPOGRAPHY REVISIONS

JHV

JHO

LTR

DATE

REVISIONS

BY

APPROD.

DESIGNED

SCS ENGINEERS

DRAWN

GRD

CHECKED

JHO/JPA

JONES EDMUNDS

730 NE WALDO ROAD, GAINESVILLE, FLORIDA 32641 / (352) 377-5821
324 S HYDE PARK AVE, TAMPA, FLORIDA 33606 / (813) 258-0703


HILLSBOROUGH COUNTY
SOLID WASTE MANAGEMENT DEPARTMENT
SOUTHEAST COUNTY LANDFILL

SECTION 8 CAPACITY EXPANSION
EXCAVATION PLAN
CONSTRUCTION DRAWINGS

CERTIFICATE OF AUTHORIZATION #1814
APPROVED BY: [Signature]
JOSEPH H. EDWARDS, P.E.
P.E. # 052049

DATE
2/28/06
SCALE
AS SHOWN

PROJECT NO.
08449-020-01
DWG. NO.
3

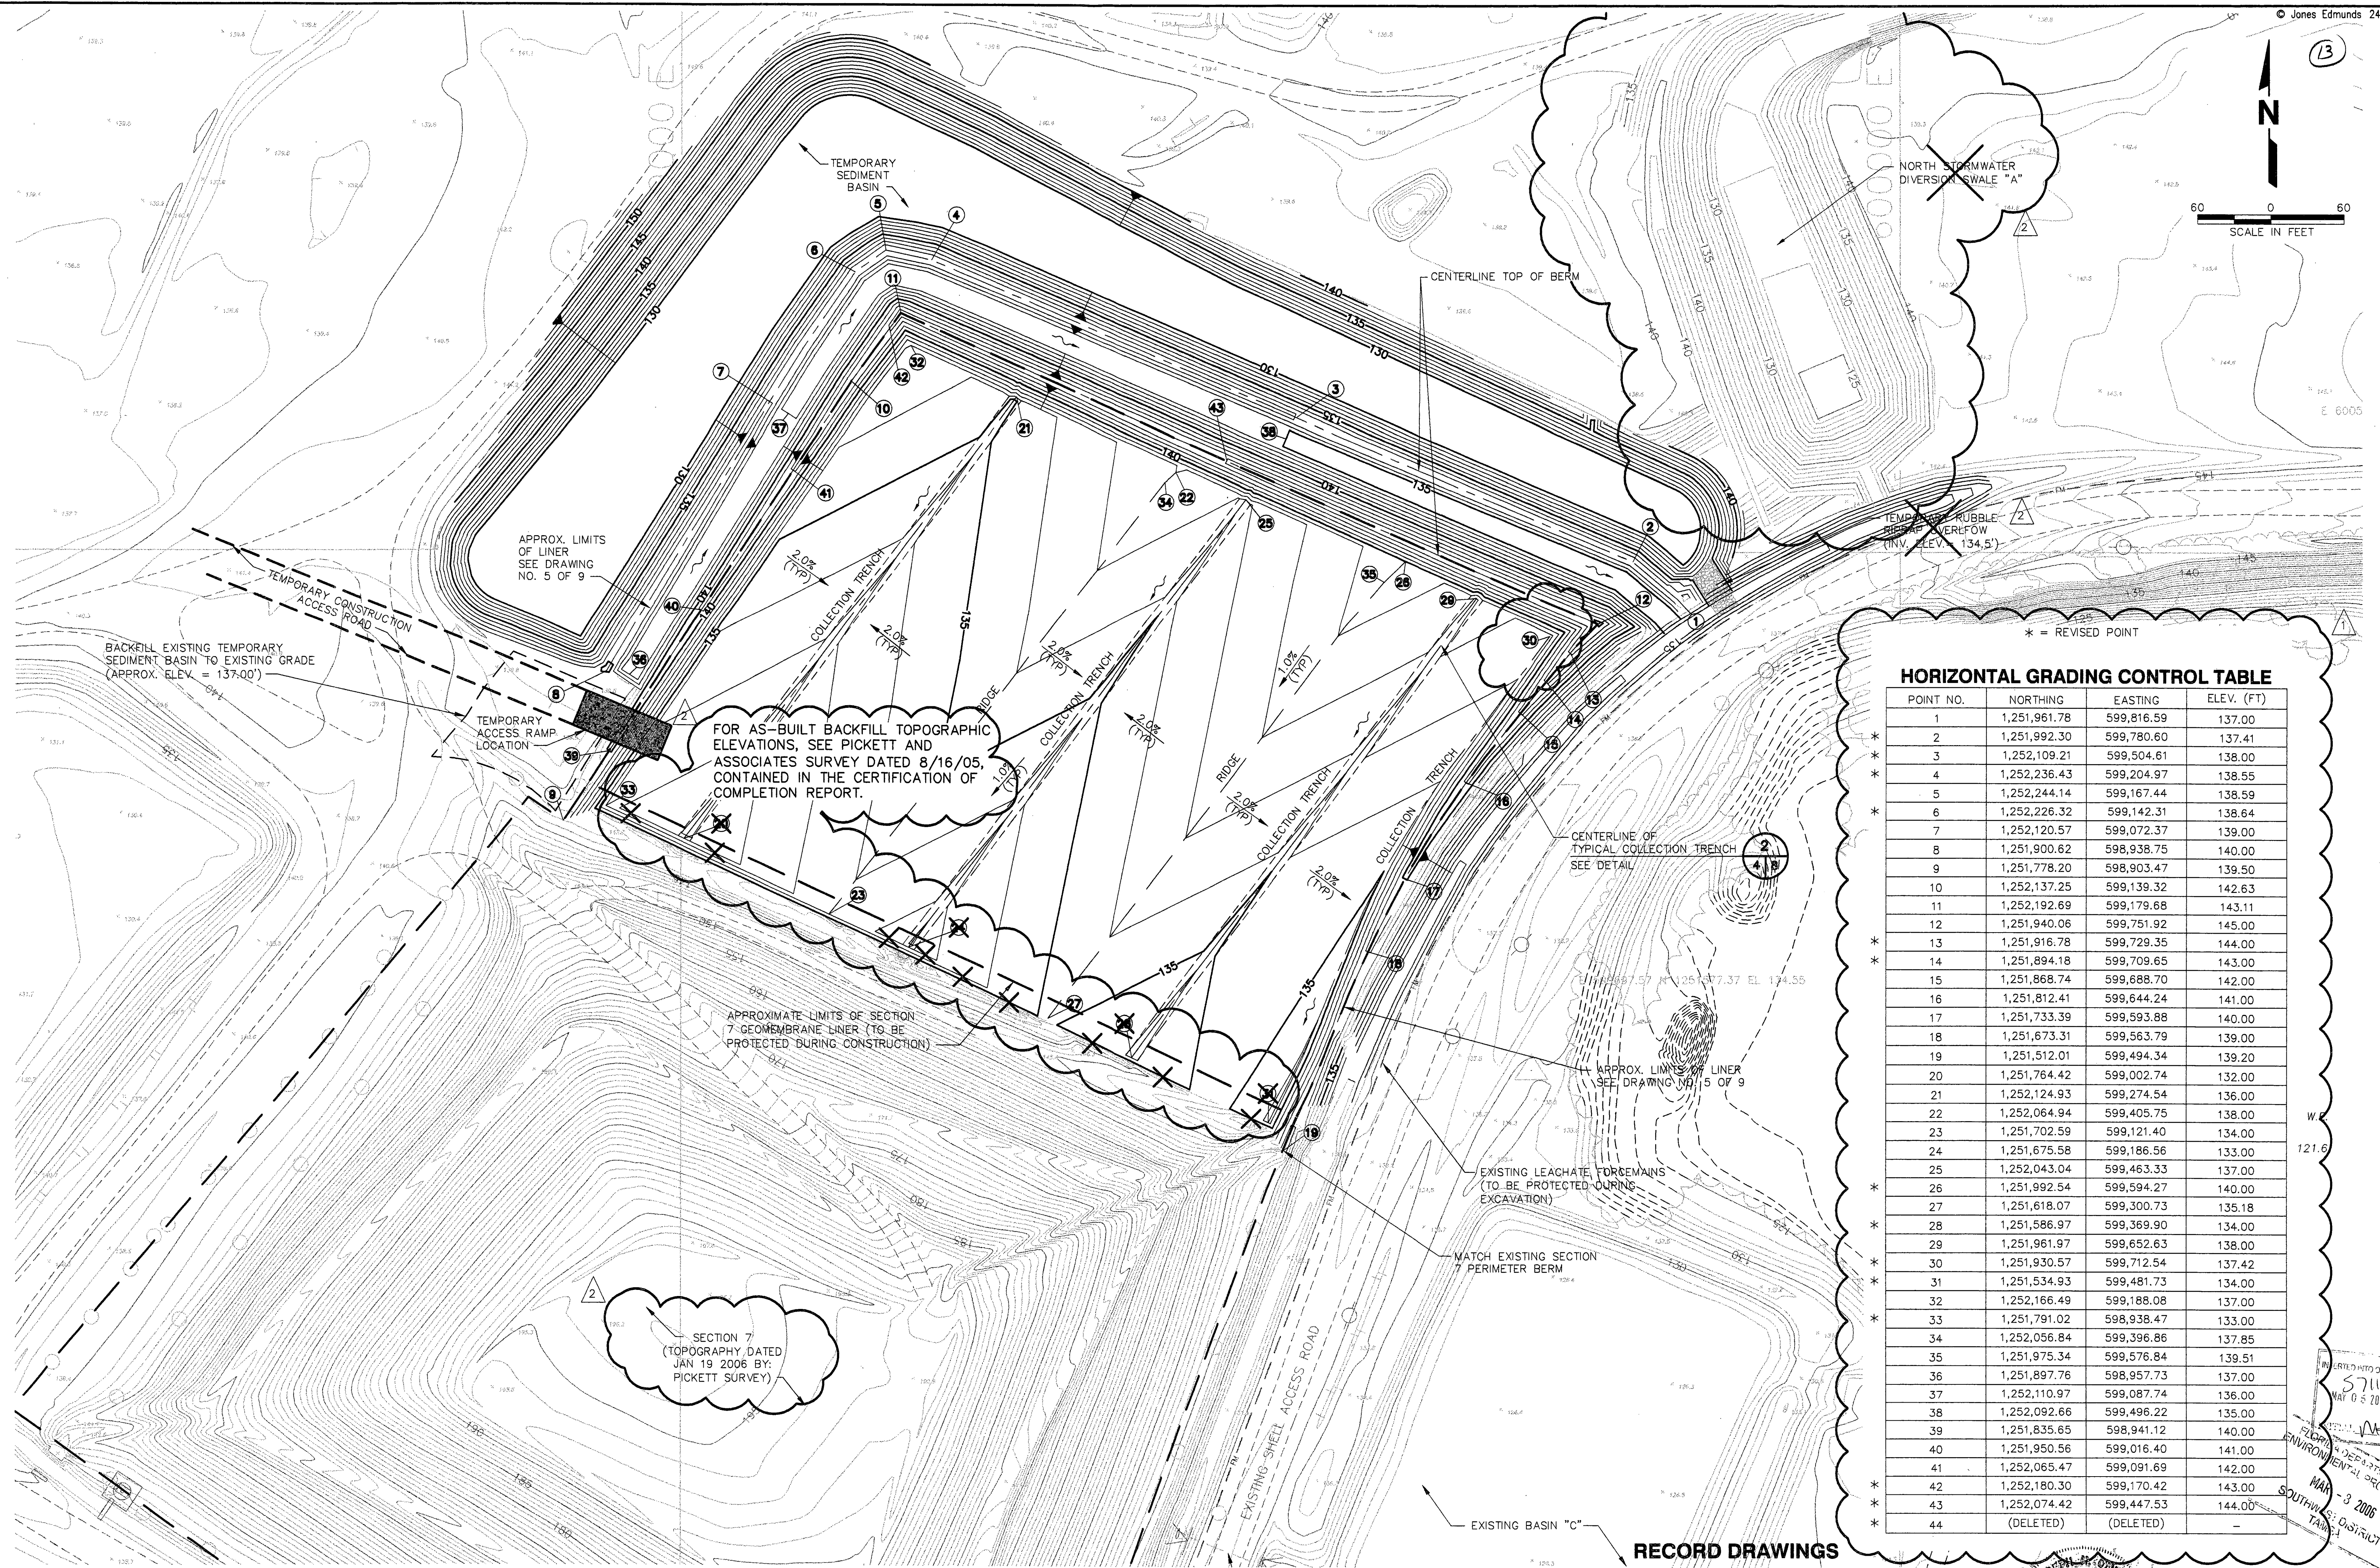

HORIZONTAL GRADING CONTROL TABLE

POINT NO.	NORTHING	EASTING	ELEV. (FT)
1	1,251,961.78	599,816.59	137.00
2	1,251,992.30	599,780.60	137.41
3	1,252,109.21	599,504.61	138.00
4	1,252,236.43	599,204.97	138.55
5	1,252,244.14	599,167.44	138.59
6	1,252,226.32	599,142.31	138.64
7	1,252,120.57	599,072.37	139.00
8	1,251,900.62	598,938.75	140.00
9	1,251,778.20	598,903.47	139.50
10	1,252,137.25	599,139.32	142.63
11	1,252,192.69	599,179.68	143.11
12	1,251,940.06	599,751.92	145.00
13	1,251,916.78	599,729.35	144.00
14	1,251,894.18	599,709.65	143.00
15	1,251,868.74	599,688.70	142.00
16	1,251,812.41	599,644.24	141.00
17	1,251,733.39	599,593.88	140.00
18	1,251,673.31	599,563.79	139.00
19	1,251,512.01	599,494.34	139.20
20	1,251,764.42	599,002.74	132.00
21	1,252,124.93	599,274.54	136.00
22	1,252,064.94	599,405.75	138.00
23	1,251,702.59	599,121.40	134.00
24	1,251,675.58	599,186.56	133.00
25	1,252,043.04	599,463.33	137.00
26	1,251,992.54	599,594.27	140.00
27	1,251,618.07	599,300.73	135.18
28	1,251,586.97	599,369.90	134.00
29	1,251,961.97	599,652.63	138.00
30	1,251,930.57	599,712.54	137.42
31	1,251,534.93	599,481.73	134.00
32	1,252,166.49	599,188.08	137.00
33	1,251,791.02	598,938.47	133.00
34	1,252,056.84	599,396.86	137.85
35	1,251,975.34	599,576.84	139.51
36	1,251,897.76	598,957.73	137.00
37	1,252,110.97	599,087.74	136.00
38	1,252,092.66	599,496.22	135.00
39	1,251,835.65	598,941.12	140.00
40	1,251,950.56	599,016.40	141.00
41	1,252,065.47	599,091.69	142.00
42	1,252,180.30	599,170.42	143.00
43	1,252,074.42	599,447.53	144.00
44	(DELETED)	(DELETED)	-

RECORD DRAWINGS

1		SCS REVISION -- REGRADE OF SLOPE, RIPRAP OVERFLOW REMOVED, GRADING POINTS MODIFIED	JHV	JHO	DESIGNED	SCS ENGINEER
2	2/28/06	RECORD DRAWING -- OMISSIONS AND TOPOGRAPHY MODIFIED			DRAWN	GRD
LTR.	DATE	REVISIONS	BY	APPRD.	CHECKED	JHO/JPA


DESIGNED	SCS ENGINEERS
DRAWN	GRD
CHECKED	JHO/JPA

JONES EDMUNDS
 730 NE WALDO ROAD, GAINESVILLE, FLORIDA 32641 / (352) 377-5821
 324 S HYDE PARK AVE, TAMPA, FLORIDA 33606 / (813) 258-0703

**HILLSBOROUGH COUNTY
 SOLID WASTE MANAGEMENT DEPARTMENT
 SOUTHEAST COUNTY LANDFILL**

**SECTION 8 CAPACITY EXPANSION
 BACKFILL PLAN
 CONSTRUCTION DRAWINGS**

CERTIFICATE OF AUTHORIZATION #1814 APPROVED BY: [Signature] JOSEPH J. EDWARDS, P.E. P.E. # 052093	DATE 2/28/06	PROJECT NO. 08449-020-01
SCALE AS SHOWN	DWG. NO. 4	

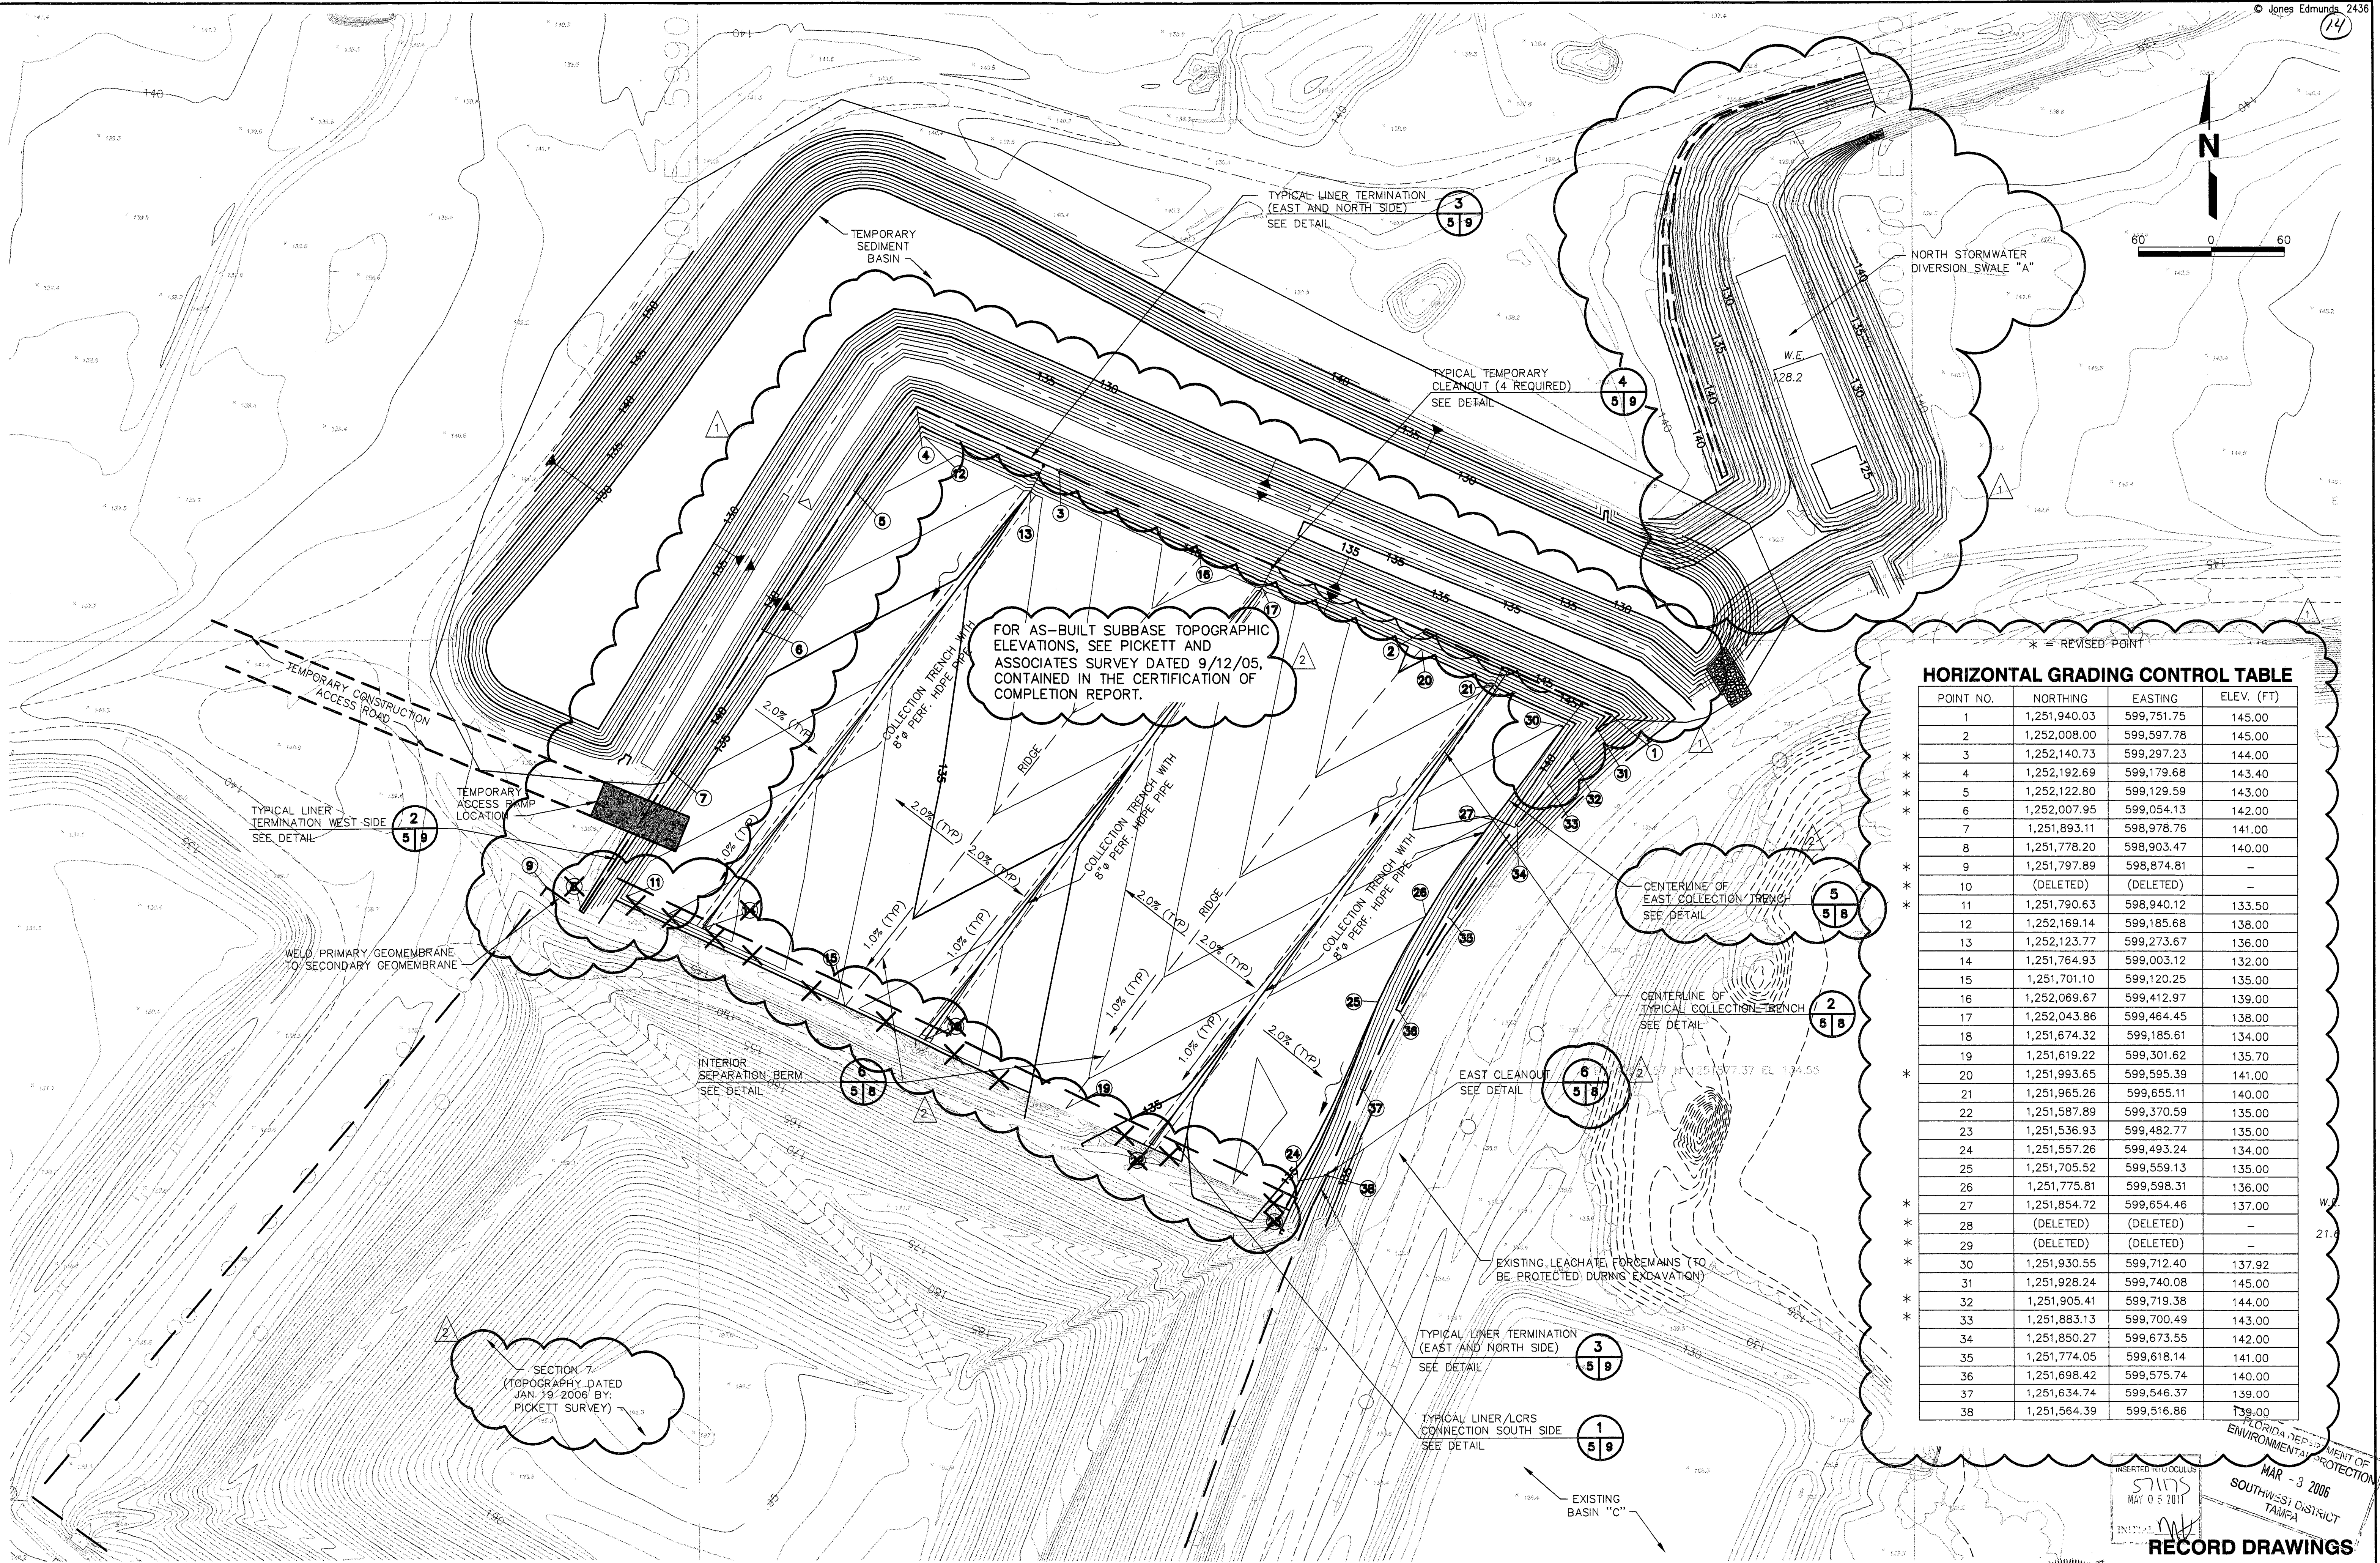

HORIZONTAL GRADING CONTROL TABLE

POINT NO.	NORTHING	EASTING	ELEV. (FT)
1	1,251,940.03	599,751.75	145.00
2	1,252,008.00	599,597.78	145.00
3	1,252,140.73	599,297.23	144.00
4	1,252,192.69	599,179.68	143.40
5	1,252,122.80	599,129.59	143.00
6	1,252,007.95	599,054.13	142.00
7	1,251,893.11	598,978.76	141.00
8	1,251,778.20	598,903.47	140.00
9	1,251,797.89	598,874.81	-
10	(DELETED)	(DELETED)	-
11	1,251,790.63	598,940.12	133.50
12	1,252,169.14	599,185.68	138.00
13	1,252,123.77	599,273.67	136.00
14	1,251,764.93	599,003.12	132.00
15	1,251,701.10	599,120.25	135.00
16	1,252,069.67	599,412.97	139.00
17	1,252,043.86	599,464.45	138.00
18	1,251,674.32	599,185.61	134.00
19	1,251,619.22	599,301.62	135.70
20	1,251,993.65	599,595.39	141.00
21	1,251,965.26	599,655.11	140.00
22	1,251,587.89	599,370.59	135.00
23	1,251,536.93	599,482.77	135.00
24	1,251,557.26	599,493.24	134.00
25	1,251,705.52	599,559.13	135.00
26	1,251,775.81	599,598.31	136.00
27	1,251,854.72	599,654.46	137.00
28	(DELETED)	(DELETED)	-
29	(DELETED)	(DELETED)	-
30	1,251,930.55	599,712.40	137.92
31	1,251,928.24	599,740.08	145.00
32	1,251,905.41	599,719.38	144.00
33	1,251,883.13	599,700.49	143.00
34	1,251,850.27	599,673.55	142.00
35	1,251,774.05	599,618.14	141.00
36	1,251,698.42	599,575.74	140.00
37	1,251,634.74	599,546.37	139.00
38	1,251,564.39	599,516.86	139.00

RECORD DRAWINGS

CERTIFICATE OF AUTHORIZATION 1814	DATE	PROJECT NO.
APPROVED BY [Signature]	2/28/06	08449-020-01
JOSEPH H. O'NEILL, P.E.	SCALE	DWG. NO.
P.E. # 000049	AS SHOWN	5


1	SCS REVISION - ALIGNMENT OF TOP OF BERM MODIFIED	DESIGNED	SCS ENGINEERS
2	2/28/06 NORTH SWALE MODIFIED; GRADING POINTS MODIFIED	DRAWN	GRD
	RECORD DRAWING TOPOGRAPHY MODIFIED	CHECKED	JHO/JPA
LTR.	DATE	BY	APPRD.

JONES EDMUNDS
730 NE WALDO ROAD, GAINESVILLE, FLORIDA 32641 / (352) 377-5821
324 S HYDE PARK AVE, TAMPA, FLORIDA 33606 / (813) 258-0703

HILLSBOROUGH COUNTY
SOLID WASTE MANAGEMENT DEPARTMENT
SOUTHEAST COUNTY LANDFILL


SECTION 8 CAPACITY EXPANSION
LCR GRADING PLAN (TOP OF CLAY SUBBASE)
CONSTRUCTION DRAWINGS

Edited: 00/00/00 0:00 login

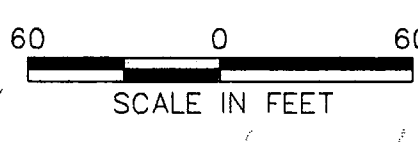


FLORIDA DEPARTMENT OF
ENVIRONMENTAL PROTECTION
MAR - 3 2006
SOUTHWEST DISTRICT
TAMPA

CERTIFICATE OF AUTHORIZATION 0814 APPROVED BY: 	DATE	PROJECT NO.
	2/28/06	08449-020-01
P.E. # 052069	SCALE	DWG. NO.
	AS SHOWN	6

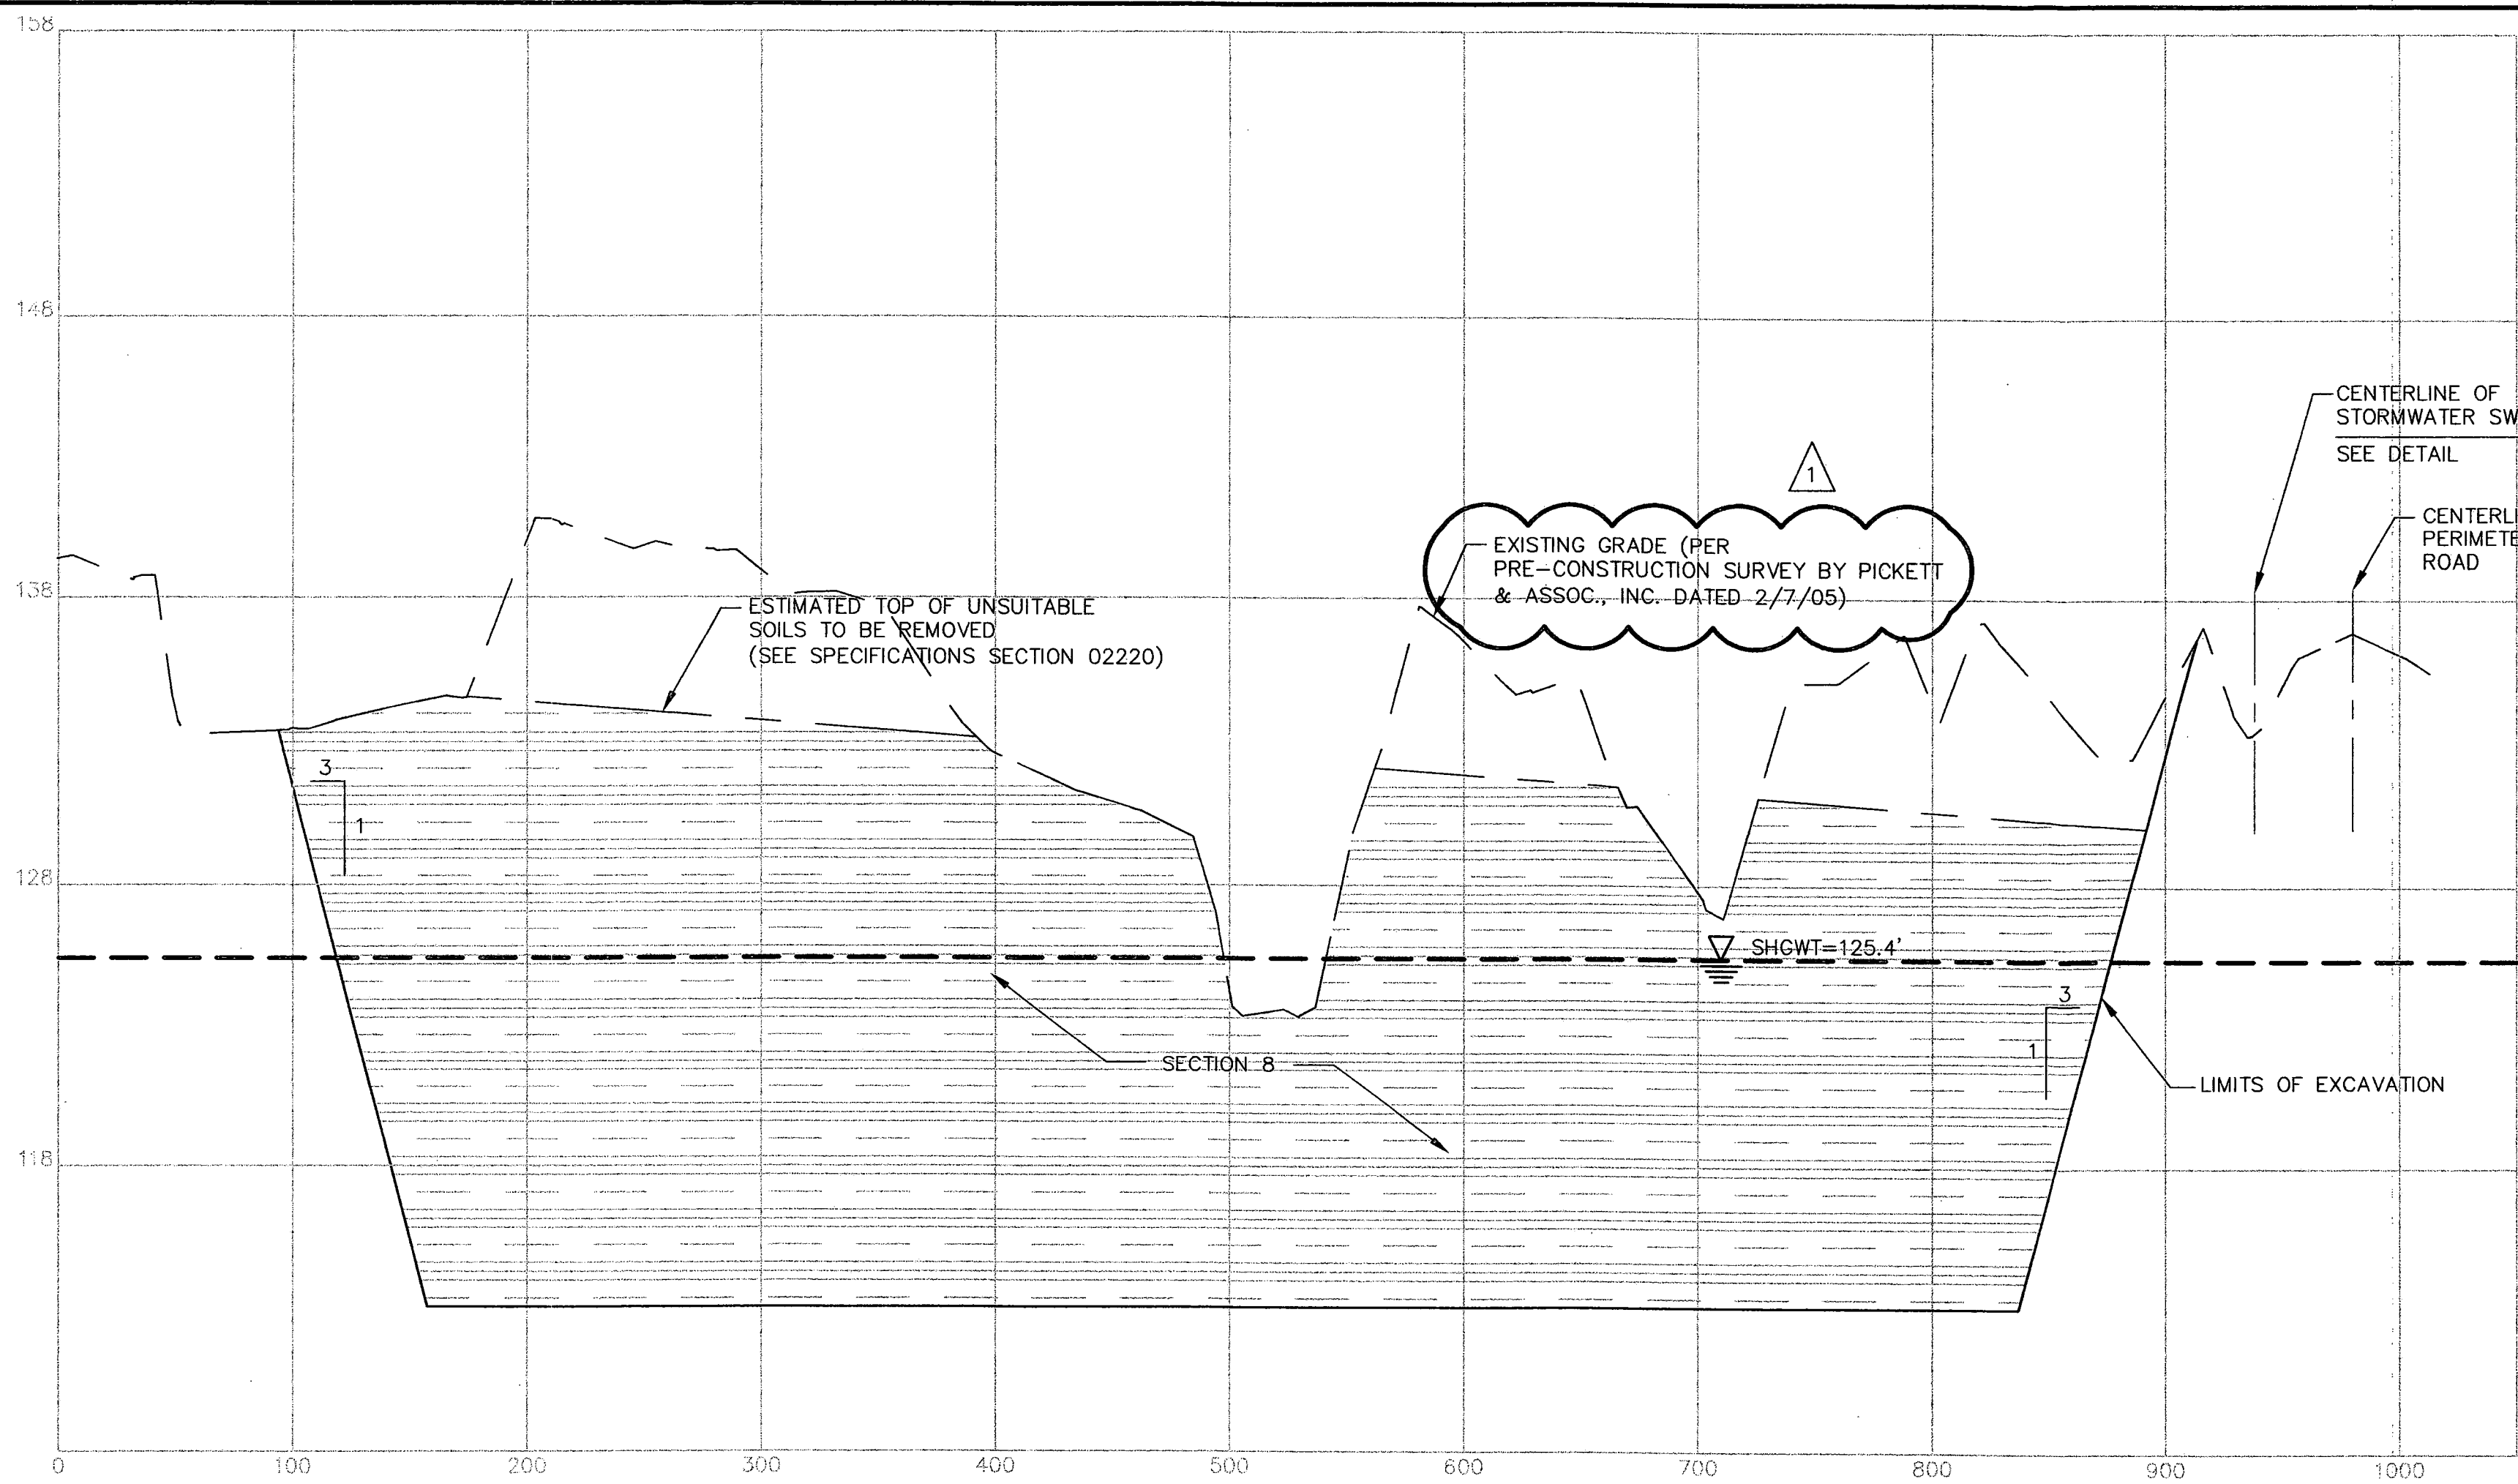


EXCAVATION SECTION A
SCALE 1" = 60' HORIZ
1" = 5' VERT

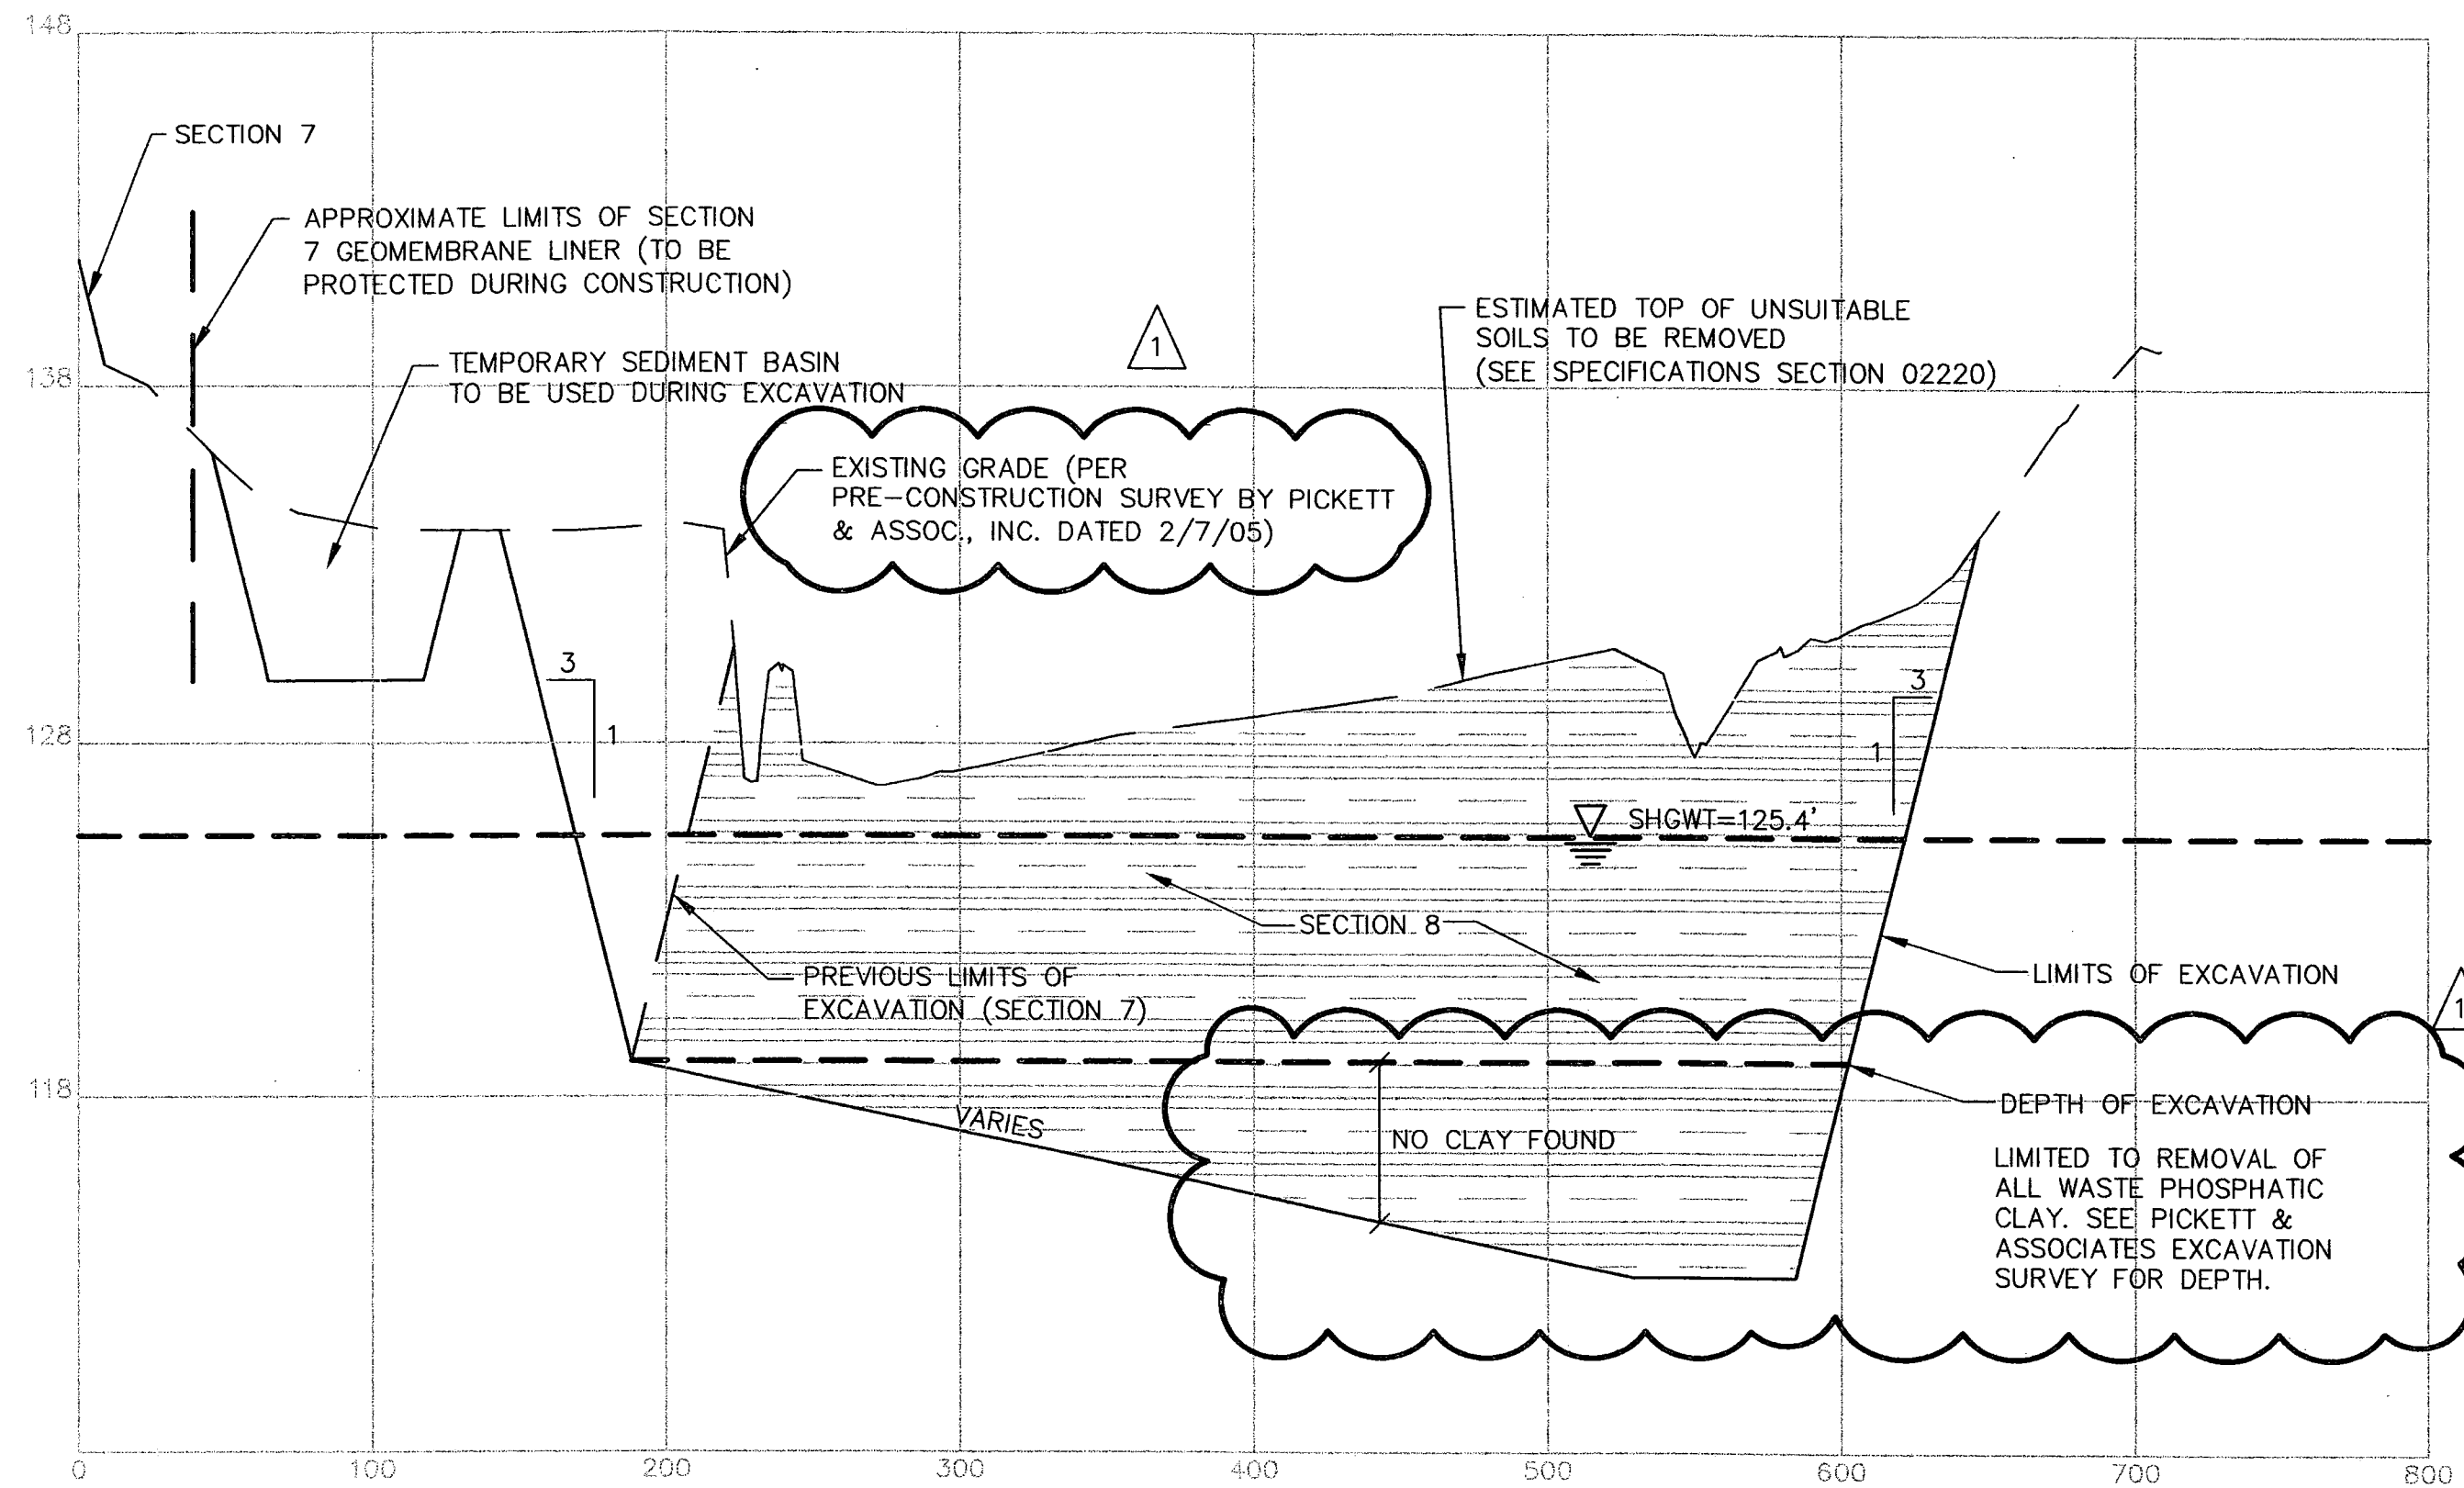


EXCAVATION SECTION B
SCALE 1" = 60' HORIZ
1" = 5' VERT


SOIL LEGEND			
1	SAND TAILINGS	5	LIGHT BROWN SAND WITH SILT TO SILTY SAND OCCASIONALLY CEMENTED (SP-SM TO SM)
1A	GRAYISH BROWN SAND WITH SILT TO SILTY SAND WITH CLAY (SP-SM TO SM-SC) TAILING SAND	5A	LIGHT TO DARK GRAY SLIGHTLY SILTY TO SILTY FINE SANDS WITH OCCASIONAL TRACES OF ROOTS AND OTHER ORGANIC MATTER
1B	GRAYISH BROWN CLAYEY SAND (SC) TAILING SAND AND PHOSPHATIC WASTE CLAY MIX	6	GRAY SAND WITH CEMENTED SAND PARTICLES (SP)
1C	BROWN SAND	6A	LIGHT TO DARK BROWN SLIGHTLY SILTY TO SILTY FINE SANDS WITH OCCASIONAL SEAMS OF CEMENTED SANDS (HARDPAN)
2A	GREENISH GRAY PHOSPHATIC WASTE CLAY (CH)	7	GRAY SANDY CLAY WITH PHOSPHATE (CH)
2B	GREENISH GRAY SANDY PHOSPHATIC WASTE CLAY (CH-CL) PHOSPHATIC WASTE CLAY AND TAILING SAND MIX	9	GRAY CLAYEY SAND WITH PHOSPHATE (SC)
3	BROWNISH GRAY SAND WITH SILT (SP-SM)	10	LIGHT BROWN CLAYEY SAND WITH SILT AND PHOSPHATE, CEMENTED (SC)
3A	DARK BROWN SAND WITH SILT AND GRAY CLAY LAYER	12	GRAY CLAYEY SAND (SC)
3B	SAND TAILINGS MIXED WITH WASTE PHOSPHATIC CLAYS	12A	BROWN AND ORANGISH-BROWN CLAYEY SAND
4	DARK BROWN SILTY SAND (SM) HARD PAN		

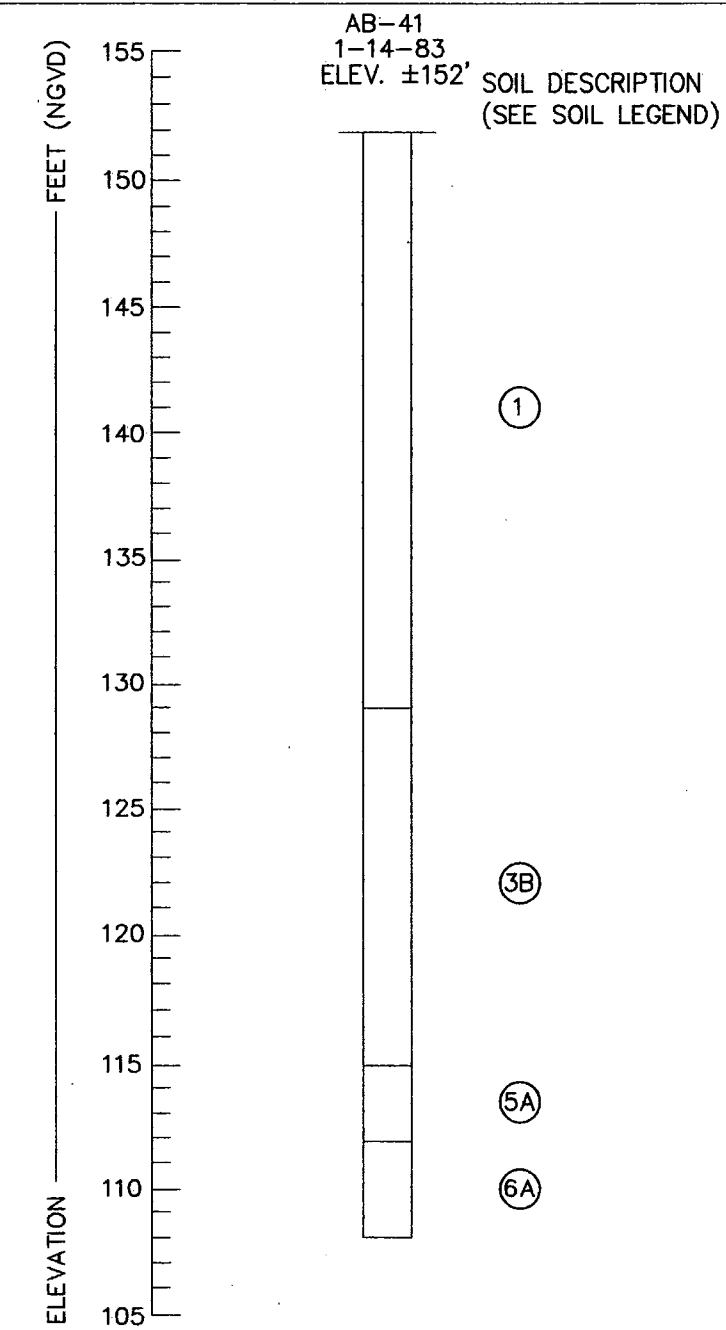


BORING PROFILE AUGER BORING (AB-41)
NTS

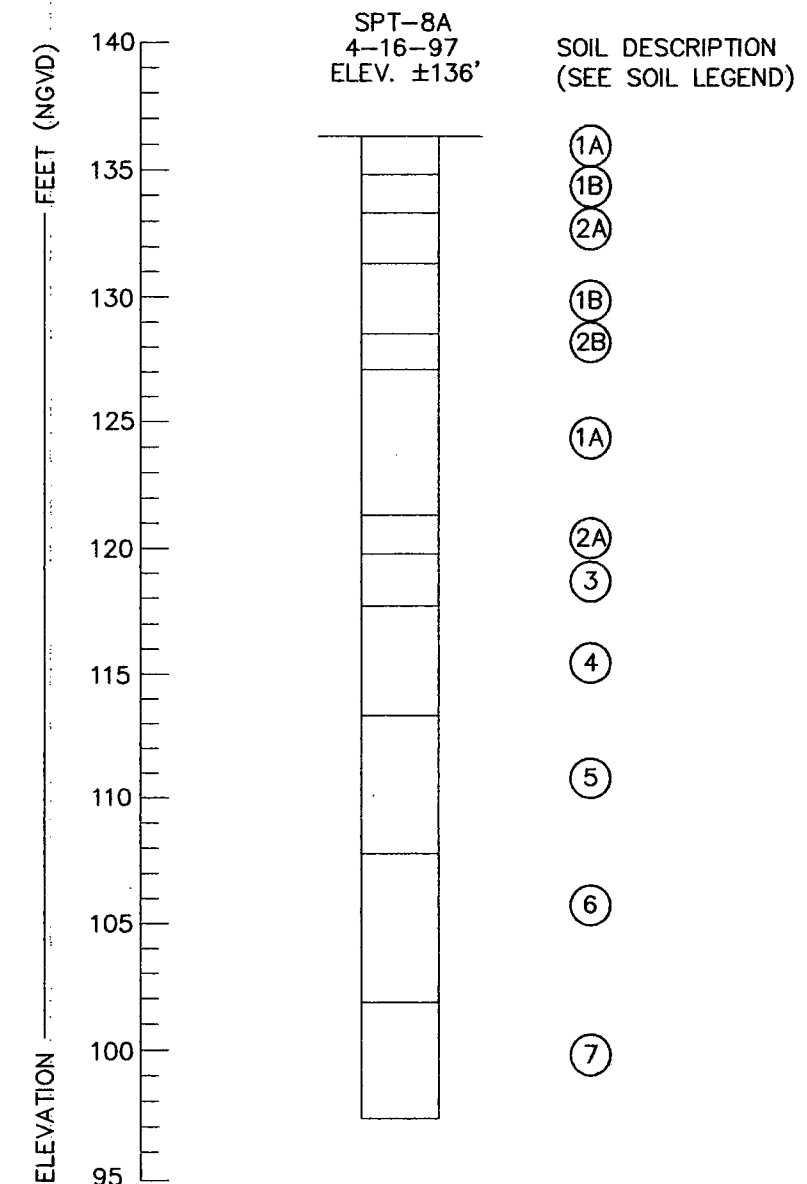


BORING PROFILE STANDARD PENETRATION TEST (SPT-8A)
NTS

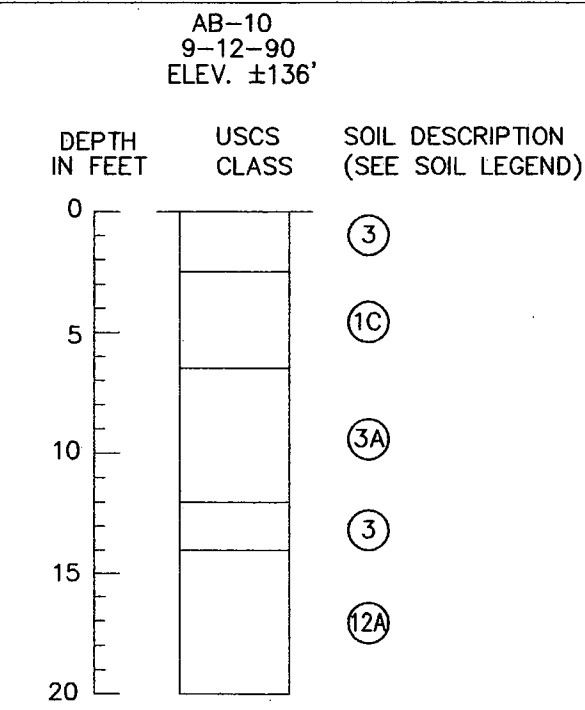

BORING PROFILE AUGER BORING (AB-10)
NTS

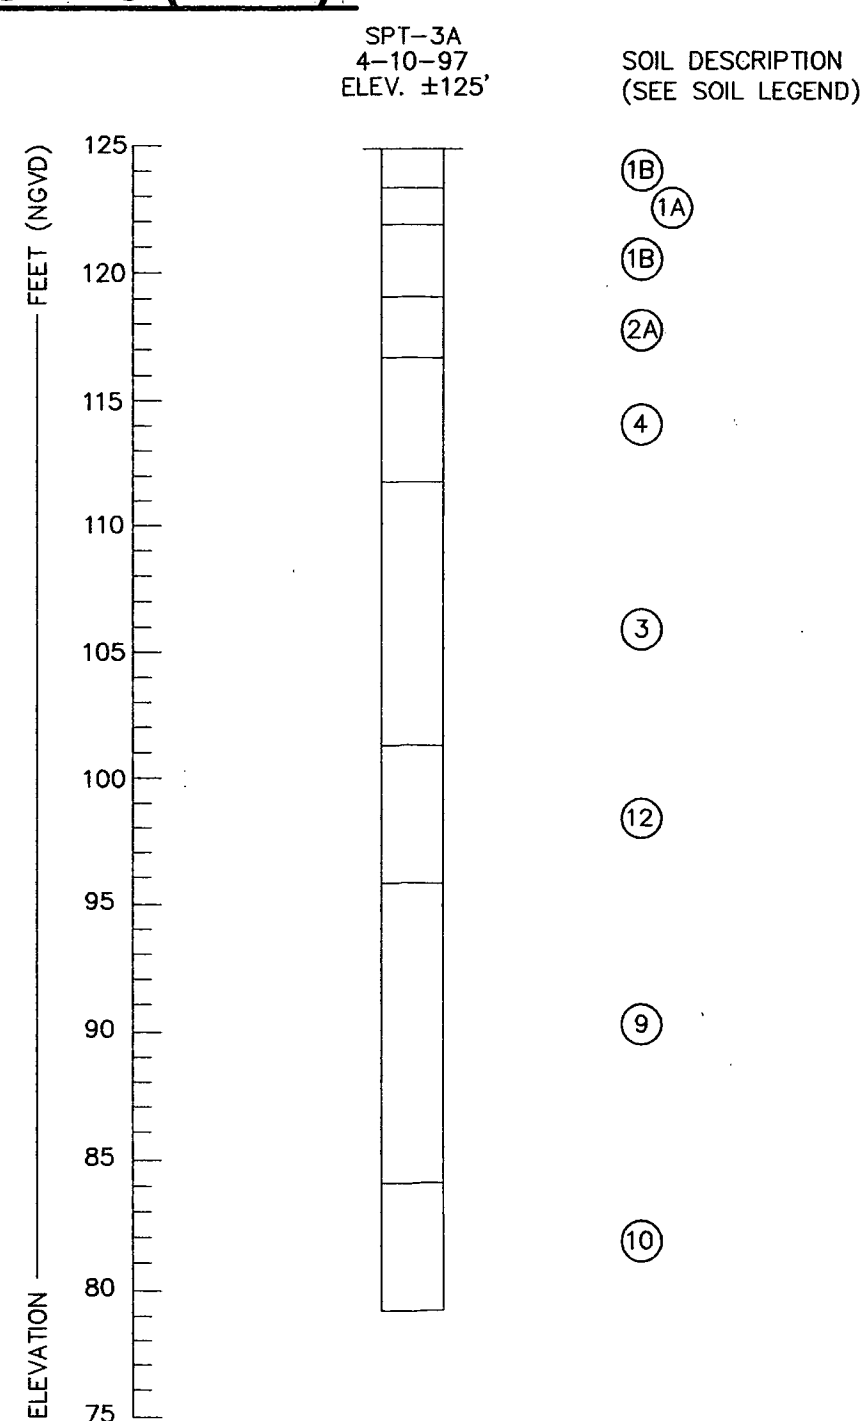

BORING PROFILE STANDARD PENETRATION TEST (SPT-3A)
NTS

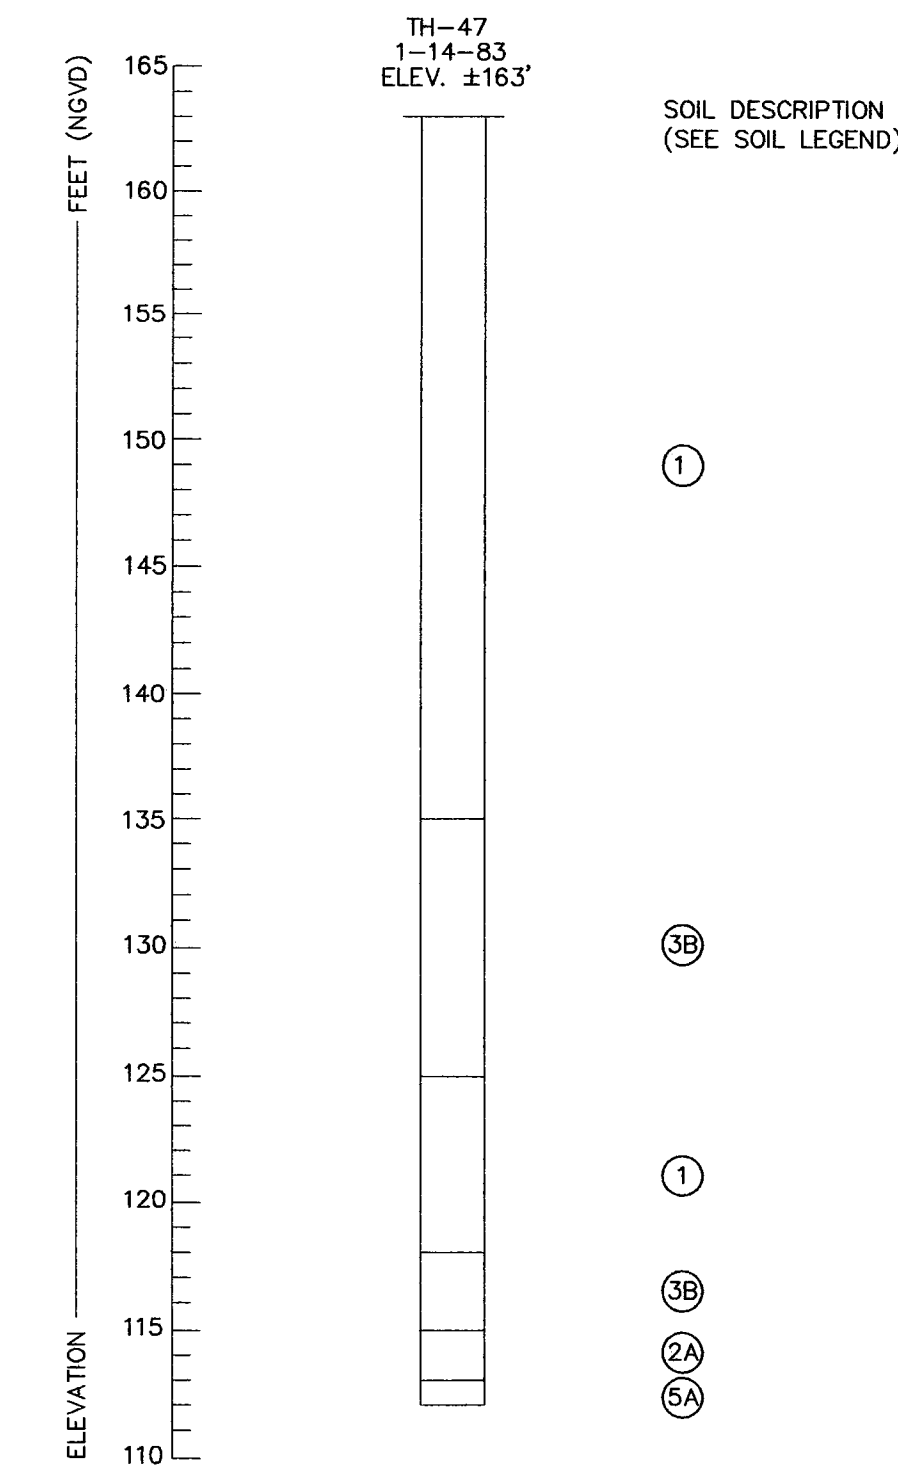

BORING PROFILE STANDARD PENETRATION TEST (TH-47)
NTS

1	SCS REVISION - EXCAVATION DEPTH MODIFIED;				
	EXISTING TOPOGRAPHY INSERTED				
LTR.	DATE	REVISIONS	BY	APPRD.	CHECKED

DESIGNED SCS ENGINEERS
DRAWN GRD
CHECKED JHO/JPA

JONES EDMUNDS
730 NE WALDO ROAD, GAINESVILLE, FLORIDA 32641 / (352) 377-5821
324 S HYDE PARK AVE, TAMPA, FLORIDA 33606 / (813) 258-0703


HILLSBOROUGH COUNTY
SOLID WASTE MANAGEMENT DEPARTMENT
SOUTHEAST COUNTY LANDFILL

SECTION 8 CAPACITY EXPANSION
SECTIONS & SOIL BORING PROFILES
CONSTRUCTION DRAWINGS

CERTIFICATE OF AUTHORIZATION #1814 APPROVED BY JOSEPH H. O'NEILL, P.E. P.E. #082049	DATE 2/28/06 SCALE AS SHOWN	PROJECT NO. 08449-020-01 DWG. NO. 7
--	--------------------------------------	--


RECORD DRAWINGS

FLORIDA DEPARTMENT OF
ENVIRONMENTAL PROTECTION
MAR - 3 2006
SOUTHWEST DISTRICT
TAMPA
INITIALS
57175
MAY 0 5 2011

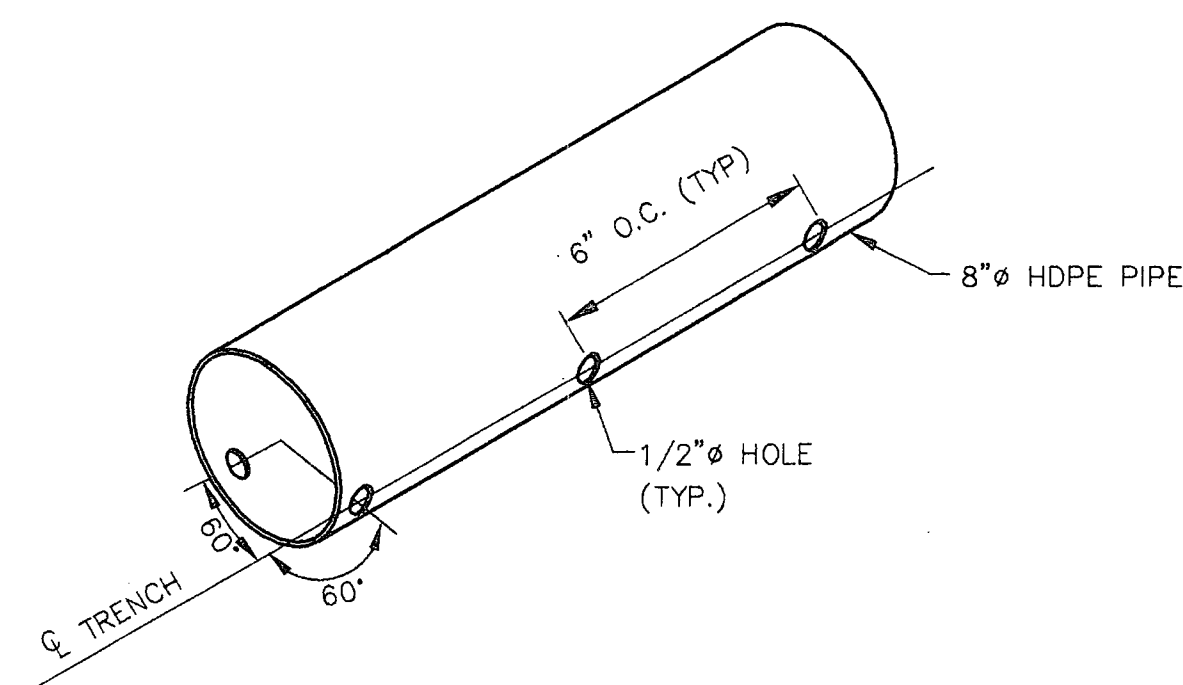


NOTE: CONTRACTOR SHALL PLACE PERFORATED PIPE AS SHOWN (HOLES TOWARDS BOTTOM OF TRENCH).


PIPE PERFORATION DETAIL 4
NOT TO SCALE

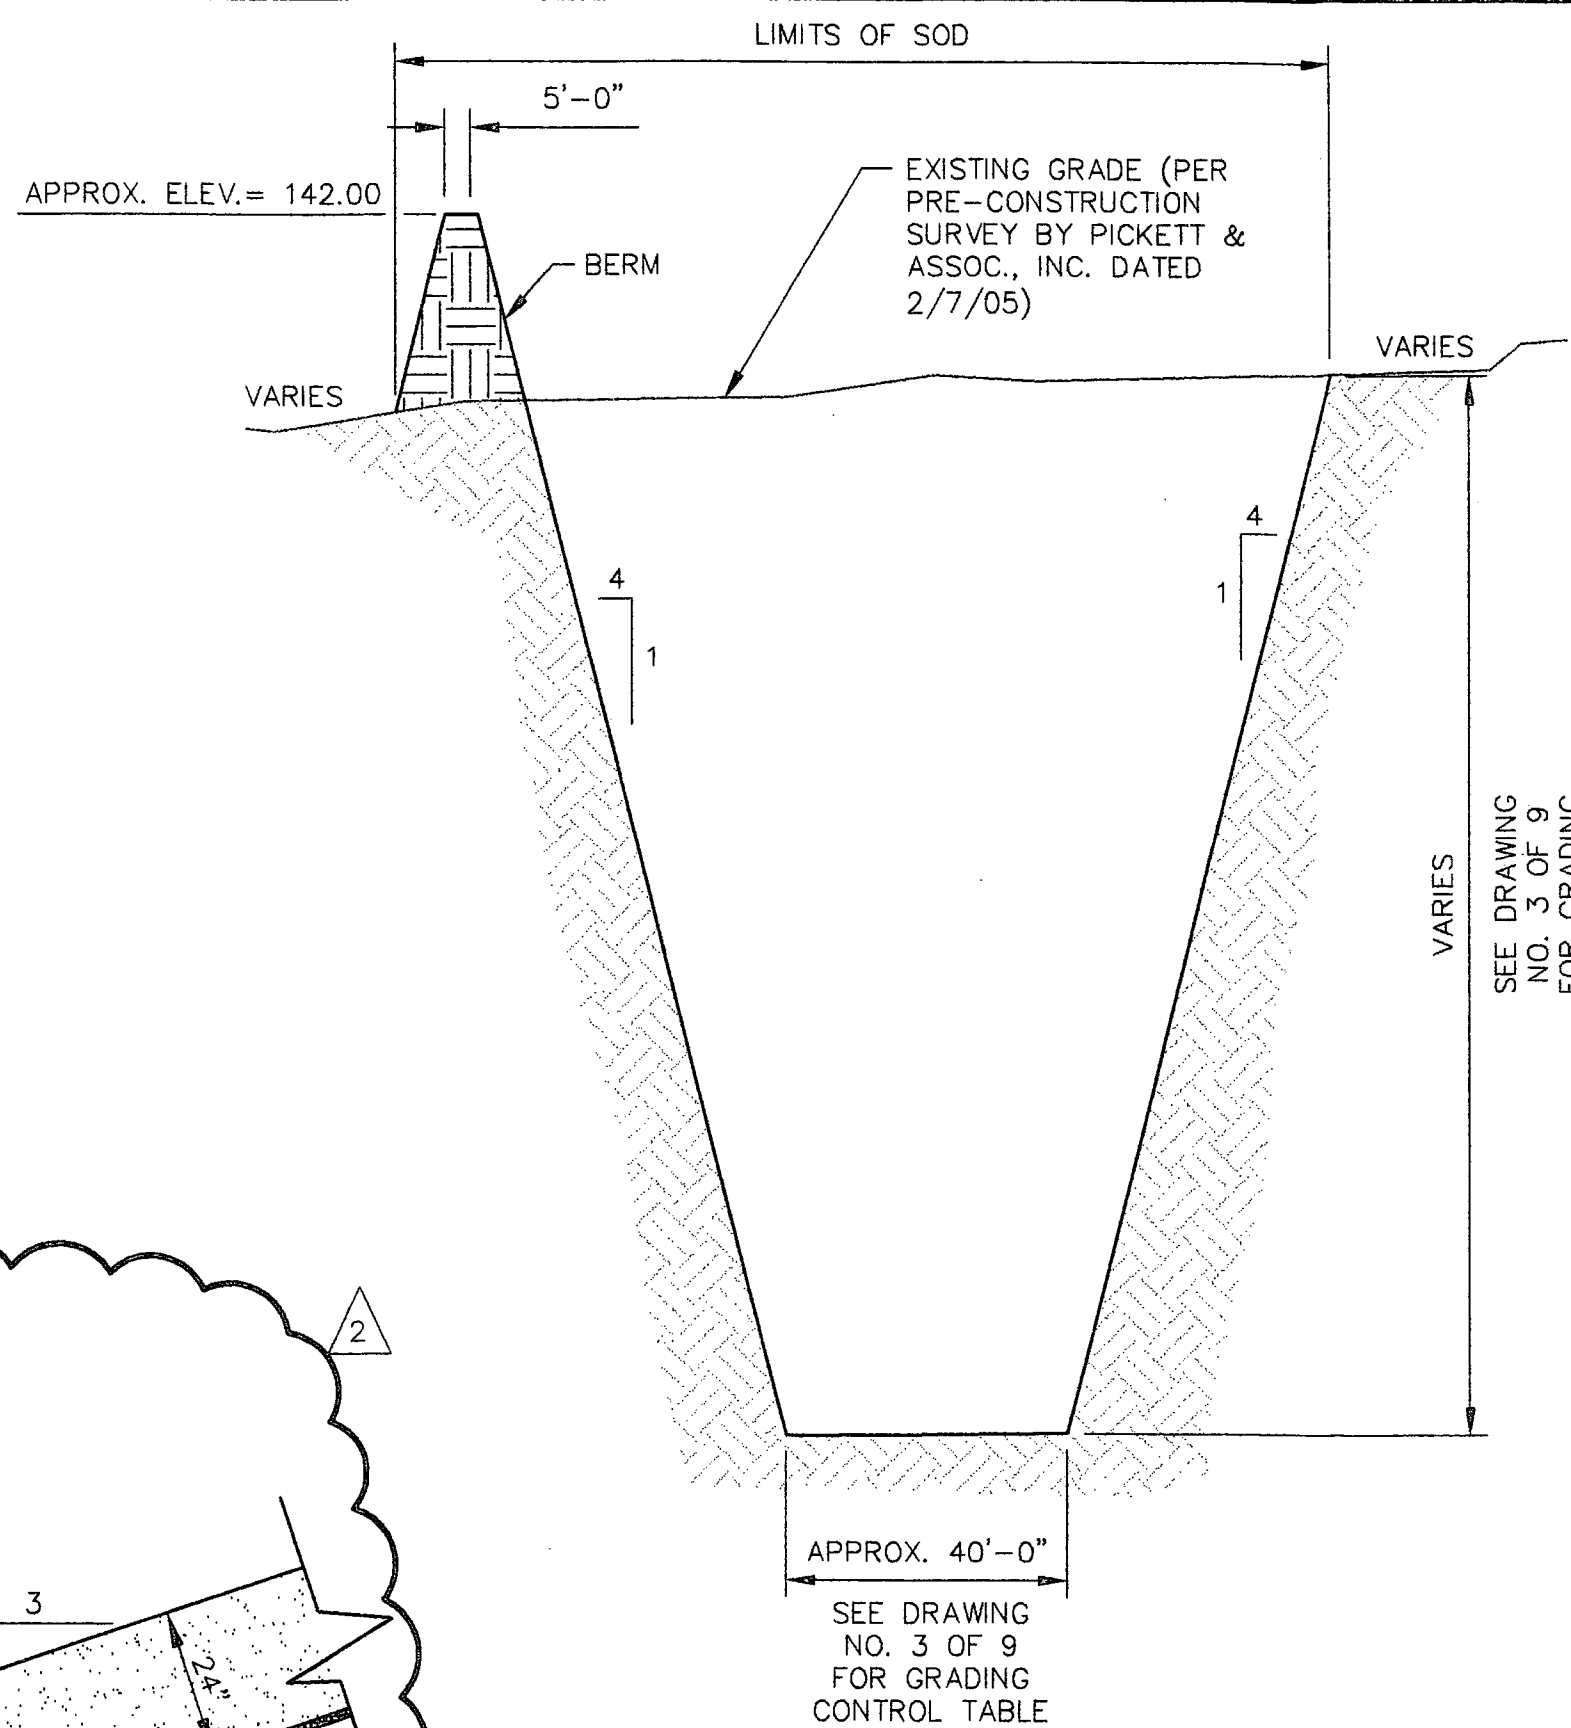


NORTH STORMWATER DIVERSION SWALE "A" DETAIL 3
NOT TO SCALE

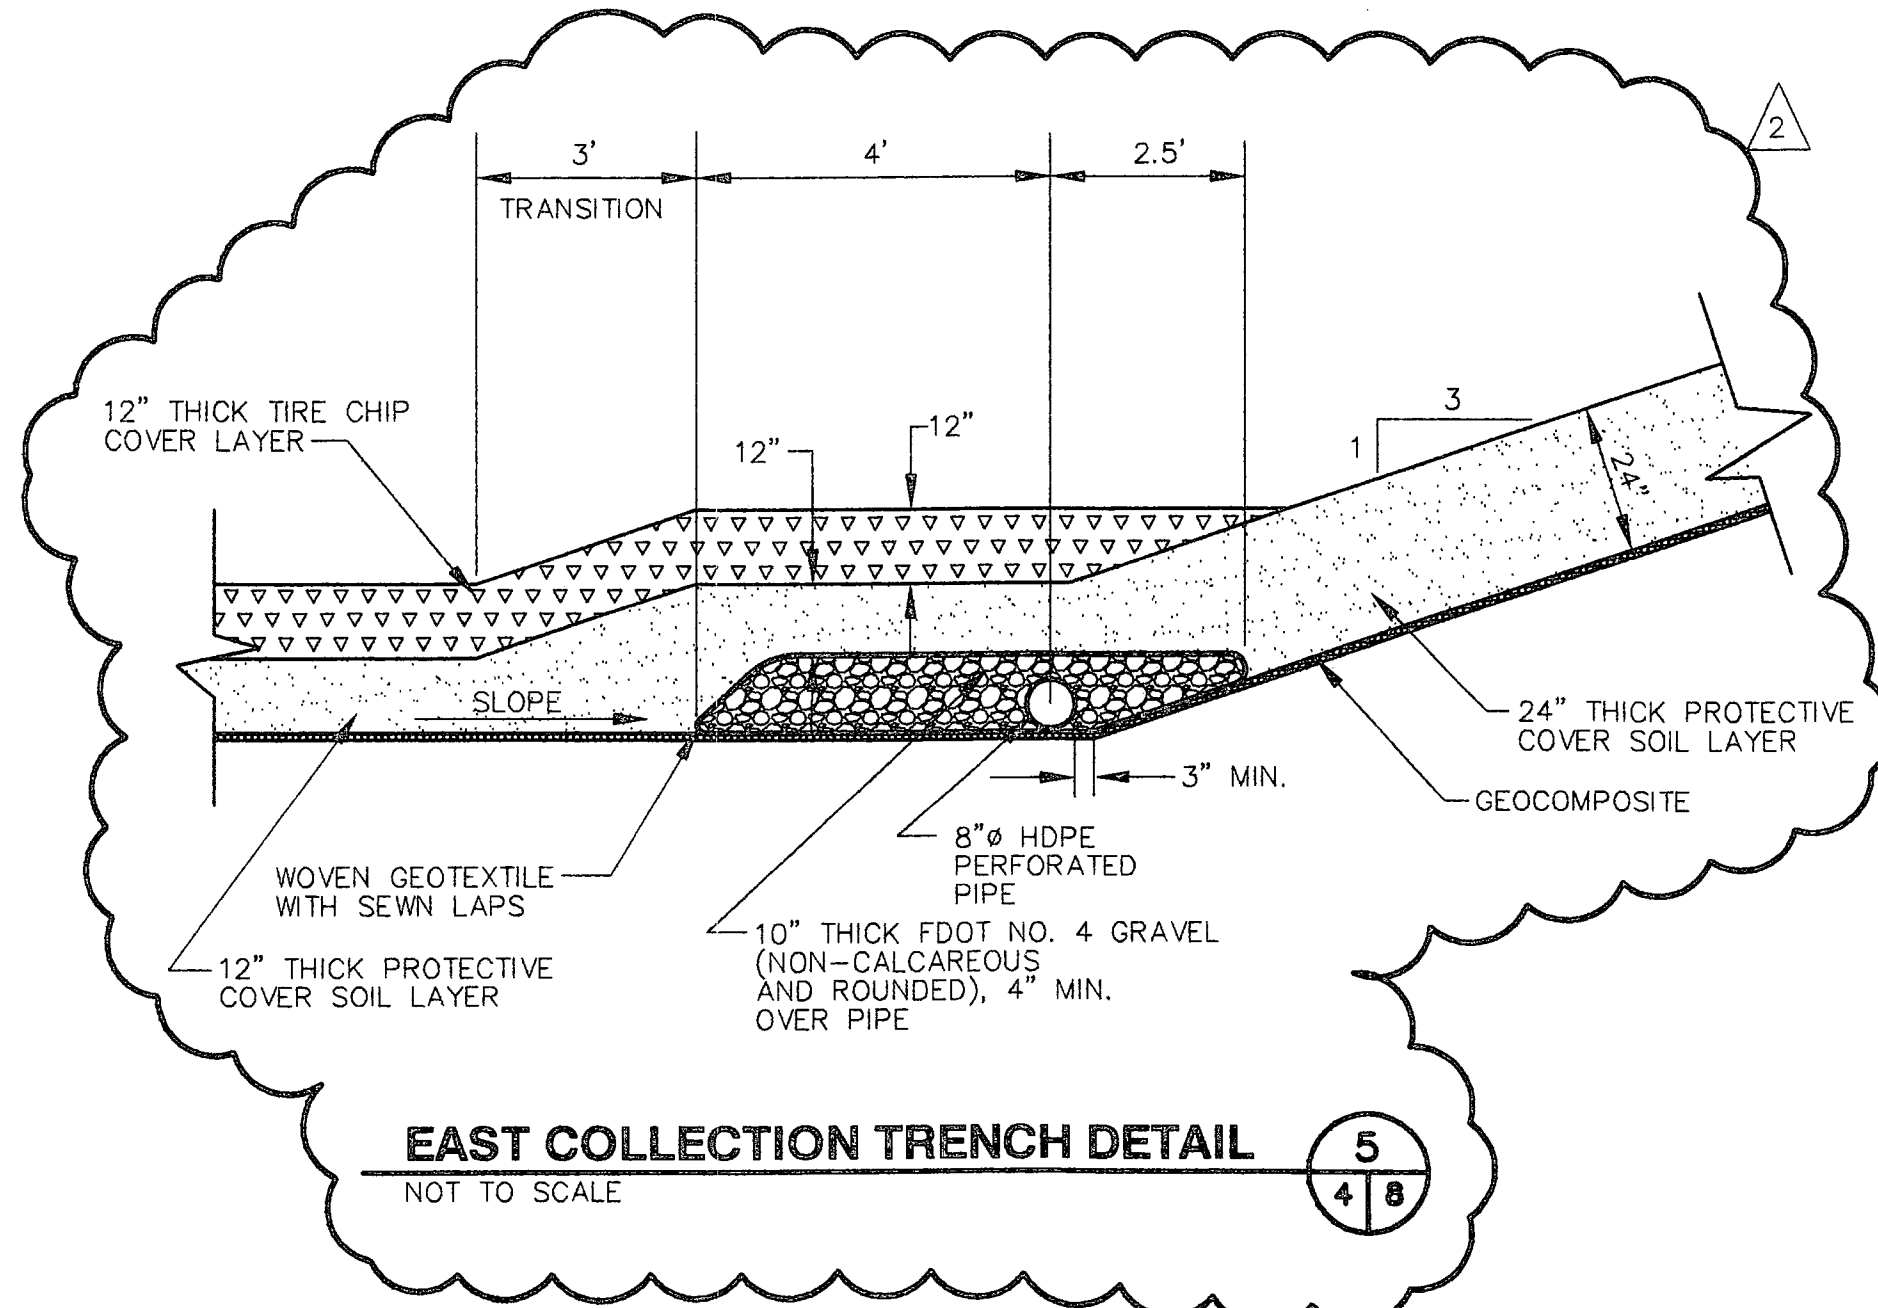


EAST COLLECTION TRENCH DETAIL 5
NOT TO SCALE

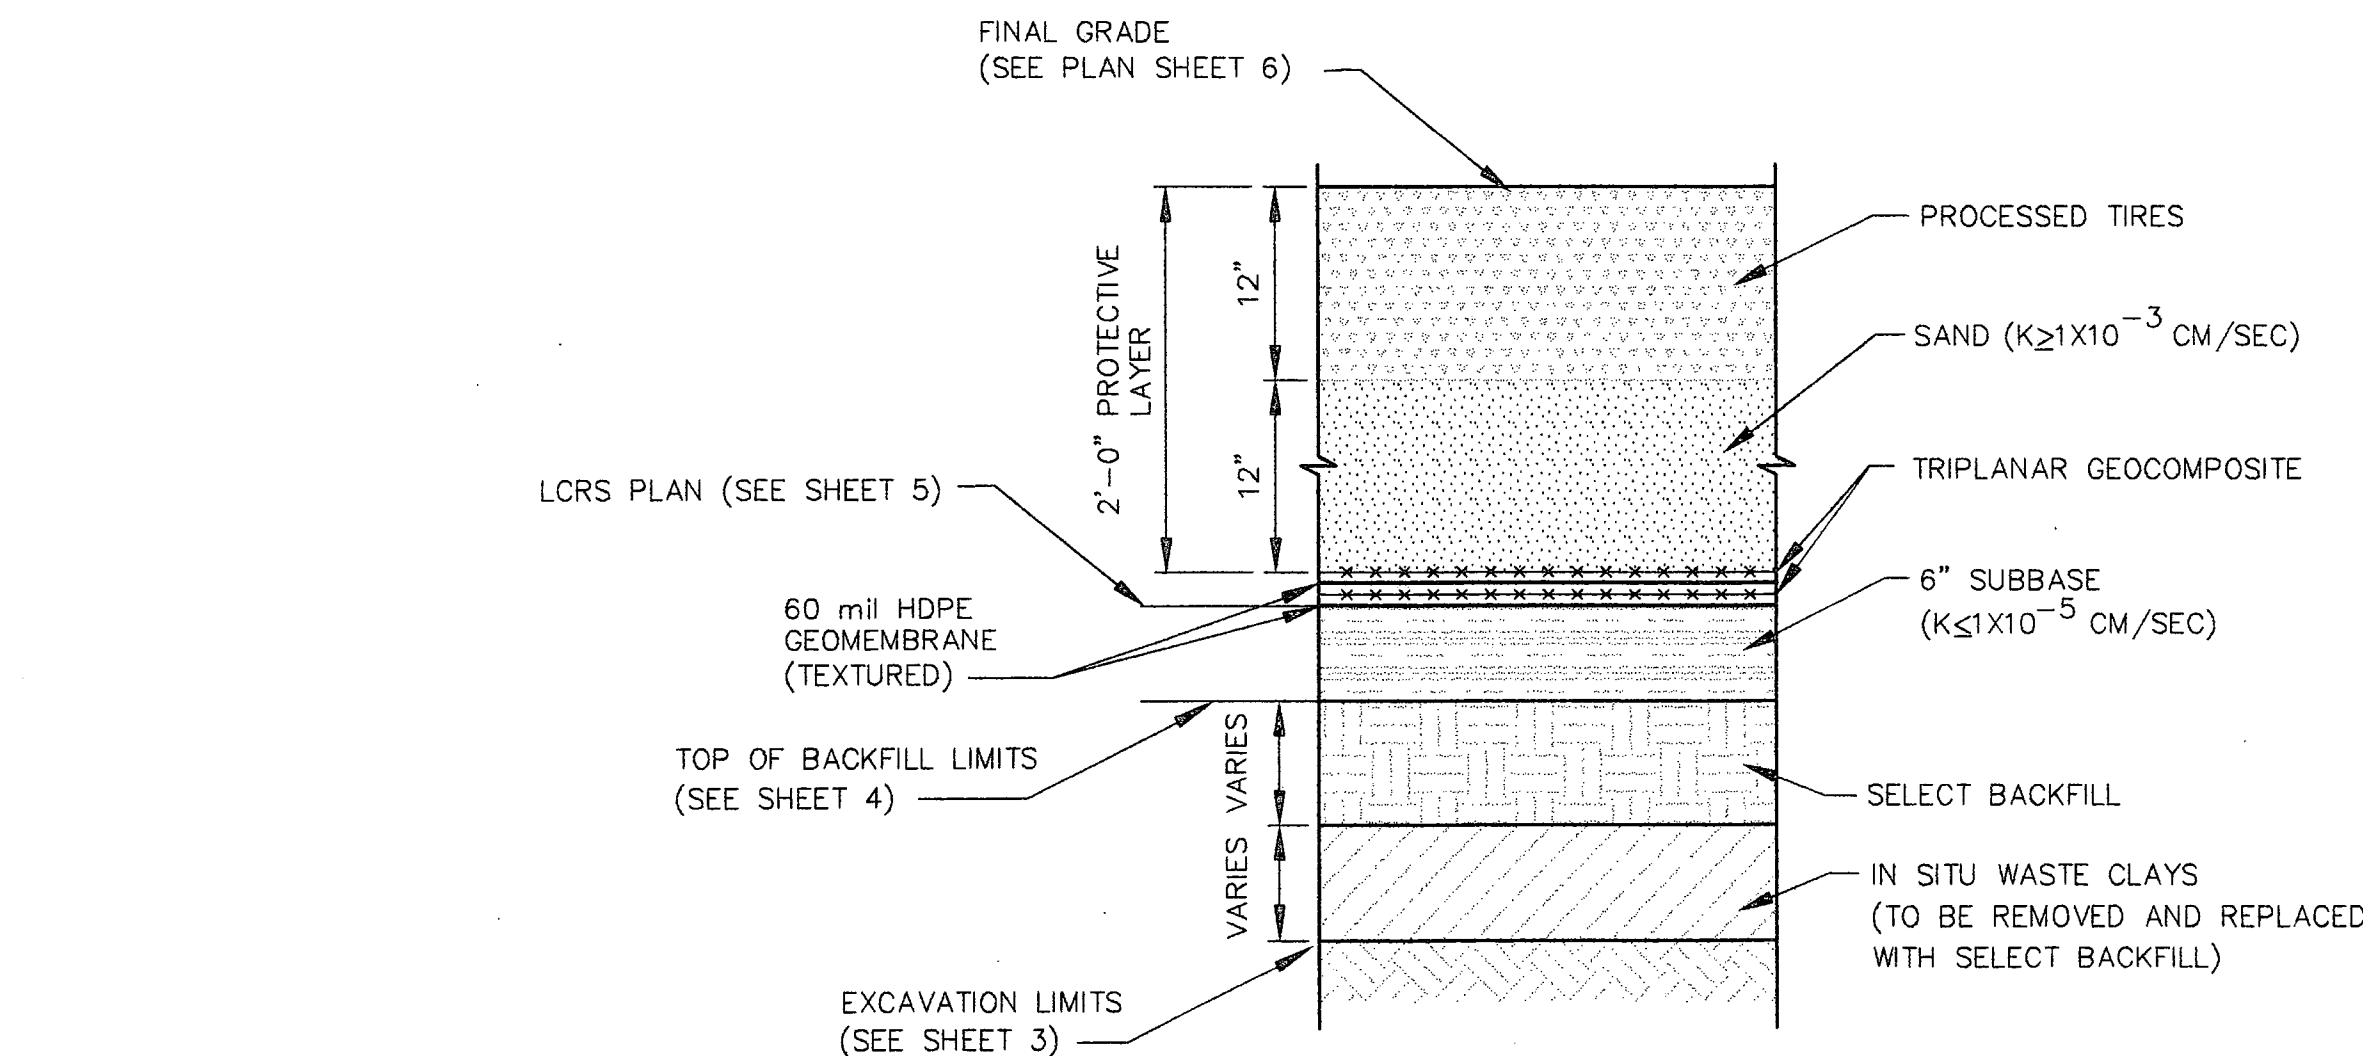


LINER SYSTEM DETAIL 1
NOT TO SCALE

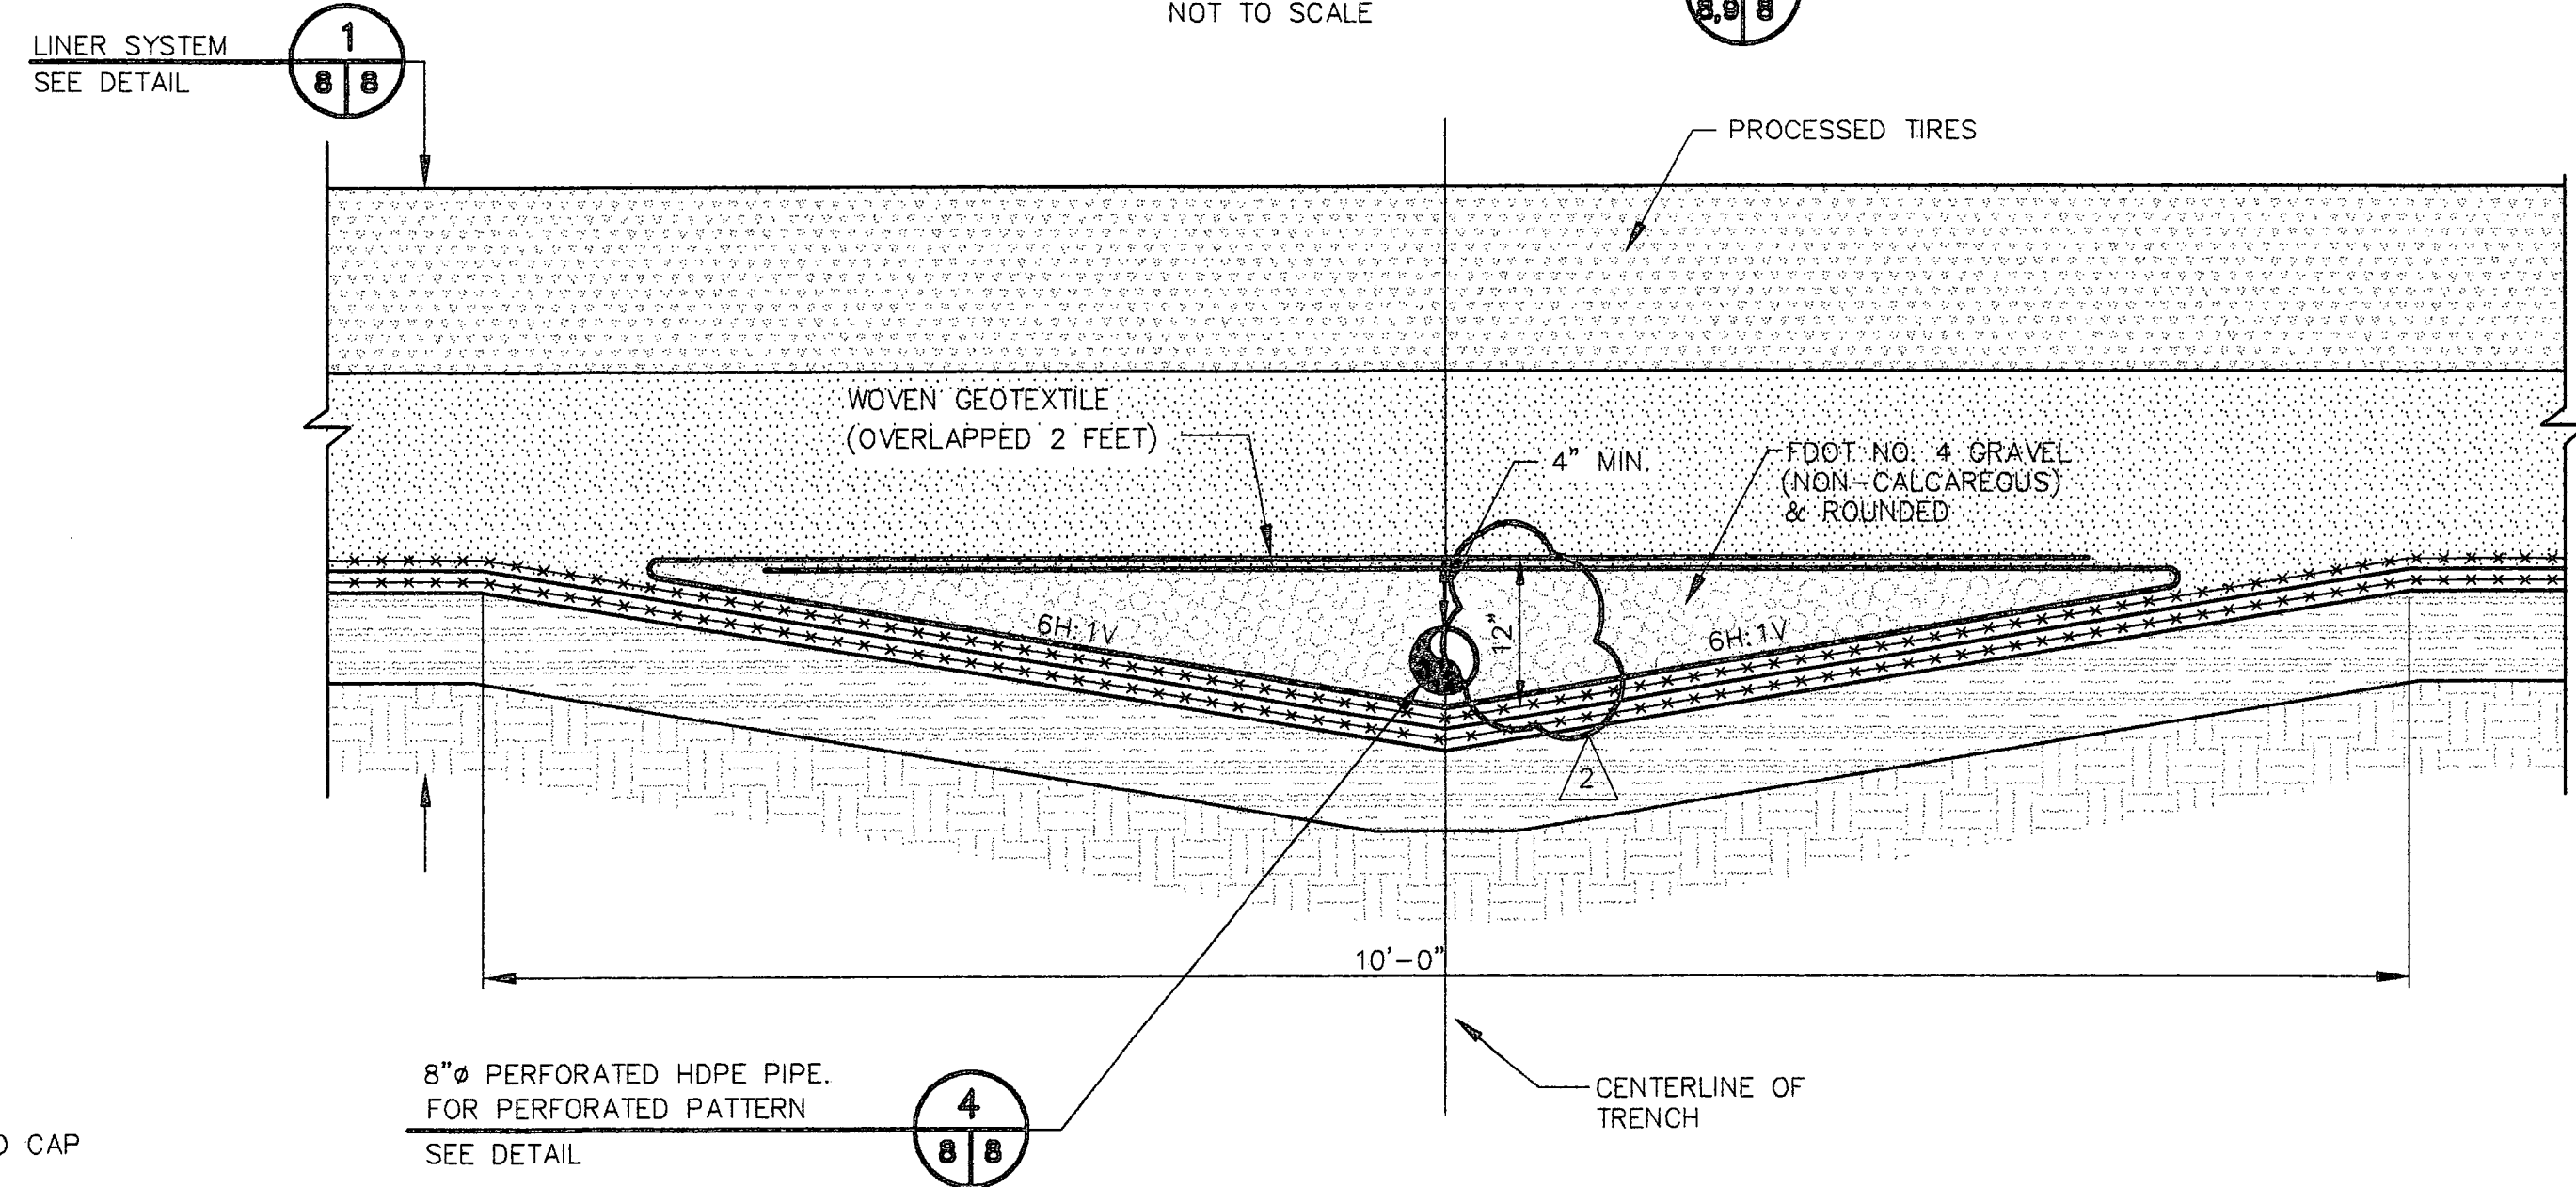

TYPICAL COLLECTION TRENCH DETAIL 2
NOT TO SCALE

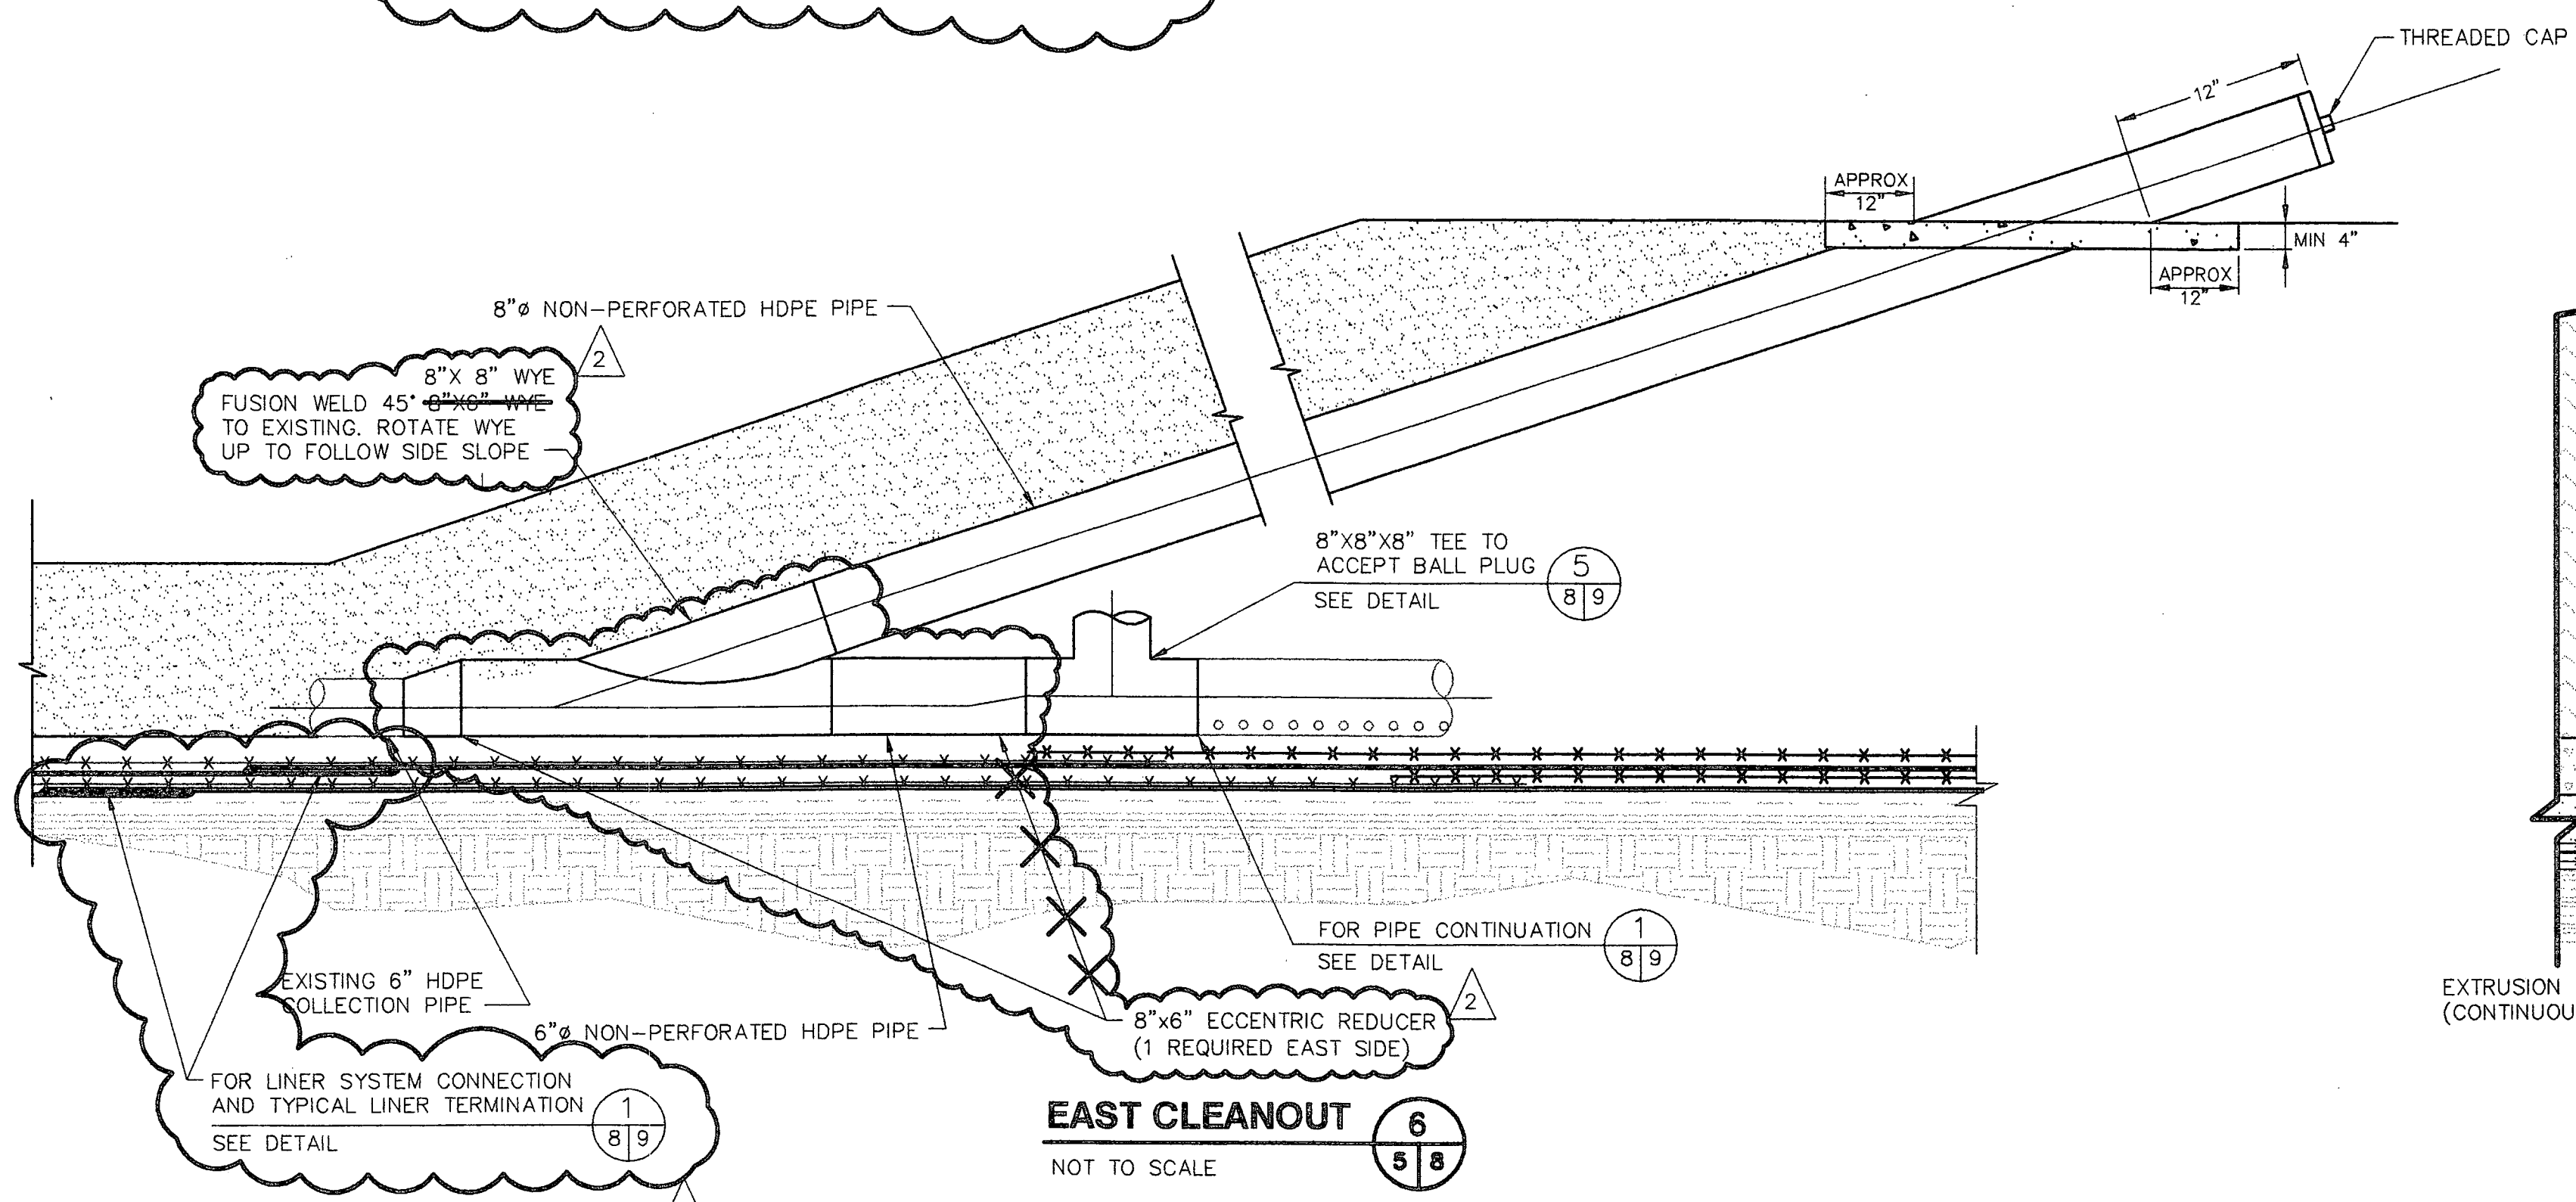

EAST CLEANOUT 6
NOT TO SCALE

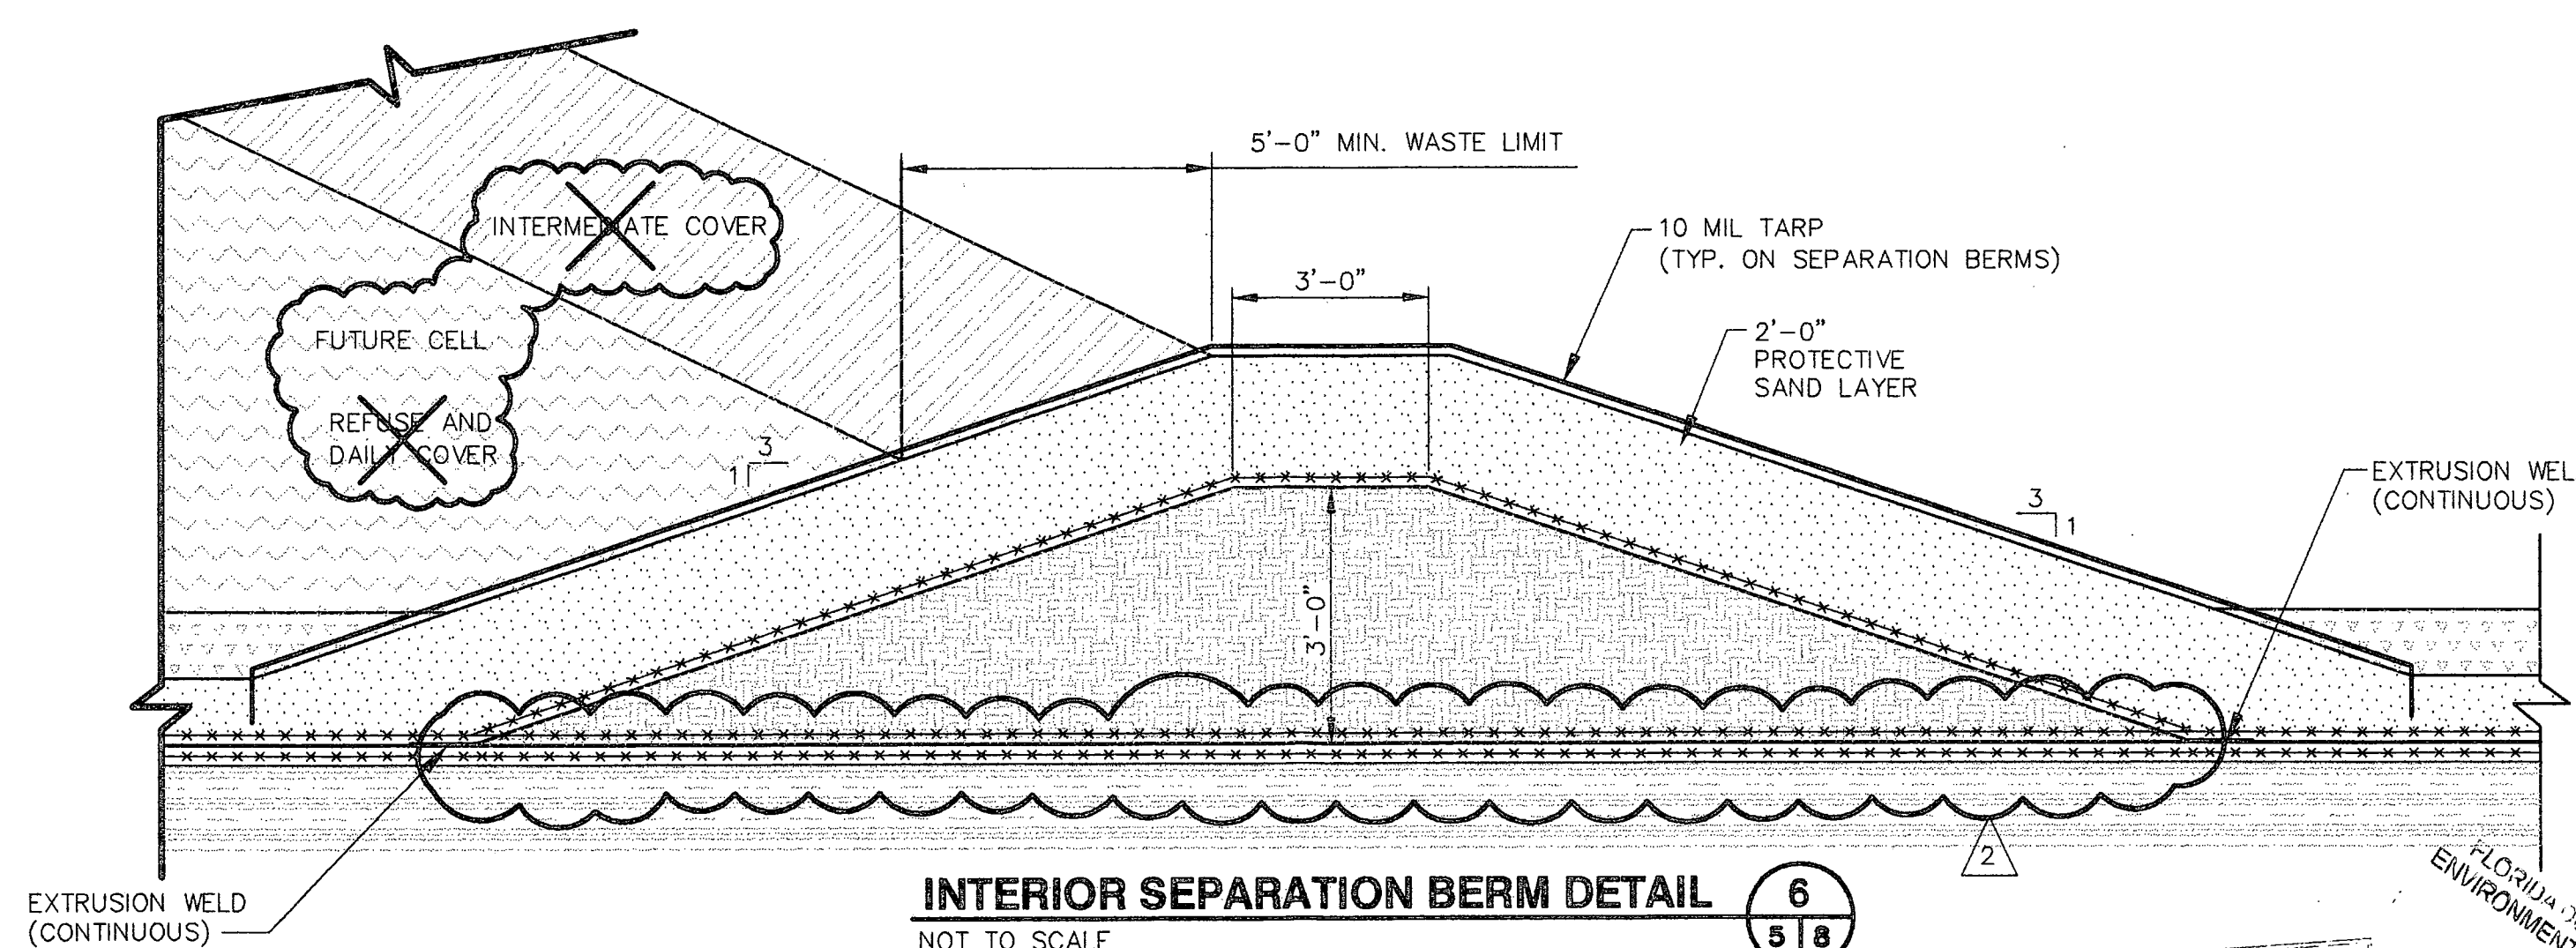

INTERIOR SEPARATION BERM DETAIL 6
NOT TO SCALE

LTR.	DATE	REVISIONS	BY	APPRO.
1		SCS REVISIONS - NORTH SWALE MODIFIED		
2	2/28/06	EAST COLLECTION TRENCH DETAIL ADDED;		
		ADDITIONAL ROCK PLACED OVER PIPES;		
		8"x8" WYE ADDED; GEOCOMPOSITE ADDED	JHV	JHO

DESIGNED **SCS ENGINEERS**

DRAWN **GRD**

CHECKED **JHO/JPA**

JONES EDMUNDS

730 NE WALDO ROAD, GAINESVILLE, FLORIDA 32641 / (352) 377-5821
324 S HYDE PARK AVE, TAMPA, FLORIDA 33606 / (813) 258-0703

HILLSBOROUGH COUNTY
SOLID WASTE MANAGEMENT DEPARTMENT
SOUTHEAST COUNTY LANDFILL

SECTION 8 CAPACITY EXPANSION
DETAILS -1
CONSTRUCTION DRAWINGS

CERTIFICATE OF AUTHORIZATION #1814	DATE	PROJECT NO.
APPROVED BY	2/28/06	08449-020-01
STATE OF FLORIDA	SCALE	DWG. NO.
JOSEPH H. O'NEILL, P.E.	AS SHOWN	8
P.E. # 082049		

RECORD DRAWINGS

FLORIDA DEPARTMENT OF ENVIRONMENTAL PROTECTION






MAR - 3 2006

SOUTHFLA DISTRICT TAMPA

INITIAL: MJ

57175

MAY 0 3 2011

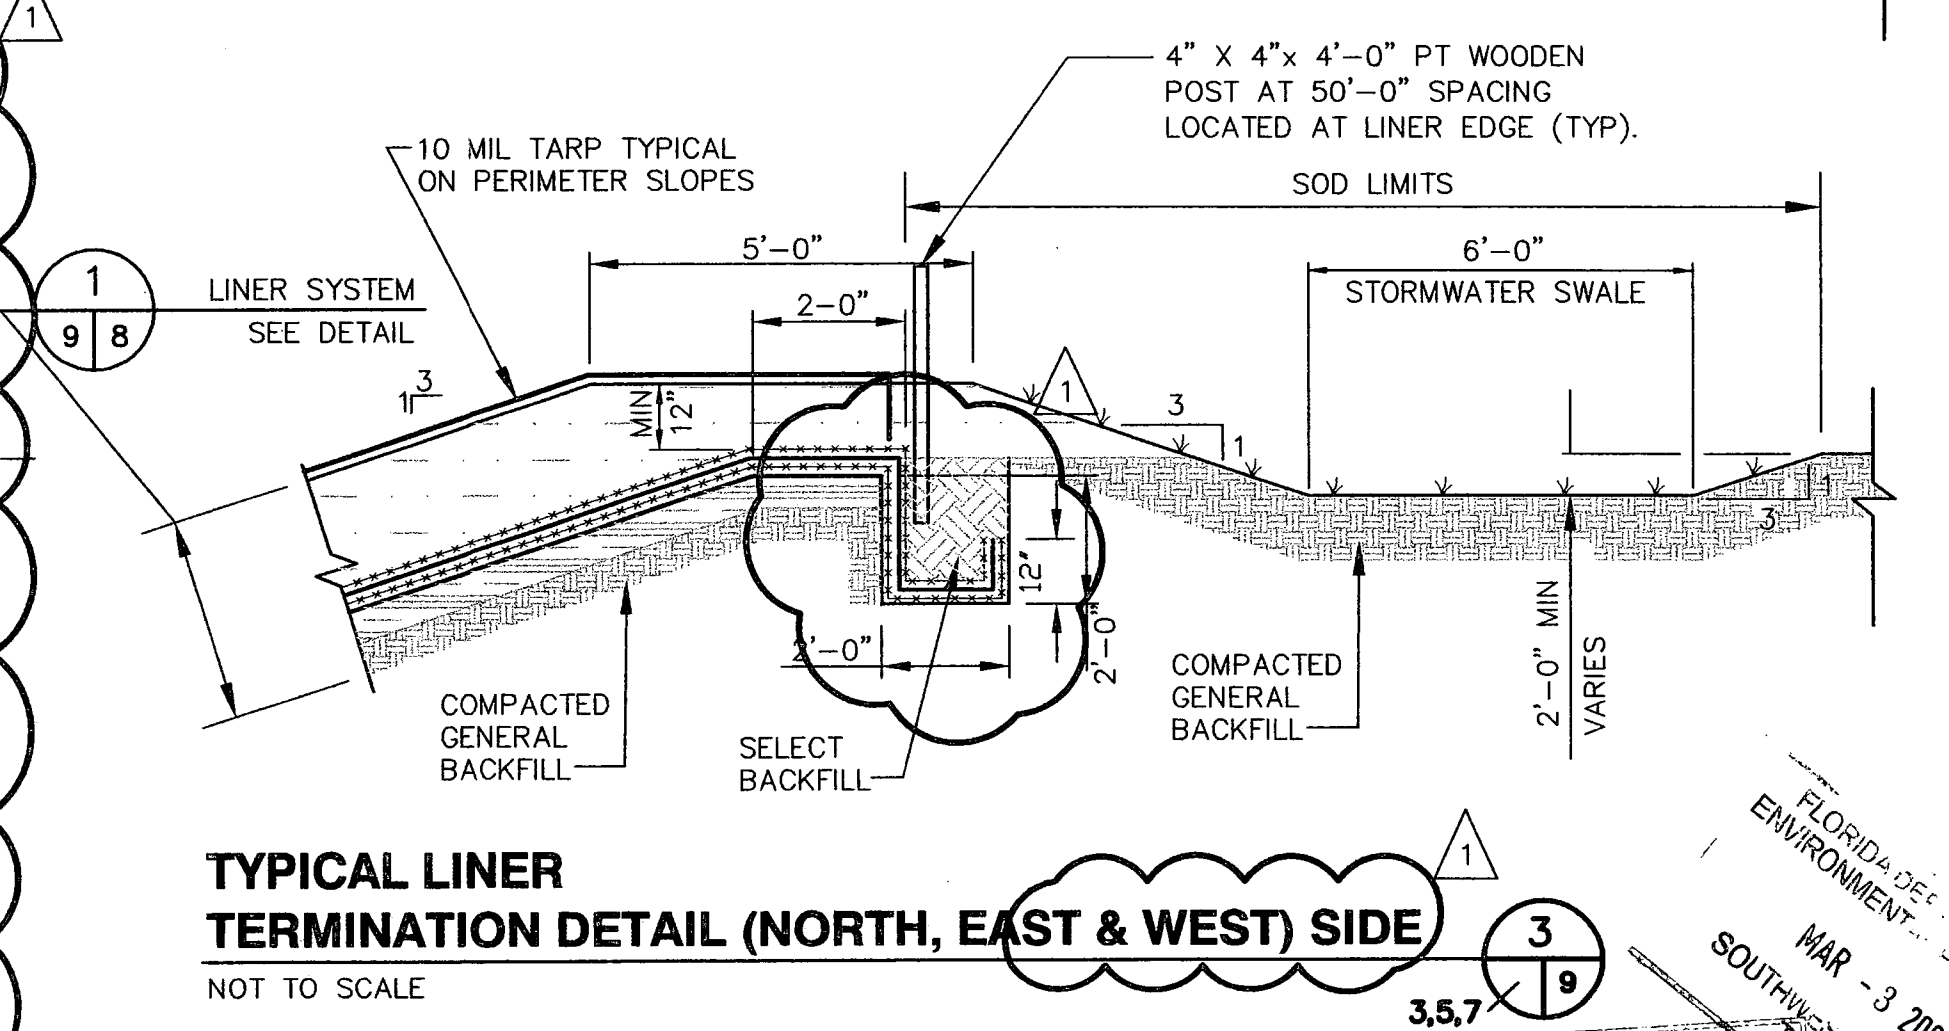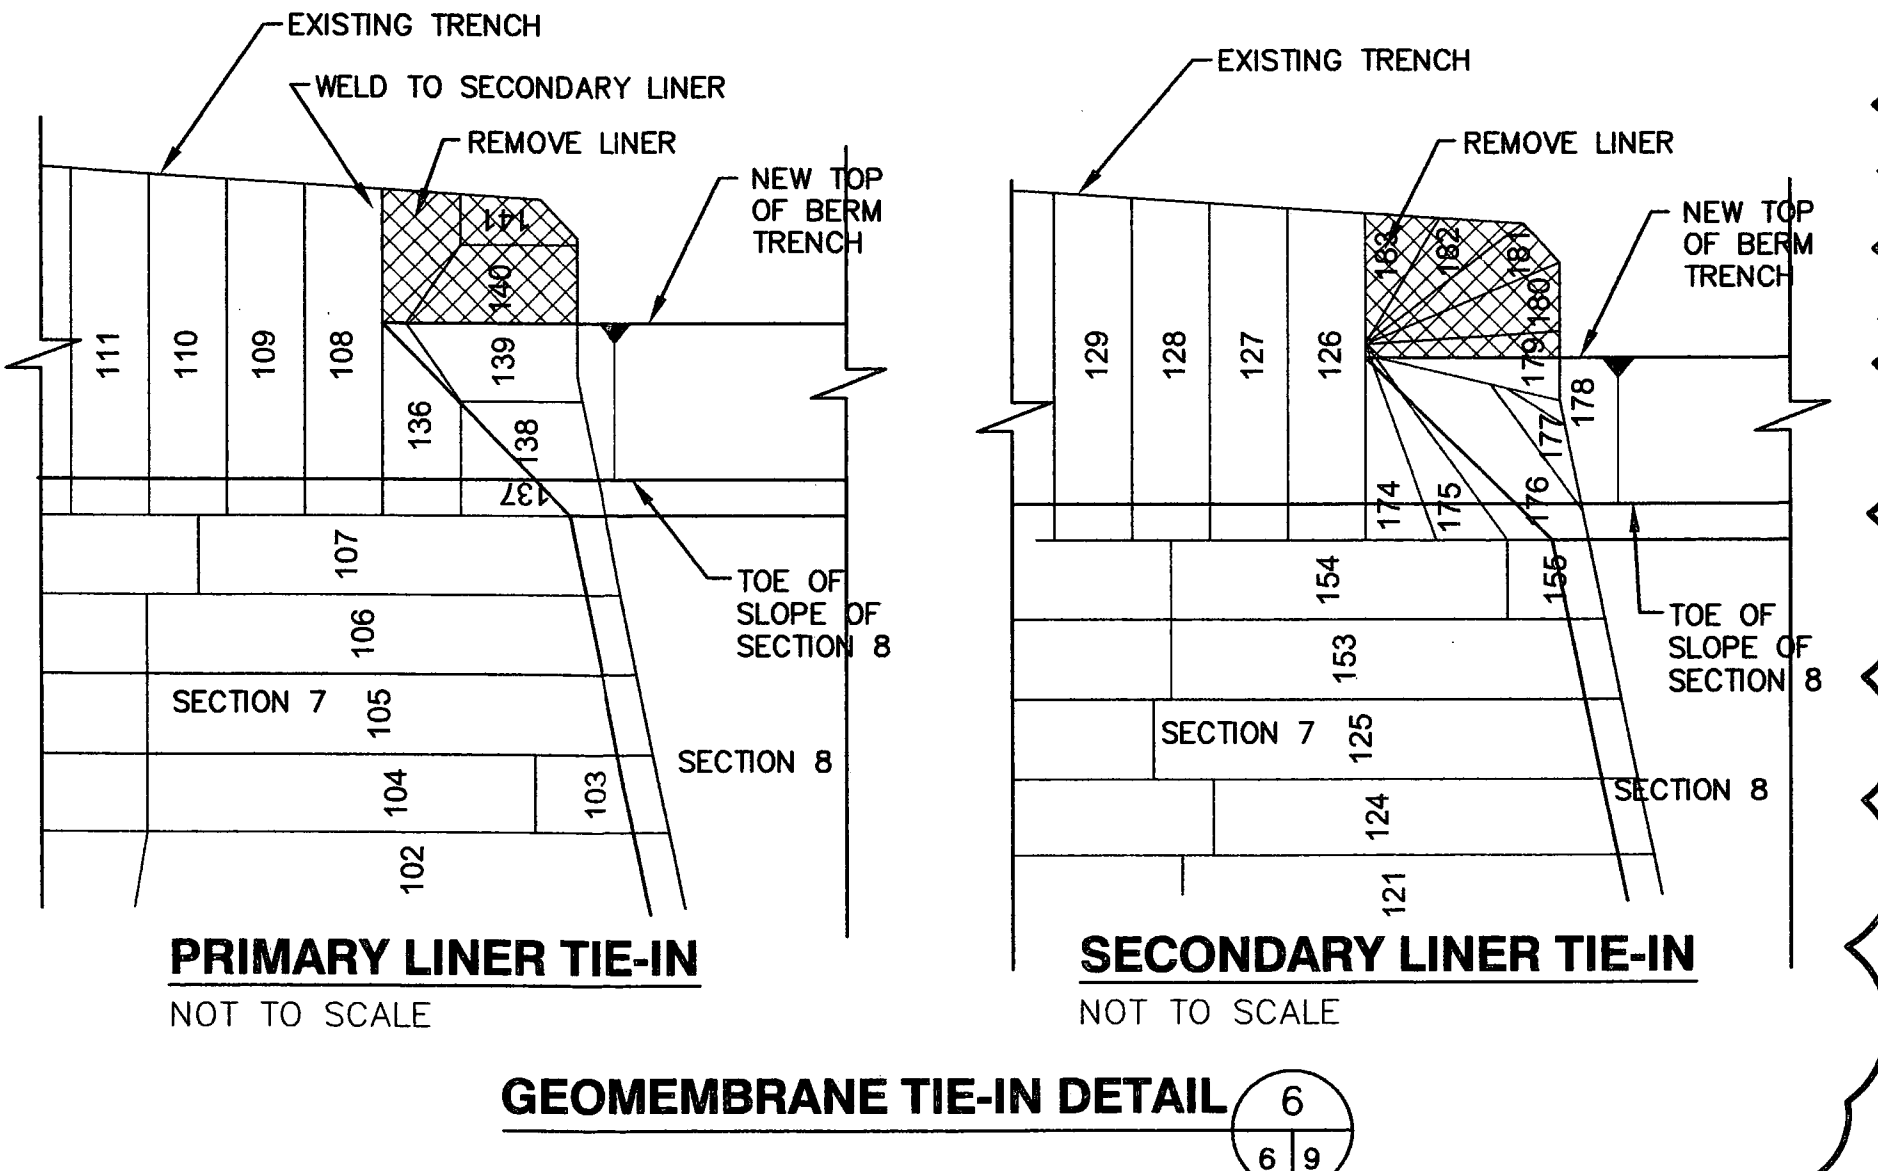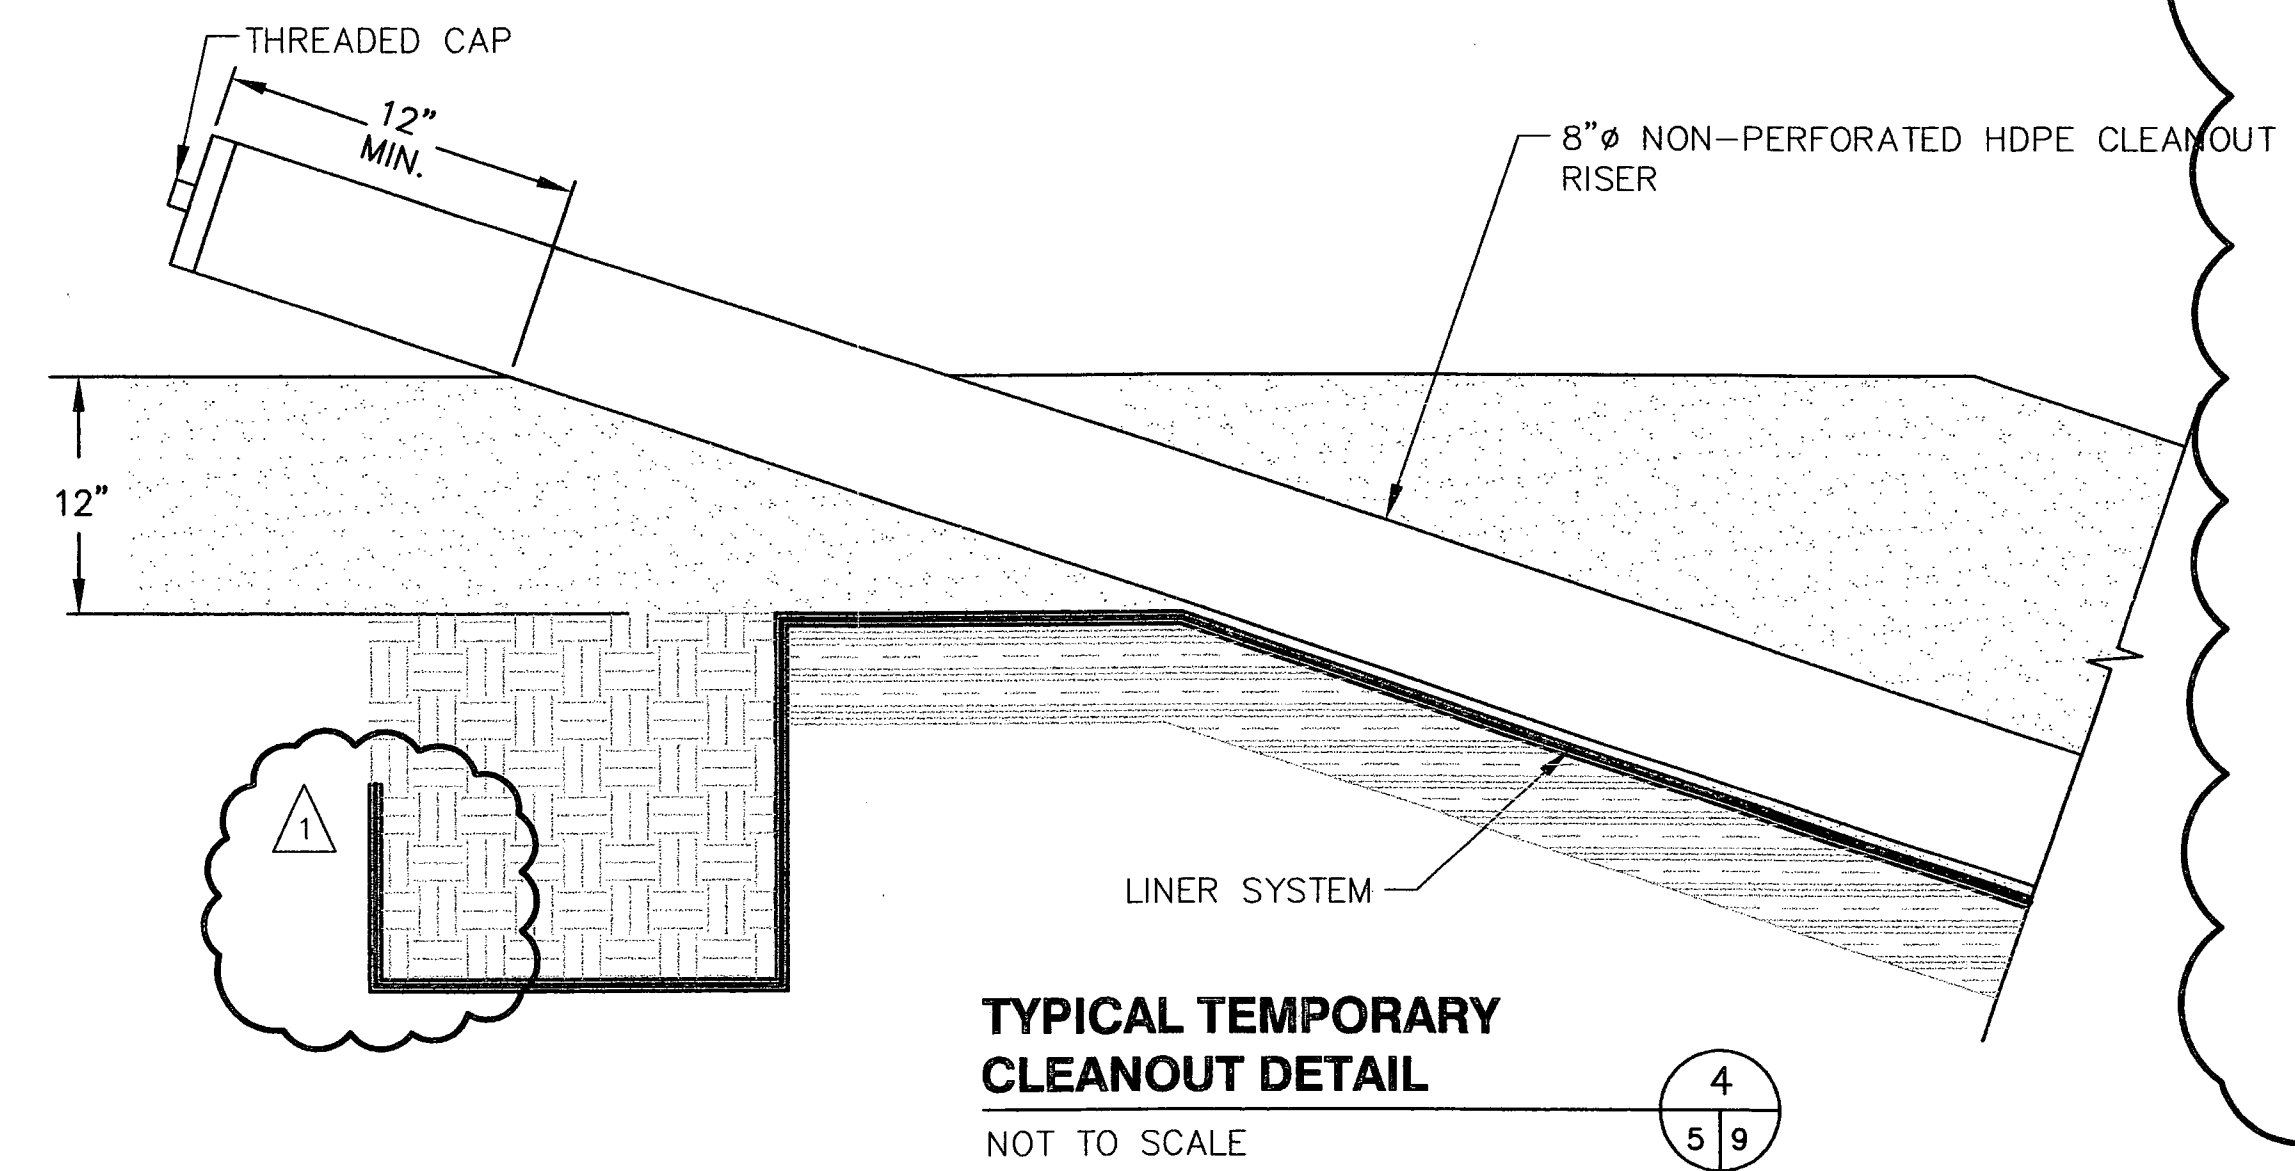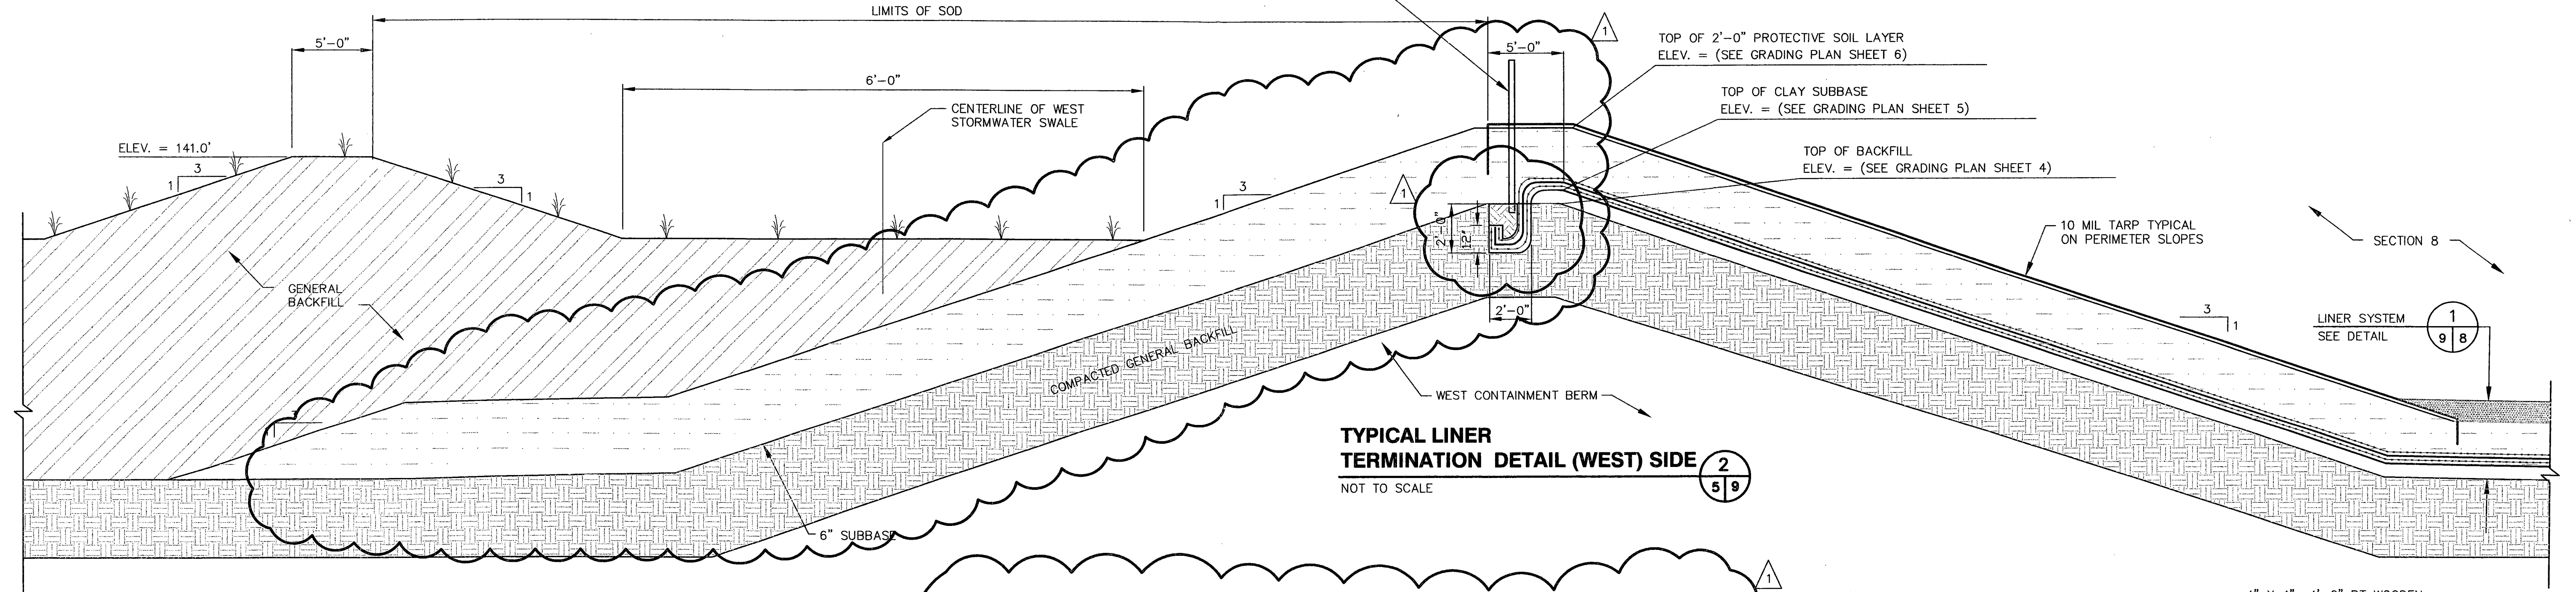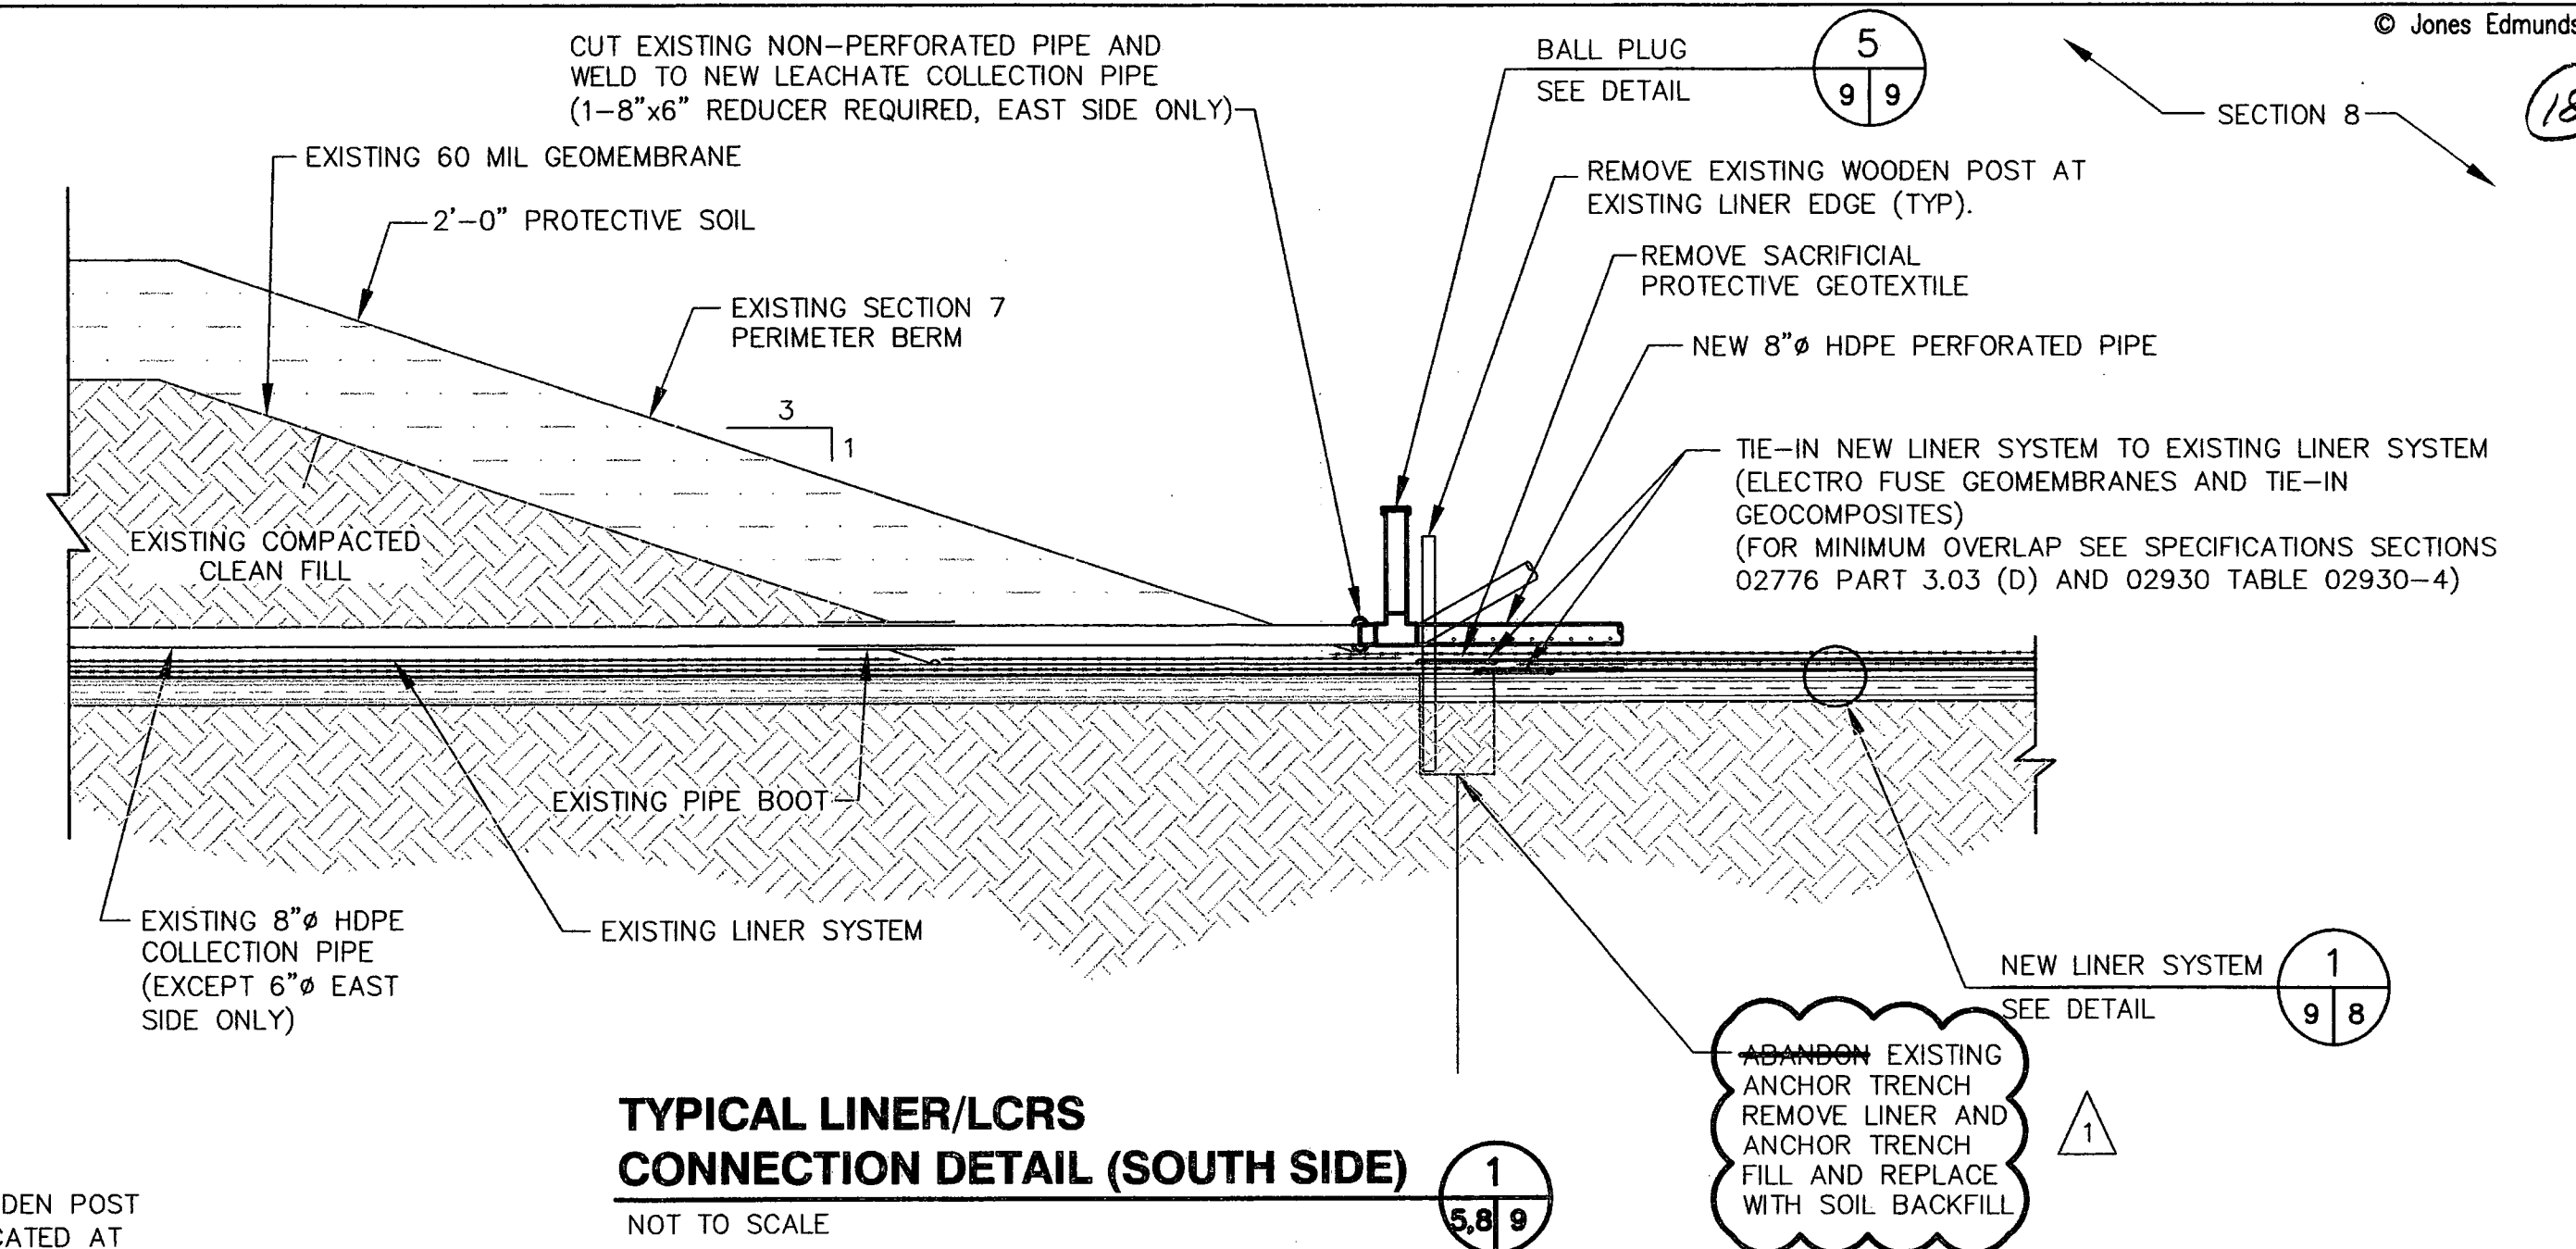

FLORIDA DEPARTMENT OF
ENVIRONMENT PROTECTION
MAR - 3 2006
SOUTHERN DISTRICT
S11175
MAY 05 2011
MAK

1	2/28/06	PLUG VALVE PLACEMENT CHANGED; ADDITIONAL MATERIAL ADDED TO ANCHOR TRENCH; GEOMEMBRANE REMOVED FROM WEST BERM; EXCESS GEOMEMBRANE REMOVED FROM SECTION 7	JHV	JHO	DESIGNED	SCS ENGINEERS	 730 NE WALDO ROAD, GAINESVILLE, FLORIDA 32641 / (352) 377-5821 324 S HYDE PARK AVE, TAMPA, FLORIDA 33606 / (813) 258-0703	HILLSBOROUGH COUNTY SOLID WASTE MANAGEMENT DEPARTMENT SOUTHEAST COUNTY LANDFILL	SECTION 8 CAPACITY EXPANSION DETAILS - 2 CONSTRUCTION DRAWINGS	CERTIFICATE OF AUTHORIZATION #1814 APPROVED BY:  3/4/06 JOSEPH H. O'NEILL, P.E. P.E. # 062049	DATE 2/28/06	PROJECT NO. 08449-020-01
					DRAWN	GRD				SCALE AS SHOWN	DWG. NO. 9	
					CHECKED	JHO/JPA						
LTR.	DATE	REVISIONS	BY	APPRD.								