

**HILLSBOROUGH COUNTY
SOUTHEAST COUNTY LANDFILL
CAPACITY EXPANSION AREA SECTIONS 7 - 9
CERTIFICATION OF CONSTRUCTION
COMPLETION**


Prepared for:

**HILLSBOROUGH COUNTY
SOLID WASTE MANAGEMENT DEPARTMENT**

601 East Kennedy Boulevard
County Center, 24th Floor
Tampa, Florida 33602

**Dept. of Environmental
Protection**

JUN 19 2008

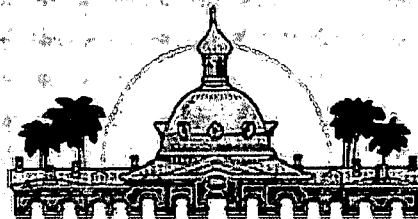


Southwest District

Prepared by:

JONES EDMUNDS & ASSOCIATES, INC.
324 S. Hyde Park Avenue, Suite 250
Tampa, Florida 33606

**JONES
EDMUNDS**
ENGINEERS | ARCHITECTS | SCIENTISTS

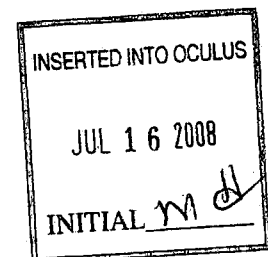

P.E. CERTIFICATE OF AUTHORIZATION #1841

June 2008

JONES EDMUNDS

June 17, 2008

Mr. R. Douglas Hyman, P.E.
Stormwater Engineer
Southwest District
Florida Department of Environmental Protection
13051 N Telecom Parkway
Temple Terrace, FL 33637-0926

Dept. Of Environmental Protection

**RE: Southeast County Landfill Cell Sections 7 -9
Certification of Construction Completion
DEP Permit No.: 29-0270881-001
JE Project No.: 08449-030-02**

JUN 19 2008

Southwest District

Mr. Hyman:


Jones Edmunds & Associates, Inc., on behalf of the Hillsborough County Solid Waste Management Department (SWMD), is pleased to provide the enclosed Certification of Construction Completion Report for the Southeast County Landfill (SCLF) Cell Sections 7 - 9. In accordance with Permit Number 29-0270881-001, General Condition 13 and Specific Condition 11, this Certification of Construction Completion is being submitted within 30 days of construction completion, which was June 12, 2008.

The enclosed completion report provides the Certification of Construction Completion including the following:


- Environmental Resource Permit As-Built Certification by a Registered Professional {DEP Form # 62-343.900(5)}
- Request for Transfer of Environmental Resource Permit Construction Phase to Operation Phase {DEP Form # 62-343.900(7)}
- Construction Completion Report
- Completion photographs
- Record Drawings (Drawings B1 - B-6, and Drawing 4, 4a, and 4b)
- As-Built Topographic Survey

Please let me know if you require any additional information.

Sincerely,


Joseph H. O'Neill, P.E.
Solid Waste Department Manager

cc: Patricia V. Berry, SWMD
Megan Miller, SWMD
Larry Ruiz, SWMD
Susan J. Pelz, FDEP
Ron Cope, HCEPC

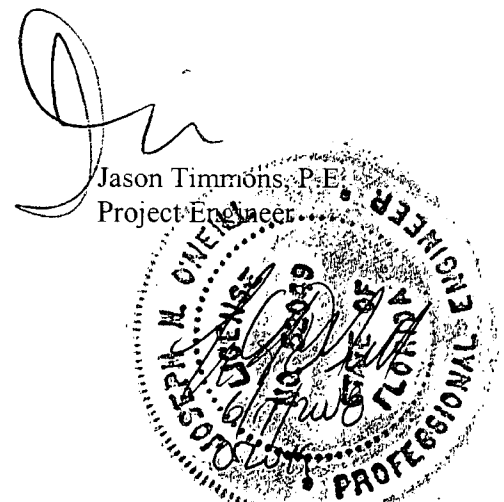

Jason Timmons, P.E.
Project Engineer

T:\08449 - Hillsborough\030-01 SCLF General Services\4000 - Phase 4 Site A Capacity Exp
\4300\Section 9 Const. Mgmt\3150 Correspondence Out\DEP\ERP-Section 7-9\
Completion Report\ConstructCompletion (Basin C)_Cover_Ltr.doc

324 South Hyde Park Avenue
Suite 250
Tampa, FL 33606

813.258.0703 Phone
813.254.6860 Fax
www.jonesedmunds.com

TABLE OF CONTENTS

PART I	ENVIRONMENTAL RESOURCE PERMIT AS-BUILT CERTIFICATION BY A REGISTERED PROFESSIONAL {DEP FORM # 62-343.900(5)}	
PART II	REQUEST FOR TRANSFER OF ENVIRONMENTAL RESOURCE PERMIT CONSTRUCTION PHASE TO OPERATION PHASE {DEP FORM # 62-343.900(7)}	
PART III	CONSTRUCTION COMPLETION REPORT	
1.0	<u>INTRODUCTION</u>	1
2.0	<u>CONSTRUCTION ACTIVITY SUMMARY</u>	1
2.1	SECTION 9 CONSTRUCTION.....	1
2.2	BASIN C MODIFICATION CONSTRUCTION.....	2
2.3	RECORD DRAWINGS	3
3.0	<u>COMPARISON OF PERMITTED CELL SECTION 7-9 CONDITIONS VERSUS COMPLETED CONDITIONS</u>	3

ATTACHMENTS

ATTACHMENT 1	CONSTRUCTION COMPLETION PHOTOGRAPHS
ATTACHMENT 2	STAFF GAUGE AND TURBIDITY MEASUREMENT RECORDS
ATTACHMENT 3	RECORD DRAWINGS
ATTACHMENT 4	AS-BUILT TOPOGRAPHIC SURVEY
ATTACHMENT 5	ICPR STORMWATER MODEL CONFIRMATION

PART I

**ENVIRONMENTAL RESOURCE PERMIT AS-BUILT
CERTIFICATION BY A REGISTERED PROFESSIONAL
{DEP FORM # 62-343.900(5)}**

ENVIRONMENTAL RESOURCE PERMIT
AS-BUILT CERTIFICATION BY A REGISTERED PROFESSIONAL

Permit Number: 29-0270881-001

Project Name: HCSELF Cell Sections 7 - 9 (Basin C)

I hereby certify that all components of this surface water management system have been built substantially in accordance with the approved plans and specifications and are ready for inspection. Any substantial deviations (noted below) from the approved plans and specifications will not prevent the system from functioning as designed when properly maintained and operated. These determinations are based upon on-site observation of the system conducted by me or by my designee under my direct supervision and/or my review of as-built plans certified by a registered professional or Land Surveyor licensed in the State of Florida.

Joseph H. O'Neill

Name (please print)

Signature of Professional

Jones Edmunds & Associates, Inc.
Company Name

52049
Florida Registration Number


324 S Hyde Park Ave
Company Address

Date June 17, 2008

Tampa, Florida 33615
City, State, Zip Code

813-258-0703
Telephone Number

(Affix Seal)

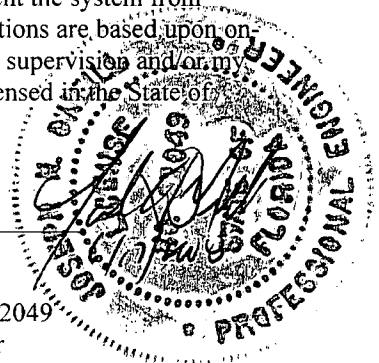

Dept. Of Environmental Protection

JUN 19 2008

Southwest District

Substantial deviations from the approved plans and specifications:

(Note: attach two copies of as-built plans when there are substantial deviations)

Within 30 days of completion of the system, submit two copies of the form to:

PART II

**REQUEST FOR TRANSFER OF ENVIRONMENTAL
RESOURCE PERMIT CONSTRUCTION PHASE TO
OPERATION PHASE {DEP FORM # 62-343.900(7)}**

Request for Transfer of Environmental Resource Permit Construction Phase to Operation Phase

(To be completed and submitted by the operating entity)

Florida Department of Environmental Protection

It is requested that Department Permit Number 29-0270881-001 authorizing the construction and operation of a surface water management system for the below mention project be transferred from the construction phase permittee to the operation phase operating entity.

Project: HCSELF Cell Sections 7 - 9 (Basin C)

From: Name: Joseph H. O'Neill, P.E., Agent, Jones Edmunds & Associates, Inc.
Address: 324 S. Hyde Park Ave., Suite 250
City: Tampa State: Florida Zip: 33606

To: Name: Hillsborough County Southeast County Landfill
Address: 15960 CR 672
City: Lithia State: Florida Zip: 33547

The surface water management facilities are hereby accepted for operation and maintenance in accordance with the engineers certification and as outlined in the restrictive covenants and articles of incorporation for the operating entity. Enclosed is a copy of the document transferring title of the operating entity for the common areas on which the surface water management system is located. Note that if the operating entity has not been previously approved, the applicant should contact the Department staff prior to filing for a permit transfer.

The undersigned hereby agrees that all terms and conditions of the permit and subsequent modifications, if any, have been reviewed, are understood and are hereby accepted. Any proposed modifications shall be applied for and obtained prior to such modification.

Operating Entity: Barry Boldissar

Name

Title: Director

Telephone: 813-272-5680

Enclosure

- ☒ copy of recorded transfer of title surface water management system
- ☒ Coy of plat(s)
- ☐ Copy of recorded restrictive covenants, articles of incorporation, and certificate of incorporation.

PART III

CONSTRUCTION COMPLETION REPORT

**HILLSBOROUGH COUNTY
SOUTHEAST COUNTY LANDFILL
CAPACITY EXPANSION AREA SECTIONS 7 - 9**

**CERTIFICATION OF CONSTRUCTION
COMPLETION**

Project No.: 08449-030-02

Dept. Of Environmental Protection

Permit No.: 29-0270881-001

JUN 19 2008

Prepared For:

Southwest District


**HILLSBOROUGH COUNTY
SOLID WASTE MANAGEMENT DEPARTMENT**
601 East Kennedy Boulevard
County Center, 24th Floor
Tampa, Florida 33602

Engineer:

JONES EDMUNDS & ASSOCIATES, INC.
324 S. Hyde Park Avenue, Suite 250
Tampa, Florida 33606

Certificate of Authorization #1841

June 2008

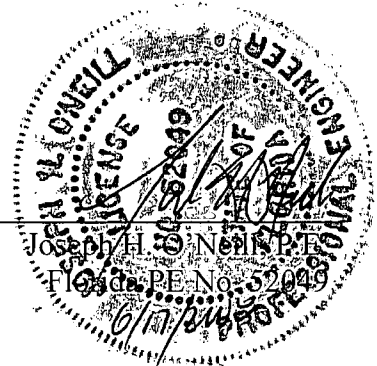

1.0 INTRODUCTION

Jones Edmunds & Associates, Inc. (Jones Edmunds) developed construction documents and provided oversight for the construction of the Hillsborough County Southeast County Landfill (SCLF) Section 9 Capacity Expansion Project. The design plans submitted as part of the permit application were reviewed and approved by the Florida Department of Environmental Protection (DEP). An Environmental Resource Permit for Cell Sections 7 – 9 was issued on July 20, 2007 (DEP Permit No. 29-0270881-001). The Section 9 Capacity Expansion Project Notice to Proceed was issued to the Contractor on July 25, 2007.

The project included the activities related to Section 9 construction and modifications to Basin C. The construction activities for Section 9 included excavation, dewatering, stockpiling of excavated soils, improvements to the stormwater ditches, and placement of new box culverts that discharge into Basin C. The modifications to Basin C include converting the existing dry detention stormwater pond with effluent filtration into a wet detention system.

Onsite observation was performed by the Jones Edmunds resident project representative and Quality Environment Services, Inc. (QES), a subcontractor working under the direct supervision of Jones Edmunds. Jones Edmunds and QES worked in conjunction with the SCLF Operations Manager. Additional onsite observation and office support was provided by Jones Edmunds engineers and staff.

This report provides documentation demonstrating that the construction activity related to Landfill Cells 7 - 9 was completed in substantial conformance with Part IV of Chapter 373, F.S. and Chapter 40D-4, Florida Administration Code (FAC), the approved plans, and project specifications as required the DEP Environmental Resource Permit No. 29-0270881-001. Photographs of construction activities for the stormwater management systems for Section 7, 8 and 9 and Basin C modification construction are provided in Attachment 1.

2.0 CONSTRUCTION ACTIVITY SUMMARY

The construction of the SCLF Section 9 stormwater management systems and Basin C is described in the following sections.

2.1 SECTION 9 CONSTRUCTION

A Preconstruction Meeting for the Section 9 Capacity Expansion Project, that included the modifications to Basin C, was held on July 25, 2007. The DEP was notified of the meeting in accordance with Specific Condition 8 of the permit. The meeting was attended by representative of the DEP ERP Program.

As required in Specific Condition 9 of the permit, quarterly progress reports were submitted to the DEP beginning on July 1, 2007. The report outlined the activities completed during the previous quarter and a project of the work to be accomplished. These reports were dated June 29, 2007; October 1, 2007; December 31, 2007; and April 1, 2008.

Section 9 construction activities began with installation of a silt fence around the Section 9 construction site, the construction trailers, equipment lay down area, and the stockpile area. Two

staff gauges were installed in Mine Cuts No.1 and No. 2, which are located to the east and northeast of the construction area, respectively, to observe water elevations and possible dewatering effects on the mine cuts. Two additional staff gauges were also installed, one in Mine Cut No. 3 and one in Mine cut No. 4. The levels were monitored weekly in accordance with Specific Condition 33 of the permit. No significant change in water elevation was observed during the project. Staff gauge elevations were recorded beginning on August 24, 2007 to April 23, 2008. A plot of the staff gauge records are provided in Attachment 2.

Turbidity measurements were collected up to six times per week in Mine Cut No. 1. Turbidity was measured to monitor the performance of the sedimentation controls used during construction as directed in Specific Condition 16 of the permit. Starting on August 3, 2007, a total of eleven turbidity measurements were made before excavation started on August 20, 2007, to establish a background level. The background level was established at 10.12 NTUs. Since August 20, 2007, 191 turbidity measurements were recorded. No measurements exceeded the permit required limit of 29 NTUs above background levels (i.e. 39.12 NTUs). A plot of the turbidity measurements are provided in Attachment 2.

Dewatering operations for the Section 9 construction area, which began on October 3, 2007, were completed on February 14, 2008, after completion of excavation activities. Rainfall and groundwater that accumulated in the excavation was conveyed to the lower end of the excavation, by rim ditches, where it was pumped into the permitted dewatering Rapid Infiltration Basin (RIB) area. The stockpile for excavated soils and RIB were constructed and used in accordance with Drawings 4, 4A, and 4B of the construction drawings.

The 4 foot by 8 foot concrete box culverts were installed in early April of 2008. The access roadway construction around Section 9 was completed by early May of 2008. Construction of Drainage Swales 'A' & 'B' for Section 9 surface water runoff was completed by mid April, 2008.

A Decommissioning Plan submitted to the Department of Environmental Protection on August 10, 2007 called for the RIB basin to be graded and seeded when construction is completed. The RIB is currently within the SCLF active borrow area so final grades within this area have not been achieved. As the SCLF need borrow material, soil will be excavated from the stockpile and RIB area to lower the elevations. As it currently existing, both the Stockpile and the RIB area are surrounded by higher ground and berm that would prevent runoff from entering the adjacent mine cuts or run off-site. Thus, in our professional opinion, not fully implementing the Decommissioning plan at this time not needed.

2.2 BASIN C MODIFICATION CONSTRUCTION

Prior to any modifications or excavation of soil from Basin C, sediment samples for Basin C were collected and analyzed in accordance with Specific Condition 35 of the permit. The result of the analysis was provided in correspondence to DEP dated August 10, 2007. The sediment analysis result showed that the sediments were below the guidance limits and do not pose a threat of violation to surface or groundwater parameters. Thus soils from Basin C were excavated and staged within the stockpile area.

Basin C modifications began on mid March 14, 2008 and were completed on mid April, 2008. Basin C construction activities include excavation of existing berms, construction of berms for the modified Basin C area, construction of inlet/sedimentation basin area, and modification of the overflow/outlet structure.

The project involved modifications to an existing dry detention stormwater pond (basin) with effluent filtration (Basin C). Basin C was converted into a wet detention pond with a littoral zone. The pond was designed to have sufficient capacity to provide water quality pre-treatment and attenuation for a total contributing area of 61.7 acres. The pond can treat in excess of the first one inch of runoff from the 61.7 contributing area, and provide attenuation for the 25 year, 24-hour design storm event. A new emergency spillway was designed to prevent the Basin C perimeter berm from overtopping during extreme storm events and to discharge to the adjacent wetland deep mine cut. The spillway and the flow path from the spillway to the adjacent wetland are stabilized by grass on mature sandy soils.

2.3 RECORD DRAWINGS

The completed stormwater management systems for Section 9 and the Basin C modifications are shown in the Record Drawings provided in Attachment 3. Revisions to the permitted design drawings are marked by a cloud while deletions are marked with strikethroughs. All deviations were reviewed and approved by the Engineer of Record and are made part of this certified completion report.

A final as-built survey, completed by Southeastern Surveying, Inc., of the Section 9 stormwater system and Basin C modification is provided in Attachment 4.

3.0 COMPARISON OF PERMITTED CELL SECTION 7-9 CONDITIONS VERSUS COMPLETED CONDITIONS

The following is a listing of the changes made to the original permit, ERP Permit No. ERP Permit Nos. 29-0270881-001.

- In accordance with Specific Condition 23 of the permit, signs have been posted along the perimeter of the wet detention pond stating "Stormwater Treatment Pond – No mowing or spraying of aquatic vegetation allowed unless authorized by FDEP. Call 813/632-7600 for more information." As discussed with DEP in email correspondence dated April 4, 2008 the number of signs was reduced from a minimum of a sign every 100 feet to a total of seven signs located along the perimeter of Basin C.
- During construction layout of Basin C it was noted that the northern berm placement would have required the removal of several large oak trees. To accommodate leaving the oak trees in place, the northern berms were modified to go around the trees. Additional storage volume to gained by modifying the sideslopes on the westside of the Basin C from a 4(h):1(v) to a 3(h):1(v) sideslope. This modification was discussed with DEP prior to completion of Basin C and approval of the modification was allowed. The modified Basin C design was also used for the modeling used in ERP Permit No. 29-0270881-003.

A comparison of permitted and post-development storm peak discharges as well as post-development water quality treatment for Basin C is provided in Table 1.

Table 1. Comparison Table of Basin C Parameters

	Permitted Basin C	As-built Basin C		
Treatment Volume	Treatment for 1" of runoff from the contributing area is 231,891.0 ft ³ (5.32 ac-ft)	Treatment for 1" of runoff from the contributing area is 231,891.0 ft ³ (5.32 ac-ft)		
Total Capacity	1) For the 25-year, 24-hour storm, inflow to Basin C is 248 cfs with a total volume of 1,497,162 cubic feet (34.37 ac-ft). 2) The post development runoff at the off-site discharge point had a total volume of 5,285,353 cubic feet (123.6 ac-ft)	1) For the 25-year, 24-hour storm, inflow to Basin C is 248 cfs with a total volume of 1,497,162 cubic feet (34.37 ac-ft). 2) The post development runoff at the off-site discharge point had a total volume of 5,285,353 cubic feet (123.6 ac-ft)		
Littoral Zone	The littoral zone covers 36.8% (1.3 acres) of the pond surface.	The littoral zone covers 36.8% (1.3 acres) of the pond surface.		
Stage Areas	Elevation	Total Sq Ft	Elevation	Total Sq Ft
	120	65,498	120	63,930
	121	71,974	121	71,544
	121.7	104,406	121.7	115,606
	122	104,965	122	117,070
	123	126,577	123	136,924
	123.7	148,540	123.7	143,730
	124	149,411	124	148,683
	125	157,687	125	157,314
	126	165,528	126	165,487
	127	172,062	127	175,406
	128	179,032	128	179,553
	129	186,437	129	187,146
	130	193,842	130	195,658
Orifice Bleed Down Size	3 inches	3 inches		


The construction of the Section 9 and modifications to Basin C were completed in accordance with the general and specific conditions provided in ERP Permit Nos. 29-0270881-001 and 29-0270881-003.

All the as-built conditions were input into the permitted stormwater model for ERP Permit No. 29-0270881-003 (the latest stormwater model to include Section 7,8,&9 plus the runoff from the LTRF tank area. As shown in the calculations contained in Attachment 5, the stormwater calculations for discharge, littoral zone, treatment volume, and drawdown of treatment volume meet the permit requirements.

In summary, Basin C was constructed in accordance with the design intent and permit of the ERP and the modification made during construction did not alter the design intent or permit requirements.

ATTACHMENT 1

CONSTRUCTION COMPLETION PHOTOGRAPHS

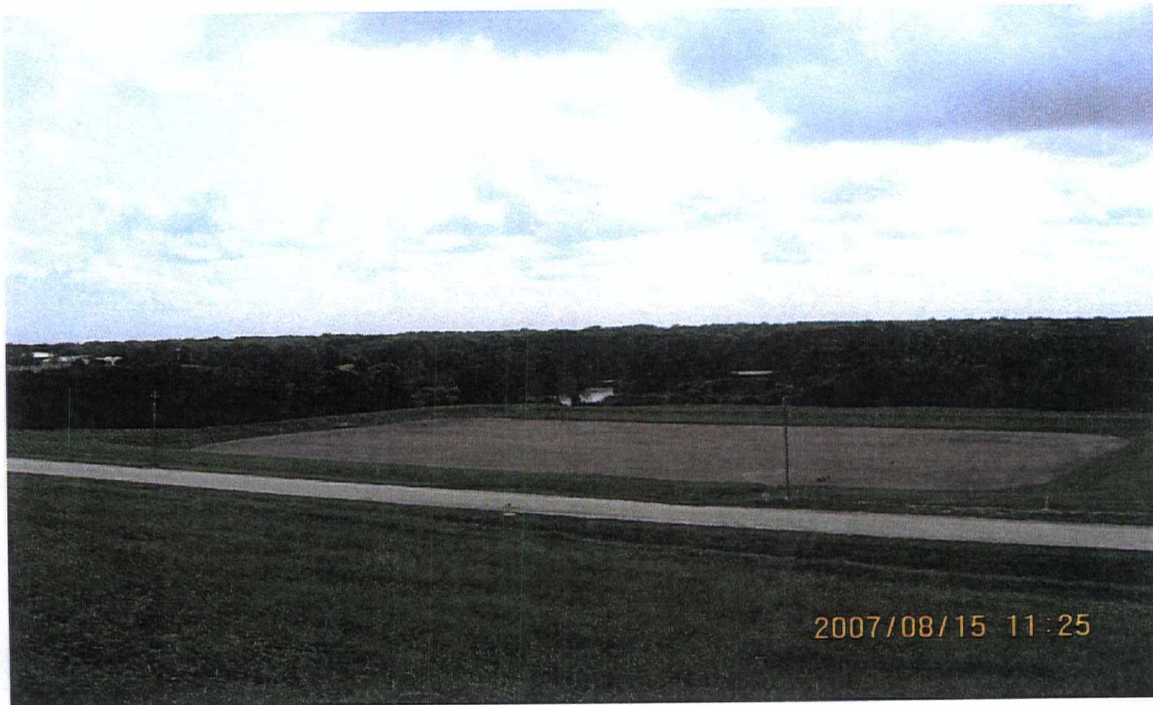

Dept. Of Environmental Protection

Figure 1 - August 15, 2007 Basin C Construction photo looking to the east from Section 7 to Basin C.

JUN 19 2008

Southwest District

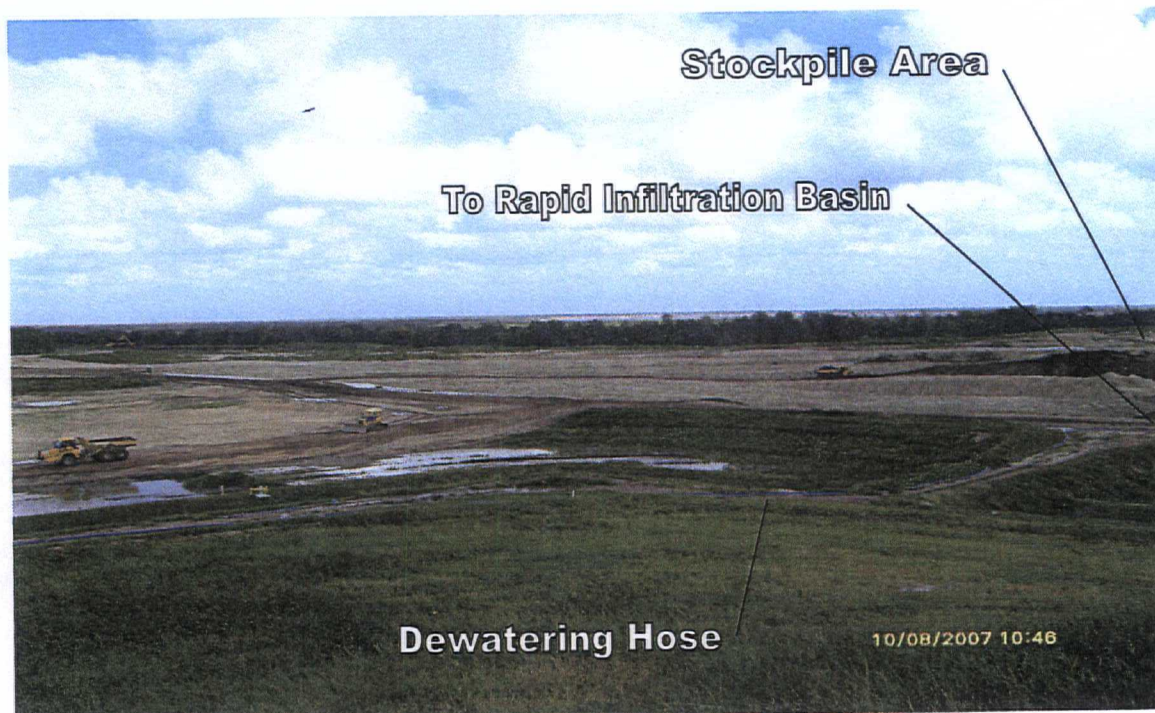


Figure 2 - October 8, 2007 Section 9 Construction photo showing rain water being dewatered to the Rapid Infiltration Basin.



Dept. Of Environmental Protection

Figure 3 – February 18, 2008 Basin C Construction photo shows Basin C prior to any modifications.

JUN 19 2008

Southwest District



Figure 4 – March 24, 2008 Basin C Construction photo shows work beginning at Basin C.



Figure 5 – March 26, 2008 Basin C Construction photo shows formwork being built for the wings on the headwall for the box culvert.



Figure 6 – March 31, 2008 Basin C Construction photo shows Swale B earthwork and the formwork being built for the end treatment for the dual ADS pipes.



Figure 7 – April 3, 2008 Basin C Construction Photo –This photo shows Basin C modification construction.



Figure 8 – April 15, 2008 Basin C Construction Photo – This photo shows the weekly progress of Basin C modification.

Dept. Of Environmental Protection

JUN 19 2008

Southwest District



Figure 9 – April 28, 2008 Basin C Construction Photo – This photo shows the weekly progress of Basin C modification and the placement of sod.



Figure 10 – June 9, 2008 Basin C Construction Photo – This photo shows a completed standpipe with skimmer.



Figure 11 – June 9, 2008 Basin C Construction Photo – This photo shows the inside of a completed standpipe with skimmer.



Figure 12 – June 9, 2008 Basin C Construction Photo – This photo shows the completed headwall for the box culvert leading into Basin C.

Department of Environmental Protection

JUN 19 2008

Southwest District



Figure 13 – June 9, 2008 Basin C Construction Photo – This photo shows the completed Swale B leading into Basin C.

Dept. Of Environmental Protection


JUN 19 2008

Southwest District


ATTACHMENT 2

**STAFF GAUGE AND TURBIDITY MEASUREMENT
RECORDS**

Staff Gauge Measurement Summary Graph

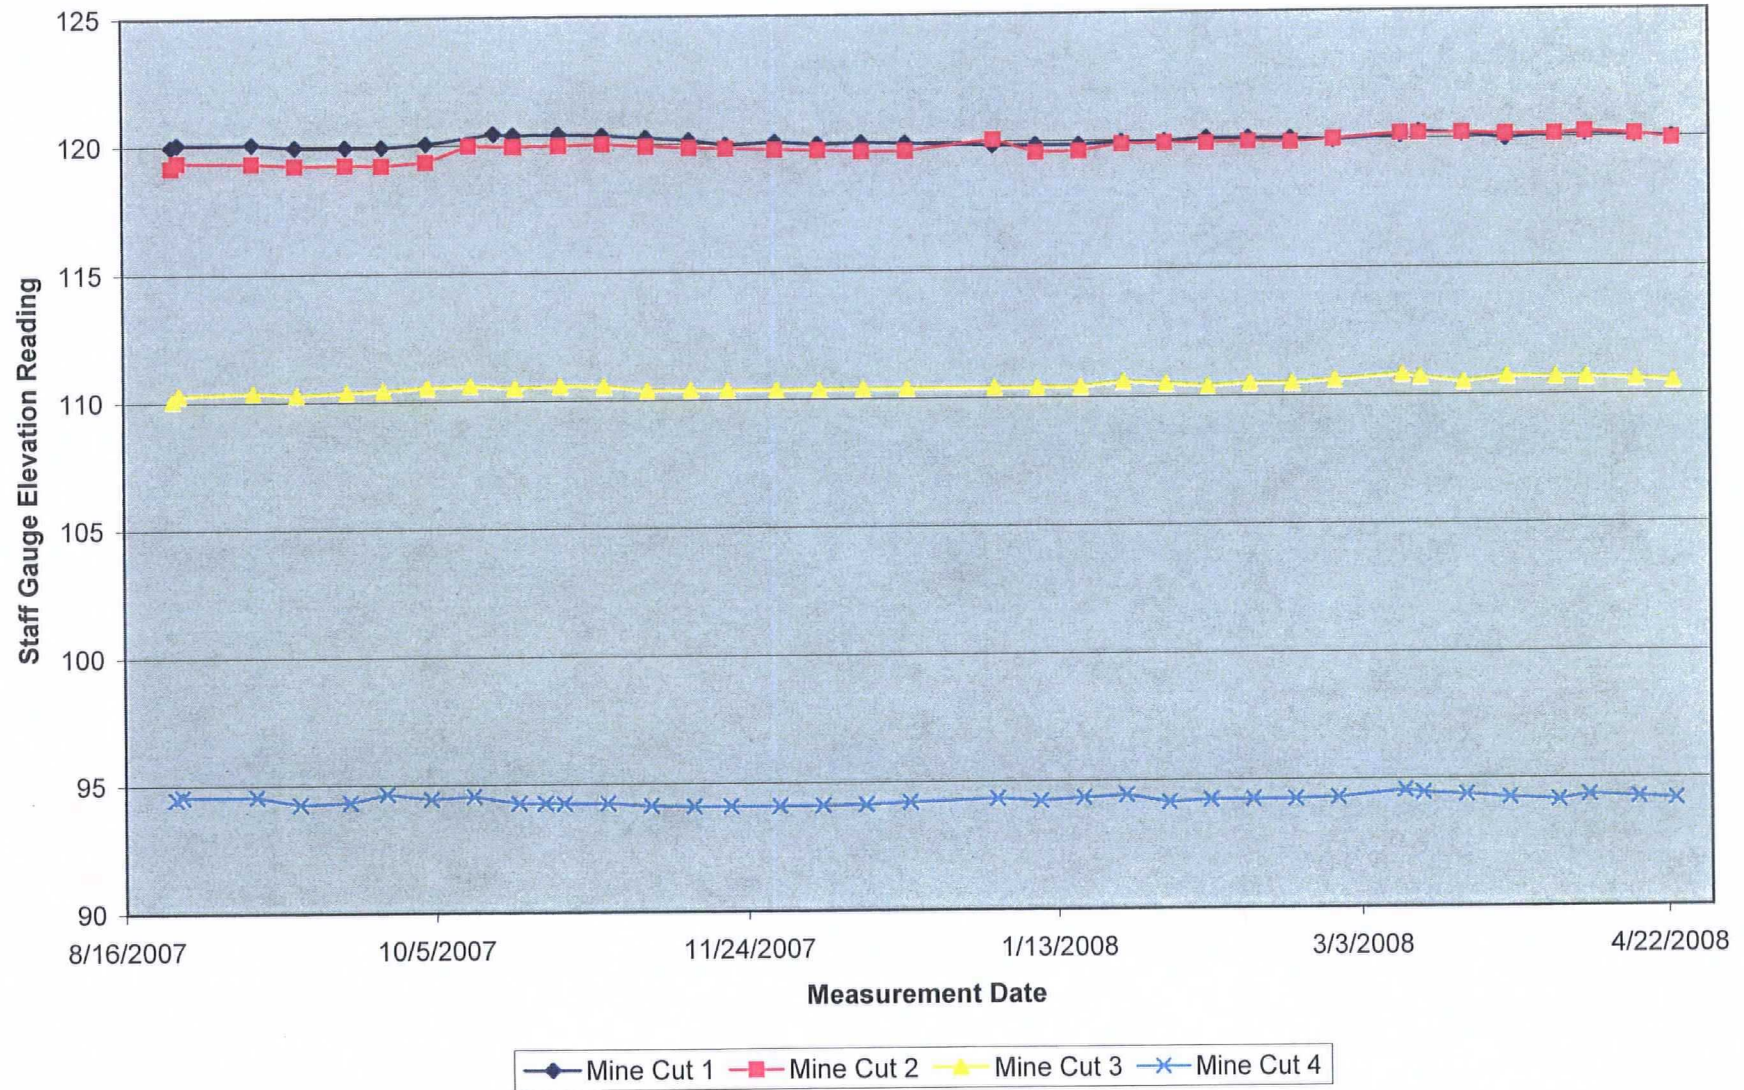


Turbidity Measurement Summary Graph
(measured at Mine Cut 1)

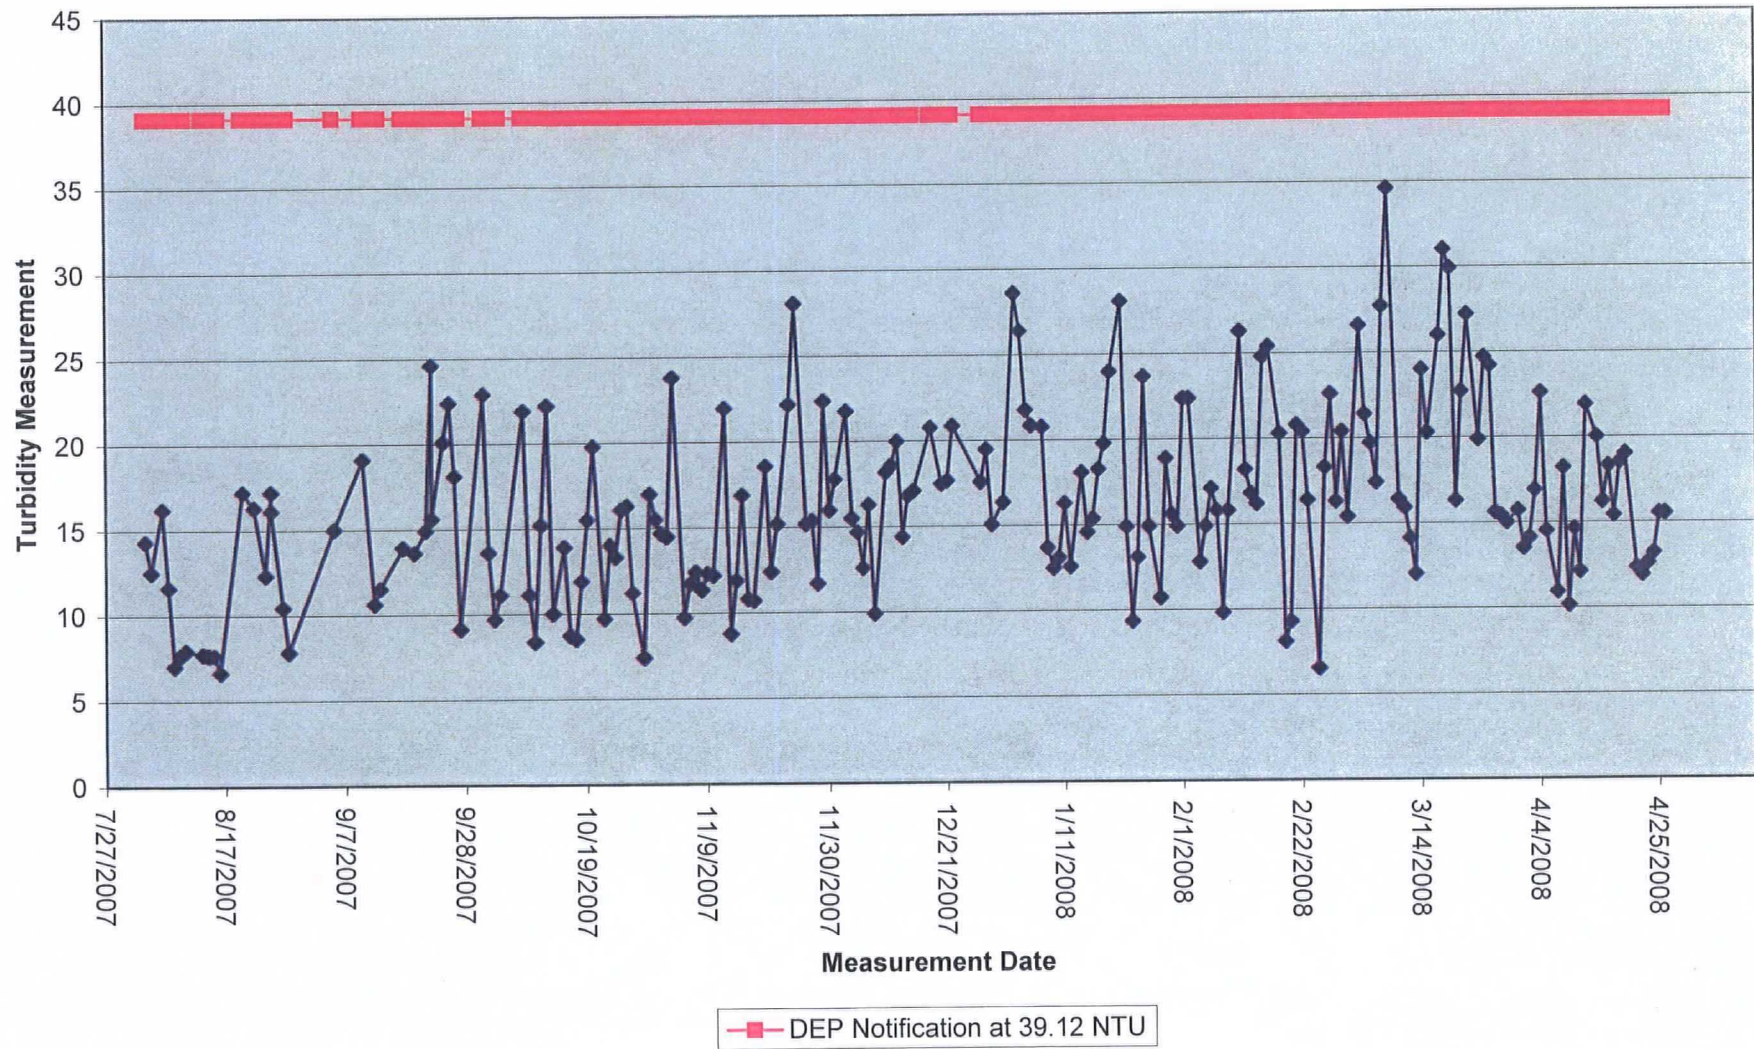

ATTACHMENT 3
RECORD DRAWINGS

N:\08449 Hillsborough County\021-SELF Section 9\Final Design Drawings\AS-BUILT\2008-05-27\0844902101-C-04-MASTER-SITE-Plan4.dwg Plotted: 6/09/08 - jpm white

Edited: 00/00/00 0:00 login

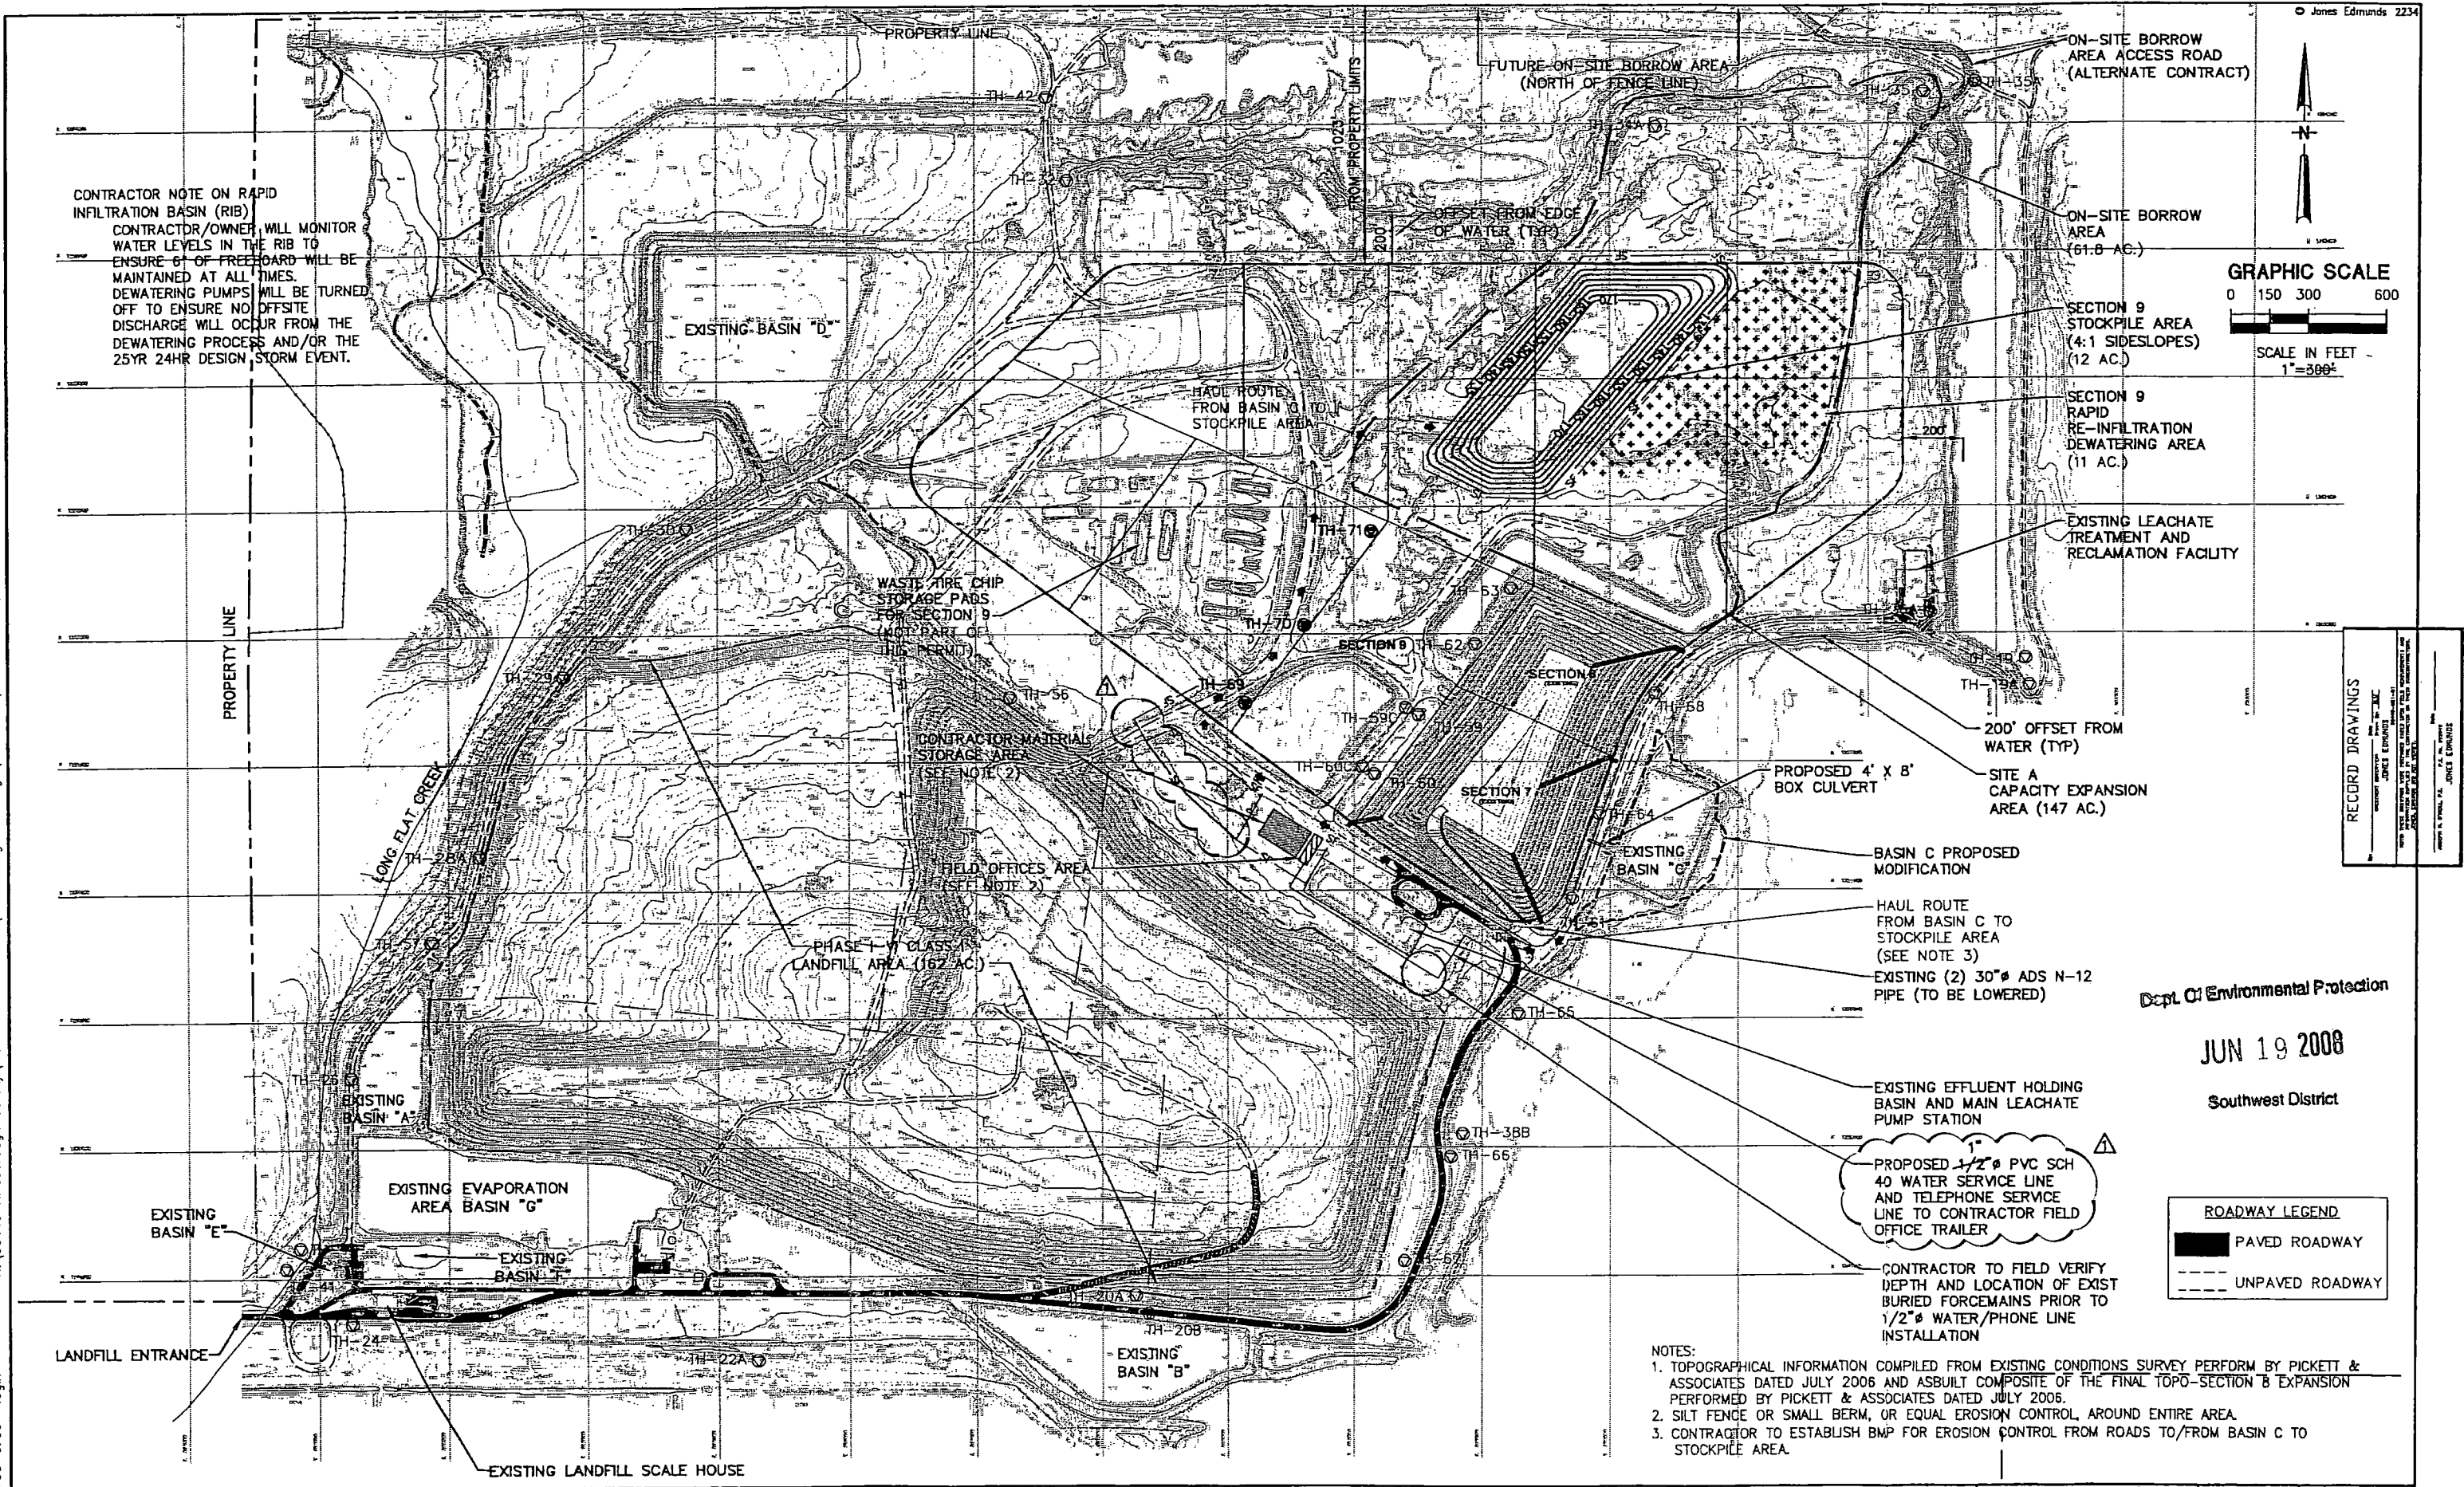

					DESIGNED	JHO/RAS
					DRAWN	GRD
					CHECKED	JHO
					BY	JHO
					APPROD.	

JONES EDMUNDS
730 NE WALDO ROAD, GAINESVILLE, FLORIDA 32641 / (352) 377-6821
324 S HYDE PARK AVE, TAMPA, FLORIDA 33608 / (813) 258-0705

HILLSBOROUGH COUNTY
SOLID WASTE MANAGEMENT DEPARTMENT
SOUTHEAST COUNTY LANDFILL


SECTION 9 CAPACITY EXPANSION
FACILITY SITE PLAN 1

CERTIFICATE OF AUTHORIZATION #1841 APPROVED BY	DATE 01/2007	PROJECT NO. 08449-021-01
JOSEPH H. O'NEILL, P.E. P.E. # 052049	SCALE AS SHOWN	DWG. NO. 4

Plotted: 6/09/08 4:40pm dwl

N:\084449 Hillsborough County\021-SELF Section 9\Final Design Drawings\AS-BUILT\2008-05-27\0844902101-C-04A-SITE SECT.dwg

Edited: 00/00/00 0:00 login

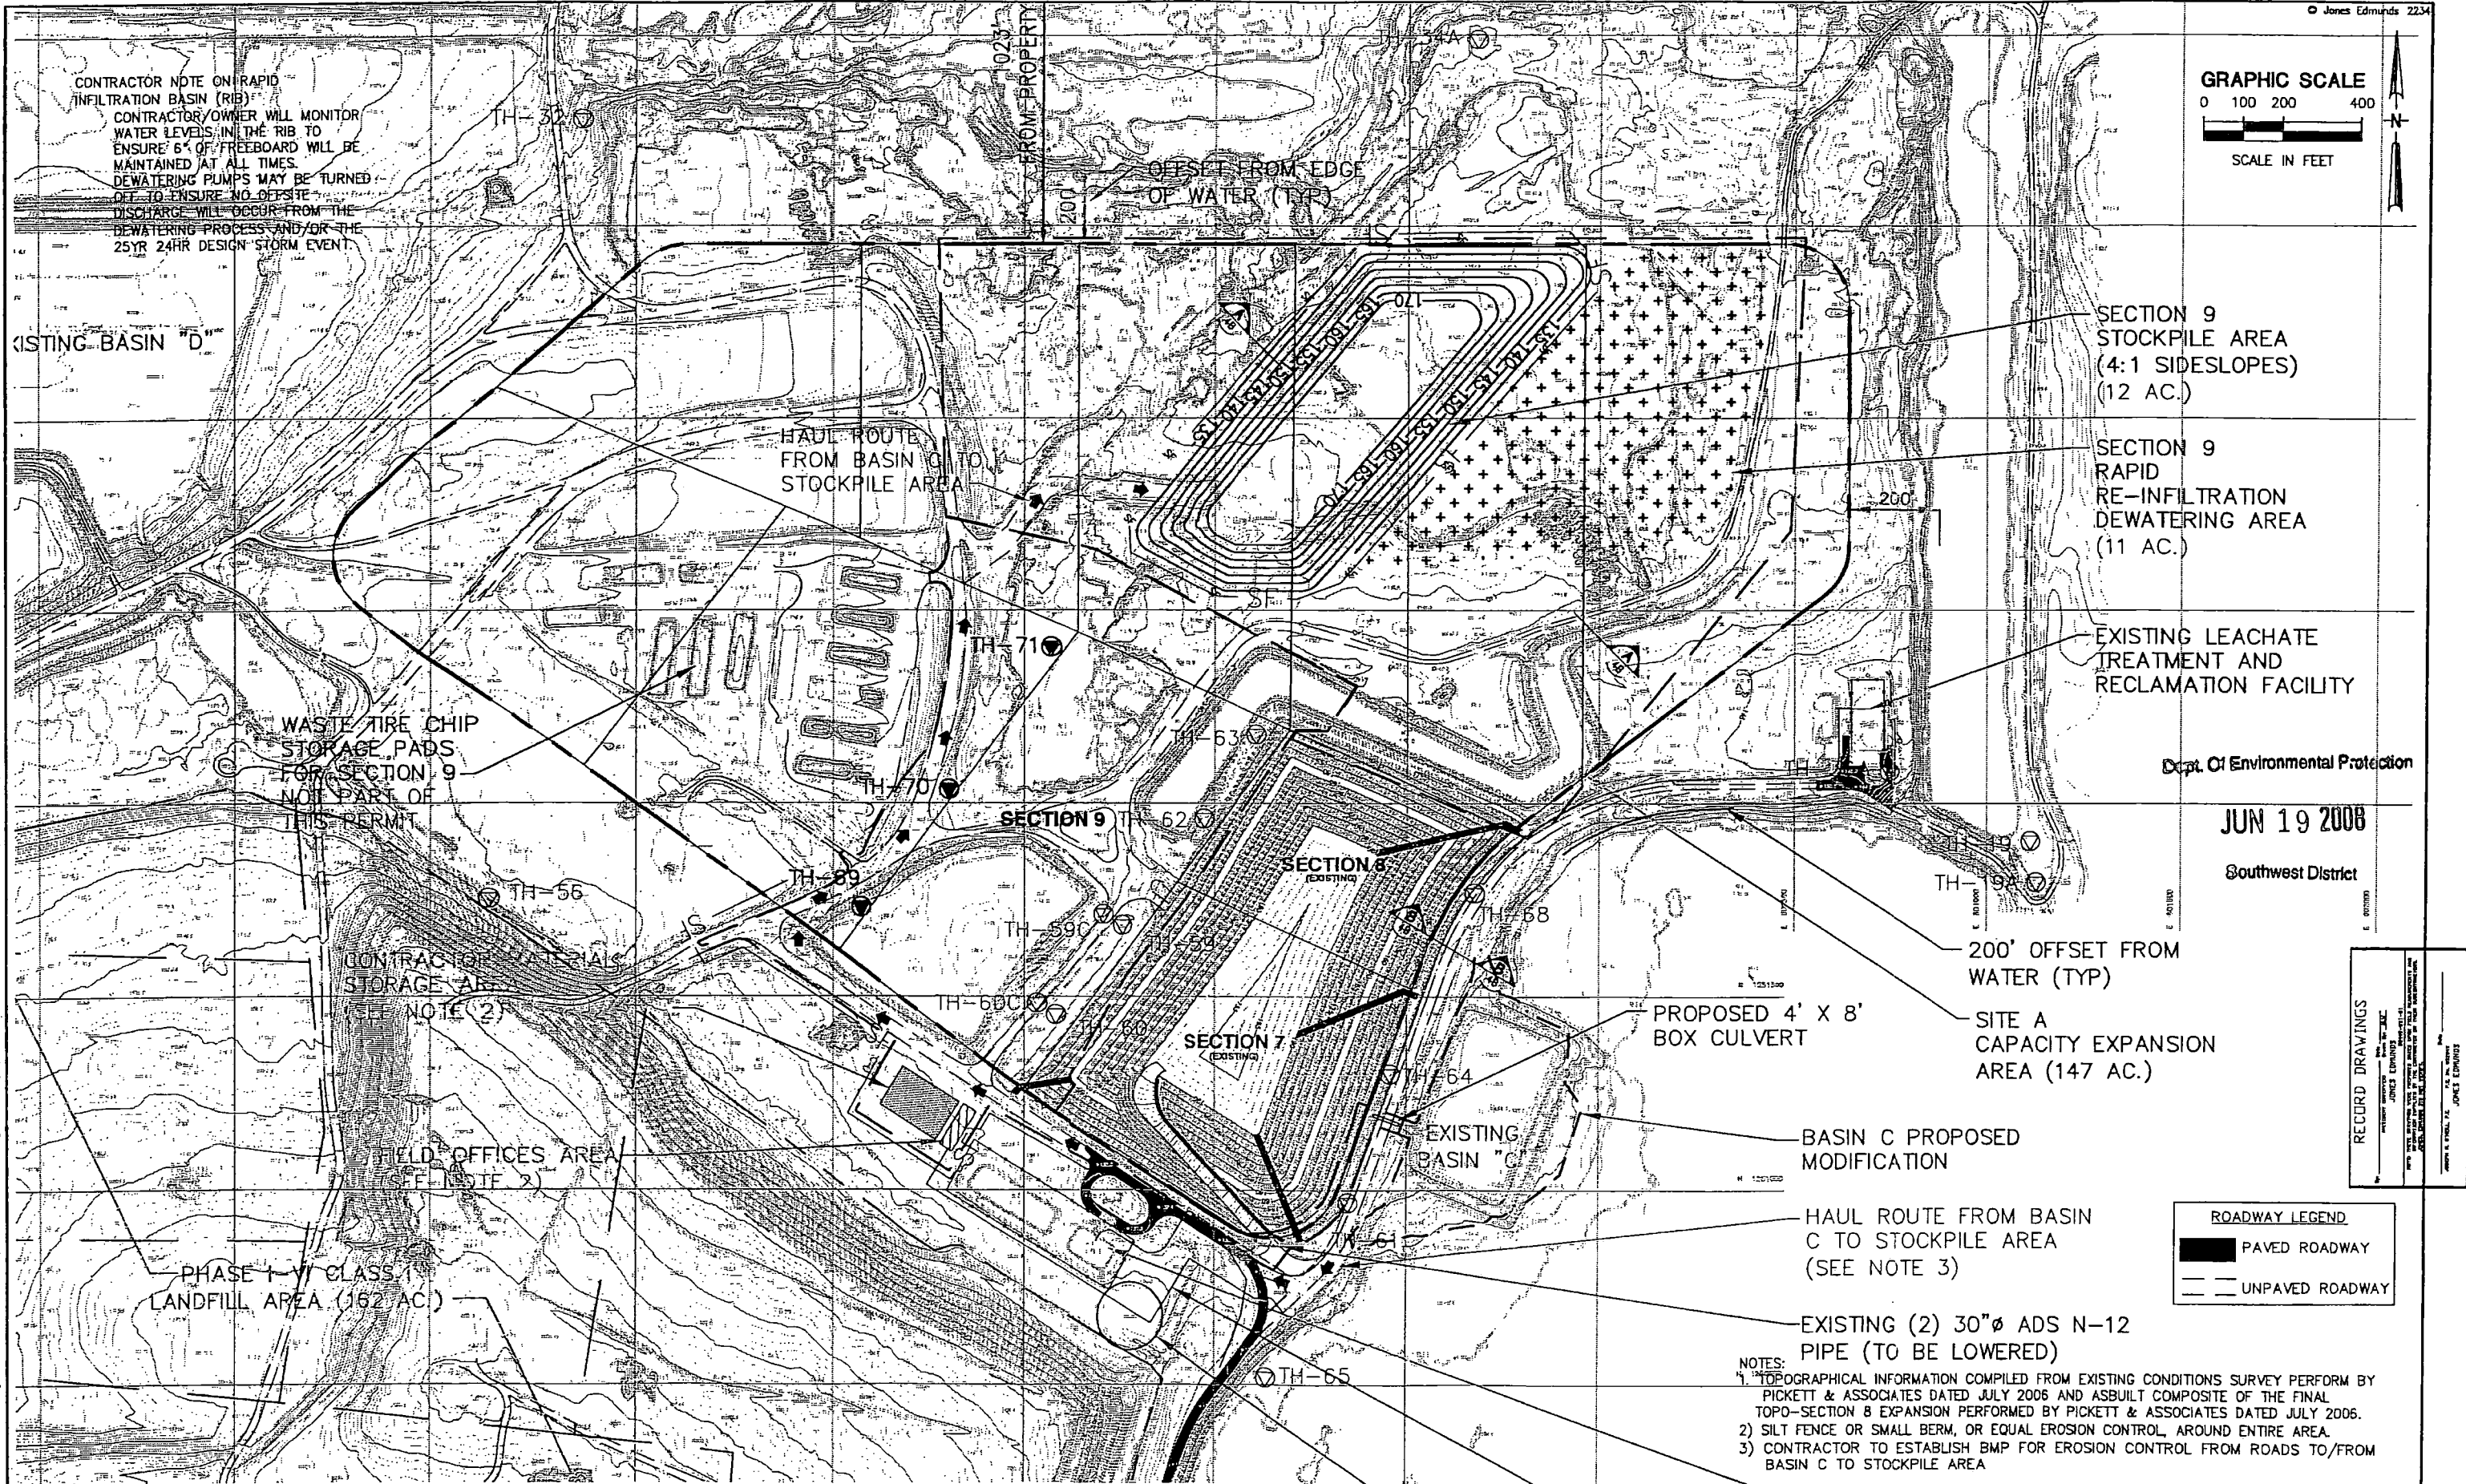

GRAPHIC SCALE
0 100 200 400
SCALE IN FEET

SECTION 9
STOCKPILE AREA
(4:1 SIDESLOPES)
(12 AC.)

SECTION 9
RAPID
RE-INFILTRATION
DEWATERING AREA
(11 AC.)

EXISTING LEACHATE
TREATMENT AND
RECLAMATION FACILITY

Dept. Of Environmental Protection

JUN 19 2008

Southwest District

200' OFFSET FROM
WATER (TYP)

SITE A
CAPACITY EXPANSION
AREA (147 AC.)

PROPOSED 4' X 8'
BOX CULVERT

BASIN C PROPOSED
MODIFICATION

HAUL ROUTE FROM BASIN
C TO STOCKPILE AREA
(SEE NOTE 3)

EXISTING (2) 30"Ø ADS N-12
PIPE (TO BE LOWERED)

- NOTES:
- 1) TOPOGRAPHICAL INFORMATION COMPILED FROM EXISTING CONDITIONS SURVEY PERFORM BY PICKETT & ASSOCIATES DATED JULY 2006 AND ASBUILT COMPOSITE OF THE FINAL TOPO-SECTION 8 EXPANSION PERFORMED BY PICKETT & ASSOCIATES DATED JULY 2006.
 - 2) SILT FENCE OR SMALL BERM, OR EQUAL EROSION CONTROL, AROUND ENTIRE AREA.
 - 3) CONTRACTOR TO ESTABLISH BMP FOR EROSION CONTROL FROM ROADS TO/FROM BASIN C TO STOCKPILE AREA

ROADWAY LEGEND
PAVED ROADWAY
UNPAVED ROADWAY



DESIGNED	JHO/RAS
DRAWN	GRD
CHECKED	JHO
BY	JHO
APPROD.	
LTR.	DATE
REVISIONS	

JONES EDMUNDS
730 NE WALDO ROAD, GAINESVILLE, FLORIDA 32641 / (352) 377-5821
324 S HYDE PARK AVE, TAMPA, FLORIDA 33606 / (813) 258-0703


HILLSBOROUGH COUNTY
SOLID WASTE MANAGEMENT DEPARTMENT
SOUTHEAST COUNTY LANDFILL

SECTION 9 CAPACITY EXPANSION
FACILITY SITE PLAN 2

CERTIFICATE OF AUTHORIZATION #1841 APPROVED BY	DATE 01/2007	PROJECT NO. 084449-021-01
JOSEPH H. O'NEILL P.E. P.E. # 052049	SCALE AS SHOWN	DWG. NO. 4A

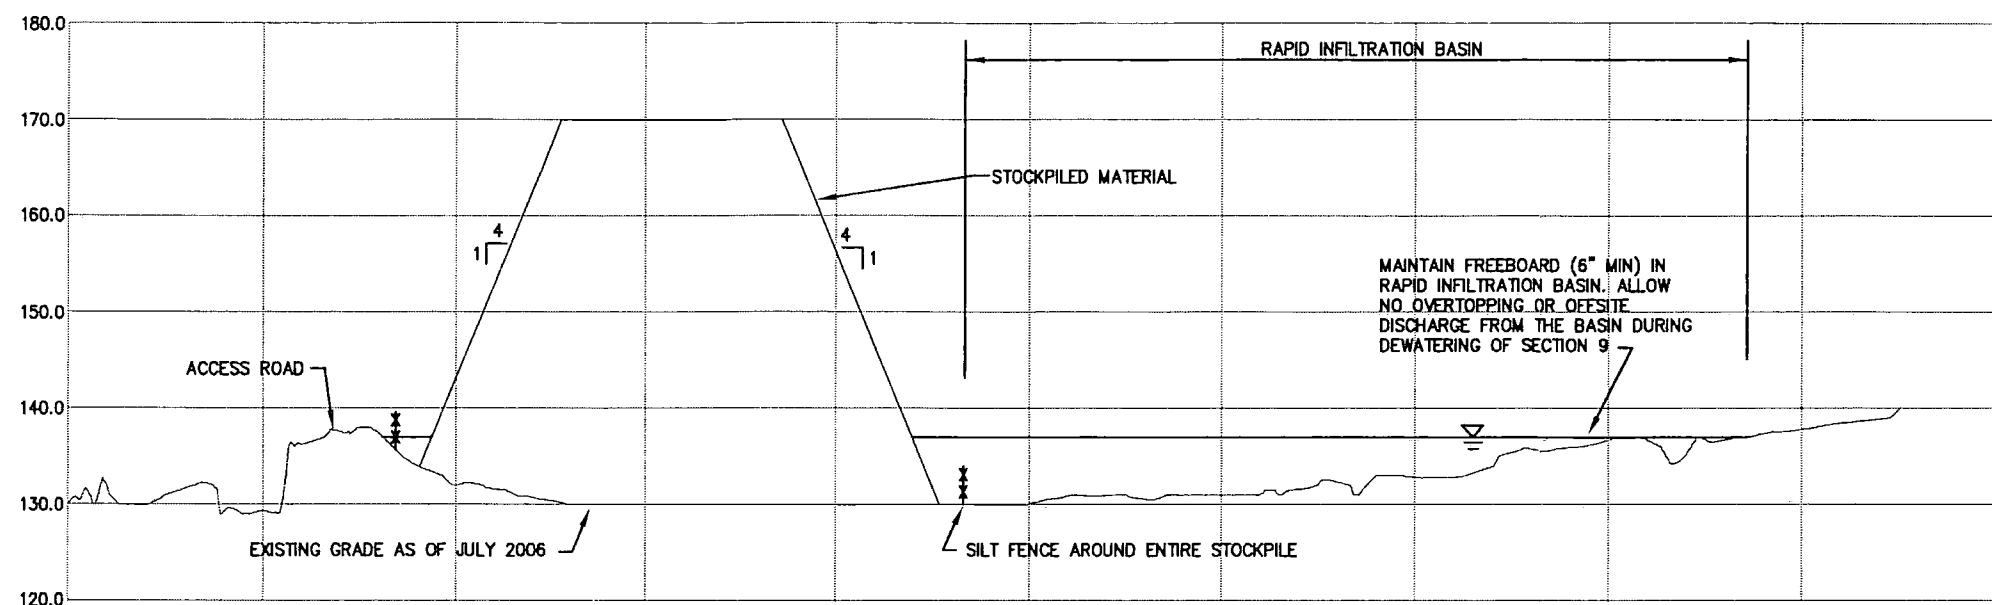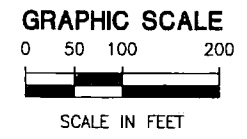

SECTION A
 4A
 HORZ. 1"=100'
 VERT. 1"=10'

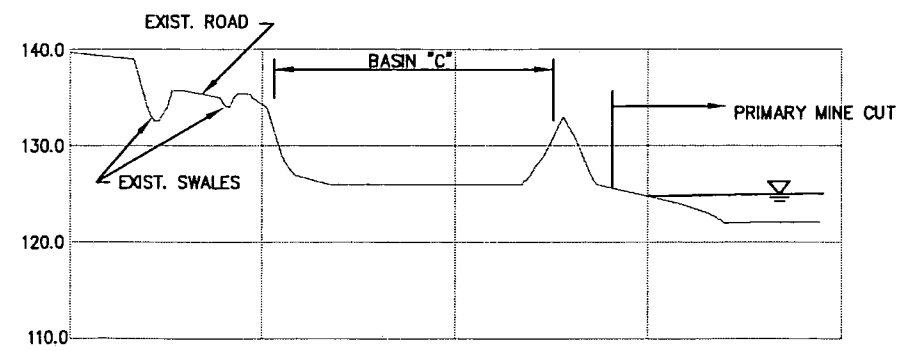

SECTION B
 4A
 HORZ. 1"=100'
 VERT. 1"=10'

Dept. Of Environmental Protection
JUN 19 2008
 Southwest District

RECORD DRAWINGS	
DESIGNED BY JONES EDMUNDS	DATE JUN 19 2008
DRAWN BY JONES EDMUNDS	
CHECKED BY JONES EDMUNDS	
APPROVED BY JONES EDMUNDS	

REV.	DATE	REVISIONS	BY	APPROD.
1	8/9/05	RECORD DRAWINGS	DLW	JHO
2				
3				
4				
5				

JONES EDMUNDS

730 NE WALDO ROAD, GAINESVILLE, FLORIDA 32641 / (352) 377-5821
 324 S HYDE PARK AVE, TAMPA, FLORIDA 33608 / (813) 258-0703

**HILLSBOROUGH COUNTY
 SOLID WASTE MANAGEMENT DEPARTMENT
 SOUTHEAST COUNTY LANDFILL**

**SECTION 9 CAPACITY EXPANSION
 CROSS SECTIONS**


CERTIFICATE OF AUTHORIZATION #1841 APPROVED BY JOSEPH H. O'NEILL P.E. P.E. # 052049	DATE 01/2007	PROJECT NO. 08449-021-01
SCALE AS SHOWN	DWG. NO. 4B	

Plotted: 6/10/08 7:35pm dwhite
N:\08449 Hillsborough County\022-SELF Misc Engineering\SECTION 9 ERP\2008-06-10\0844902101-BASIN REDESIGN 1-6.dwg
Edited: 12/09/05 11:16 JWilliams

SOUTHEAST COUNTY LANDFILL BASIN C MODIFICATION


JANUARY, 2007

HILLSBOROUGH COUNTY SOLID WASTE MANAGEMENT DEPARTMENT TAMPA, FLORIDA

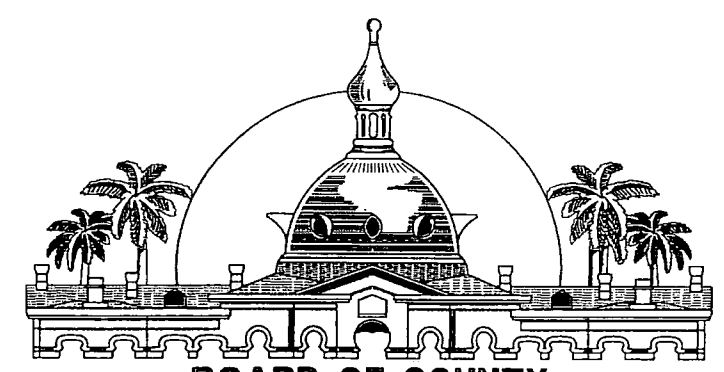

**BOARD OF COUNTY
COMMISSIONERS**

ROSE FERLITA, Commissioner
KEN HAGAN, Commissioner
KEVIN WHITE, Commissioner
AL HIGGINBOTHAM, Commissioner
JIM NORMAN, Commissioner
BRIAN BLAIR, Commissioner
MARK SHARPE, Commissioner

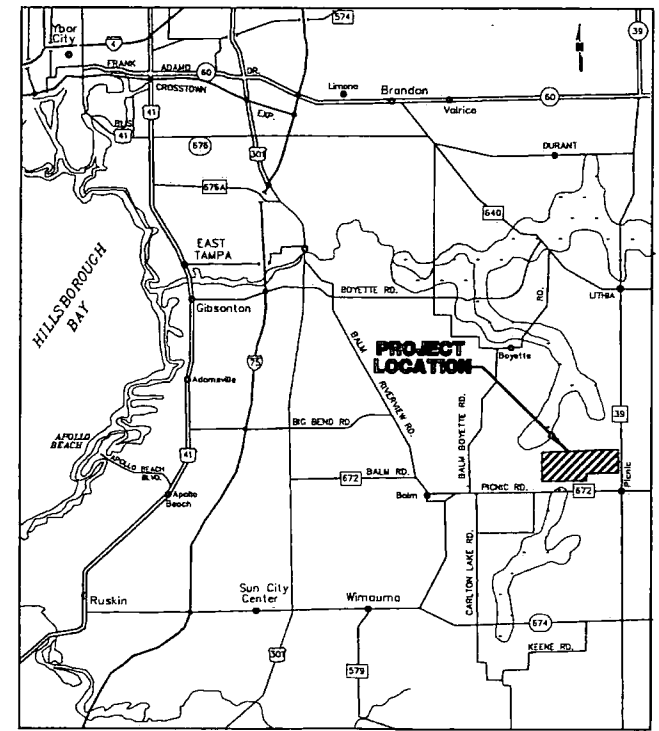

LOCATION MAP

**JONES
EDMUNDS**

730 NE WALDO ROAD, GAINESVILLE, FLORIDA 32641 / (352) 377-5821
324 S HYDE PARK AVE, TAMPA, FLORIDA 33606 / (813) 258-0703

Dept. Of Environmental Protection
JUN 19 2008
Southwest District

DRAWING NO.	DRAWING TITLE
B-1	COVER SHEET
B-2	LEGEND, ABBREVIATIONS AND GENERAL NOTES
B-3	FACILITY SITE PLAN
B-4	EXISTING CONDITIONS
B-5	GRADING PLAN
B-6	SECTION AND DETAILS

RECORD DRAWINGS

DATE: JUN 19 2008
DRAWN BY: JONES EDWARDS
CHECKED BY: JONES EDWARDS
APPROVED BY: JONES EDWARDS

CERTIFICATE OF AUTHORIZATION #1841

APPROVED BY

JOSEPH H. O'NEILL P.E.
052049

CIVIL LEGEND

	EXISTING TREE LINE
	EXISTING CONTOUR
	EXISTING GRADE SPOT EL
	EXISTING OVERHEAD ELECTRIC
	EXISTING FENCE
	EXISTING FIBER OPTIC
	EXISTING LEACHATE FORCE MAIN
	EXISTING UNDERGROUND ELECTRIC
	EXISTING CONCRETE
	EXISTING ASPHALT
	WETLANDS TO REMAIN
	PROPOSED CONTOUR
	PROPOSED SILT FENCE
	PROPOSED GRADE SPOT EL
	STORMWATER FLOW
	EXISTING POWER POLE
	PROPERTY BOUNDARY
	EXISTING MITERED END SECTION
	EXISTING LIGHT POLE

ABBREVIATIONS

GENERAL

APPROX	APPROXIMATE, APPROXIMATELY	MFR	MANUFACTURER
BLDG	BUILDING	MH	MANHOLE
BTM	BOTTOM	MIN	MINIMUM
CB	CATCH BASIN	MISC	MISCELLANEOUS
CHDPE	CORRUGATED HIGH DENSITY POLYETHYLENE	MSL	(ABOVE) MEAN SEA LEVEL
CM	CONCRETE MONUMENT	MT	MOUNT
CO	COMPANY	N/A	NOT APPLICABLE
CONC	CONCRETE	N/AVAIL	NOT AVAILABLE
CONT	CONTINUOUS	NGVD	NATIONAL GEODETIC VERTICAL DATUM
CORR	CORRUGATED	NIC	NOT IN CONTRACT
DET	DETAIL	No	NUMBER
DOT	DEPARTMENT OF TRANSPORTATION (FLORIDA)	NP	NONPERFORMED
DIA	DIAMETER	NTS	NOT TO SCALE
DIM	DIMENSION	OC	ON CENTER
DWG	DRAWING	OD	OUTSIDE DIAMETER
EA	EACH	OSHA	OCCUPATIONAL SAFETY & HEALTH ADMINISTRATION
EOL	EDGE OF LINER	PC	POINT OF CURVE
ETC	ET CETERA	PLS	PROFESSIONAL LAND SURVEYOR
ENCL	ENCLOSE, ENCLOSURE	PS	PUMP STATION
EL	ELEVATION	R	RADIUS
EQUIP	EQUIPMENT	RCP	REINFORCED CONCRETE PIPE
EXIST	EXISTING	REF	REFERENCE
FDEP	FLORIDA DEPARTMENT OF ENVIRONMENTAL PROTECTION	R/W	RIGHT OF WAY
FDOT	FLORIDA DEPARTMENT OF TRANSPORTATION	REQD	REQUIRED
FIN	FINISHED	S	SLOPE
FM	FORCE MAIN	SCH	SCHEDULE
GALV	GALVANIZED	SDR	STANDARD DIMENSION RATIO
GCL	GEOSYNTHETIC CLAY LINER	SHT	SHEET
GFFR	GROUT FILLED FIBER REVEMENT	SIM	SIMILAR
GR	GRADE	SS	STAINLESS STEEL
GS	GALVANIZED STEEL	STD	STANDARD
HDPE	HIGH DENSITY POLYETHYLENE	STL	STEEL
HP	HIGH POINT	T	TANGENT
ID	INSIDE DIAMETER	TBM	TURNING BENCH MARK
IE	INVERT ELEVATION	TYP	TYPICAL
L	LENGTH	USC&GS	UNITED STATES COASTAL AND GEODETIC SURVEY
LCRS	LEACHATE COLLECTION REMOVAL SYSTEM	USGS	UNITED STATES GEOLOGICAL SURVEY
LDS	LEAK DETECTION SYSTEM	WGT	WEIGHT
MAX	MAXIMUM	Δ	DELTA, ANGULAR CHANGE

GENERAL NOTES

1. SURVEY WAS PROVIDED BY PICKETT AND ASSOCIATES, INC. DATED JULY 2006. FOR SURVEY INFORMATION SEE SURVEYORS NOTES.

2. ANY NORTH AMERICA VERTICAL DATUM 1988 (NAVD 88) MONUMENT WITHIN THE LIMITS OF CONSTRUCTION SHALL BE PROTECTED. IF IN DANGER OF DAMAGE, THE CONTRACTOR SHALL NOTIFY:

FLORIDA STATE GEODETIC ADVISOR

RONNIE L. TAYLOR
NOAA, NATIONAL GEODETIC SURVEY
NATIONAL OCEAN SERVICE ADVISOR
C/O BUREAU OF SURVEYS AND MAPPING, FLDEP
3900 COMMONWEALTH BLVD, MAIL STOP 105
TALLAHASSEE, FL 32399

TELEPHONE: (850)245-2610
FAX: (850)245-2545
E-MAIL: Ronie.Taylor@noaa.gov

IN THE EVENT THAT MR TAYLOR IS UNAVAILABLE, CONTACT:

ASSISTANT GEODETIC ADVISOR

RANDY WEGNER
NOAA, NATIONAL GEODETIC SURVEY
ASSISTANT NATIONAL OCEAN SERVICE ADVISOR
BUREAU OF SURVEYS AND MAPPING
3900 COMMONWEALTH BLVD, MAIL STOP 105
TALLAHASSEE, FL 32399

TELEPHONE: (850)245-2606
E-MAIL: Randy.Wegner@dep.state.fl.us

3. THE CONTRACTOR SHALL PROVIDE A PROFESSIONAL LAND SURVEYOR REGISTERED IN THE STATE OF FLORIDA TO ESTABLISH THE CONSTRUCTION SITE LAYOUT, PERFORM TOPOGRAPHIC SURVEYS, AND PERFORM ALL OTHER REQUIRED SURVEYING SERVICES.

4. CONSTRUCTION MONUMENTS FOR VERTICAL AND HORIZONTAL CONTROL HAVE BEEN PROVIDED AT THE PROJECT SITE. THE CONTRACTOR SHALL VERIFY THE ACCURACY OF THESE MONUMENTS TO THEIR OWN SATISFACTION. THE CONTRACTOR IS SOLELY RESPONSIBLE FOR PROPER VERTICAL AND HORIZONTAL ALIGNMENT OF CONSTRUCTED FACILITIES AND FINISHED GRADE.

5. LOCATIONS, ELEVATIONS, AND DIMENSIONS OF EXISTING UTILITIES, STRUCTURES, AND OTHER FEATURES ARE SHOWN TO THE BEST INFORMATION AVAILABLE AT THE TIME OF PREPARATION OF THESE PLANS. THE CONTRACTOR SHALL VERIFY, PRIOR TO CONSTRUCTION, THE LOCATIONS, ELEVATIONS, AND DIMENSIONS OF ALL EXISTING UTILITIES, STRUCTURES, AND OTHER FEATURES (WHETHER OR NOT SHOWN ON THE PLANS) AFFECTING THEIR OWN WORK.

6. THE CONTRACTOR SHALL VERIFY ALL CLEARANCES PRIOR TO CONSTRUCTION.

7. THE CONTRACTOR SHALL NOTIFY THE ENGINEER IMMEDIATELY WHEN CONFLICTS BETWEEN DRAWINGS AND ACTUAL CONDITIONS ARE DISCOVERED.

8. FIELD CONDITIONS MAY NECESSITATE SLIGHT ALIGNMENT AND GRADE DEVIATION OF THE PROPOSED CONSTRUCTION TO AVOID OBSTACLES, AS ORDERED BY THE ENGINEER. THE CONTRACTOR SHALL CONSTRUCT THE PROPOSED FACILITIES TO THE ORDERED DEVIATION WITHOUT INCREASE IN THE CONTRACT PRICE OR TIME.

9. THE CONTRACTOR SHALL PROVIDE AT LEAST 48 HOURS NOTICE TO THE VARIOUS UTILITY COMPANIES IN ORDER TO PERMIT THE LOCATION OF EXISTING UNDERGROUND UTILITIES IN ADVANCE OF CONSTRUCTION. CONTACT SUNSHINE STATE ONE CALL AT 1-800-432-4770.

10. THE INFORMATION PROVIDED IN THESE PLANS IS SOLELY TO ASSIST THE CONTRACTOR IN ASSESSING THE NATURE AND EXTENT OF THE CONDITIONS WHICH MAY BE ENCOUNTERED DURING THE COURSE OF WORK. ALL CONTRACTORS ARE DIRECTED, PRIOR TO BIDDING, TO CONDUCT WHATEVER INVESTIGATIONS THEY MAY DEEM NECESSARY TO ARRIVE AT THEIR OWN CONCLUSIONS REGARDING THE ACTUAL CONDITIONS THAT WILL BE ENCOUNTERED, AND UPON WHICH THEIR BIDS SHALL BE BASED.

11. —, ., ? , & • ARE EXAMPLES OF DRAWING ELEMENTS WHICH HAVE BEEN SCREENED/SHADOWED TO INDICATE EXISTING CONDITIONS.

12. THE CONTRACTOR SHALL BE AWARE THAT THE CONSTRUCTION SITE IS ADJACENT TO ACTIVE LANDFILL CELLS, AND THAT LANDFILL GAS MAY MIGRATE ONTO THE CONSTRUCTION SITE. THE CONTRACTOR SHALL TAKE PROVEN MEANS TO PROTECT PERSONNEL AND FACILITIES FROM RELATED HAZARDS, INCLUDING EXPLOSION, ASPHYXIATION, AND POISONING DUE TO THE PRESENCE OF LANDFILL GASES.

13. THE CONTRACTOR SHALL NOT INTERFERE WITH FACILITY OPERATIONS. THE CONTRACTOR SHALL COORDINATE WITH AND NOTIFY THE OWNER A MINIMUM OF 48 HOURS IN ADVANCE OF ALL PLANNED UTILITY OUTAGES AND ROAD CROSSINGS.

14. THE CONTRACTOR SHALL REPLACE ALL EXISTING PAVING, STABILIZED EARTH, CURBS, DRIVEWAYS, SIDEWALKS, FENCES, MAILBOXES, GRASSING, SIGNS, AND OTHER IMPROVEMENTS WITH SAME TYPE OF MATERIAL THAT WAS REMOVED DURING CONSTRUCTION OR AS DIRECTED BY THE ENGINEER TO EQUAL OR BETTER CONDITION WITHOUT INCREASE IN THE CONTRACT PRICE OR TIME.

15. THE CONTRACTOR SHALL COMPLY WITH ALL TERMS, CONDITIONS, AND REQUIREMENTS OF ALL APPLICABLE PERMITS, INCLUDING FDEP AND WATER MANAGEMENT DISTRICT PERMITS FOR THE SITE.

16. ALL CONSTRUCTION SHALL BE IN ACCORDANCE WITH EXISTING COUNTY DESIGN AND CONSTRUCTION STANDARDS UNLESS THOSE STANDARDS CONFLICT WITH THESE CONTRACT DOCUMENTS IN WHICH CASE THESE CONTRACT DOCUMENTS SHALL GOVERN. SUCH CONFLICTS SHALL BE BROUGHT TO THE ENGINEER'S ATTENTION IMMEDIATELY.

17. IT IS THE RESPONSIBILITY OF THE CONTRACTOR TO BECOME FAMILIAR WITH THE OSHA EXCAVATION SAFETY STANDARDS AND TO ABIDE BY THEM AS COVERED UNDER THE FLORIDA TRENCH SAFETY ACT (LAWS OF FLORIDA 90-96) EFFECTIVE OCTOBER 1, 1990.

18. THE CONTRACTOR SHALL PROVIDE TO THE ENGINEER A WRITTEN STATEMENT PRIOR TO BEGINNING WORK THAT HE/SHE WILL COMPLY WITH APPLICABLE TRENCH SAFETY STANDARDS.

19. THE CONTRACTOR SHALL PROVIDE AND MAINTAIN ENVIRONMENTAL PROTECTION DURING THE LIFE OF THE CONTRACT, INCLUDING THE WARRANTY PERIOD. THE CONTRACTORS' OPERATIONS SHALL COMPLY WITH FEDERAL, STATE, AND LOCAL REGULATIONS, INCLUDING THOSE PERTAINING TO WATER, AIR, SOLID WASTE, HAZARDOUS WASTE MATERIALS, OILY SUBSTANCES, AND NOISE POLLUTION. THE CONTRACTOR SHALL IMPLEMENT EROSION AND SEDIMENTATION CONTROL MEASURES AS NECESSARY TO COMPLY WITH THESE REGULATIONS FOR BOTH TEMPORARY AND PERMANENT CONSTRUCTION.



20. PRIOR TO BEGINNING WORK, THE CONTRACTOR SHALL PROVIDE STORMWATER AND EROSION CONTROL PLANS TO PREVENT PONDING AND CONTROL EROSION AND RUNOFF. NO PONDING OF WATER SHALL BE ALLOWED. THE CONTRACTOR SHALL USE APPROVED CONSTRUCTION TECHNIQUES TO PREVENT EROSION AND SHALL BE RESPONSIBLE FOR ALL WORK, INCLUDING PROVIDING EQUIPMENT, LABOR, FILL, ETC NECESSARY TO REMEDIATE AND/OR RESTORE ALL AREAS IMPACTED BY CONSTRUCTION.

21. THE CONTRACTOR SHALL BE RESPONSIBLE FOR PREVENTING STORMWATER RUNOFF, SOLID WASTE, LANDFILL GAS, AND LEACHATE FROM ENTERING OR IMPACTING THE AREAS OF THE WORK. THE CONTRACTOR SHALL INSTALL AND MAINTAIN MANAGEMENT AND CONTROL DEVICES INCLUDING DIVERSION/COLLECTION BERMS, DITCHES, PUMPING STATIONS, WALLS, LINERS, ETC. TO COMPLY WITH THE REQUIREMENTS OF THE CONTRACT DOCUMENTS WITHOUT INCREASE IN THE CONTRACT PRICE OR TIME.

22. THE CONTRACTOR SHALL MAINTAIN A CLEAR PATH FOR ALL SURFACE WATER DRAINAGE STRUCTURES AND DITCHES DURING ALL PHASES OF CONSTRUCTION AND SHALL USE APPROVED CONSTRUCTION TECHNIQUES TO MANAGE STORMWATER SUCH THAT THE IMPACT TO CONSTRUCTION IS MINIMIZED. THE CONTRACTOR SHALL BE RESPONSIBLE FOR REPAIR OF DAMAGE DUE TO STORMWATER.

23. FDOT INDICES SHALL REFER TO THE "2004 FLORIDA DEPARTMENT OF TRANSPORTATION ROADWAY AND TRAFFIC DESIGN STANDARDS."

24. THE CONTRACTOR SHALL PROVIDE CONTROL AND MAINTENANCE OF TRAFFIC IN ACCORDANCE WITH FDOT INDEX 600 THROUGH 665, OSHA, AND OTHER APPLICABLE REGULATORY REQUIREMENTS AND AS NECESSARY TO PROVIDE FOR SITE SAFETY DURING CONSTRUCTION.

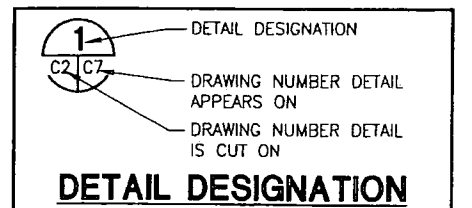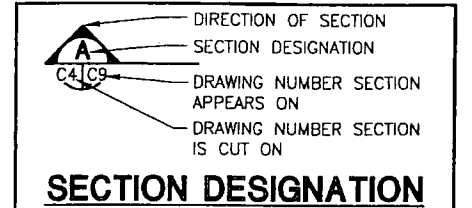

RECORD DRAWINGS
DATE: JUN 19 2008
BY: JONES EDMUNDS
FOR: HILLSBOROUGH COUNTY
PROJECT: BASIN C MODIFICATION
DRAWING: LEGEND, ABBREVIATIONS AND GENERAL NOTES

Dept. Of Environmental Protection

JUN 19 2008

Southwest District


					DESIGNED	JHO/RAS
Δ	6/10/08	RECORD DRAWINGS	JHO	JHO	DRAWN	GRD
Δ	3/17/08	REVISED SHEET	JHO	JHO		
Δ	1/22/08	REVISED DRAIN "C"	JHO	FOOD		
LTR.	DATE	REVISIONS	BY	APPRD.	CHECKED	JHO



HILLSBOROUGH COUNTY
SOLID WASTE MANAGEMENT DEPARTMENT
SOUTHEAST COUNTY LANDFILL

BASIN C MODIFICATION
LEGEND, ABBREVIATIONS AND
GENERAL NOTES

CERTIFICATE OF AUTHORIZATION #1841	DATE	PROJECT NO.
APPROVED BY	01/2007	08449-021-01
JOSEPH H. O'NEILL P.E.	SCALE	DWG. NO.
P.E. # 052049	AS SHOWN	B-2

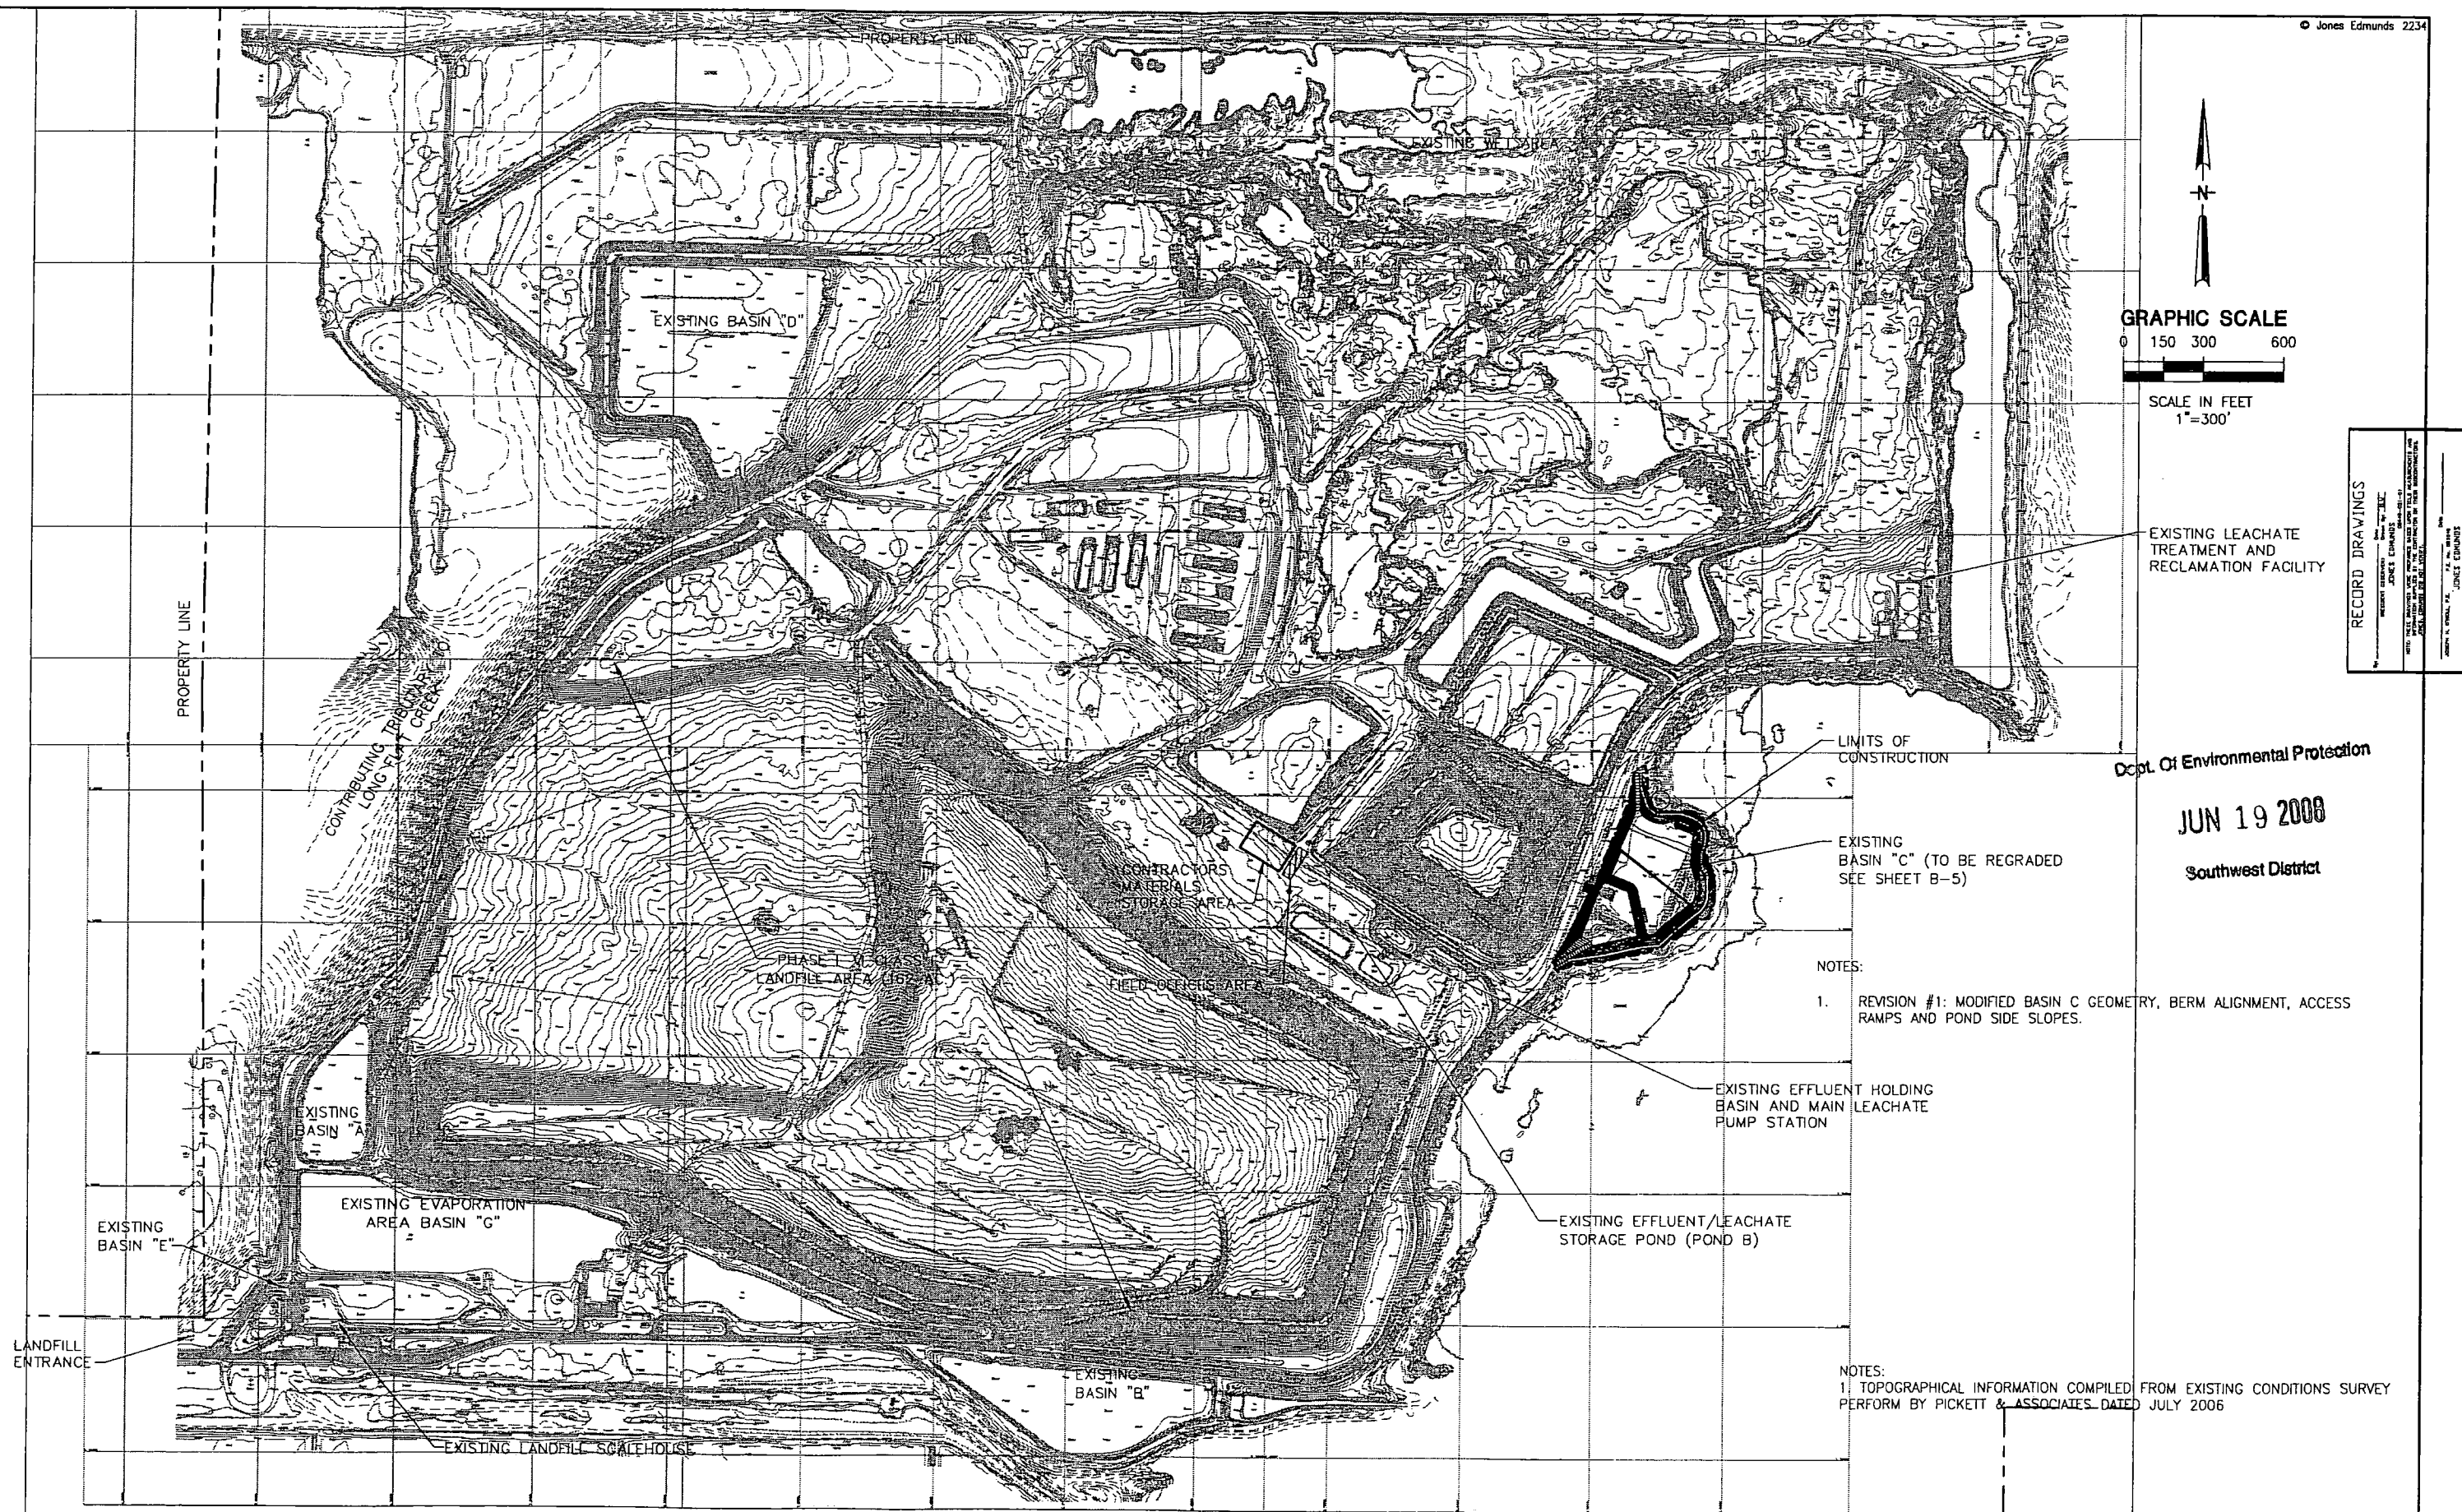


					DESIGNED	JHO/RAS
▲	6/10/08	RECORD DRAWINGS	JHO	JHO	DRAWN	GRD
▲	3/17/08	REVISED SAMPLE	JHO	JHO		
▲	1/23/08	REVISED BRUSH "C"	JHO	ROD		
LTR.	DATE	REVISIONS	BY	APPRD.	CHECKED	JHO

JONES EDMUNDS
730 NE WALDO ROAD, GAINESVILLE, FLORIDA 32641 / (352) 577-6821

HILLSBOROUGH COUNTY
SOLID WASTE MANAGEMENT DEPARTMENT
SOUTHEAST COUNTY LANDFILL

BASIN C MODIFICATION
FACILITY SITE PLAN

CERTIFICATE OF AUTHORIZATION #1841	DATE	PROJECT NO.
APPROVED BY	01/2007	08449-021-01
JOSEPH H. O'NEILL P.E.	SCALE	DWG. NO.
P.E. # 052049	AS SHOWN	B-3

 

Southwest District

NOTES:
1. TOPOGRAPHICAL INFORMATION COMPILED FROM EXISTING CONDITIONS SURVEY
PERFORM BY PICKETT & ASSOCIATES DATED JULY 2006

					DESIGNED	JHO/RAS
▲	3/10/05	RECORD DRAWINGS	DLJ	JHO	DRAWN	GRD
▲	3/17/05	REVISED SINGLE	JHO	JHO		
▲	1/25/06	REVISED BASHN "C"	DLJ	RED		
LTR.	DATE	REVISIONS	BY	APPRO.	CHECKED	JHO





HILLSBOROUGH COUNTY
SOLID WASTE MANAGEMENT DEPARTMENT
SOUTHEAST COUNTY LANDFILL

BASIN C MODIFICATION EXISTING CONDITIONS

CERTIFICATE OF AUTHORIZATION #1841	DATE	PROJECT NO.
APPROVED BY	01/2007	08449-021-01
JOSEPH H. O'NEILL P.E.	SCALE	DWG. NO.
P.E. # 052049	AS SHOWN	B-4

Edited: 00/00/00 0:00 login

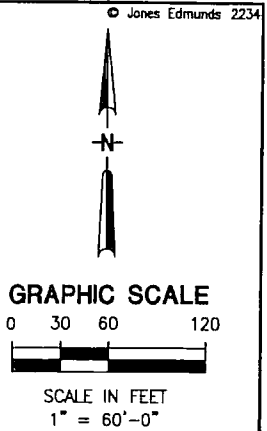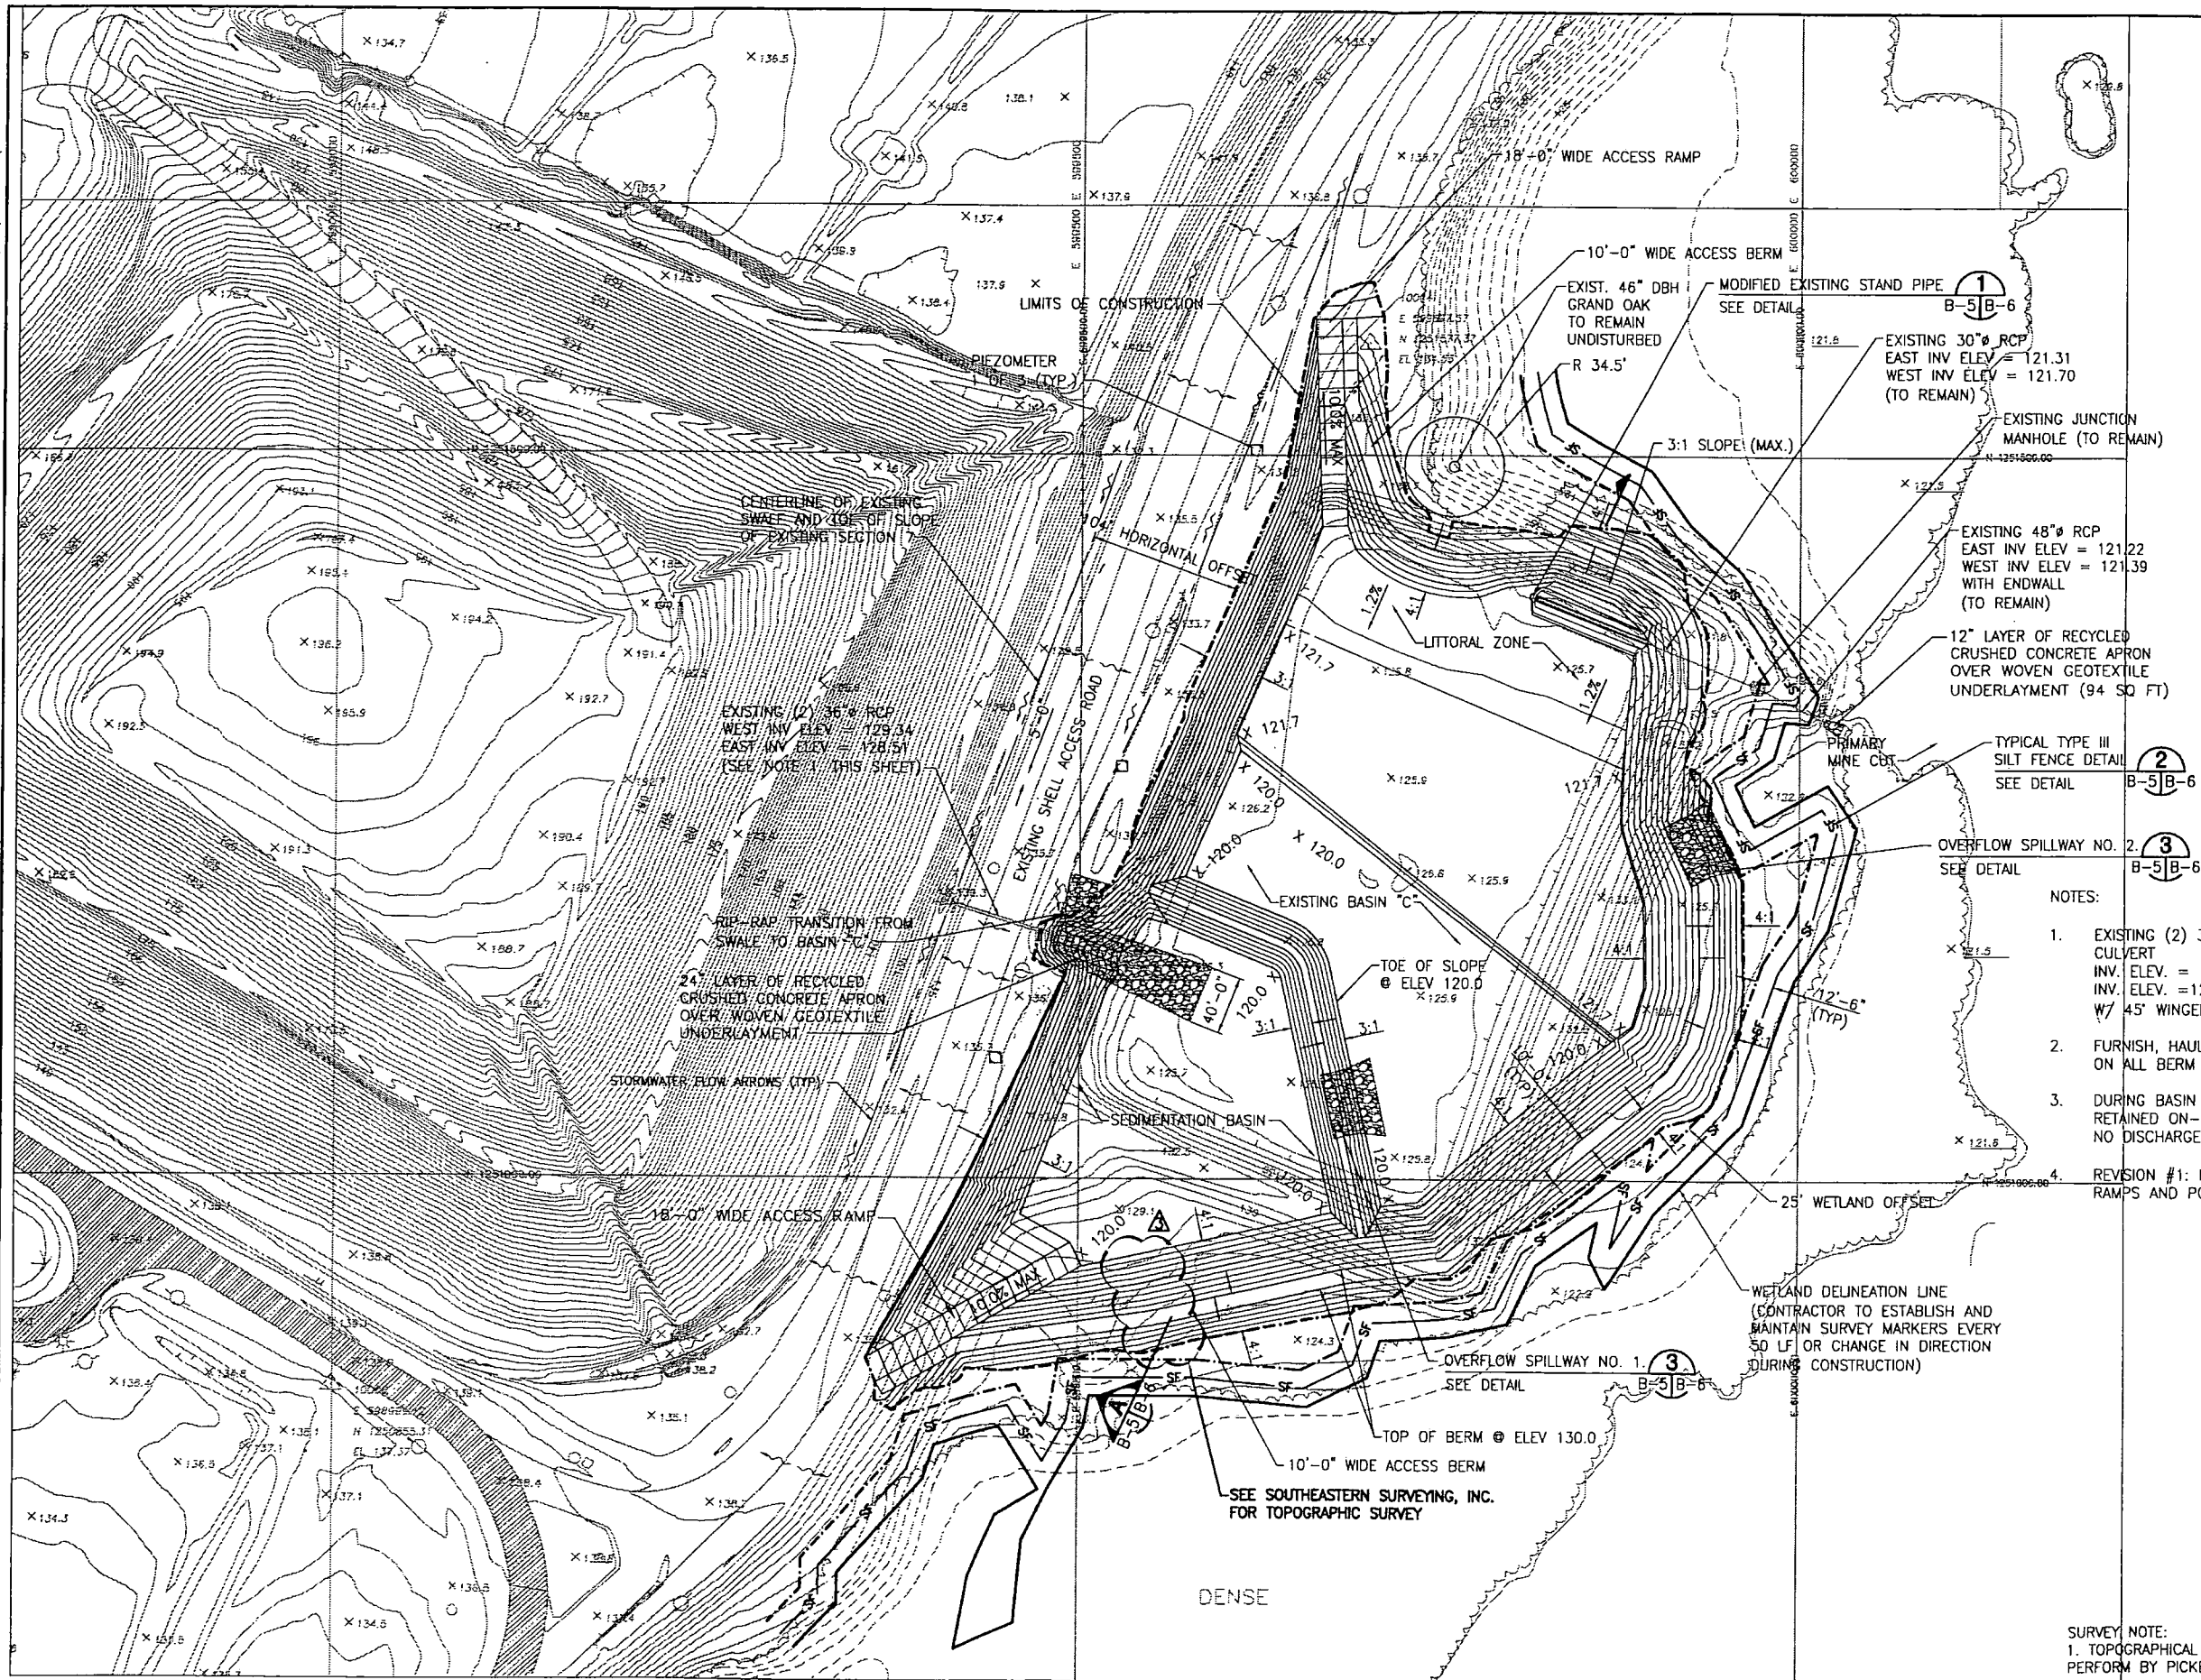[illegible]

Dept. Of Environmental Protection

JUN 19 2008

Southwest District

NOTES:

1. EXISTING (2) 36" RCP TO BE REPLACED WITH 70 LF OF 4' X 8' BOX CULVERT
INV. ELEV. = 130.0 WEST
INV. ELEV. = 129.0 EAST
~~W/~~ 45' WINGED ENDWALLS FOOT INDEX 266 (IN SECTION 9 BID)
2. FURNISH, HAUL, AND PLACE SOD, PER SPECIFICATIONS SECTION 02990, ON ALL BERM SIDE SLOPES 4H:1V OR STEEPER AND THEIR TOP.
3. DURING BASIN C CONSTRUCTION DEWATERING, ALL WATER WILL BE RETAINED ON-SITE, CONTRACTOR TO PUMP TO DEWATERING AREA, WITH NO DISCHARGE TO STATE WATERS.
4. REVISION #1: MODIFIED BASIN C GEOMETRY, BERM ALIGNMENT, ACCESS RAMPS AND POND SIDE SLOPES.

SURVEY NOTE:
1. TOPOGRAPHICAL INFORMATION COMPILED FROM EXISTING CONDITIONS SURVEY
PERFORM BY PICKETT & ASSOCIATES DATED JULY 2006


					DESIGNED	JHO/RAS
▲	8/10/05	RECORD DRAWINGS	DLF	JHO	DRAWN	GRD
▲	3/17/05	REVISED SIGNAL	JHO	JHO		
▲	1/25/05	REVISED BRUSH "C"	JHO	ROD		
LTR.	DATE	REVISIONS	BY	APPRD.	CHECKED	JHO



HILLSBOROUGH COUNTY
SOLID WASTE MANAGEMENT DEPARTMENT
SOUTHEAST COUNTY LANDFILL

BASIN C MODIFICATION GRADING PLAN

CERTIFICATE OF AUTHORIZATION #1841		DATE	PROJECT NO.
APPROVED BY		01/2007	08449-021-01
JOSEPH H. O'NEILL P.E.		SCALE	OWG. NO.
P.E. # 052049		AS SHOWN	B-5

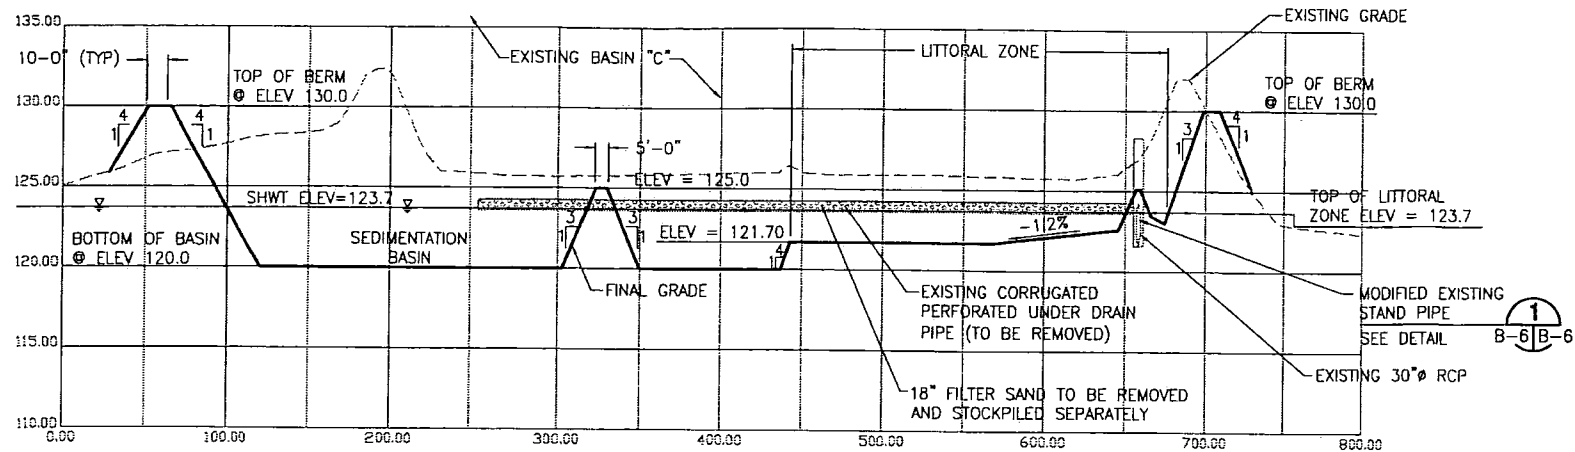

SECTION A


SCALE 1"=60'-0" HORZ
1"=6'-0" VERT

NOTE:
FURNISH, HAUL, AND PLACE SOD, PER SPECIFICATIONS
SECTION 02990, ON ALL BERM SIDE SLOPES 4H:1V OR
STEEPER AND THEIR TOP.

OPTIONAL POST POSITIONS
PRINCIPLE POST POSITION
(CANTED 20° TOWARD FLOW)



SECTION

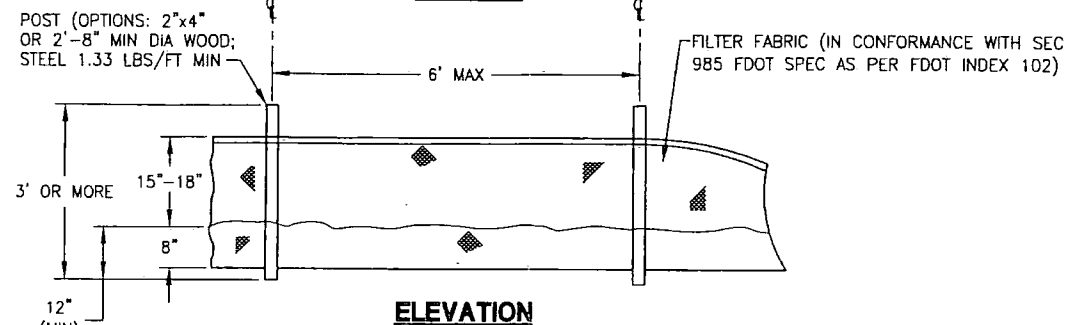

ELEVATION

TYPICAL TYPE III SILT FENCE DETAIL

NTS

B-5, B-6


Dept. Of Environmental Protection

JUN 19 2008

Southwest District


RECORD DRAWINGS

DESIGNED BY: JHO/RAS
DRAWN BY: GRD
CHECKED BY: JHO
DATE: 6/10/08
PROJECT NO.: 08449-021-01
DWG. NO.: B-6

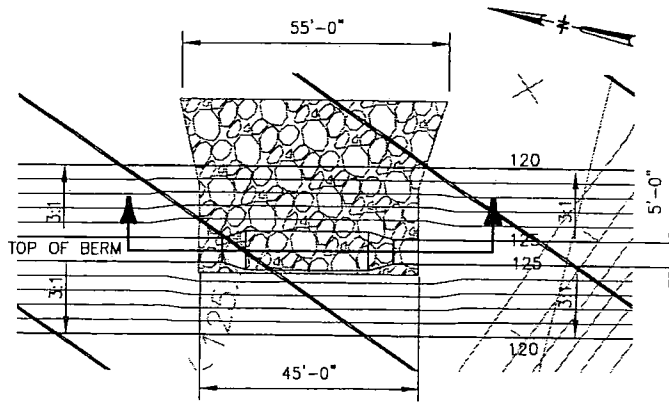


PLAN OVERFLOW SPILLWAY NO. 1

SCALE 1"= 20'-0"

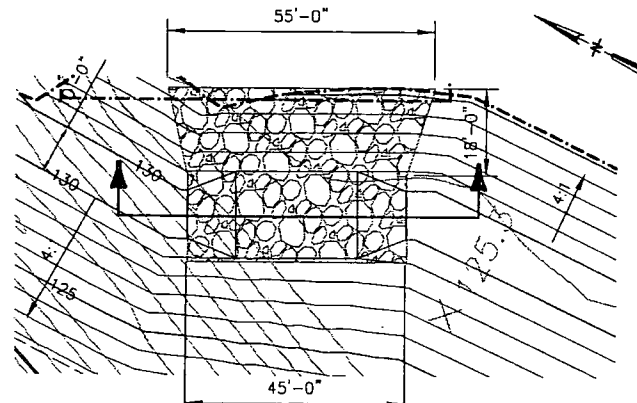

PLAN OVERFLOW SPILLWAY NO. 2

SCALE 1"= 20'-0"

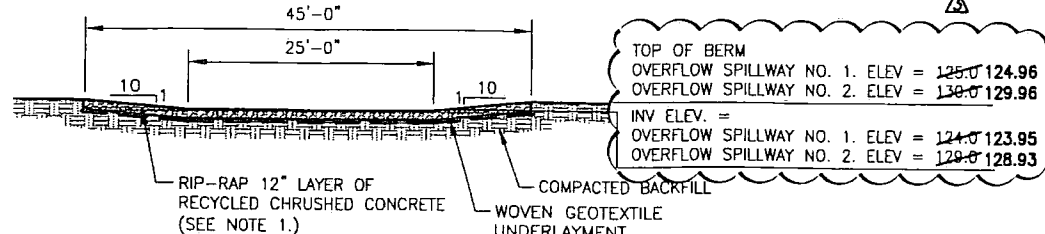

SECTION


NTS

OVERFLOW SPILLWAY NO. 1 AND 2. DETAIL

SCALE 1"= 10'-0"

B-5, B-6

NOTE:
1. RIP-RAP USED SHALL BE RECYCLED
CRUSHED CONCRETE, GRANITE OR LIMESTONE
3 INCHES TO 8 INCHES IN DIAMETER WITH A
MEDIAN OF 6 INCHES. WOVEN GEOTEXTILE
SHALL MEET THE REQUIREMENTS OF SECTION
02771 OF THE PROJECT SPECIFICATIONS.

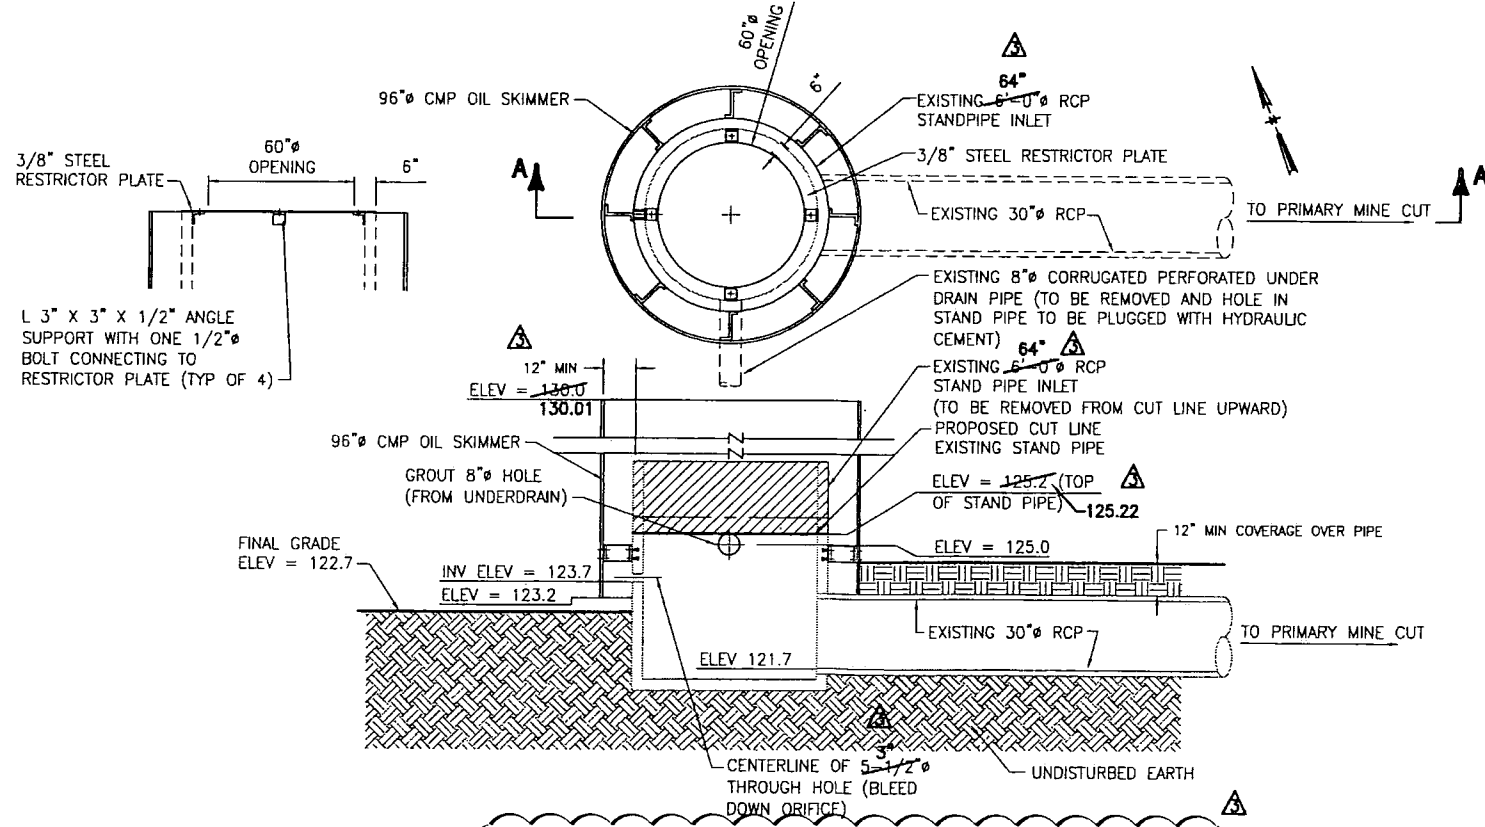

SECTION A-A'

MODIFIED EXISTING STAND PIPE

NTS

B-5, B-6



HILLSBOROUGH COUNTY
SOLID WASTE MANAGEMENT DEPARTMENT
SOUTHEAST COUNTY LANDFILL

BASIN C MODIFICATION
SECTION AND DETAILS

CERTIFICATE OF AUTHORIZATION #1841
APPROVED BY:
JOSEPH H. O'NEILL P.E.
P.E. # 052049

DATE: 01/2007
SCALE: AS SHOWN
PROJECT NO.: 08449-021-01
DWG. NO.: B-6

ATTACHMENT 4


AS-BUILT TOPOGRAPHIC SURVEY

Dept. of Environmental Protection

JUN 10 2008

Southwest District

IN THE EVENT THAT MR TAYLOR IS UNAVAILABLE, CONTACT:
 ASSISTANT GEODETIC ADVISOR
 RANDY VESNER
 NOAA, NATIONAL GEODETIC SURVEY
 ASSISTANT NATIONAL OCEAN SERVICE ADVISOR
 BUREAU OF SURVEYS AND MAPPING
 3900 COMMONWEALTH BLVD, MAIL STOP 105
 TALLAHASSEE, FL 32399
 TELEPHONE: (904) 245-2606
 E-MAIL: Randy.Vesner@noaa.gov

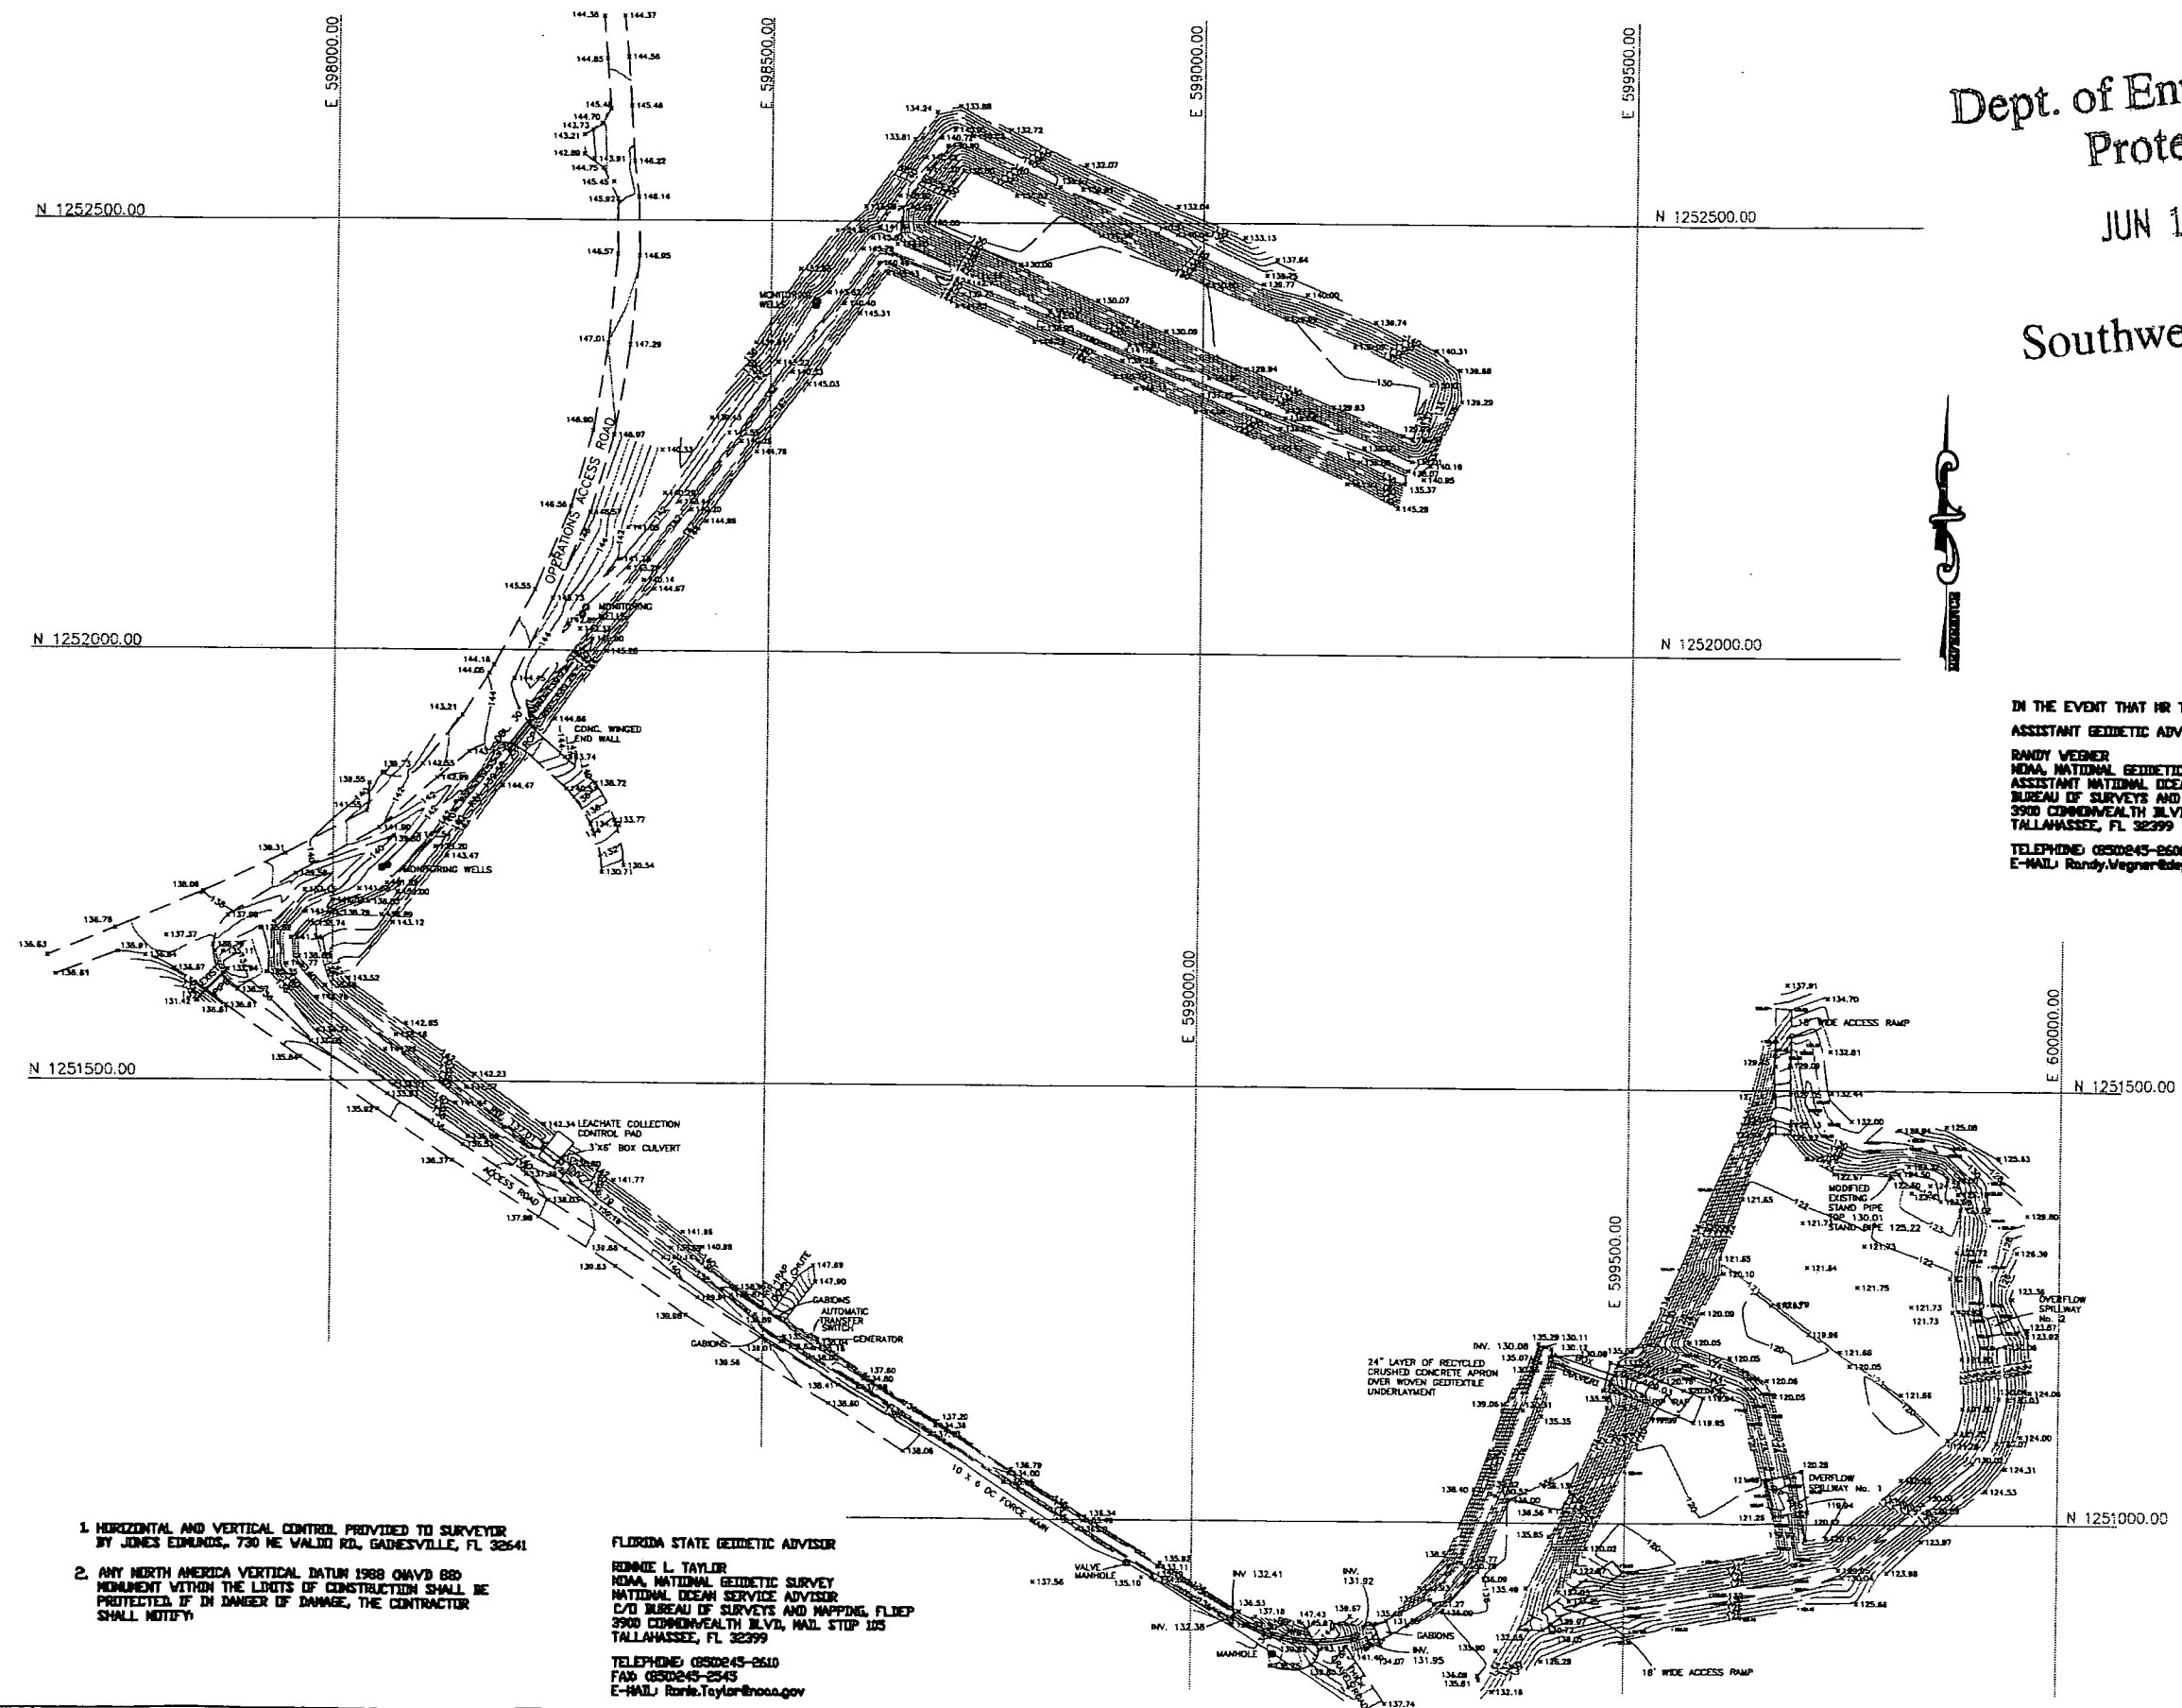

1. HORIZONTAL AND VERTICAL CONTROL PROVIDED TO SURVEYOR BY JONES EDWARDS, 730 NE VALUO RD, GADSDENVILLE, FL 32641
2. ANY NORTH AMERICA VERTICAL DATUM 1988 (NAVD 88) MONUMENT WITHIN THE LIMITS OF CONSTRUCTION SHALL BE PROTECTED. IF IN DANGER OF DAMAGE, THE CONTRACTOR SHALL NOTIFY:

FLORIDA STATE GEODETIC ADVISOR
 RONNIE L. TAYLOR
 NOAA, NATIONAL GEODETIC SURVEY
 NATIONAL OCEAN SERVICE ADVISOR
 C/O BUREAU OF SURVEYS AND MAPPING, FLDP
 3900 COMMONWEALTH BLVD, MAIL STOP 105
 TALLAHASSEE, FL 32399
 TELEPHONE: (904) 245-2610
 FAX: (904) 245-2343
 E-MAIL: Ronnie.Taylor@noaa.gov



GRAPHIC SCALE: 1 INCH = 100 FT.

Southeastern Surveying, Inc.

601 N. St. Augustine Rd. Telephone: 228-259-9455
 Valdosta, GA 31601 Fax: 228-259-9926
 E-mail: bherring@southeasternsurveying.com

THIS MAP IS NOT VALID WITHOUT THE SIGNATURE AND THE ORIGINAL RAISED SEAL OF A FLORIDA LICENSED SURVEYOR AND MAPPER


BARBARA L. HERRING, PMS #5194
 PERFORMING LAND SURVEYING SERVICES UNDER THE LICENSE BUSINESS NUMBER LB-0007091

HILLSBOROUGH COUNTY
 SOLID WASTE MANAGEMENT DEPARTMENT
 SOUTHEAST COUNTY LANDFILL

TOPOGRAPHIC SURVEY OF
 ACCESS ROADS AND STORM WATER DRAINAGE,
 BASIN C

DATE: MAY 28, 2008

SHEET 8 OF

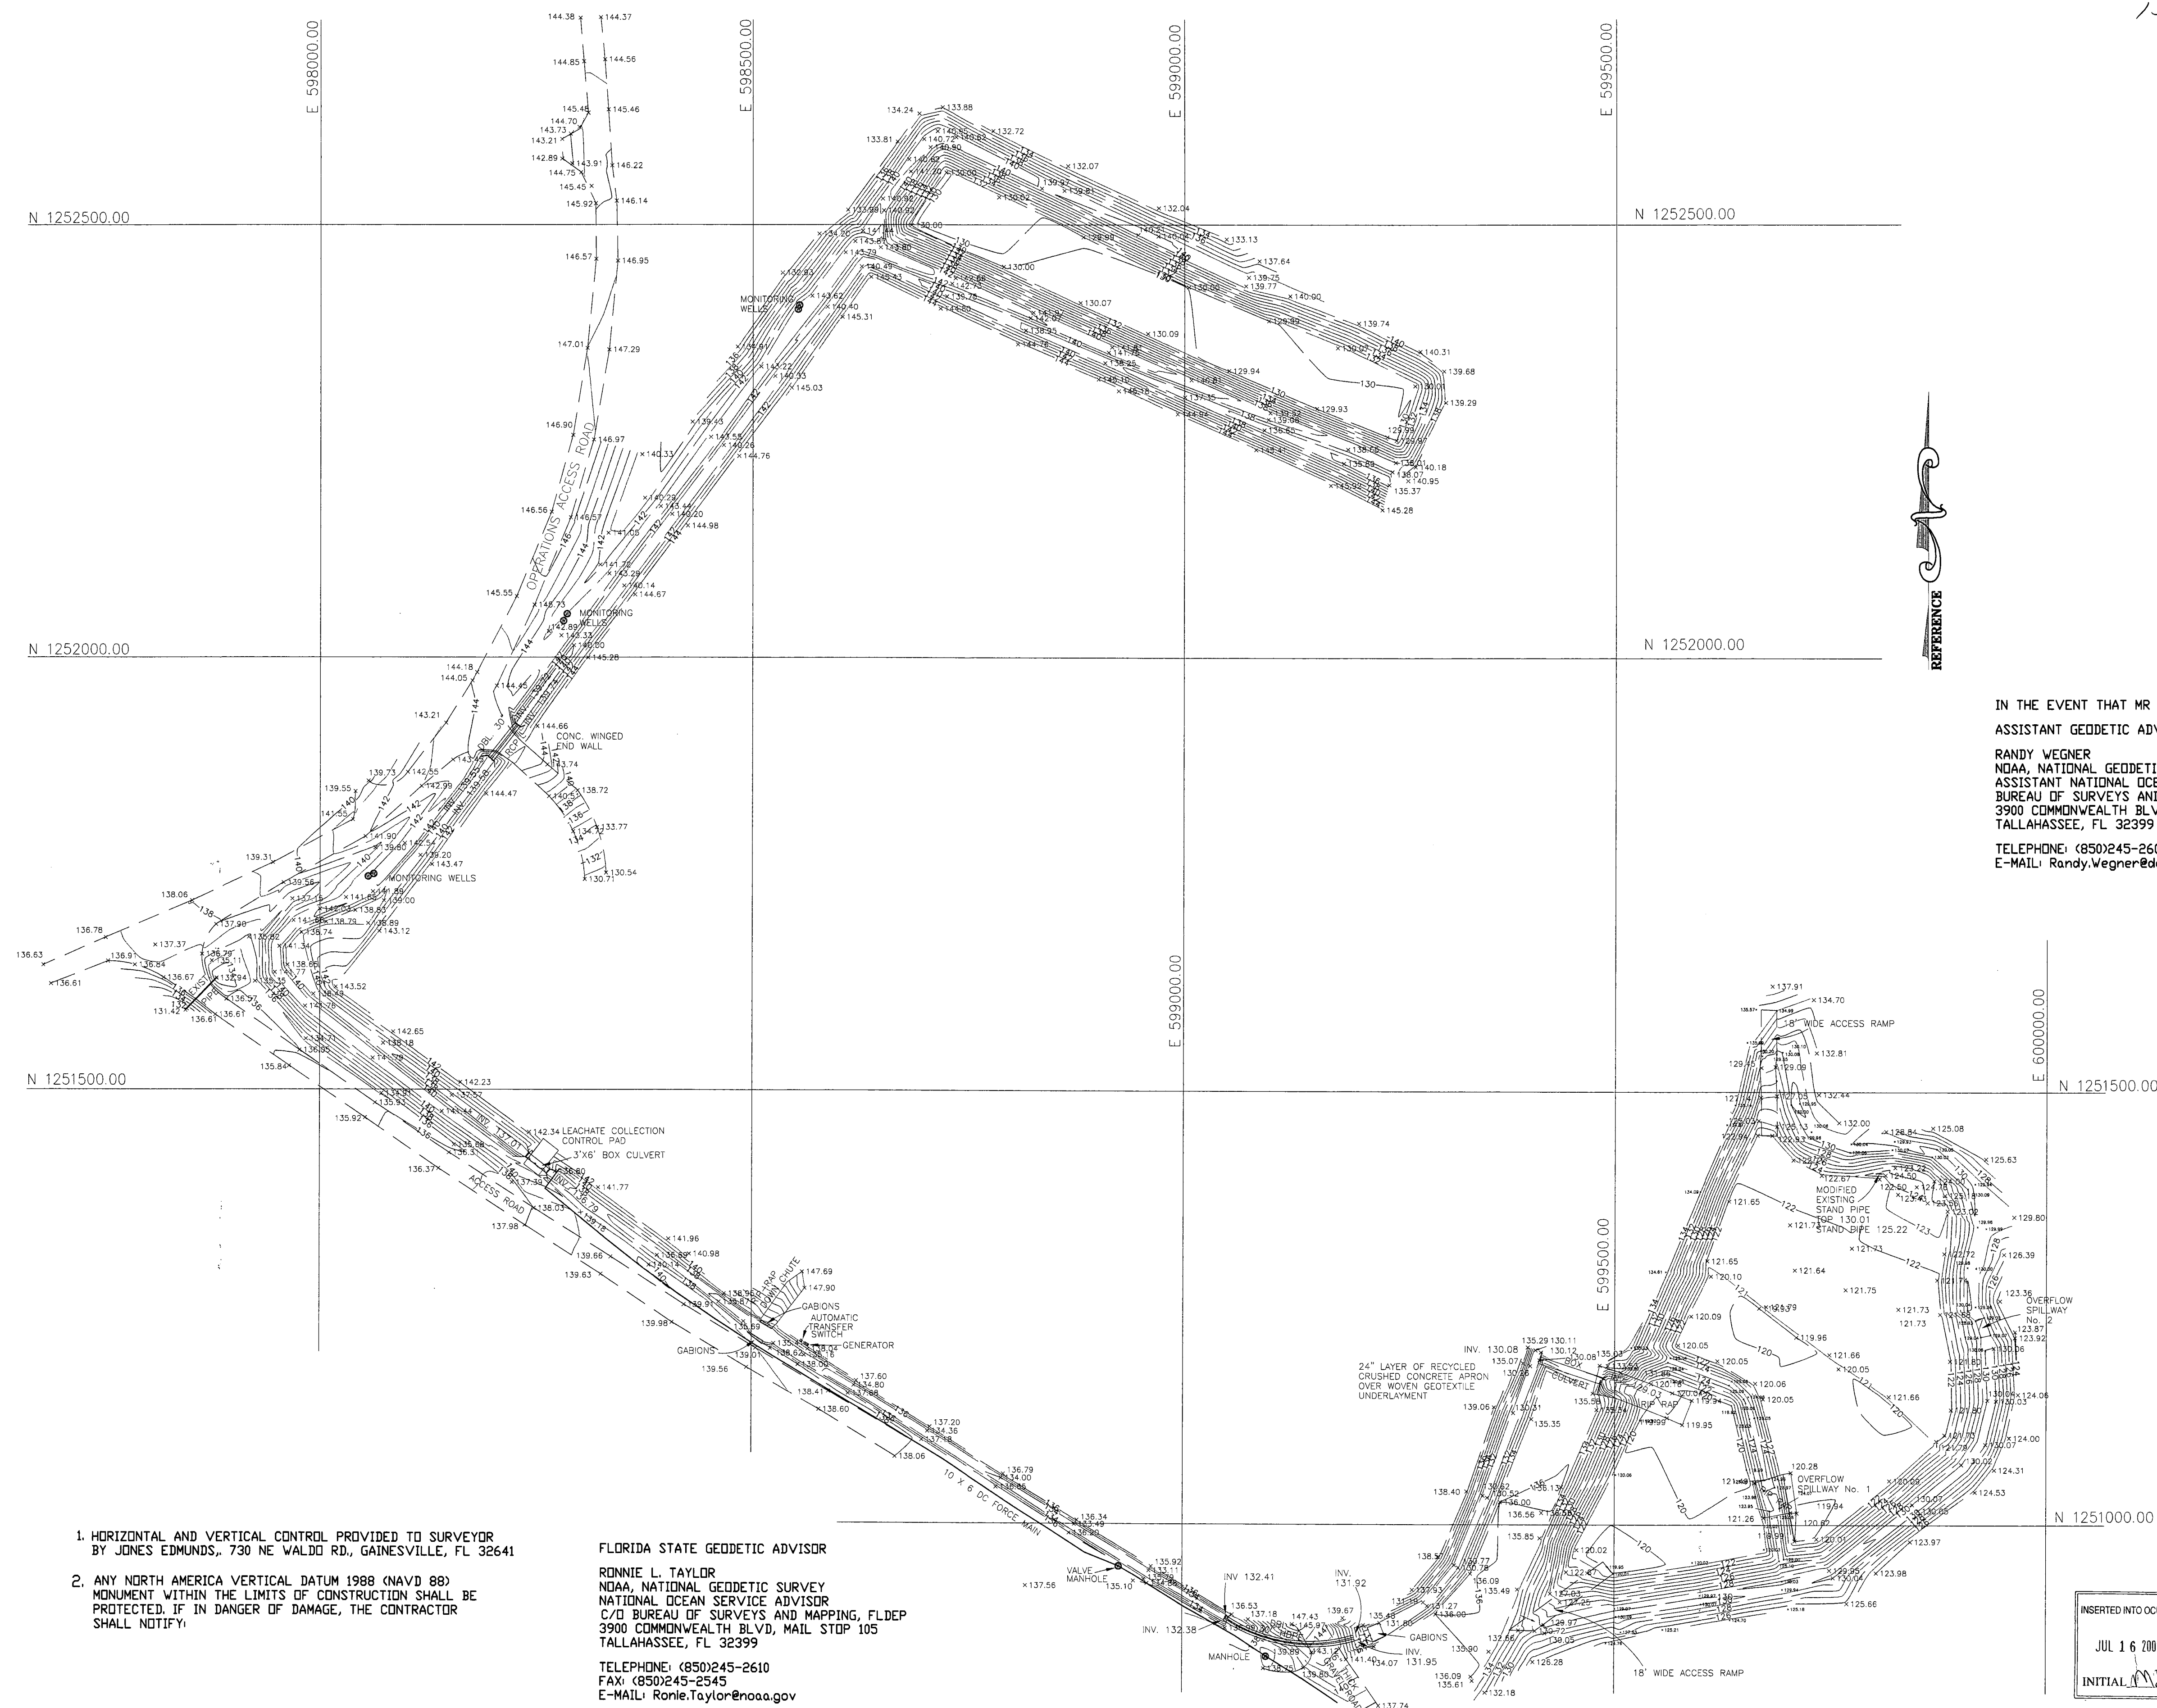

ATTACHMENT 5

ICPR STORMWATER MODEL CONFIRMATION

ICPR INPUT REPORT

Post Development
Input Report (After Construction)

Basins

Name: 10AcBasin Node: 10 Ac-node Status: Onsite
Group: BASE Type: SCS Unit Hydrograph

Unit Hydrograph: Uh256 Peaking Factor: 256.0
Rainfall File: Flmod Storm Duration(hrs): 24.00
Rainfall Amount(in): 8.400 Time of Conc(min): 13.30
Area(ac): 10.000 Time Shift(hrs): 0.00
Curve Number: 90.00 Max Allowable Q(cfs): 999999.000
DCIA(%): 0.00

Name: 19AcBasin Node: 19 Ac-node Status: Onsite
Group: BASE Type: SCS Unit Hydrograph

Unit Hydrograph: Uh256 Peaking Factor: 256.0
Rainfall File: Flmod Storm Duration(hrs): 24.00
Rainfall Amount(in): 8.400 Time of Conc(min): 12.60
Area(ac): 19.120 Time Shift(hrs): 0.00
Curve Number: 90.00 Max Allowable Q(cfs): 999999.000
DCIA(%): 0.00

Name: Area2 Node: Area2 Status: Onsite
Group: BASE Type: SCS Unit Hydrograph

Unit Hydrograph: Uh484 Peaking Factor: 484.0
Rainfall File: Flmod Storm Duration(hrs): 24.00
Rainfall Amount(in): 8.400 Time of Conc(min): 23.90
Area(ac): 26.000 Time Shift(hrs): 0.00
Curve Number: 87.00 Max Allowable Q(cfs): 999999.000
DCIA(%): 0.00

Name: Basin 1 Node: 1-node Status: Onsite
Group: BASE Type: SCS Unit Hydrograph

Unit Hydrograph: Uh256 Peaking Factor: 256.0
Rainfall File: Flmod Storm Duration(hrs): 24.00
Rainfall Amount(in): 8.400 Time of Conc(min): 6.00
Area(ac): 0.700 Time Shift(hrs): 0.00
Curve Number: 86.00 Max Allowable Q(cfs): 999999.000
DCIA(%): 0.00

Basin North to storage tank

Name: Basin 2 Node: 2-node Status: Onsite
Group: BASE Type: SCS Unit Hydrograph

Unit Hydrograph: Uh256 Peaking Factor: 256.0
Rainfall File: Flmod Storm Duration(hrs): 24.00
Rainfall Amount(in): 8.400 Time of Conc(min): 6.00

Post Development
Input Report (After Construction)

Area(ac): 0.120
Curve Number: 78.00
DCIA(%): 0.00

Time Shift(hrs): 0.00
Max Allowable Q(cfs): 999999.000

existing dry pond southeast of storage tank

Name: Basin 4
Group: BASE

Node: 4-node
Type: SCS Unit Hydrograph

Status: Onsite

Unit Hydrograph: Uh484
Rainfall File: Flmod
Rainfall Amount(in): 8.400
Area(ac): 0.500
Curve Number: 98.00
DCIA(%): 0.00

Peaking Factor: 484.0
Storm Duration(hrs): 24.00
Time of Conc(min): 6.00
Time Shift(hrs): 0.00
Max Allowable Q(cfs): 999999.000

storage tank area

Name: Basin 5
Group: BASE

Node: 5-node
Type: SCS Unit Hydrograph

Status: Onsite

Unit Hydrograph: Uh256
Rainfall File: Flmod
Rainfall Amount(in): 8.400
Area(ac): 0.170
Curve Number: 82.00
DCIA(%): 0.00

Peaking Factor: 256.0
Storm Duration(hrs): 24.00
Time of Conc(min): 6.00
Time Shift(hrs): 0.00
Max Allowable Q(cfs): 999999.000

Name: Basin 6
Group: BASE

Node: 6-node
Type: SCS Unit Hydrograph

Status: Onsite

Unit Hydrograph: Uh256
Rainfall File: Flmod
Rainfall Amount(in): 8.400
Area(ac): 0.170
Curve Number: 82.00
DCIA(%): 0.00

Peaking Factor: 256.0
Storm Duration(hrs): 24.00
Time of Conc(min): 6.00
Time Shift(hrs): 0.00
Max Allowable Q(cfs): 999999.000

swale south of storage tank area

Name: Basin 7
Group: BASE

Node: 7-node
Type: SCS Unit Hydrograph

Status: Onsite

Unit Hydrograph: Uh256
Rainfall File: Flmod
Rainfall Amount(in): 8.400
Area(ac): 0.700
Curve Number: 87.00
DCIA(%): 0.00

Peaking Factor: 256.0
Storm Duration(hrs): 24.00
Time of Conc(min): 6.00
Time Shift(hrs): 0.00
Max Allowable Q(cfs): 999999.000

swale southeast of storage tank area to swale 3

Name: Basin-PrMineCut
Group: BASE

Node: PrMine Cut
Type: SCS Unit Hydrograph

Status: Onsite

Unit Hydrograph: Uh256

Peaking Factor: 256.0

Post Development
Input Report (After Construction)

Rainfall File: Flmod	Storm Duration(hrs): 24.00
Rainfall Amount(in): 8.400	Time of Conc(min): 60.00
Area(ac): 112.300	Time Shift(hrs): 0.00
Curve Number: 90.00	Max Allowable Q(cfs): 999999.000
DCIA(%): 0.00	

Name: BasinC	Node: BasinC	Status: Onsite
Group: BASE	Type: SCS Unit Hydrograph	
Unit Hydrograph: Uh256	Peaking Factor: 256.0	
Rainfall File: Flmod	Storm Duration(hrs): 24.00	
Rainfall Amount(in): 8.400	Time of Conc(min): 6.00	
Area(ac): 4.400	Time Shift(hrs): 0.00	
Curve Number: 98.00	Max Allowable Q(cfs): 999999.000	
DCIA(%): 0.00		

Name: Sect78	Node: Sect78	Status: Onsite
Group: BASE	Type: SCS Unit Hydrograph	
Unit Hydrograph: Uh484	Peaking Factor: 484.0	
Rainfall File: Flmod	Storm Duration(hrs): 24.00	
Rainfall Amount(in): 8.400	Time of Conc(min): 14.13	
Area(ac): 22.200	Time Shift(hrs): 0.00	
Curve Number: 87.00	Max Allowable Q(cfs): 999999.000	
DCIA(%): 0.00		

Name: Sect9	Node: Sect9	Status: Onsite
Group: BASE	Type: SCS Unit Hydrograph	
Unit Hydrograph: Uh484	Peaking Factor: 484.0	
Rainfall File: Flmod	Storm Duration(hrs): 24.00	
Rainfall Amount(in): 8.400	Time of Conc(min): 10.12	
Area(ac): 11.500	Time Shift(hrs): 0.00	
Curve Number: 87.00	Max Allowable Q(cfs): 999999.000	
DCIA(%): 0.00		

3/4 of Section 9

Name: Swale4Basin	Node: swale4	Status: Onsite
Group: BASE	Type: SCS Unit Hydrograph	
Unit Hydrograph: Uh256	Peaking Factor: 256.0	
Rainfall File: Flmod	Storm Duration(hrs): 24.00	
Rainfall Amount(in): 8.400	Time of Conc(min): 30.60	
Area(ac): 0.531	Time Shift(hrs): 0.00	
Curve Number: 90.00	Max Allowable Q(cfs): 999999.000	
DCIA(%): 0.00		

Name: WestSideBasin	Node: WestSideCut	Status: Onsite
Group: BASE	Type: SCS Unit Hydrograph	

Post Development
Input Report (After Construction)

```

Unit Hydrograph: Uh256
Rainfall File: Flmod
Rainfall Amount(in): 8.400
Area(ac): 0.280
Curve Number: 90.00
DCIA(%): 0.00

```

```

      Peaking Factor: 256.0
Storm Duration(hrs): 24.00
  Time of Conc(min): 19.75
    Time Shift(hrs): 0.00
Max Allowable Q(cfs): 999999.000

```

Nodes

```
Name: 1-node
Group: BASE
Type: Stage/Area
```

Base Flow(cfs): 0.000

```
Init Stage(ft): 147.000
Warn Stage(ft): 149.000
```

South end of existing swale northeast to storage tank

Stage(ft)	Area(ac)
147.000	0.0001
148.000	0.0001
149.000	0.0001

```
Name: 10 Ac-node
Group: BASE
Type: Stage/Area
```

Base Flow(cfs): 0.000

```
Init Stage(ft): 119.300
Warn Stage(ft): 125.000
```

Stage (ft)	Area (ac)
119.300	10.0000
122.500	10.5000
123.500	11.0300
124.500	11.6000

```
Name: 19 Ac-node
Group: BASE
Type: Stage/Area
```

Base Flow(cfs): 0.000

```
Init Stage(ft): 106.700
Warn Stage(ft): 120.000
```

19.12

Stage(ft)	Area(ac)
106.700	19.1200
108.000	20.1000
111.000	21.1000
113.000	22.2000
115.000	23.3100
117.000	24.5000
120.000	25.7000

Name: 2-node
Group: BASE
Type: Stage/Area

Base Flow(cfs): 0.000

```
Init Stage(ft): 146.000
Warn Stage(ft): 149.750
```

existing dry pond southeast of storage tank

Post Development
Input Report (After Construction)

Stage(ft) Area(ac)

146.000	0.0173
147.000	0.0235
148.000	0.0305
149.000	0.0429
150.000	0.0535

Name: 4-node Base Flow(cfs): 0.000 Init Stage(ft): 140.000
Group: BASE Warn Stage(ft): 145.750
Type: Stage/Area

storage tank area

Stage(ft) Area(ac)

140.000	0.1213
141.000	0.1520
142.000	0.1833
143.000	0.2168
144.000	0.2508
145.000	0.2867
146.000	0.3238

Name: 5-node Base Flow(cfs): 0.000 Init Stage(ft): 145.000
Group: BASE Warn Stage(ft): 148.500
Type: Stage/Area

Stage(ft) Area(ac)

145.000	0.0001
146.000	0.0001
147.000	0.0001
148.000	0.0001
149.000	0.0001

Name: 6-node Base Flow(cfs): 0.000 Init Stage(ft): 144.000
Group: BASE Warn Stage(ft): 148.750
Type: Stage/Area

swale south of storage tank

Stage(ft) Area(ac)

144.000	0.0001
145.000	0.0001
146.000	0.0001
147.000	0.0001
148.000	0.0001
149.000	0.0001

Name: 7-node Base Flow(cfs): 0.000 Init Stage(ft): 143.000
Group: BASE Warn Stage(ft): 144.750
Type: Stage/Area

node southwest to storage tank

Post Development
Input Report (After Construction)

Stage(ft)	Area(ac)
143.000	0.0001
144.000	0.0001
145.000	0.0001

Name: Area2	Base Flow(cfs): 0.000	Init Stage(ft): 290.000
Group: BASE		Warn Stage(ft): 298.000
Type: Stage/Area		

Stage(ft)	Area(ac)
290.000	0.0001
291.000	0.0001
292.000	0.0001
293.000	0.0001
294.000	0.0001
295.000	0.0001
296.000	0.0001
297.000	0.0001
298.000	0.0001

Name: BasinC	Base Flow(cfs): 0.000	Init Stage(ft): 124.900
Group: BASE		Warn Stage(ft): 130.000
Type: Stage/Area		

Stage(ft)	Area(ac)
123.700	3.3000
124.000	3.4100
125.000	3.6100
126.000	3.8000
127.000	4.0300
128.000	4.1200
130.000	4.4900

Name: BottomChute1	Base Flow(cfs): 0.000	Init Stage(ft): 140.000
Group: BASE		Warn Stage(ft): 145.000
Type: Stage/Area		

Stage(ft)	Area(ac)
140.000	0.0001
141.000	0.0001
142.000	0.0001
143.000	0.0001
144.000	0.0001
145.000	0.0001

Name: BottomChute3	Base Flow(cfs): 0.000	Init Stage(ft): 140.000
Group: BASE		Warn Stage(ft): 145.000
Type: Stage/Area		

Post Development
Input Report (After Construction)

Stage(ft)	Area(ac)
140.000	0.0001
141.000	0.0001
142.000	0.0001
143.000	0.0001
144.000	0.0001
145.000	0.0001

Name: Dischrg-Bound	Base Flow(cfs): 0.000	Init Stage(ft): 90.000
Group: BASE		Warn Stage(ft): 92.000
Type: Time/Stage		

Time(hrs)	Stage(ft)
0.00	90.000
9999.00	90.000

Name: manhole-node	Base Flow(cfs): 0.000	Init Stage(ft): 121.390
Group: BASE		Warn Stage(ft): 126.000
Type: Stage/Area		

Stage(ft)	Area(ac)
121.390	0.0001
121.500	0.0001
122.000	0.0001
126.000	0.0001

Name: P1-node	Base Flow(cfs): 0.000	Init Stage(ft): 129.340
Group: BASE		Warn Stage(ft): 135.000
Type: Stage/Area		

Stage(ft)	Area(ac)
129.340	0.0001
130.000	0.0001
131.000	0.0001
132.000	0.0001
133.000	0.0001
134.000	0.0001
135.000	0.0001

Name: P2-node	Base Flow(cfs): 0.000	Init Stage(ft): 128.510
Group: BASE		Warn Stage(ft): 135.000
Type: Stage/Area		

Stage(ft)	Area(ac)
-----------	----------

Post Development
Input Report (After Construction)

128.510	0.0001
129.000	0.0001
130.000	0.0001
131.000	0.0001
132.000	0.0001
133.000	0.0001
135.000	0.0001

Name: PrMine Cut	Base Flow(cfs): 0.000	Init Stage(ft): 121.600
Group: BASE		Warn Stage(ft): 125.000
Type: Stage/Area		

Stage(ft)	Area(ac)
121.900	106.0000
123.000	111.3000
124.000	116.9000
125.000	122.7000

Name: Sect78	Base Flow(cfs): 0.000	Init Stage(ft): 290.000
Group: BASE		Warn Stage(ft): 298.000
Type: Stage/Area		

Stage(ft)	Area(ac)
290.000	0.0001
291.000	0.0001
292.000	0.0001
293.000	0.0001
294.000	0.0001
295.000	0.0001
296.000	0.0001
297.000	0.0001
298.000	0.0001

Name: Sect9	Base Flow(cfs): 0.000	Init Stage(ft): 290.000
Group: BASE		Warn Stage(ft): 300.000
Type: Stage/Area		

Stage(ft)	Area(ac)
290.000	0.0001
291.000	0.0001
292.000	0.0001
293.000	0.0001
294.000	0.0001
295.000	0.0001
296.000	0.0001
297.000	0.0001
298.000	0.0001

Name: South-node	Base Flow(cfs): 0.000	Init Stage(ft): 138.500
------------------	-----------------------	-------------------------

Post Development
Input Report (After Construction)

Warn Stage(ft): 145.000

Group: BASE
Type: Stage/Area

Stage(ft)	Area(ac)
138.500	0.0001
140.000	0.0001
141.000	0.0001
142.000	0.0001
143.000	0.0001
144.000	0.0001
145.000	0.0001

Name: swale4 Base Flow(cfs): 0.000 Init Stage(ft): 94.750
Group: BASE Warn Stage(ft): 109.000
Type: Stage/Area

Stage(ft)	Area(ac)
94.750	0.2120
98.000	0.3700
101.000	0.5310
104.000	0.6900
109.000	0.8500

Name: WestSideCut Base Flow(cfs): 0.000 Init Stage(ft): 90.570
Group: BASE Warn Stage(ft): 102.000
Type: Stage/Area

Stage(ft)	Area(ac)
90.570	0.1100
94.000	0.2800
98.000	0.3640
102.000	0.4500

==== Operating Tables =====

Name: Pump Group: BASE
Type: Rating Curve
Function: Head vs. Discharge

submersible pump from storage tank out to swale south of storage tank

Head(ft)	Discharge(cfs)
0.00	0.00
12.00	0.11

==== Pipes =====

Post Development
Input Report (After Construction)

Name: Culver1A	From Node: PrMine Cut	Length(ft): 100.00
Group: BASE	To Node: 10 Ac-node	Count: 1
		Friction Equation: Average Conveyance
		Solution Algorithm: Automatic
		Flow: Both
UPSTREAM	DOWNSTREAM	Entrance Loss Coef: 0.50
Geometry: Circular	Circular	Exit Loss Coef: 1.00
Span(in): 24.00	24.00	Bend Loss Coef: 0.00
Rise(in): 24.00	24.00	Outlet Ctrl Spec: Use dc or tw
Invert(ft): 121.680	120.980	Inlet Ctrl Spec: Use dn
Manning's N: 0.012000	0.012000	Stabilizer Option: None
Top Clip(in): 0.000	0.000	
Bot Clip(in): 0.000	0.000	

Upstream FHWA Inlet Edge Description:
Circular Concrete: Square edge w/ headwall

Downstream FHWA Inlet Edge Description:
Circular Concrete: Square edge w/ headwall

second pipe from Primary Mine Cut to the 10 acre mine cut

Name: Culvert1	From Node: PrMine Cut	Length(ft): 100.00
Group: BASE	To Node: 10 Ac-node	Count: 1
		Friction Equation: Average Conveyance
		Solution Algorithm: Automatic
		Flow: Both
UPSTREAM	DOWNSTREAM	Entrance Loss Coef: 0.50
Geometry: Circular	Circular	Exit Loss Coef: 1.00
Span(in): 24.00	24.00	Bend Loss Coef: 0.00
Rise(in): 24.00	24.00	Outlet Ctrl Spec: Use dc or tw
Invert(ft): 121.770	120.890	Inlet Ctrl Spec: Use dn
Manning's N: 0.012000	0.012000	Stabilizer Option: None
Top Clip(in): 0.000	0.000	
Bot Clip(in): 0.000	0.000	

Upstream FHWA Inlet Edge Description:
Circular Concrete: Square edge w/ headwall

Downstream FHWA Inlet Edge Description:
Circular Concrete: Square edge w/ headwall

one of two pipes from Primary Mine Cut to the 10 acre mine cut

Name: Culvert2	From Node: 10 Ac-node	Length(ft): 94.00
Group: BASE	To Node: 19 Ac-node	Count: 1
		Friction Equation: Average Conveyance
		Solution Algorithm: Automatic
		Flow: Both
UPSTREAM	DOWNSTREAM	Entrance Loss Coef: 0.50
Geometry: Circular	Circular	Exit Loss Coef: 1.00
Span(in): 24.00	24.00	Bend Loss Coef: 0.00
Rise(in): 24.00	24.00	Outlet Ctrl Spec: Use dc or tw
Invert(ft): 120.420	119.460	Inlet Ctrl Spec: Use dn
Manning's N: 0.012000	0.012000	Stabilizer Option: None
Top Clip(in): 0.000	0.000	
Bot Clip(in): 0.000	0.000	

Upstream FHWA Inlet Edge Description:
Circular Concrete: Square edge w/ headwall

Post Development
Input Report (After Construction)

Downstream FHWA Inlet Edge Description:
Circular Concrete: Square edge w/ headwall

one of two pipes from 10 acre mine cut to the 19 acre mine cut

Name: Culvert2A	From Node: 10 Ac-node	Length(ft): 94.00
Group: BASE	To Node: 19 Ac-node	Count: 1
		Friction Equation: Average Conveyance
		Solution Algorithm: Automatic
		Flow: Both
UPSTREAM	DOWNSTREAM	Entrance Loss Coef: 0.50
Geometry: Circular	Circular	Exit Loss Coef: 1.00
Span(in): 24.00	24.00	Bend Loss Coef: 0.00
Rise(in): 24.00	24.00	Outlet Ctrl Spec: Use dc or tw
Invert(ft): 120.450	119.400	Inlet Ctrl Spec: Use dn
Manning's N: 0.012000	0.012000	Stabilizer Option: None
Top Clip(in): 0.000	0.000	
Bot Clip(in): 0.000	0.000	

Upstream FHWA Inlet Edge Description:
Circular Concrete: Square edge w/ headwall

Downstream FHWA Inlet Edge Description:
Circular Concrete: Square edge w/ headwall

second pipe from 10 acre mine cut to 19 acre mine cut

Name: Culvert3	From Node: 19 Ac-node	Length(ft): 50.00
Group: BASE	To Node: swale4	Count: 1
		Friction Equation: Average Conveyance
		Solution Algorithm: Automatic
		Flow: Both
UPSTREAM	DOWNSTREAM	Entrance Loss Coef: 0.50
Geometry: Circular	Circular	Exit Loss Coef: 1.00
Span(in): 18.00	18.00	Bend Loss Coef: 0.00
Rise(in): 18.00	18.00	Outlet Ctrl Spec: Use dc or tw
Invert(ft): 107.040	106.770	Inlet Ctrl Spec: Use dn
Manning's N: 0.012000	0.012000	Stabilizer Option: None
Top Clip(in): 0.000	0.000	
Bot Clip(in): 0.000	0.000	

Upstream FHWA Inlet Edge Description:
Circular Concrete: Square edge w/ headwall

Downstream FHWA Inlet Edge Description:
Circular Concrete: Square edge w/ headwall

Name: Culvert4	From Node: swale4	Length(ft): 50.00
Group: BASE	To Node: WestSideCut	Count: 1
		Friction Equation: Average Conveyance
		Solution Algorithm: Automatic
		Flow: Both
UPSTREAM	DOWNSTREAM	Entrance Loss Coef: 0.50
Geometry: Circular	Circular	Exit Loss Coef: 1.00
Span(in): 20.00	20.00	Bend Loss Coef: 0.00
Rise(in): 20.00	20.00	Outlet Ctrl Spec: Use dc or tw
Invert(ft): 95.400	94.880	Inlet Ctrl Spec: Use dn
Manning's N: 0.012000	0.012000	Stabilizer Option: None
Top Clip(in): 0.000	0.000	
Bot Clip(in): 0.000	0.000	

Post Development
Input Report (After Construction)

Upstream FHWA Inlet Edge Description:
Circular Concrete: Square edge w/ headwall

Downstream FHWA Inlet Edge Description:
Circular Concrete: Square edge w/ headwall

Name: Culvert4A	From Node: swale4	Length(ft): 50.00
Group: BASE	To Node: WestSideCut	Count: 1
	Friction Equation: Average Conveyance	
	Solution Algorithm: Automatic	
	Flow: Both	
UPSTREAM	DOWNSTREAM	
Geometry: Circular	Circular	
Span(in): 20.00	20.00	Entrance Loss Coef: 0.50
Rise(in): 20.00	20.00	Exit Loss Coef: 1.00
Invert(ft): 95.400	94.880	Bend Loss Coef: 0.00
Manning's N: 0.012000	0.012000	Outlet Ctrl Spec: Use dc or tw
Top Clip(in): 0.000	0.000	Inlet Ctrl Spec: Use dn
Bot Clip(in): 0.000	0.000	Stabilizer Option: None

Upstream FHWA Inlet Edge Description:
Circular Concrete: Square edge w/ headwall

Downstream FHWA Inlet Edge Description:
Circular Concrete: Square edge w/ headwall

Name: northpipe-link	From Node: 1-node	Length(ft): 64.00
Group: BASE	To Node: 5-node	Count: 1
	Friction Equation: Average Conveyance	
	Solution Algorithm: Automatic	
	Flow: Both	
UPSTREAM	DOWNSTREAM	
Geometry: Vert Ellipse	Vert Ellipse	Entrance Loss Coef: 0.50
Span(in): 14.00	14.00	Exit Loss Coef: 1.00
Rise(in): 23.00	23.00	Bend Loss Coef: 0.00
Invert(ft): 148.000	146.000	Outlet Ctrl Spec: Use dc or tw
Manning's N: 0.012000	0.012000	Inlet Ctrl Spec: Use dn
Top Clip(in): 0.000	0.000	Stabilizer Option: None
Bot Clip(in): 0.000	0.000	

Upstream FHWA Inlet Edge Description:
Vertical Ellipse Concrete: Square edge w/ headwall

Downstream FHWA Inlet Edge Description:
Vertical Ellipse Concrete: Square edge w/ headwall

pipe running under existing metal building southeast to storage tank

Name: Outlet Pipe	From Node: WestSideCut	Length(ft): 50.00
Group: BASE	To Node: Dischrg-Bound	Count: 1
	Friction Equation: Average Conveyance	
	Solution Algorithm: Automatic	
	Flow: Both	
UPSTREAM	DOWNSTREAM	
Geometry: Circular	Circular	

Post Development
Input Report (After Construction)

Span(in): 48.00	48.00	Entrance Loss Coef: 0.50
Rise(in): 48.00	48.00	Exit Loss Coef: 1.00
Invert(ft): 90.850	90.610	Bend Loss Coef: 0.00
Manning's N: 0.012000	0.012000	Outlet Ctrl Spec: Use dc or tw
Top Clip(in): 0.000	0.000	Inlet Ctrl Spec: Use dn
Bot Clip(in): 0.000	0.000	Stabilizer Option: None

Upstream FHWA Inlet Edge Description:
Circular Concrete: Square edge w/ headwall

Downstream FHWA Inlet Edge Description:
Circular Concrete: Square edge w/ headwall

Name: Outlet Pipe2	From Node: WestSideCut	Length(ft): 50.00
Group: BASE	To Node: Dischrg-Bound	Count: 1
		Friction Equation: Average Conveyance
		Solution Algorithm: Automatic
		Flow: Both
UPSTREAM	DOWNSTREAM	
Geometry: Circular	Circular	Entrance Loss Coef: 0.50
Span(in): 48.00	48.00	Exit Loss Coef: 1.00
Rise(in): 48.00	48.00	Bend Loss Coef: 0.00
Invert(ft): 91.010	90.660	Outlet Ctrl Spec: Use dc or tw
Manning's N: 0.012000	0.012000	Inlet Ctrl Spec: Use dn
Top Clip(in): 0.000	0.000	Stabilizer Option: None
Bot Clip(in): 0.000	0.000	

Upstream FHWA Inlet Edge Description:
Circular Concrete: Square edge w/ headwall

Downstream FHWA Inlet Edge Description:
Circular Concrete: Square edge w/ headwall

Name: Pipe-link	From Node: P1-node	Length(ft): 50.00
Group: BASE	To Node: P2-node	Count: 1
		Friction Equation: Average Conveyance
		Solution Algorithm: Automatic
		Flow: Both
UPSTREAM	DOWNSTREAM	
Geometry: Rectangular	Rectangular	Entrance Loss Coef: 0.50
Span(in): 96.00	96.00	Exit Loss Coef: 1.00
Rise(in): 48.00	48.00	Bend Loss Coef: 0.00
Invert(ft): 129.340	128.510	Outlet Ctrl Spec: Use dc or tw
Manning's N: 0.012000	0.012000	Inlet Ctrl Spec: Use dn
Top Clip(in): 0.000	0.000	Stabilizer Option: None
Bot Clip(in): 0.000	0.000	

Upstream FHWA Inlet Edge Description:
Rectangular Box: 30° to 75° wingwall flares

Downstream FHWA Inlet Edge Description:
Rectangular Box: 30° to 75° wingwall flares

Post Development
Input Report (After Construction)

Name: Pipe-PrMineCut	From Node: manhole-node	Length(ft): 65.00
Group: BASE	To Node: PrMine Cut	Count: 1
	Friction Equation: Average Conveyance	
	Solution Algorithm: Automatic	
	Flow: Both	
UPSTREAM	DOWNSTREAM	
Geometry: Circular	Circular	
Span(in): 48.00	48.00	Entrance Loss Coef: 0.50
Rise(in): 48.00	48.00	Exit Loss Coef: 1.00
Invert(ft): 121.390	121.220	Bend Loss Coef: 0.00
Manning's N: 0.012000	0.012000	Outlet Ctrl Spec: Use dc or tw
Top Clip(in): 0.000	0.000	Inlet Ctrl Spec: Use dn
Bot Clip(in): 0.000	0.000	Stabilizer Option: None

Upstream FHWA Inlet Edge Description:
Circular Concrete: Square edge w/ headwall

Downstream FHWA Inlet Edge Description:
Circular Concrete: Square edge w/ headwall

Name: S24pipe-link	From Node: 2-node	Length(ft): 87.63
Group: BASE	To Node: 5-node	Count: 1
	Friction Equation: Average Conveyance	
	Solution Algorithm: Automatic	
	Flow: Both	
UPSTREAM	DOWNSTREAM	
Geometry: Vert Ellipse	Vert Ellipse	Entrance Loss Coef: 0.50
Span(in): 12.00	12.00	Exit Loss Coef: 1.00
Rise(in): 18.00	18.00	Bend Loss Coef: 0.00
Invert(ft): 148.000	147.000	Outlet Ctrl Spec: Use dc or tw
Manning's N: 0.012000	0.012000	Inlet Ctrl Spec: Use dn
Top Clip(in): 0.000	0.000	Stabilizer Option: None
Bot Clip(in): 0.000	0.000	

Upstream FHWA Inlet Edge Description:
Vertical Ellipse Concrete: Square edge w/ headwall

Downstream FHWA Inlet Edge Description:
Vertical Ellipse Concrete: Square edge w/ headwall

pipe from existing pond to swale south of storage tank

Name: swpipe1-link	From Node: 6-node	Length(ft): 130.00
Group: BASE	To Node: 7-node	Count: 1
	Friction Equation: Average Conveyance	
	Solution Algorithm: Automatic	
	Flow: Both	
UPSTREAM	DOWNSTREAM	
Geometry: Circular	Circular	Entrance Loss Coef: 0.50
Span(in): 24.00	24.00	Exit Loss Coef: 1.00
Rise(in): 24.00	24.00	Bend Loss Coef: 0.00
Invert(ft): 145.000	143.000	Outlet Ctrl Spec: Use dc or tw
Manning's N: 0.012000	0.012000	Inlet Ctrl Spec: Use dn
Top Clip(in): 0.000	0.000	Stabilizer Option: None
Bot Clip(in): 0.000	0.000	

Upstream FHWA Inlet Edge Description:
Circular Concrete: Square edge w/ headwall

Post Development
Input Report (After Construction)

Downstream FHWA Inlet Edge Description:
Circular Concrete: Square edge w/ headwall

1st of 2 pipes from swale south of storage tank to swale southeast of storage tank

Name: SWpipe2-link	From Node: 6-node	Length(ft): 130.00
Group: BASE	To Node: 7-node	Count: 1
		Friction Equation: Average Conveyance
		Solution Algorithm: Automatic
		Flow: Both
UPSTREAM	DOWNSTREAM	Entrance Loss Coef: 0.50
Geometry: Circular	Circular	Exit Loss Coef: 1.00
Span(in): 24.00	24.00	Bend Loss Coef: 0.00
Rise(in): 24.00	24.00	Outlet Ctrl Spec: Use dc or tw
Invert(ft): 145.000	143.000	Inlet Ctrl Spec: Use dn
Manning's N: 0.012000	0.012000	Stabilizer Option: None
Top Clip(in): 0.000	0.000	
Bot Clip(in): 0.000	0.000	

Upstream FHWA Inlet Edge Description:
Circular Concrete: Square edge w/ headwall

Downstream FHWA Inlet Edge Description:
Circular Concrete: Square edge w/ headwall

2nd of 2 pipes from swale south of storage tank to swale southeast of storage tank

==== Channels =====

Name: Channel2	From Node: P2-node	Length(ft): 70.00
Group: BASE	To Node: BasinC	Count: 1
		Friction Equation: Average Conveyance
		Solution Algorithm: Automatic
		Flow: Both
UPSTREAM	DOWNSTREAM	Contraction Coef: 0.000
Geometry: Trapezoidal	Trapezoidal	Expansion Coef: 0.000
Invert(ft): 128.300	120.000	Entrance Loss Coef: 0.000
TClpInitZ(ft): 9999.000	9999.000	Exit Loss Coef: 0.000
Manning's N: 0.035000	0.035000	Outlet Ctrl Spec: Use dc or tw
Top Clip(ft): 0.000	0.000	Inlet Ctrl Spec: Use dn
Bot Clip(ft): 0.000	0.000	Stabilizer Option: None
Main XSec:		
AuxElev1(ft):		
Aux XSec1:		
AuxElev2(ft):		
Aux XSec2:		
Top Width(ft):		
Depth(ft):		
Bot Width(ft): 15.000	34.000	
LtSdSlp(h/v): 3.00	3.00	
RtSdSlp(h/v): 3.00	3.00	

Name: CombFlow-link	From Node: South-node	Length(ft): 350.00
Group: BASE	To Node: P1-node	Count: 1
		Friction Equation: Average Conveyance
		Solution Algorithm: Automatic
		Flow: Both
UPSTREAM	DOWNSTREAM	
Geometry: Trapezoidal	Trapezoidal	
Invert(ft): 135.000	129.340	

Post Development
Input Report (After Construction)

TClpInitZ(ft):	9999.000	9999.000	Contraction Coef:	0.000
Manning's N:	0.035000	0.035000	Expansion Coef:	0.000
Top Clip(ft):	0.000	0.000	Entrance Loss Coef:	0.000
Bot Clip(ft):	0.000	0.000	Exit Loss Coef:	0.000
Main XSec:			Outlet Ctrl Spec:	Use dc or tw
AuxElev1(ft):			Inlet Ctrl Spec:	Use dn
Aux XSec1:			Stabilizer Option:	None
AuxElev2(ft):				
Aux XSec2:				
Top Width(ft):				
Depth(ft):				
Bot Width(ft):	10.000	10.000		
LtSdSlp(h/v):	3.00	3.00		
RtSdSlp(h/v):	3.00	3.00		

Name: DownChutel	From Node: Sect9	Length(ft): 1300.00
Group: BASE	To Node: BottomChutel	Count: 1

	UPSTREAM	DOWNSTREAM	
Geometry:	Trapezoidal	Trapezoidal	Friction Equation: Average Conveyance
Invert(ft):	290.000	140.000	Solution Algorithm: Automatic
TClpInitZ(ft):	9999.000	9999.000	Flow: Both
Manning's N:	0.250000	0.250000	Contraction Coef: 0.000
Top Clip(ft):	0.000	0.000	Expansion Coef: 0.000
Bot Clip(ft):	0.000	0.000	Entrance Loss Coef: 0.000
Main XSec:			Exit Loss Coef: 0.000
AuxElev1(ft):			Outlet Ctrl Spec: Use dc or tw
Aux XSec1:			Inlet Ctrl Spec: Use dn
AuxElev2(ft):			Stabilizer Option: None
Aux XSec2:			
Top Width(ft):			
Depth(ft):			
Bot Width(ft):	4.000	4.000	
LtSdSlp(h/v):	3.00	3.00	
RtSdSlp(h/v):	3.00	3.00	

Name: DownChute2	From Node: Sect78	Length(ft): 1300.00
Group: BASE	To Node: South-node	Count: 1

	UPSTREAM	DOWNSTREAM	
Geometry:	Trapezoidal	Trapezoidal	Friction Equation: Average Conveyance
Invert(ft):	290.000	138.500	Solution Algorithm: Automatic
TClpInitZ(ft):	9999.000	9999.000	Flow: Both
Manning's N:	0.250000	0.250000	Contraction Coef: 0.000
Top Clip(ft):	0.000	0.000	Expansion Coef: 0.000
Bot Clip(ft):	0.000	0.000	Entrance Loss Coef: 0.000
Main XSec:			Exit Loss Coef: 0.000
AuxElev1(ft):			Outlet Ctrl Spec: Use dc or tw
Aux XSec1:			Inlet Ctrl Spec: Use dn
AuxElev2(ft):			Stabilizer Option: None
Aux XSec2:			
Top Width(ft):			
Depth(ft):			
Bot Width(ft):	4.000	4.000	
LtSdSlp(h/v):	3.00	3.00	
RtSdSlp(h/v):	3.00	3.00	

Post Development
Input Report (After Construction)

Name: DownChute3 From Node: Area2 Length(ft): 675.00
Group: BASE To Node: BottomChute3 Count: 1

	UPSTREAM	DOWNSTREAM	
Geometry:	Trapezoidal	Trapezoidal	Friction Equation: Average Conveyance
Invert(ft):	290.000	140.000	Solution Algorithm: Automatic
TClpInitZ(ft):	9999.000	9999.000	Flow: Both
Manning's N:	0.250000	0.250000	Contraction Coef: 0.000
Top Clip(ft):	0.000	0.000	Expansion Coef: 0.000
Bot Clip(ft):	0.000	0.000	Entrance Loss Coef: 0.000
Main XSec:			Exit Loss Coef: 0.000
AuxElev1(ft):			Outlet Ctrl Spec: Use dc or tw
Aux XSec1:			Inlet Ctrl Spec: Use dn
AuxElev2(ft):			Stabilizer Option: None
Aux XSec2:			
Top Width(ft):			
Depth(ft):			
Bot Width(ft):	4.000	4.000	
LtSdSlp(h/v):	3.00	3.00	
RtSdSlp(h/v):	3.00	3.00	

Name: Spillway-CHANNE From Node: BasinC Length(ft): 22.50
Group: BASE To Node: PrMine Cut Count: 1

	UPSTREAM	DOWNSTREAM	
Geometry:	Trapezoidal	Trapezoidal	Friction Equation: Average Conveyance
Invert(ft):	129.000	124.000	Solution Algorithm: Automatic
TClpInitZ(ft):	9999.000	9999.000	Flow: Both
Manning's N:	0.035000	0.035000	Contraction Coef: 0.000
Top Clip(ft):	0.000	0.000	Expansion Coef: 0.000
Bot Clip(ft):	0.000	0.000	Entrance Loss Coef: 0.000
Main XSec:			Exit Loss Coef: 0.000
AuxElev1(ft):			Outlet Ctrl Spec: Use dc or tw
Aux XSec1:			Inlet Ctrl Spec: Use dn
AuxElev2(ft):			Stabilizer Option: None
Aux XSec2:			
Top Width(ft):			
Depth(ft):			
Bot Width(ft):	25.000	30.000	
LtSdSlp(h/v):	10.00	10.00	
RtSdSlp(h/v):	10.00	10.00	

Name: Swale1 From Node: BottomChute1 Length(ft): 2000.00
Group: BASE To Node: South-node Count: 1

	UPSTREAM	DOWNSTREAM	
Geometry:	Trapezoidal	Trapezoidal	Friction Equation: Average Conveyance
Invert(ft):	140.000	135.000	Solution Algorithm: Automatic
TClpInitZ(ft):	9999.000	9999.000	Flow: Both
Manning's N:	0.035000	0.035000	Contraction Coef: 0.000
Top Clip(ft):	0.000	0.000	Expansion Coef: 0.000
Bot Clip(ft):	0.000	0.000	Entrance Loss Coef: 0.000
Main XSec:			Exit Loss Coef: 0.000
AuxElev1(ft):			Outlet Ctrl Spec: Use dc or tw
			Inlet Ctrl Spec: Use dn

Post Development
Input Report (After Construction)

Aux XSec1: Stabilizer Option: None
AuxElev2(ft):
Aux XSec2:
Top Width(ft):
Depth(ft):
Bot Width(ft): 10.000 10.000
LtSdSlp(h/v): 3.00 3.00
RtSdSlp(h/v): 3.00 3.00

Name: Swale3 From Node: BottomChute3 Length(ft): 2000.00
Group: BASE To Node: Pl-node Count: 1

	UPSTREAM	DOWNSTREAM	
Geometry:	Trapezoidal	Trapezoidal	Friction Equation: Average Conveyance
Invert(ft):	140.000	129.340	Solution Algorithm: Automatic
TClpInitZ(ft):	9999.000	9999.000	Flow: Both
Manning's N:	0.035000	0.035000	Contraction Coef: 0.000
Top Clip(ft):	0.000	0.000	Expansion Coef: 0.000
Bot Clip(ft):	0.000	0.000	Entrance Loss Coef: 0.000
Main XSec:			Exit Loss Coef: 0.000
AuxElev1(ft):			Outlet Ctrl Spec: Use dc or tw
Aux XSec1:			Inlet Ctrl Spec: Use dn
AuxElev2(ft):			Stabilizer Option: None
Aux XSec2:			
Top Width(ft):			
Depth(ft):			
Bot Width(ft):	10.000	10.000	
LtSdSlp(h/v):	3.00	3.00	
RtSdSlp(h/v):	3.00	3.00	

Name: swale5-link From Node: 5-node Length(ft): 194.00
Group: BASE To Node: 6-node Count: 1

	UPSTREAM	DOWNSTREAM	
Geometry:	Trapezoidal	Trapezoidal	Friction Equation: Average Conveyance
Invert(ft):	145.000	144.000	Solution Algorithm: Automatic
TClpInitZ(ft):	9999.000	9999.000	Flow: Both
Manning's N:	0.013000	0.013000	Contraction Coef: 0.000
Top Clip(ft):	0.000	0.000	Expansion Coef: 0.000
Bot Clip(ft):	0.000	0.000	Entrance Loss Coef: 0.000
Main XSec:			Exit Loss Coef: 0.000
AuxElev1(ft):			Outlet Ctrl Spec: Use dc or tw
Aux XSec1:			Inlet Ctrl Spec: Use dn
AuxElev2(ft):			Stabilizer Option: None
Aux XSec2:			
Top Width(ft):			
Depth(ft):			
Bot Width(ft):	10.000	10.000	
LtSdSlp(h/v):	3.00	3.00	
RtSdSlp(h/v):	3.00	3.00	

Name: swale6-link From Node: 7-node Length(ft): 800.00
Group: BASE To Node: BottomChute3 Count: 1

Post Development
Input Report (After Construction)

	UPSTREAM	DOWNSTREAM	
Geometry:	Trapezoidal	Trapezoidal	Friction Equation: Average Conveyance
Invert(ft):	143.000	140.000	Solution Algorithm: Automatic
TClpInitZ(ft):	9999.000	9999.000	Flow: Both
Manning's N:	0.013000	0.013000	Contraction Coef: 0.000
Top Clip(ft):	0.000	0.000	Expansion Coef: 0.000
Bot Clip(ft):	0.000	0.000	Entrance Loss Coef: 0.000
Main XSec:			Exit Loss Coef: 0.000
AuxElev1(ft):			Outlet Ctrl Spec: Use dc or tw
Aux XSec1:			Inlet Ctrl Spec: Use dn
AuxElev2(ft):			Stabilizer Option: None
Aux XSec2:			
Top Width(ft):			
Depth(ft):			
Bot Width(ft):	10.000	10.000	
LtSdSlp(h/v):	3.00	3.00	
RtSdSlp(h/v):	3.00	3.00	

exiting southwest of storage tank to swale 3

==== Drop Structures =====

Name:	From Node:	Length(ft): 0.00
Group: BASE	To Node:	Count: 1

	UPSTREAM	DOWNSTREAM	
Geometry:	Circular	Circular	Friction Equation: Average Conveyance
Span(in):	0.00	0.00	Solution Algorithm: Automatic
Rise(in):	0.00	0.00	Flow: Both
Invert(ft):	0.000	0.000	Entrance Loss Coef: 0.000
Manning's N:	0.000000	0.000000	Exit Loss Coef: 0.000
Top Clip(in):	0.000	0.000	Outlet Ctrl Spec: Use dc or tw
Bot Clip(in):	0.000	0.000	Inlet Ctrl Spec: Use dn
			Solution Incs: 10

Upstream FHWA Inlet Edge Description:
Circular Concrete: Square edge w/ headwall

Downstream FHWA Inlet Edge Description:
Circular Concrete: Square edge w/ headwall

Name: drop-strt-link	From Node: BasinC	Length(ft): 165.00
Group: BASE	To Node: manhole-node	Count: 1

	UPSTREAM	DOWNSTREAM	
Geometry:	Circular	Circular	Friction Equation: Average Conveyance
Span(in):	30.00	30.00	Solution Algorithm: Automatic
Rise(in):	30.00	30.00	Flow: Both
Invert(ft):	121.700	121.310	Entrance Loss Coef: 0.500
Manning's N:	0.012000	0.012000	Exit Loss Coef: 1.000
Top Clip(in):	0.000	0.000	Outlet Ctrl Spec: Use dc or tw
Bot Clip(in):	0.000	0.000	Inlet Ctrl Spec: Use dn
			Solution Incs: 10

Upstream FHWA Inlet Edge Description:
Circular Concrete: Square edge w/ headwall

Downstream FHWA Inlet Edge Description:
Circular Concrete: Square edge w/ headwall

Post Development
Input Report (After Construction)

Pipe segment

*** Weir 1 of 2 for Drop Structure drop-strct-link ***

TABLE

Count: 1	Bottom Clip(in): 0.000
Type: Horizontal	Top Clip(in): 0.000
Flow: Both	Weir Disc Coef: 3.200
Geometry: Circular	Orifice Disc Coef: 0.600
Span(in): 3.00	Invert(ft): 123.700
Rise(in): 3.00	Control Elev(ft): 123.700

*** Weir 2 of 2 for Drop Structure drop-strct-link ***

TABLE

Count: 1	Bottom Clip(in): 0.000
Type: Horizontal	Top Clip(in): 0.000
Flow: Both	Weir Disc Coef: 3.200
Geometry: Circular	Orifice Disc Coef: 0.600
Span(in): 60.00	Invert(ft): 125.200
Rise(in): 60.00	Control Elev(ft): 125.200

==== Breaches =====

Name:	From Node:	Count: 1
Group: BASE	To Node:	Flow: Both
Bottom Width(ft): 0.00	Water Surface Elev(ft): 0.000	
Left Side Slope(h/v): 0.00	Breach Duration(hrs): 0.00	
Right Side Slope(h/v): 0.00	Power Coef: 0.00	
Bottom Breach Elev(ft): 0.000	Weir Discharge Coef: 0.000	
Top Breach Elev(ft): 0.000		

==== Rating Curves =====

Name: Pump	From Node: 4-node	Count: 1
Group: BASE	To Node: 5-node	Flow: Both
TABLE	ELEV ON(ft)	ELEV OFF(ft)
#1: Pump	140.250	140.000
#2:	0.000	0.000
#3:	0.000	0.000
#4:	0.000	0.000

submersible pump within storage tank area

==== Hydrology Simulations =====

Name: new
Filename: T:\08449 - Hillsborough\030-02 SCLF General Services\5000 - Leachate Storage Tank ERP\510
Override Defaults: Yes
Storm Duration(hrs): 24.00

Post Development
Input Report (After Construction)

Rainfall File: Flmod
Rainfall Amount(in): 8.40

Time(hrs)	Print Inc(min)
24.000	2.00

==== Routing Simulations =====

Name: new Hydrology Sim: new
Filename: T:\08449 - Hillsborough\030-02 SCLF General Services\5000 - Leachate Storage Tank ERP\510

Execute: Yes Restart: No Patch: No
Alternative: No

Max Delta Z(ft): 0.50	Delta Z Factor: 0.00250
Time Step Optimizer: 10.000	
Start Time(hrs): 0.000	End Time(hrs): 150.00
Min Calc Time(sec): 0.2500	Max Calc Time(sec): 30.0000
Boundary Stages:	Boundary Flows:

Time(hrs)	Print Inc(min)
12.000	15.000
14.000	5.000
150.000	30.000

Group	Run
BASE	Yes

==== Boundary Conditions =====

**ICPR
LINK AND NODE MAXIMUM WATER LEVELS
AND FLOW**

Post Development
Link Maximum Report (After Construction)

Name	Group	Simulation	Max Time Flow hrs	Max Flow cfs	Max Delta Q cfs	Max Time US Stage hrs	Max US Stage ft	Max Time DS Stage hrs	Max DS Stage ft
Channel2	BASE	new	12.34	237.037	-153.270	12.56	130.408	13.11	129.143
CombFlow-link	BASE	new	0.00	661.760	661.760	0.00	138.500	0.00	132.840
Culvert1A	BASE	new	23.98	5.017	0.002	23.99	122.782	23.98	121.654
Culvert1	BASE	new	23.99	4.341	0.002	23.99	122.782	23.99	121.479
Culvert2	BASE	new	50.98	3.647	0.001	51.61	121.336	50.98	119.979
Culvert2A	BASE	new	51.17	3.444	0.001	51.61	121.336	51.17	119.893
Culvert3	BASE	new	113.23	4.431	0.004	113.23	108.286	113.23	107.578
Culvert4	BASE	new	113.19	2.216	0.001	113.19	96.145	113.19	95.308
Culvert4A	BASE	new	113.19	2.216	0.001	113.19	96.145	113.19	95.308
DownChute1	BASE	new	12.07	61.592	0.040	12.06	292.871	12.15	141.467
DownChute2	BASE	new	12.09	114.252	0.072	12.09	293.736	12.09	140.400
DownChute3	BASE	new	12.15	119.740	0.078	12.15	293.194	12.15	141.944
drop-strct-link	BASE	new	13.11	46.839	0.259	13.11	129.143	13.11	124.861
northpipe-link	BASE	new	12.01	3.684	0.014	12.01	149.208	12.01	146.520
Outlet Pipe	BASE	new	112.05	2.800	-0.001	113.74	91.488	112.05	91.054
Outlet Pipe2	BASE	new	113.23	1.632	0.001	113.74	91.488	113.23	90.974
Pipe-link	BASE	new	12.34	237.038	-33.498	12.34	134.659	12.34	130.176
Pipe-PrMineCut	BASE	new	13.11	46.839	1.141	13.11	124.861	13.11	123.271
Pump	BASE	new	7.26	0.000	0.000	23.99	142.187	12.07	145.751
S24pipe-link	BASE	new	18.61	0.017	-0.001	18.64	148.063	18.61	147.047
Spillway-channe	BASE	new	13.11	19.982	-0.031	13.11	129.143	13.11	124.129
Swale1	BASE	new	12.16	54.243	0.020	12.15	141.467	0.00	138.500
Swale3	BASE	new	12.23	120.346	-5.731	12.23	141.888	12.34	134.659
swale5-link	BASE	new	12.04	4.265	-0.035	12.07	145.751	12.07	145.730
swale6-link	BASE	new	12.06	8.337	-0.033	12.06	143.275	12.06	140.275
swpipe1-link	BASE	new	12.07	2.451	0.002	12.07	145.730	12.07	143.384
SWpipe2-link	BASE	new	12.07	2.451	0.002	12.07	145.730	12.07	143.384

Post Development
Node Maximum Report (After Construction)

Name	Group	Simulation	Max Time Stage hrs	Max Stage ft	Warning Stage ft	Max Delta Stage ft	Max Surf Area ft2	Max Time Inflow hrs	Max Inflow cfs	Max Time Outflow hrs	Max Outflow cfs
1-node	BASE	new	12.01	149.208	149.000	0.0012	149	12.00	3.700	12.01	3.684
10 Ac-node	BASE	new	51.61	121.336	125.000	0.0006	449821	12.07	43.871	51.17	7.090
19 Ac-node	BASE	new	113.23	108.286	120.000	0.0001	879902	12.07	83.576	113.23	4.431
2-node	BASE	new	18.64	148.063	149.750	0.0003	1382	12.00	0.562	18.61	0.017
4-node	BASE	new	23.99	142.187	145.750	0.0003	8257	12.00	3.155	7.26	0.000
5-node	BASE	new	12.07	145.751	148.500	0.0005	1699	12.01	4.533	12.04	4.265
6-node	BASE	new	12.07	145.730	148.750	0.0012	2186	12.03	5.102	12.07	4.901
7-node	BASE	new	12.06	143.275	144.750	0.0001	4989	12.03	8.479	12.06	8.337
Area2	BASE	new	12.15	293.194	298.000	0.0012	7297	12.13	120.365	12.15	119.740
BasinC	BASE	new	13.11	129.143	130.000	-0.0008	191537	12.32	248.438	13.11	66.822
BottomChute1	BASE	new	12.15	141.467	145.000	0.0004	28742	12.07	61.592	12.16	54.243
BottomChute3	BASE	new	12.23	141.888	145.000	0.0009	36589	12.14	127.275	12.23	120.346
Dischrg-Bound	BASE	new	0.00	90.000	92.000	0.0000	10	113.23	4.432	0.00	0.000
manhole-node	BASE	new	13.11	124.861	126.000	-0.0012	212	13.11	46.839	13.11	46.839
P1-node	BASE	new	12.34	134.659	135.000	0.0170	40145	0.00	661.760	12.34	237.038
P2-node	BASE	new	12.56	130.408	135.000	0.0248	1727	12.34	237.038	12.34	237.037
PrMine Cut	BASE	new	23.99	122.782	125.000	0.0002	4802813	12.66	259.835	23.99	9.358
Sect78	BASE	new	12.09	293.736	298.000	0.0012	15494	12.03	119.519	12.09	114.252
Sect9	BASE	new	12.06	292.871	300.000	0.0012	12464	12.00	65.132	12.07	61.592
South-node	BASE	new	0.00	138.500	145.000	-0.0057	29043	12.11	166.279	0.00	661.760
swale4	BASE	new	113.19	96.145	109.000	0.0001	12304	113.23	4.431	113.19	4.432
WestSideCut	BASE	new	113.74	91.488	102.000	0.0001	6981	113.19	4.432	113.23	4.432

A vertical dashed line consisting of 20 short, thick black horizontal bars spaced evenly along the left margin of the page.

LITTORAL ZONE CALCULATION

PROBLEM: VERIFY CONSTRUCTED LITTORAL ZONE MEETS LITTORAL ZONE REQUIREMENTS.

METHOD: AREA AT WATER TABLE ELEVATION (123.7 FT NGVD) = 143730 FT²

$$\begin{array}{r} \text{LITTORAL ZONE MINIMUM REQUIREMENT} = 143730 \text{ FT}^2 \\ \times \quad 35\% \\ \hline 50305.5 \text{ FT}^2 \end{array}$$

$$\text{CONSTRUCTED LITTORAL ZONE} = 64,980 \text{ FT}^2$$

$$\frac{64,980 \text{ FT}^2}{143730 \text{ FT}^2} \times 100 = 45\%$$

SOLUTION: The constructed LITTORAL ZONE IS 45 % of the POND SURFACE WITH ELEVATIONS FROM 121.7 TO 123.7 FT NGVD, EXCEEDING ERP LITTORAL ZONE REQUIREMENT.

A vertical dashed line on the left side of the page, consisting of 20 short horizontal black bars.

TREATMENT VOLUME CALCULATION

DETERMINE/RECONFORM TREATMENT VOLUME

$$V = \left(\sqrt{A_1 \times A_2} + A_1 + A_2 \right) \frac{h}{3}$$

EQUATION for
TRUNCATED PYRAMID

FROM X5-BUILT SURVEY FROM SOUTHEASTERN
CADD AREA TAKEN AND SHOWN BELOW

	EL	Area	
Control ELEVATION (CE)	123.7	143,730	SF
T.V. (10" CE)	125.2	158,948.6	
EL 125	157,314		
125.2	158,948.6		
126	165,487		

$$TV = \left(\sqrt{158,948.6 \times 143,730} + 143,730 + 158,948.6 \right) \frac{1.5}{3}$$

T.V. = 226,913 FT³ (5.21 FT).
provided

T.V. required = 224,049 (5.14 AC-ft)

61.72 AC $\times \frac{1}{12}$
= 5.14 AC-ft

T.V. provided > T.V. required

OK

DRAWDOWN CALCULATIONS

Drawdown Simulation

Simulation	Node	Group	Time hrs	Stage ft	Warning Stage ft	Surface Area ft2	Total Inflow cfs	Total Outflow cfs	Total Vol In af	Total Vol Out af
drawdown	BasinC	BASE	0.00	125.200	130.000	159977	16.467	0.289	0.0	0.0
drawdown	BasinC	BASE	0.25	125.475	130.000	162261	25.043	7.558	0.4	0.1
drawdown	BasinC	BASE	0.50	125.494	130.000	162396	4.783	8.341	0.7	0.2
drawdown	BasinC	BASE	0.75	125.466	130.000	162153	1.432	7.202	0.8	0.4
drawdown	BasinC	BASE	1.00	125.434	130.000	161890	0.594	6.016	0.8	0.5
drawdown	BasinC	BASE	1.25	125.406	130.000	161655	0.312	5.017	0.8	0.7
drawdown	BasinC	BASE	1.50	125.382	130.000	161451	0.059	4.203	0.8	0.8
drawdown	BasinC	BASE	1.75	125.361	130.000	161275	0.012	3.539	0.8	0.8
drawdown	BasinC	BASE	2.00	125.342	130.000	161125	0.010	3.005	0.8	0.9
drawdown	BasinC	BASE	2.25	125.327	130.000	160994	0.007	2.568	0.8	1.0
drawdown	BasinC	BASE	2.50	125.314	130.000	160886	0.007	2.224	0.8	1.0
drawdown	BasinC	BASE	2.75	125.302	130.000	160790	0.011	1.936	0.8	1.0
drawdown	BasinC	BASE	3.00	125.292	130.000	160705	0.004	1.695	0.8	1.1
drawdown	BasinC	BASE	3.25	125.283	130.000	160631	0.004	1.496	0.8	1.1
drawdown	BasinC	BASE	3.50	125.275	130.000	160566	0.004	1.328	0.8	1.1
drawdown	BasinC	BASE	3.75	125.268	130.000	160508	0.004	1.186	0.8	1.2
drawdown	BasinC	BASE	4.00	125.262	130.000	160456	0.004	1.065	0.8	1.2
drawdown	BasinC	BASE	4.25	125.256	130.000	160409	0.004	0.961	0.8	1.2
drawdown	BasinC	BASE	4.50	125.251	130.000	160367	0.003	0.871	0.8	1.2
drawdown	BasinC	BASE	4.75	125.246	130.000	160328	0.003	0.794	0.8	1.3
drawdown	BasinC	BASE	5.00	125.242	130.000	160293	0.003	0.726	0.8	1.3
drawdown	BasinC	BASE	5.25	125.238	130.000	160261	0.003	0.667	0.8	1.3
drawdown	BasinC	BASE	5.50	125.235	130.000	160231	0.002	0.615	0.8	1.3
drawdown	BasinC	BASE	5.75	125.231	130.000	160204	0.002	0.569	0.8	1.3
drawdown	BasinC	BASE	6.00	125.228	130.000	160179	0.002	0.530	0.8	1.3
drawdown	BasinC	BASE	6.25	125.225	130.000	160155	0.002	0.494	0.8	1.3
drawdown	BasinC	BASE	6.50	125.223	130.000	160132	0.002	0.462	0.8	1.3
drawdown	BasinC	BASE	6.75	125.220	130.000	160112	0.002	0.435	0.8	1.4
drawdown	BasinC	BASE	7.00	125.218	130.000	160092	0.001	0.410	0.8	1.4
drawdown	BasinC	BASE	7.25	125.216	130.000	160074	0.001	0.388	0.8	1.4
drawdown	BasinC	BASE	7.50	125.213	130.000	160056	0.001	0.369	0.8	1.4
drawdown	BasinC	BASE	7.75	125.211	130.000	160040	0.001	0.351	0.8	1.4
drawdown	BasinC	BASE	8.00	125.209	130.000	160024	0.001	0.336	0.8	1.4
drawdown	BasinC	BASE	8.25	125.208	130.000	160008	0.001	0.323	0.8	1.4
drawdown	BasinC	BASE	8.50	125.206	130.000	159994	0.001	0.312	0.8	1.4
drawdown	BasinC	BASE	8.75	125.204	130.000	159979	0.001	0.303	0.8	1.4
drawdown	BasinC	BASE	9.00	125.202	130.000	159966	0.001	0.296	0.8	1.4
drawdown	BasinC	BASE	9.25	125.201	130.000	159952	0.001	0.290	0.8	1.4
drawdown	BasinC	BASE	9.50	125.199	130.000	159938	0.001	0.289	0.8	1.4
drawdown	BasinC	BASE	9.75	125.198	130.000	159925	0.001	0.289	0.8	1.4
drawdown	BasinC	BASE	10.00	125.196	130.000	159912	0.001	0.289	0.8	1.4
drawdown	BasinC	BASE	10.25	125.194	130.000	159898	0.001	0.289	0.8	1.4

Drawdown Simulation

Simulation	Node	Group	Time hrs	Stage ft	Warning Stage ft	Surface Area ft2	Total Inflow cfs	Total Outflow cfs	Total Vol In af	Total Vol Out af
drawdown	BasinC	BASE	10.50	125.193	130.000	159885	0.001	0.289	0.8	1.5
drawdown	BasinC	BASE	10.75	125.191	130.000	159871	0.001	0.288	0.8	1.5
drawdown	BasinC	BASE	11.00	125.189	130.000	159858	0.001	0.288	0.8	1.5
drawdown	BasinC	BASE	11.25	125.188	130.000	159845	0.000	0.288	0.8	1.5
drawdown	BasinC	BASE	11.50	125.186	130.000	159831	0.000	0.288	0.8	1.5
drawdown	BasinC	BASE	11.75	125.185	130.000	159818	0.000	0.288	0.8	1.5
drawdown	BasinC	BASE	12.00	125.183	130.000	159804	0.000	0.288	0.8	1.5
drawdown	BasinC	BASE	12.25	125.181	130.000	159791	0.000	0.287	0.8	1.5
drawdown	BasinC	BASE	12.34	125.181	130.000	159786	0.000	0.287	0.8	1.5
drawdown	BasinC	BASE	12.42	125.180	130.000	159782	0.000	0.287	0.8	1.5
drawdown	BasinC	BASE	12.50	125.180	130.000	159778	0.000	0.287	0.8	1.5
drawdown	BasinC	BASE	12.59	125.179	130.000	159773	0.000	0.287	0.8	1.5
drawdown	BasinC	BASE	18.00	125.144	130.000	159485	0.000	0.284	0.8	1.6
drawdown	BasinC	BASE	18.50	125.141	130.000	159458	0.000	0.284	0.8	1.6
drawdown	BasinC	BASE	19.00	125.138	130.000	159432	0.000	0.283	0.8	1.7
drawdown	BasinC	BASE	19.50	125.135	130.000	159405	0.000	0.283	0.8	1.7
drawdown	BasinC	BASE	20.00	125.132	130.000	159379	0.000	0.283	0.8	1.7
drawdown	BasinC	BASE	20.50	125.128	130.000	159352	0.000	0.282	0.8	1.7

Drawdown Simulation

Simulation	Node	Group	Time hrs	Stage ft	Warning Stage ft	Surface Area ft2	Total Inflow cfs	Total Outflow cfs	Total Vol In af	Total Vol Out af
drawdown	BasinC	BASE	21.00	125.125	130.000	159326	0.000	0.282	0.8	1.7
drawdown	BasinC	BASE	21.50	125.122	130.000	159300	0.000	0.282	0.8	1.7
drawdown	BasinC	BASE	22.00	125.119	130.000	159273	0.000	0.281	0.8	1.7
drawdown	BasinC	BASE	22.50	125.116	130.000	159247	0.000	0.281	0.8	1.7
drawdown	BasinC	BASE	23.00	125.112	130.000	159221	0.000	0.281	0.8	1.7
drawdown	BasinC	BASE	23.50	125.109	130.000	159195	0.000	0.280	0.8	1.8
drawdown	BasinC	BASE	24.00	125.106	130.000	159168	0.000	0.280	0.8	1.8
drawdown	BasinC	BASE	24.50	125.103	130.000	159142	0.000	0.280	0.8	1.8
drawdown	BasinC	BASE	25.00	125.100	130.000	159116	0.000	0.279	0.8	1.8
drawdown	BasinC	BASE	25.50	125.097	130.000	159090	0.000	0.279	0.8	1.8
drawdown	BasinC	BASE	26.00	125.093	130.000	159064	0.000	0.279	0.8	1.8
drawdown	BasinC	BASE	26.50	125.090	130.000	159038	0.000	0.279	0.8	1.8
drawdown	BasinC	BASE	27.00	125.087	130.000	159012	0.000	0.278	0.8	1.8
drawdown	BasinC	BASE	27.50	125.084	130.000	158985	0.000	0.278	0.8	1.9
drawdown	BasinC	BASE	28.00	125.081	130.000	158959	0.000	0.278	0.8	1.9
drawdown	BasinC	BASE	28.50	125.078	130.000	158933	0.000	0.277	0.8	1.9
drawdown	BasinC	BASE	29.00	125.075	130.000	158907	0.000	0.277	0.8	1.9
drawdown	BasinC	BASE	29.50	125.071	130.000	158882	0.000	0.277	0.8	1.9
drawdown	BasinC	BASE	30.00	125.068	130.000	158856	0.000	0.276	0.8	1.9
drawdown	BasinC	BASE	30.50	125.065	130.000	158830	0.000	0.276	0.8	1.9
drawdown	BasinC	BASE	31.00	125.062	130.000	158804	0.000	0.276	0.8	1.9
drawdown	BasinC	BASE	31.50	125.059	130.000	158778	0.000	0.275	0.8	1.9
drawdown	BasinC	BASE	32.00	125.056	130.000	158752	0.000	0.275	0.8	2.0
drawdown	BasinC	BASE	32.50	125.053	130.000	158726	0.000	0.275	0.8	2.0
drawdown	BasinC	BASE	33.00	125.050	130.000	158701	0.000	0.274	0.8	2.0
drawdown	BasinC	BASE	33.50	125.046	130.000	158675	0.000	0.274	0.8	2.0
drawdown	BasinC	BASE	34.00	125.043	130.000	158649	0.000	0.274	0.8	2.0
drawdown	BasinC	BASE	34.50	125.040	130.000	158623	0.000	0.273	0.8	2.0
drawdown	BasinC	BASE	35.00	125.037	130.000	158598	0.000	0.273	0.8	2.0
drawdown	BasinC	BASE	35.50	125.034	130.000	158572	0.000	0.273	0.8	2.0
drawdown	BasinC	BASE	36.00	125.031	130.000	158547	0.000	0.273	0.8	2.0
drawdown	BasinC	BASE	36.50	125.028	130.000	158521	0.000	0.272	0.8	2.1
drawdown	BasinC	BASE	37.00	125.025	130.000	158495	0.000	0.272	0.8	2.1
drawdown	BasinC	BASE	37.50	125.022	130.000	158470	0.000	0.272	0.8	2.1
drawdown	BasinC	BASE	38.00	125.019	130.000	158444	0.000	0.271	0.8	2.1
drawdown	BasinC	BASE	38.50	125.016	130.000	158419	0.000	0.271	0.8	2.1
drawdown	BasinC	BASE	39.00	125.012	130.000	158393	0.000	0.271	0.8	2.1
drawdown	BasinC	BASE	39.50	125.009	130.000	158368	0.000	0.270	0.8	2.1
drawdown	BasinC	BASE	40.00	125.006	130.000	158343	0.000	0.270	0.8	2.1
drawdown	BasinC	BASE	40.50	125.003	130.000	158317	0.000	0.270	0.8	2.1
drawdown	BasinC	BASE	41.00	125.000	130.000	158292	0.000	0.269	0.8	2.2
drawdown	BasinC	BASE	41.50	124.997	130.000	158265	0.000	0.269	0.8	2.2

Drawdown Simulation

Simulation	Node	Group	Time hrs	Stage ft	Warning Stage ft	Surface Area ft2	Total Inflow cfs	Total Outflow cfs	Total Vol In af	Total Vol Out af
drawdown	BasinC	BASE	42.00	124.994	130.000	158239	0.000	0.269	0.8	2.2
drawdown	BasinC	BASE	42.50	124.991	130.000	158212	0.000	0.268	0.8	2.2
drawdown	BasinC	BASE	43.00	124.988	130.000	158185	0.000	0.268	0.8	2.2
drawdown	BasinC	BASE	43.50	124.985	130.000	158159	0.000	0.268	0.8	2.2
drawdown	BasinC	BASE	44.00	124.982	130.000	158132	0.000	0.267	0.8	2.2
drawdown	BasinC	BASE	44.50	124.979	130.000	158106	0.000	0.267	0.8	2.2
drawdown	BasinC	BASE	45.00	124.976	130.000	158079	0.000	0.267	0.8	2.2
drawdown	BasinC	BASE	45.50	124.973	130.000	158053	0.000	0.266	0.8	2.3
drawdown	BasinC	BASE	46.00	124.970	130.000	158026	0.000	0.266	0.8	2.3
drawdown	BasinC	BASE	46.50	124.967	130.000	158000	0.000	0.266	0.8	2.3
drawdown	BasinC	BASE	47.00	124.964	130.000	157974	0.000	0.266	0.8	2.3
drawdown	BasinC	BASE	47.50	124.961	130.000	157947	0.000	0.265	0.8	2.3
drawdown	BasinC	BASE	48.00	124.958	130.000	157921	0.000	0.265	0.8	2.3
drawdown	BasinC	BASE	48.50	124.955	130.000	157895	0.000	0.265	0.8	2.3
drawdown	BasinC	BASE	49.00	124.952	130.000	157869	0.000	0.264	0.8	2.3
drawdown	BasinC	BASE	49.50	124.949	130.000	157842	0.000	0.264	0.8	2.3
drawdown	BasinC	BASE	50.00	124.946	130.000	157816	0.000	0.264	0.8	2.4
drawdown	BasinC	BASE	50.50	124.943	130.000	157790	0.000	0.263	0.8	2.4
drawdown	BasinC	BASE	51.00	124.940	130.000	157764	0.000	0.263	0.8	2.4
drawdown	BasinC	BASE	51.50	124.937	130.000	157738	0.000	0.263	0.8	2.4
drawdown	BasinC	BASE	58.00	124.898	130.000	157400	0.000	0.259	0.8	2.5
drawdown	BasinC	BASE	58.50	124.895	130.000	157375	0.000	0.258	0.8	2.5
drawdown	BasinC	BASE	59.00	124.892	130.000	157349	0.000	0.258	0.8	2.5
drawdown	BasinC	BASE	59.50	124.889	130.000	157323	0.000	0.258	0.8	2.6
drawdown	BasinC	BASE	60.00	124.886	130.000	157298	0.000	0.257	0.8	2.6
drawdown	BasinC	BASE	60.50	124.883	130.000	157272	0.000	0.257	0.8	2.6
drawdown	BasinC	BASE	61.00	124.880	130.000	157246	0.000	0.257	0.8	2.6
drawdown	BasinC	BASE	61.50	124.877	130.000	157221	0.000	0.256	0.8	2.6
drawdown	BasinC	BASE	62.00	124.874	130.000	157195	0.000	0.256	0.8	2.6
drawdown	BasinC	BASE	62.50	124.871	130.000	157170	0.000	0.256	0.8	2.6