


1564173


①

MANATEE COUNTY LENA ROAD LANDFILL LEACHATE POND FACILITIES


FLORIDA DEPARTMENT OF
ENVIRONMENTAL PROTECTION
JAN 30 2002
SOUTHWEST DISTRICT
TAMPA

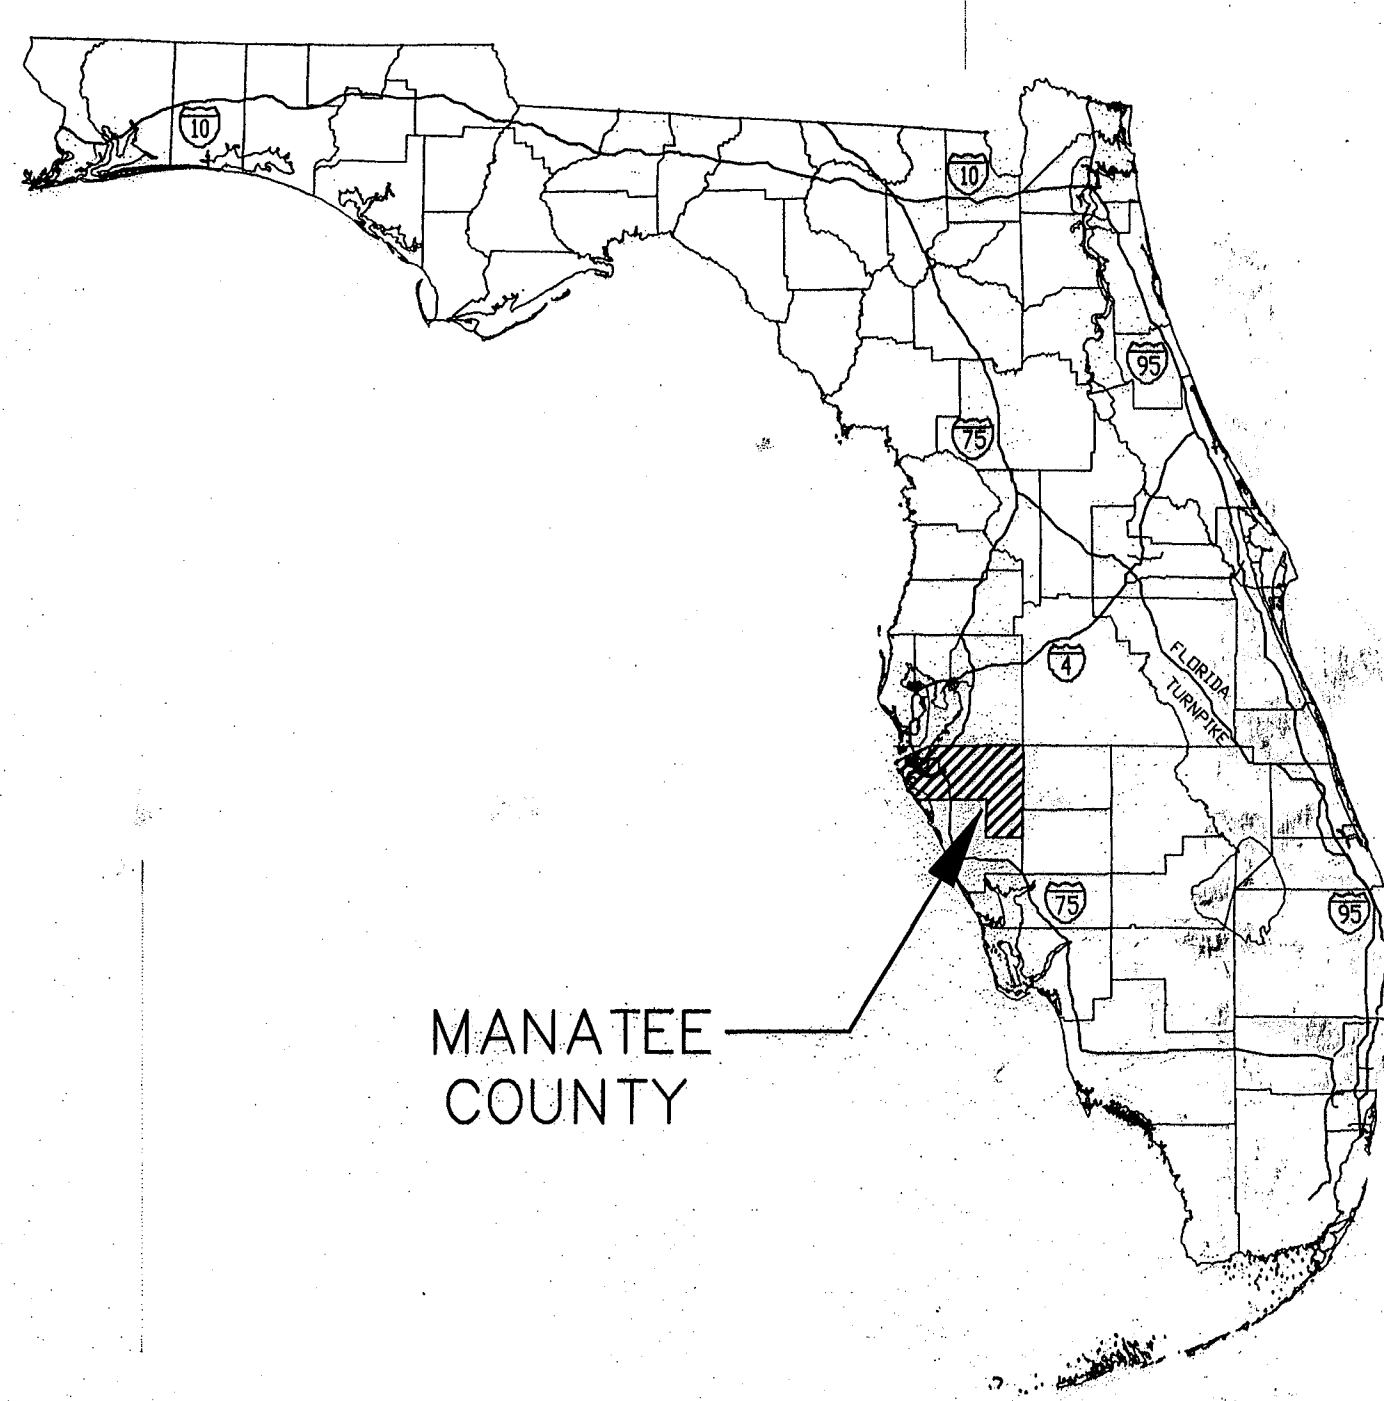

LOCATION MAP

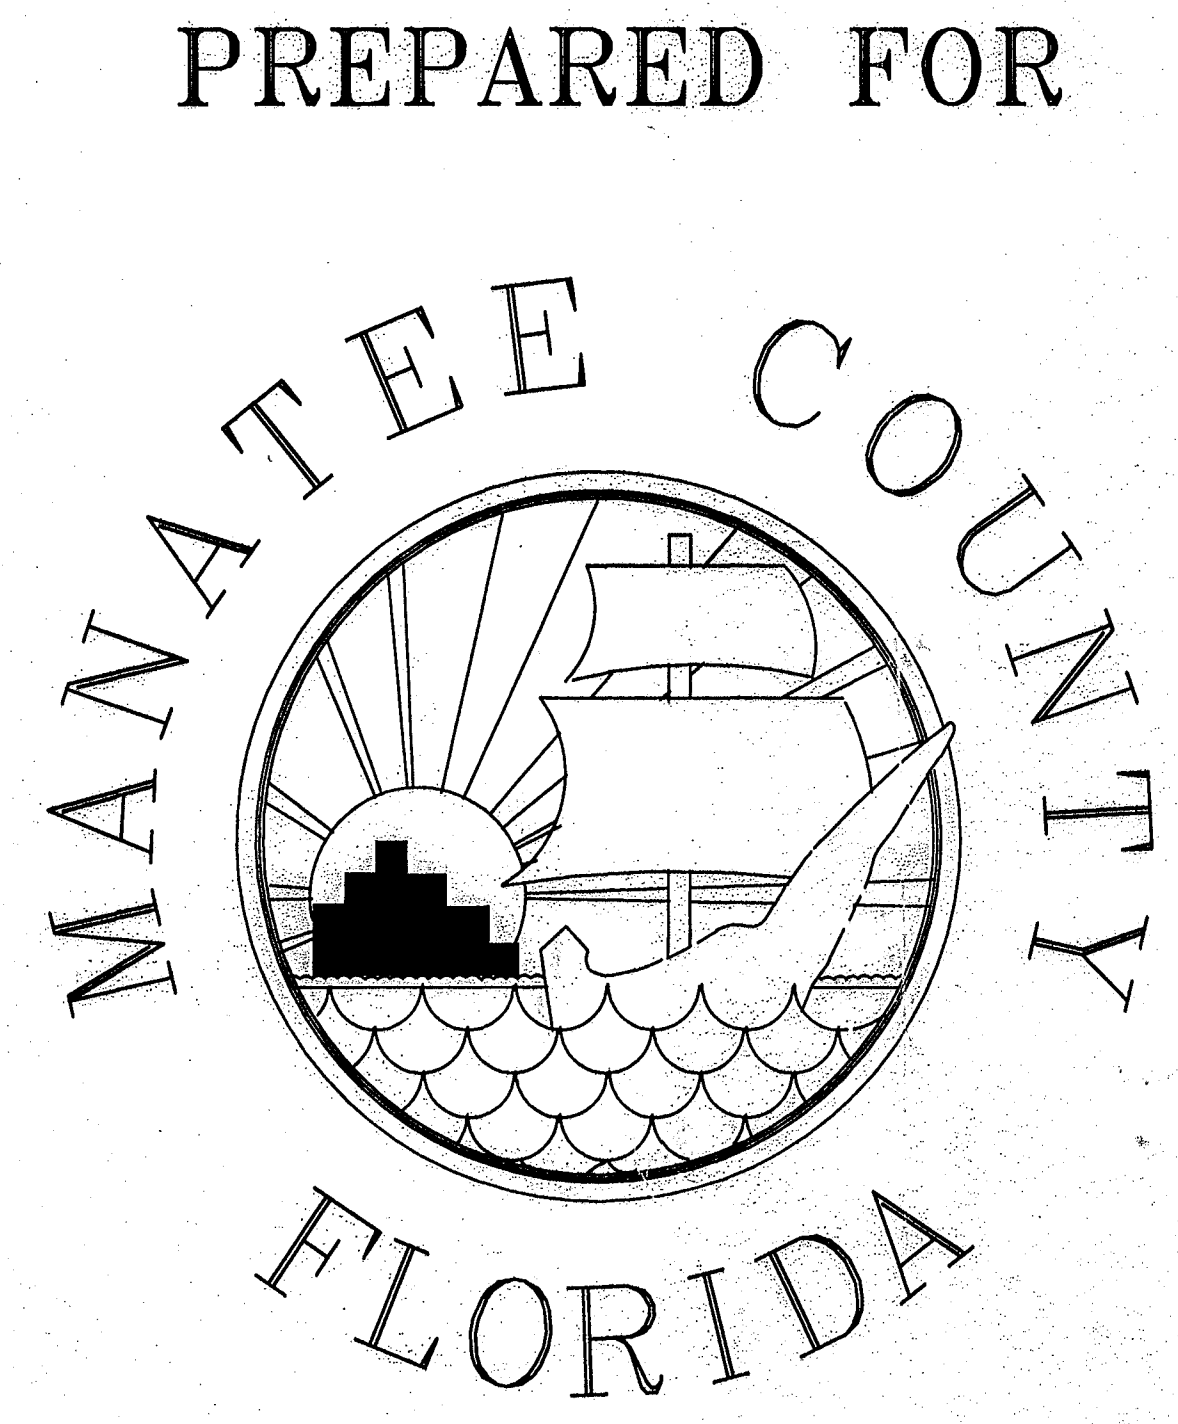

MANATEE
COUNTY
1026 26th AVENUE EAST
BRADENTON, FLORIDA 34208

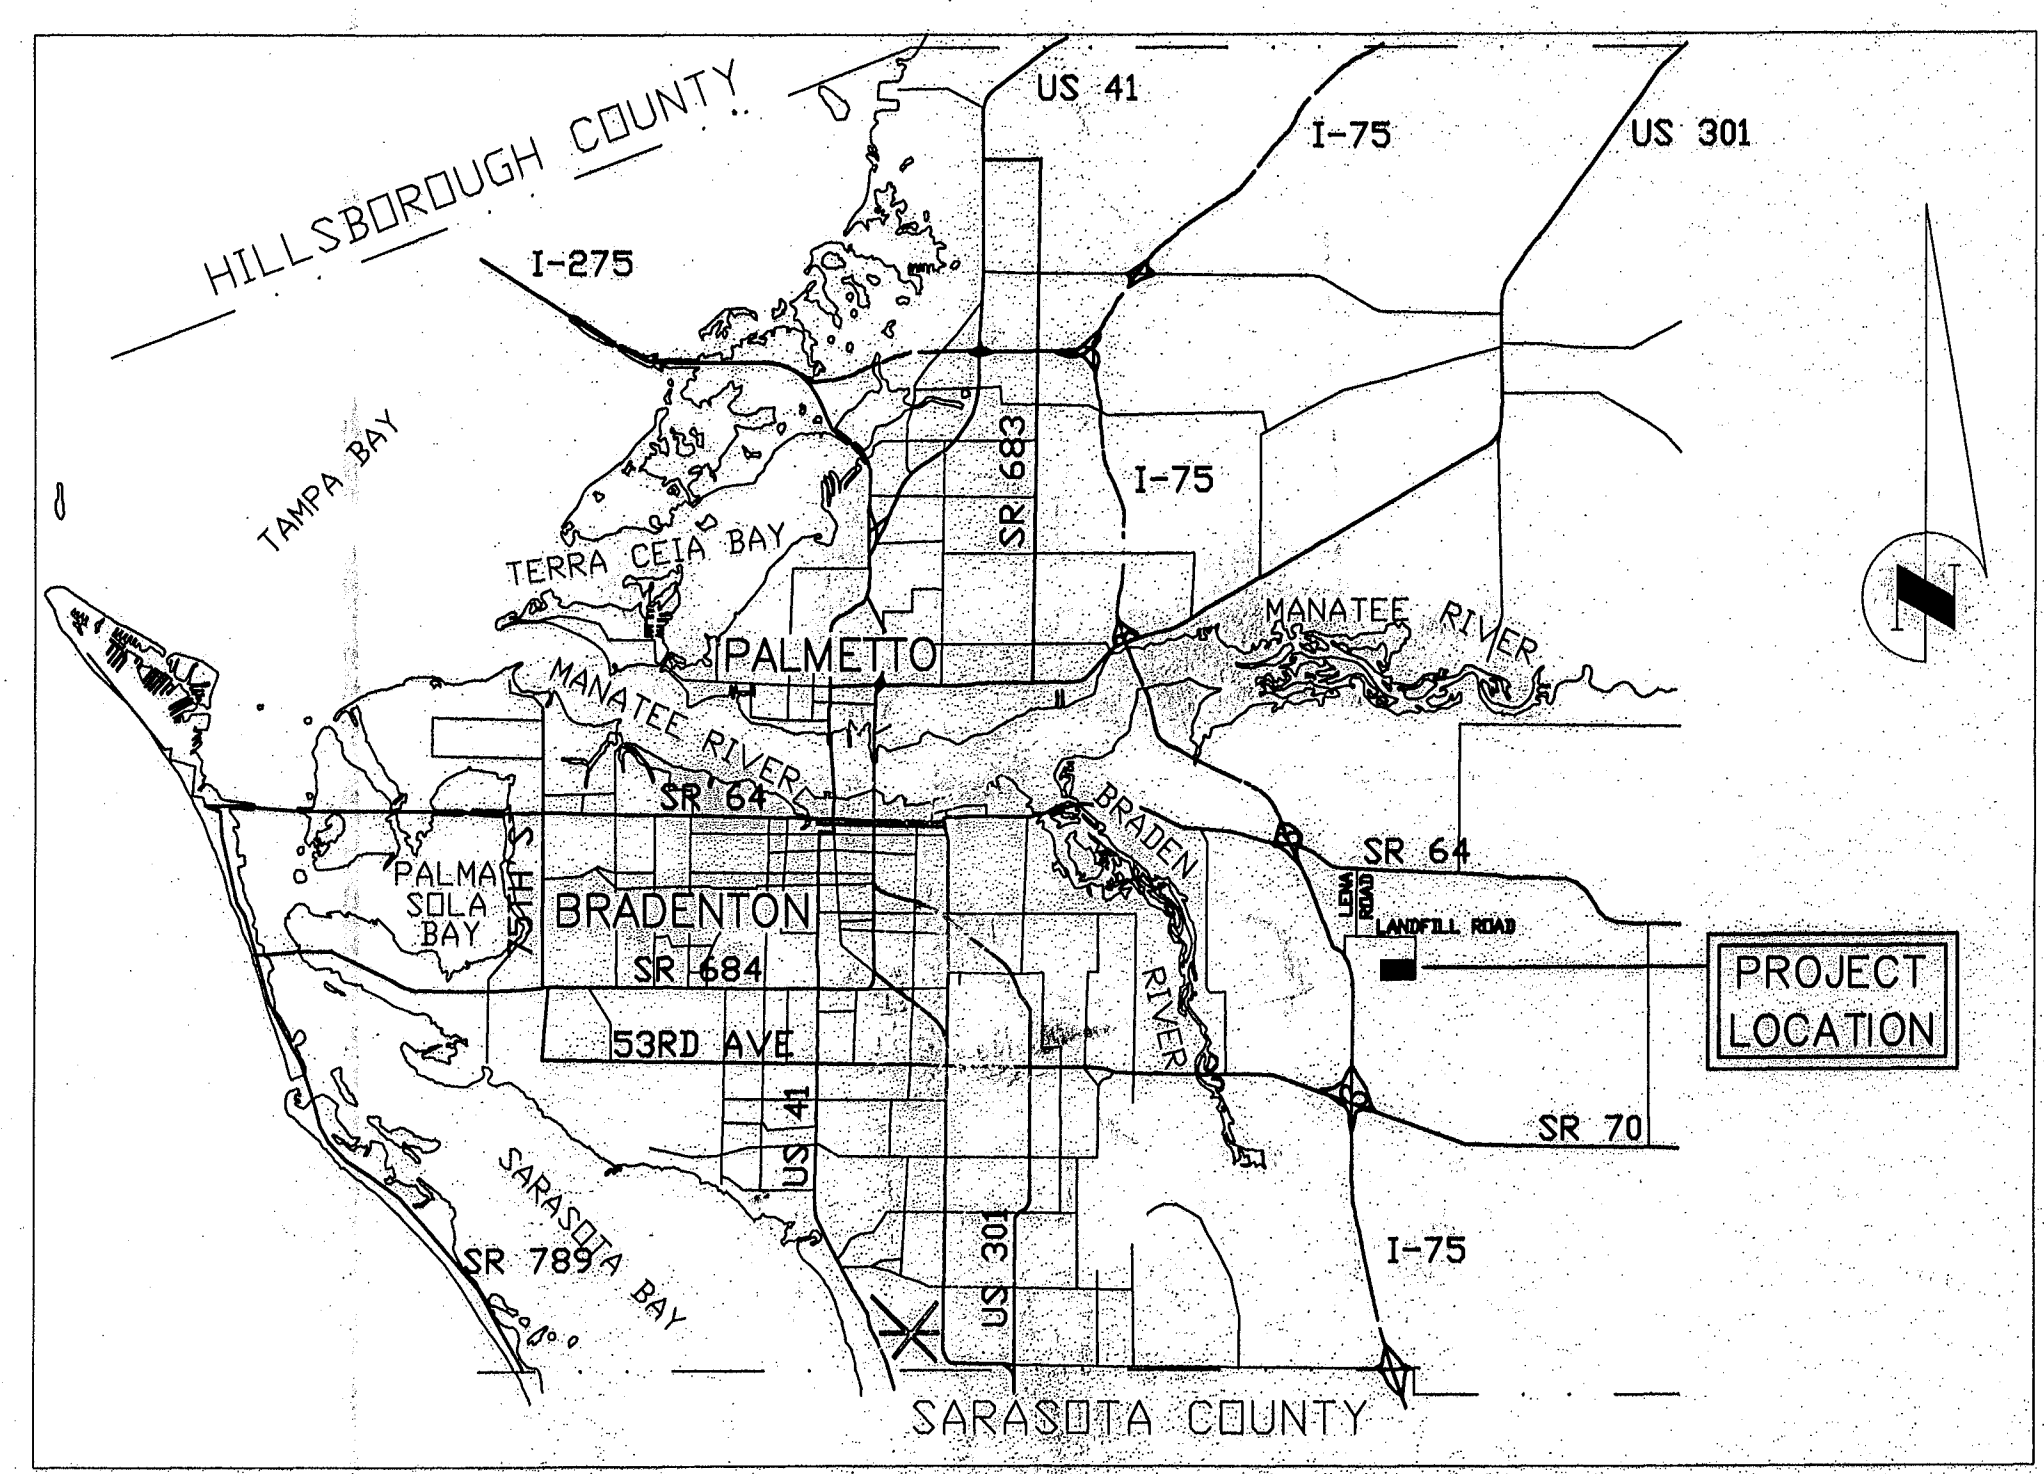

VICINITY MAP

INDEX TO DRAWINGS

SHEET NO.	TITLE
1	COVER SHEET
2	GENERAL NOTES, ABBREVIATIONS AND LEGEND
3	PROJECT KEY
4	PLAN AND PROFILE STA. 1+00 TO 12+00
5	PLAN AND PROFILE STA. 12+00 TO 23+00
6	PLAN AND PROFILES STA. 23+00 TO 25+63 AND STA. 300+00 TO 302+35
7	PLAN AND PROFILES STA. 400+00 TO 600+54
8	DETAILS
9	METERING STATION DETAILS
10	EROSION CONTROL DETAILS
11	EROSION CONTROL DETAILS
L1	EXTENSION AT STORAGE POND PLAN
L2	EXTENSION IN STAGE III LANDFILL
L3	SECTIONS AND DETAILS
L4	PIEZOMETER AND MONITOR WELL INSTALLATION DETAIL


REC DWG JAN/02

"RECORD DRAWING"
INCORPORATING THOSE CHANGES MADE
DURING CONSTRUCTION BASED ON DATA
FURNISHED BY THE CONTRACTOR TO THE
ENGINEER

DATE: AUG., 2001

PREPARED BY

PBS&J
330 SOUTH PINEAPPLE AVE.
SUITE 113
SARASOTA, FLORIDA 34236
Ph. (941) 954-4036
POST: BUCKLEY, SMITH & BERNARD, INC. D/B/A/ PBS&J
2001 N.W. 107TH AVENUE, MIAMI, FL. 33172-2507
FEDERAL CERTIFICATE OF AUTHORIZATION NO.24

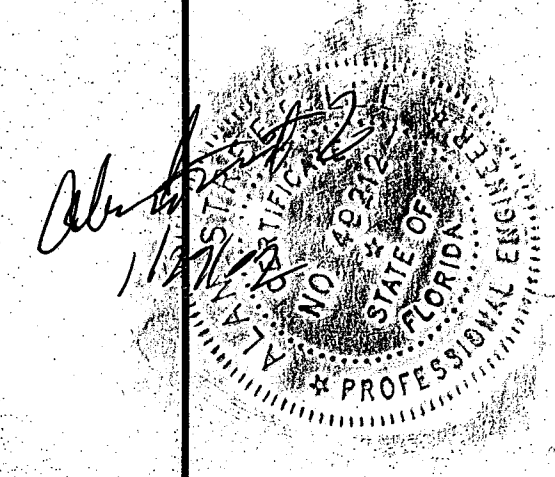

FLORIDA DEPARTMENT OF
ENVIRONMENTAL PROTECTION
JAN 30 2002
SOUTHWEST DISTRICT
TAMPA

GENERAL NOTES


1. THE CONTRACTOR SHALL BE RESPONSIBLE FOR MEETING ALL CONDITIONS AND REQUIREMENTS OF ALL PERMITS AND ALL GOVERNING FEDERAL, STATE, AND LOCAL AGENCIES.
2. EXISTING UNDERGROUND FACILITIES, STRUCTURES, AND UTILITIES HAVE BEEN LOCATED FROM THE BEST AVAILABLE SURVEY DATA AND RECORDS AND THEIR LOCATIONS MUST ONLY BE CONSIDERED AS APPROXIMATE. IT SHALL BE THE CONTRACTOR'S RESPONSIBILITY TO VERIFY THE EXACT LOCATION OF ALL EXISTING UTILITIES SHOWN ON THE PLANS AND ANY OTHER UTILITIES WHICH MAY NOT BE SHOWN ON THE PLANS. THE CONTRACTOR SHALL NOTIFY ALL UTILITY COMPANIES IN THE AREA AT LEAST 72 HOURS PRIOR TO BEGINNING CONSTRUCTION. CALL FLORIDA SUNSHINE STATE ONE CALL CENTER AT 1-800-432-4770.
3. A HORIZONTAL SPACING OF 10 FEET OUTSIDE TO OUTSIDE SHALL BE MAINTAINED BETWEEN POTABLE WATER MAINS AND ANY SANITARY SEWER MAINS. IN THE CASE OF A CROSSING, A VERTICAL SEPARATION OF NOT LESS THAN 18" SHALL BE MAINTAINED.
4. THE CONTRACTOR SHALL PROVIDE ALL DEWATER EQUIPMENT NECESSARY TO KEEP ALL EXCAVATIONS DRY AND SHALL PROVIDE ALL NECESSARY SHEETING, SHORING, AND BRACING NECESSARY TO PROTECT ADJACENT STRUCTURES, UTILITIES, AND PAVEMENT, OR TO MINIMIZE TRENCH WIDTH, ALL IN ACCORDANCE WITH THE PLANS AND SPECIFICATIONS.
5. THE CONTRACTOR SHALL PROVIDE HAY BALES AND/OR SILT FENCES AROUND THE CONSTRUCTION ACTIVITY, AS NECESSARY, TO PREVENT THE TRANSPORTATION OF SEDIMENTS DOWNSTREAM INTO STREETS, STORM SEWERS, OPEN DITCHES, LAKES, RETENTION PONDS, PRIVATE PROPERTY, ETC., AND SHALL PERFORM ALL NECESSARY INSPECTIONS AND MAINTENANCE IN ACCORDANCE WITH THE STORMWATER POLLUTION PREVENTION PLAN (SPPP), AND FEDERAL, STATE, AND LOCAL GOVERNING AGENCY REQUIREMENTS.
6. THE CONTRACTOR SHALL IMMEDIATELY NOTIFY THE OWNER'S CONSTRUCTION MANAGER REGARDING ANY CONFLICTS OR DISCREPANCIES ARISING DURING CONSTRUCTION.
7. THE CONTRACTOR SHALL BE RESPONSIBLE FOR ANY DAMAGE TO EXISTING FACILITIES, STRUCTURES, OR UTILITIES CAUSED BY CONSTRUCTION OPERATIONS WHICH HAVE BEEN PREVIOUSLY LOCATED BY THEIR RESPECTIVE OWNERS.
8. CONNECTIONS TO EXISTING FACILITIES SHALL BE DONE IN THE PRESENCE OF THE UTILITY OWNER AND THE ENGINEER. THE CONTRACTOR SHALL GIVE AT LEAST 2 WEEKS NOTICE TO ALL PARTIES CONCERNED PRIOR TO BEGINNING WORK.
9. ALL ADDITIONAL EXCAVATION AND DEMOLITION MATERIAL SHALL BE DISPOSED OF BY THE CONTRACTOR AT NO ADDITIONAL EXPENSE TO THE OWNER.
10. THE CONTRACTOR SHALL BE RESPONSIBLE FOR COMPLIANCE WITH THE FLORIDA TRENCH SAFETY ACT, 90-96, LAWS OF FLORIDA, EFFECTIVE OCTOBER 1, 1990, AND THE OCCUPATIONAL SAFETY AND HEALTH ADMINISTRATION EXCAVATION SAFETY STANDARDS, 29 CFR 1926.650, SUBPART P, AS AMENDED. THE CONTRACTOR SHALL INCLUDE IN THE TOTAL BID PRICE, ALL COSTS FOR COMPLIANCE WITH THESE REGULATIONS.
11. ALL DISTURBED AREAS SHALL BE RESTORED TO THEIR ORIGINAL CONDITION OR BETTER UNLESS OTHERWISE NOTED.
12. ALL ELEVATIONS ARE BASED UPON NATIONAL GEODETIC VERTICAL DATUM, 1929.
13. THE CONTRACTOR SHALL BE REQUIRED TO OBTAIN ALL APPLICABLE PERMITS.
14. ALL FITTINGS USED ON THIS PROJECT SHALL BE DUCTILE IRON UNLESS OTHERWISE SHOWN. FITTING LININGS SHALL BE FUSION BONDED EPOXY 20 MILS DFT. ALL MECHANICAL JOINT FITTINGS AND VALVES ARE TO BE RESTRAINED USING THE "MEGA-LUG" SYSTEM OR EQUAL.
15. THE EXHAUST SYSTEM OF ALL GASOLINE AND DIESEL ENGINES SHALL BE EQUIPPED WITH MUFFLERS THAT MEET THE EQUIPMENT MANUFACTURER'S REQUIREMENTS FOR NOISE SUPPRESSION. THE CONTRACTOR SHALL, AT THE DIRECTION OF THE ENGINEER DUE TO RESIDENTIAL COMPLAINTS, INSTALL NOISE ABATEMENT BAFFLES POSITIONED TO BREAK LINE-OF-SITE FROM THE NOISE SOURCE TO AFFECTED RESIDENCES, AS APPROVED BY THE ENGINEER.
16. TEMPORARY PLUGS MUST BE INCLUDED FOR TESTING PURPOSES PRIOR TO FINAL TIE-IN OF NEW FORCE MAINS.
17. SEE STANDARD DETAIL SHEET 8 FOR RESTRAINED JOINT LENGTH TABLE.
18. THE CONTRACTOR SHALL PROVIDE PROPER WARNING SIGNS, BARRICADES, TEMPORARY FENCING AND OTHER APPROPRIATE SAFETY DEVICES DURING THE EXECUTION OF THE WORK TO PROVIDE PUBLIC PROTECTION AND SAFETY.
19. THE CONTRACTOR SHALL COORDINATE ALL TIE-INS, DOWN TIME OF LIFT STATIONS AND FLOW HANDLING WITH MANATEE COUNTY UTILITY OPERATIONS PRIOR TO CONSTRUCTION. CONTRACTOR SHALL PROVIDE FOR STATION DOWN TIMES TO OCCUR AT LOW FLOWS AND MAXIMUM DOWN TIME MUST BE LIMITED TO 2 HOURS. CONTRACTOR SHALL PROVIDE FOR THE PROPER HANDLING AND DISPOSAL OF ALL WASTEWATER FLOWS DURING THE CONNECTION PROCEDURES. CONTRACTOR SHALL NOT OPERATE ANY VALVES OR PUMP CONTROLS.
20. CONTRACTOR SHALL DEFLECT PIPE JOINTS TO OBTAIN MINIMUM CLEARANCE REQUIREMENTS AT ALL PIPE CROSSINGS INSTEAD OF USING VERTICAL FITTINGS.
21. CONTRACTOR SHALL BE RESPONSIBLE FOR RESTORATION OF ALL SLURRY WALLS PENETRATED/DAMAGED DURING CONSTRUCTION.

LEGEND

- [] = CONCRETE
- [M] = WATER METER
- [C] = CONCRETE POST WITH CONTROL PANELS
- [S] = SIGN
- [P] = POWER POLE
- [A] = GUY ANCHOR
- [W] = MONITORING WELL
- [M] = MISCELLANEOUS MANHOLE
- [V] = BLOWOFF VALVE (WATER)
- [P] = WATERLINE MARKER (2" PVC PIPE)
- [V] = WATER VALVE
- [H] = FIRE HYDRANT
- OHL = OVERHEAD LINE
- [M] = SANITARY MANHOLE
- [G] = GATE
- [C] = CONTROL PANEL
- [P] = LIGHT POLE
- [T] = PROPANE TANK
- [B] = WIRING PULL BOX (ELECTRIC)

ABBREVIATIONS


APPROX	APPROXIMATELY	LSB	LICENSED SURVEYOR BUSINESS
ALUM	ALUMINUM	LF	LINEAL FEET
ARV	AIR RELEASE VALVE	LT	LEFT
AWWA	AMERICAN WATER WORK ASSOC.	MAX	MAXIMUM
AVG	AVERAGE	MJ	MECHANICAL JOINT
BL	BASE LINE	MISC	MISCELLANEOUS
BOC	BACK OF CURB	MIN	MINIMUM
BWF	BARBED WIRE FENCE	NTS	NOT TO SCALE
BFV	BUTTERFLY VALVE	OCEW	ON CENTER EACH WAY
CLF	CHAIN LINK FENCE	OD	OUTSIDE DIAMETER
CF	CUBIC FEET	OH	OVERHEAD
CL	CENTERLINE	OHL	OVERHEAD LINES
CLR	CLEARANCE	PE	PLAIN END
CM	CONCRETE MONUMENT	PRM	PERMANENT REFERENCE MARKER
CMP	CORRUGATED METAL PIPE	PVC	POLYVINYL CHLORIDE
CONC	CONCRETE	PSI	POUNDS PER SQUARE INCH
CONN	CONNECT	RCP	REINFORCED CONCRETE PIPE
CONT	CONTINUOUS	RDCR	REDUCER
COR	CORNER	REQ'D	REQUIRED
DFT	DRY FILM THICKNESS	RJ	RESTRAINED JOINT
DIA, d	DIAMETER	R/W	RIGHT-OF-WAY
DI, DIP	DUCTILE IRON PIPE	RWGV	RESILIENT WEDGE GATE VALVE W/ LOW ZINC STEM & NUT
D/W	DRIVEWAY	RT	RIGHT
E	EAST	SCHD	SCHEDULE
EL, ELEV	ELEVATION	SHT	SHEET
EOP	EDGE OF PAVEMENT	SQ.FT.	SQUARE FEET
EXIST/EX	EXISTING	SST, ST/STL	STAINLESS STEEL
FL	FLANGED	STA	STATION
FM	FORCE MAIN	STS	STORM SEWER
FND	FOUND	TOB	TOP OF BANK
FPS	FEET PER SECOND	TOS	TOE OF SLOPE
FT	FEET	TYP.	TYPICAL
GAL	GALLONS	W	WEST
GV	GATE VALVE	W/	WITH
HDPE	HIGH DENSITY POLYETHYLENE	WM	POTABLE WATER MAIN
HR	HOURLY		
ID	IDENTIFICATION		
INV	INVERT		
IR	IRON ROD		
LB	POUND		

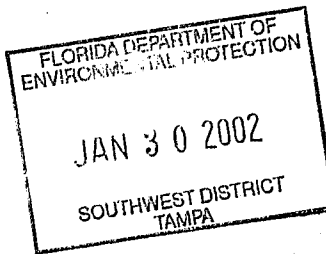

"RECORD DRAWING" APPROVED
INCORPORATING THOSE CHANGES MADE
DURING CONSTRUCTION BASED ON DATA
FURNISHED BY THE CONTRACTOR TO THE
ENGINEER.



CLIENT
**MANATEE COUNTY
PROJECT MANAGEMENT
DEPARTMENT**
**1023 26TH AVENUE EAST
BRADENTON, FLORIDA 34208**

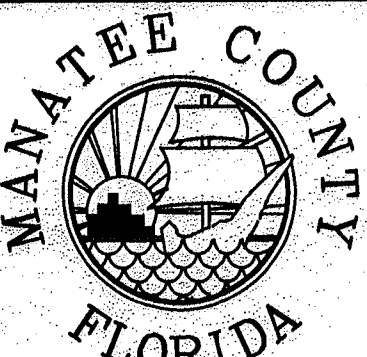

PROJECT
**LENA ROAD LANDFILL LEACHATE
POND FACILITIES**


TASK
**GENERAL NOTES, ABBREVIATIONS
AND LEGEND**

ORIGINAL: _____
REVISIONS:
1 REC. DWG. JAN/02
2 _____
3 _____
4 _____
5 _____


6 _____
7 _____
8 _____
9 _____
10 _____
11 _____
12 _____

NOT VALID FOR CONSTRUCTION
UNLESS SIGNED IN THIS BLOCK


JOB NO. 120498.02
DRAWN MV
DESIGNED JME
CHECKED JME
QC DBR
SHEET 2

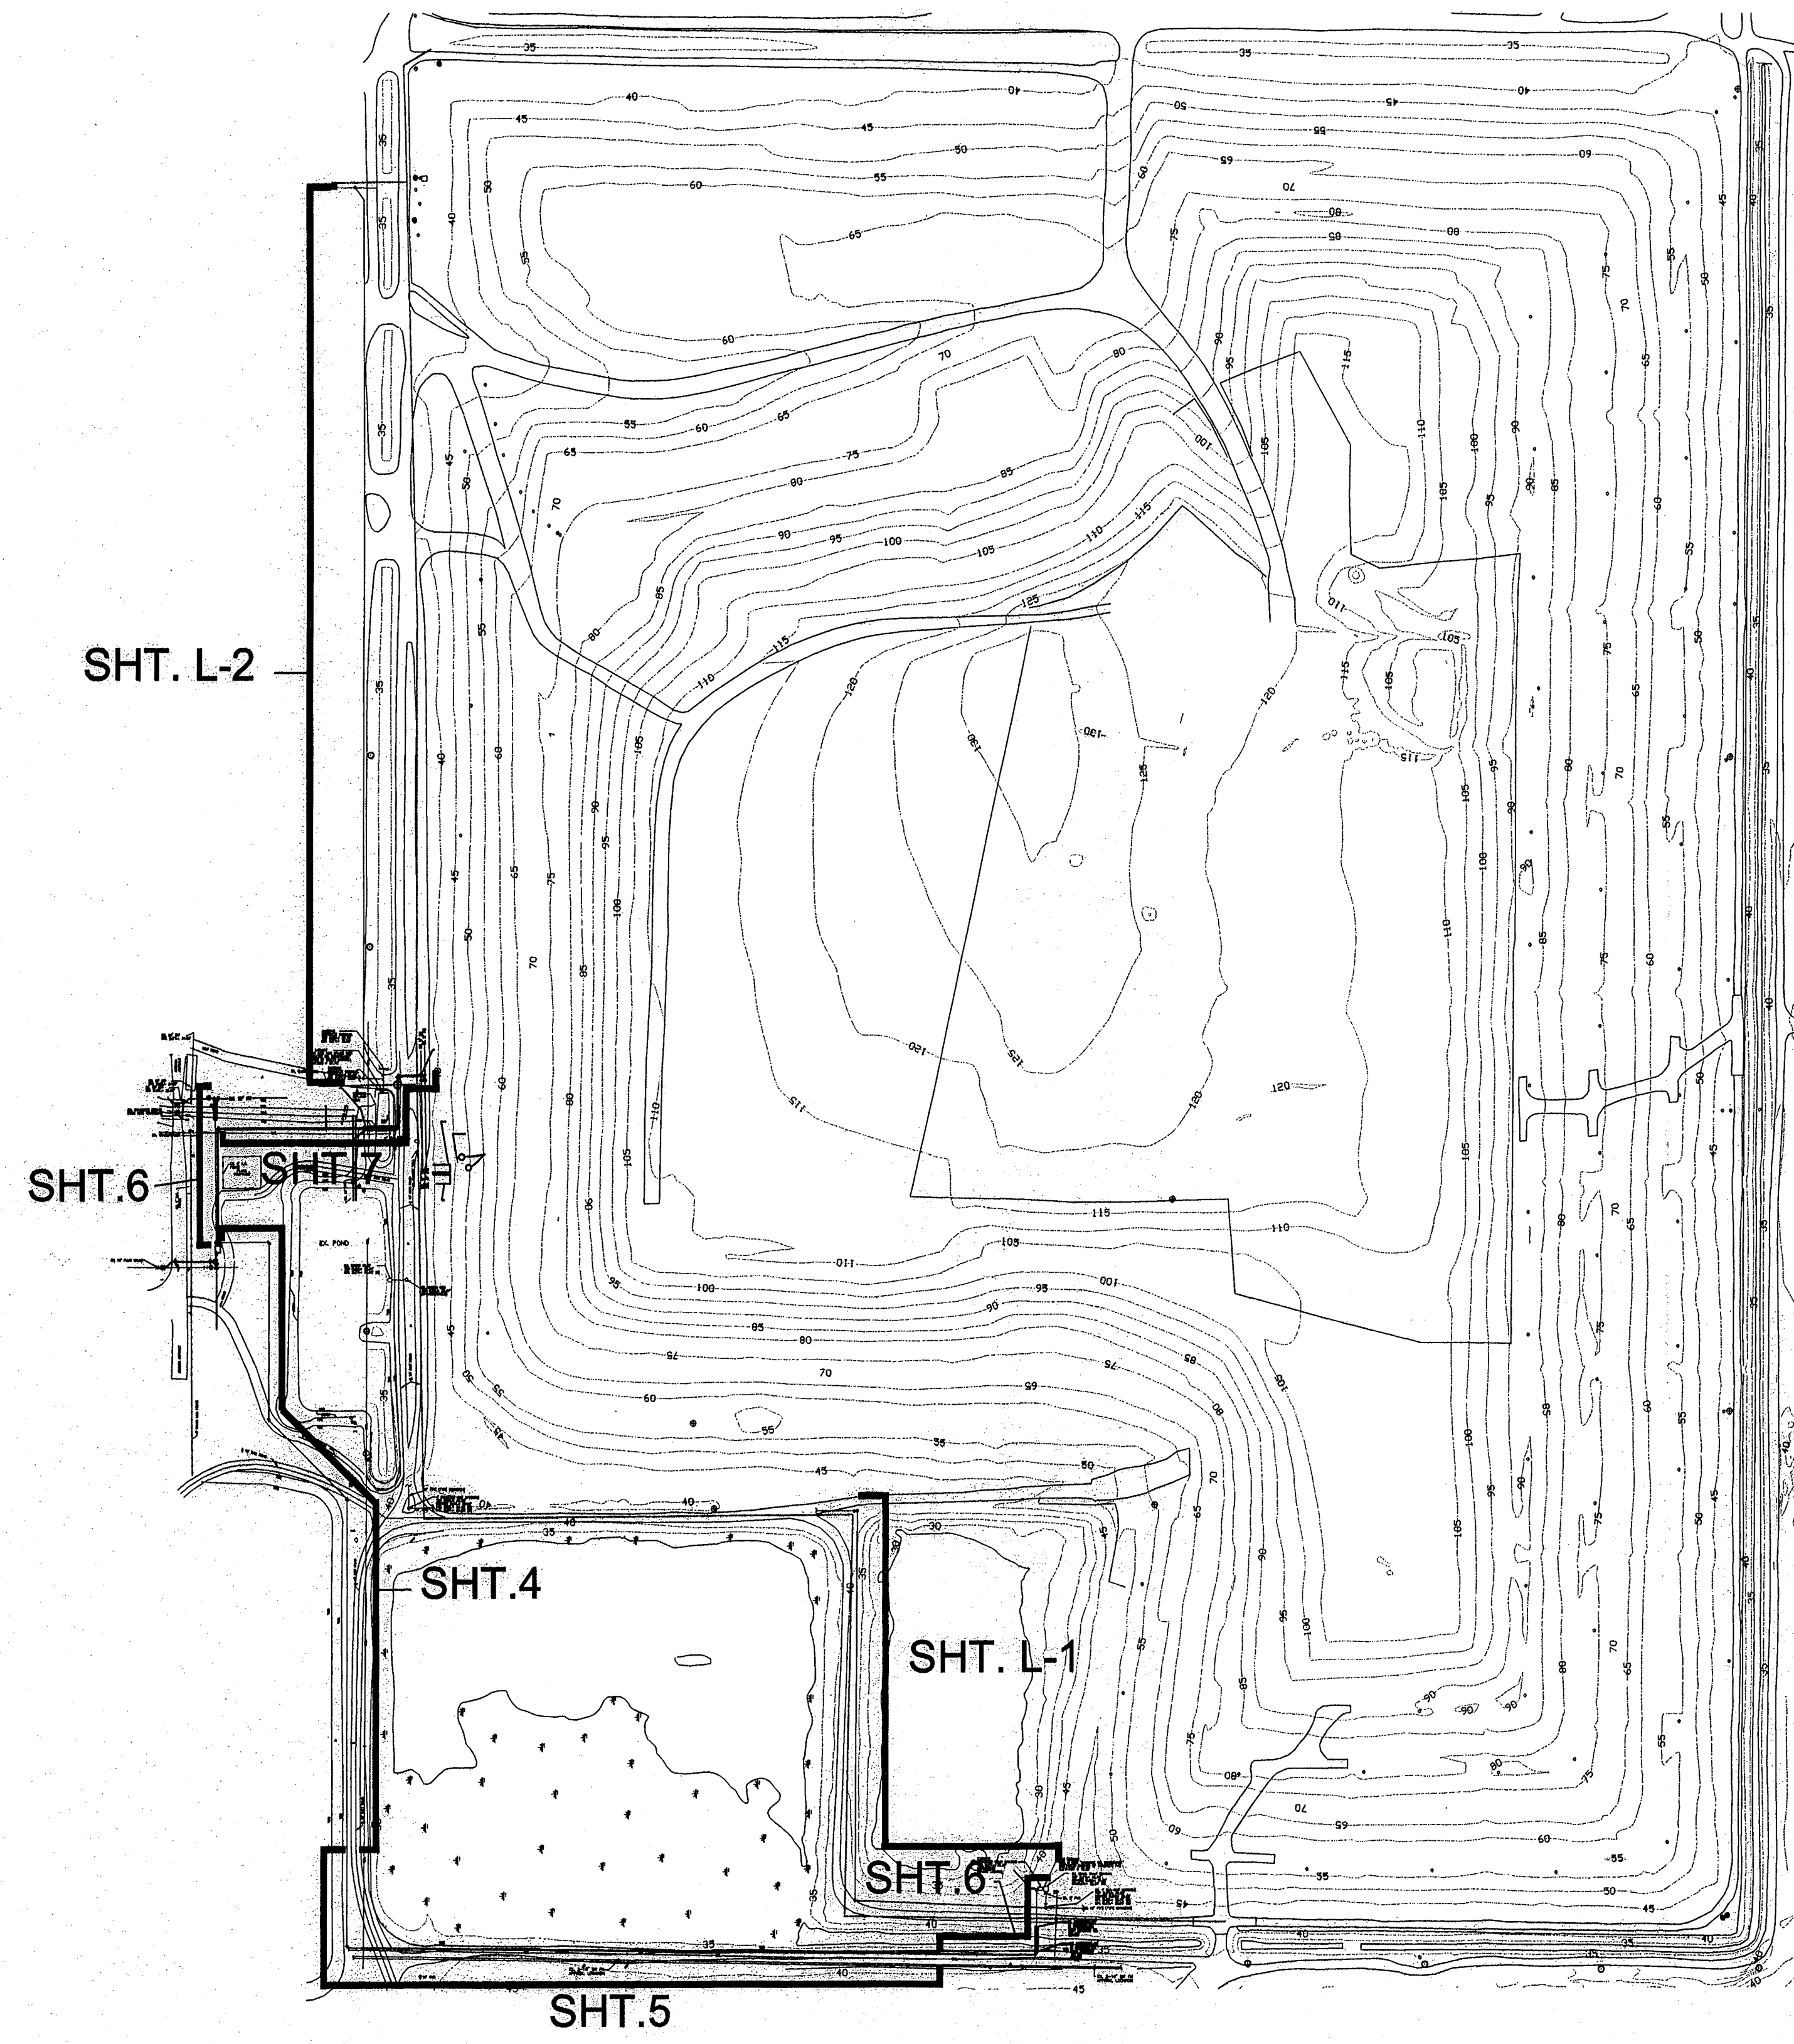

NORTH

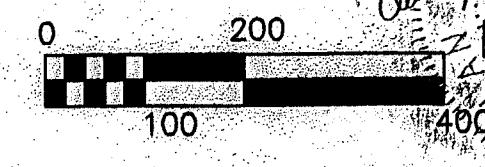


"RECORD DRAWING"
INCORPORATING THOSE CHANGES MADE
DURING CONSTRUCTION BASED ON DATA
FURNISHED BY THE CONTRACTOR TO THE
ENGINEER

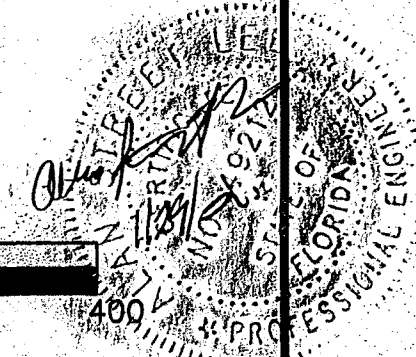

PBS&J
330 SOUTH PINEAPPLE AVE.
SUITE 113
SARASOTA, FLORIDA 34236
Ph. (941) 954-4036
PORT BUREAU, SOREN & JENSEN, INC. (PBJ&J) FIRM
2001 N.W. 107TH AVENUE, MIAMI, FL 33172-2667
FIRM CERTIFICATE OF AUTHORIZATION NO.24

CLIENT
**MANATEE COUNTY
PROJECT MANAGEMENT
DEPARTMENT**
**1026 26TH AVENUE EAST
BRADENTON, FLORIDA 34208**

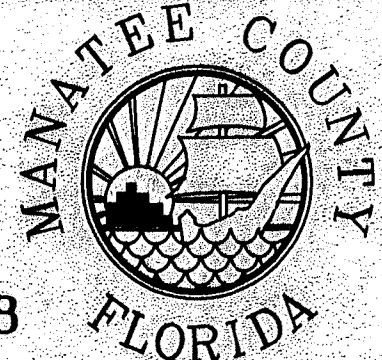

PROJECT
LENA ROAD LANDFILL LEACHATE POND FACILITIES



TASK
PROJECT KEY

ORIGINAL:
REVISIONS:
1 REC. DWG. JAN/02
2
3
4
5



6
7
8
9
10
11
12

NOT VALID FOR CONSTRUCTION
UNLESS SIGNED IN THIS BLOCK


JOB NO.	120498.02
DRAWN	MV
DESIGNED	JME
CHECKED	JME
QC	DBR
SHEET	3

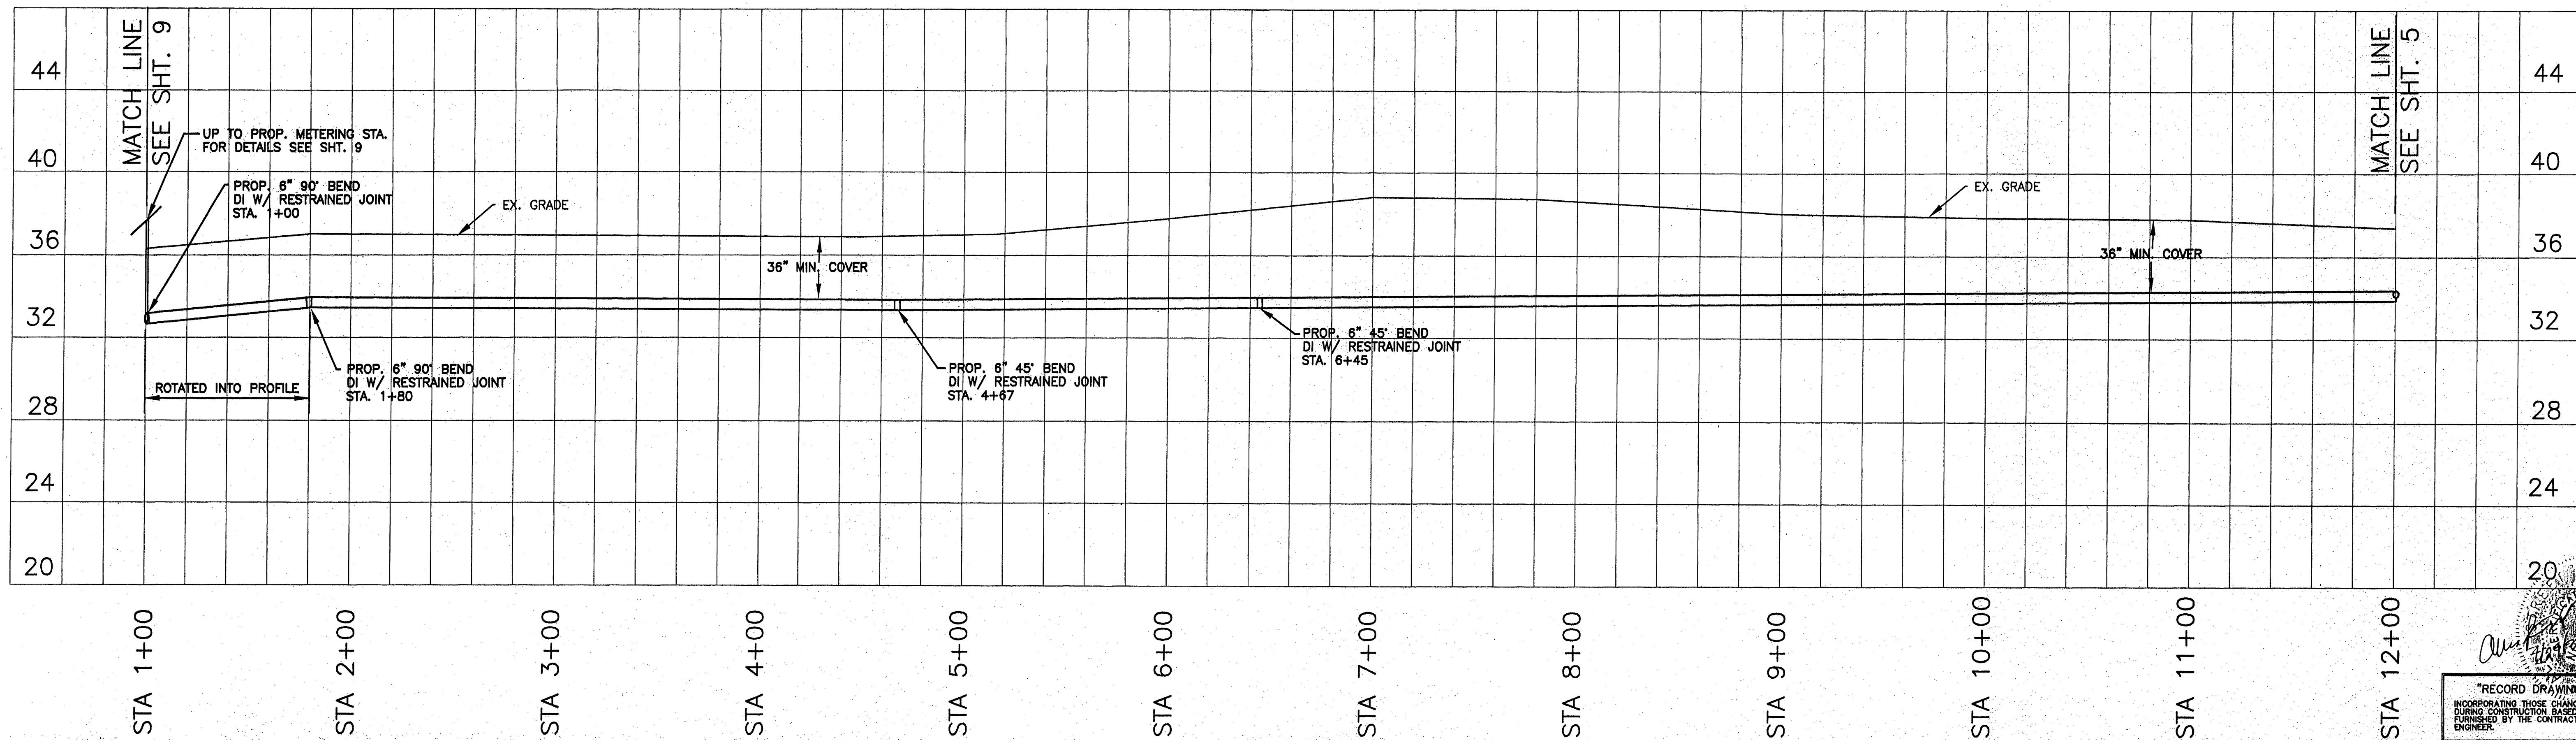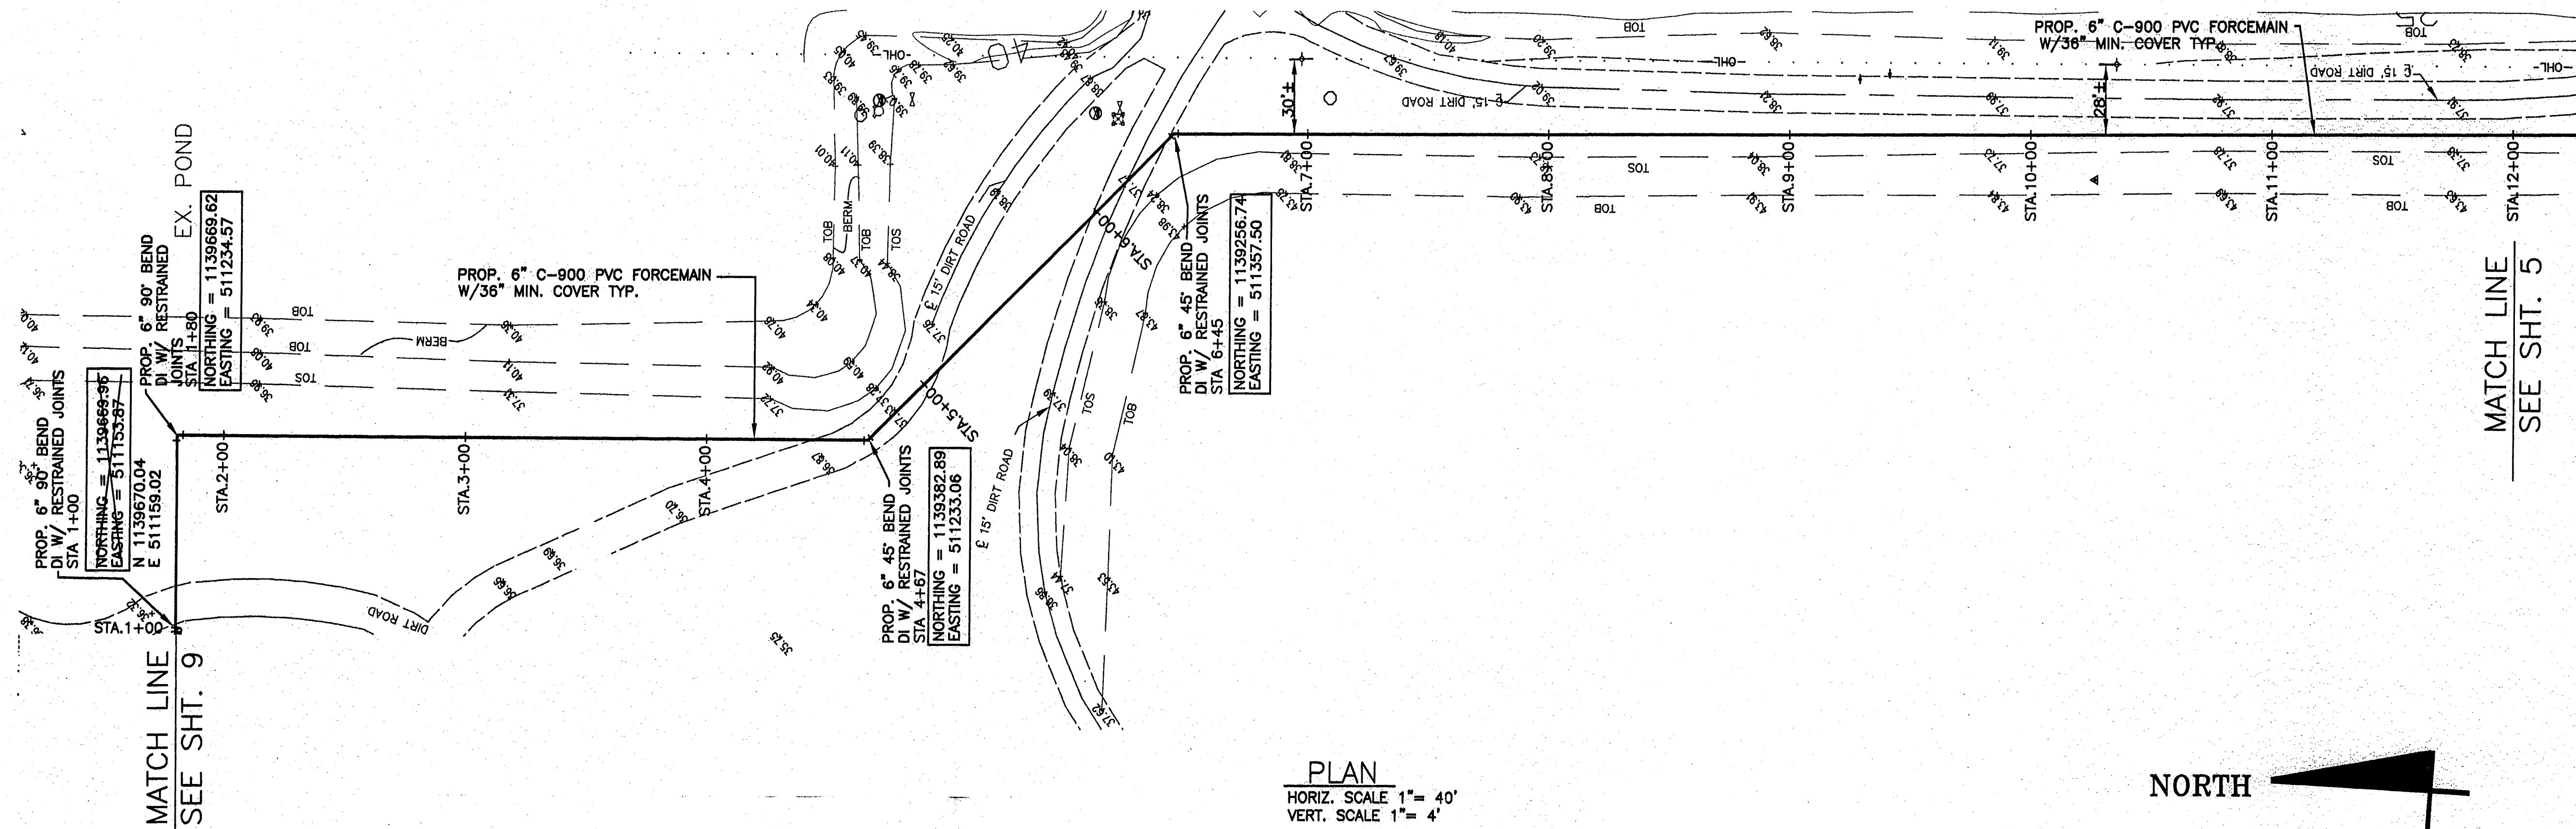


PBS& 330 SOUTH PINEAPPLE AVE. SUITE 113 SARASOTA, FLORIDA 34236 Ph. (941) 954-4038 FOR: SUDLEY, SCHMIDT & ASSOCIATES, INC. 500 N. MIAMI 2001 AVE. MIAMI BEACH, FL 33132-2507 FIRM LICENSE NO. 10000000000000000000	CLIENT MANATEE COUNTY PROJECT MANAGEMENT DEPARTMENT 1026 28TH AVENUE EAST BRADENTON, FLORIDA 34208		PROJECT	TASK	ORIGINAL:	6 _____ 7 _____ 8 _____ 9 _____ 10 _____ 11 _____ 12 _____	JOB NO. 120498.02 DRAWN MV DESIGNED JME CHECKED JME QC DBR
			LENA ROAD LANDFILL LEACHATE POND FACILITIES	PLAN AND PROFILE STA 1+00 TO 12+00	1 REC. DWG. JAN/02 2 _____ 3 _____ 4 _____ 5 _____		

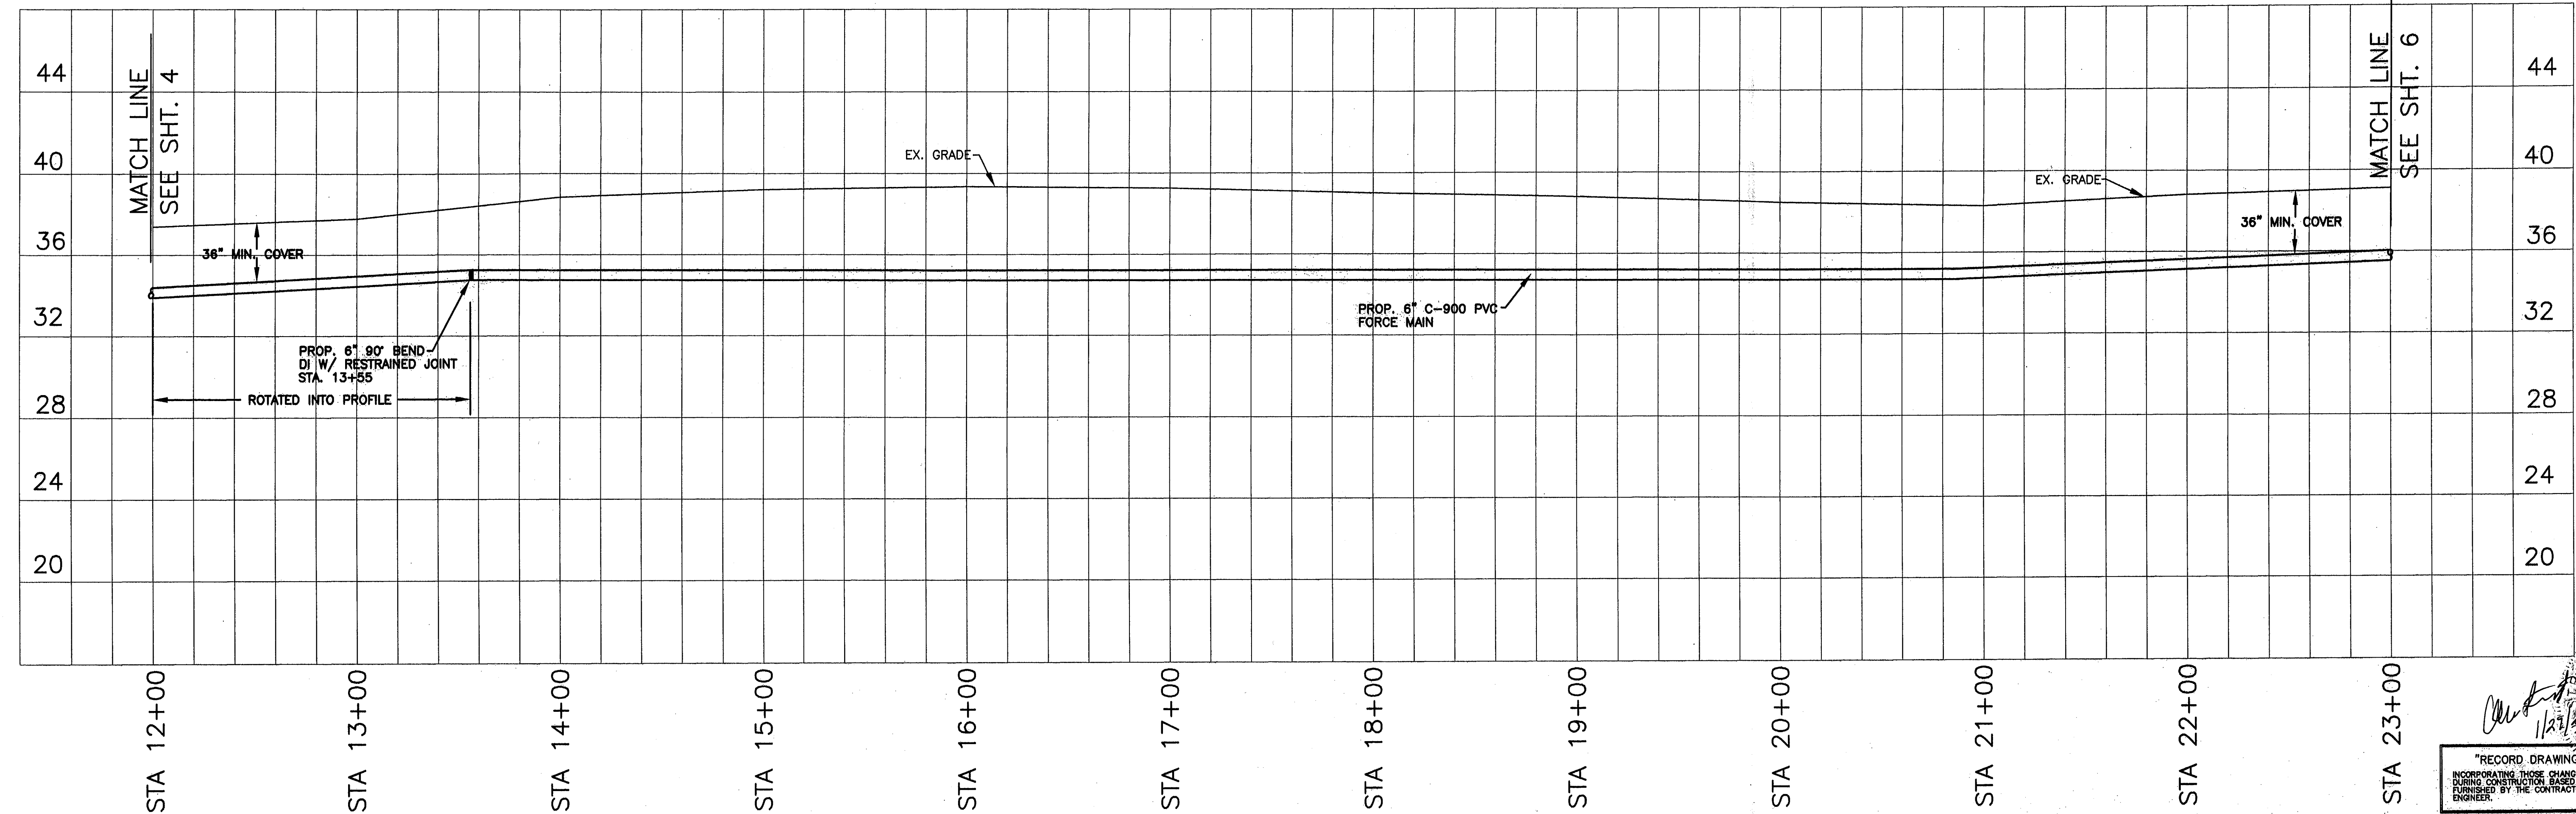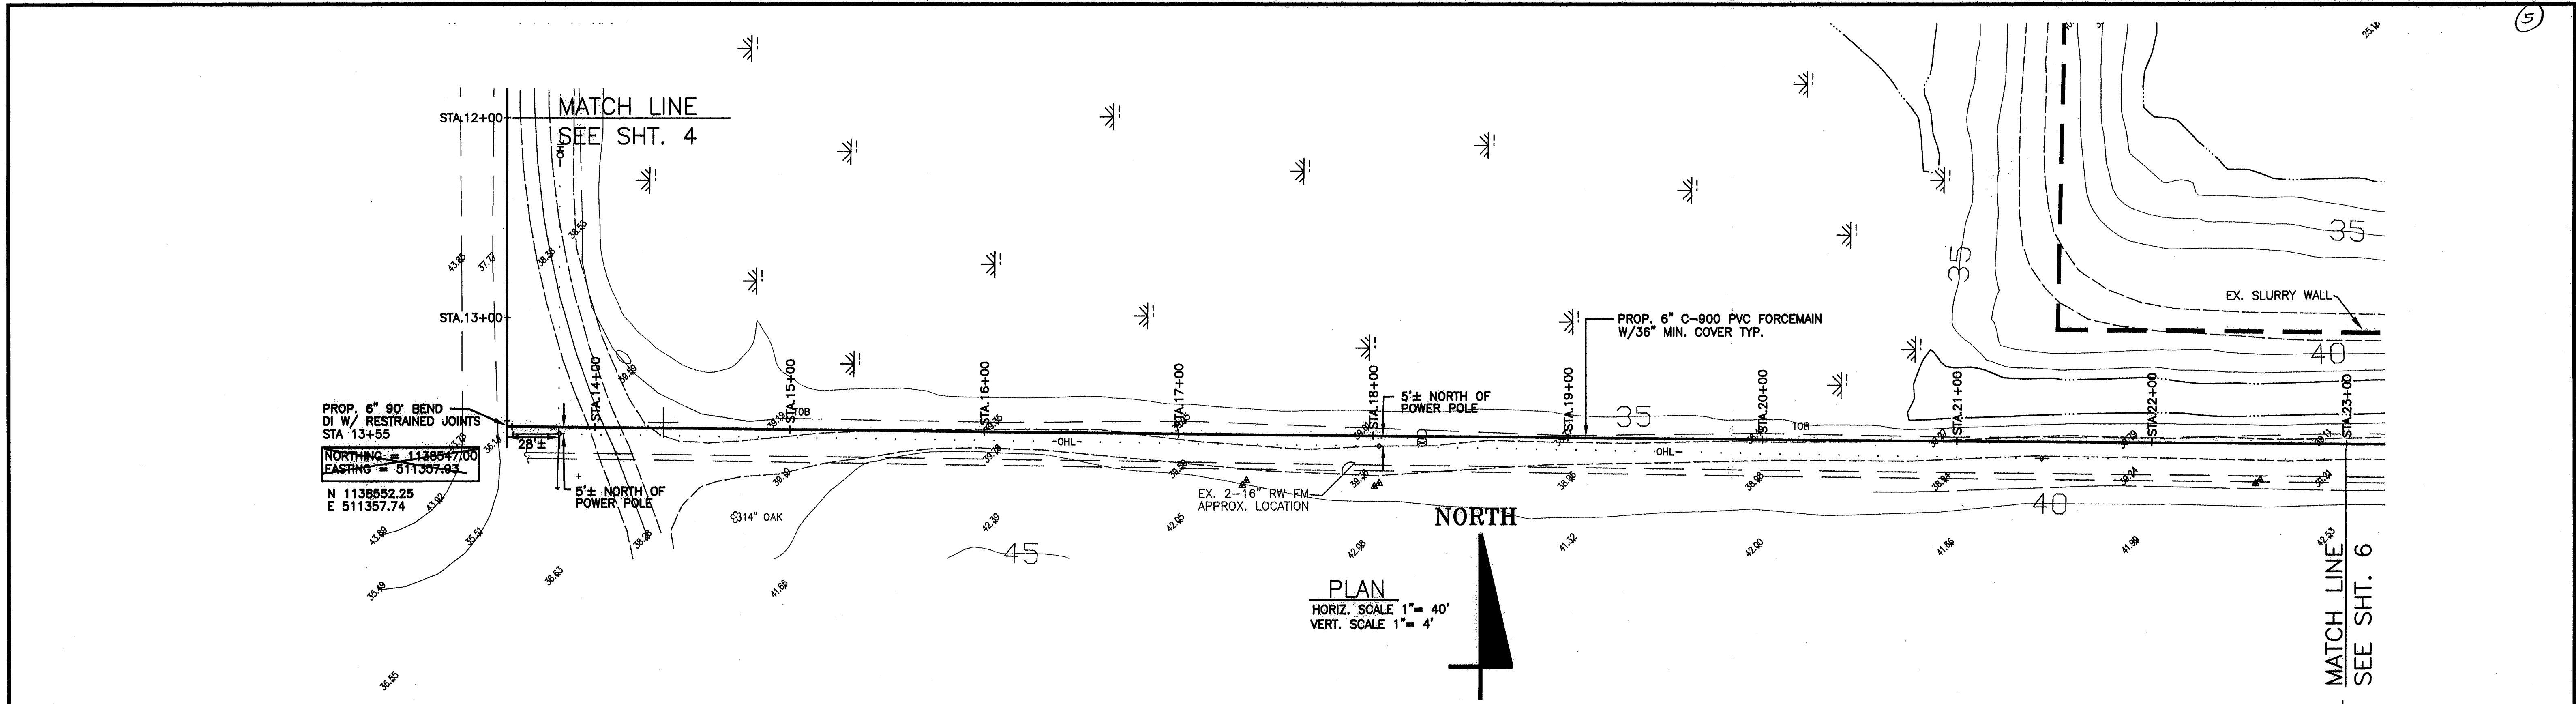



330 SOUTH PINEAPPLE AVE. SUITE 113 SARASOTA, FLORIDA 34236 Ph. (941) 954-4036	CLIENT MANATEE COUNTY PROJECT MANAGEMENT DEPARTMENT 1026 26TH AVENUE EAST BRADENTON, FLORIDA 34208		PROJECT	TASK	ORIGINAL:	6 _____ 7 _____ 8 _____ 9 _____ 10 _____ 11 _____ 12 _____	JOB NO. 120498.02 DRAWN MV DESIGNED JME CHECKED JME QC DBR
			LENA ROAD LANDFILL LEACHATE POND FACILITIES	PLAN AND PROFILE STA 12+00 TO 23+00	REVISIONS: 1 REC. DWG JAN/02 2 _____ 3 _____ 4 _____ 5 _____		

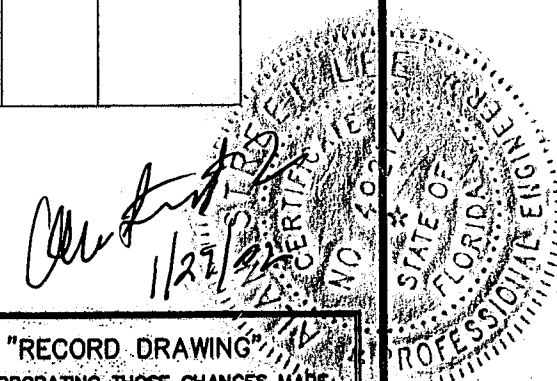

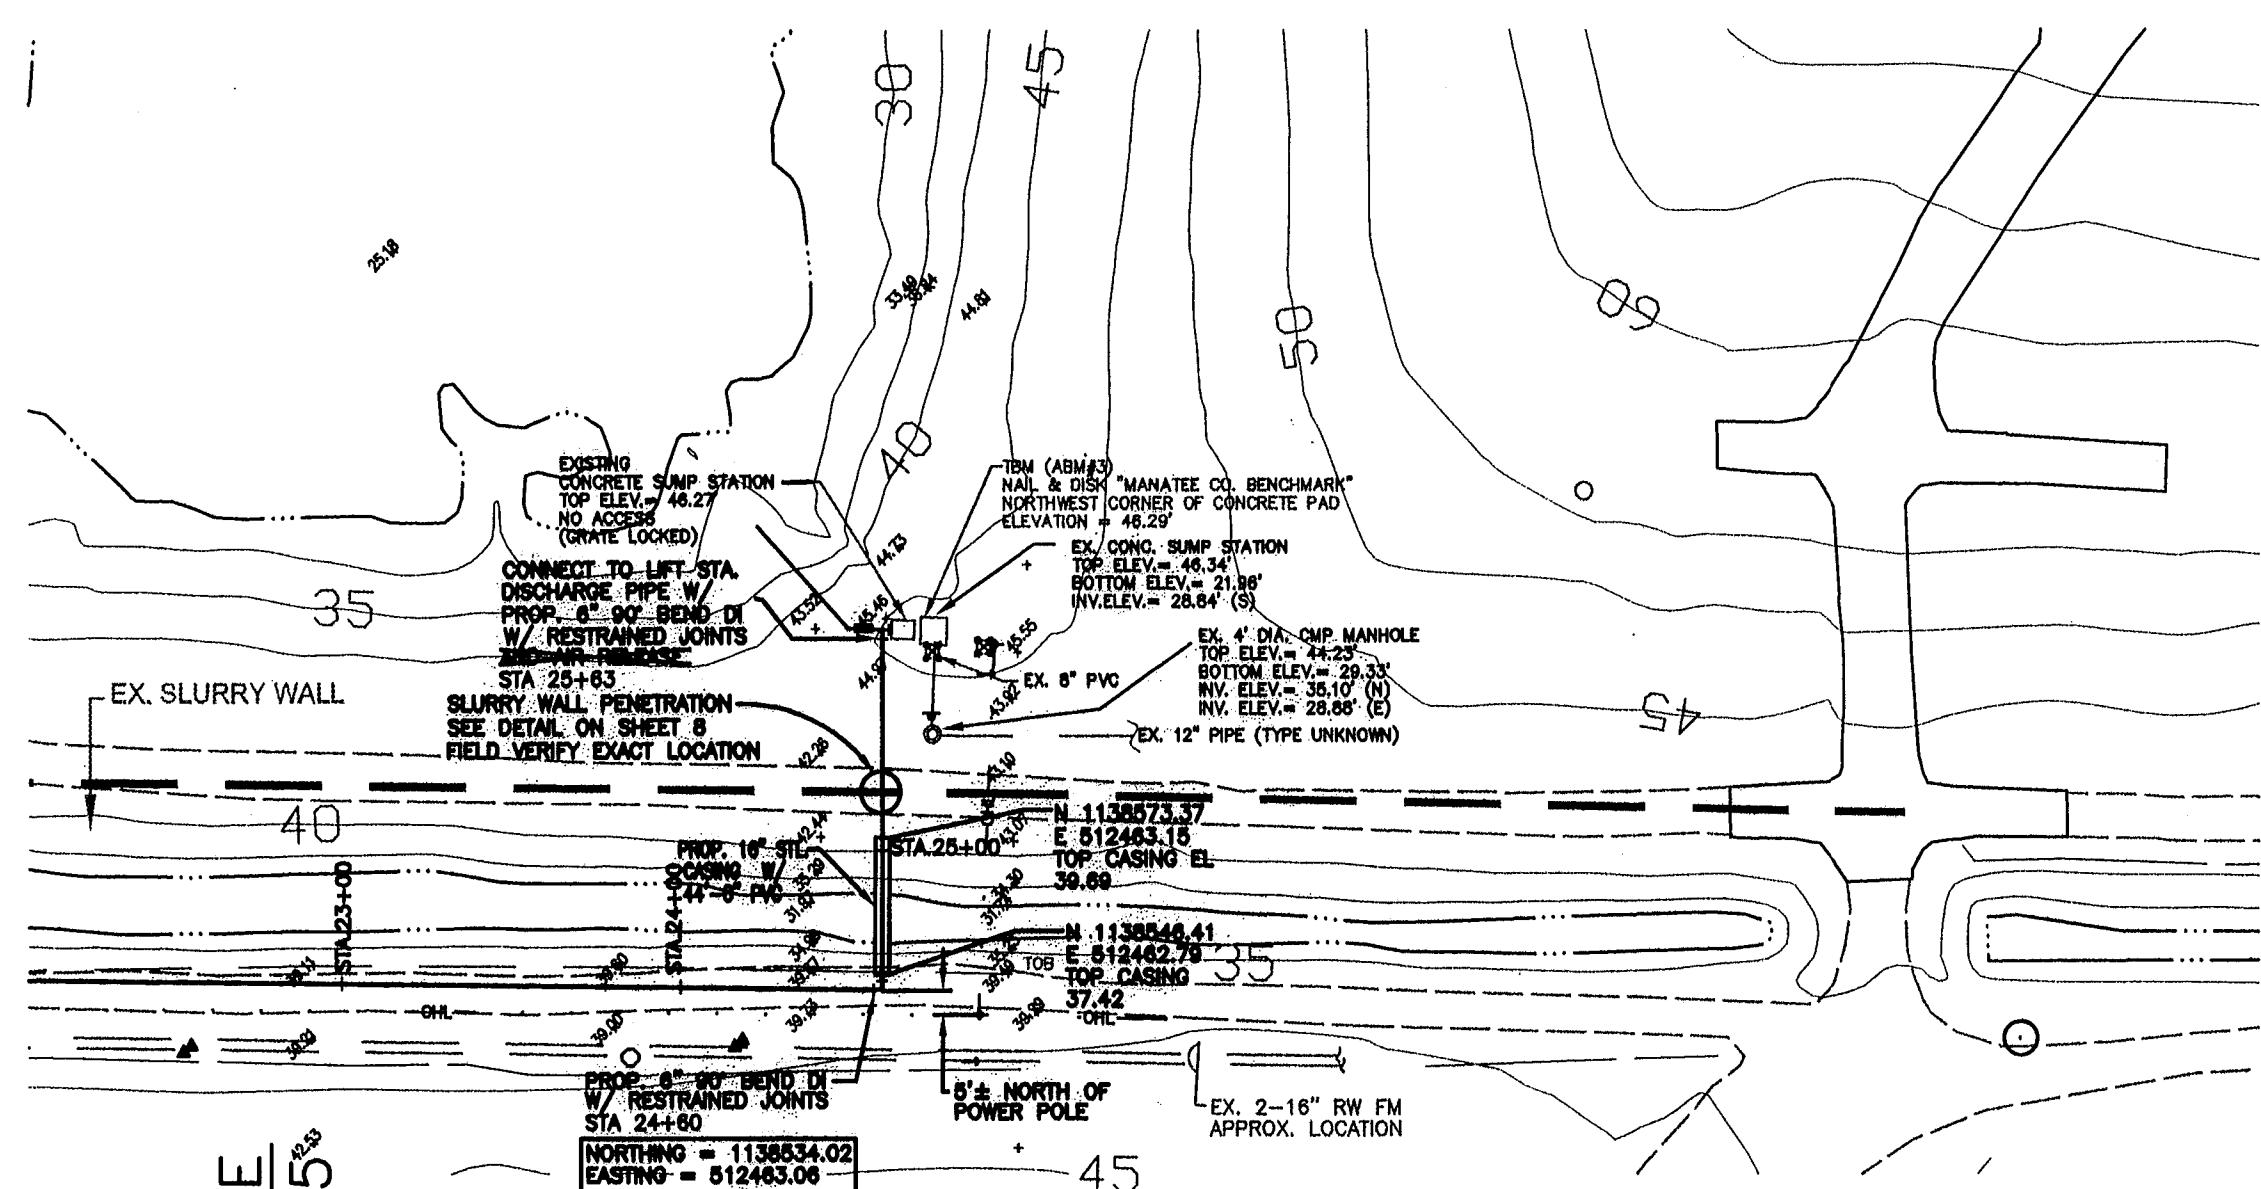

MATCH LINE
SEE SHT. 5

PLAN
HORIZ. SCALE 1"= 40'
VERT. SCALE 1"= 4'

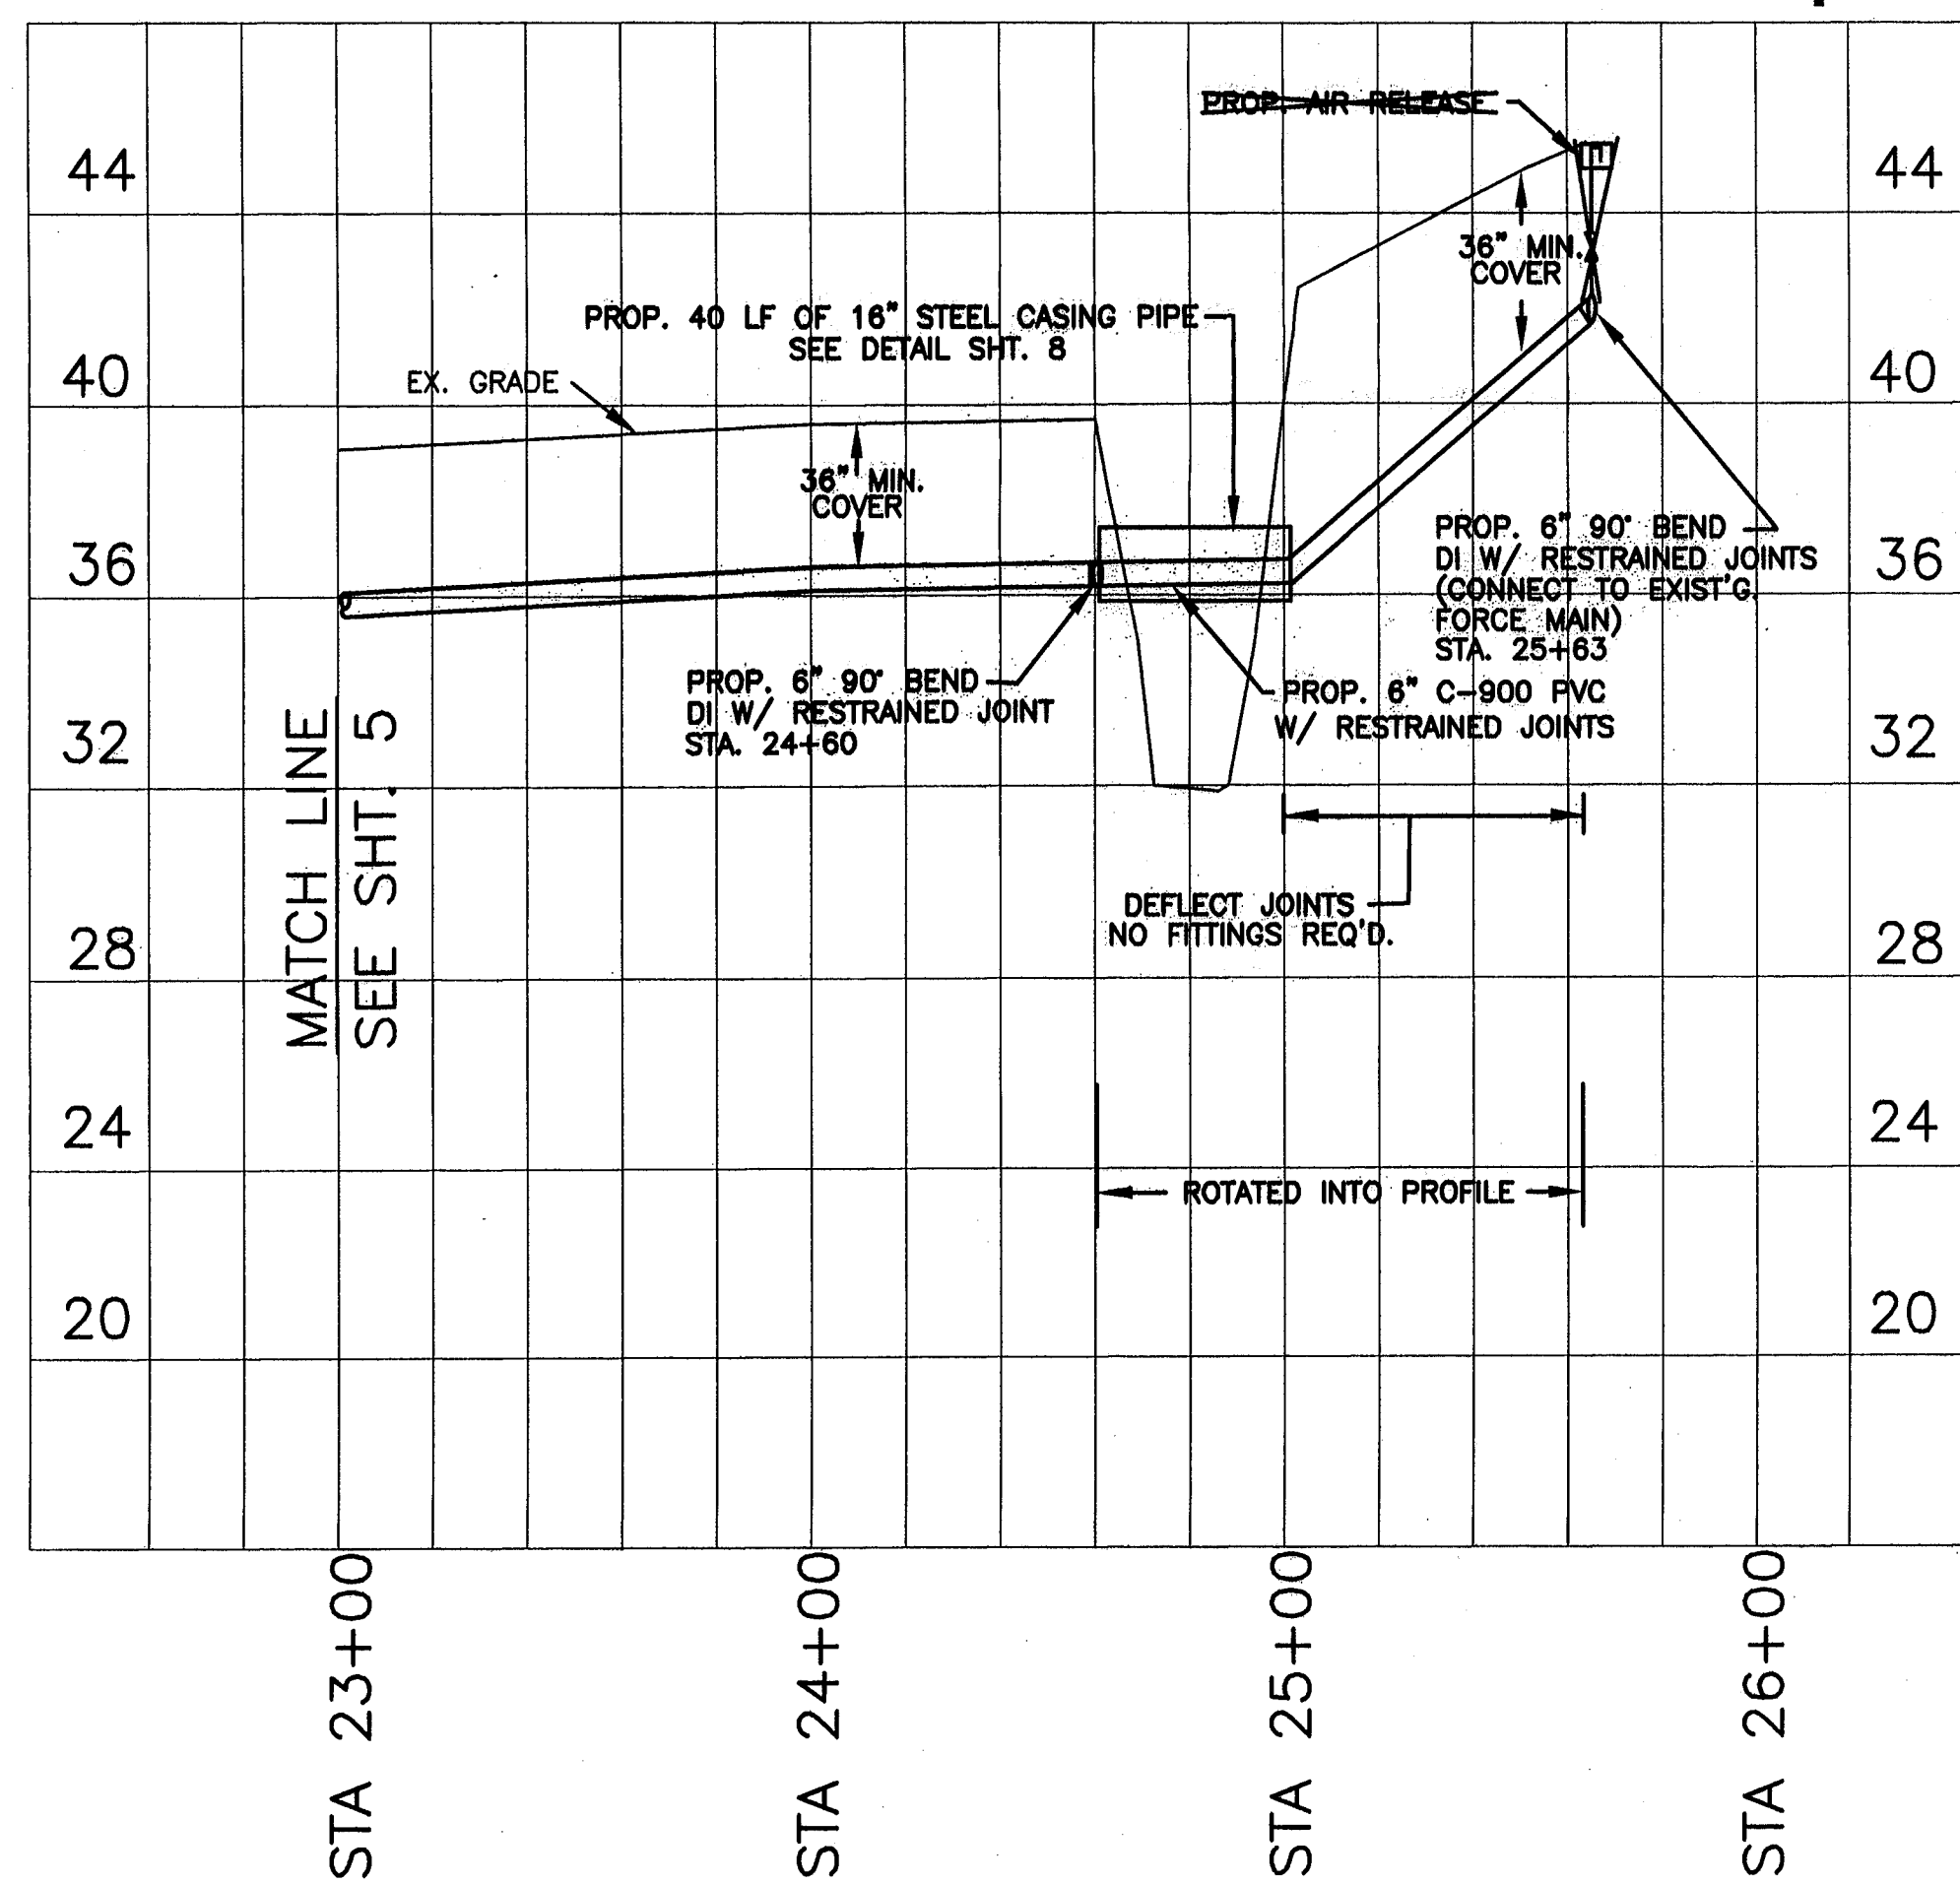
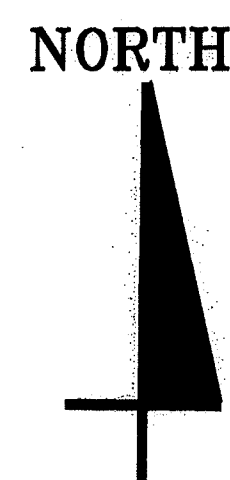


MATCH LINE
SEE SHT. 5

DEFLECT JOINTS
NO FITTINGS REQ'D.


ROTATED INTO PROFILE

NORTH END N 1139899.37, E 511152.92
TOP CASING EL 35.29
SOUTH END N 1139870.60, E 511150.98
TOP CASING EL 34.01

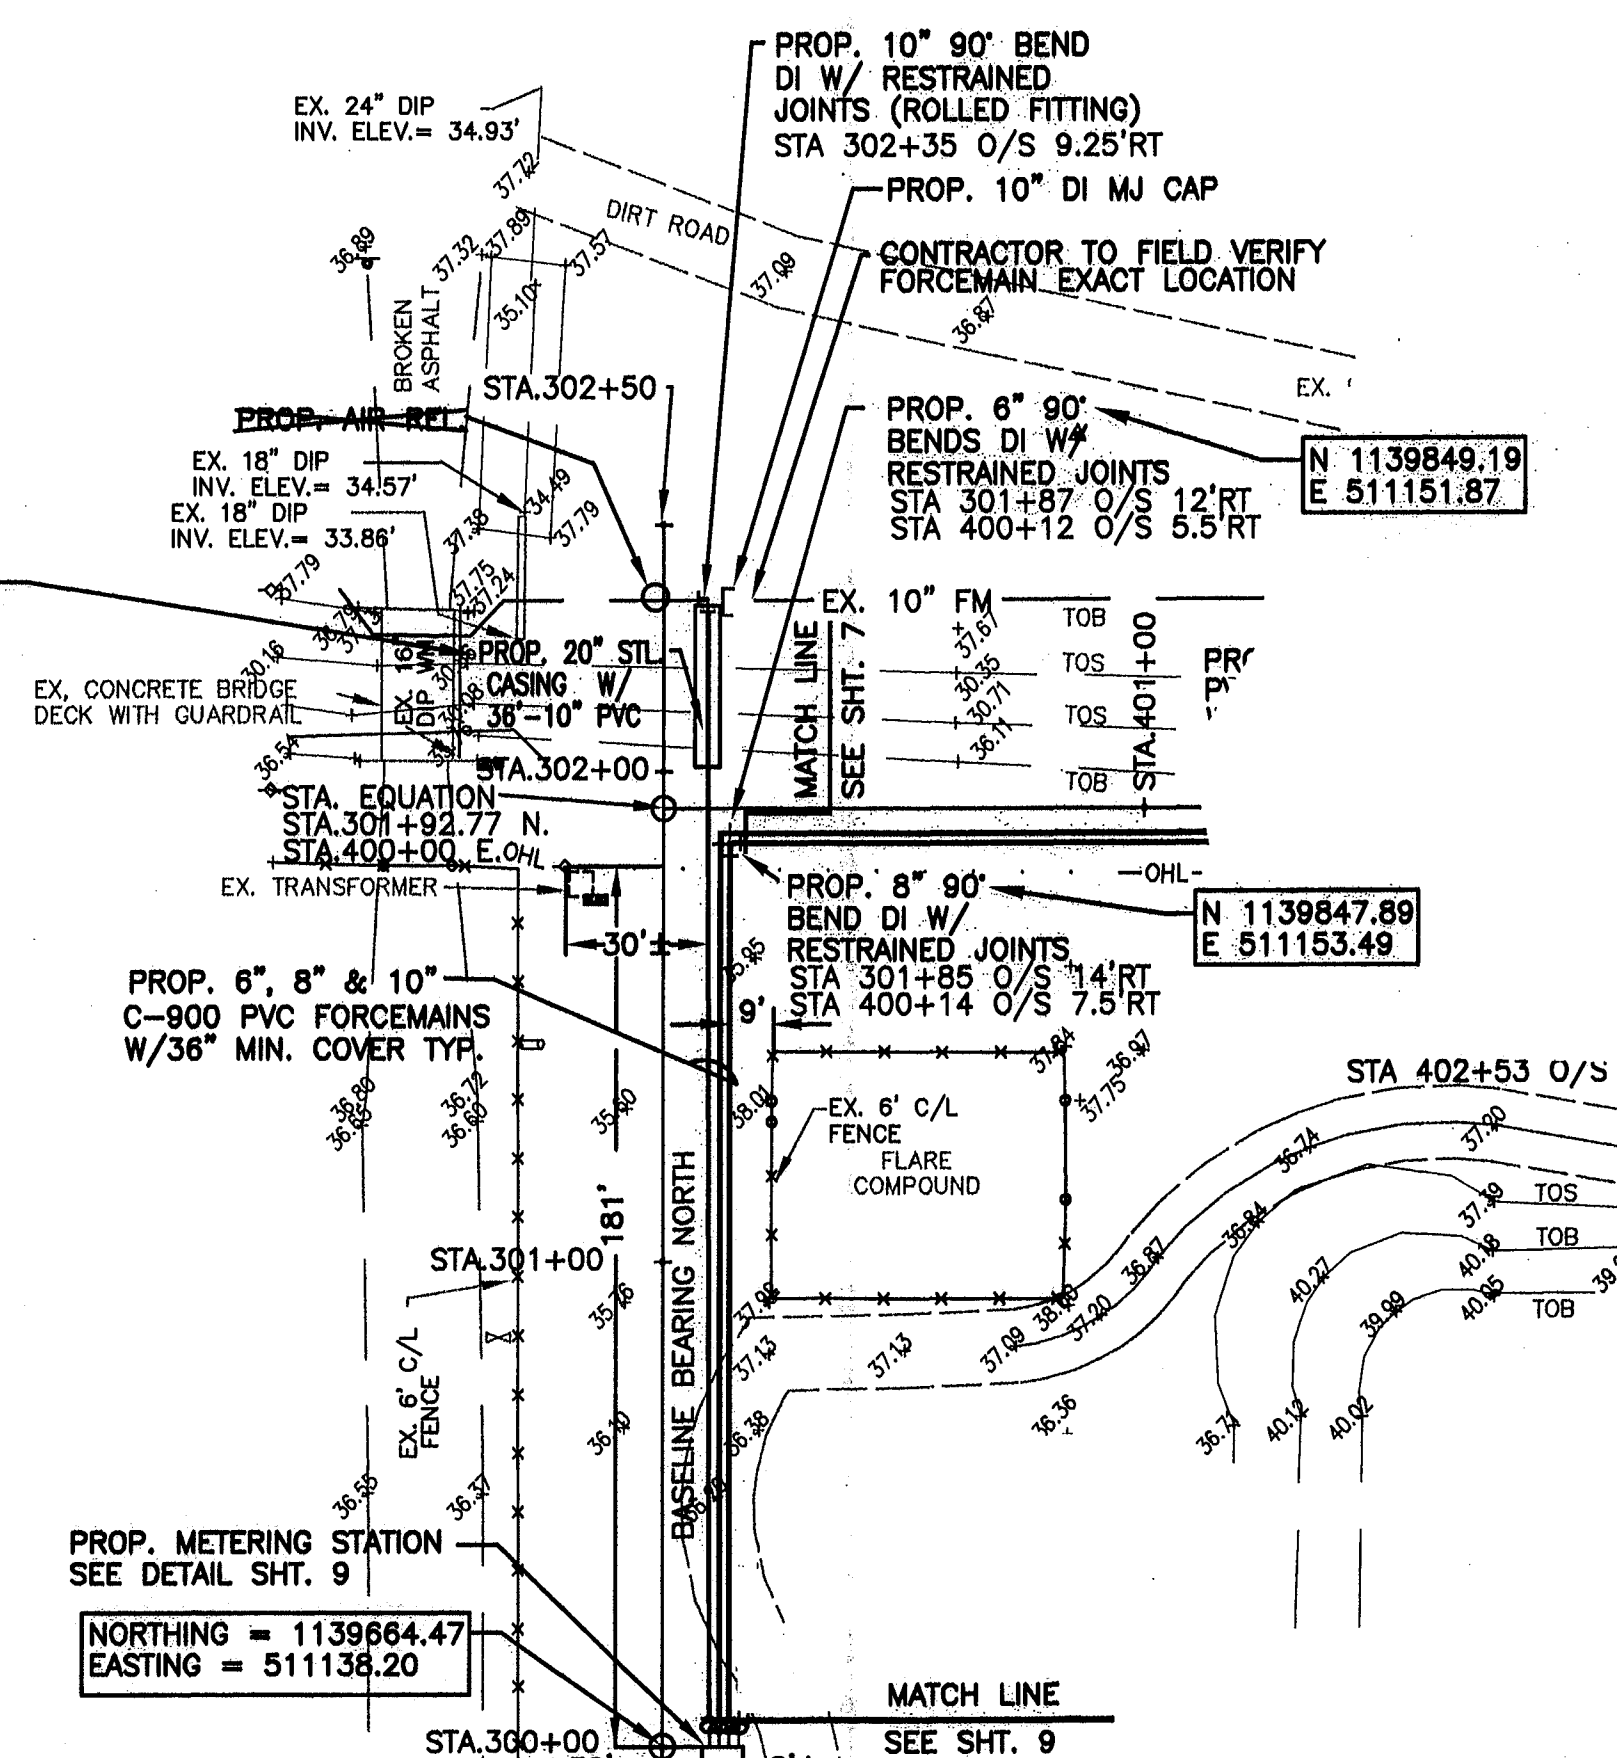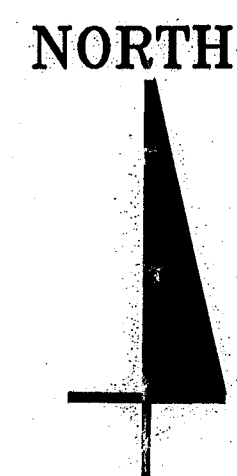

NORTHING = 1139864.47
EASTING = 511138.20

PLAN
HORIZ. SCALE 1"= 40'
VERT. SCALE 1"= 4'

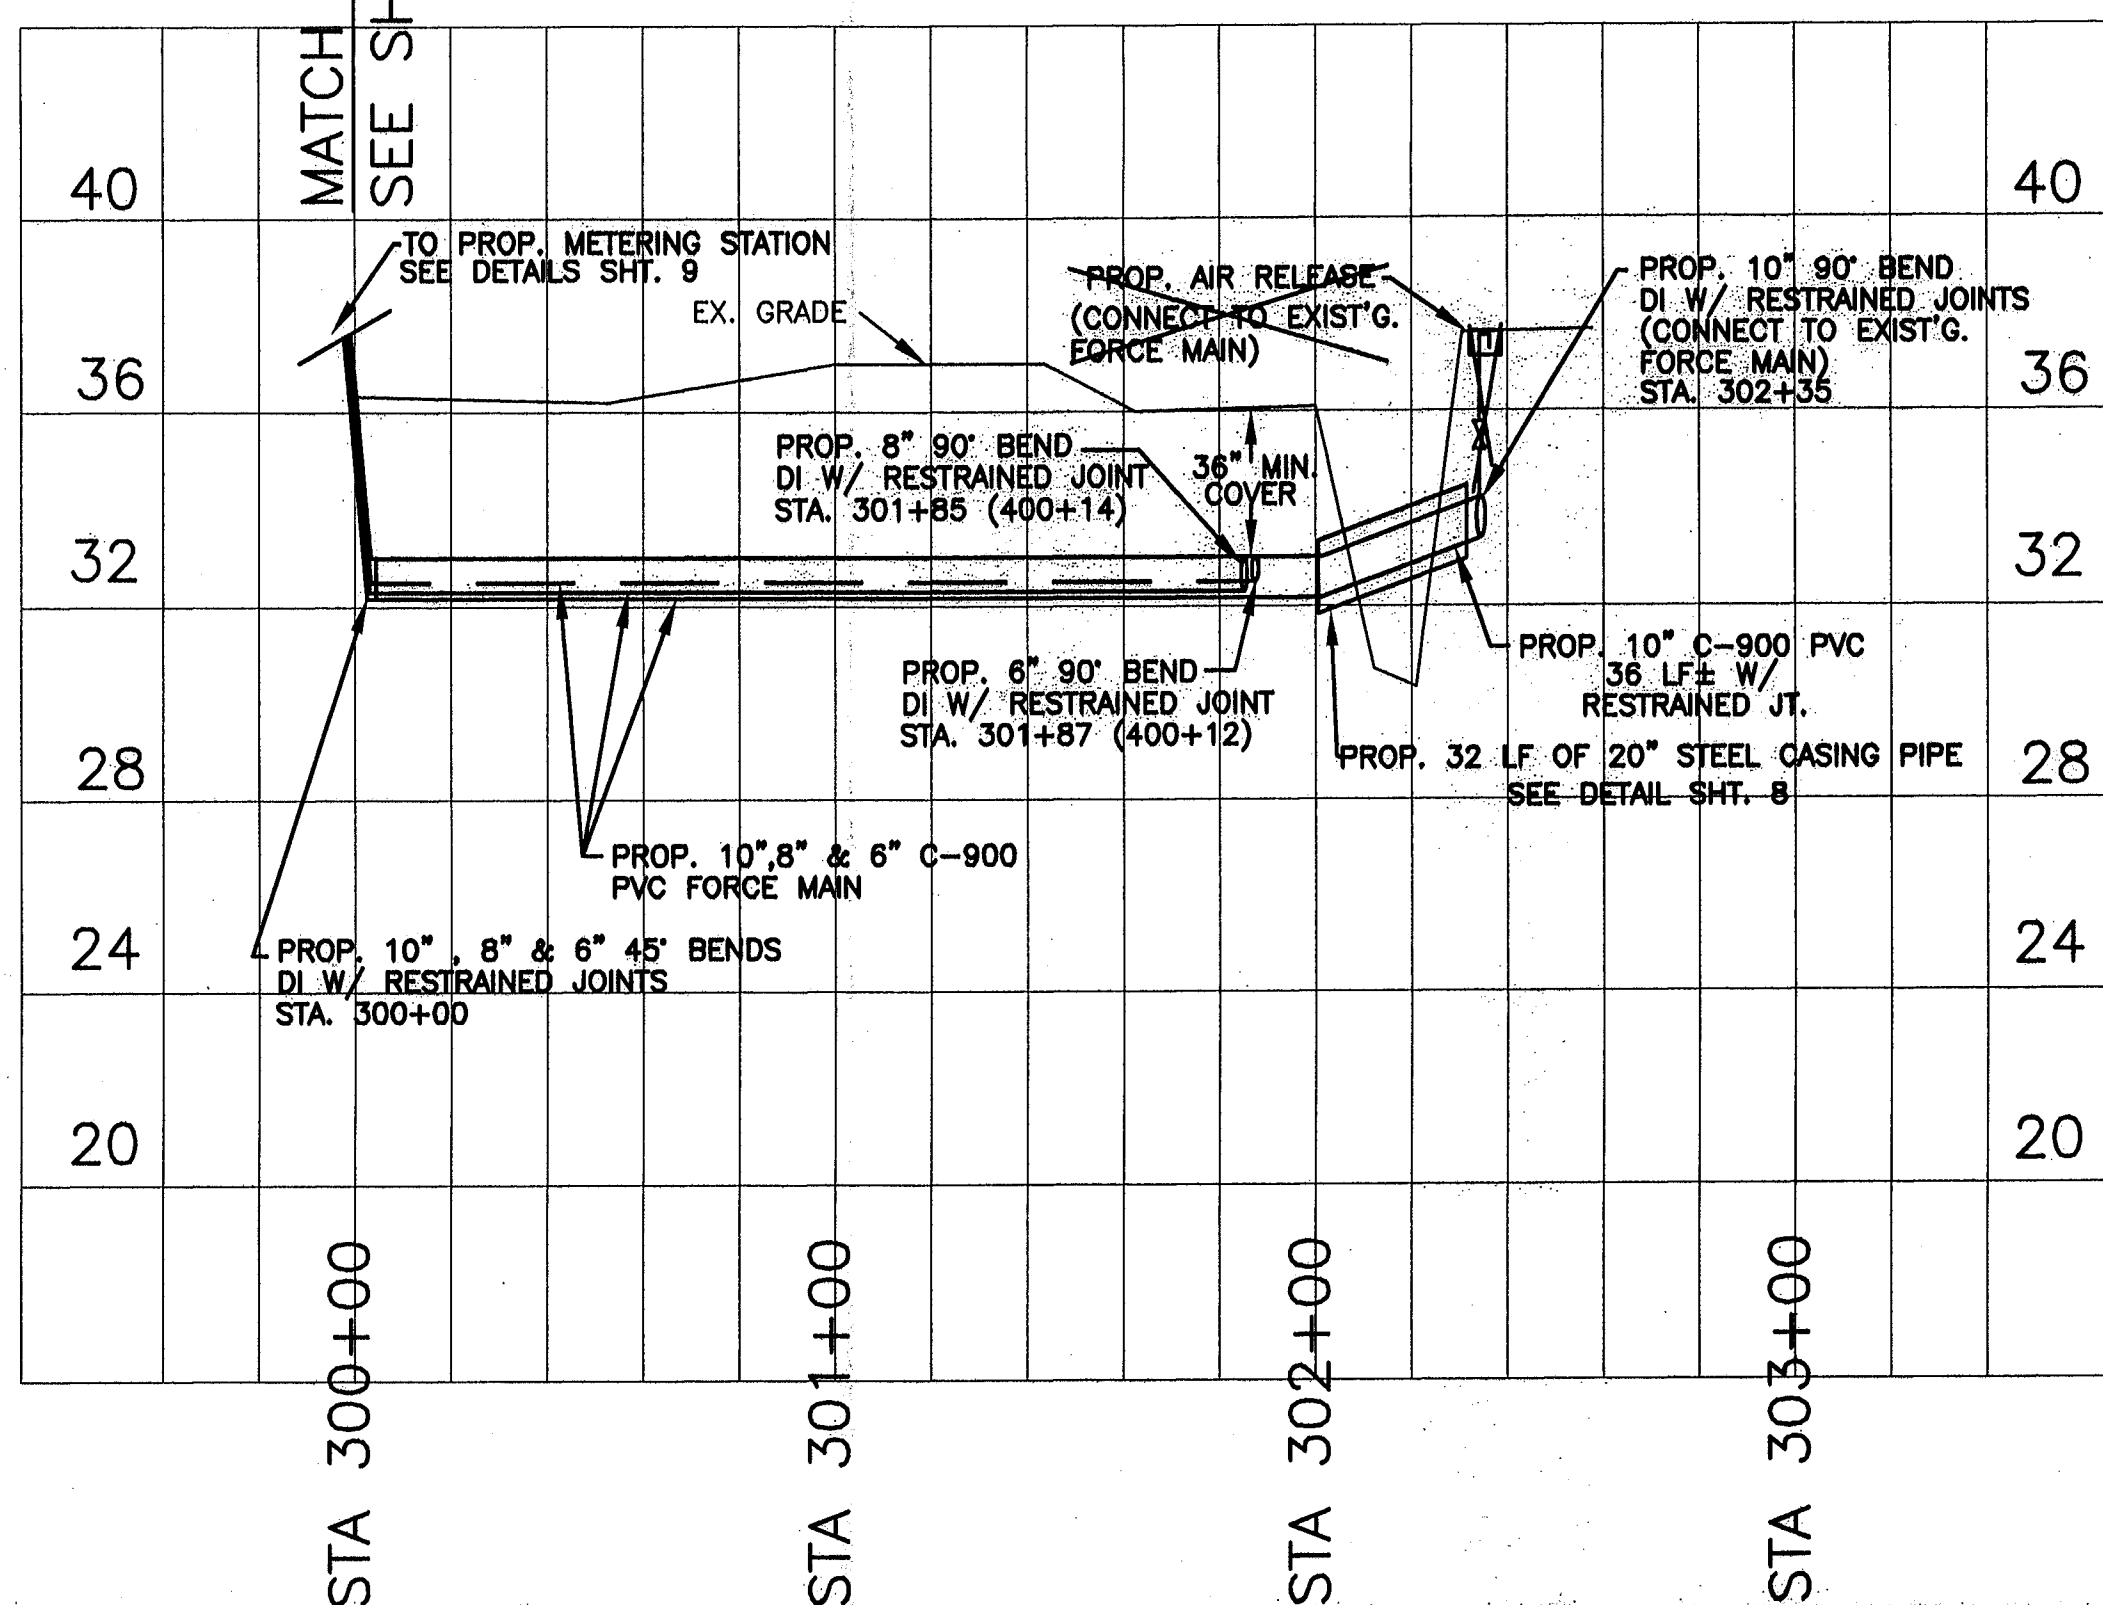

MATCH LINE
SEE SHT. 9

TO PROP. METERING STATION
SEE DETAILS SHT. 9

EX. GRADE

PROP. AIR RELEASE
(CONNECT TO EXIST'G.
FORCE MAIN)

PROP. 10" 90° BEND
DI W/ RESTRAINED JOINTS
(CONNECT TO EXIST'G.
FORCE MAIN)
STA. 302+35

PROP. 8" 90° BEND
DI W/ RESTRAINED JOINT
STA. 301+85 (400+14)

36" MIN. COVER

PROP. 6" 90° BEND
DI W/ RESTRAINED JOINT
STA. 301+87 (400+12)

PROP. 10" 8" & 6" C-900
PVC FORCE MAIN

PROP. 10" 8" & 6" 45° BENDS
DI W/ RESTRAINED JOINTS
STA. 300+00


PROP. 10" C-900 PVC
36" LF W/
RESTRAINED JT.
SEE DETAIL SHT. 8

PROP. 32' LF OF 20" STEEL CASING PIPE
SEE DETAIL SHT. 8

"RECORD DRAWING"
INCORPORATING THOSE CHANGES MADE
DURING CONSTRUCTION BASED ON DATA
FURNISHED BY THE CONTRACTOR TO THE
ENGINEER.

PBS&
330 SOUTH PINEAPPLE AVE.
SUITE 113
SARASOTA, FLORIDA 34236
Ph. (941) 854-4036
FOR: BUREAU OF SANITATION, INC. (BOSAN)
1001 E. TERRY AVE., SUITE 110, SARASOTA, FL 34236
FIRM CERTIFICATE OF AUTHORIZATION NO. 124

CLIENT
**MANATEE COUNTY
PROJECT MANAGEMENT
DEPARTMENT**
1026 26TH AVENUE EAST
BRADENTON, FLORIDA 34208

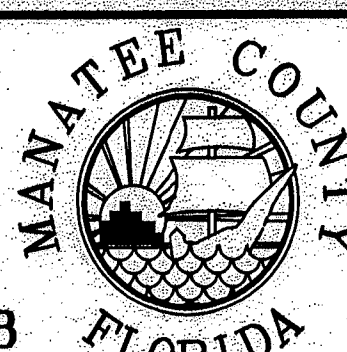

PROJECT
**LENA ROAD LANDFILL LEACHATE
POND FACILITIES**


TASK
**PLAN AND PROFILES
STA 23+00 TO 25+63
STA 300+00 TO 302+35**

ORIGINAL:
REVISIONS:
1 REC. DWG. JAN/02:
2
3
4
5


6
7
8
9
10
11
12

NOT VALID FOR CONSTRUCTION
UNLESS SIGNED IN THIS BLOCK

JOB NO. 120498.02
DRAWN MV
DESIGNED JME
CHECKED JME
QC DBR
SHEET 6

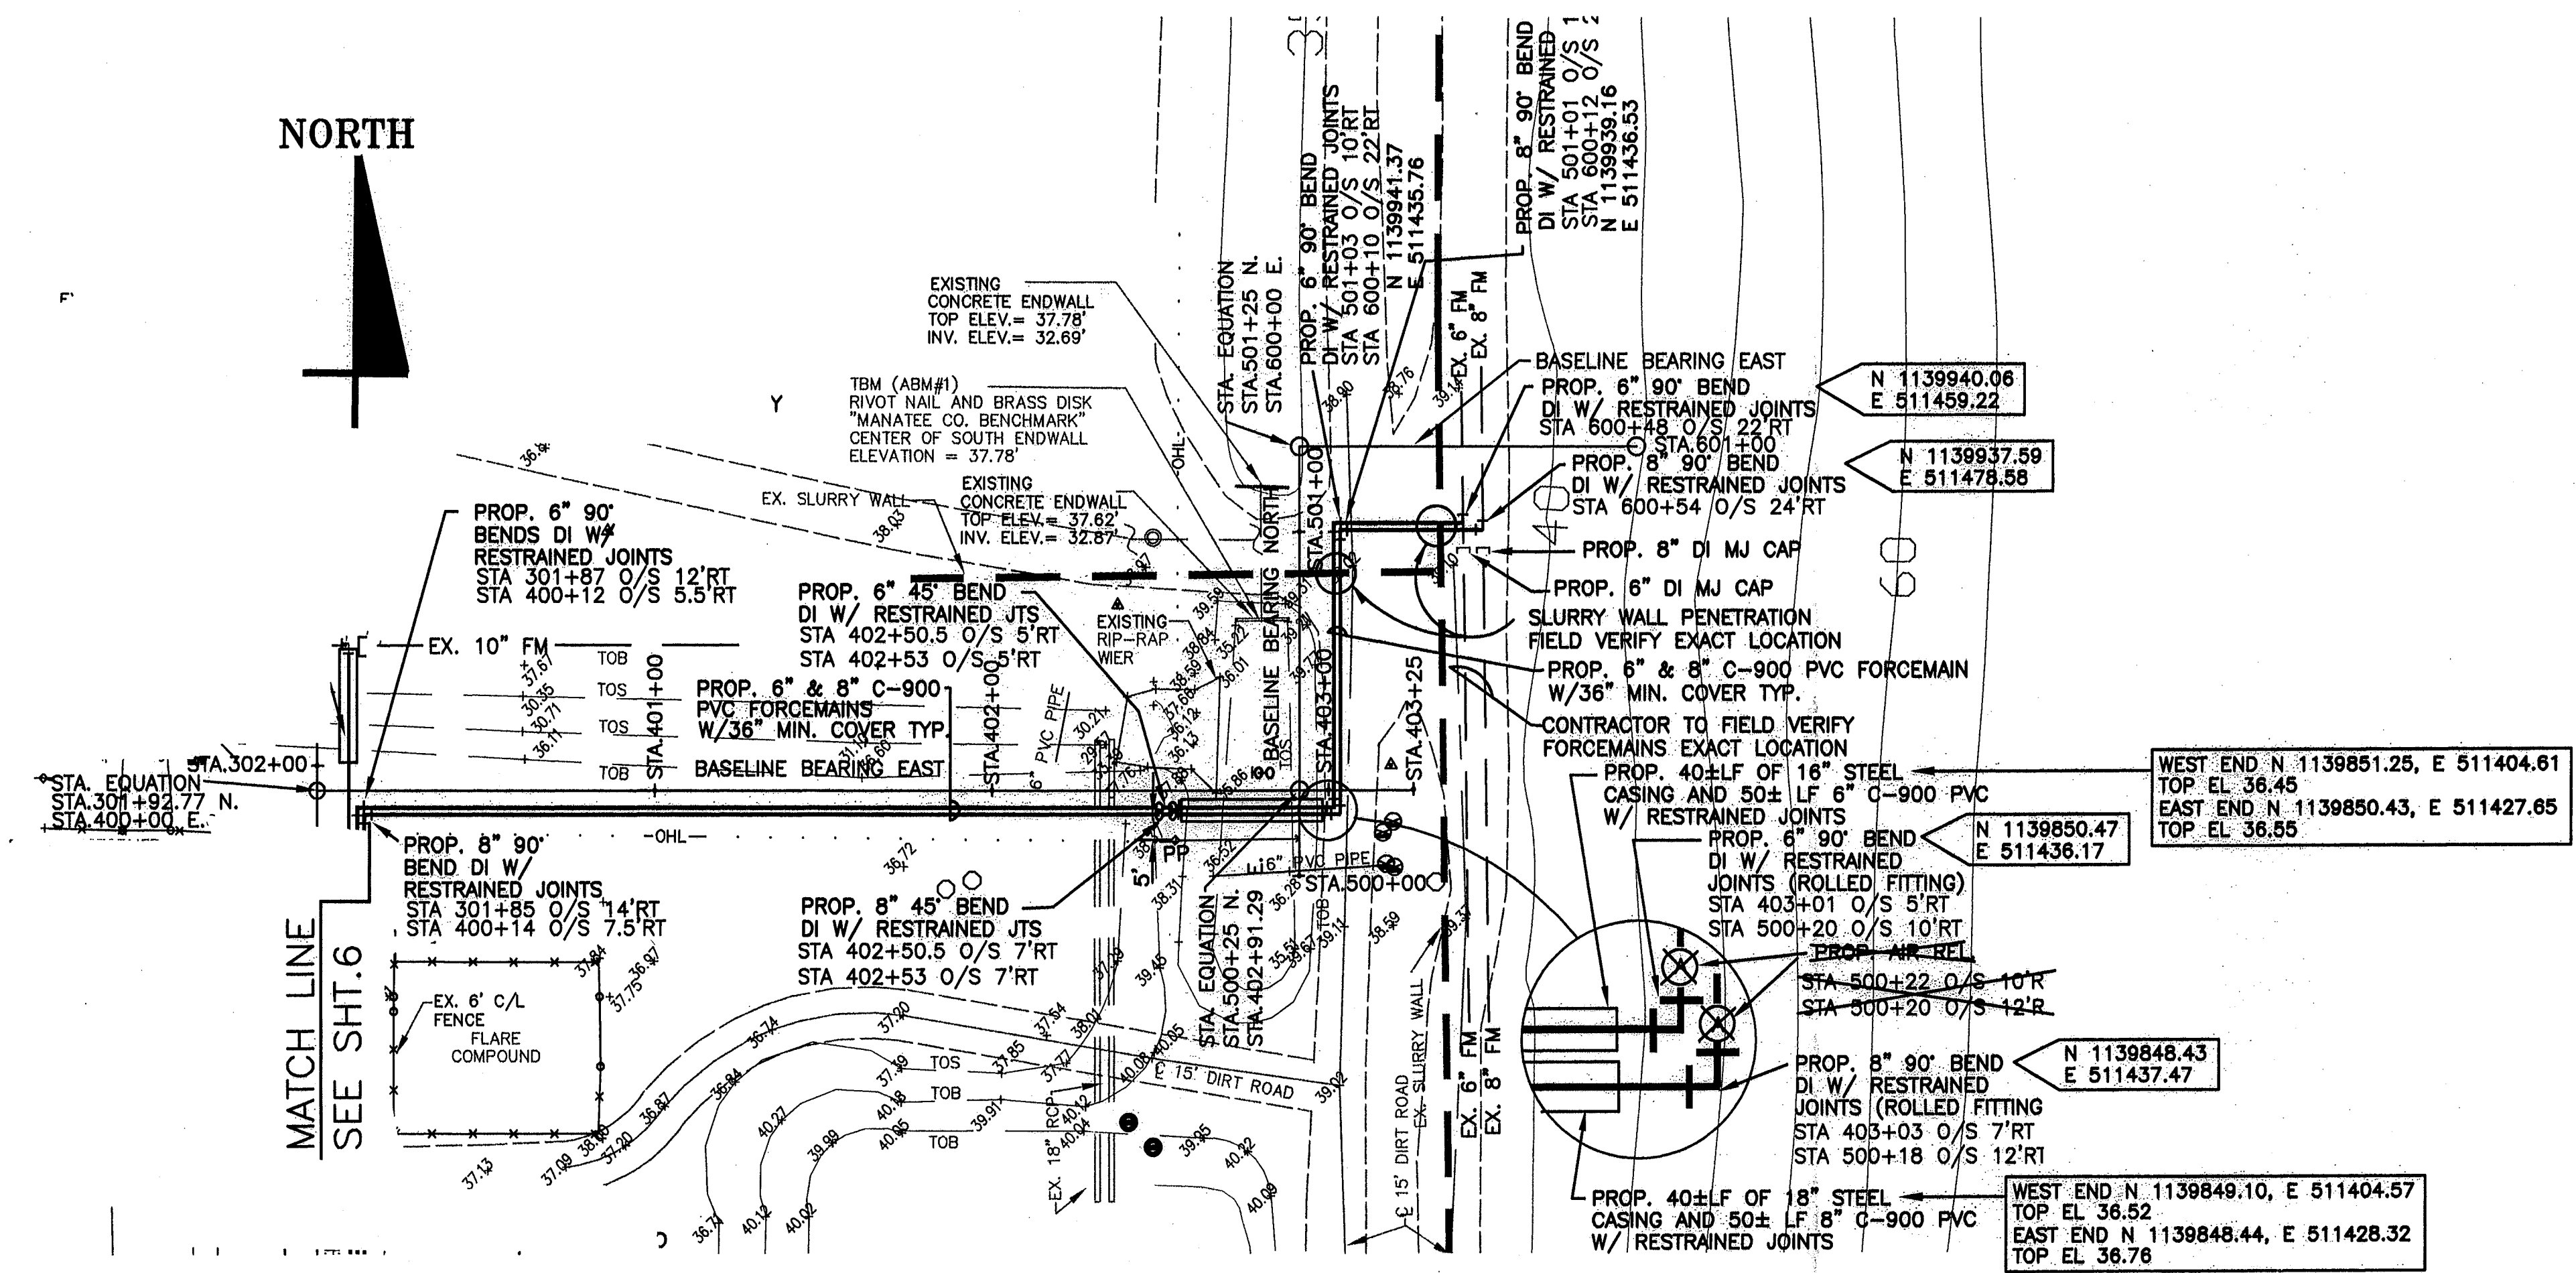

PLAN
HORIZ. SCALE 1" = 40'
VERT. SCALE 1" = 4'

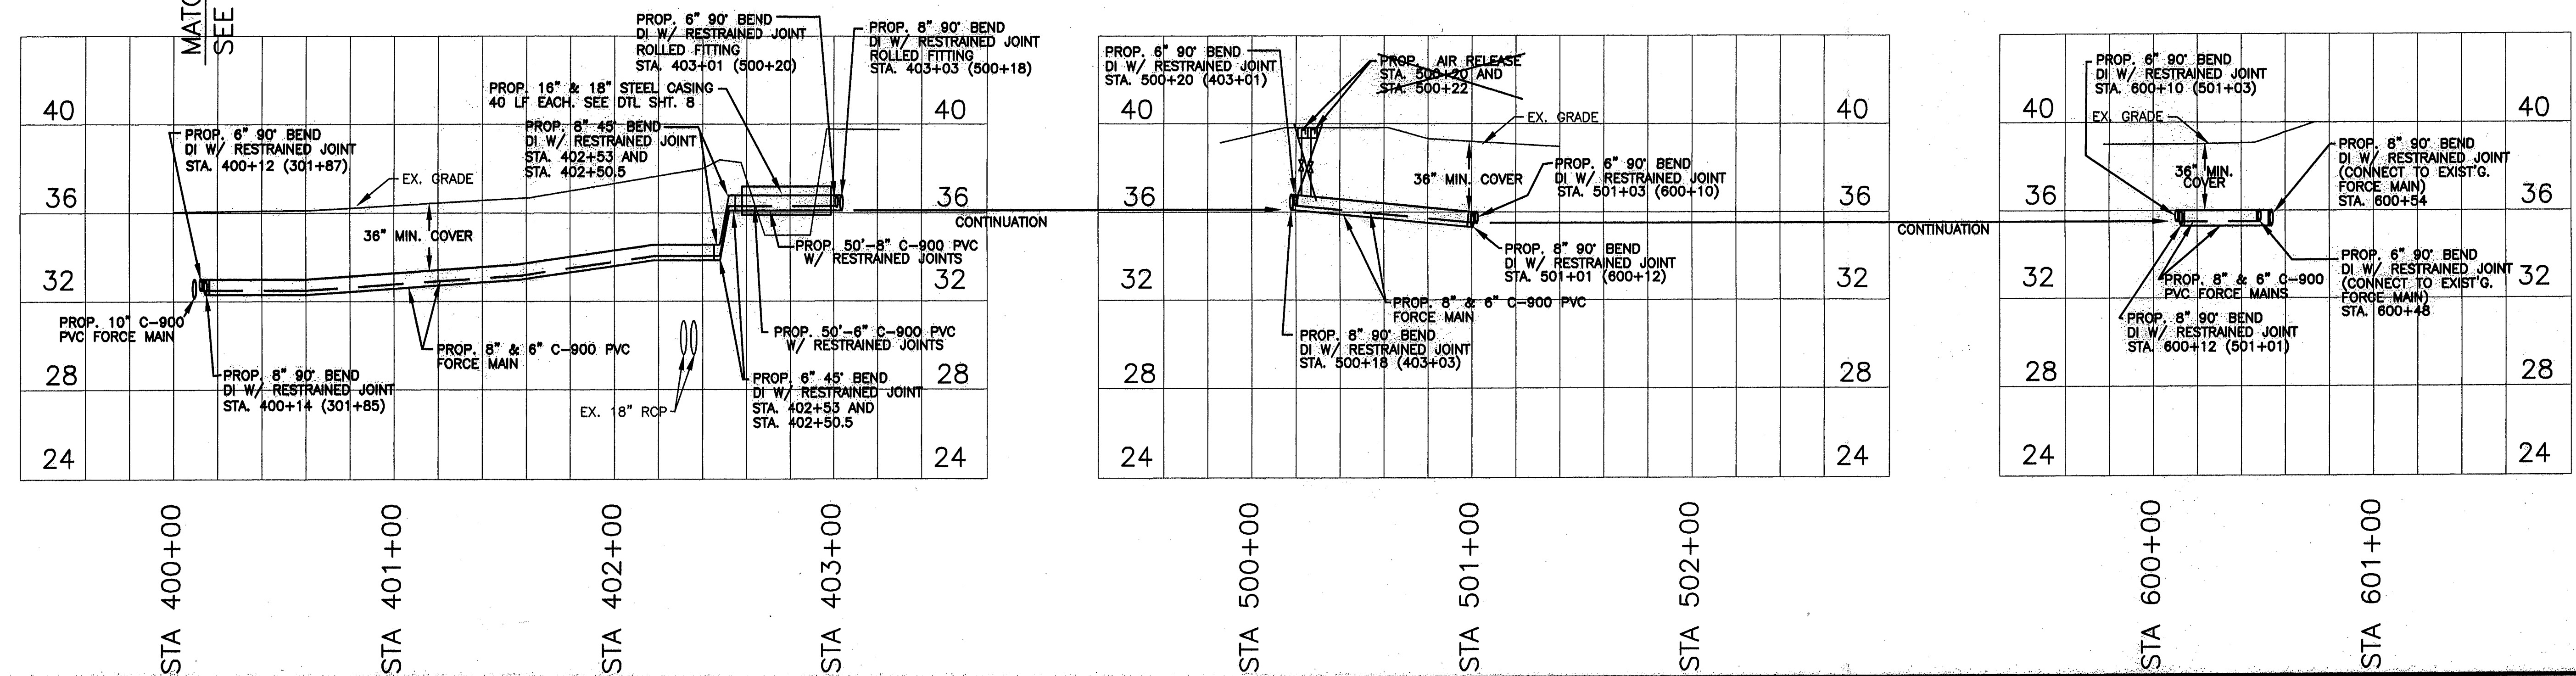

CLIENT
**MANATEE COUNTY
PROJECT MANAGEMENT
DEPARTMENT**
1026 26TH AVENUE EAST
BRADENTON, FLORIDA 34210




PROJECT
**LENA ROAD LANDFILL LEACHATE
POND FACILITIES**

TASK
**PLAN AND PROFILES
STA 400+00 TO 600+54**


ORIGINAL:	6
REVISIONS:	7
1 REC DWG JAN/02	8
2	9
3	10
4	11
5	12

NOT VALID FOR CONSTRUCTION
UNLESS SIGNED IN THIS BLOCK


JOB NO. 120498.02
DRAWN MV
DESIGNED JME
CHECKED JME
QC DBR
SHEET 7

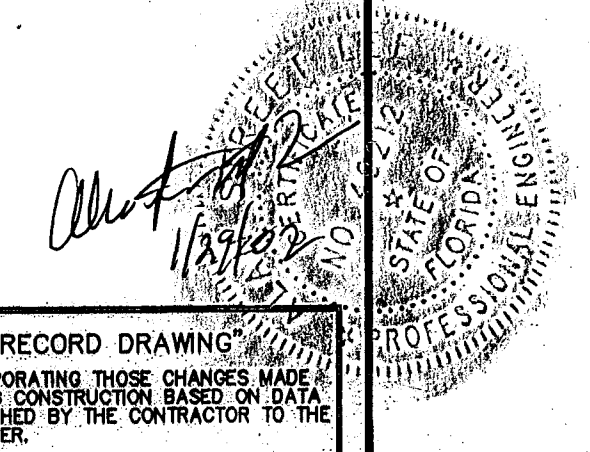

- NOTES:
- 1.) USE OF TYPE A-2 AND A-3 PIPE BEDDING TO BE DETERMINED IN THE FIELD BY THE ENGINEER.
 - 2.) 10" MAX. FOR PIPE DIAMETER LESS THAN 24"; 12" MAX. FOR PIPE DIAMETER 24" AND LESS THAN 42"; 24" MAX. FOR PIPE DIAMETER 42" AND OVER.
 - 3.) 4" MAX. FOR PIPE 18" DIAMETER & LESS; 6" MAX. FOR PIPE 18" TO 36" DIAMETER; AND 9" MAX. FOR PIPE 42" DIAMETER AND LARGER.
 - 4.) INSTALLATION SHALL BE IN ACCORDANCE WITH THE MANUFACTURER'S SPECIFICATIONS.

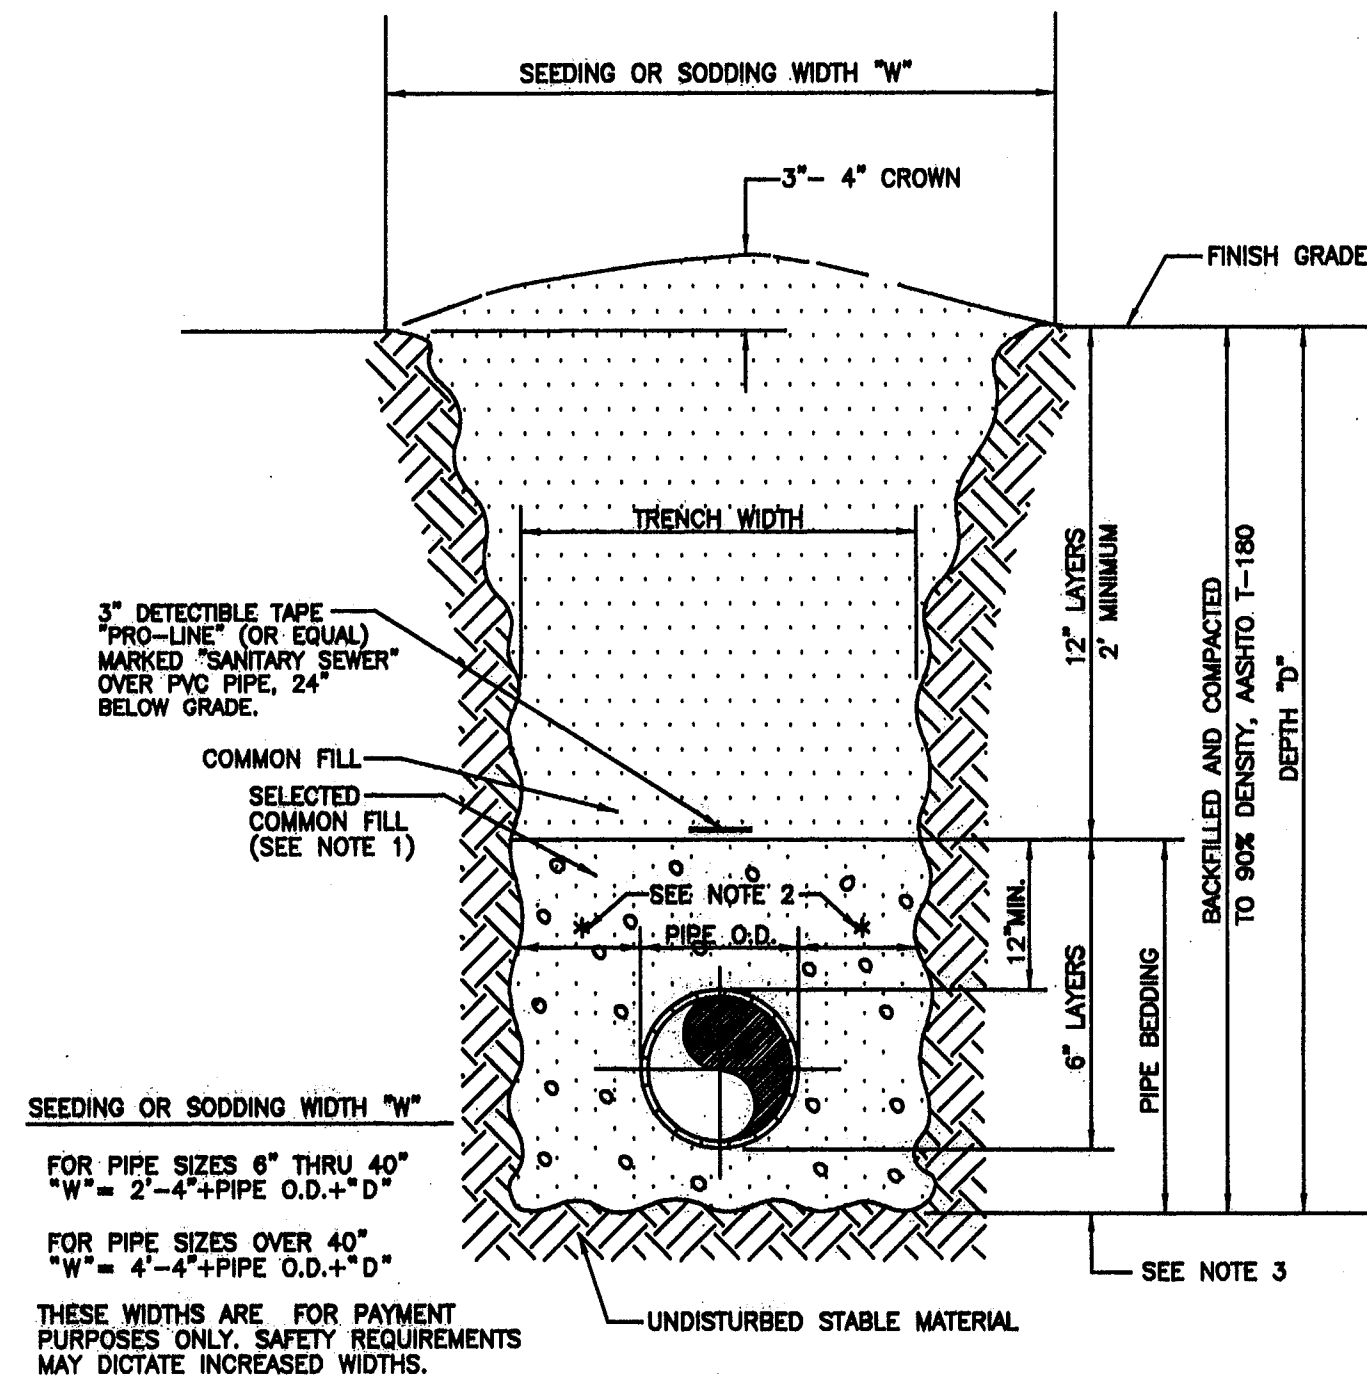

PIPE BEDDING DETAIL

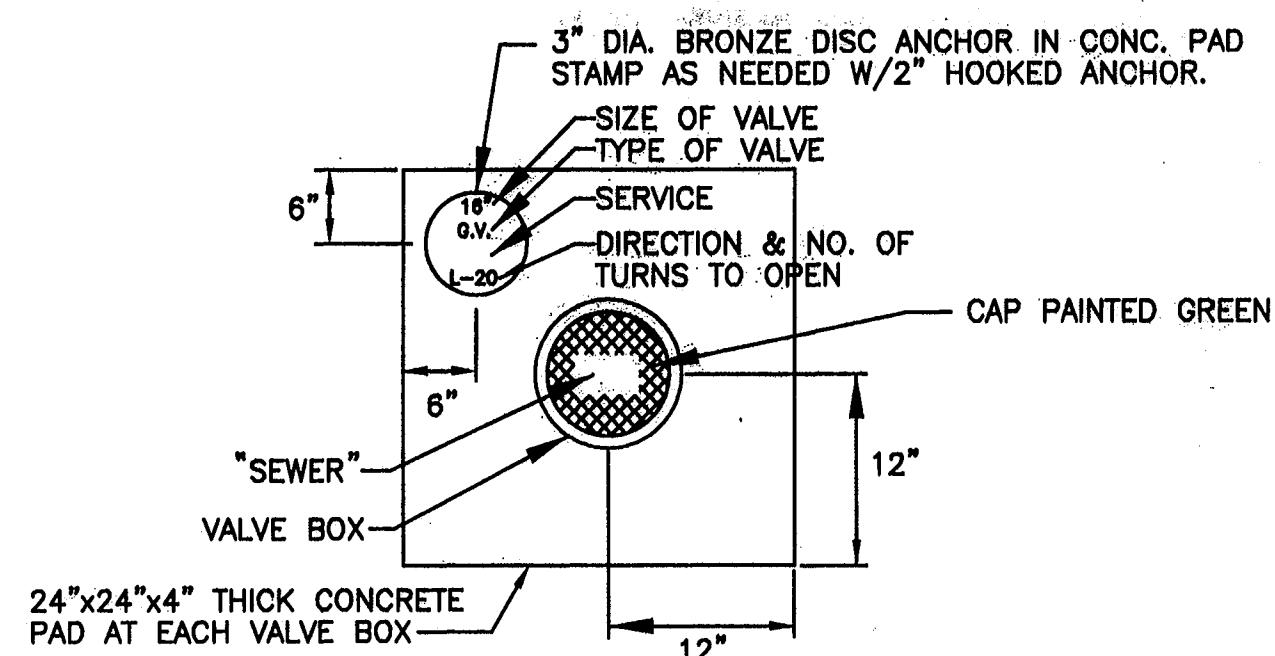


- NOTES:
1. GATE VALVE TO BE MARKED IN CURB WITH A "SV" WITH A FOOTAGE FROM THE BACK OF CURB TO THE VALVE OR IF NO CURB, A GREEN DISC WITH "SV" IN THE EDGE OF PAVEMENT WITH THE FOOTAGE FROM THE DISC TO THE VALVE.
 2. ALL EXISTING AND PROPOSED VALVE BOXES SHALL BE ADJUSTED TO FINISHED GRADES AS ESTABLISHED IN THE FIELD.
 3. SEWER VALVES SHALL NOT BE PLACED IN HANDICAPPED RAMPS.
 4. ALL EXPOSED EDGES OF CONCRETE SHALL BE CHAMFERED 1/2".


VALVE AND COVER DETAIL

RESTRAINED JOINT FITTING TO PIPE LENGTH TABLE																					
PIPE SIZE	BENDS				TEES								REDUCERS								PLUG
	11.25'	22.5'	45'	90'	6"	8"	10"	12"	16"	18"	20"	24"	6"	8"	10"	12"	16"	18"	20"		
6"	2'	5'	10'	24'	*	N/A	N/A	N/A	N/A	N/A	N/A	N/A	N/A	N/A	N/A	N/A	N/A	N/A	N/A	53'	
8"	3'	6'	13'	31'	*	*	N/A	N/A	N/A	N/A	N/A	N/A	29'	N/A	N/A	N/A	N/A	N/A	N/A	69'	
10"	4'	7'	15'	37'	*	*	*	N/A	N/A	N/A	N/A	N/A	51'	28'	N/A	N/A	N/A	N/A	N/A	83'	
12"	4'	9'	18'	43'	*	*	*	*	N/A	N/A	N/A	N/A	71'	52'	29'	N/A	N/A	N/A	N/A	98'	
16"	5'	11'	23'	55'	*	*	*	*	*	N/A	N/A	N/A	106'	92'	75'	54'	N/A	N/A	N/A	126'	
18"	6'	12'	25'	60'	*	*	*	*	*	*	N/A	N/A	122'	94'	75'	28'	N/A	N/A	N/A	139'	
20"	6'	13'	27'	65'	*	*	*	*	*	*	*	N/A	N/A	N/A	112'	96'	54'	28'	N/A	153'	
24"	7'	15'	31'	75'	*	*	*	*	*	*	*	*	N/A	N/A	N/A	132'	97'	76'	53'	178'	

- NOTES:
1. RESTRAIN TO NEXT JOINT BEYOND GIVEN LENGTH.
 2. * = RESTRAIN AT JOINT ONLY.

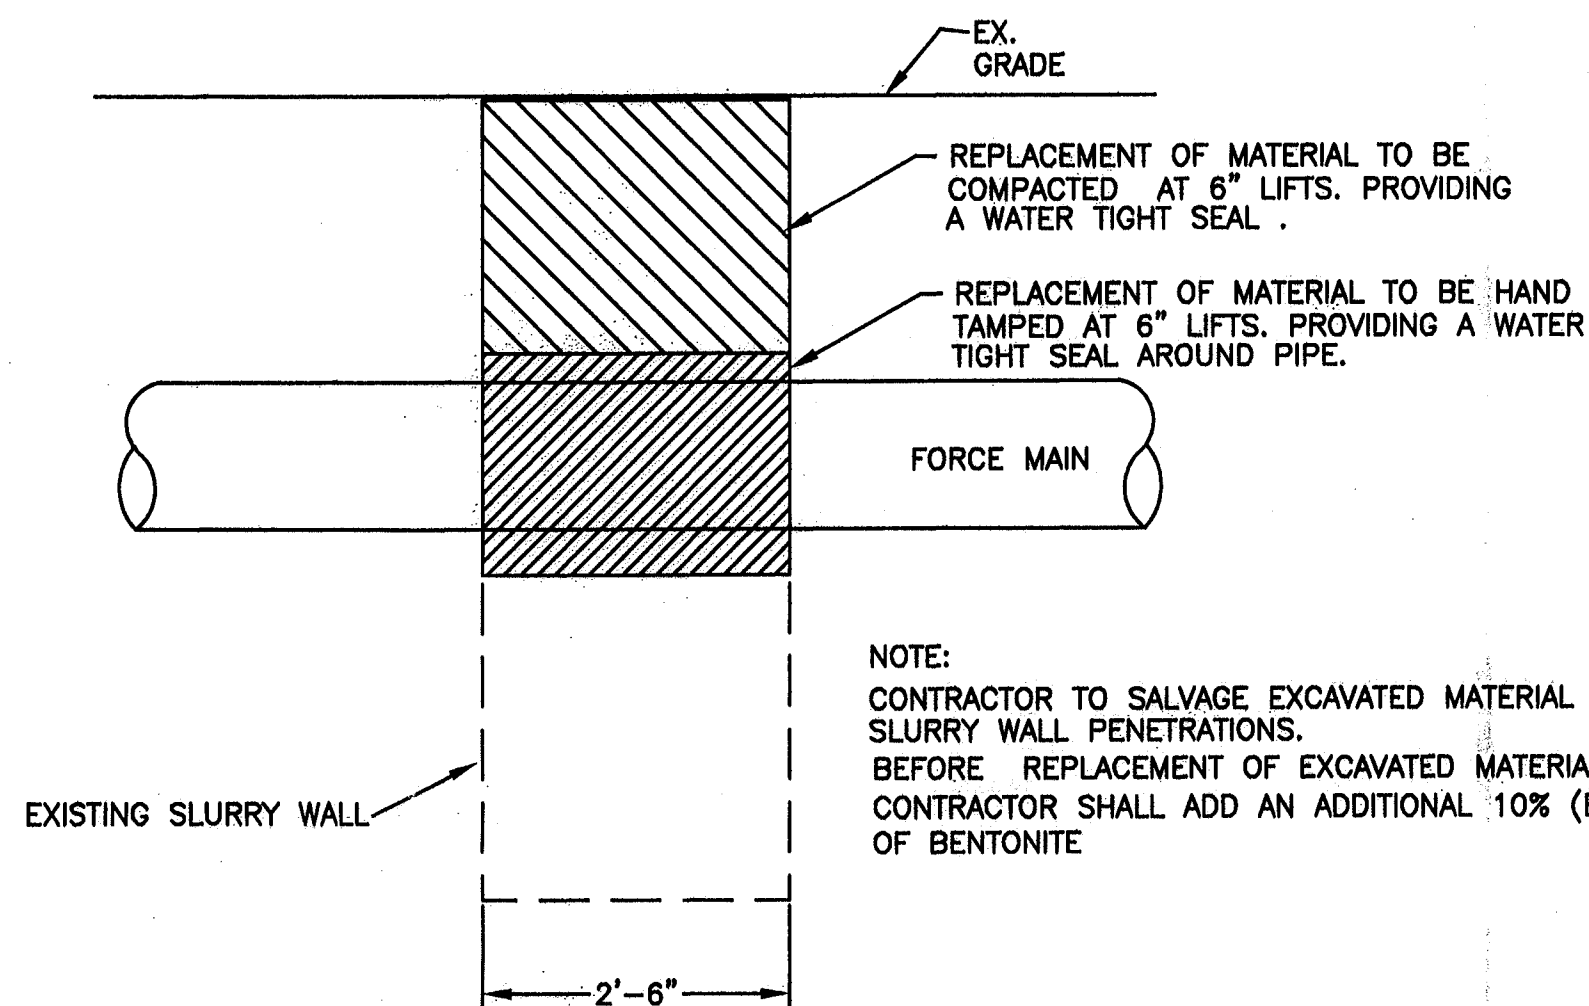


SLURRY WALL PENETRATION DETAIL

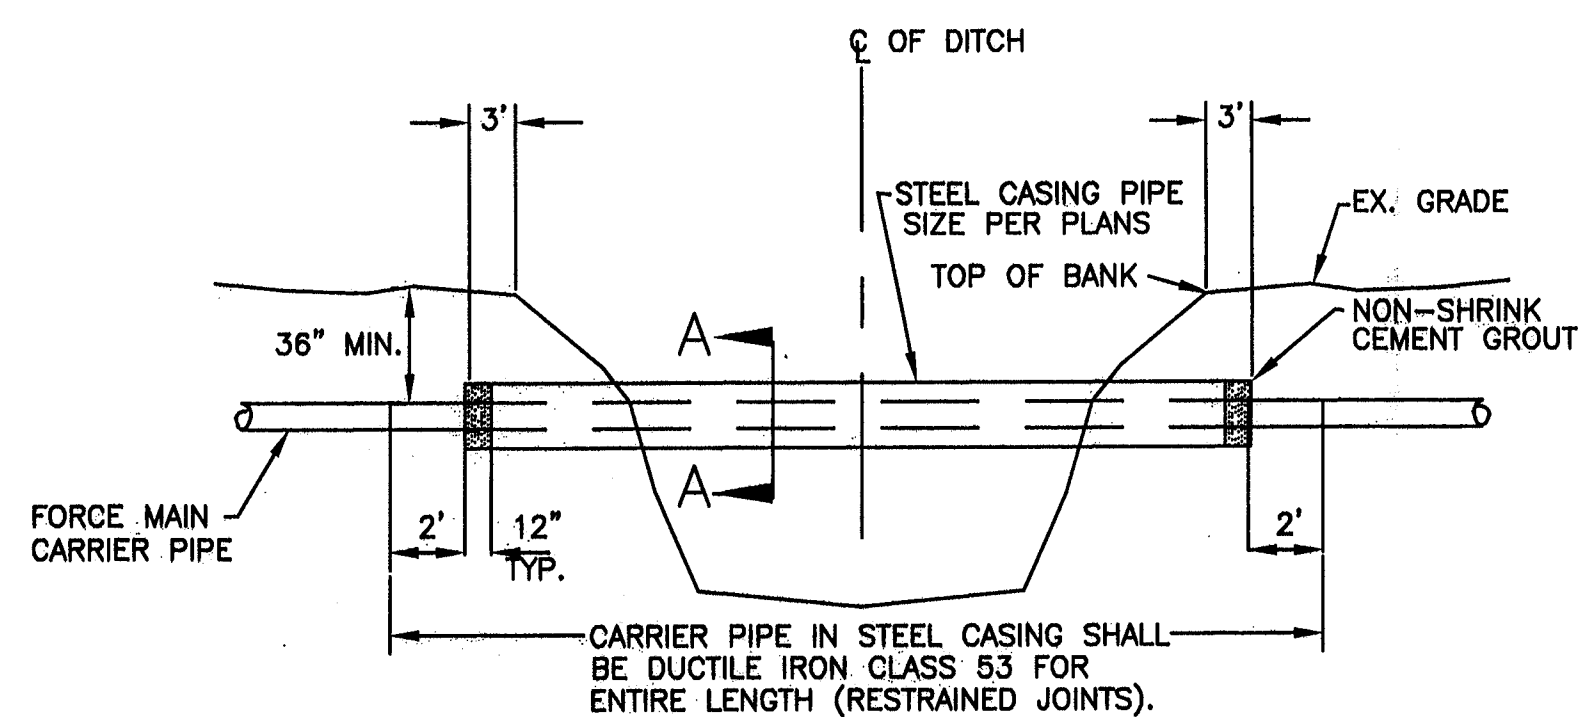


DITCH CROSSING CARRIER & CASING DETAIL

DELETED PER COUNTY REQUEST

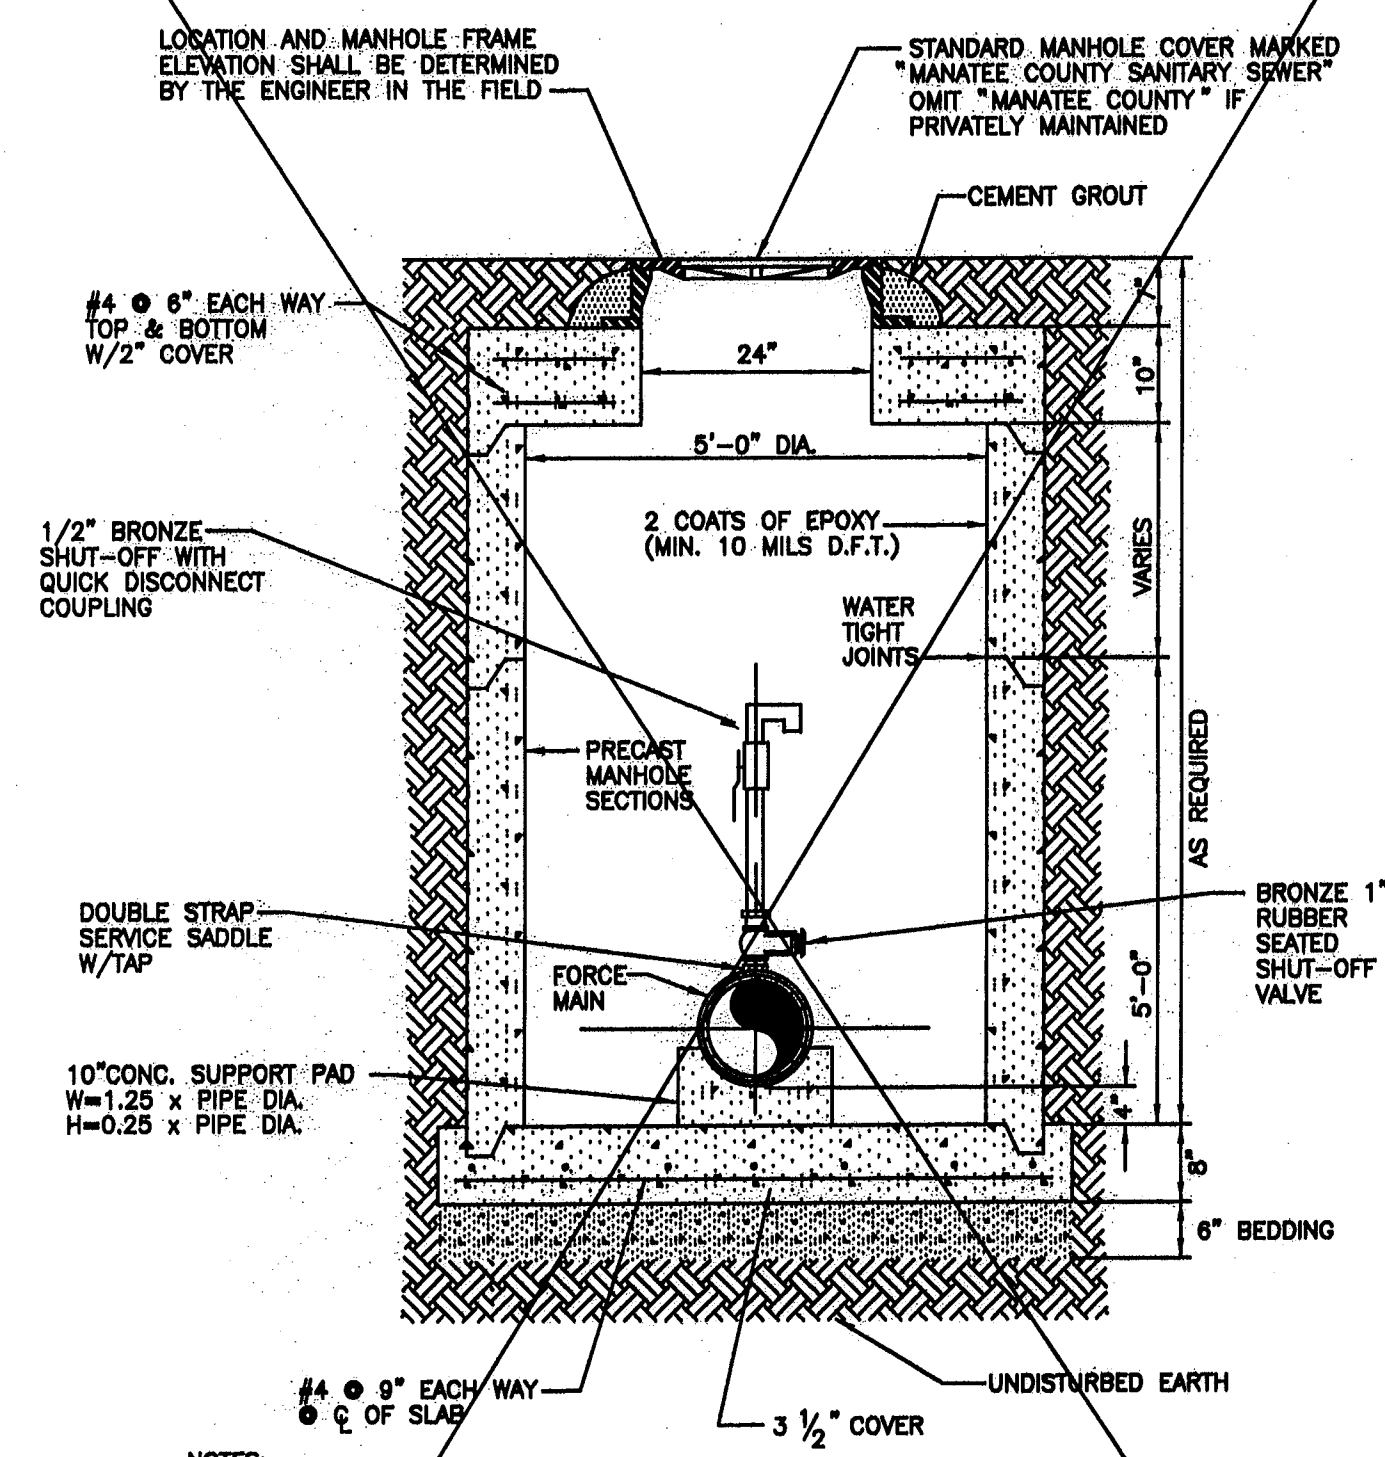


- NOTES:
1. TO PREVENT DAMAGE TO VALVE FROM TIPPED MANHOLE COVERS IN SHALLOW BOXES IT MAY BE NECESSARY TO OFFSET VALVE FROM CENTER LINE.
 2. AIR RELEASE VALVES ARE REQUIRED ON 4" AND LARGER FORCE MAINS.
 3. ALL PIPE STUBS, NIPPLES AND HARDWARE TO BE 304 STAINLESS STEEL.

MANUAL AIR RELEASE VALVE WITH ACCESSORIES DETAIL

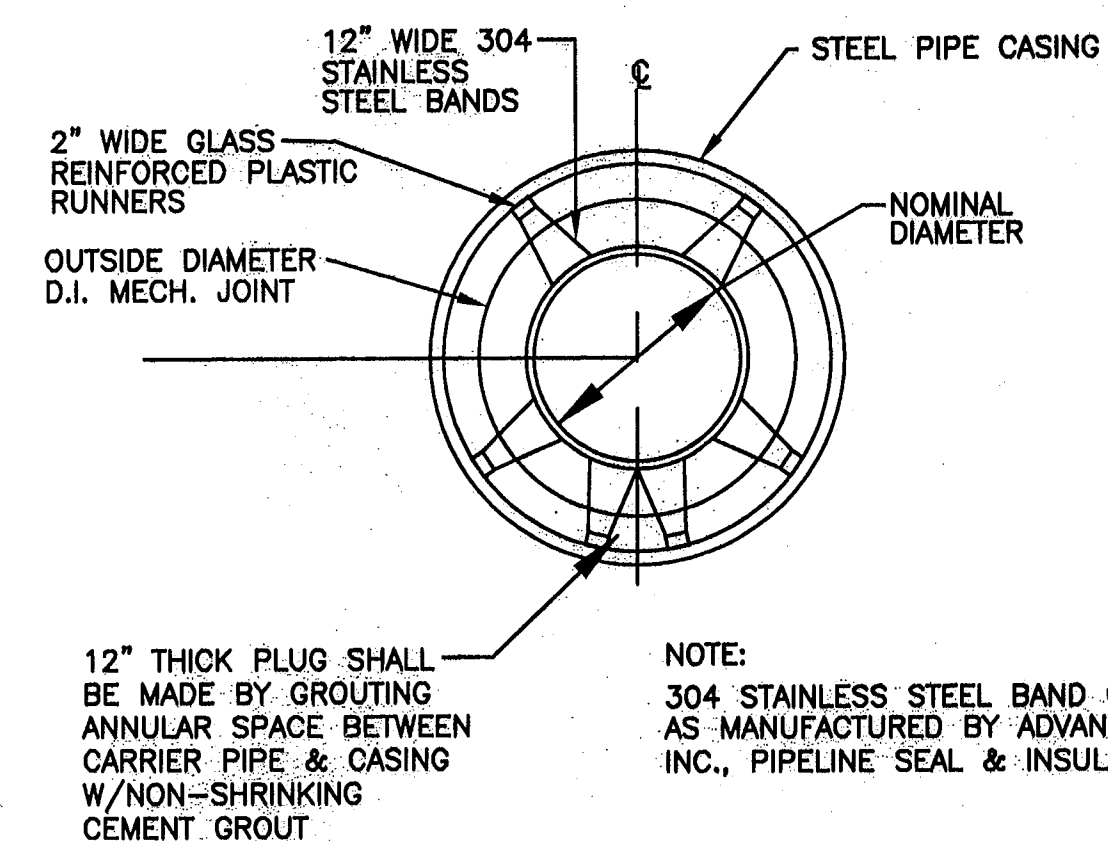

SECTION A-A

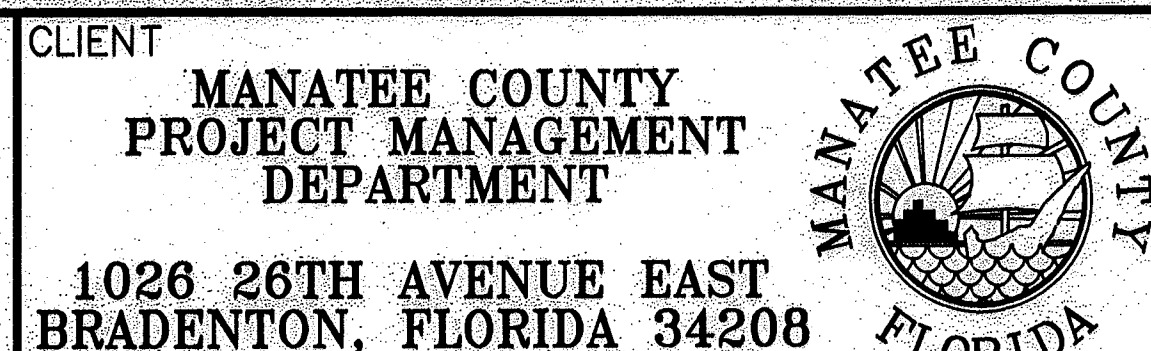

PROJECT	TASK
LENA ROAD LANDFILL LEACHATE	DETAILS
POND FACILITIES	

ORIGINAL:	REVISIONS:
1 REC DWG JAN/02	2
3	4
5	6

6	7	8	9	10	11	12
---	---	---	---	----	----	----


JOB NO. 120498.02	DRAWN MV	DESIGNED JME	CHECKED JME	QC TXFF
SHEET 8				

NOT VALID FOR CONSTRUCTION UNLESS SIGNED IN THIS BLOCK

LEGEND


- A MINIMUM DISTANCE SHALL BE 5 PIPE DIA.'S
- B MINIMUM DISTANCE SHALL BE 2 PIPE DIA.'S
- 1 6" McCROMETER MODEL NO. MF100 W/ FLOW STRAIGHTENING VANES
- 2 4" McCROMETER MODEL NO. MF100 W/ FLOW STRAIGHTENING VANES
- 3 6" OS & Y RESILIENT SEAT GATE VALVE
- 4 4" OS & Y RESILIENT SEAT GATE VALVE
- 5 10" OS & Y RESILIENT SEAT GATE VALVE
- 6 8"x 6" DI FLANGE REDUCER
- 7 6"x 4" DI FLANGE REDUCER
- 8 12"x 10" DI FLANGE REDUCER
- 9 12"x 6" DI FLANGE REDUCING ELBOW
- 10 12"x 6" DI FLANGE REDUCING TEE
- 11 12"x 4" DI FLANGE REDUCING TEE
- 12 12" DI FLANGE TEE
- 13 12" DI FLANGE 45° BEND
- 14 12" DI MJ 45° BEND W/ RETAINING GLANDS
- 15 10" DI FLANGE 45° BEND
- 16 10" DI MJ 45° BEND W/ RETAINING GLANDS
- 17 8" DI FLANGE 45° BEND
- 18 8" DI MJ 45° BEND W/ RETAINING GLANDS
- 19 6" DI FLANGE 45° BEND
- 20 6" DI MJ 45° BEND W/ RETAINING GLANDS
- 21 6" DI MJ 90° BEND W/ RETAINING GLANDS
- 22 UNI-FLANGE
- 23 PIPE SUPPORT
- 24 6" WYE STRAINER FEBCO MODEL 758 OR EQUAL
- 25 4" WYE STRAINER FEBCO MODEL 758 OR EQUAL
- 26 10" WYE STRAINER FEBCO MODEL 758 OR EQUAL
- 27 10" McCROMETER MODEL NO. MF100 W/ FLOW STRAIGHTENING VANES

MATCH LINE
SEE SHEET 6

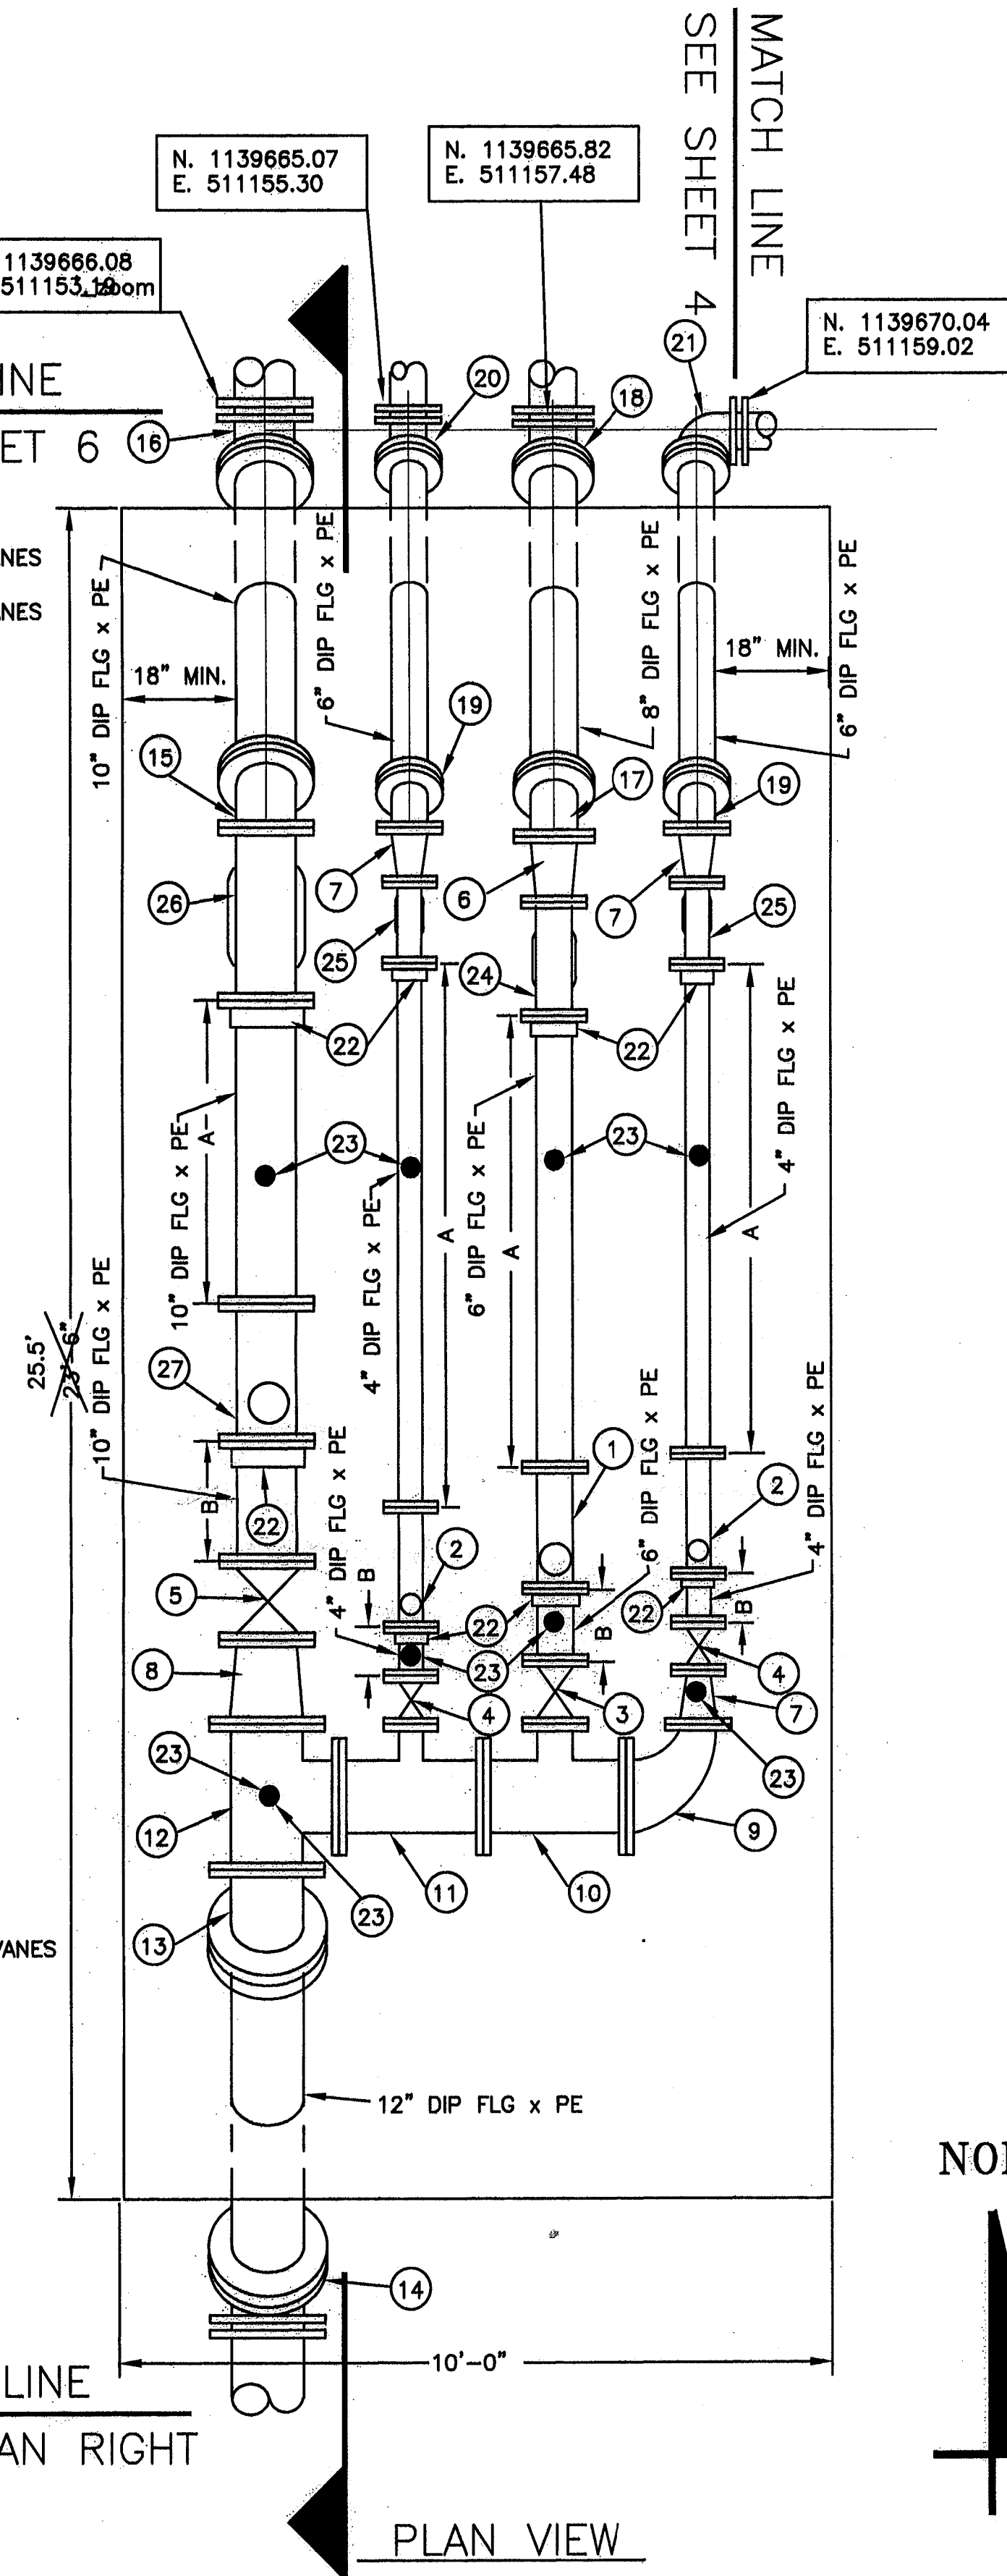


MATCH LINE
SEE PLAN RIGHT

METERING STATION DETAILS

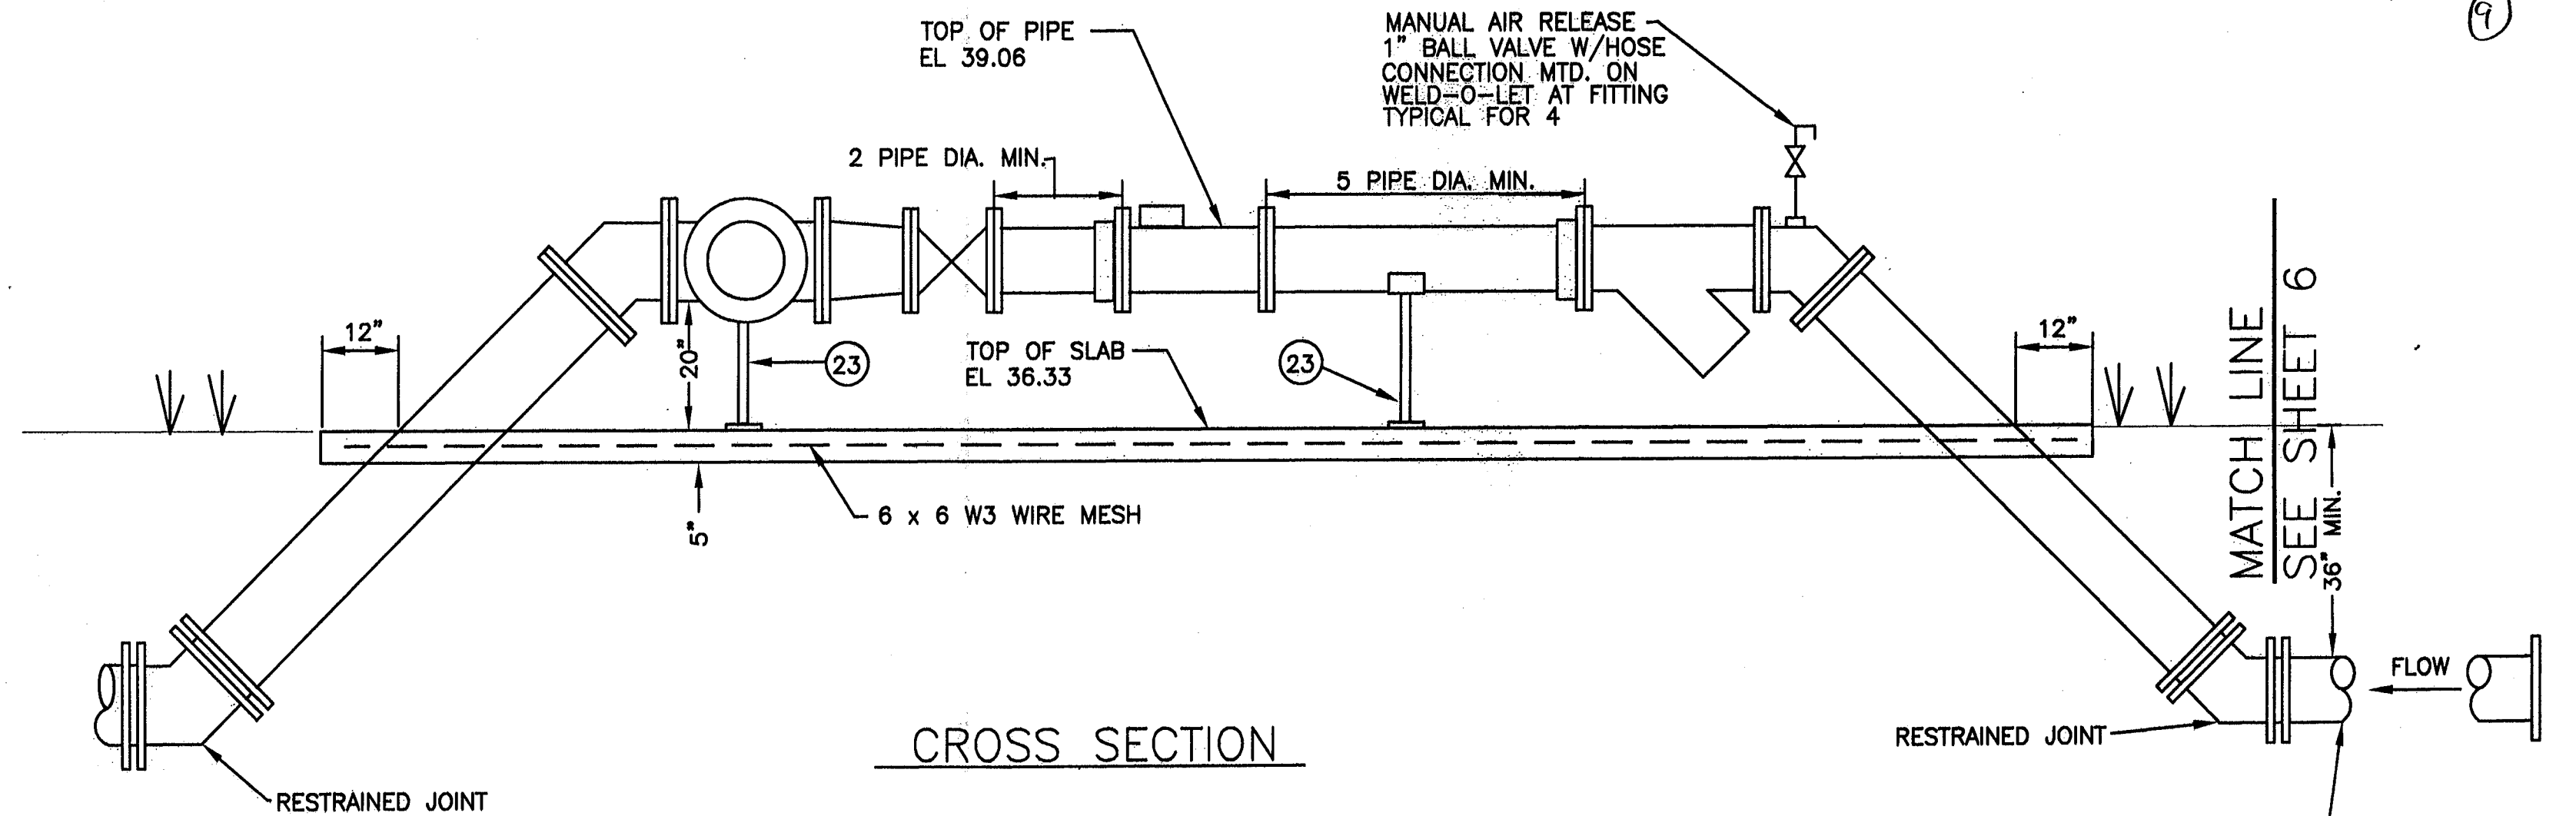

- NOTES:
1. ALL ABOVE GROUND PIPING TO BE PAINTED GREEN W/ NON- POTABLE MARKINGS.
 2. DEVICES MUST BE INSTALLED LEVEL.
 3. ALL EXPOSED CONCRETE EDGES SHALL HAVE 1/2" CHAMFER.
 4. ALL JOINTS SHALL BE FLANGED UNLESS OTHERWISE NOTED.
 5. ALL BELOW GROUND DI PIPE AND FITTINGS SHALL BE POLYETHYLENE WRAPPED.

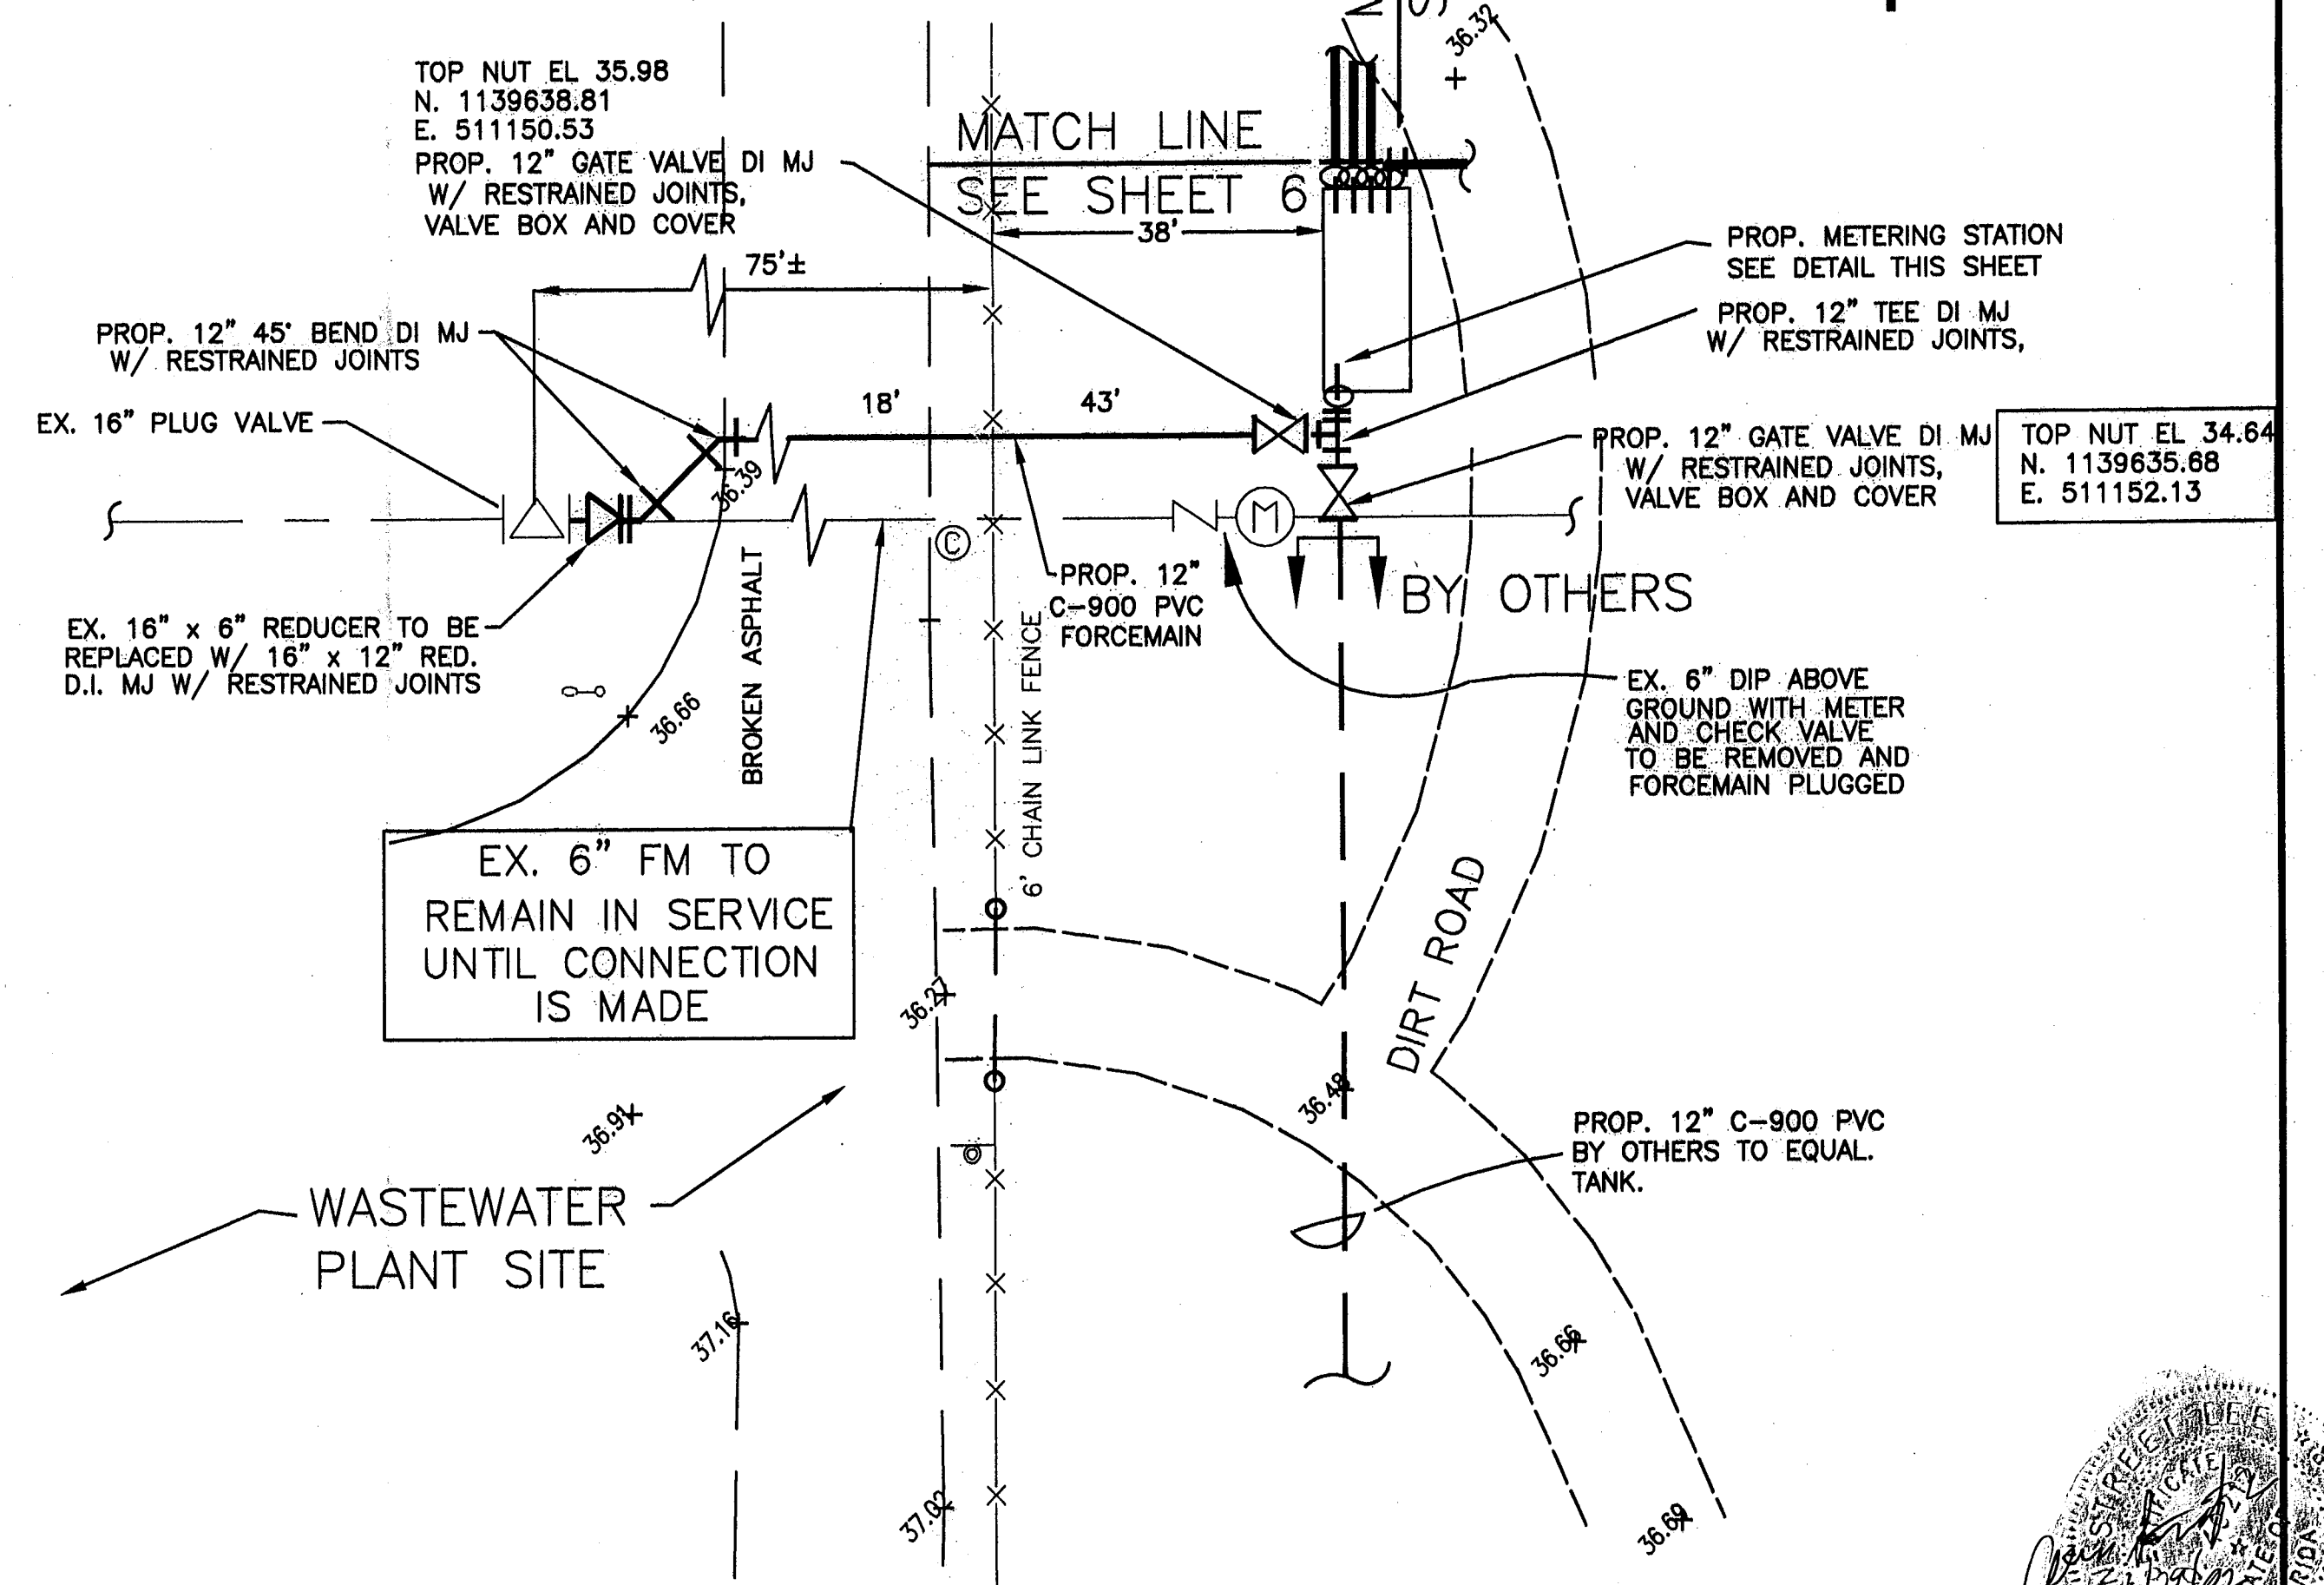

METERING STATION PLAN


NOTE: SCALE: 1"=20'
CONTRACTOR TO VERIFY EXACT LOCATION OF 6" FORCEMAIN AND MAKE ANY REQUIRED ADJUSTMENTS.

"RECORD DRAWING"
INCORPORATING THOSE CHANGES MADE DURING CONSTRUCTION BASED ON DATA FURNISHED BY THE CONTRACTOR TO THE ENGINEER.



330 SOUTH PINEAPPLE AVE.
SUITE 113
SARASOTA, FLORIDA 34236
PH: (941) 954-4036
FAX: (941) 954-4037
WWW.PBSANDJ.COM

CLIENT
**MANATEE COUNTY
PROJECT MANAGEMENT
DEPARTMENT**
1026 26TH AVENUE EAST
BRADENTON, FLORIDA 34210

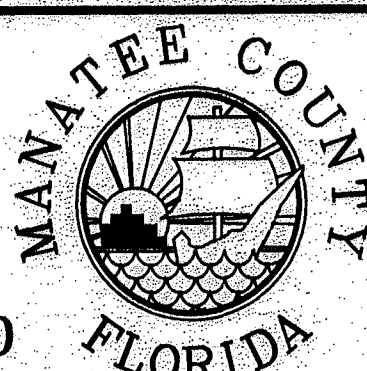

PROJECT
**LENA ROAD LANDFILL LEACHATE
POND FACILITIES**

TASK
METERING STATION DETAILS


ORIGINAL:
REVISIONS:
1 REC DWG JAN/02
2
3
4
5

6
7
8
9
10
11
12


NOT VALID FOR CONSTRUCTION
UNLESS SIGNED IN THIS BLOCK

JOB NO. 120498.02
DRAWN MV
DESIGNED JME
CHECKED JME
QC DBR


SHEET 9

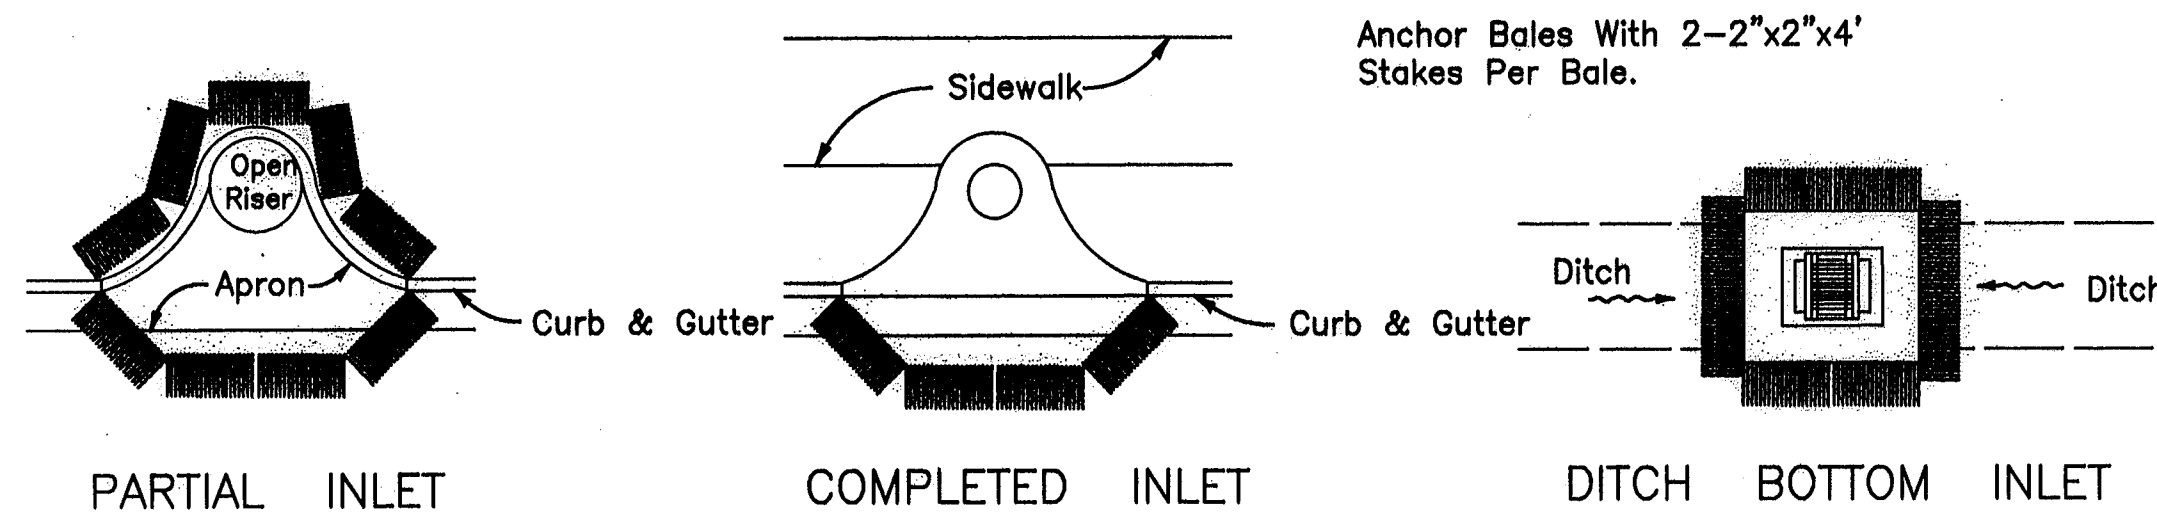


PROTECTION AROUND INLETS OR SIMILAR STRUCTURES

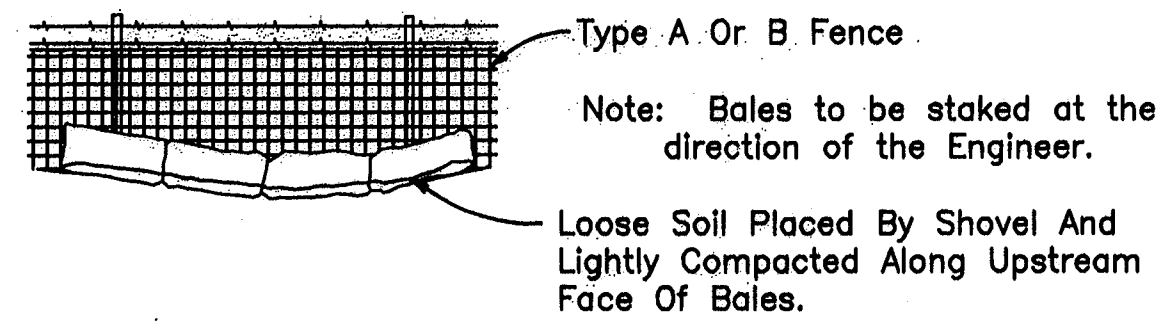

BALES BACKED BY FENCE

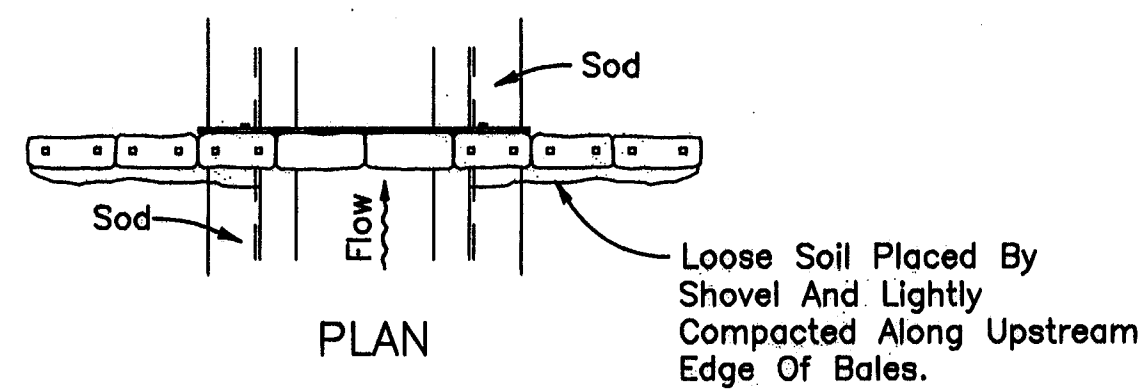


PLAN

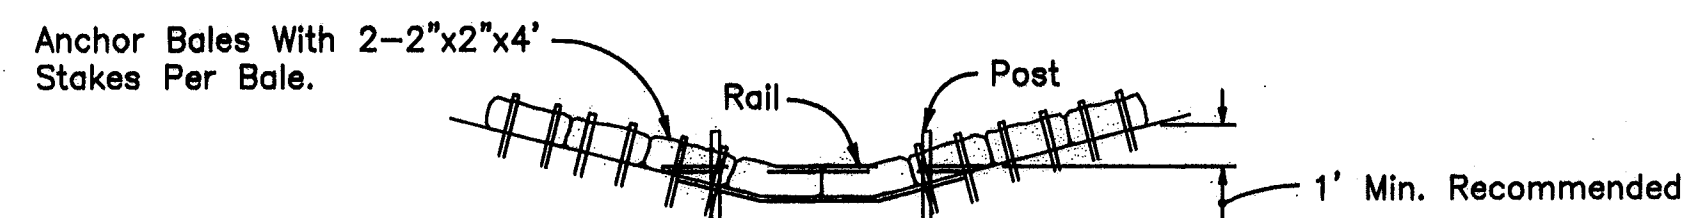

ELEVATION


Spacing: Bale barriers for paved ditches should be spaced in accordance with Chart I

BARRIER FOR PAVED DITCH

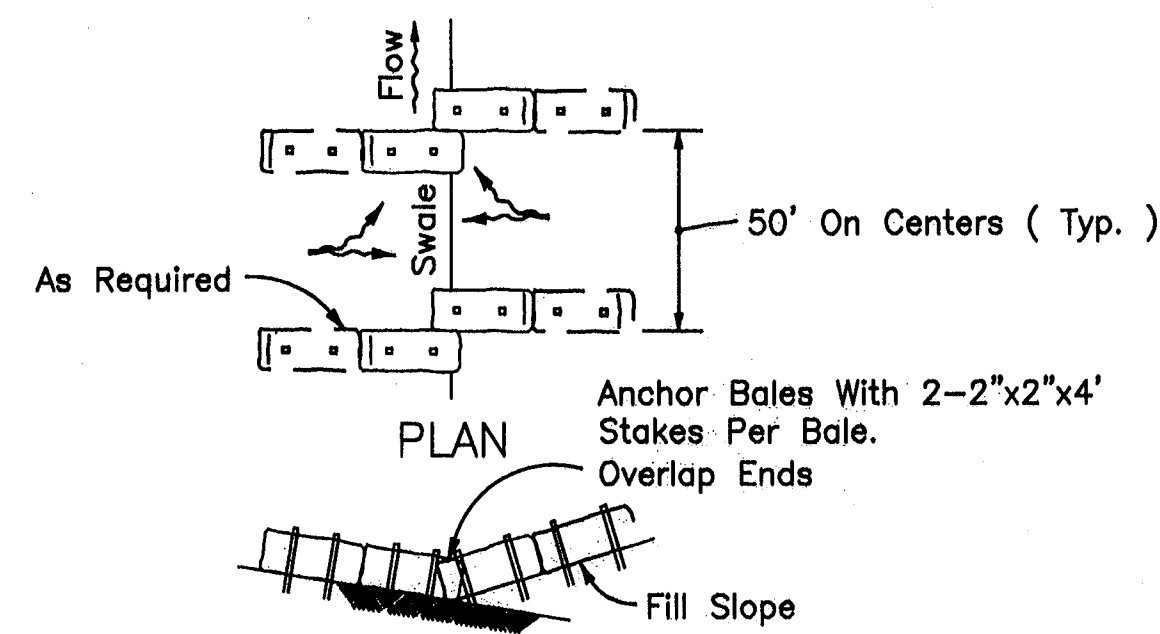

ELEVATION


TO BE USED AT SELECTED SITES WHERE THE NATURAL GROUND SLOPES TOWARD THE TOE OF SLOPE

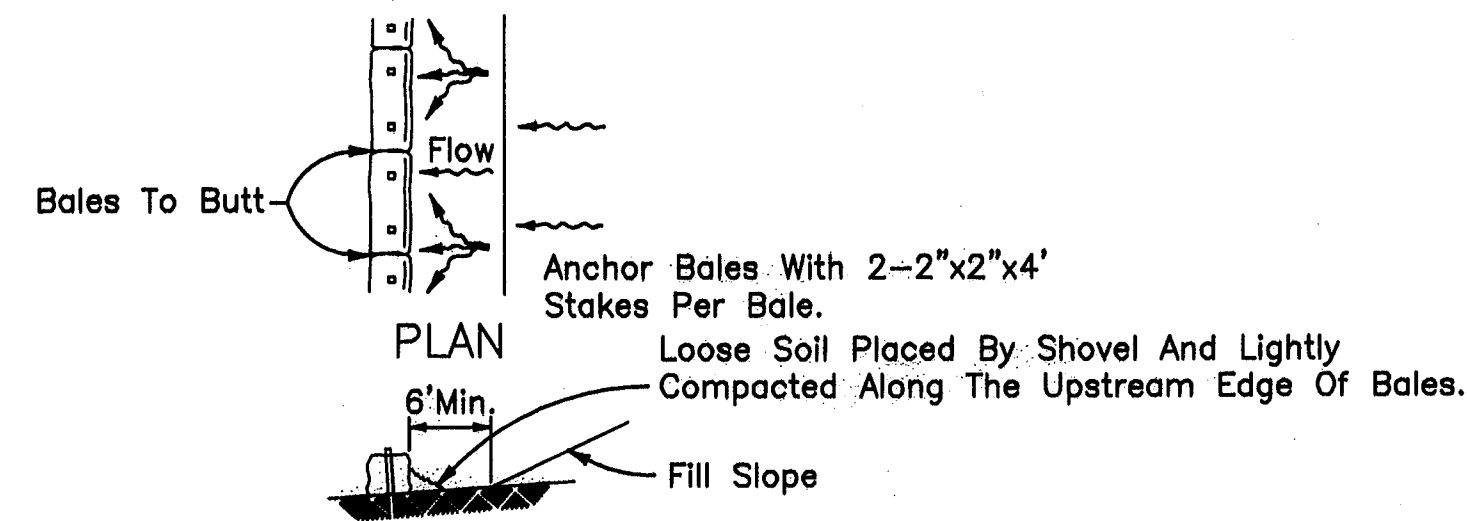

ELEVATION

TO BE USED AT SELECTED SITES WHERE THE NATURAL GROUND SLOPES AWAY FROM THE TOE OF SLOPE


BARRIERS FOR FILL SLOPES

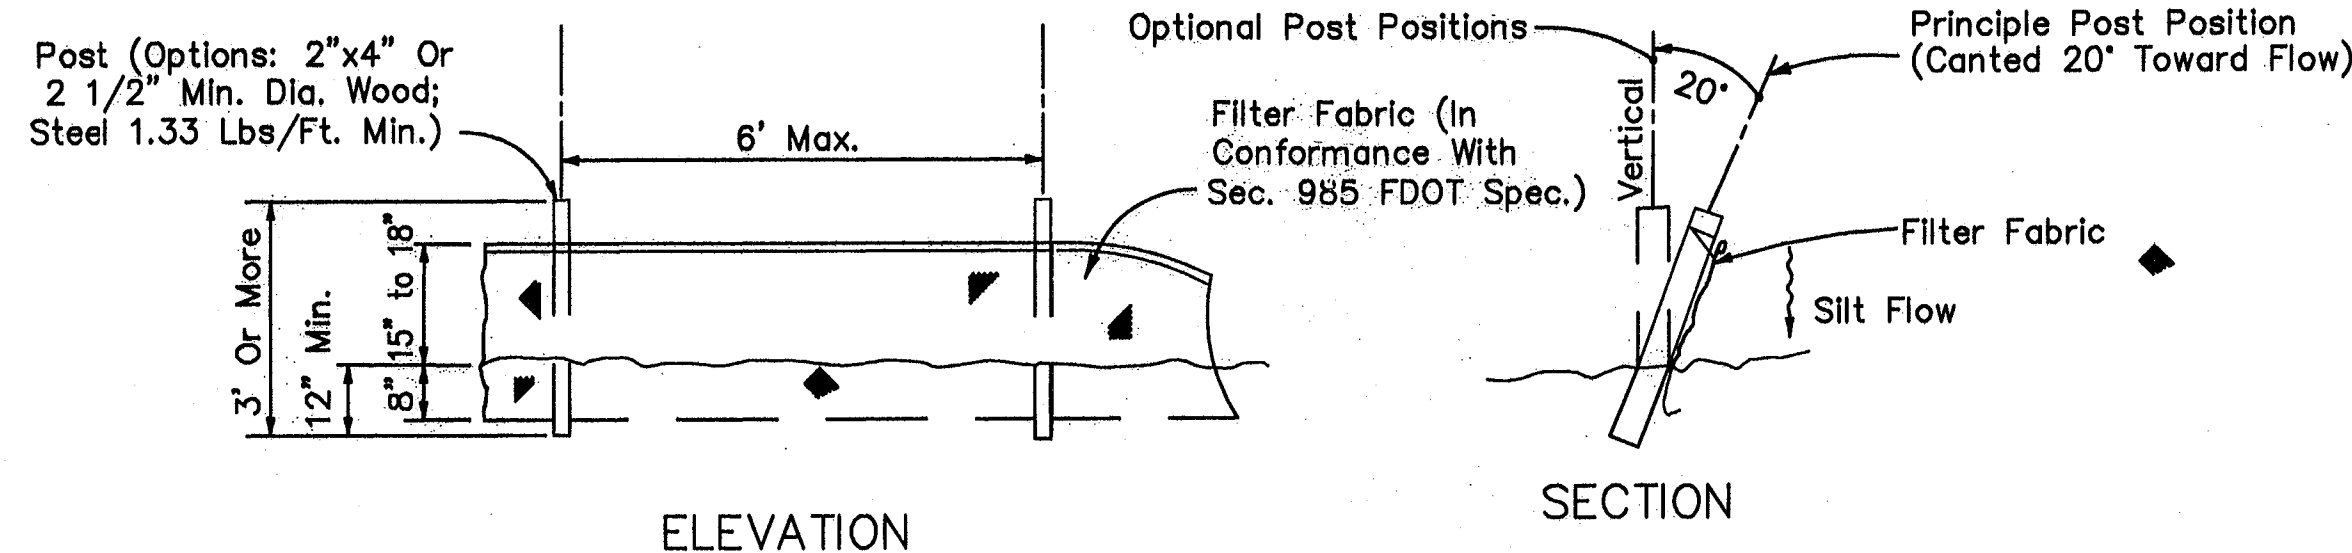

ELEVATION


SECTION

TYPE III SILT FENCE

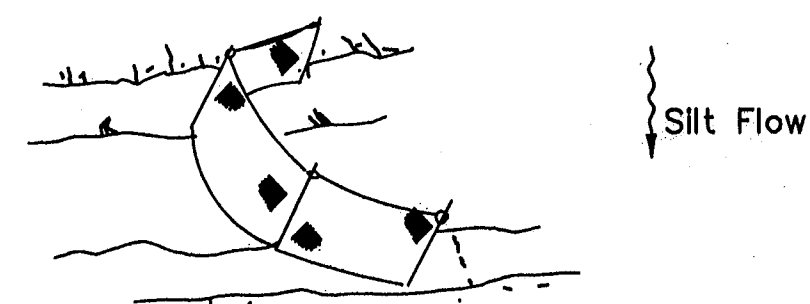


Note: Spacing for Type III Fence to be in accordance with Chart I.

Type III Silt Fence

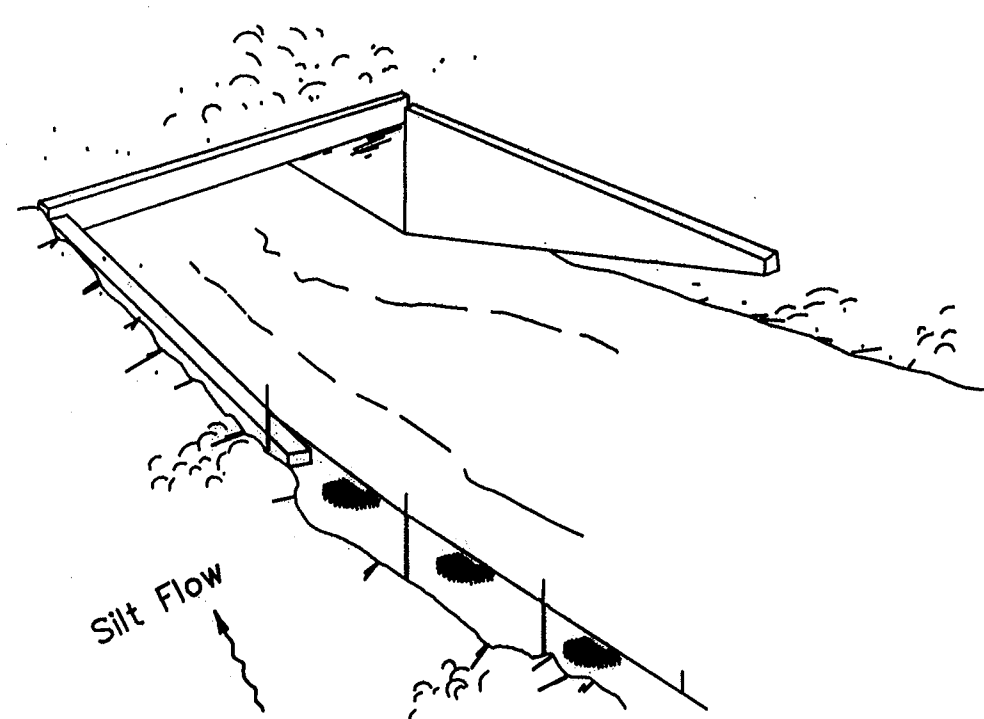


Type III Silt Fence

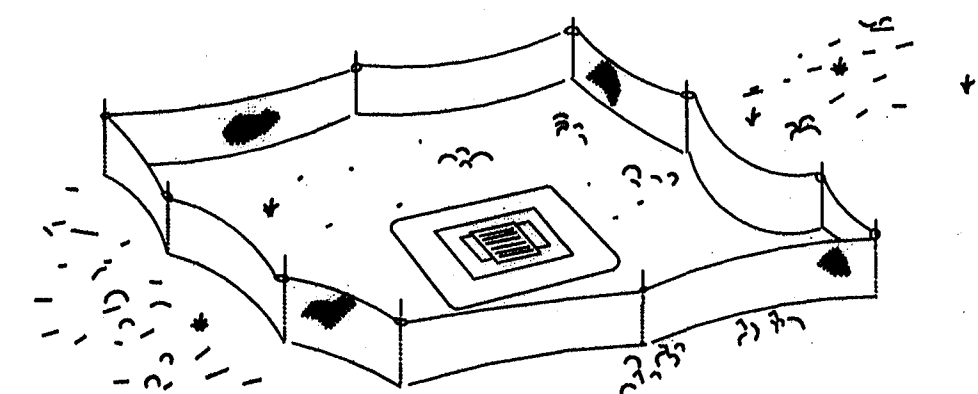

Type III Silt Fence Protection Around Ditch Bottom Inlets.


Do not deploy in a manner that silt fences will act as a dam across permanent flowing watercourses. Silt fences are to be used at upland locations and turbidity barriers used at permanent bodies of water.

SILT FENCE APPLICATIONS

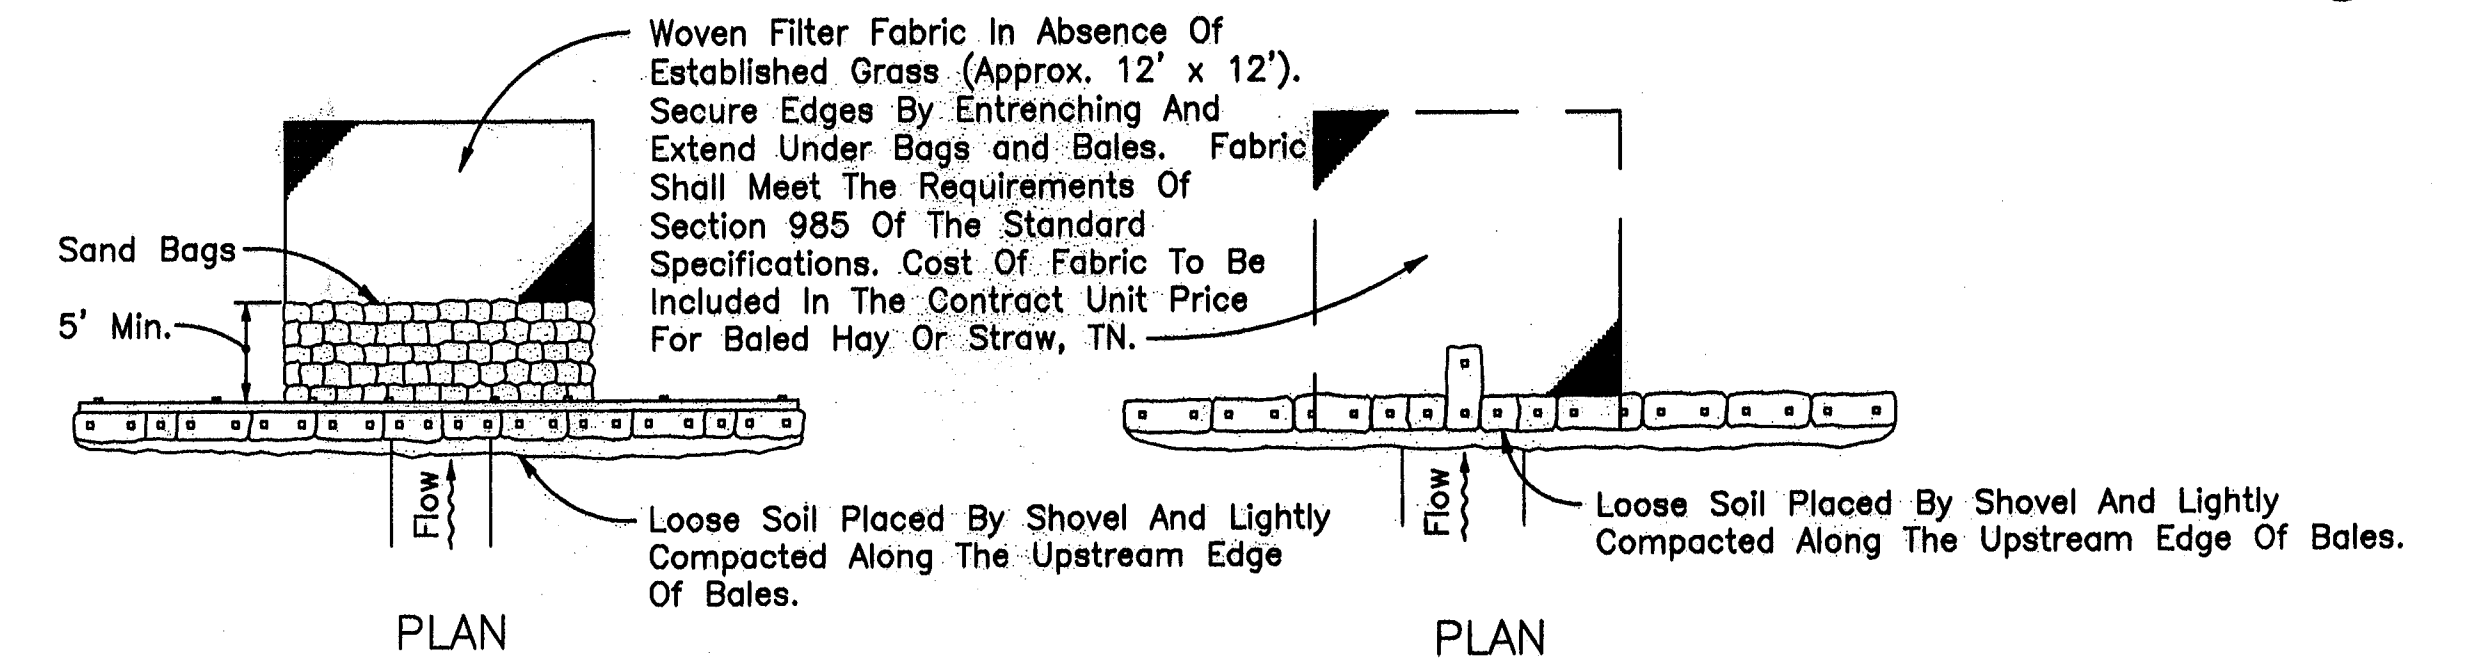

PLAN

PLAN

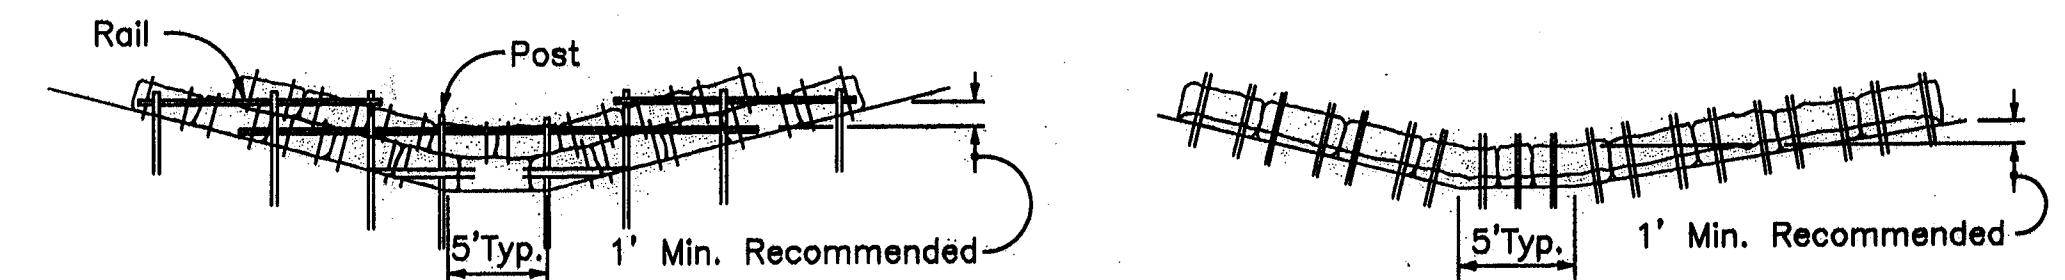

ELEVATION

ELEVATION

Application and Spacing: The use of Types I & II bale barriers should be limited to the conditions outlined in Chart I

TYPE II

TYPE I

BARRIER FOR UNPAVED DITCHES

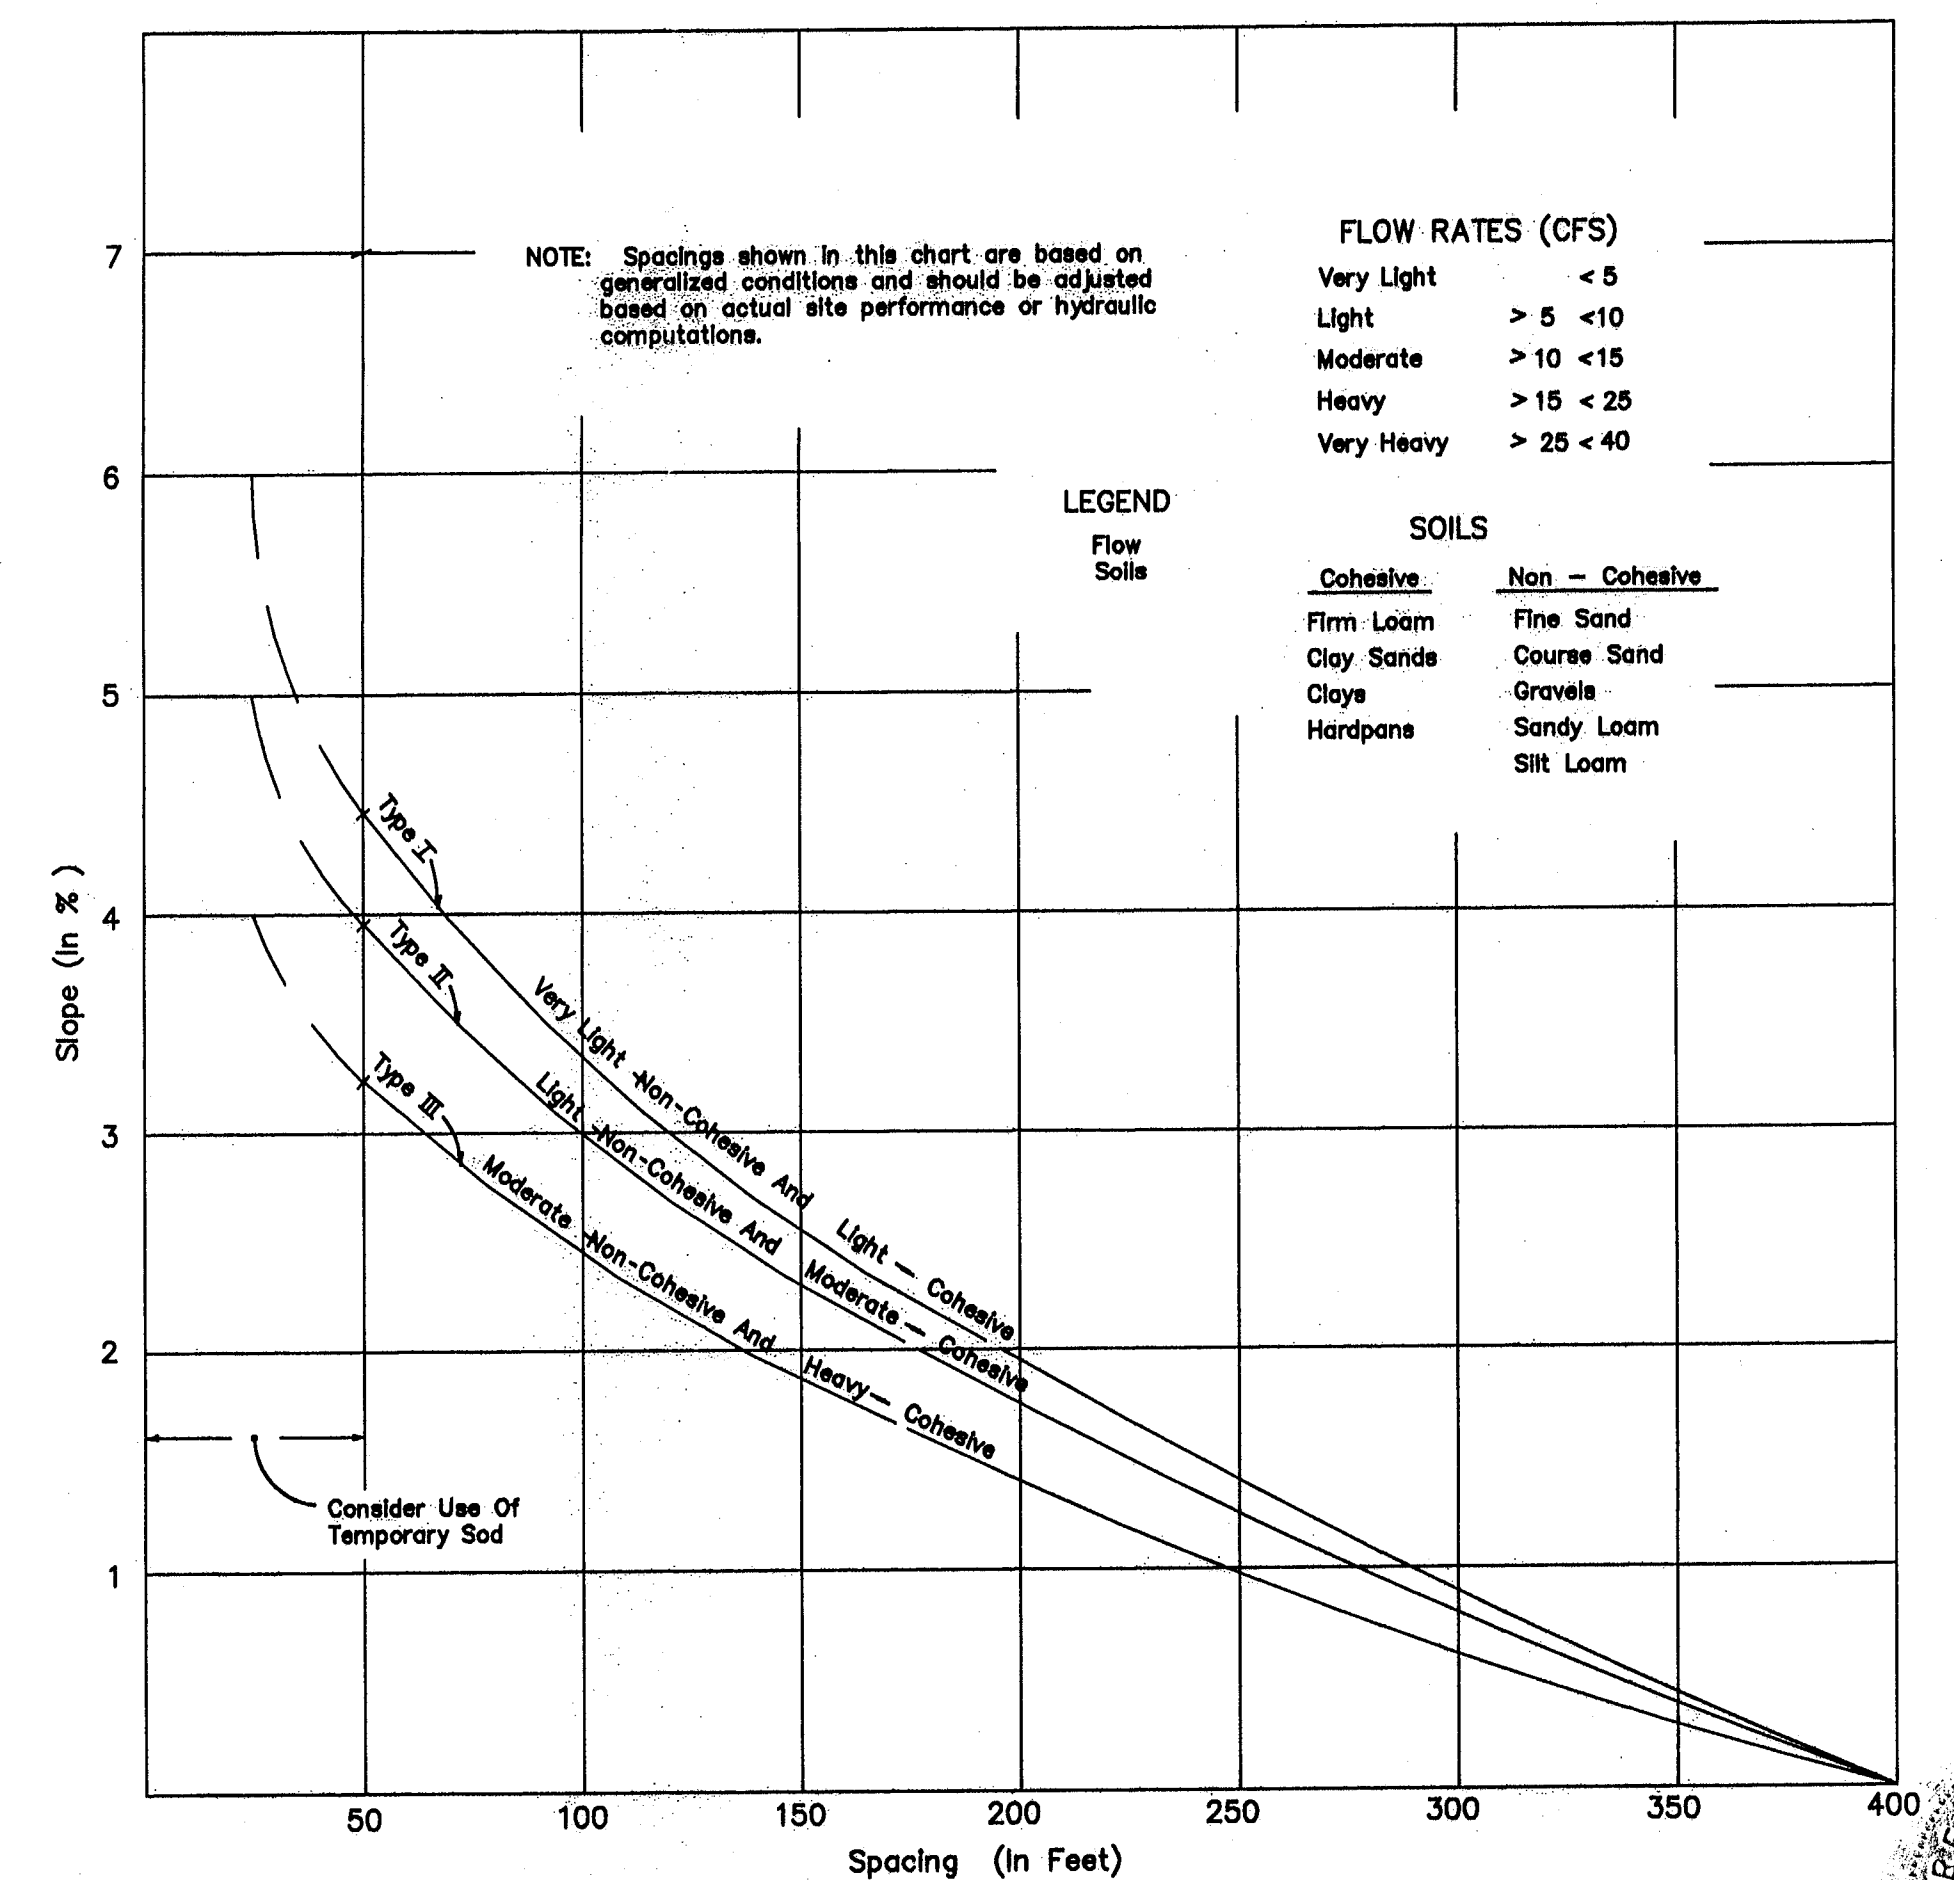


CHART I

RECOMMENDED SPACING FOR TYPE I AND TYPE II HAY BALE BARRIERS, AND TYPE III SILT FENCES




330 SOUTH PINEAPPLE AVE.
SUITE 113
SARASOTA, FLORIDA 34238
Ph. (941) 854-4038

PORT BUCKLEY, SCOTT & BROWN, INC. 3/01/01 PERM
2001 REG. 10770 AVENUE, TAMPA, FL 33622-2007
FLORIDA CERTIFICATE OF AUTHORIZATION NO. 24

CLIENT
MANATEE COUNTY
PROJECT MANAGEMENT
DEPARTMENT

1026 26TH AVENUE EAST
BRADENTON, FLORIDA 34210

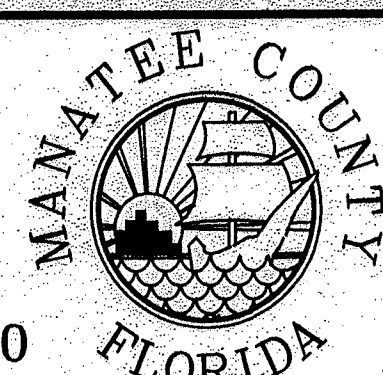

PROJECT

LENA ROAD LANDFILL LEACHATE
POND FACILITIES

TASK

EROSION CONTROL DETAILS

ORIGINAL:

REVISIONS:
1 REC DWG JAN/02

2
3
4
5

6

7

8

9

10

11

12

JOB NO. 120498.02

DRAWN MV


DESIGNED JME

CHECKED JME

QC DBR

SHEET 10



NOT VALID FOR CONSTRUCTION
UNLESS SIGNED IN THIS BLOCK

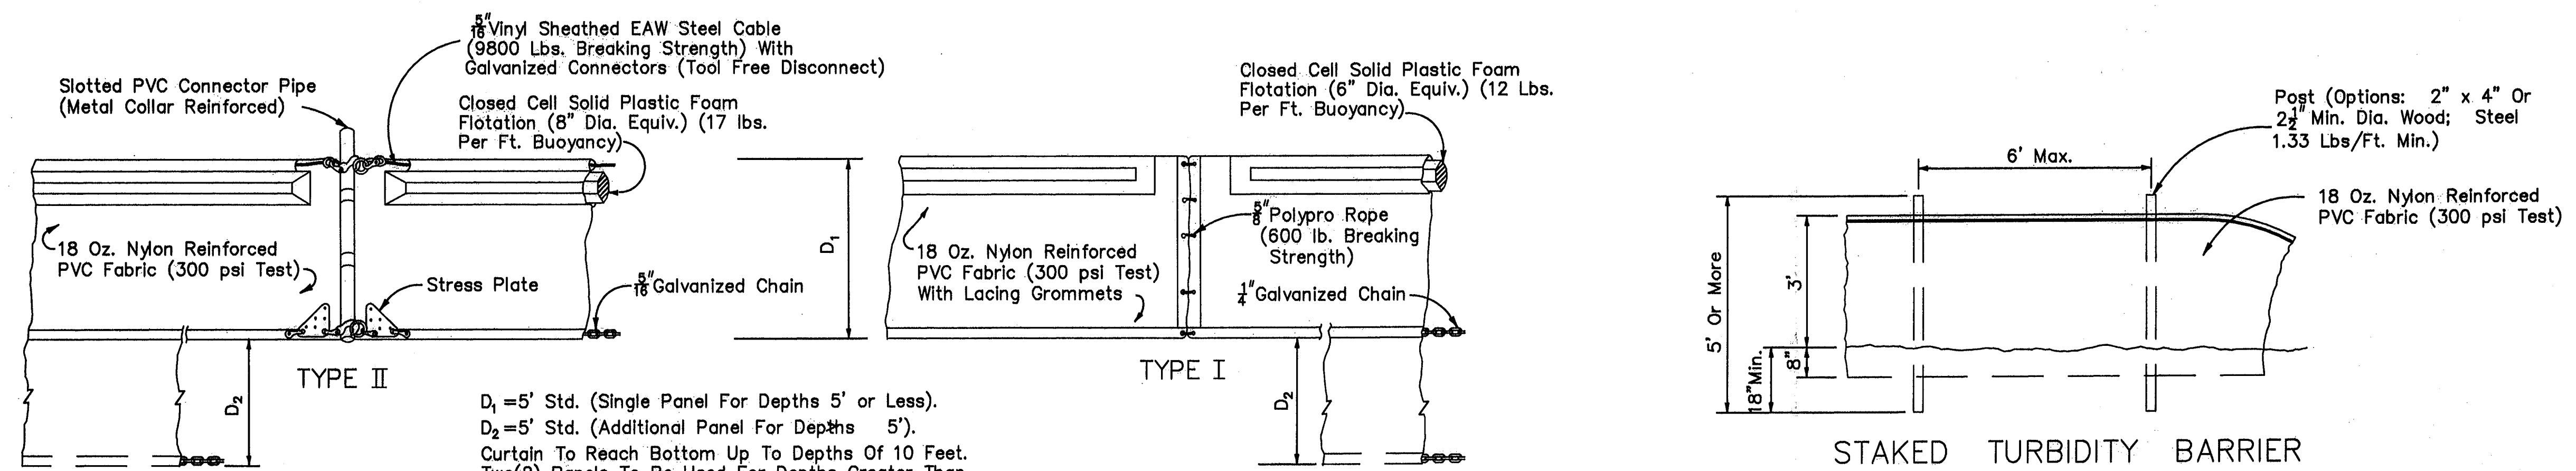

NOTICE: COMPONENTS OF TYPES I AND II MAY BE SIMILAR OR IDENTICAL TO PROPRIETARY DESIGNS. ANY INFRINGEMENT ON THE PROPRIETARY RIGHTS OF THE DESIGNER SHALL BE THE SOLE RESPONSIBILITY OF THE USER. SUBSTITUTIONS FOR TYPES I AND II SHALL BE AS APPROVED BY THE ENGINEER.

FLOATING TURBIDITY BARRIERS

- LEGEND
- Pile Locations
 - ▨ Dredge Or Fill Area
 - ⊖ Mooring Buoy w/Anchor
 - Anchor
 - Barrier Movement Due To Current Action

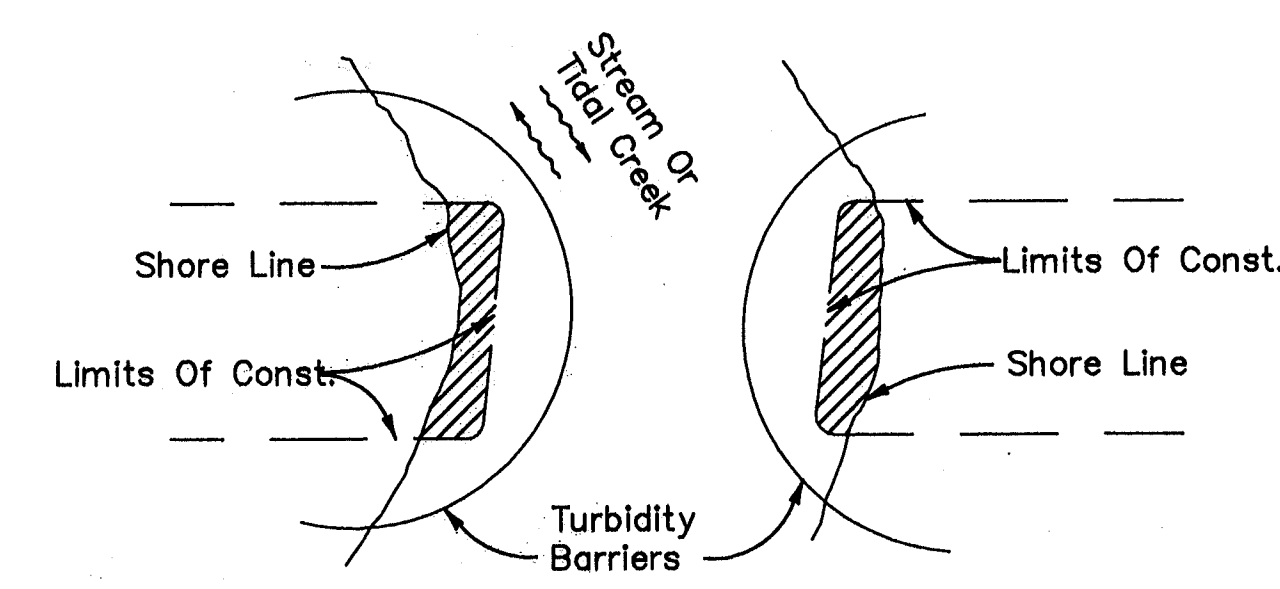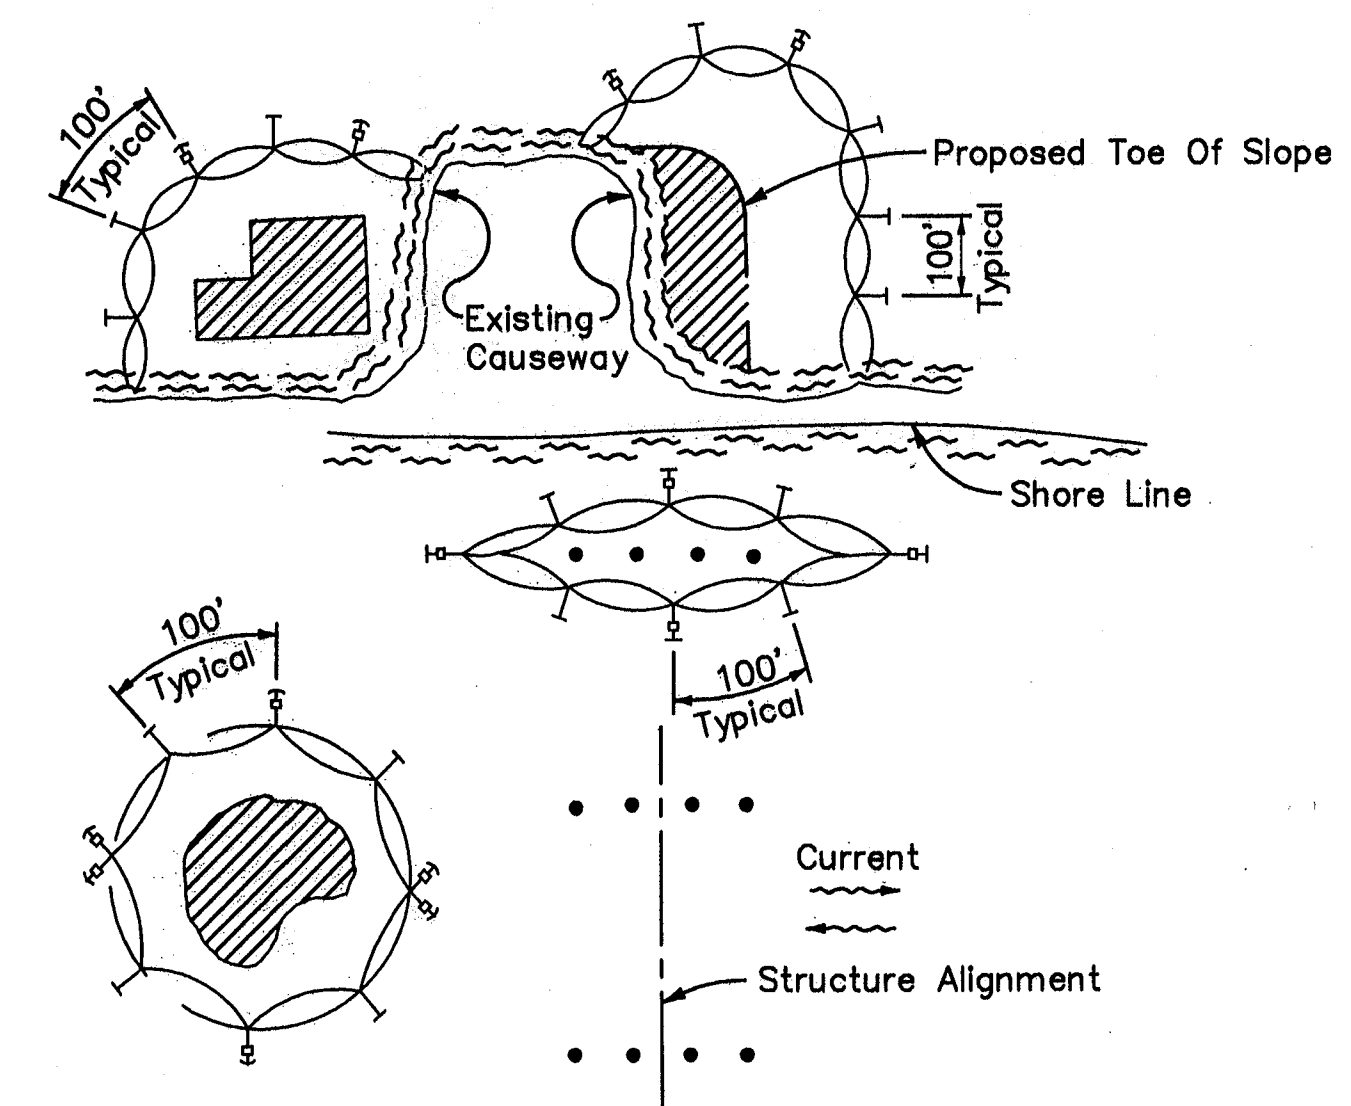

Note: Turbidity barriers for flowing streams and tidal creeks may be either floating, or staked types or any combinations of types that will suit site conditions and meet erosion control and water quality requirements. The barrier type(s) will be at the Contractors option unless otherwise specified in the plans, however payment will be under the pay item(s) established in the plans for Floating Turbidity Barrier and/or Staked Turbidity Barrier. Posts in staked turbidity barriers to be installed in vertical position unless otherwise directed by the Engineer.

- NOTES:
1. Turbidity barriers are to be used in all permanent bodies of water regardless of water depth.
 2. Number and spacing of anchors dependent on current velocities.
 3. Deployment of barrier around pile locations may vary to accommodate construction operations.
 4. Navigation may require segmenting barrier during construction operations.
 5. For additional information see Section 104 of the Standard Specifications.


TURBIDITY BARRIER APPLICATIONS

PROFESSIONAL ENGINEER
STATE OF FLORIDA
11/29/02
120498.02

"RECORD DRAWING"
INCORPORATING THOSE CHANGES MADE
DURING CONSTRUCTION BASED ON DATA
FURNISHED BY THE CONTRACTOR TO THE
ENGINEER.

PBS&J
330 SOUTH PINEAPPLE AVE.
SUITE 113
SARASOTA, FLORIDA 34236
Ph. (941) 854-4036
POST, REPLY, SCAN & E-MAIL: P.B.S. & J. FROM
2001 N.W. 107TH AVENUE, MIAMI, FL 33172-2507
FIRM CERTIFICATE OF AUTHORIZATION NO. 24

CLIENT
**MANATEE COUNTY
PROJECT MANAGEMENT
DEPARTMENT**
1026 26TH AVENUE EAST
BRADENTON, FLORIDA 34210

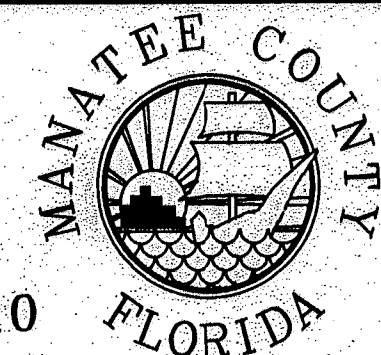

PROJECT
**LENA ROAD LANDFILL LEACHATE
POND FACILITIES**


TASK
EROSION CONTROL DETAILS

ORIGINAL:
REVISIONS:
1 REC. DWG. JAN/02
2
3
4
5





6
7
8
9
10
11
12

NOT VALID FOR CONSTRUCTION
UNLESS SIGNED IN THIS BLOCK



JOB NO. 120498.02
DRAWN MV
DESIGNED JME
CHECKED JME
QC DBR
SHEET 11

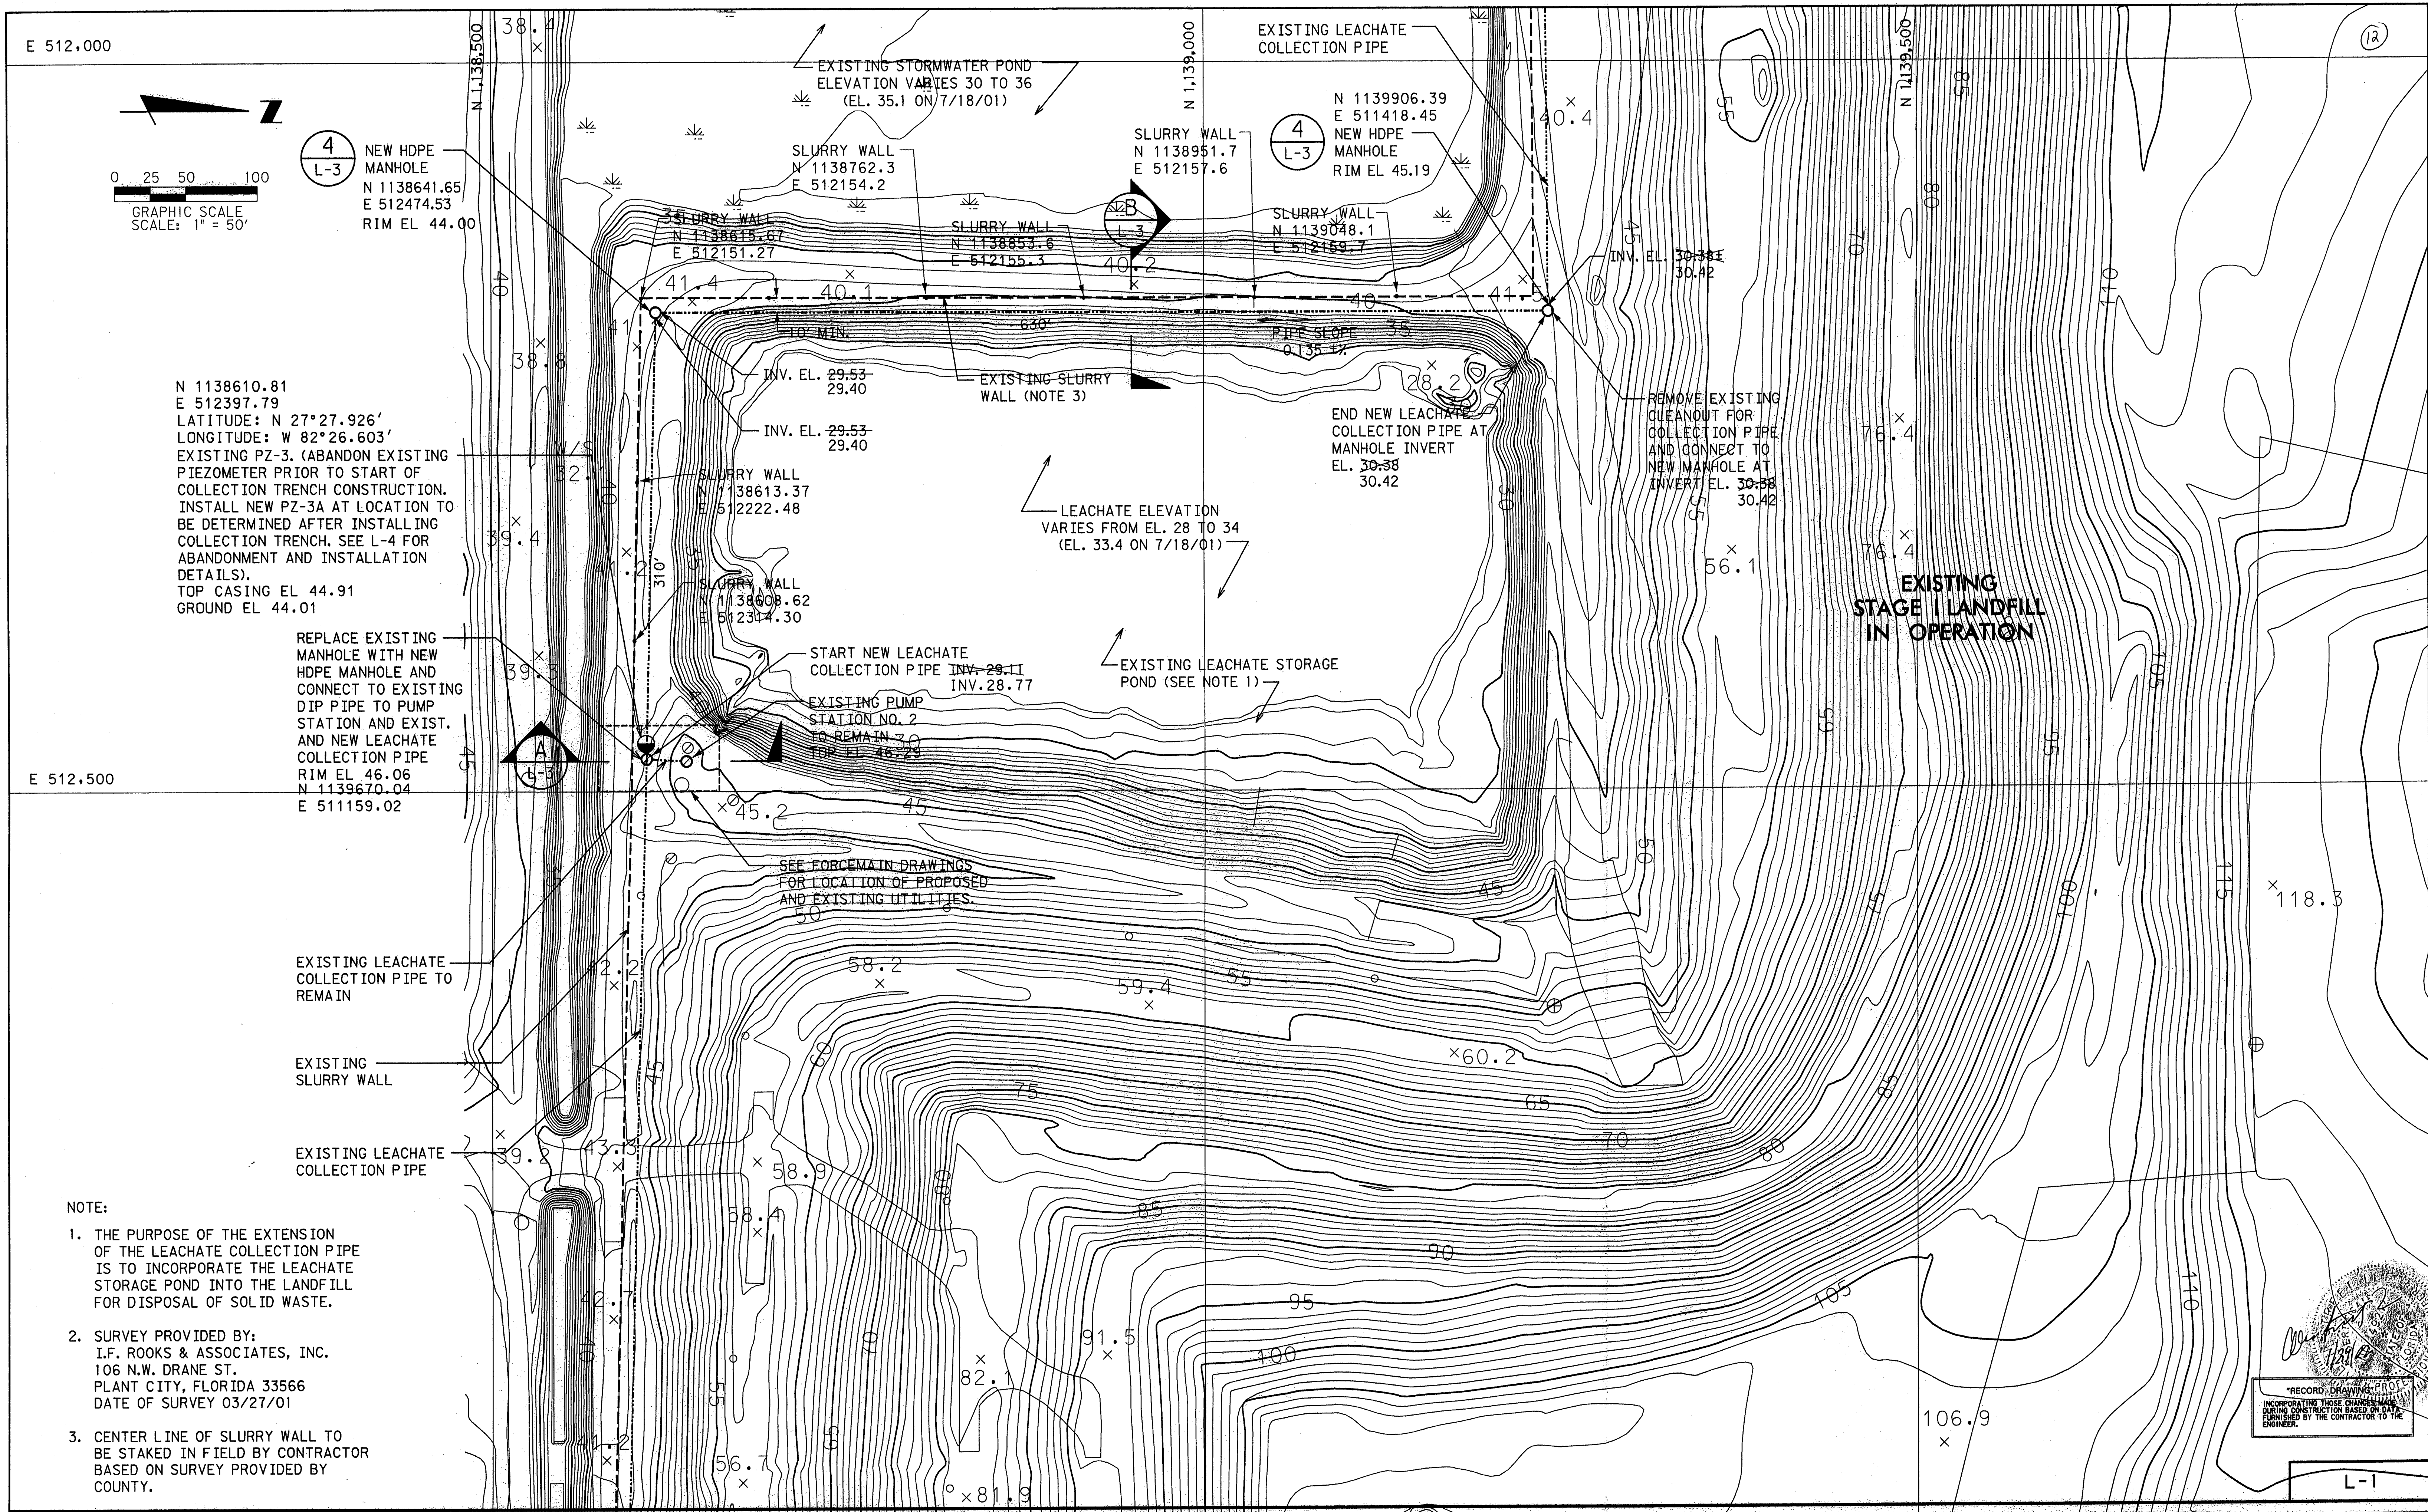


PBS&J 330 SOUTH PINEAPPLE AVE. SUITE 113 SARASOTA, FLORIDA 34236 Ph. (941) 954-4036	CLIENT MANATEE COUNTY PROJECT MANAGEMENT DEPARTMENT 1026 26th AVENUE EAST BRADENTON, FLORIDA 34208	PROJECT LENA ROAD LANDFILL CONSTRUCTION PERMIT MODIFICATIONS	TASK LEACHATE COLLECTION SYSTEM EXTENSION AT LEACHATE STORAGE POND PLAN	ORIGINAL: AUG. 2001	6	Name: JOSEPH L. MILLER Florida P.E. No.: 89177 Address: PBS&J 465 S. Keller Road Orlando, FL 32810-6101 Signature _____ Date _____ NOT VALID FOR CONSTRUCTION UNLESS SIGNED IN THIS BLOCK	JOB NO. 00-000.00 DRAWN RGC DESIGNED JLM/RGC CHECKED JLM QC DED
				REVISIONS: 1. ADDED PZ-3 (9/10/01)	7		
				2. REC. DWG JAN/02	8		
				3. _____	9		
				4. _____	10		SHEET /
				5. _____	11		
					12		

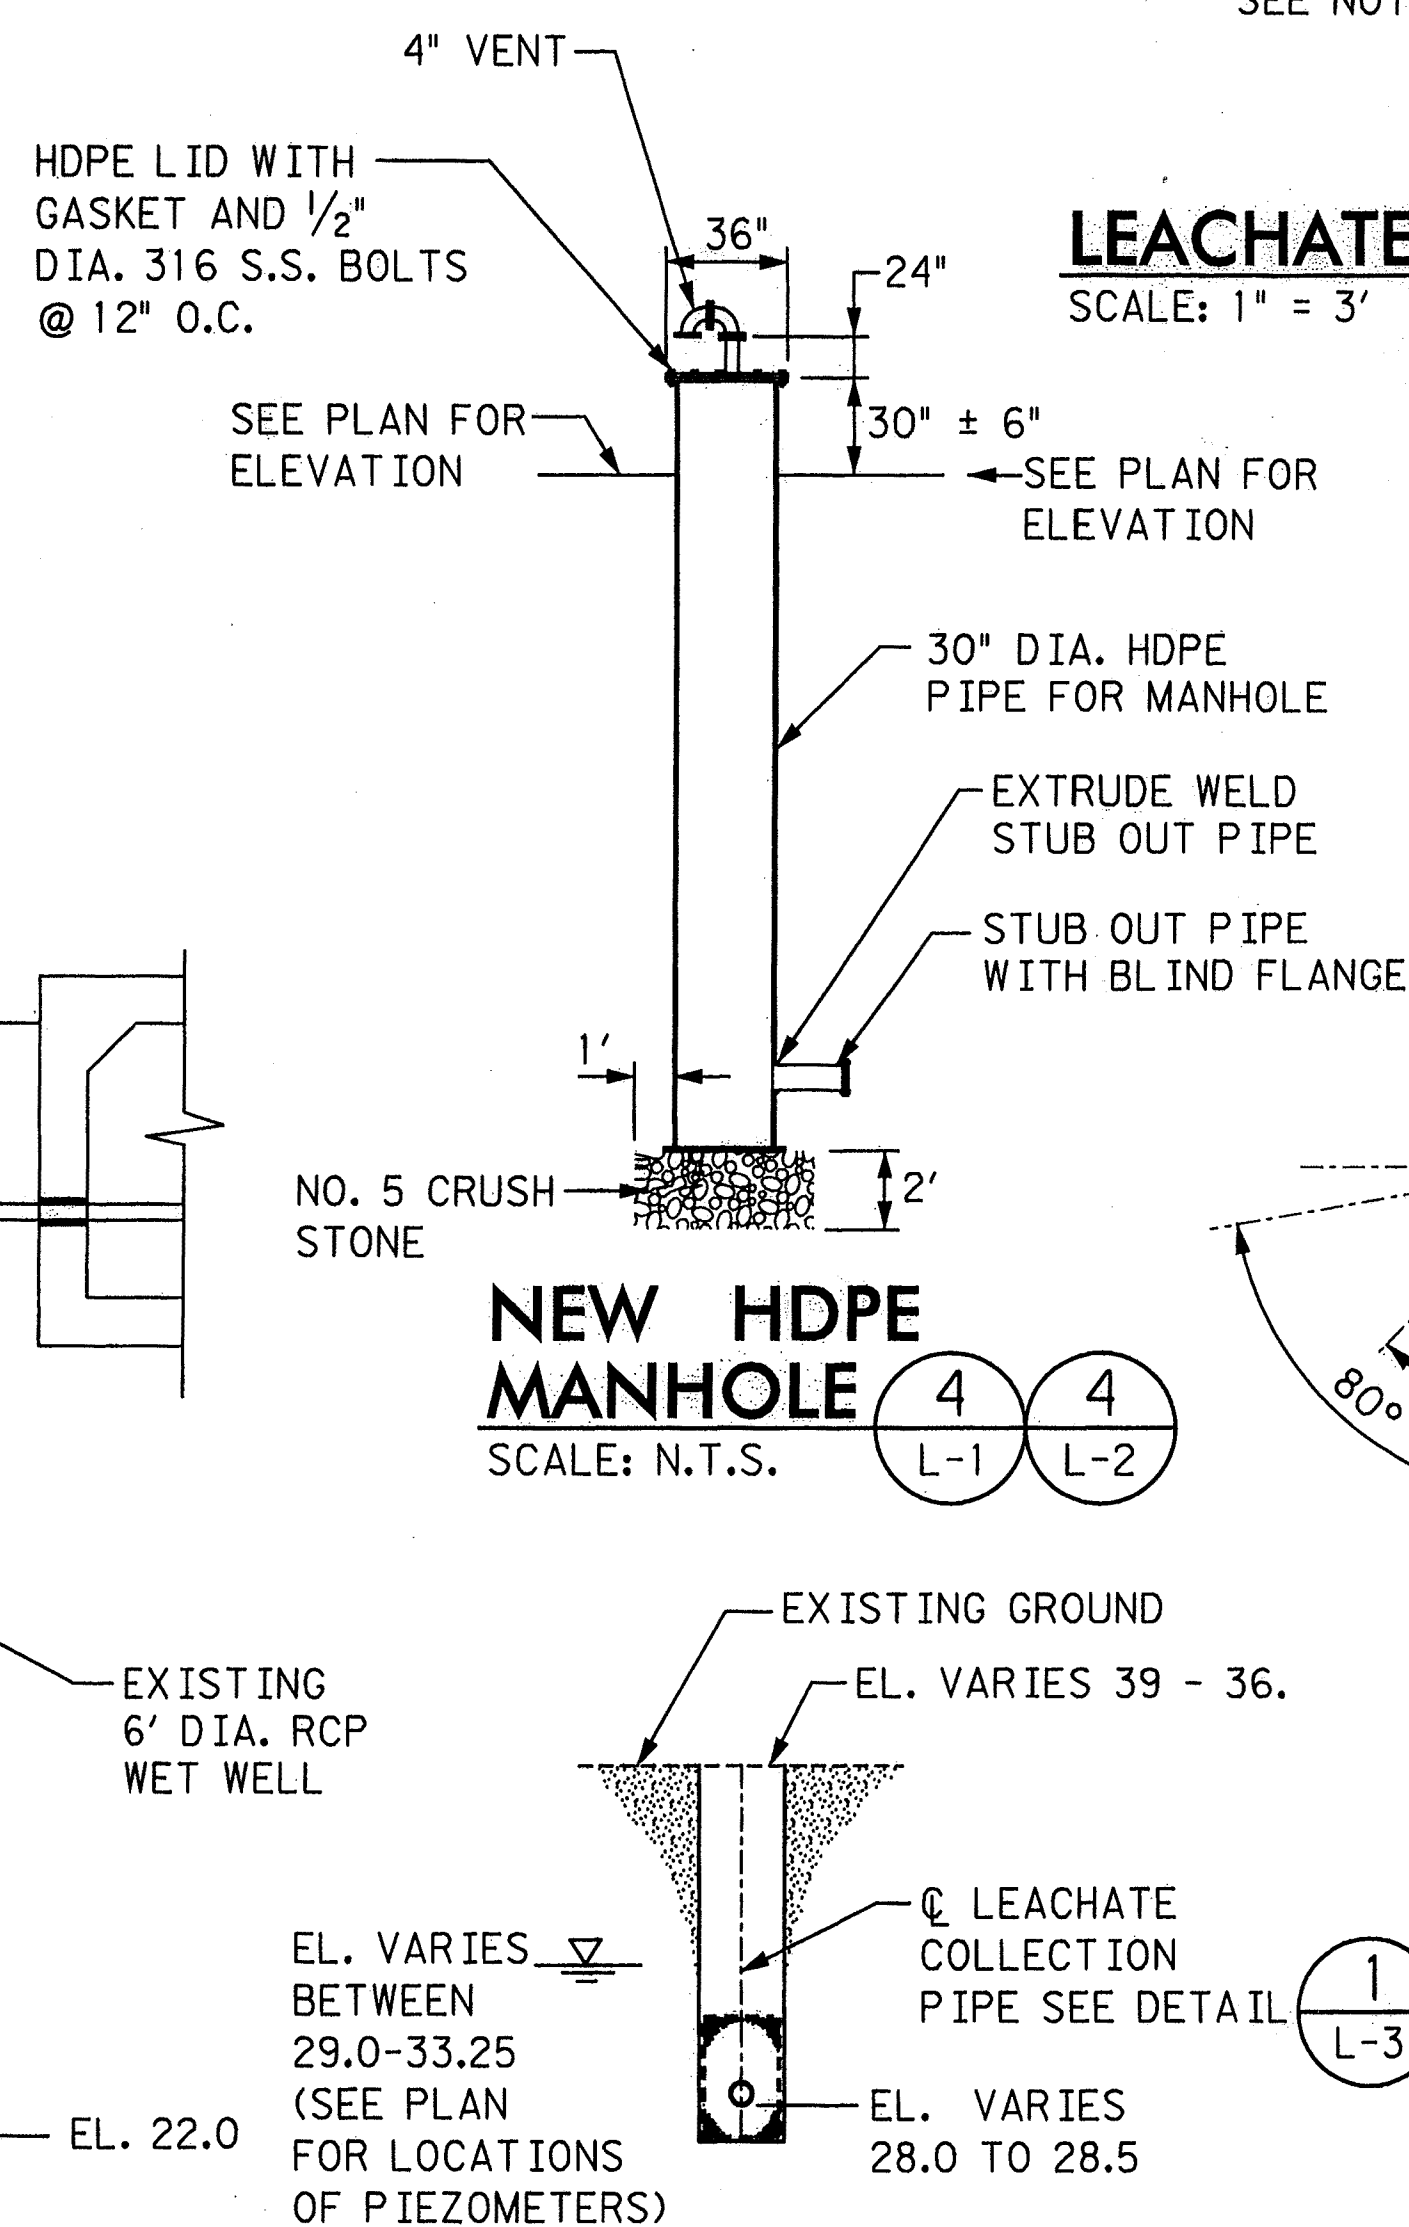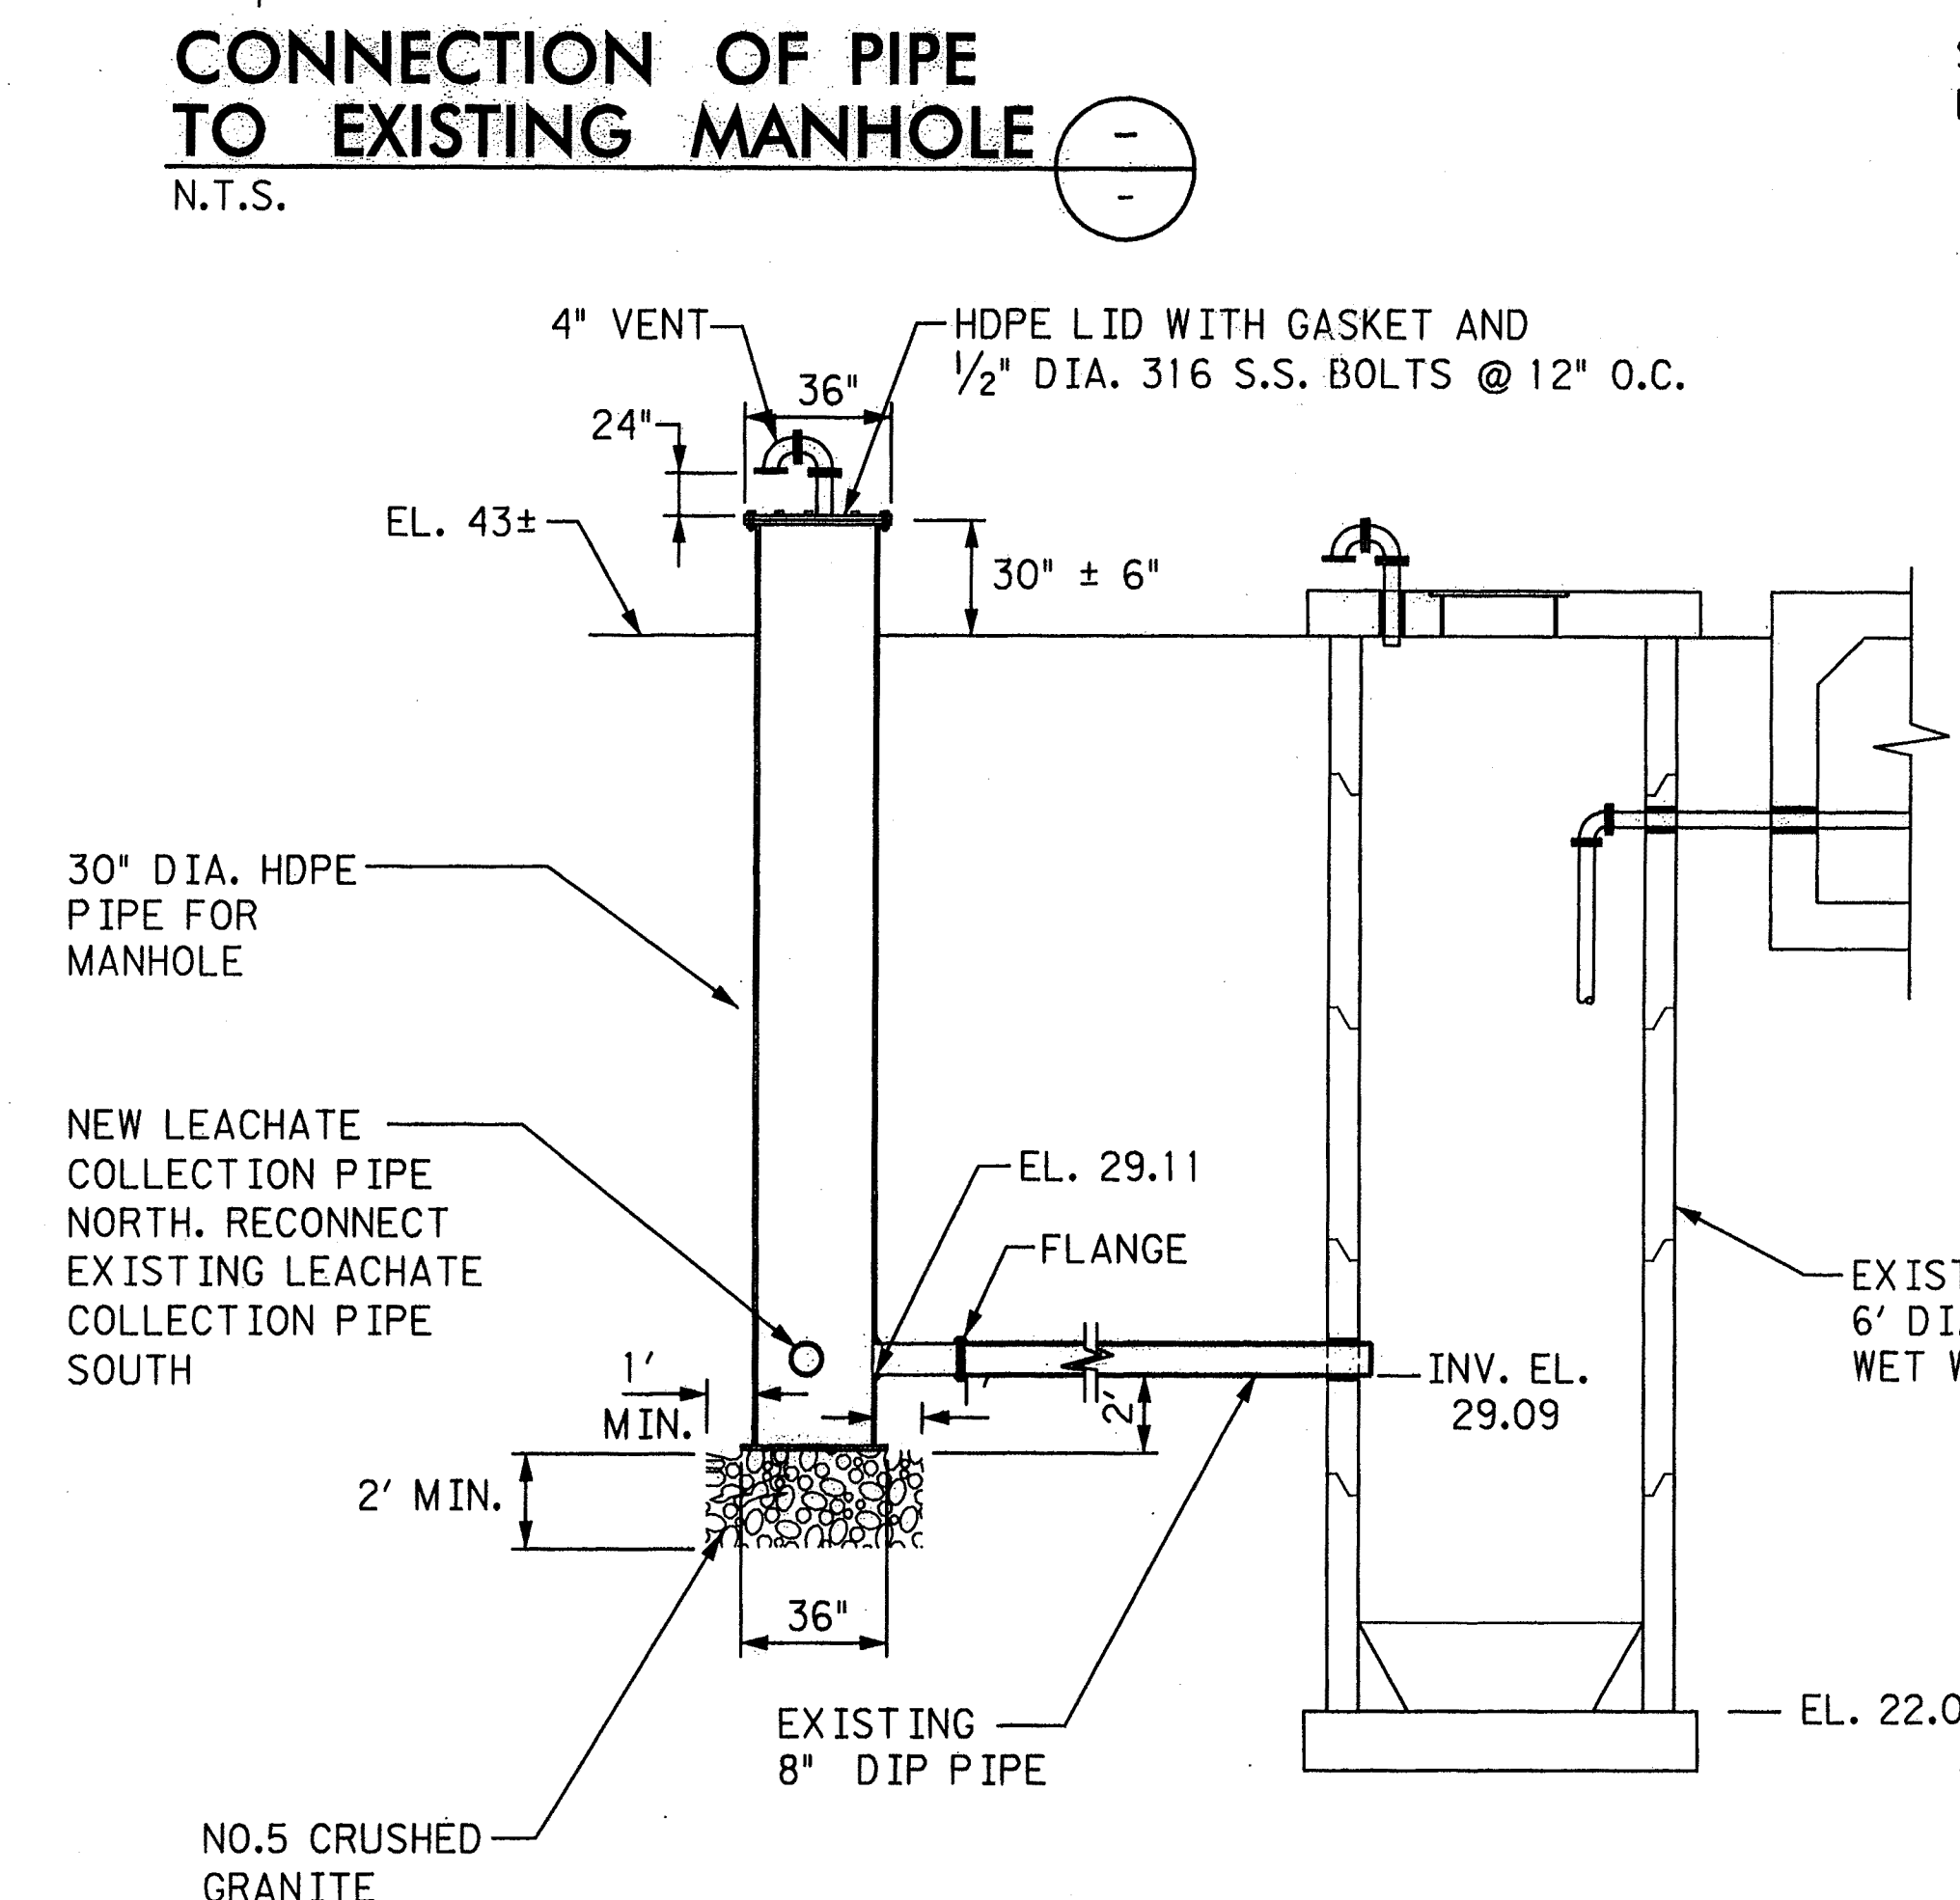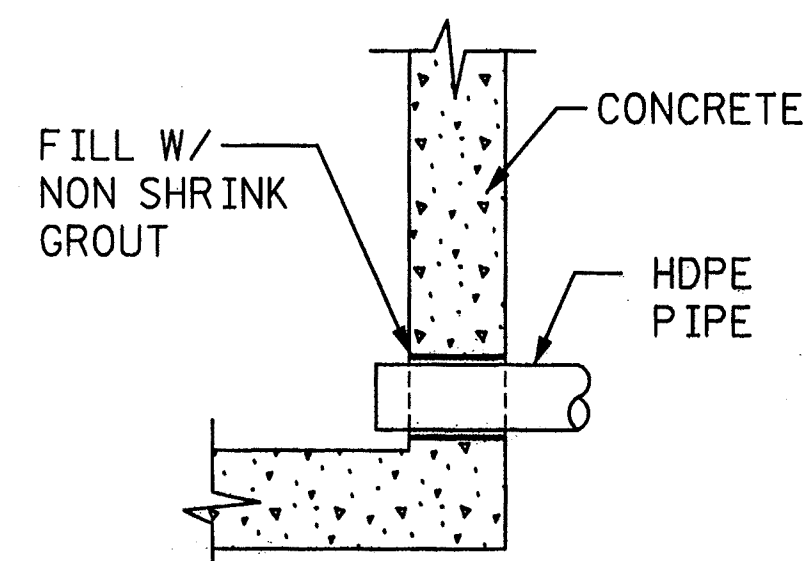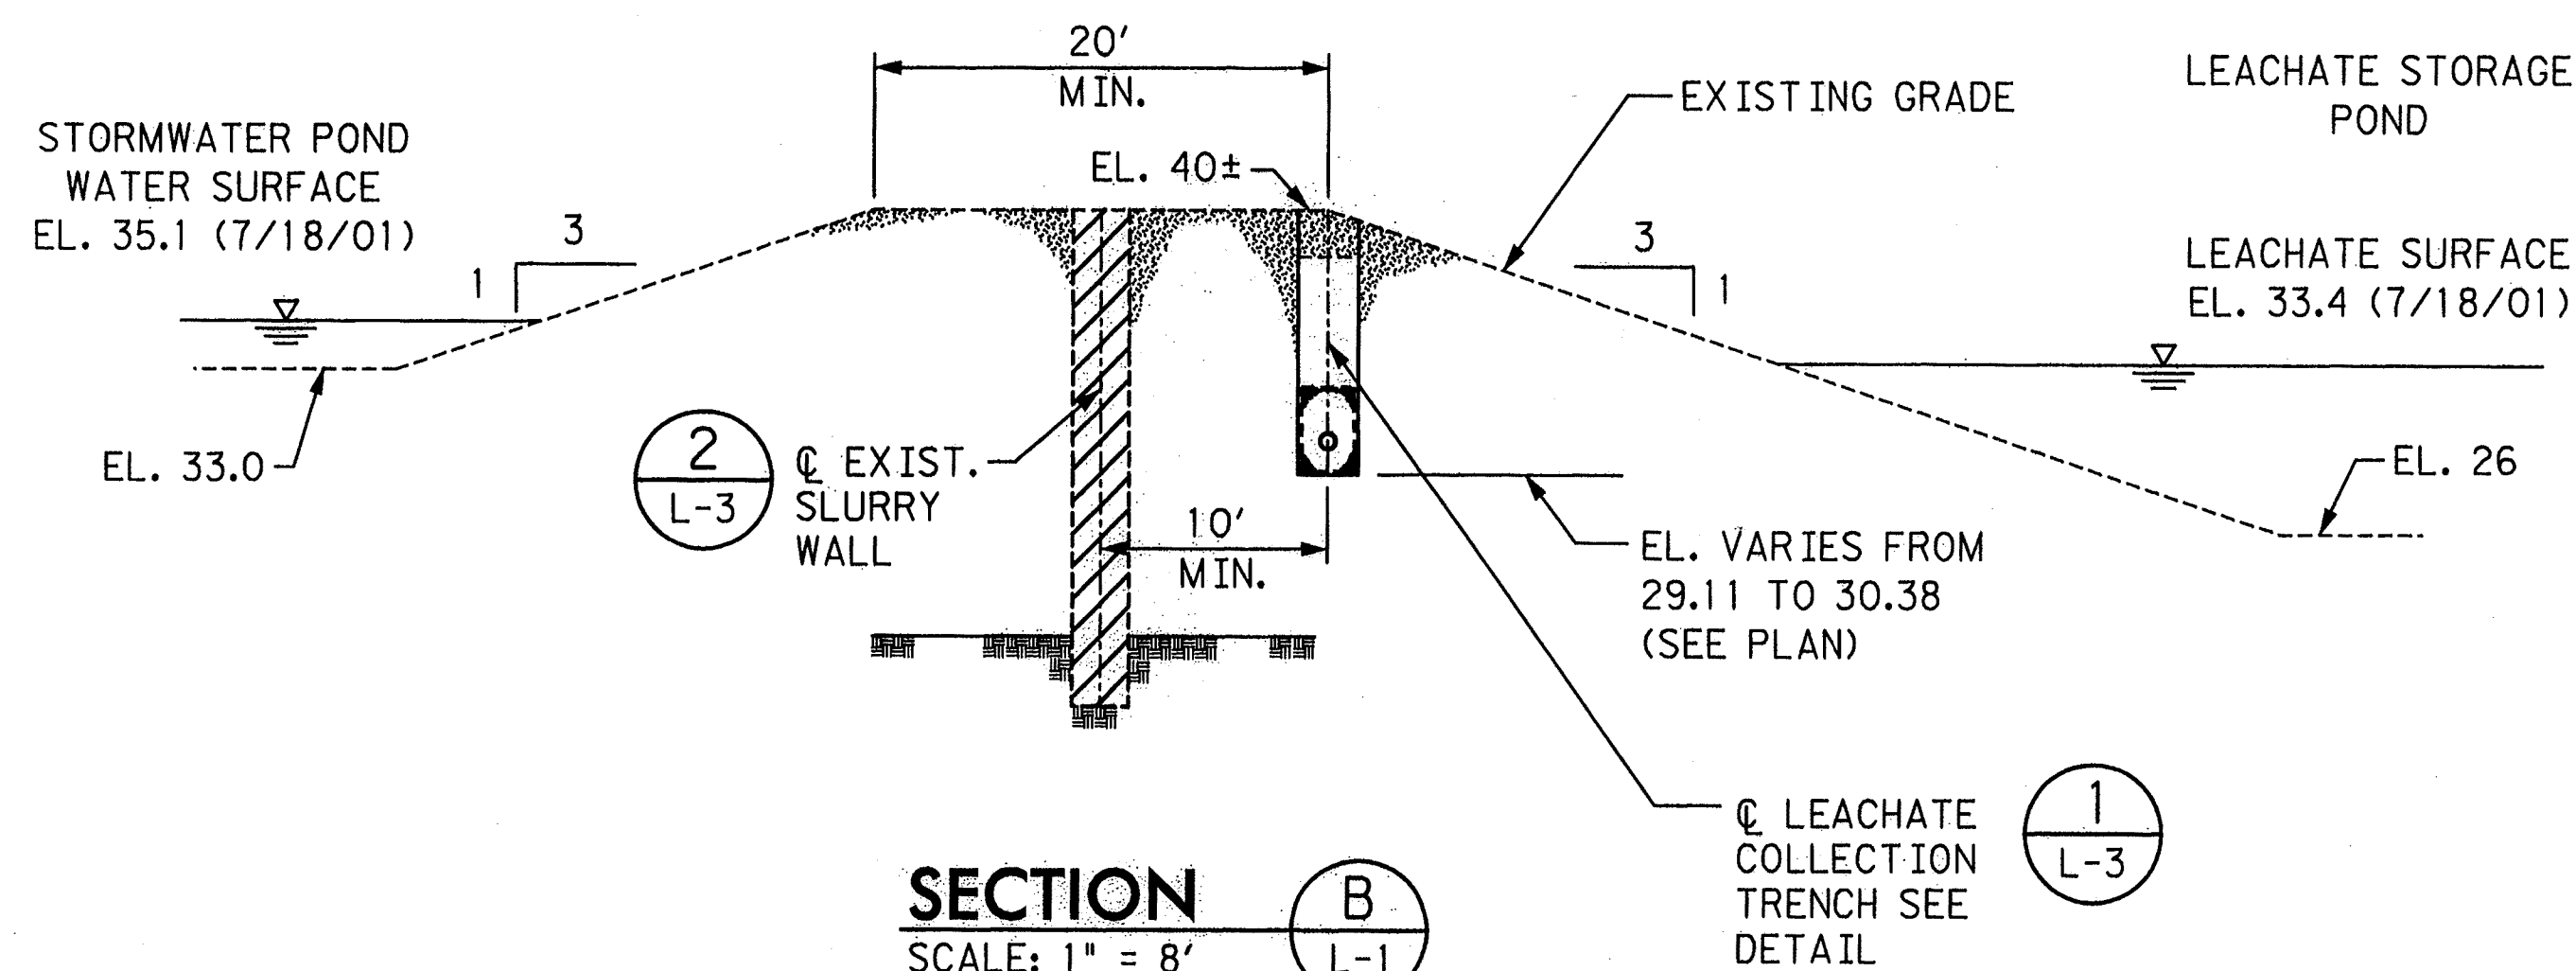

SECTION C
SCALE: N.T.S.

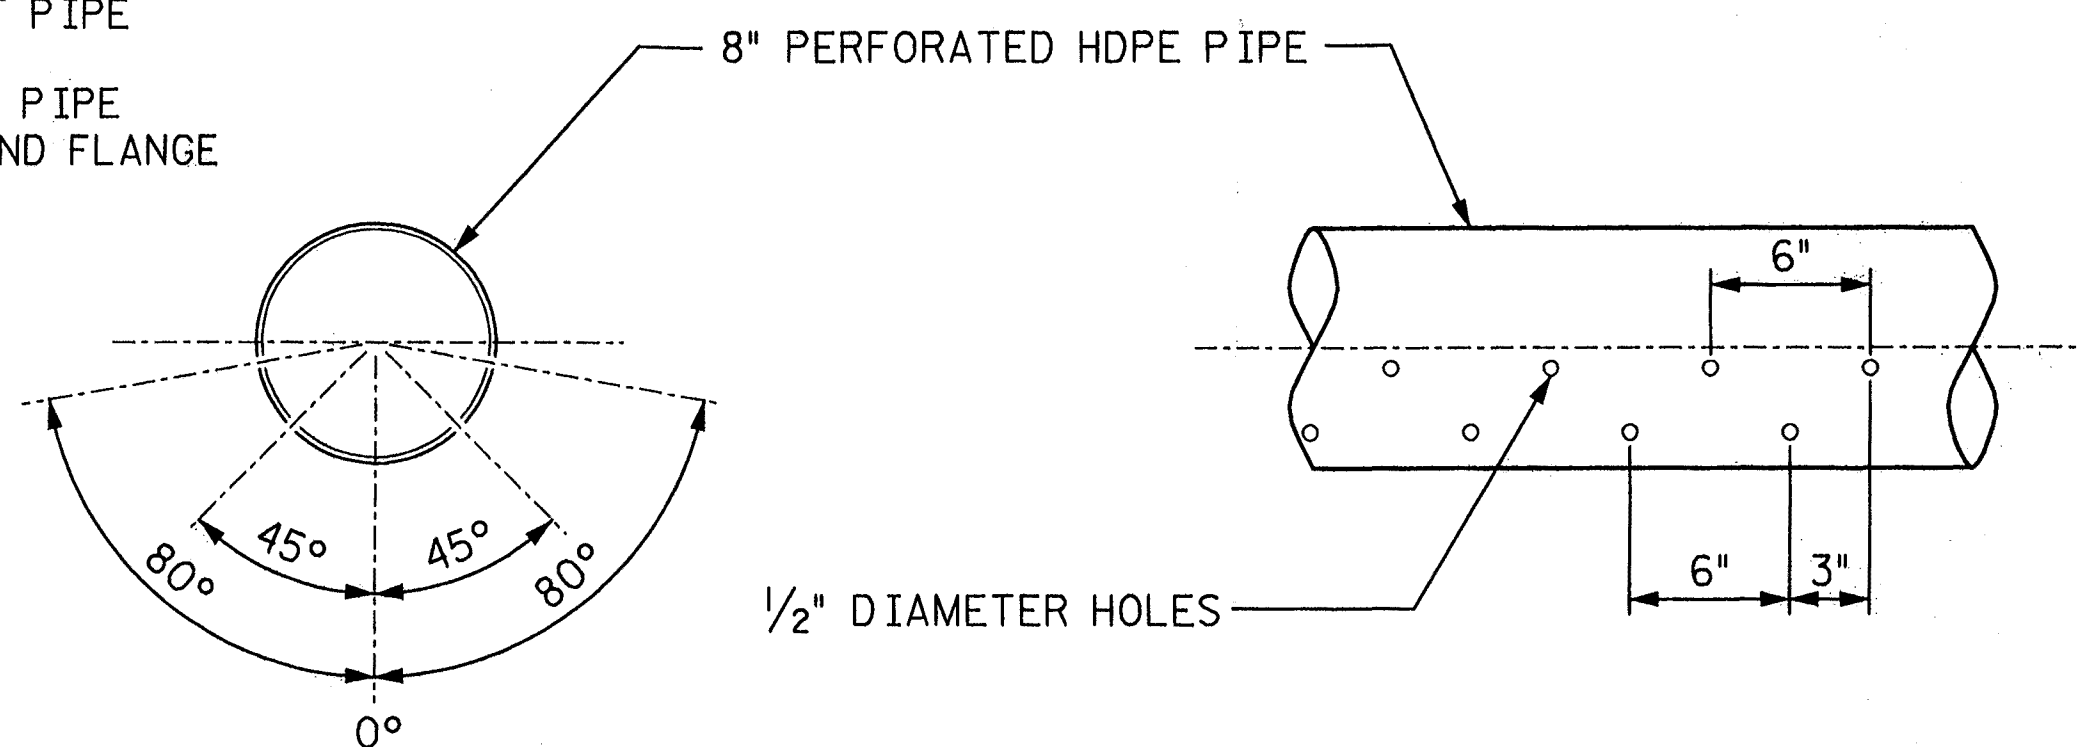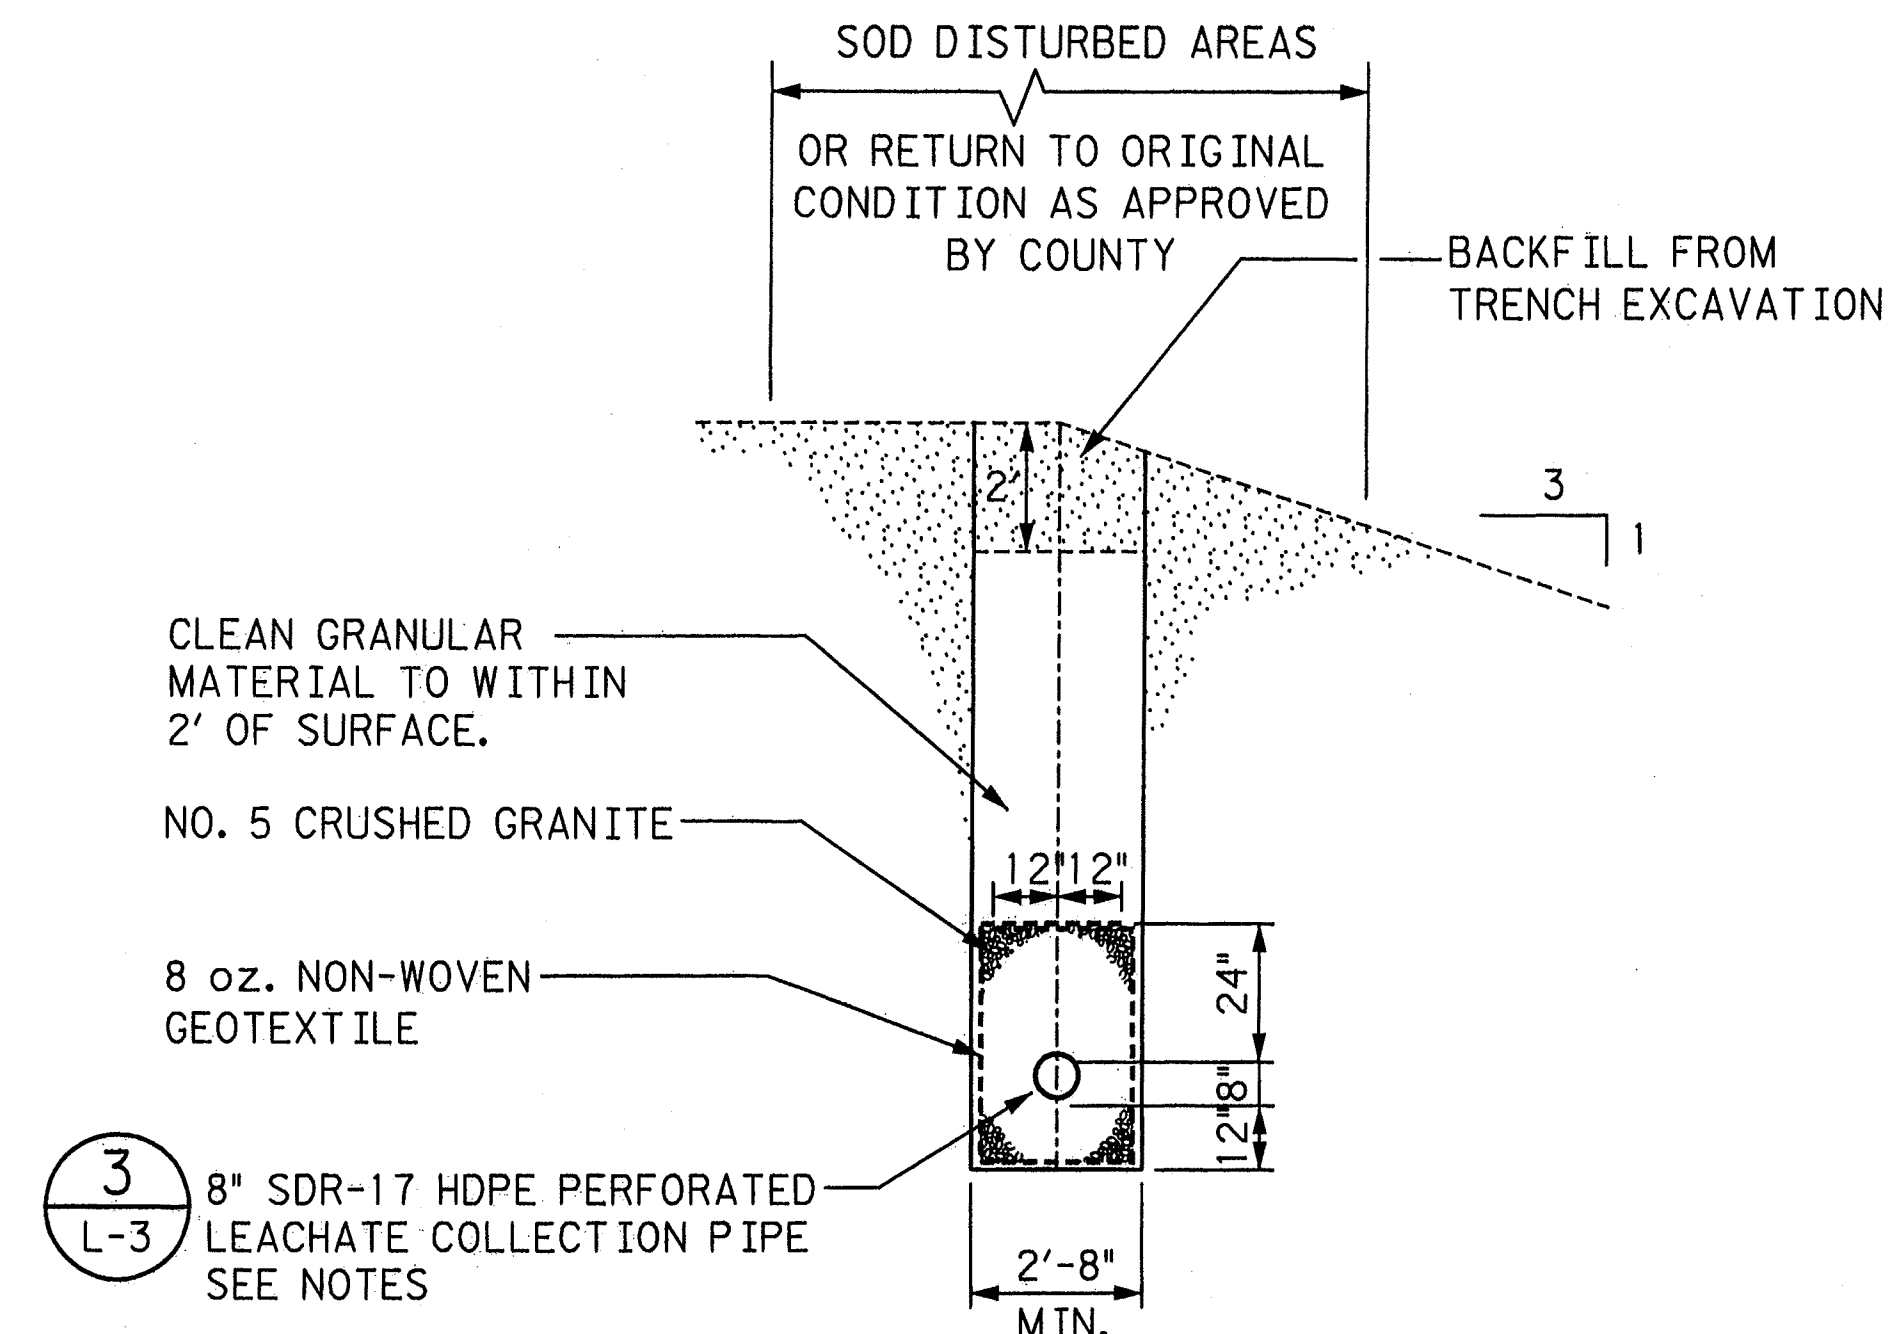

- NOTES:
- 0° CORRESPONDS TO PIPE INVERT.
 - PROVIDE FOUR 1/2" DIAMETER PERFORATIONS AS SHOWN; 6" O.C.

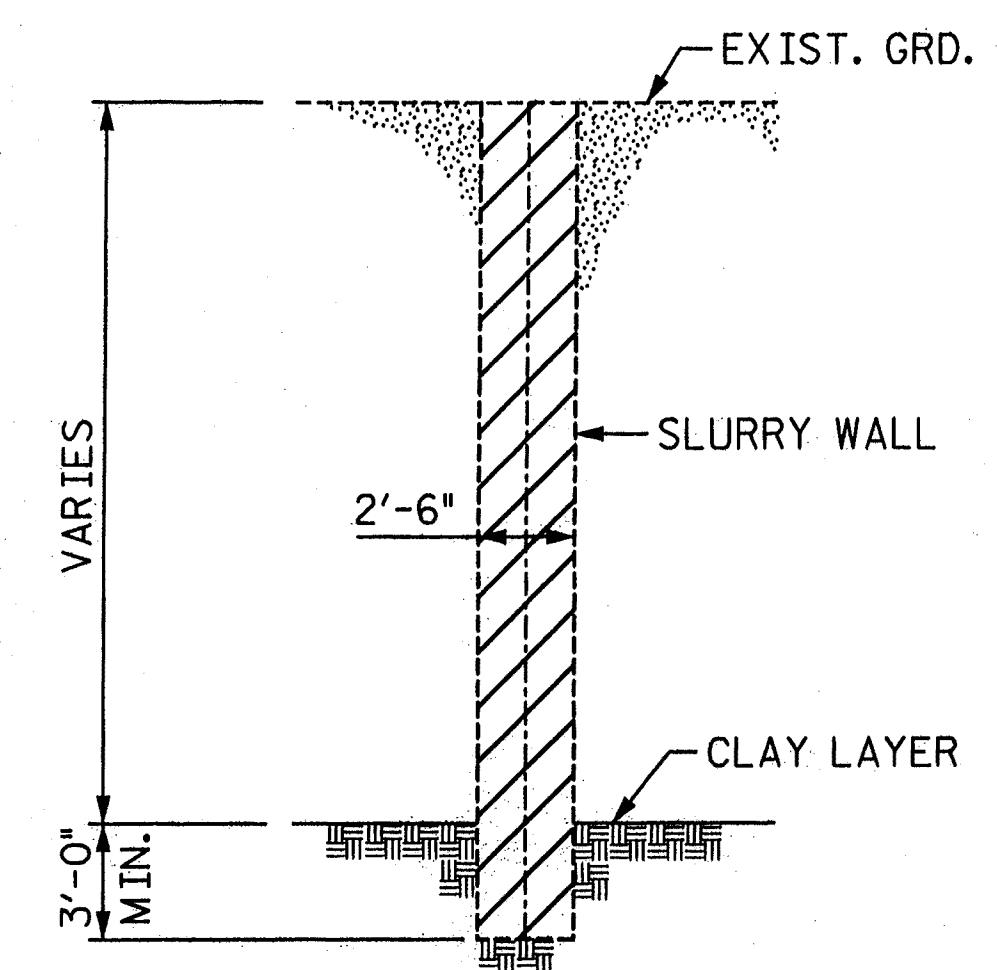

EXISTING SLURRY WALL DETAIL
SCALE: 1" = 5'

NOTES:

SPECIFICATIONS FOR PIPE:
HIGH DENSITY POLYETHYLENE PIPE

- THE POLYETHYLENE PIPE SHALL BE HIGH PERFORMANCE, HIGH MOLECULAR WEIGHT, HIGH DENSITY POLYETHYLENE PIPE, CONFORMING TO ASTM D 1248 (TYPE III, CLASS C, CATEGORY 5, GRADE P34). MINIMUM CELL CLASSIFICATION VALUE SHALL BE 345434C AS REFERENCED IN ASTM D 3350. THE MATERIAL DESIGNATION IS PE 3408. THE PIPE SHALL CONTAIN 2 PERCENT CARBON BLACK. THE PIPE SHALL BE DRISCOPIPE 1000 (PE 3404) POLYETHYLENE PIPE RESIN AS MANUFACTURED BY PHILLIPS DRISCOPIPE, INC., RICHARDSON, TEXAS; PLEXICO, FRANKLIN PARK, ILL.; POLY PIPE INDUSTRIES, INC., GAINSVILLE, TEXAS; OR EQUAL.
- FITTINGS SHALL BE BUTT FUSION TYPE OR APPROVED EQUAL, MEETING THE REQUIREMENTS OF ASTM D-3261. ALL FITTINGS SHALL BE PRESSURE RATED TO MATCH THE SYSTEM PIPING TO WHICH THEY ARE FUSED. AT THE POINT OF FUSION, THE OUTSIDE DIAMETER AND MINIMUM WALL THICKNESS SHALL MEET THE OUTSIDE DIAMETER AND MINIMUM WALL THICKNESS SPECIFICATIONS OF ASTM F-714 FOR THE SAME SIZE OF PIPE. PIPE CONNECTIONS BETWEEN DISSIMILAR MATERIALS SHALL BE JOINED BY STUB END AND BACKING FLANGE.
- CONTRACTOR SHALL TV ALL PIPES AND PROVIDE VIDEO AND REPORT TO COUNTY AS PROOF OF PROPER INSTALLATION.



330 SOUTH PINEAPPLE AVE.
SUITE 113
SARASOTA, FLORIDA 34236
Ph. (941) 954-4036

CLIENT

MANATEE COUNTY
PROJECT MANAGEMENT
DEPARTMENT

1026 26th AVENUE EAST
BRADENTON, FLORIDA 34208



PROJECT

LENA ROAD LANDFILL
CONSTRUCTION PERMIT
MODIFICATIONS

TASK

LEACHATE COLLECTION SYSTEM
SECTIONS AND DETAILS

ORIGINAL: AUG. 2001

REVISIONS:

1 REC DWG JAN/02
2
3
4
5

6

7

8

9


10

11

12

Name: JOSEPH L. MILLER
Florida P.E. No.: 39177
Address: PBS&J
489 S. Keller Road
Orlando, FL 32810-6101
Signature: _____ Date: _____
NOT VALID FOR CONSTRUCTION
UNLESS SIGNED IN THIS BLOCK

JOB NO. 00-000.00
DRAWN RGC
DESIGNED JLM/RGC
CHECKED JLM
QC DED
SHEET /

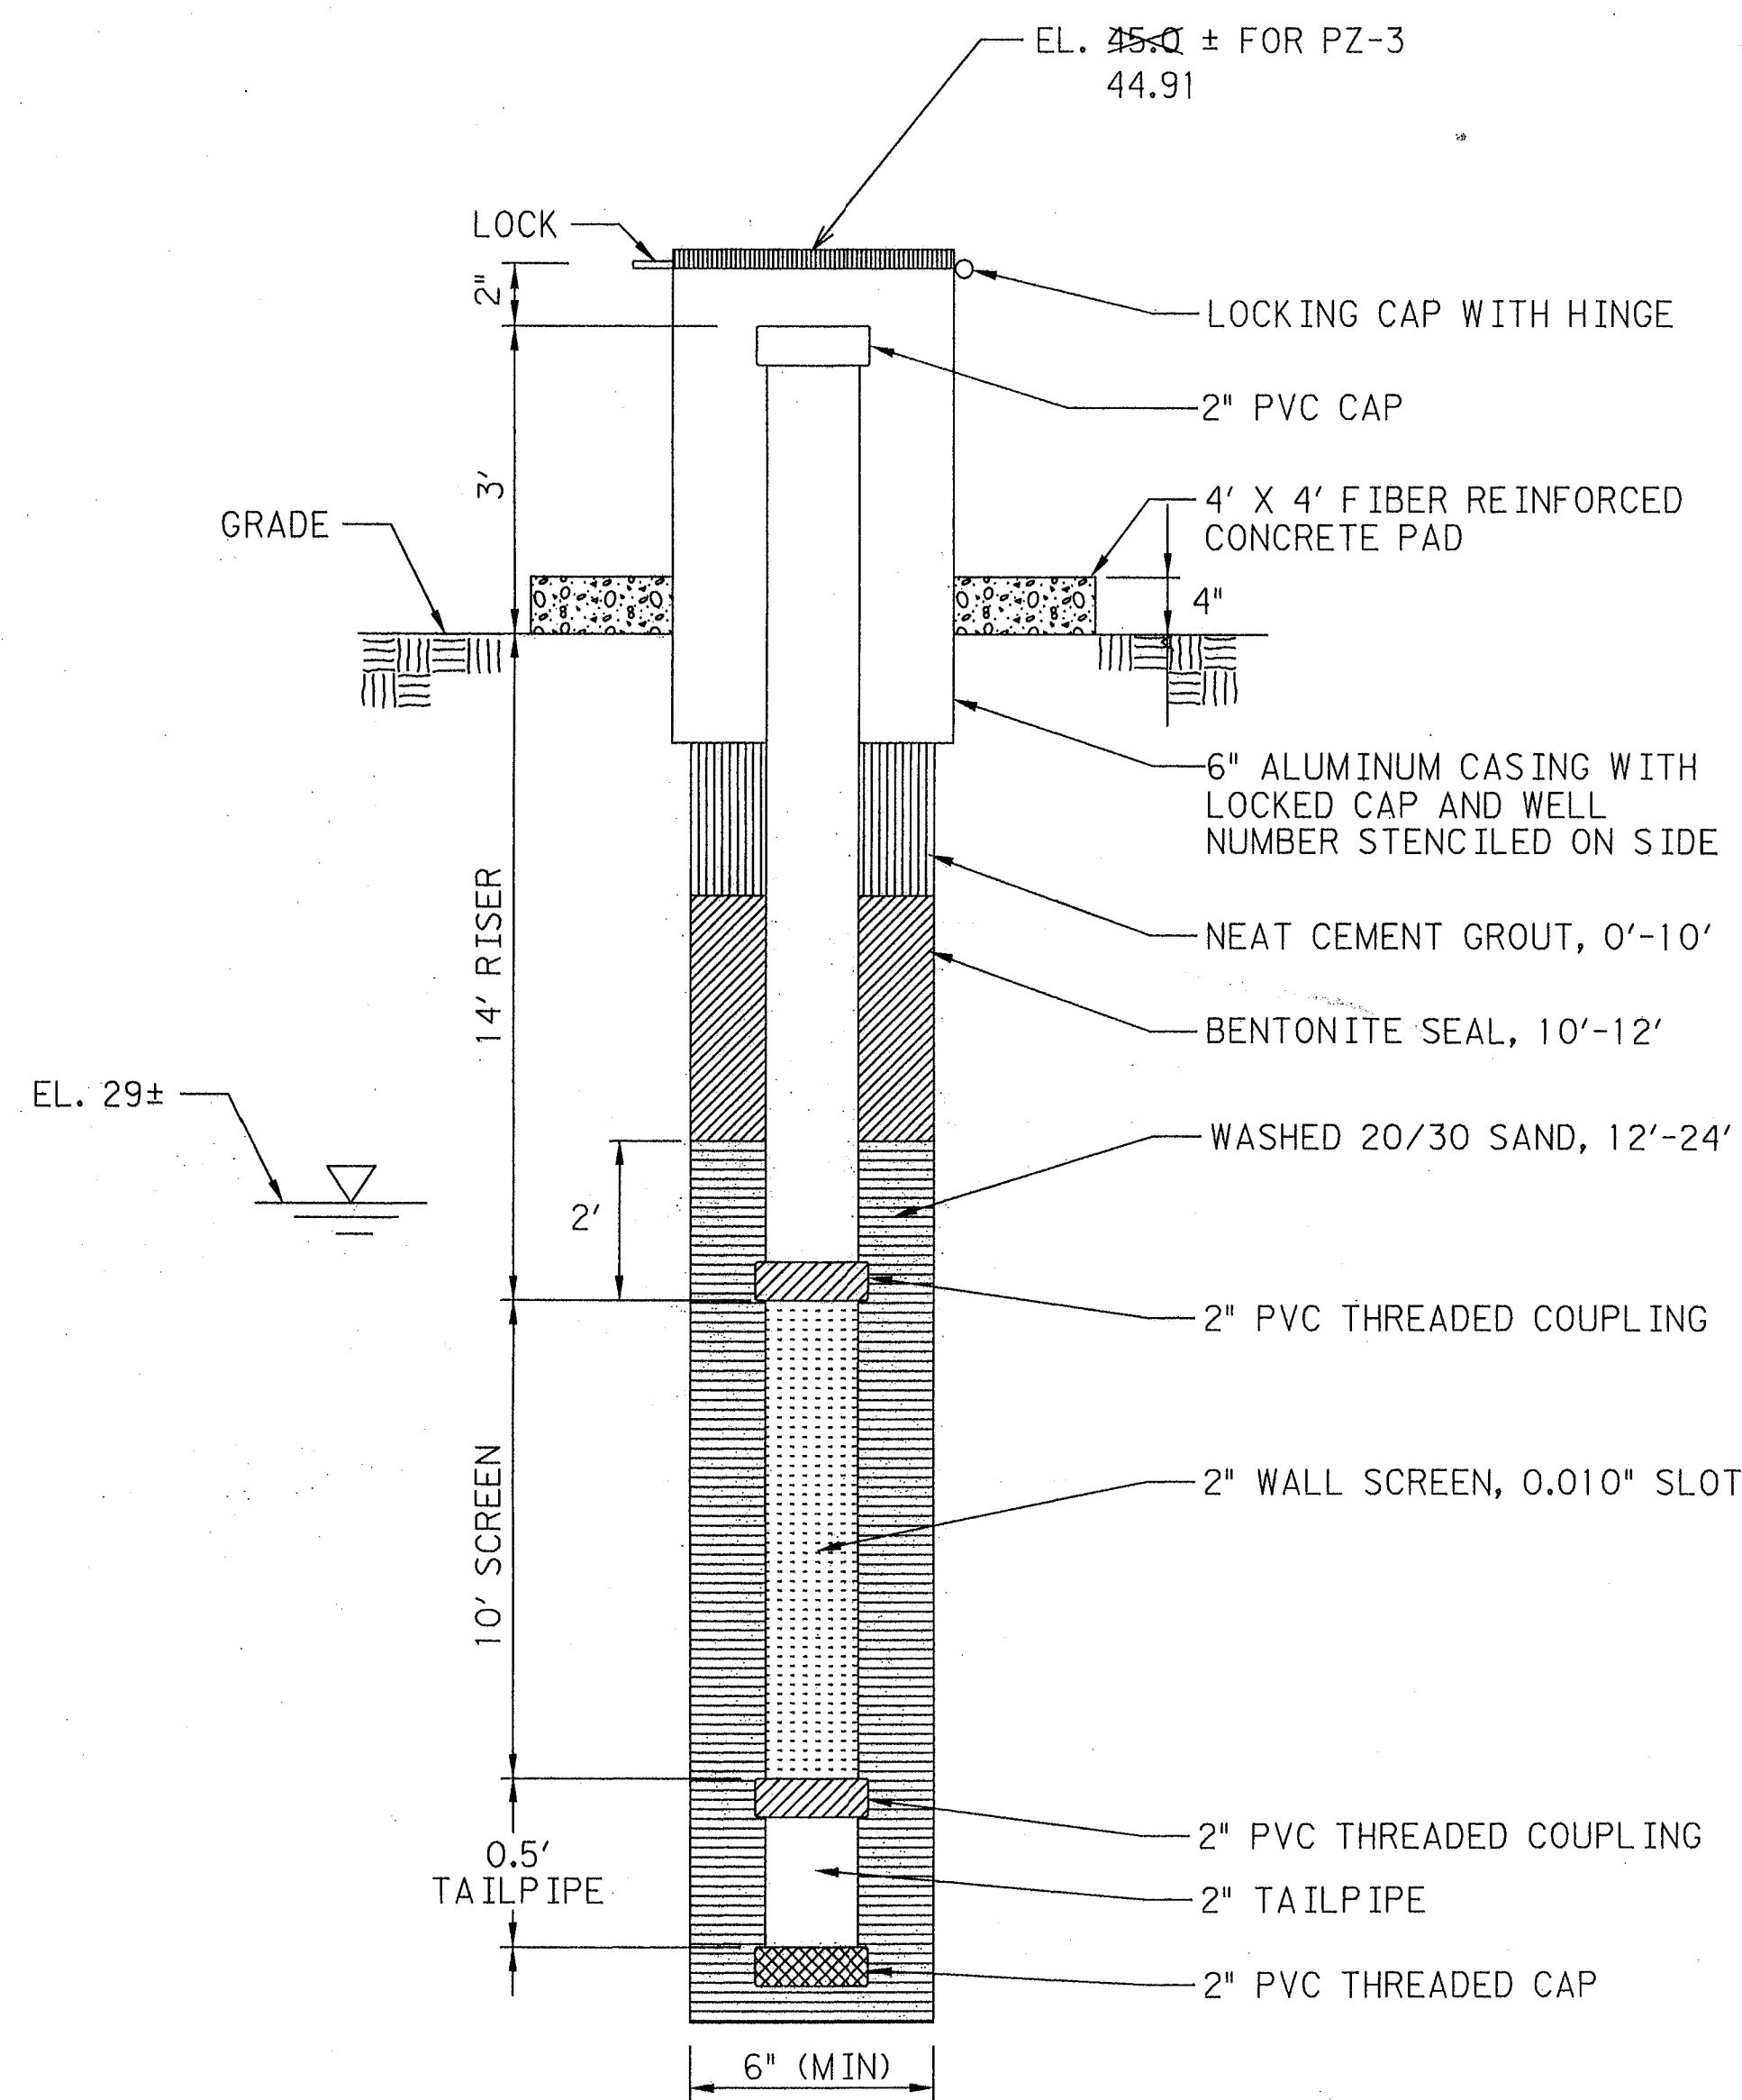

GROUNDWATER MONITORING WELL DETAIL
NTS
LATITUDE: N27°27.926'
LONGITUDE: W 82°26.603'
N 1138610.81
E 512397.79


CONSTRUCTION NOTES FOR MONITORING WELLS.

1. ALL WORK RELATED TO ABANDONMENT OR INSTALLATION OF MONITORING WELLS SHALL BE DONE BY A FLORIDA CERTIFIED WATER WELL DRILLER. GENERAL CONTRACTOR SHALL SUBMIT QUALIFICATIONS AND COPY OF DRILLER'S LICENSE FOR OWNER APPROVAL.
2. ALL MONITORING WELLS AS INDICATED ON THE DRAWINGS SHALL BE PLUGGED AND ABANDONED IN ACCORDANCE WITH F.A.C. RULE 62-532.440, AND THE SOUTHWEST FLORIDA WATER MANAGEMENT DISTRICT (SWFWMD). THE DRILLER SHALL SUBMIT A WRITTEN REPORT TO THE FLORIDA DEPARTMENT OF ENVIRONMENTAL PROTECTION, WITH COPIES TO THE OWNER AND ENGINEER, DOCUMENTING VERIFICATION OF THE WELL ABANDONMENT WITHIN 90 DAYS OF ABANDONMENT. DOCUMENTATION OF ABANDONMENT SHALL INCLUDE A MAP SHOWING LOCATIONS AND SWFWMD ABANDONMENT RECORDS. MONITORING WELLS SHALL BE ABANDONED BY REMOVING THE ENTIRE WELL AND BACKFILLING THE HOLE WITH CLEAN SAND.
3. NEW MONITORING WELLS SHALL BE INSTALLED PER ASTM D-5092 (1995) E1-STANDARD PRACTICE FOR DESIGN AND INSTALLATION OF GROUND WATER MONITORING WELLS IN GRANULAR AQUIFERS, AND THE FOLLOWING DOCUMENTATION SUBMITTED TO FDEP WITH COPIES TO THE OWNER AND ENGINEER.

A. DOCUMENTATION OF THE FOLLOWING FOR GROUND WATER MONITORING WELL INSTALLED:

- WELL IDENTIFICATION
- AQUIFER MONITORED
- SCREEN TYPE AND SLOT SIZE
- SCREEN LENGTH
- SCREEN DIAMETER
- ELEVATION AT TOP OF CASING
- ELEVATION AT GROUND SURFACE
- WELL DEVELOPMENT METHOD AND DURATION
- BORING (LITHOLOGY) LOG
- TOTAL DEPTH OF WELL
- CASING DIAMETER
- CASING TYPE AND LENGTH
- SWFWMD WELL CONSTRUCTION PERMIT NOS.
- WELL SEAL FILTER PACK TYPE AND THICKNESS


- B. WITHIN ONE WEEK OF WELL COMPLETION AND DEVELOPMENT, EACH NEW GROUND WATER MONITORING WELL SHALL BE SAMPLED FOR THE PARAMETERS LISTED IN F.A.C. RULES 62-701.510 (3) (D) (1), TO ESTABLISH INITIAL GROUNDWATER QUALITY FOR EACH NEW WELL.
- C. A SURVEY DRAWING SHALL BE SUBMITTED IN ACCORDANCE WITH F.A.C. RULE 62-701.510(3) (D) (1), SHOWING THE LOCATION OF ALL MONITORING WELLS (ACTIVE AND ABANDONED) HORIZONTALLY LOCATED IN DEGREES, MINUTES AND SECONDS OF LATITUDE AND LONGITUDE, THE UNIVERSAL TRANSVERSE MERCATOR COORDINATES, AND THE ELEVATION OF THE TOP OF THE WELL CASING TO THE NEAREST 0.01 FOOT, NATIONAL GEODETIC VERTICAL DATUM. THE SURVEYED DRAWING SHALL INCLUDE THE MONITOR WELL IDENTIFICATION NUMBERS, LOCATIONS AND ELEVATIONS OF ALL PERMANENT BENCHMARKS AND /OR CORNER MONUMENT MARKER AT THE SITE. THE SURVEY SHALL BE CONDUCTED BY A FLORIDA REGISTERED SURVEYOR. THE OWNER WILL PROVIDE THE CONTRACTOR WITH THE PRESENT SURVEY DRAWING FOR REVISION BY THE CONTRACTOR, AS APPLICABLE.
4. ALL REPORTS SHALL BE SENT TO: SOLID WASTE SECTION, DEPARTMENT OF ENVIRONMENTAL PROTECTION, SOUTHWEST DISTRICT OFFICE, 3804 COCONUT PALM DRIVE, TAMPA, FLORIDA 33619-8313; AND ALSO TO: SOLID WASTE SECTION, DEPARTMENT OF ENVIRONMENTAL PROTECTION, 3900 COMMONWEALTH BOULEVARD, M.S. 4565, TALLAHASSEE, FL 32399-3000.

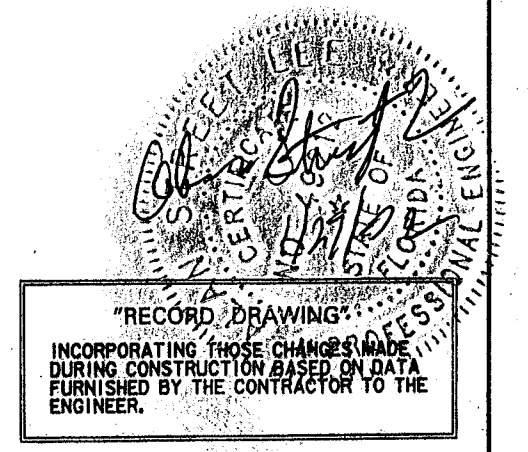

L-4


 330 SOUTH PINEAPPLE AVE. SUITE 113 SARASOTA, FLORIDA 34236 Ph. (941) 954-4036	CLIENT MANATEE COUNTY PROJECT MANAGEMENT DEPARTMENT 1026 26th AVENUE EAST BRADENTON, FLORIDA 34208		PROJECT	TASK	ORIGINAL: AUG. 2001	6	Name: JOSEPH L. MILLER Florida P.E. No.: 89177 Address: PBS&J 485 S. Keller Road Orlando, FL 32810-6101 Signature: _____ Date: _____ NOT VALID FOR CONSTRUCTION UNLESS SIGNED IN THIS BLOCK	JOB NO. 00-000.00 DRAWN RGC DESIGNED JLM/RGC CHECKED JLM QC DED SHEET /
			LENA ROAD LANDFILL	PIEZOMETER AND MONITORING WELL	REVISIONS: 1 9/5/01 2 REC DWG JAN 02	7		
			CONSTRUCTION PERMIT	INSTALLATION DETAILS	3	8		
			MODIFICATIONS		4	9		
					5	10		
						11		
						12		

PERMIT RENEWAL DRAWINGS FOR MANATEE COUNTY – LENA ROAD LANDFILL FILL SEQUENCE PLAN STAGE III LANDFILL FROM 2004 TO 2014

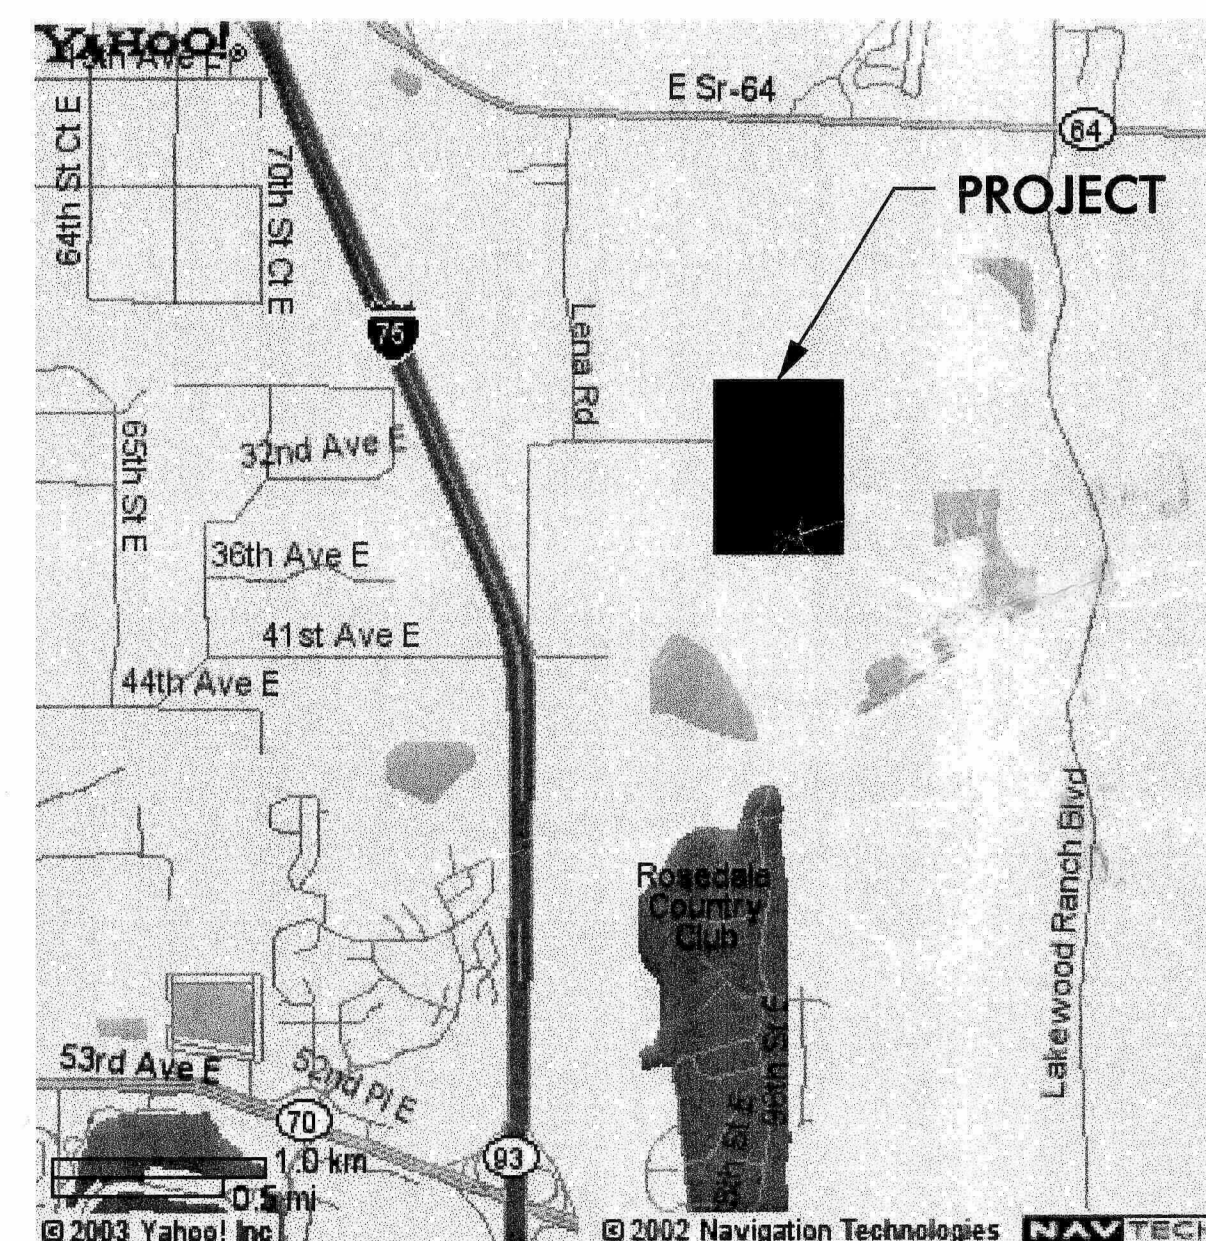

LENA ROAD LANDFILL
3333 LENA ROAD
BRADENTON, FLORIDA 34202

MANATEE COUNTY

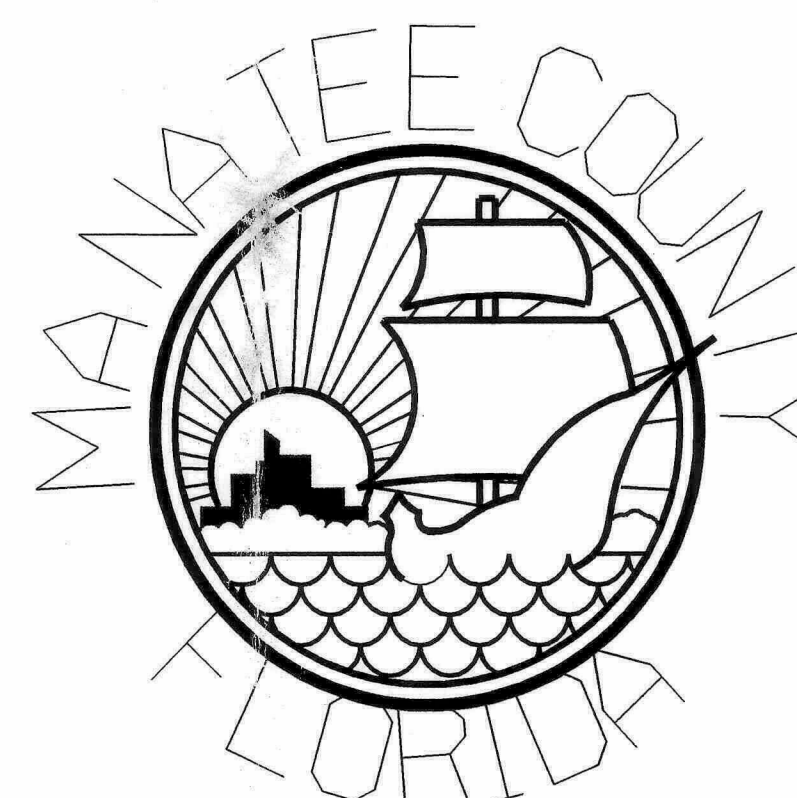

MANATEE COUNTY
UTILITY OPERATIONS
DEPARTMENT

4410 66th STREET WEST
BRADENTON, FLORIDA 34210

SEPTEMBER 2004

LIST OF DRAWINGS


- C-1 COVER
- C-2 GENERAL SITE PLAN
- C-3 STAGE III EXCAVATION PLAN
- C-4 SEQUENCE 1 (JAN. 2004 – JAN. 2005))
- C-5 SEQUENCE 2 (JAN. 2005 – OCT. 2005))
- C-6 SEQUENCE 3 (OCT. 2005 – AUG. 2006)
- C-7 SEQUENCE 4 (AUG. 2006 – MAY 2007)
- C-8 SEQUENCE 5 (MAY 2007 – FEB. 2009)
- C-9 SEQUENCE 6 (FEB. 2009 – FEB. 2013)
- C-10 SEQUENCE 7 (FEB. 2013 – MAR. 2014)
- C-11 CROSS SECTIONS
- C-12 CROSS SECTIONS
- C-13 DETAILS



An Employee – Owned Company

Consulting Engineers and Planners
482 South Keller Road
Orlando, Florida 32810
POST BUCKLEY, SCHUH & JERNIGAN, Inc.
d/b/a PBS&J
2001 N.W. 107th Ave., Miami, FL 33172-3507
FBPR Certificate of Authorization No.: 24


ENGINEER'S PROJECT NO. 120498

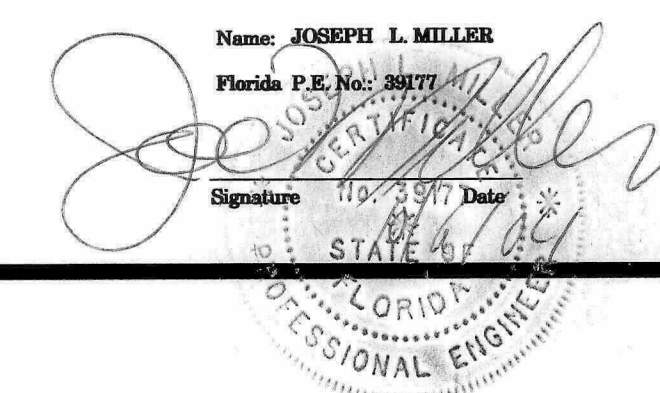

MANATEE COUNTY – LENA ROAD LANDFILL- STAGE III LANDFILL SEQUENCE PLAN (SEPT 2004)

Revised by reduced draw set size 4/19/06

FILE ONLY

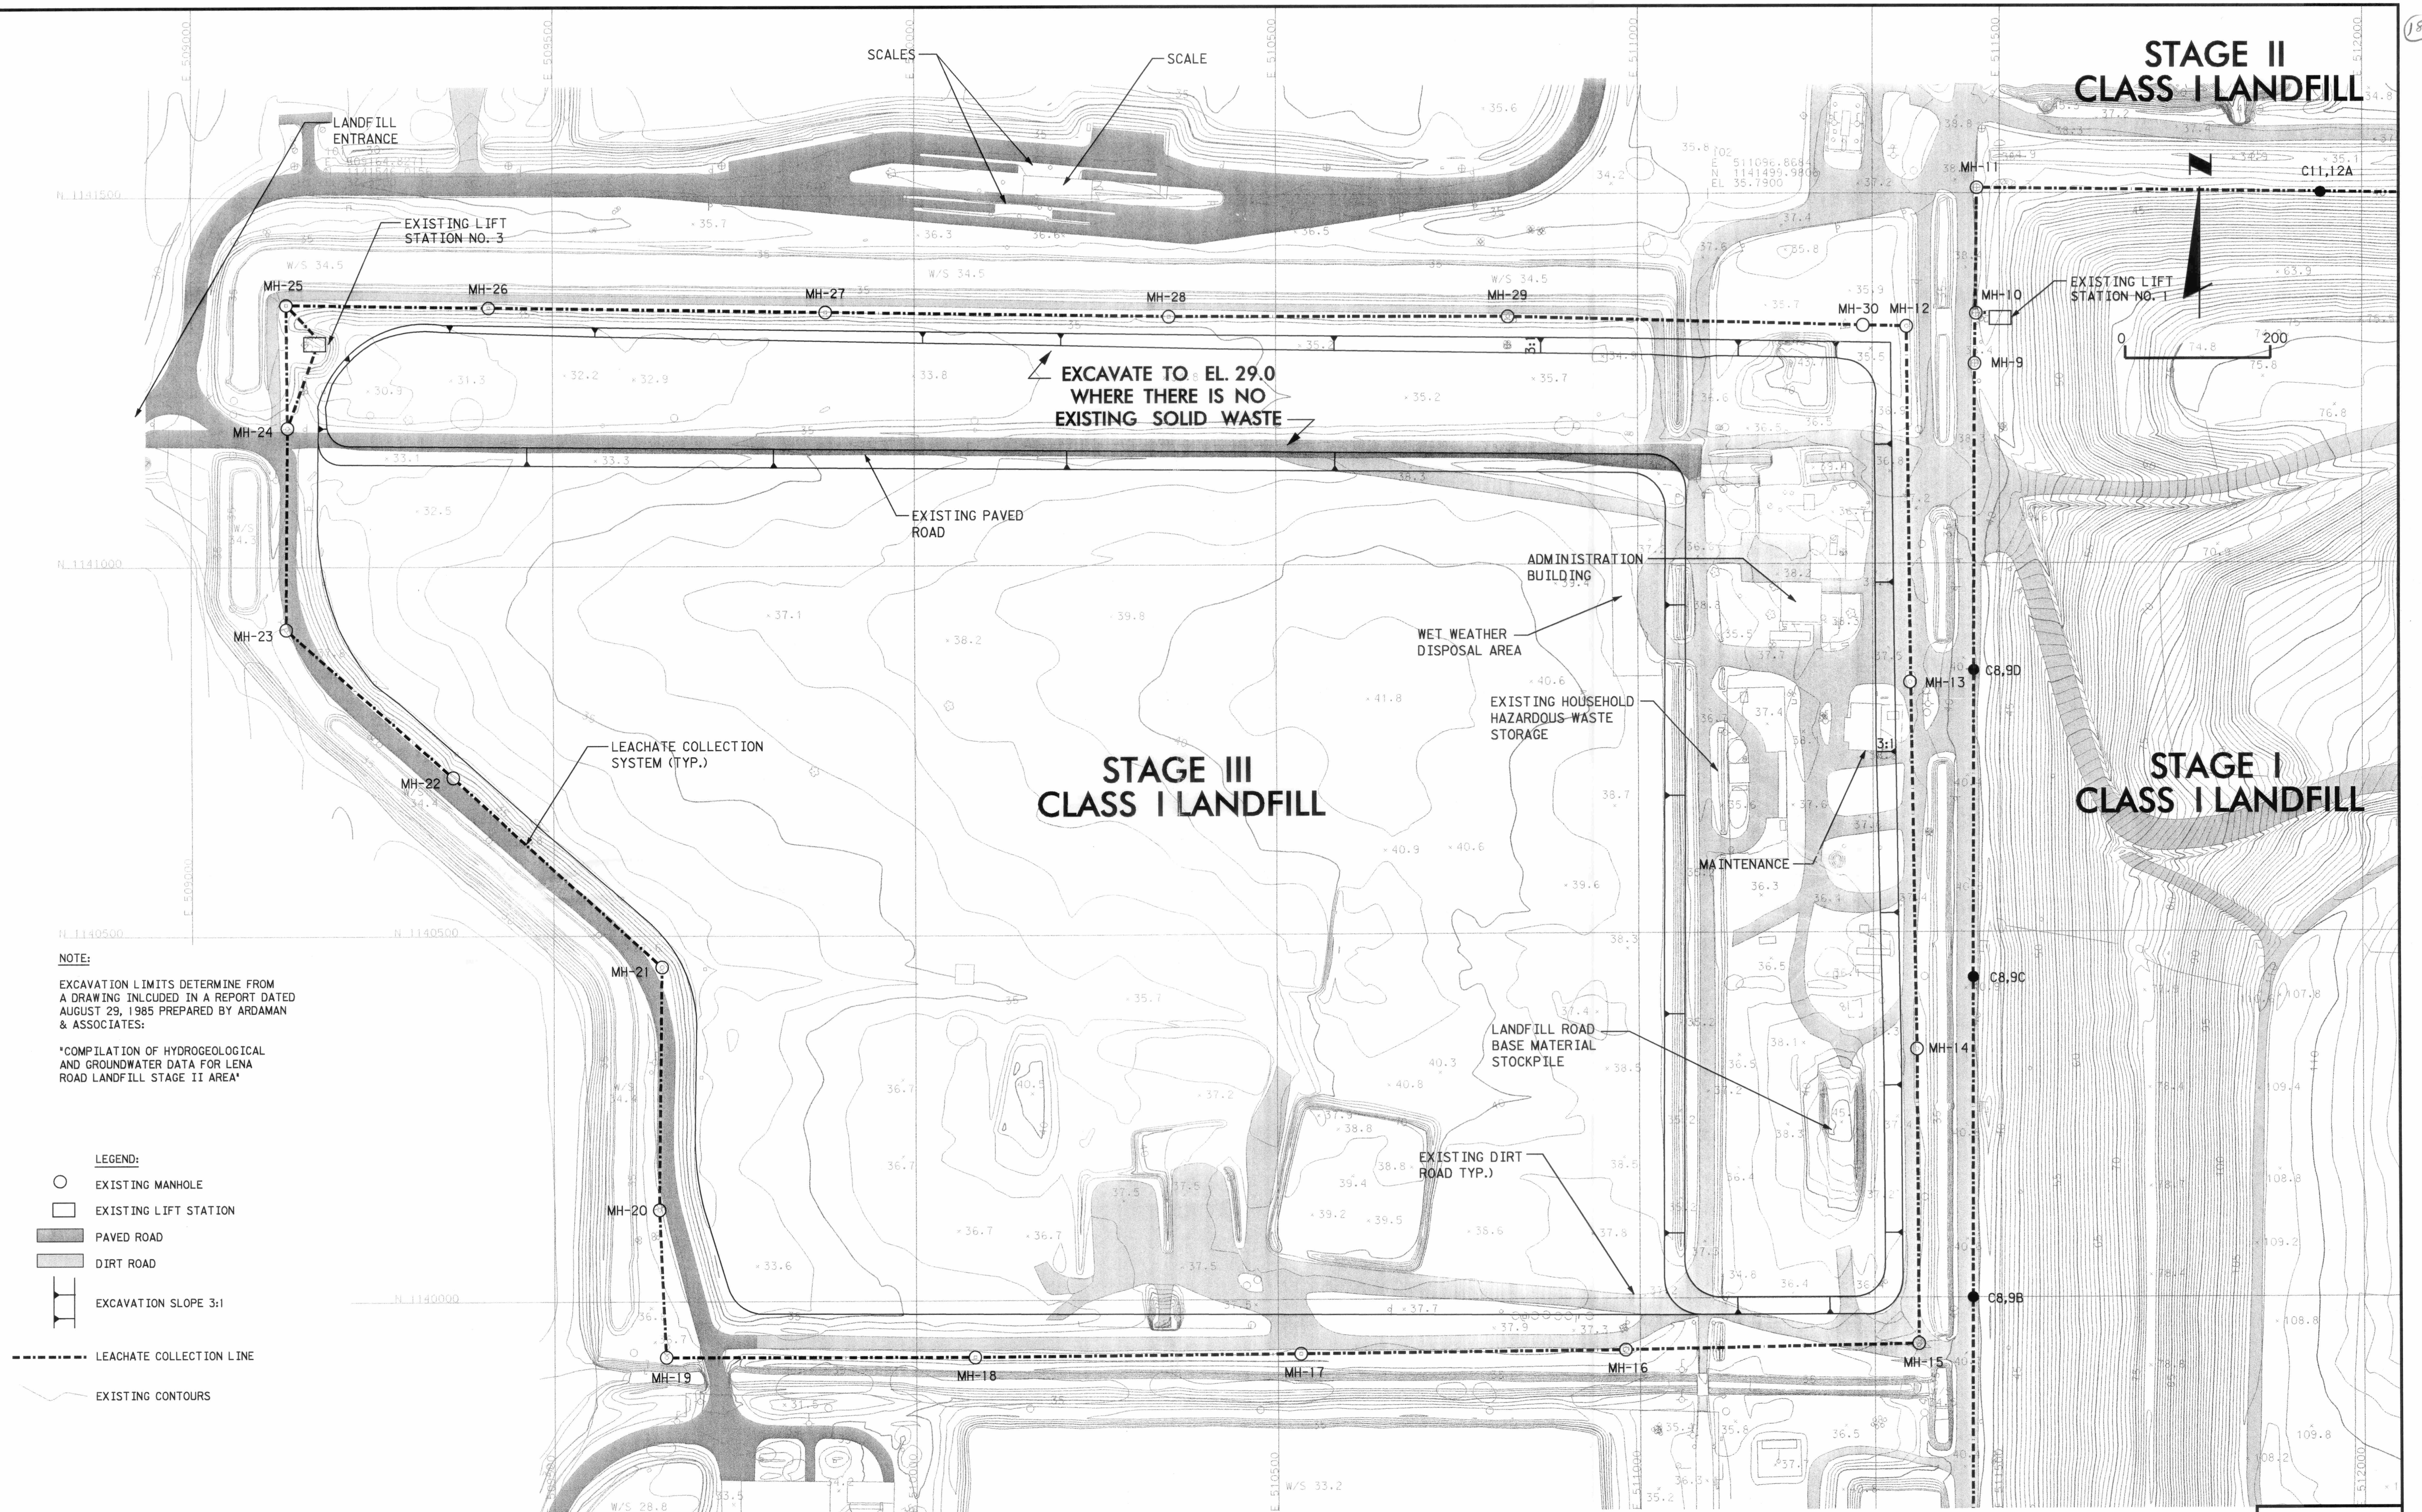

PBS &

POST BUCKLEY, SCHUH & JERNIGAN, Inc.
dba PBS&J
2001 N.W. 107th Ave., Miami, FL 33172-2507
FBPR Certificate of Authorization No.: 24

MANATEE COUNTY
BOARD OF COUNTY COMMISSIONERS


LENA ROAD LANDFILL
FILL SEQUENCE PLAN
STAGE III LANDFILL

STAGE III LANDFILL EXCAVATION PLAN

1. _____
2. _____
3. _____
4. _____
5. _____

Signature	Date
------------------	-------------


JOB NO. 00-000.00
DRAWN RGC
DESIGN JLM/RGC
CHECKED JLM
Q.C. DED

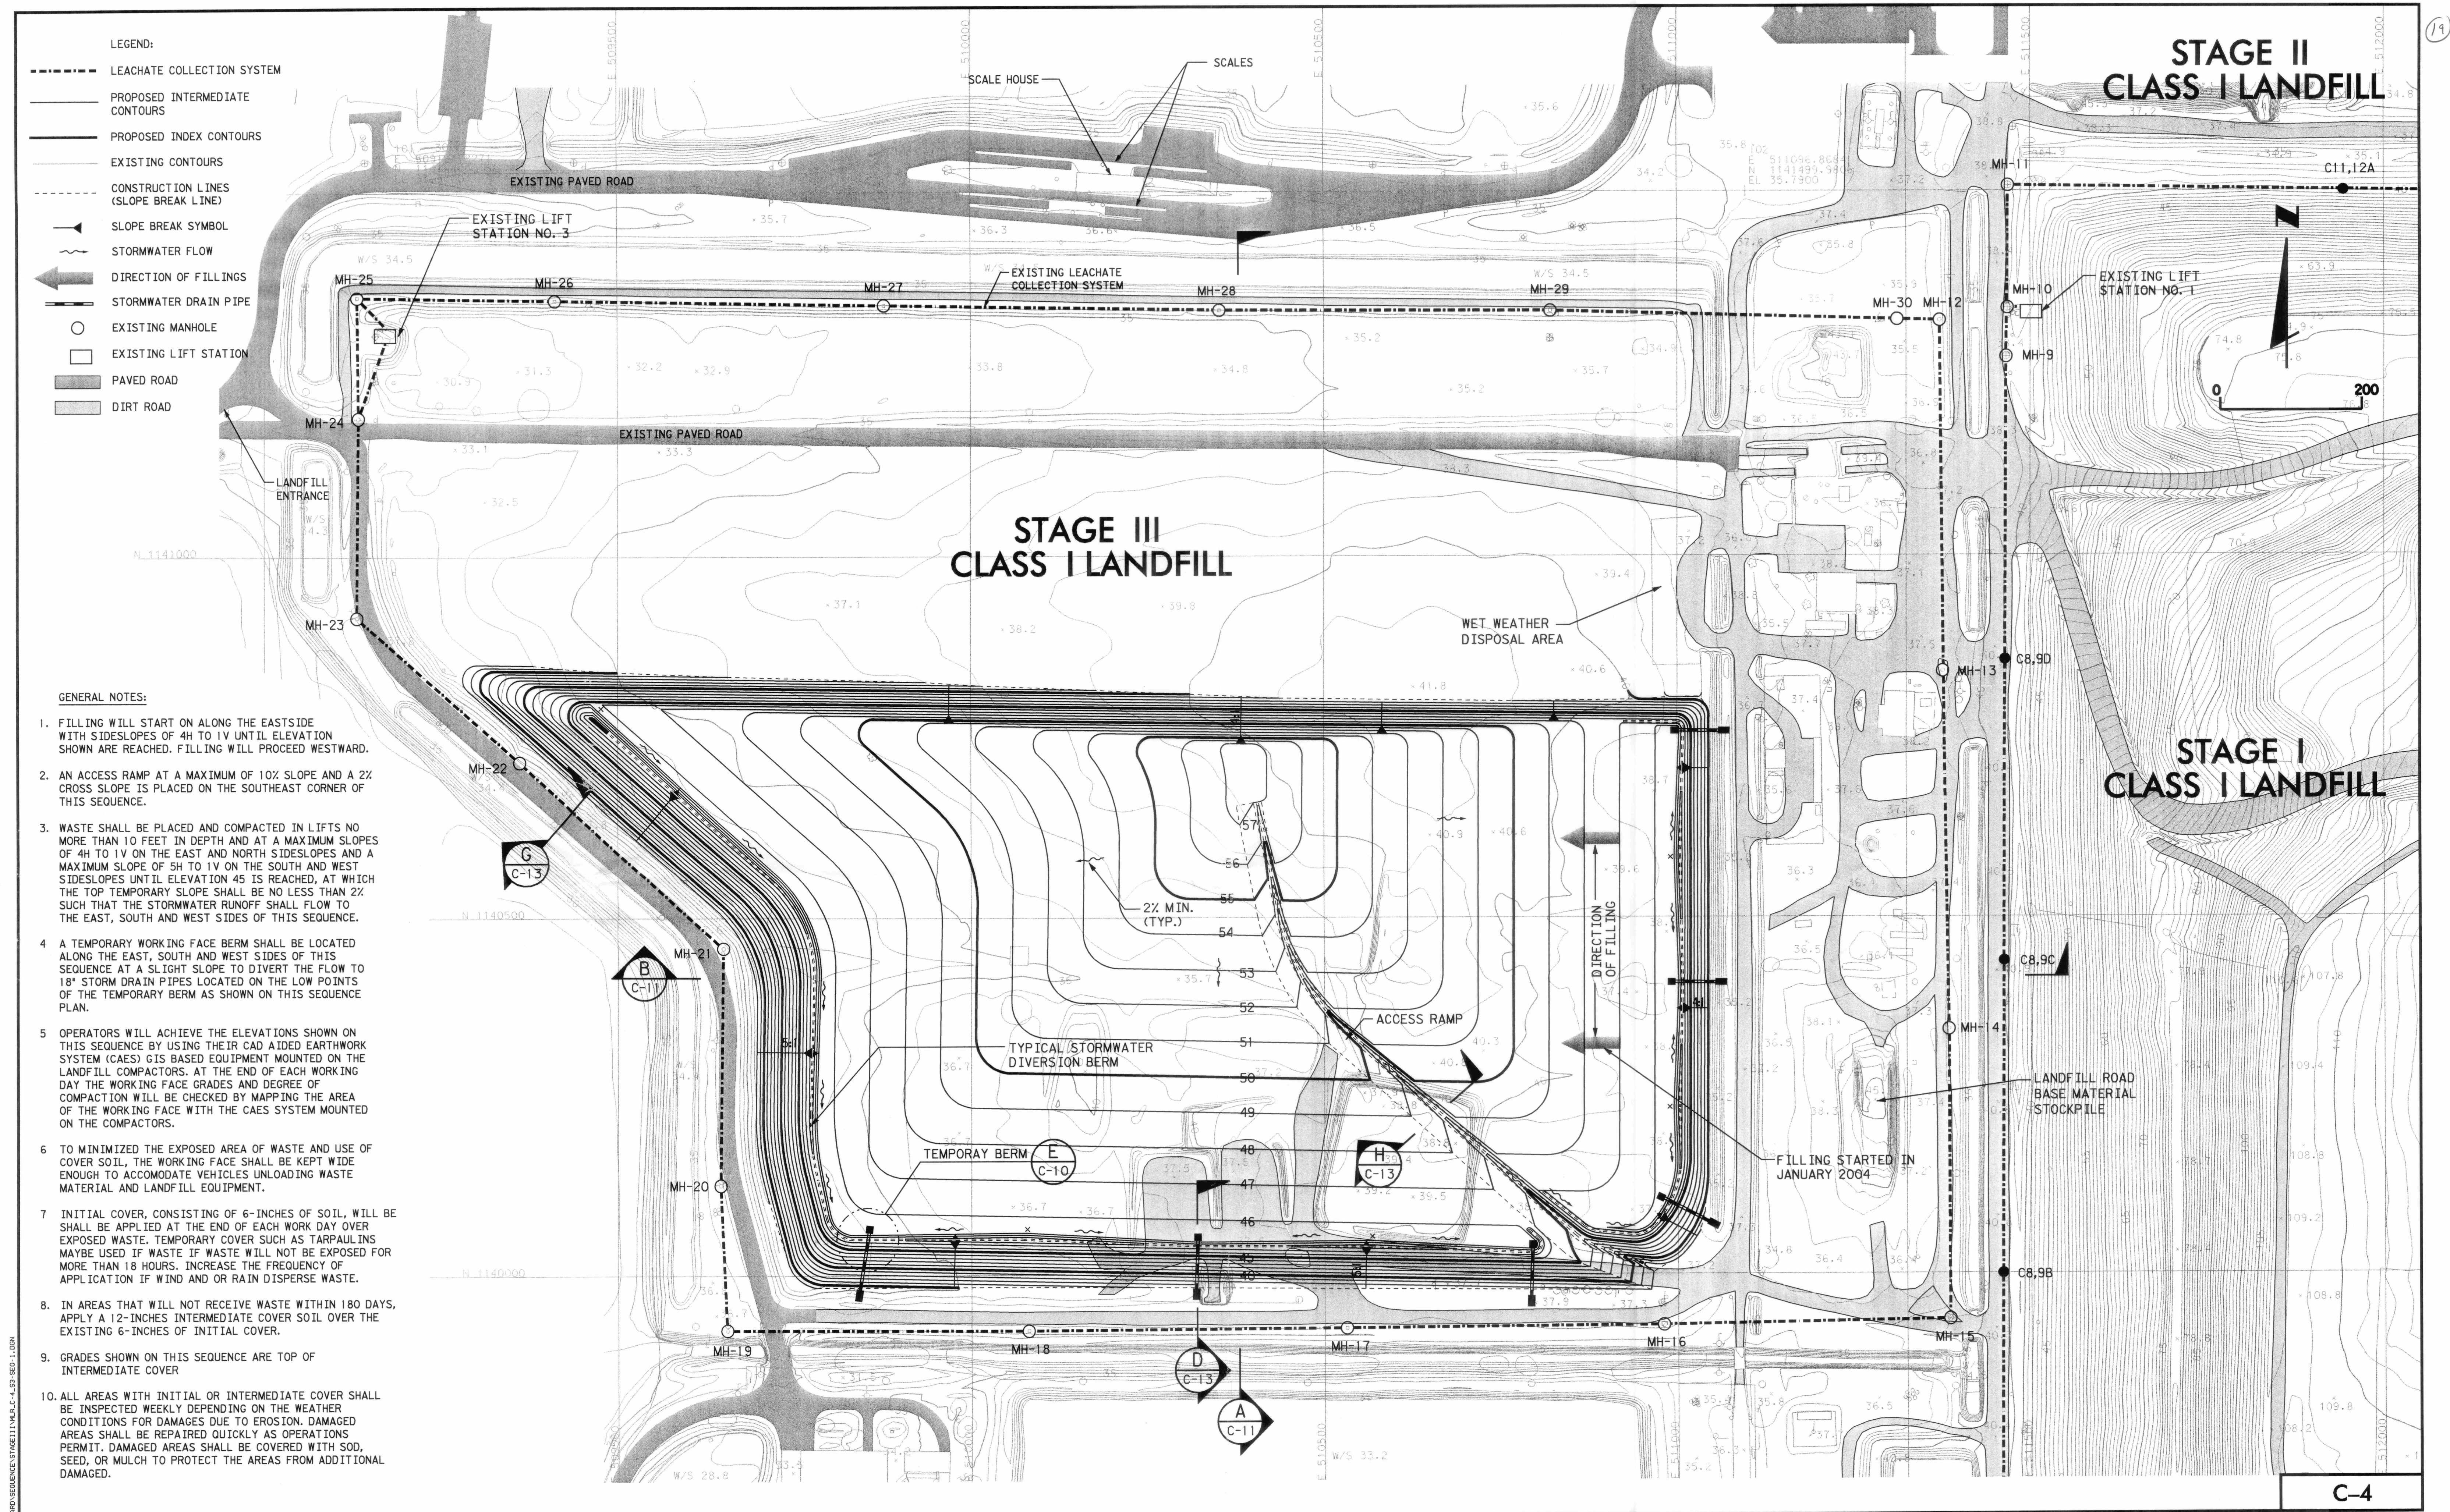

PBS &J 482 South Keller Road Orlando, FL 32810-6101 Tel. (407) 647-7275 Fax. (407) 647-0624 www.pbsj.com POST BUCKLEY, SCHUH & JERNIGAN, Inc. dba PBS&J 2001 N.W. 107th Ave., Miami, FL 33179-2667 FBPR Certificate of Authorization No. 24	CLIENT		PROJECT	TASK	ORIGINAL MAY 2004 REVISIONS: 1. _____ 2. _____ 3. _____ 4. _____ 5. _____	Name: JOSEPH L. MILLER Florida P.E. No.: 39177 Address: PBS&J 482 S. Keller Road Orlando, FL 32810-6101 Signature _____ Date _____ FLORIDA DEPARTMENT OF TRANSPORTATION OCT 07 2004 SOUTHWEST DISTRICT TRANS	JOB NO. 00-000.00 DRAWN _____ RGC DESIGN _____ JLM/RGC CHECKED _____ JLM Q.C. _____ DED
	MANATEE COUNTY		LENA ROAD LANDFILL	SEQUENCE 1			
	BOARD OF COUNTY COMMISSIONERS		FILL SEQUENCE PLAN	(JAN. 2004 – JAN. 2005)			
			STAGE III LANDFILL		SHEET 4/13		

- PBSJ** &
- 482 South Keller Road
Orlando, FL 32810-6101
Tel. (407) 647-7275
Fax. (407) 647-0624
www.pbsj.com
- POST: BUCKLEY, SCHUH & JERNIGAN, Inc.
d/b/a PBSJ
2001 N.W. 107th Ave., Miami, FL 33176-5907
FBI/PC Certificate of Authorization No. 24


FLORIDA DEPARTMENT OF
ENVIRONMENTAL PROTECTION
OCT 07 2004
SOUTHWEST DISTRICT
TAMPA

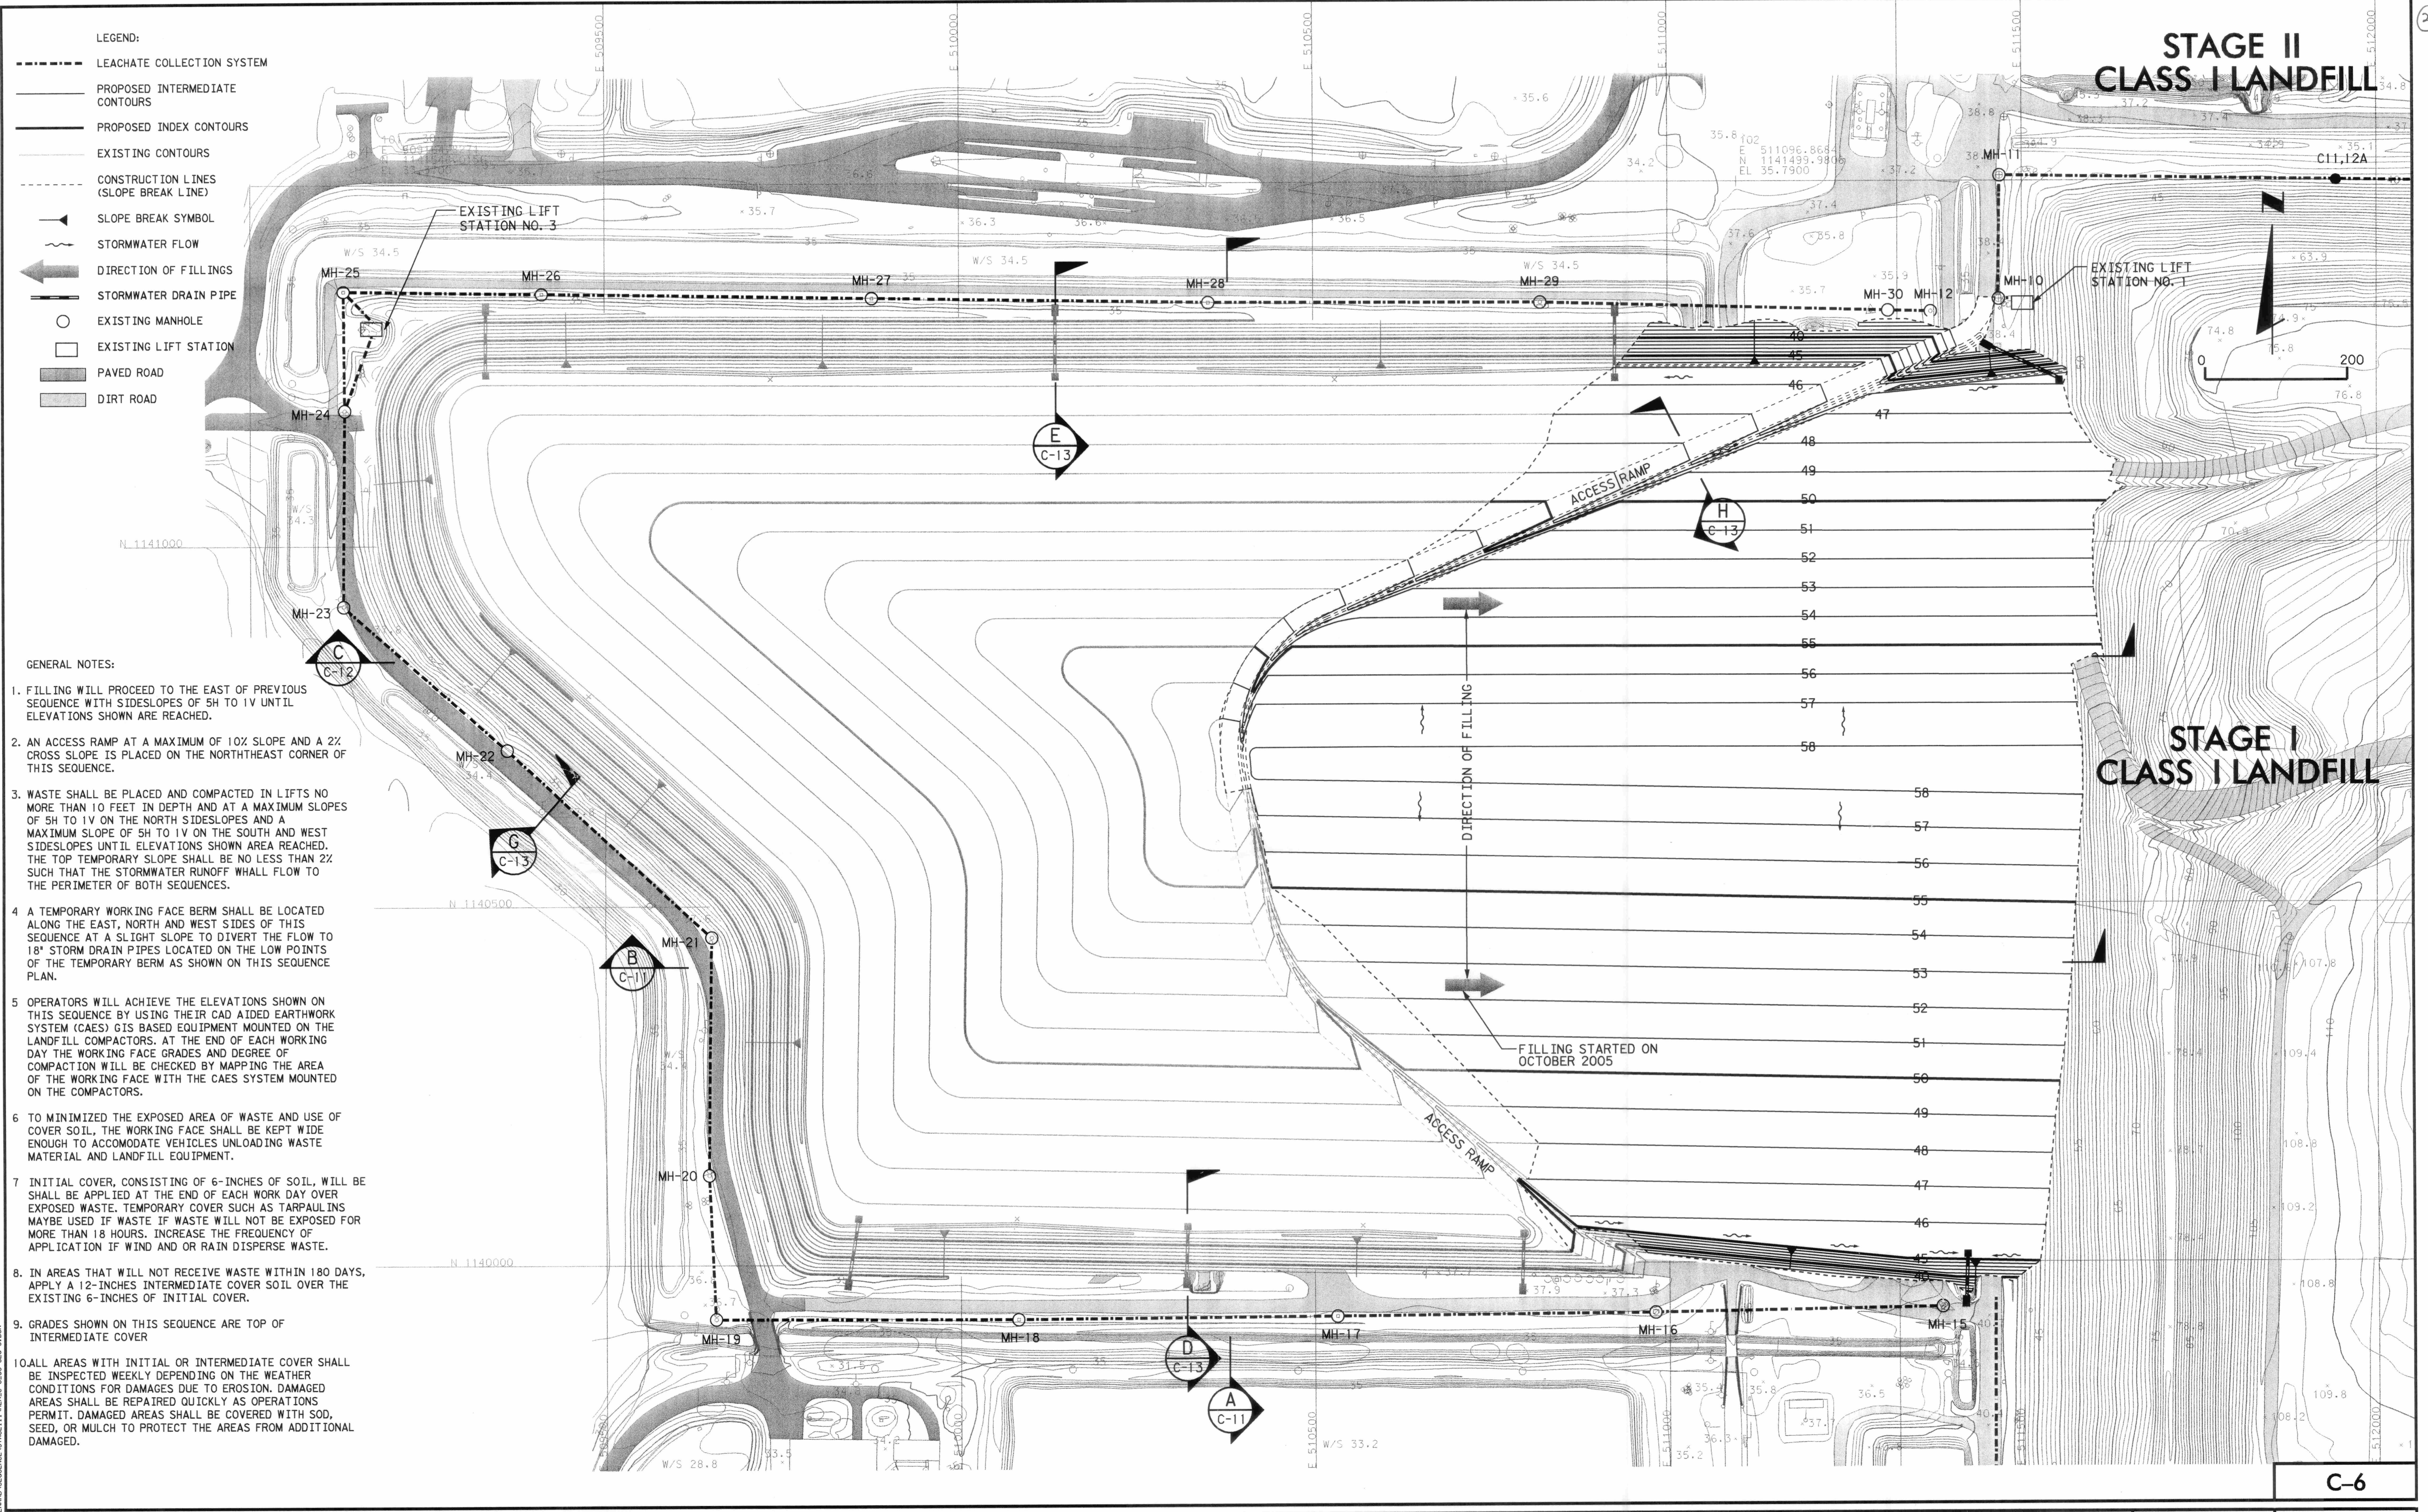

- LEGEND:
- LEACHATE COLLECTION SYSTEM
 - PROPOSED INTERMEDIATE CONTOURS
 - PROPOSED INDEX CONTOURS
 - EXISTING CONTOURS
 - - - CONSTRUCTION LINES (SLOPE BREAK LINE)
 - ▲ SLOPE BREAK SYMBOL
 - ~ STORMWATER FLOW
 - ← DIRECTION OF FILLINGS
 - STORMWATER DRAIN PIPE
 - EXISTING MANHOLE
 - EXISTING LIFT STATION
 - ▬ PAVED ROAD
 - ▬ DIRT ROAD

- GENERAL NOTES:
1. FILLING WILL PROCEED TO THE EAST OF PREVIOUS SEQUENCE WITH SIDESLOPES OF 5H TO 1V UNTIL ELEVATIONS SHOWN ARE REACHED.
 2. AN ACCESS RAMP AT A MAXIMUM OF 10% SLOPE AND A 2% CROSS SLOPE IS PLACED ON THE NORTHEAST CORNER OF THIS SEQUENCE.
 3. WASTE SHALL BE PLACED AND COMPACTED IN LIFTS NO MORE THAN 10 FEET IN DEPTH AND AT A MAXIMUM SLOPES OF 5H TO 1V ON THE NORTH SIDESLOPES AND A MAXIMUM SLOPE OF 5H TO 1V ON THE SOUTH AND WEST SIDESLOPES UNTIL ELEVATIONS SHOWN AREA REACHED. THE TOP TEMPORARY SLOPE SHALL BE NO LESS THAN 2% SUCH THAT THE STORMWATER RUNOFF SHALL FLOW TO THE PERIMETER OF BOTH SEQUENCES.
 4. A TEMPORARY WORKING FACE BERM SHALL BE LOCATED ALONG THE EAST, NORTH AND WEST SIDES OF THIS SEQUENCE AT A SLIGHT SLOPE TO DIVERT THE FLOW TO 18" STORM DRAIN PIPES LOCATED ON THE LOW POINTS OF THE TEMPORARY BERM AS SHOWN ON THIS SEQUENCE PLAN.
 5. OPERATORS WILL ACHIEVE THE ELEVATIONS SHOWN ON THIS SEQUENCE BY USING THEIR CAD AIDED EARTHWORK SYSTEM (CAES) GIS BASED EQUIPMENT MOUNTED ON THE LANDFILL COMPACTORS. AT THE END OF EACH WORKING DAY THE WORKING FACE GRADES AND DEGREE OF COMPACTION WILL BE CHECKED BY MAPPING THE AREA OF THE WORKING FACE WITH THE CAES SYSTEM MOUNTED ON THE COMPACTORS.
 6. TO MINIMIZED THE EXPOSED AREA OF WASTE AND USE OF COVER SOIL, THE WORKING FACE SHALL BE KEPT WIDE ENOUGH TO ACCOMMODATE VEHICLES UNLOADING WASTE MATERIAL AND LANDFILL EQUIPMENT.
 7. INITIAL COVER, CONSISTING OF 6-INCHES OF SOIL, WILL BE SHALL BE APPLIED AT THE END OF EACH WORK DAY OVER EXPOSED WASTE. TEMPORARY COVER SUCH AS TARPULINS MAYBE USED IF WASTE IF WASTE WILL NOT BE EXPOSED FOR MORE THAN 18 HOURS. INCREASE THE FREQUENCY OF APPLICATION IF WIND AND OR RAIN DISPERSE WASTE.
 8. IN AREAS THAT WILL NOT RECEIVE WASTE WITHIN 180 DAYS, APPLY A 12-INCHES INTERMEDIATE COVER SOIL OVER THE EXISTING 6-INCHES OF INITIAL COVER.
 9. GRADES SHOWN ON THIS SEQUENCE ARE TOP OF INTERMEDIATE COVER
 10. ALL AREAS WITH INITIAL OR INTERMEDIATE COVER SHALL BE INSPECTED WEEKLY DEPENDING ON THE WEATHER CONDITIONS FOR DAMAGES DUE TO EROSION. DAMAGED AREAS SHALL BE REPAIRED QUICKLY AS OPERATIONS PERMIT. DAMAGED AREAS SHALL BE COVERED WITH SOD, SEED, OR MULCH TO PROTECT THE AREAS FROM ADDITIONAL DAMAGED.


PBS&J 432 South Keller Road Orlando, FL 32810-6101 Tel. (407) 647-7275 Fax. (407) 647-0624 www.pbsj.com POST HUCKLEY, SCHUH & JERNIGAN, Inc. dba: PBS&J 3000 N.W. 107th Ave, Miami, FL 33179-2697 FBPR Certificate of Authorization No. 24	CLIENT	PROJECT	TASK	ORIGINAL MAY 2004 REV ISIONS: 1. _____ 2. _____ 3. _____ 4. _____ 5. _____	NAME: JOSEPH L. MILLER Florida P.E. No.: 39177 Address: PBS&J 432 S. Keller Road Orlando, FL 32810-6101 Signature _____ Date _____	FLORIDA DEPARTMENT OF ENVIRONMENTAL PROTECTION OCT 07 2004 SOUTHWEST DISTRICT DAPM	JOB NO. 00-000.00 DRAWN RGC DESIGN JLM/RGC CHECKED JLM O.C. DED SHEET 6/13
	MANATEE COUNTY	LENA ROAD LANDFILL	SEQUENCE 3				
	BOARD OF COUNTY COMMISSIONERS	FILL SEQUENCE PLAN	(OCT. 2005 – AUG. 2006)				
		STAGE III LANDFILL					

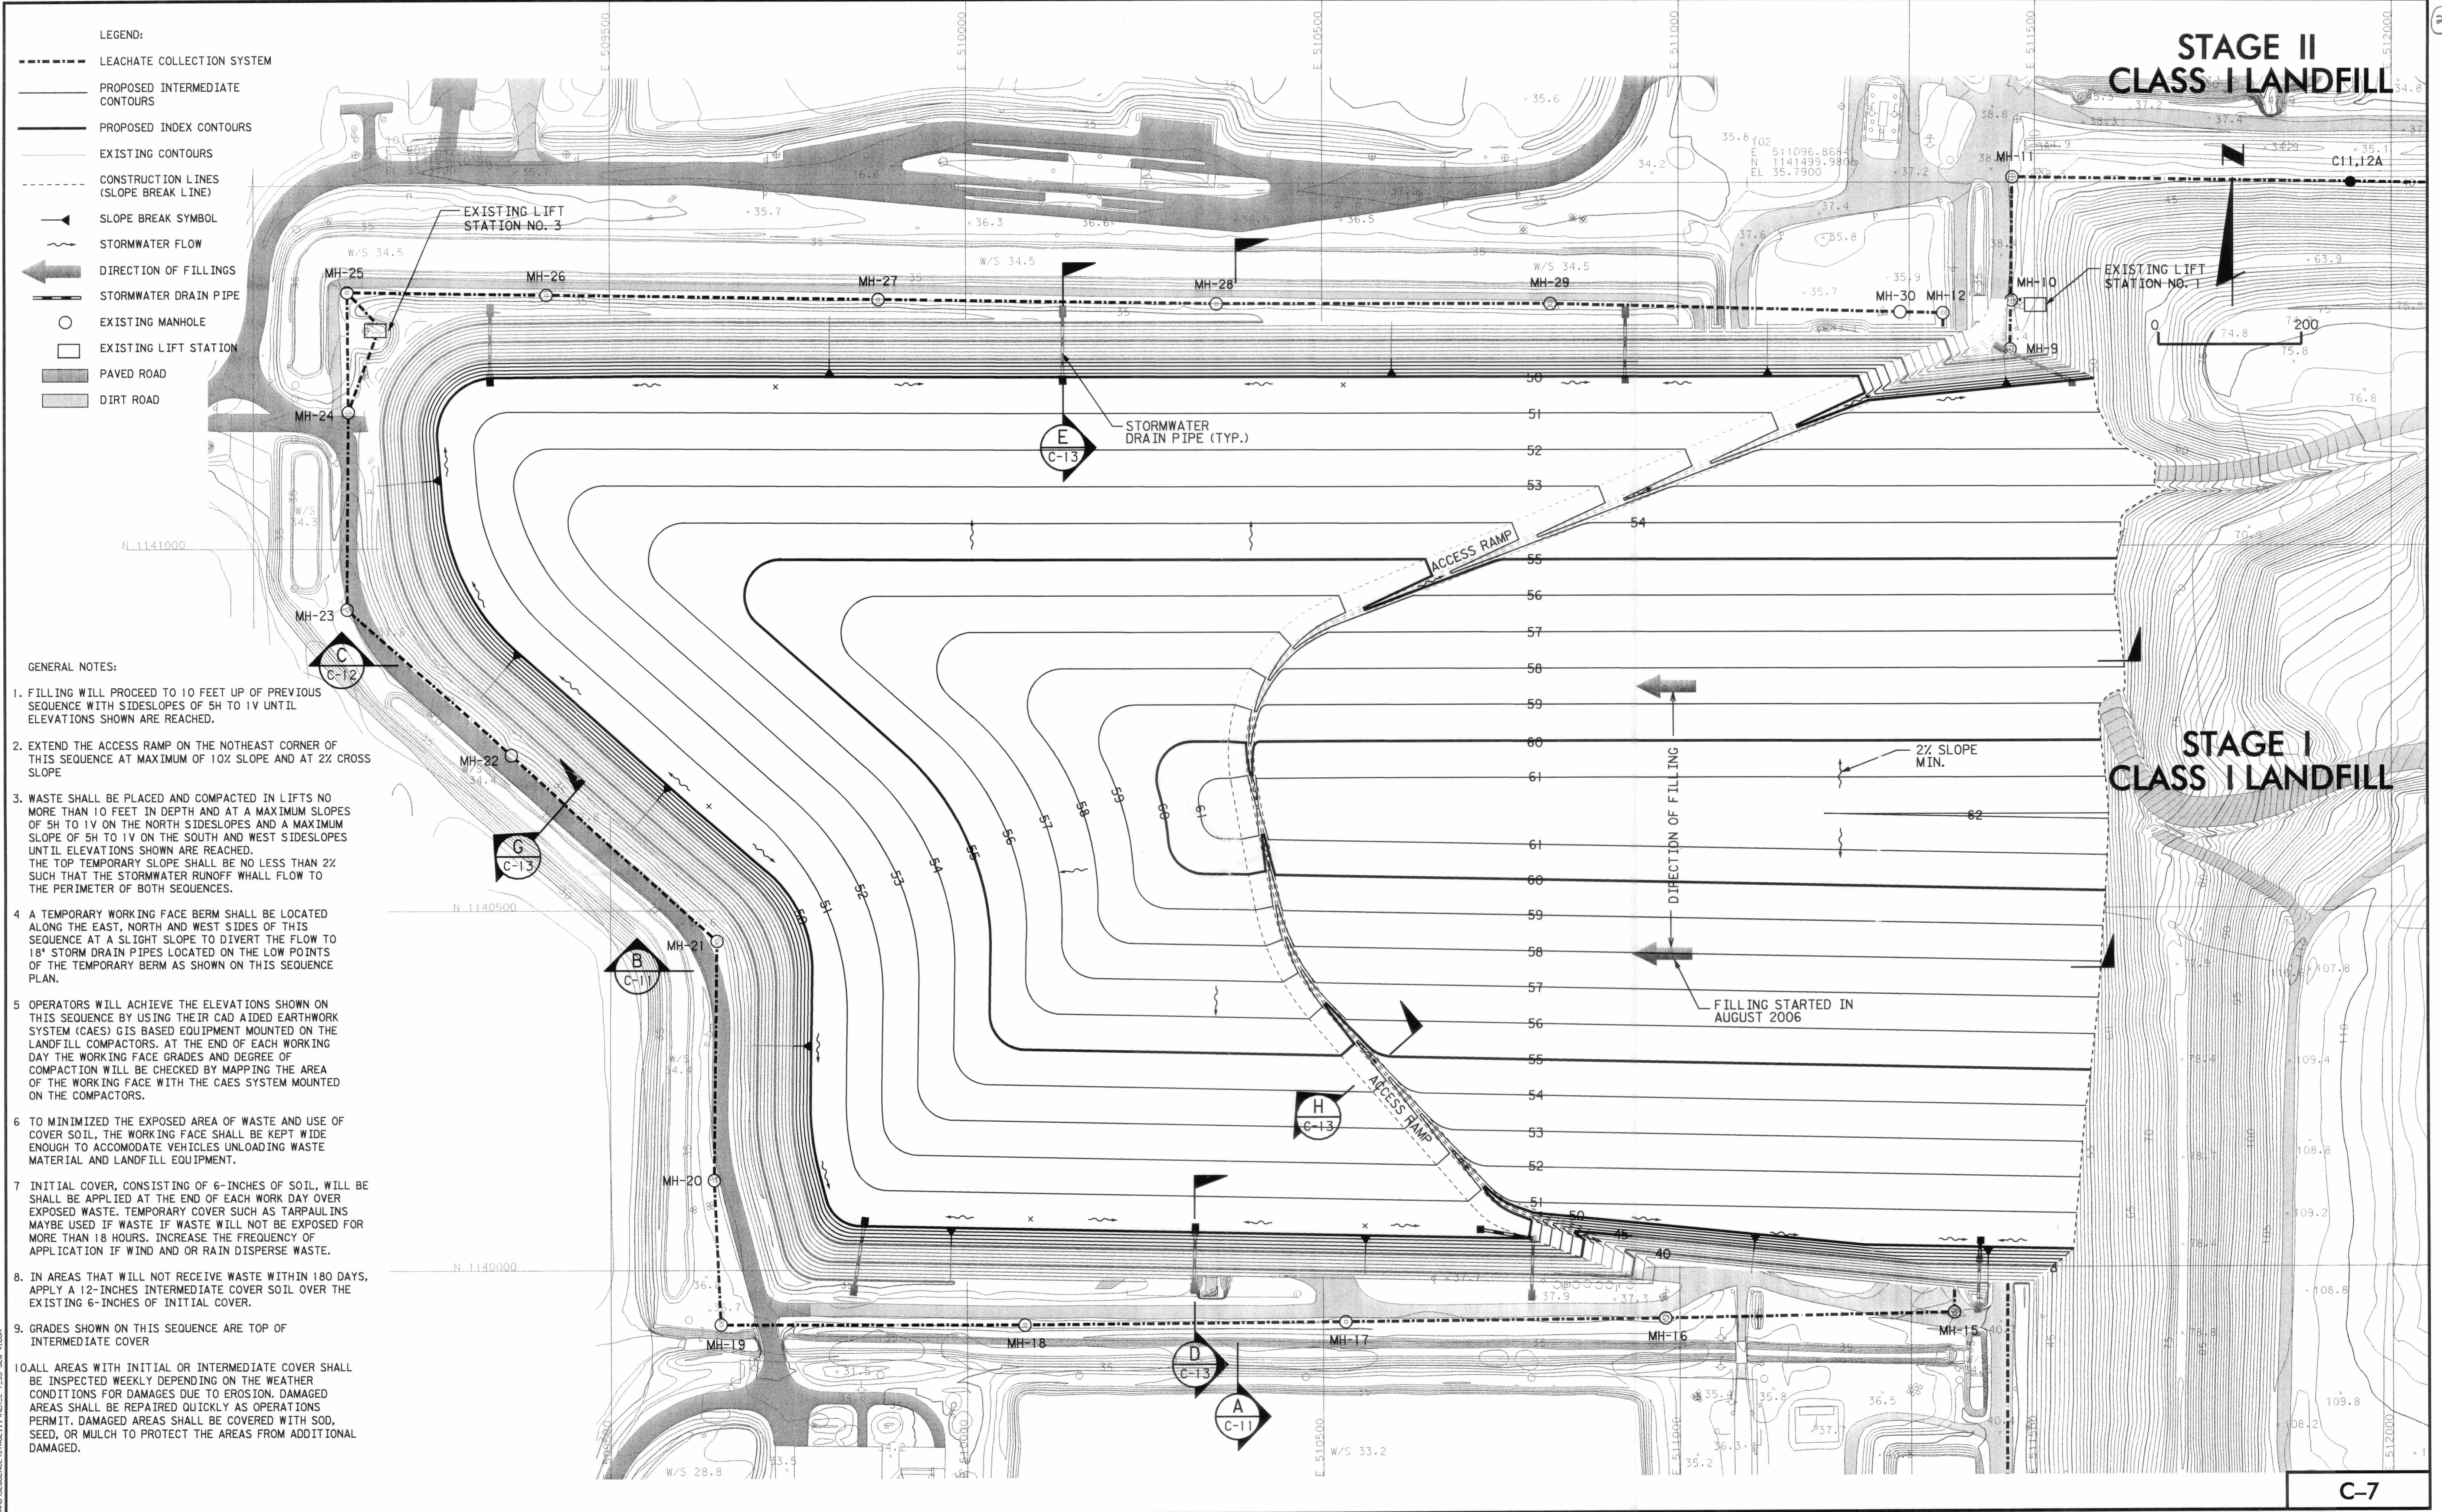


- LEGEND:
- LEACHATE COLLECTION SYSTEM
 - PROPOSED INTERMEDIATE CONTOURS
 - PROPOSED INDEX CONTOURS
 - EXISTING CONTOURS
 - CONSTRUCTION LINES (SLOPE BREAK LINE)
 - ▲ SLOPE BREAK SYMBOL
 - ~ STORMWATER FLOW
 - ➔ DIRECTION OF FILLINGS
 - STORMWATER DRAIN PIPE
 - EXISTING MANHOLE
 - EXISTING LIFT STATION
 - ▬ PAVED ROAD
 - ▬ DIRT ROAD

- GENERAL NOTES:
1. FILLING WILL PROCEED TO 10 FEET UP OF PREVIOUS SEQUENCE WITH SIDESLOPES OF 5H TO 1V UNTIL ELEVATIONS SHOWN ARE REACHED.
 2. EXTEND THE ACCESS RAMP ON THE NOTHEAST CORNER OF THIS SEQUENCE AT MAXIMUM OF 10% SLOPE AND AT 2% CROSS SLOPE
 3. WASTE SHALL BE PLACED AND COMPACTED IN LIFTS NO MORE THAN 10 FEET IN DEPTH AND AT A MAXIMUM SLOPES OF 5H TO 1V ON THE NORTH SIDESLOPES AND A MAXIMUM SLOPE OF 5H TO 1V ON THE SOUTH AND WEST SIDESLOPES UNTIL ELEVATIONS SHOWN ARE REACHED. THE TOP TEMPORARY SLOPE SHALL BE NO LESS THAN 2% SUCH THAT THE STORMWATER RUNOFF WHALL FLOW TO THE PERIMETER OF BOTH SEQUENCES.
 4. A TEMPORARY WORKING FACE BERM SHALL BE LOCATED ALONG THE EAST, NORTH AND WEST SIDES OF THIS SEQUENCE AT A SLIGHT SLOPE TO DIVERT THE FLOW TO 18" STORM DRAIN PIPES LOCATED ON THE LOW POINTS OF THE TEMPORARY BERM AS SHOWN ON THIS SEQUENCE PLAN.
 5. OPERATORS WILL ACHIEVE THE ELEVATIONS SHOWN ON THIS SEQUENCE BY USING THEIR CAD AIDED EARTHWORK SYSTEM (CAES) GIS BASED EQUIPMENT MOUNTED ON THE LANDFILL COMPACTORS. AT THE END OF EACH WORKING DAY THE WORKING FACE GRADES AND DEGREE OF COMPACTION WILL BE CHECKED BY MAPPING THE AREA OF THE WORKING FACE WITH THE CAES SYSTEM MOUNTED ON THE COMPACTORS.
 6. TO MINIMIZED THE EXPOSED AREA OF WASTE AND USE OF COVER SOIL, THE WORKING FACE SHALL BE KEPT WIDE ENOUGH TO ACCOMODATE VEHICLES UNLOADING WASTE MATERIAL AND LANDFILL EQUIPMENT.
 7. INITIAL COVER, CONSISTING OF 6-INCHES OF SOIL, WILL BE SHALL BE APPLIED AT THE END OF EACH WORK DAY OVER EXPOSED WASTE. TEMPORARY COVER SUCH AS TARPULINS MAYBE USED IF WASTE IF WASTE WILL NOT BE EXPOSED FOR MORE THAN 18 HOURS. INCREASE THE FREQUENCY OF APPLICATION IF WIND AND OR RAIN DISPERSE WASTE.
 8. IN AREAS THAT WILL NOT RECEIVE WASTE WITHIN 180 DAYS, APPLY A 12-INCHES INTERMEDIATE COVER SOIL OVER THE EXISTING 6-INCHES OF INITIAL COVER.
 9. GRADES SHOWN ON THIS SEQUENCE ARE TOP OF INTERMEDIATE COVER
 10. ALL AREAS WITH INITIAL OR INTERMEDIATE COVER SHALL BE INSPECTED WEEKLY DEPENDING ON THE WEATHER CONDITIONS FOR DAMAGES DUE TO EROSION. DAMAGED AREAS SHALL BE REPAIRED QUICKLY AS OPERATIONS PERMIT. DAMAGED AREAS SHALL BE COVERED WITH SOD, SEED, OR MULCH TO PROTECT THE AREAS FROM ADDITIONAL DAMAGED.


PBS&J 482 South Keller Road Orlando, FL 32810-6101 Tel. (407) 647-7275 Fax. (407) 647-0624 www.pbsj.com POST BUCKLEY, SCHUH & JERNIGAN, Inc. 484 FRS&J 3001 N.W. 307th Ave., Miami, FL 33179-2607 FBPR Certificate of Authorization No.: 24	CLIENT	PROJECT	TASK	ORIGINAL MAY 2004 REV ISIONS: 1. _____ 2. _____ 3. _____ 4. _____ 5. _____	Name: JOSEPH L. MILLER Florida P.E. No.: 39177 Address: PBS&J 482 S. Keller Road Orlando, FL 32810-6101 Signature _____ Date _____	FLORIDA DEPARTMENT OF ENVIRONMENTAL PROTECTION OCT 07 2004 SOUTHWEST DISTRICT TAMPA	JOB NO. 00-000.00 DRAWN RGC DESIGN JLM/RGC CHECKED JLM Q.C. DED SHEET 7/13
	MANATEE COUNTY BOARD OF COUNTY COMMISSIONERS	LENA ROAD LANDFILL FILL SEQUENCE PLAN STAGE III LANDFILL	SEQUENCE 4 (AUG. 2006 - MAY 2007)				

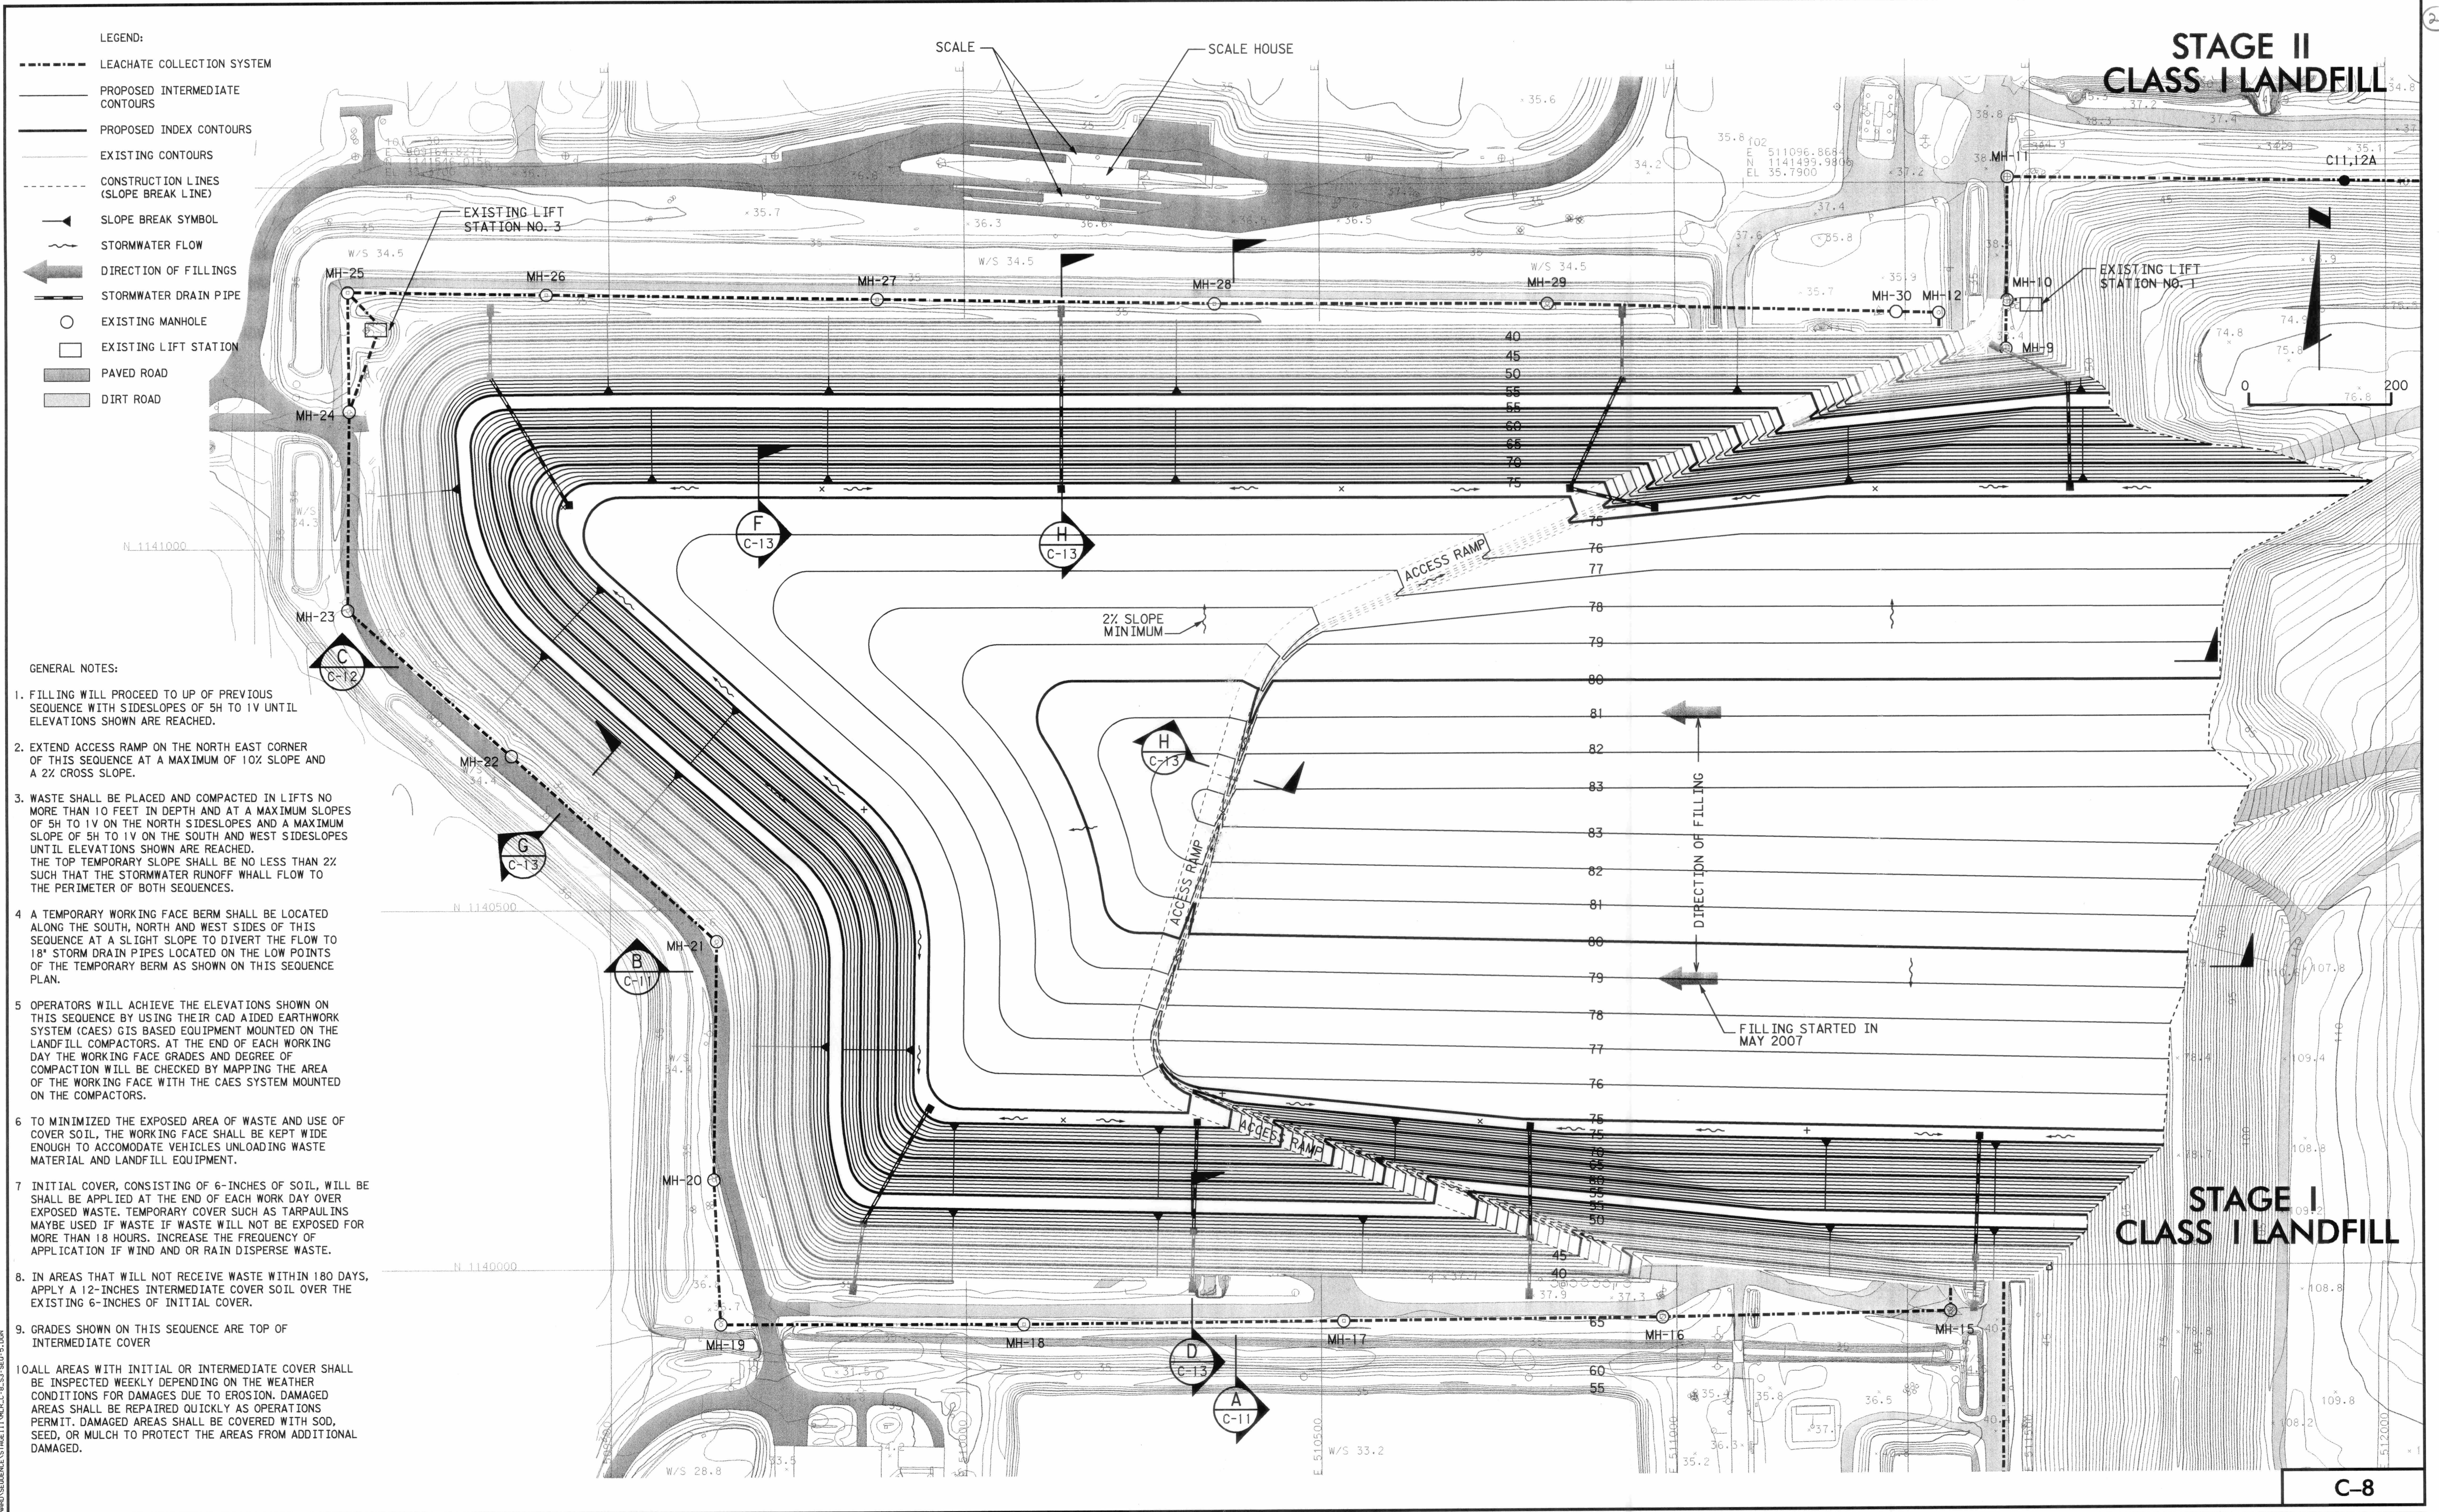

 482 South Keller Road Orlando, FL 32810-6101 Tel. (407) 647-7275 Fax. (407) 647-0624 www.pbsj.com POST BUCKLEY, SCHUH & JERNIGAN, Inc. dba PBS&J 2001 N.W. 107th Ave., Miami, FL 33178-2607 FPR Certificate of Authorization No. 24	CLIENT	PROJECT	TASK	ORIGINAL MAY 2004 REVISIONS:	Name: JOSEPH L. MILLER Florida P.E. No.: 39177 Address: PBS&J 482 S. Keller Road Orlando, FL 32810-6101 Signature _____ Date _____ FLORIDA DEPARTMENT OF ENVIRONMENTAL PROTECTION OCT 07 2004 SOUTHWEST DISTRICT TAMPA	JOB NO. 00-000.00 DRAWN RGC DESIGN JLM/RGC CHECKED JLM Q.C. DED
	MANATEE COUNTY BOARD OF COUNTY COMMISSIONERS	LENA ROAD LANDFILL FILL SEQUENCE PLAN STAGE III LANDFILL	SEQUENCE 5 (MAY 2007 - FEB 2009)	1. _____ 2. _____ 3. _____ 4. _____ 5. _____		SHEET 8/13

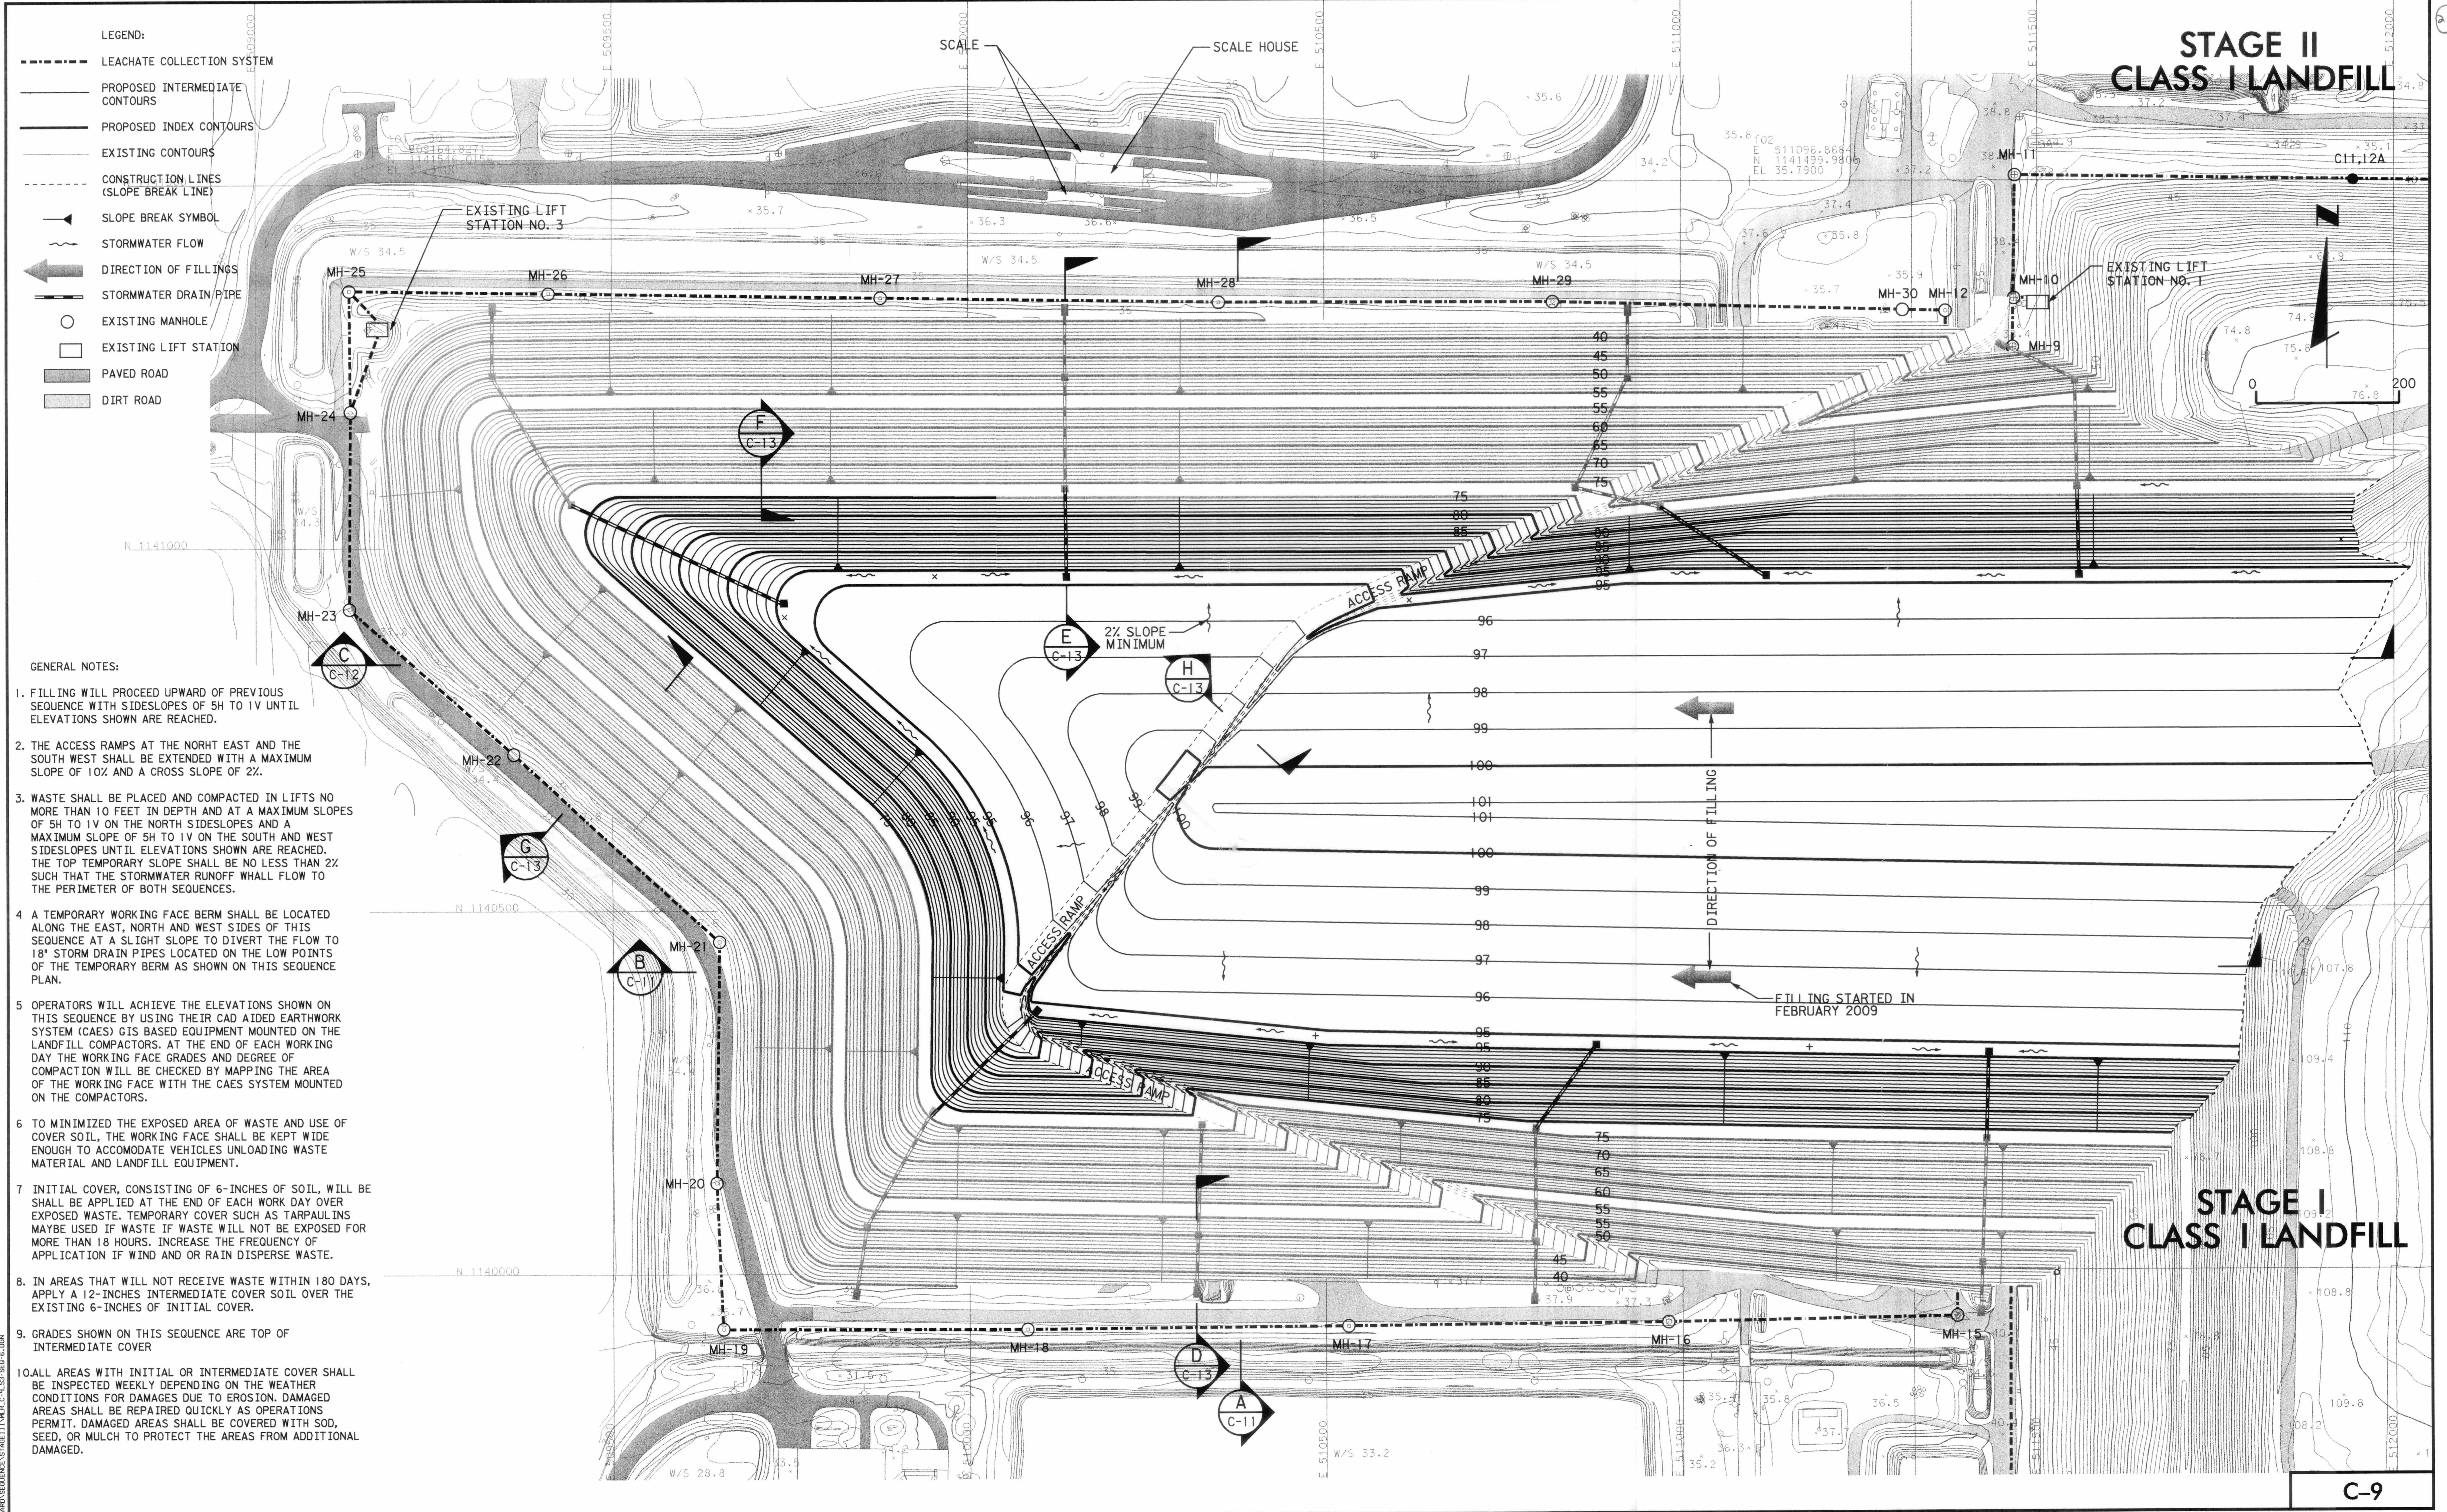

 482 South Keller Road Orlando, FL 32810-6101 Tel. (407) 647-7275 Fax. (407) 647-0624 www.pbsj.com POST BUCKLEY, SCHUH & JERNIGAN, Inc. dba PBS&J 3901 N.W. 107th Ave., Miami, FL 33179-2507 FBPR Certificate of Authorization No. 24	CLIENT	PROJECT	TASK	ORIGINAL MAY 2004 REVISIONS: 1. _____ 2. _____ 3. _____ 4. _____ 5. _____	Name: JOSEPH L. MILLER Florida P.E. No.: 39177 Address: PBS&J 482 S. Keller Road Orlando, FL 32810-6101 Signature _____ Date _____	 OCT 07 2004 SOUTHWEST DISTRICT TAMPA	JOB NO. 00-000.00 DRAWN RGC DESIGN JLM/RGC CHECKED JLM Q.C. DED SHEET 9/13
	MANATEE COUNTY BOARD OF COUNTY COMMISSIONERS	LENA ROAD LANDFILL FILL SEQUENCE PLAN STAGE III LANDFILL	SEQUENCE 6 (FEB 2009 – FEB 2013)				

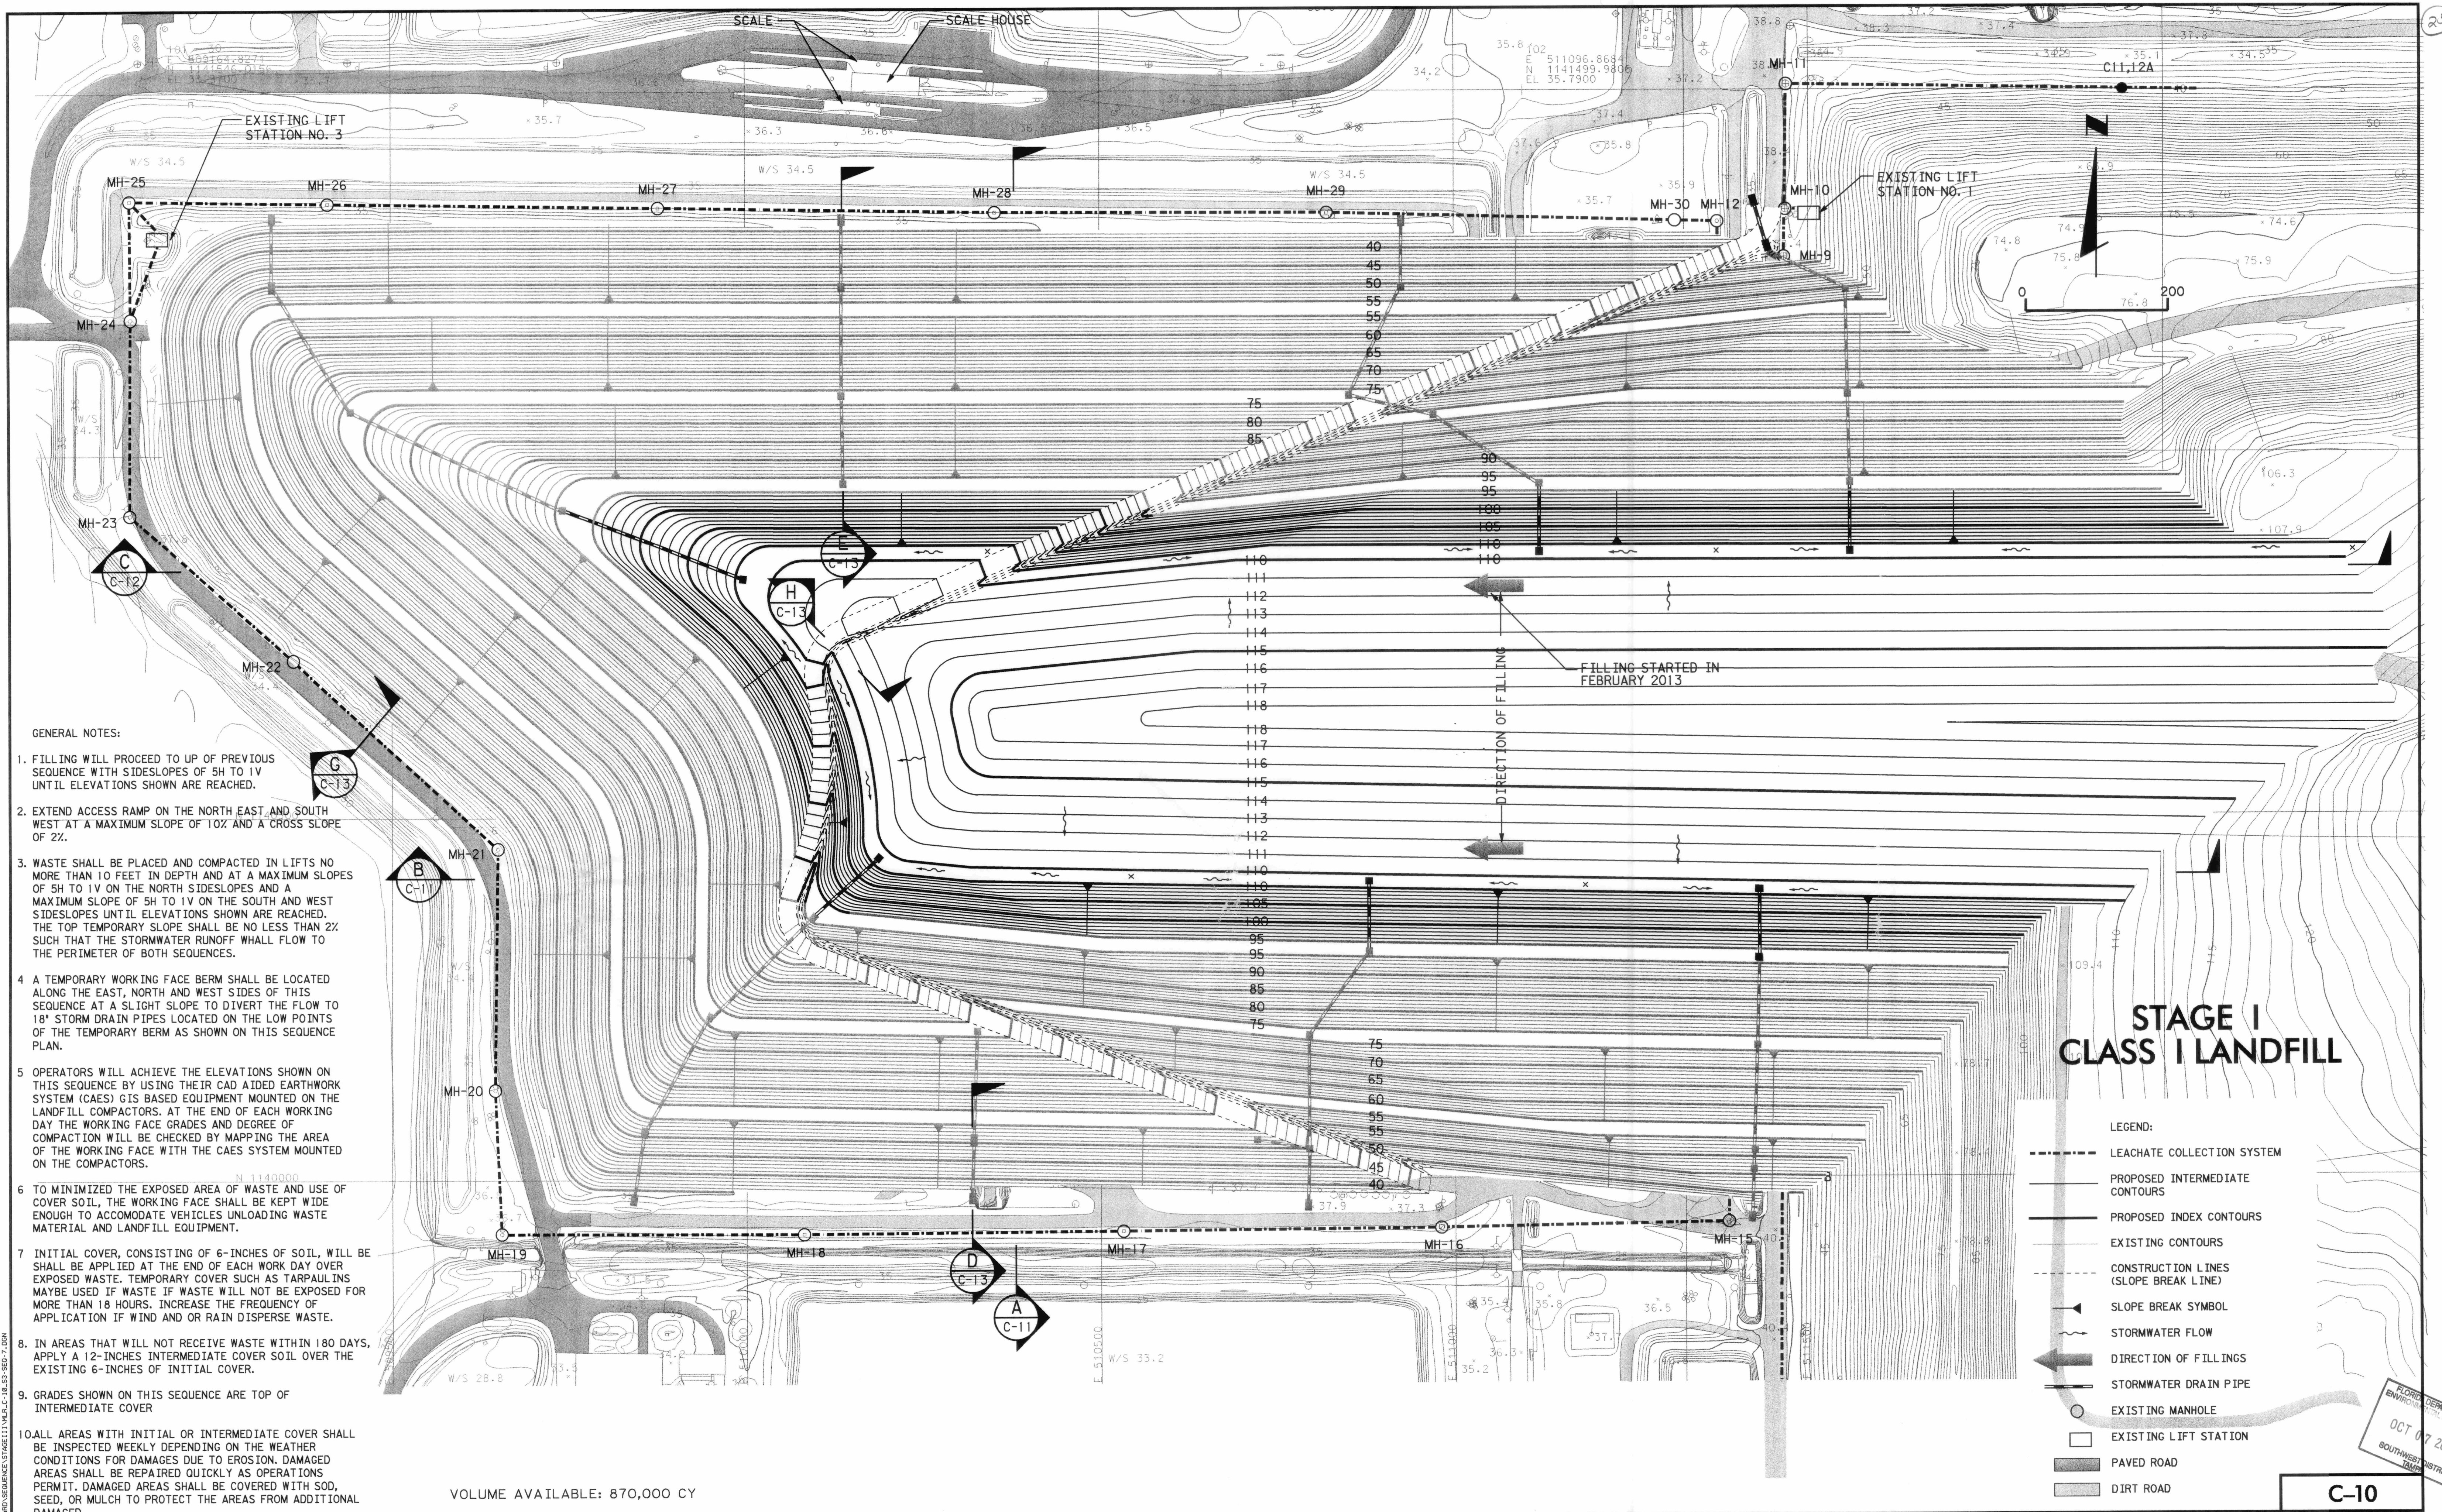

PBS&

482 South Keller Road
Orlando, FL 32810-6101
Tel. (407) 647-7275
Fax. (407) 647-0624
www.pbsj.com

PORT BUCKLEY, SCHUH & JERNIGAN, Inc.
John P. Schuh
3001 N.W. 107th Ave., Miami, FL 33178-3507
FBPR Certificate of Authorization No. 34

CLIENT
MANATEE COUNTY
BOARD OF COUNTY COMMISSIONERS

PROJECT
LENA ROAD LANDFILL
FILL SEQUENCE PLAN
STAGE III LANDFILL


TASK
SEQUENCE 7
(FEB 2013 – MAR 2014)

ORIGINAL MAY 2004
REVISIONS:
1.
2.
3.
4.
5.

Name: JOSEPH L. MILLER
Florida P.E. No.: 39177
Address: PBS&J
482 S Keller Road
Orlando, FL 32810-6101
Signature _____
Date _____


JOB NO. 00-000.00
DRAWN RGC
DESIGN JLM/RGC
CHECKED JLM
Q.C. DED
SHEET 10/13

U:\01\15\ENV\CAZ\WASTE\MANATEE\LENA\ROAD\SEQUENCE\STAGE III\W.L.C.-10-53-2004-7.DGN

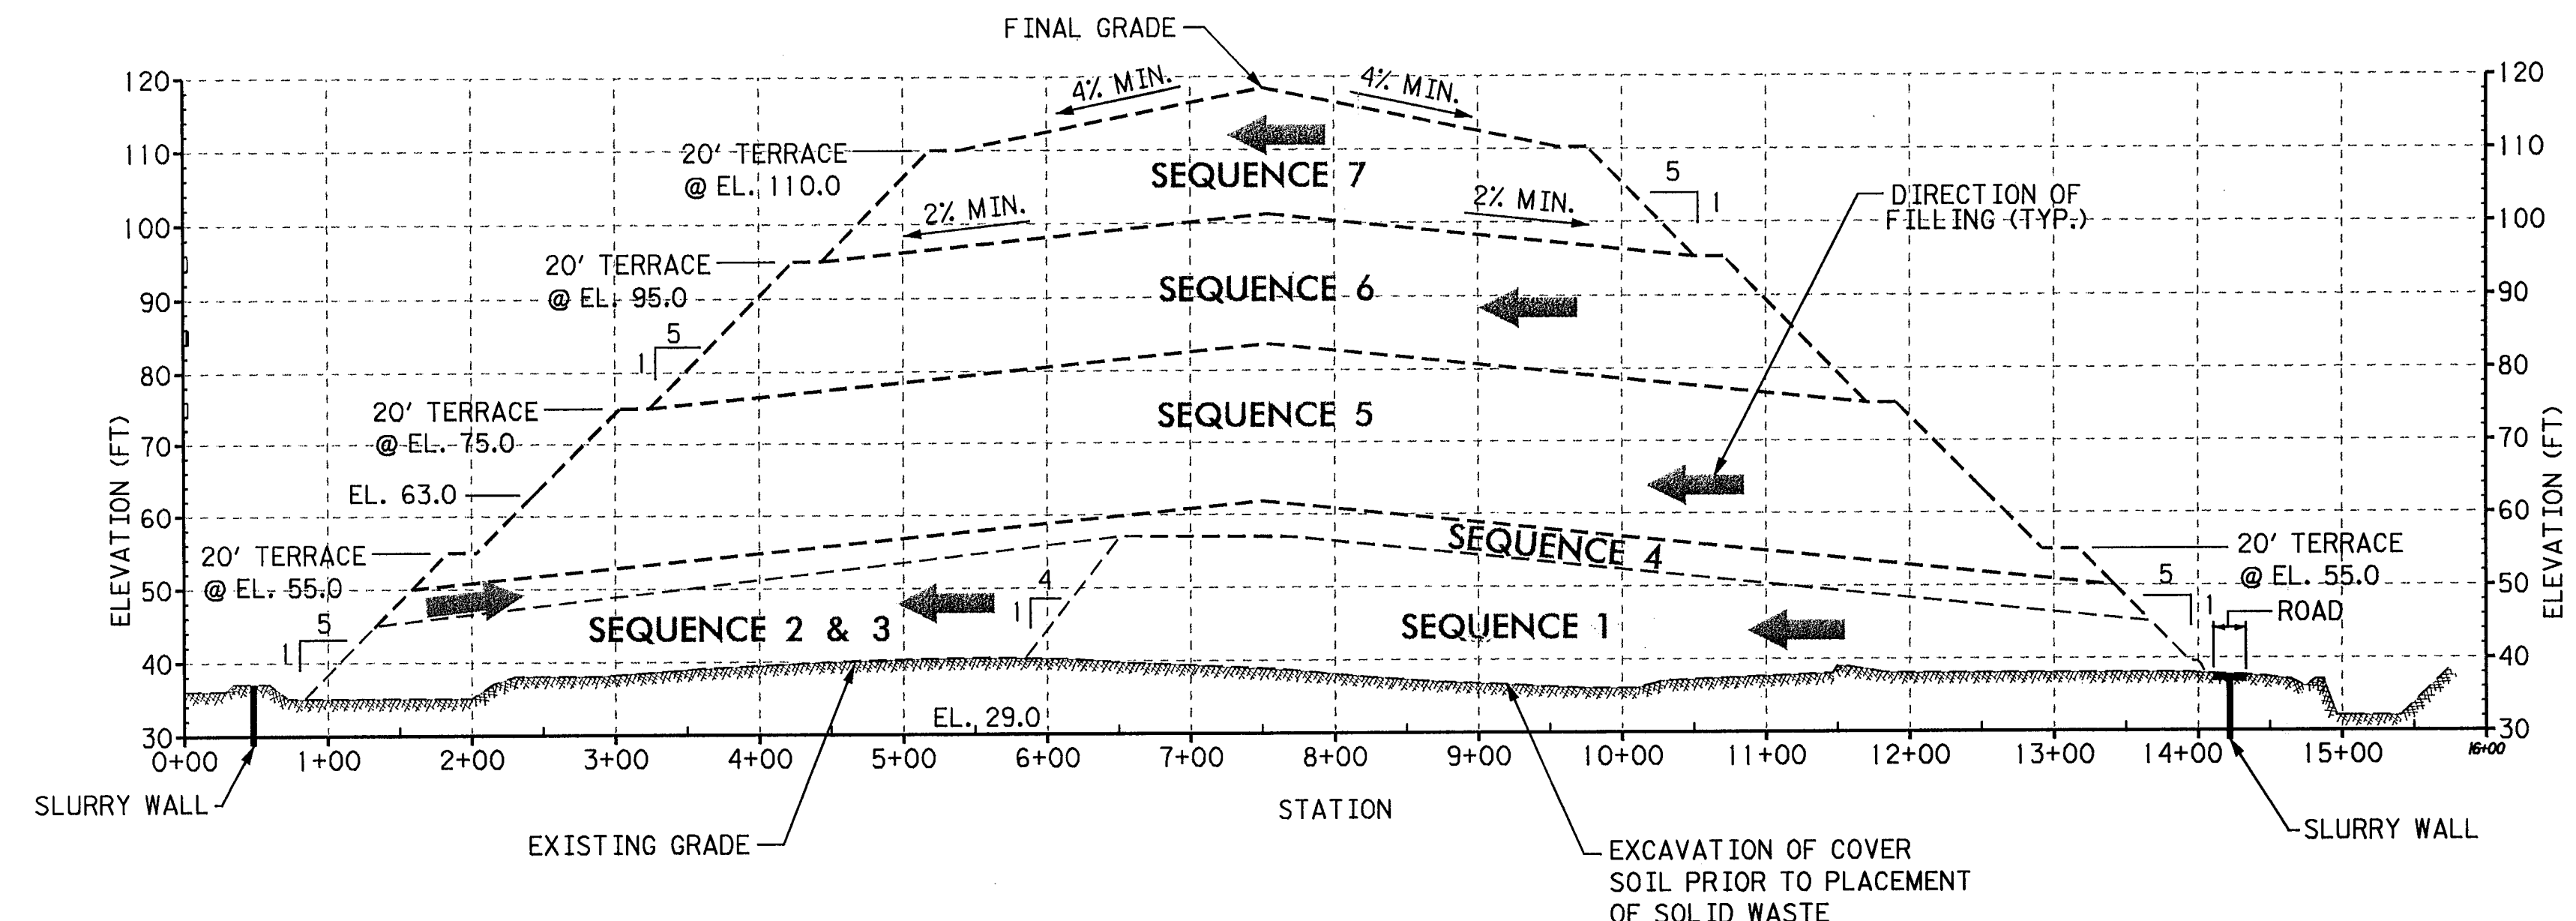

SECTION A A A A A A A
SCALE: N.T.S. C-4 C-5 C-6 C-7 C-8 C-9 C-10

STAGE III LIMITS

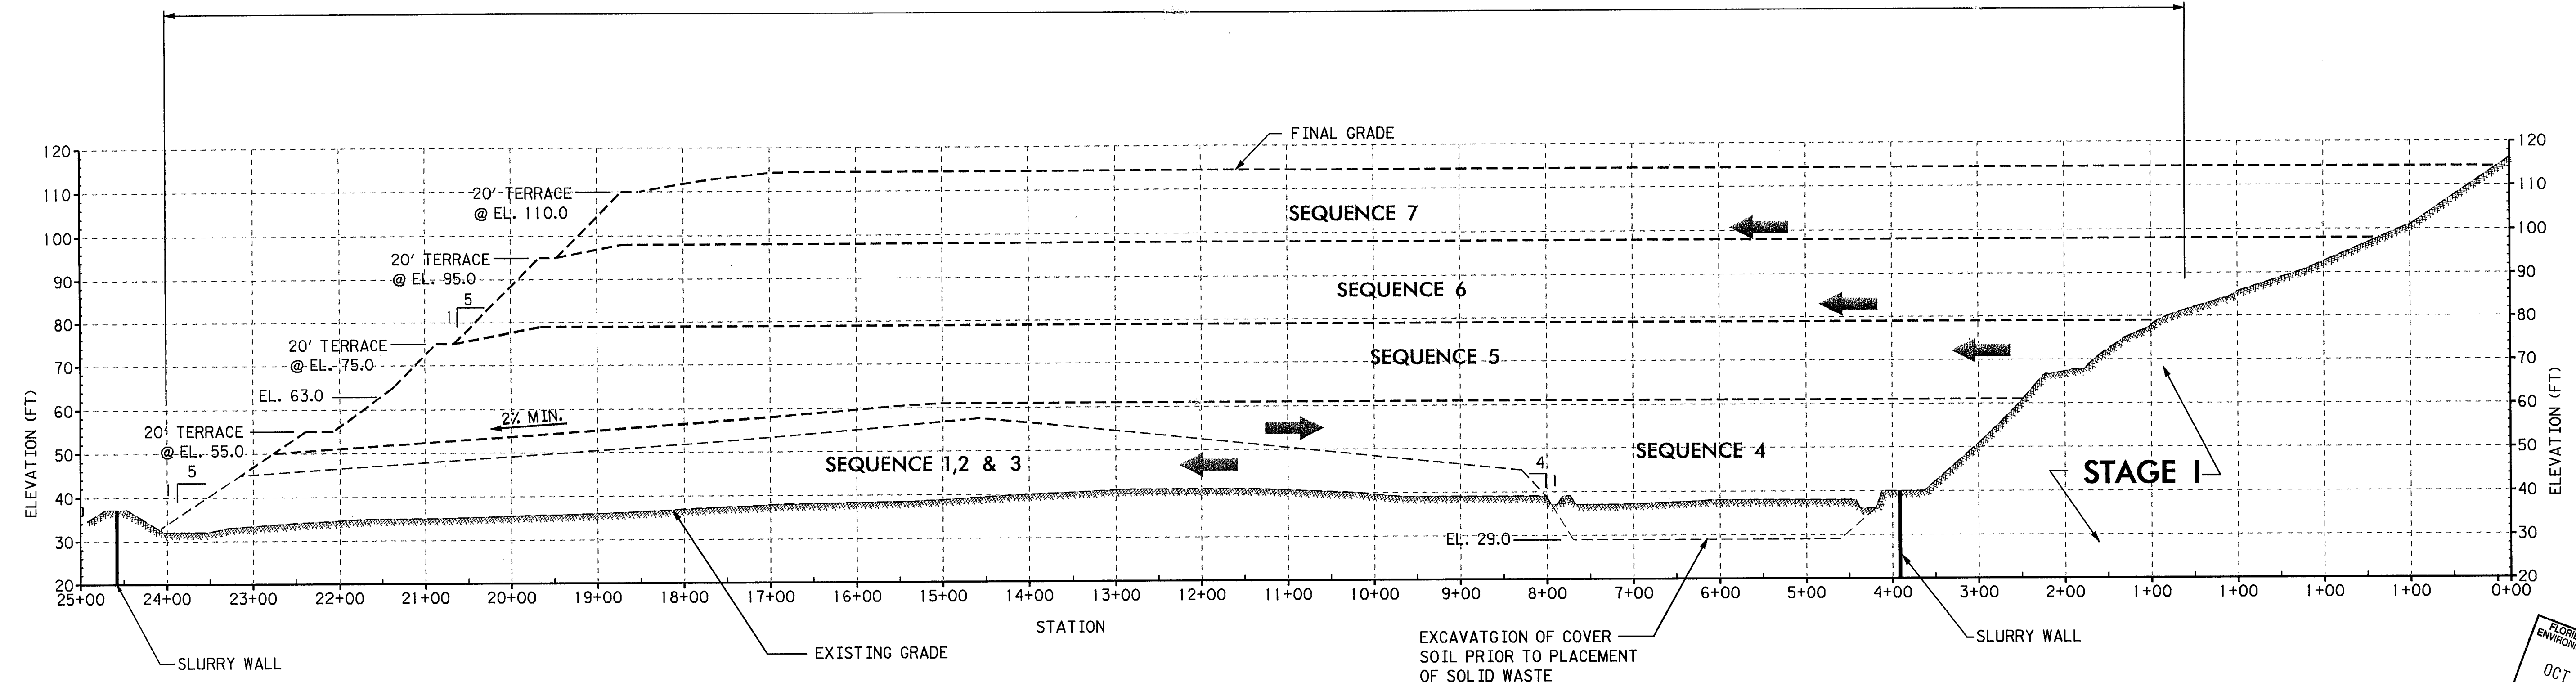

SECTION B B B B B B B
SCALE: N.T.S. C-4 C-5 C-6 C-7 C-8 C-9 C-10

FLORIDA DEPARTMENT OF
ENVIRONMENTAL PROTECTION
OCT 07 2004
SOUTHWEST DISTRICT
DMPA

C-11



432 South Keller Road
Orlando, FL 32810-6101
Tel. (407) 647-7275
Fax. (407) 647-0624
www.pbsj.com
POST BUCKLEY, SCHUH & JERNIGAN, Inc.
dba PBS&J
2001 N.W. 107th Ave., Miami, FL 33179-2607
FDEPR Certificate of Authorization No.: 24

CLIENT
MANATEE COUNTY
BOARD OF COUNTY COMMISSIONERS



PROJECT
LENA ROAD LANDFILL
FILL SEQUENCE PLAN
STAGE III LANDFILL

TASK
CROSS SECTIONS



ORIGINAL MAY 2004
REVISIONS:
1.
2.
3.
4.
5.

Name: JOSEPH L. MILLER
Florida P.E. No.: 39177
Address: PBS&J
432 S. Keller Road
Orlando, FL 32810-6101
Signature _____ Date _____

JOB NO. 00-000.00
DRAWN RGC
DESIGN JLM/RGC
CHECKED JLM
Q.C. DED
SHEET 11/11

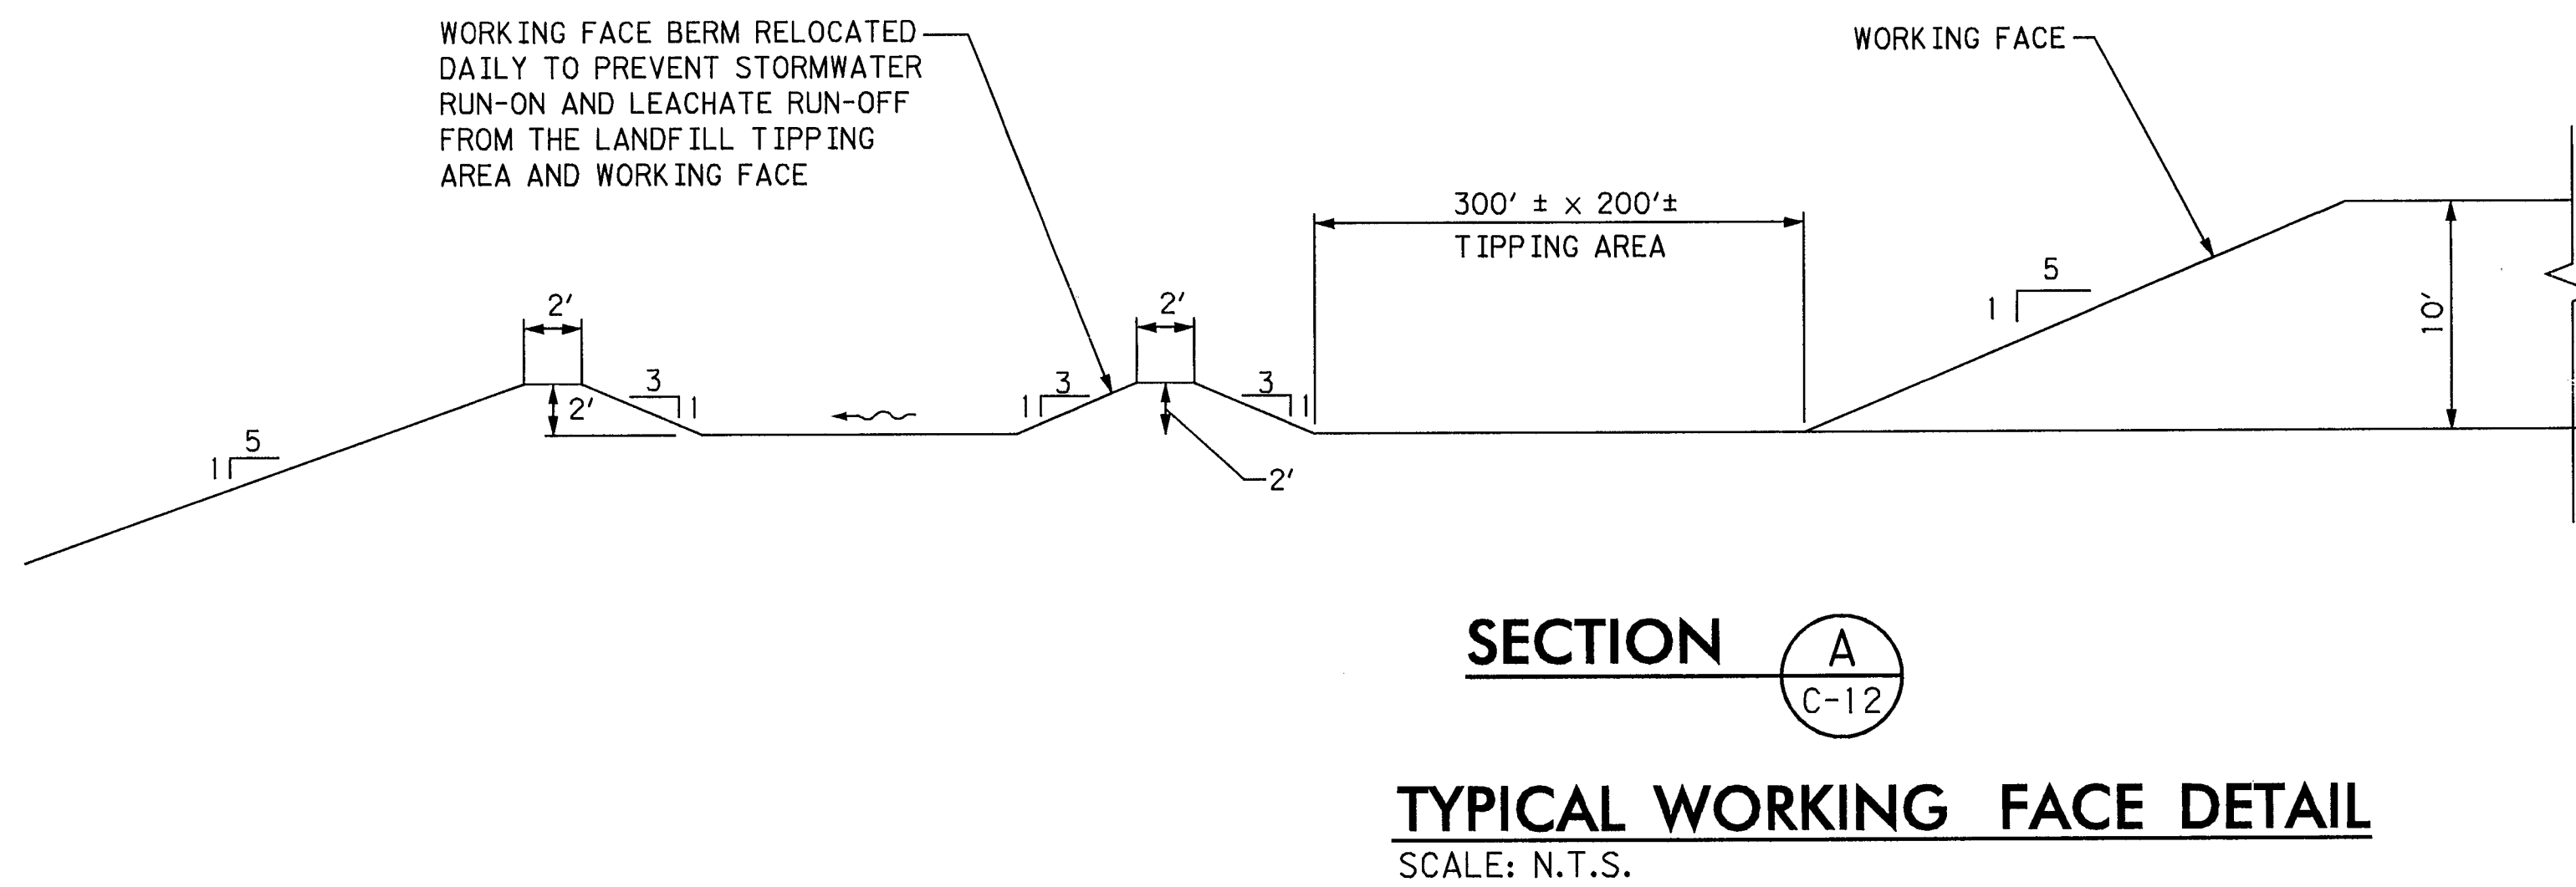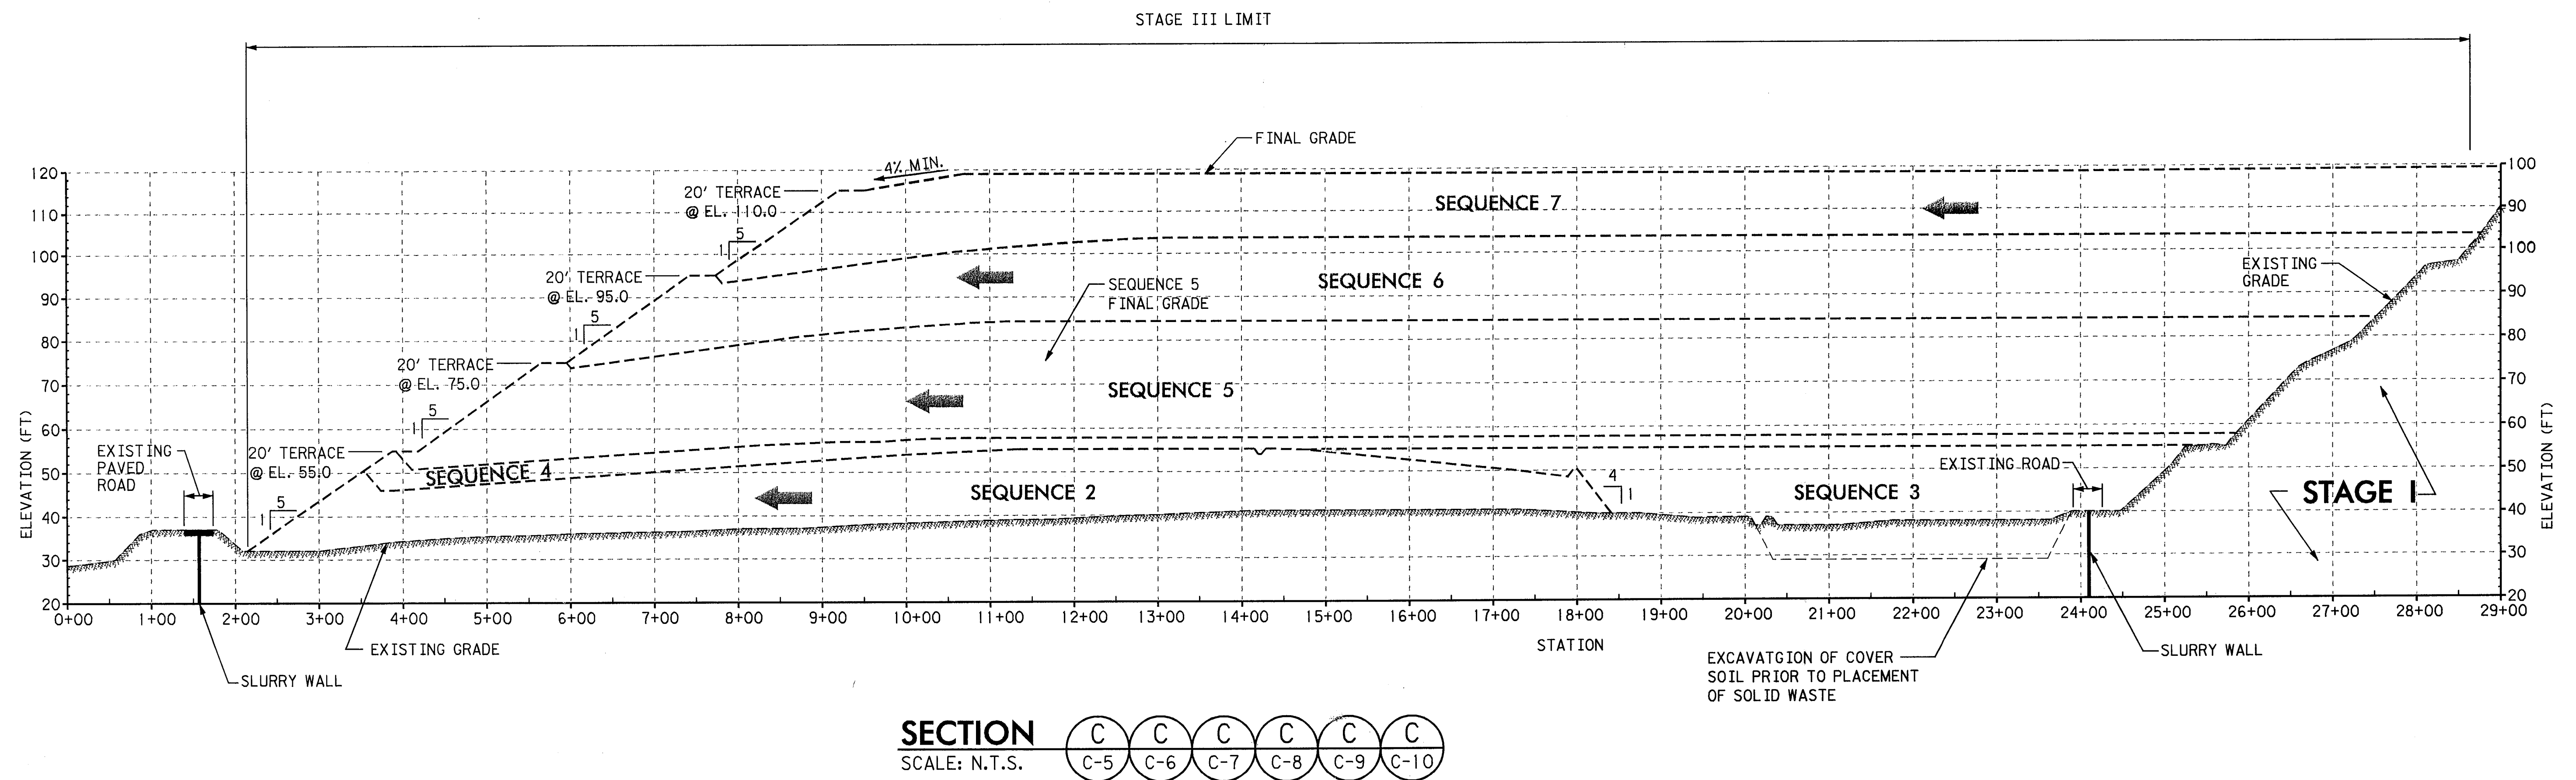

WORKING FACE BERM RELOCATED DAILY TO PREVENT STORMWATER RUN-ON AND LEACHATE RUN-OFF FROM THE LANDFILL TIPPING AREA AND WORKING FACE

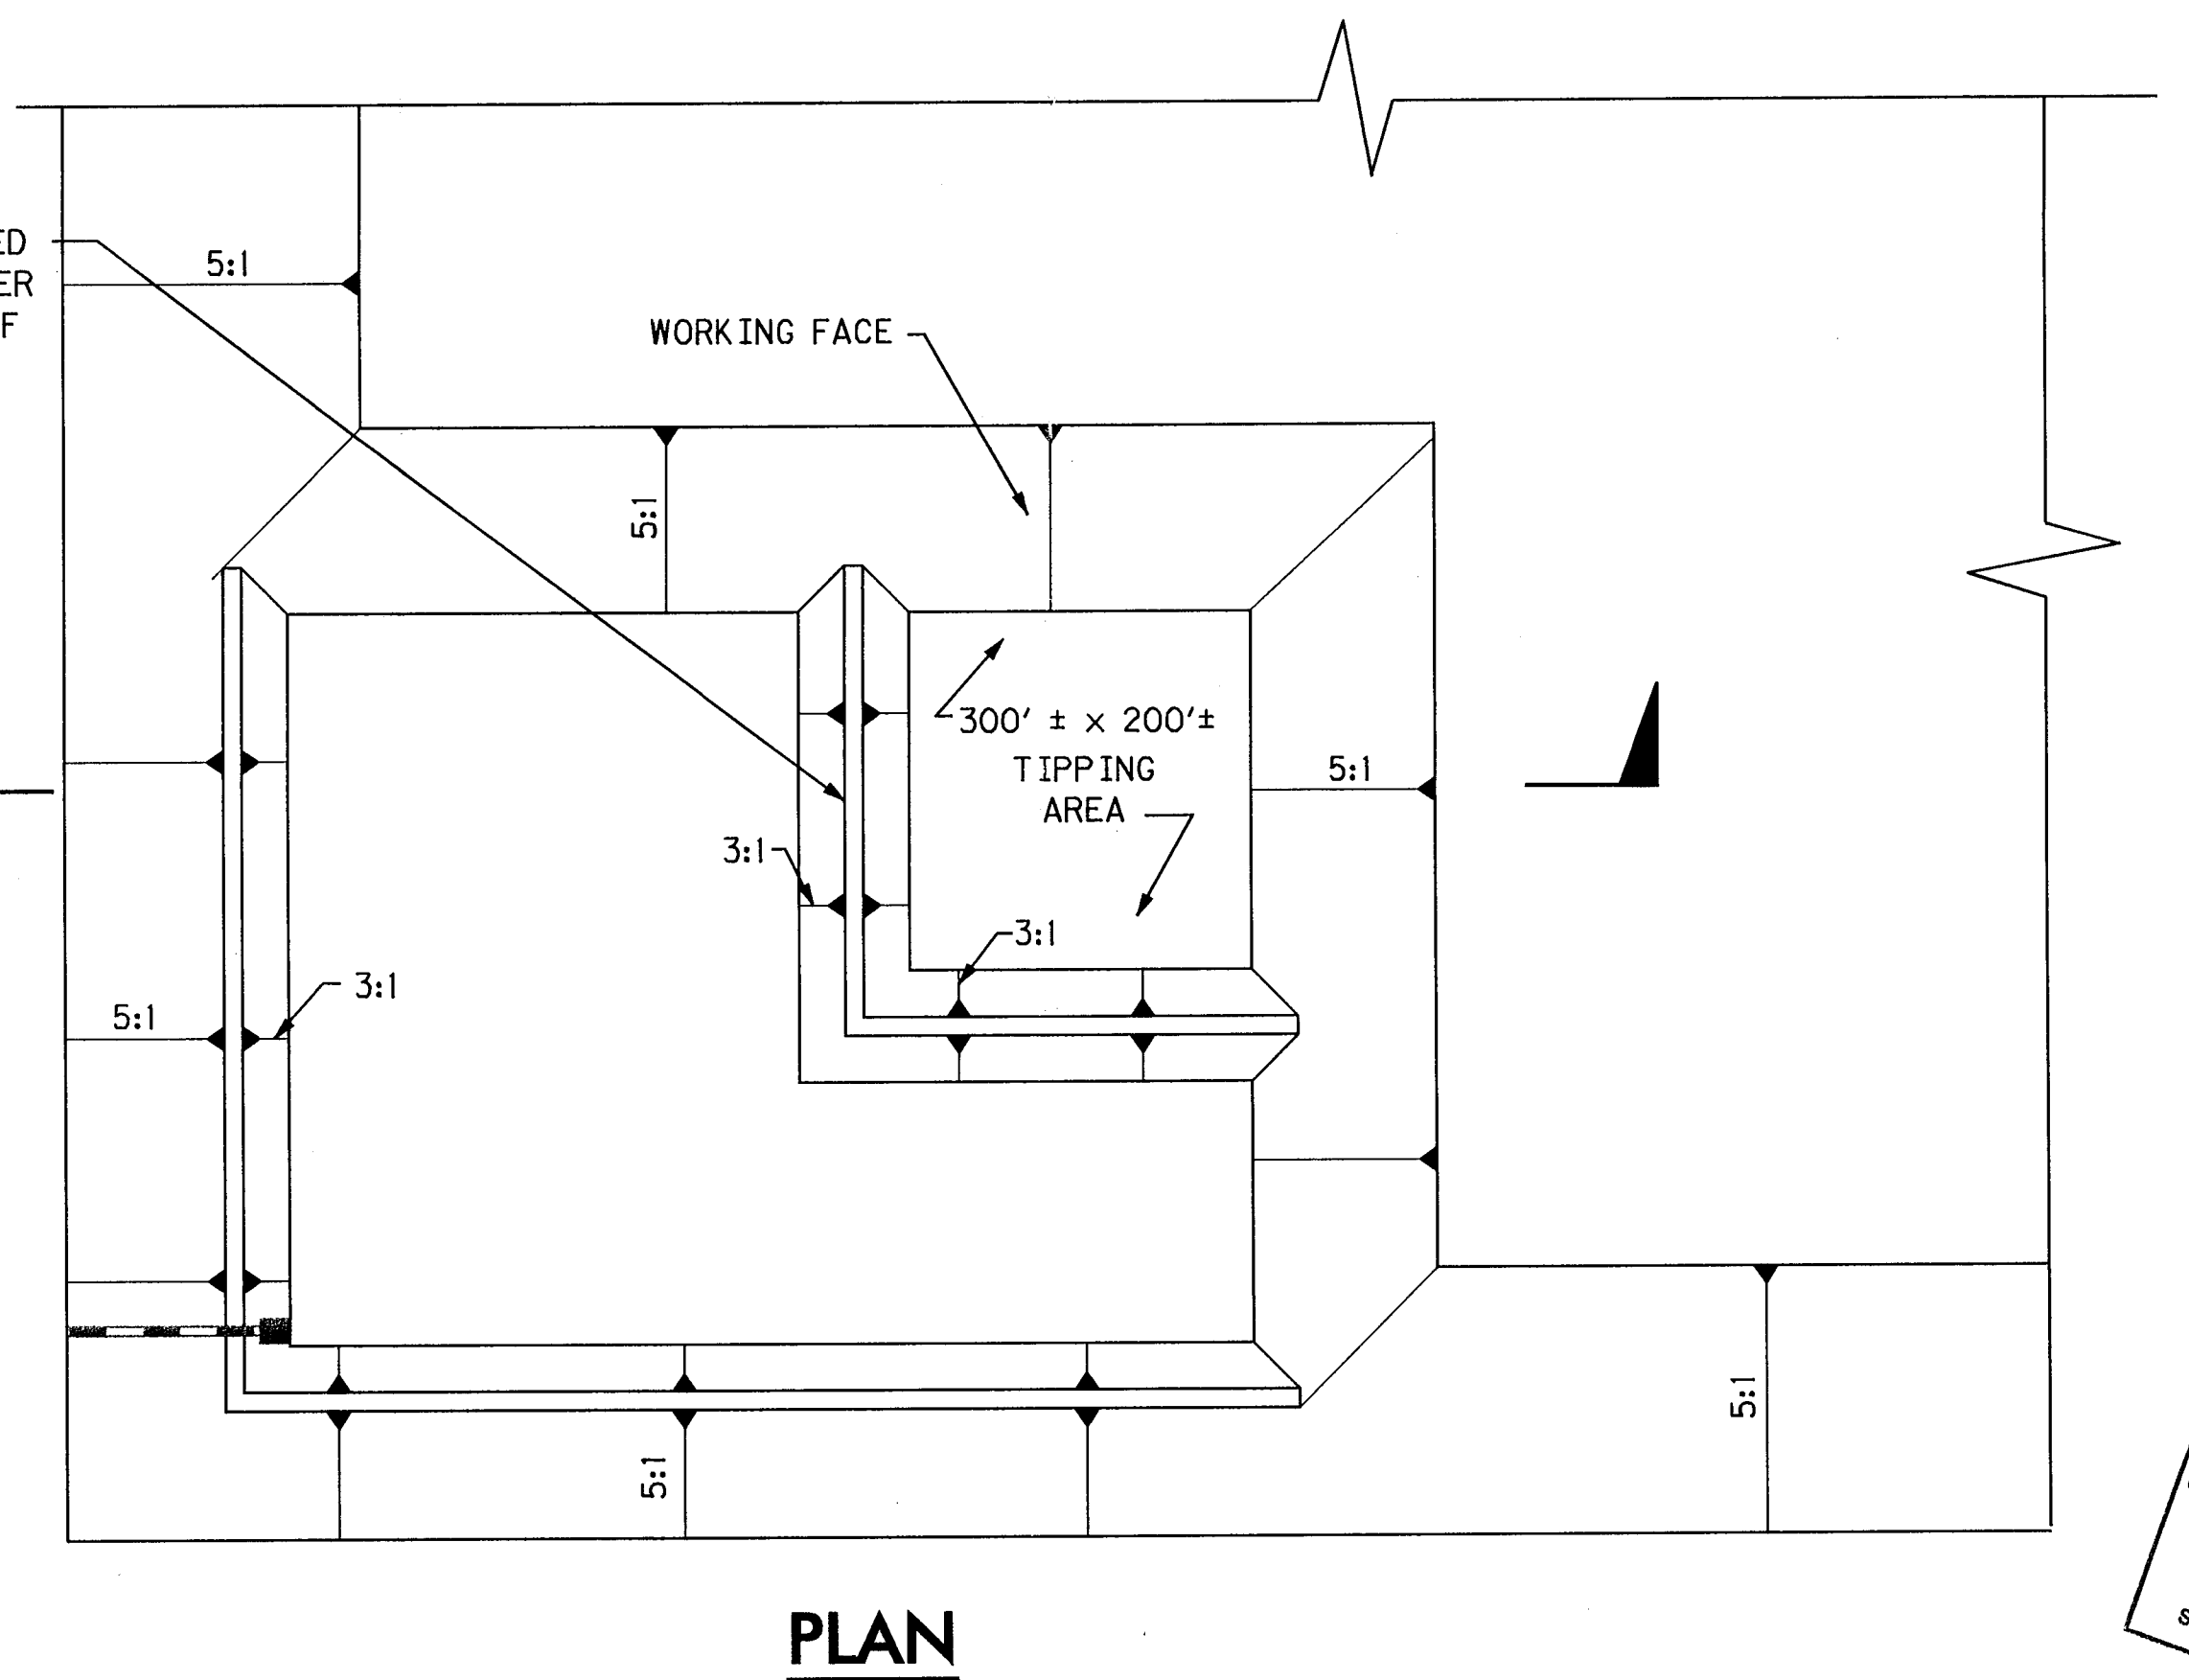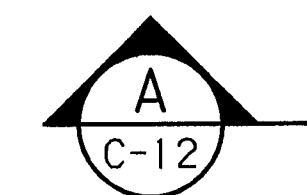

FLORIDA DEPARTMENT OF
ENVIRONMENTAL PROTECTION
OCT 07 2004
SOUTHWEST DISTRICT
LADPA

C-12



482 South Keller Road
Orlando, FL 32810-6101
Tel. (407) 647-7275
Fax. (407) 647-0624
www.pbsj.com
POST BUCKLEY, SCHUH & JERNIGAN, Inc.
dba PBS&J
2001 N.W. 107th Ave., Miami, FL 33179-2507
FBPR Certificate of Authorization No. 24

CLIENT
MANATEE COUNTY
BOARD OF COUNTY COMMISSIONERS


PROJECT
LENA ROAD LANDFILL
FILL SEQUENCE PLAN
STAGE III LANDFILL

TASK
CROSS SECTION


ORIGINAL MAY 2004
REVISIONS:
1.
2.
3.
4.
5.

Name: JOSEPH L. MILLER
Florida P.E. No.: 39177
Address: PBS&J
482 S. Keller Road
Orlando, FL 32810-6101
Signature _____ Date _____


JOB NO. 00-000.00
DRAWN RGC
DESIGN JLM/RGC
CHECKED JLM
Q.C. DED
SHEET 12/13

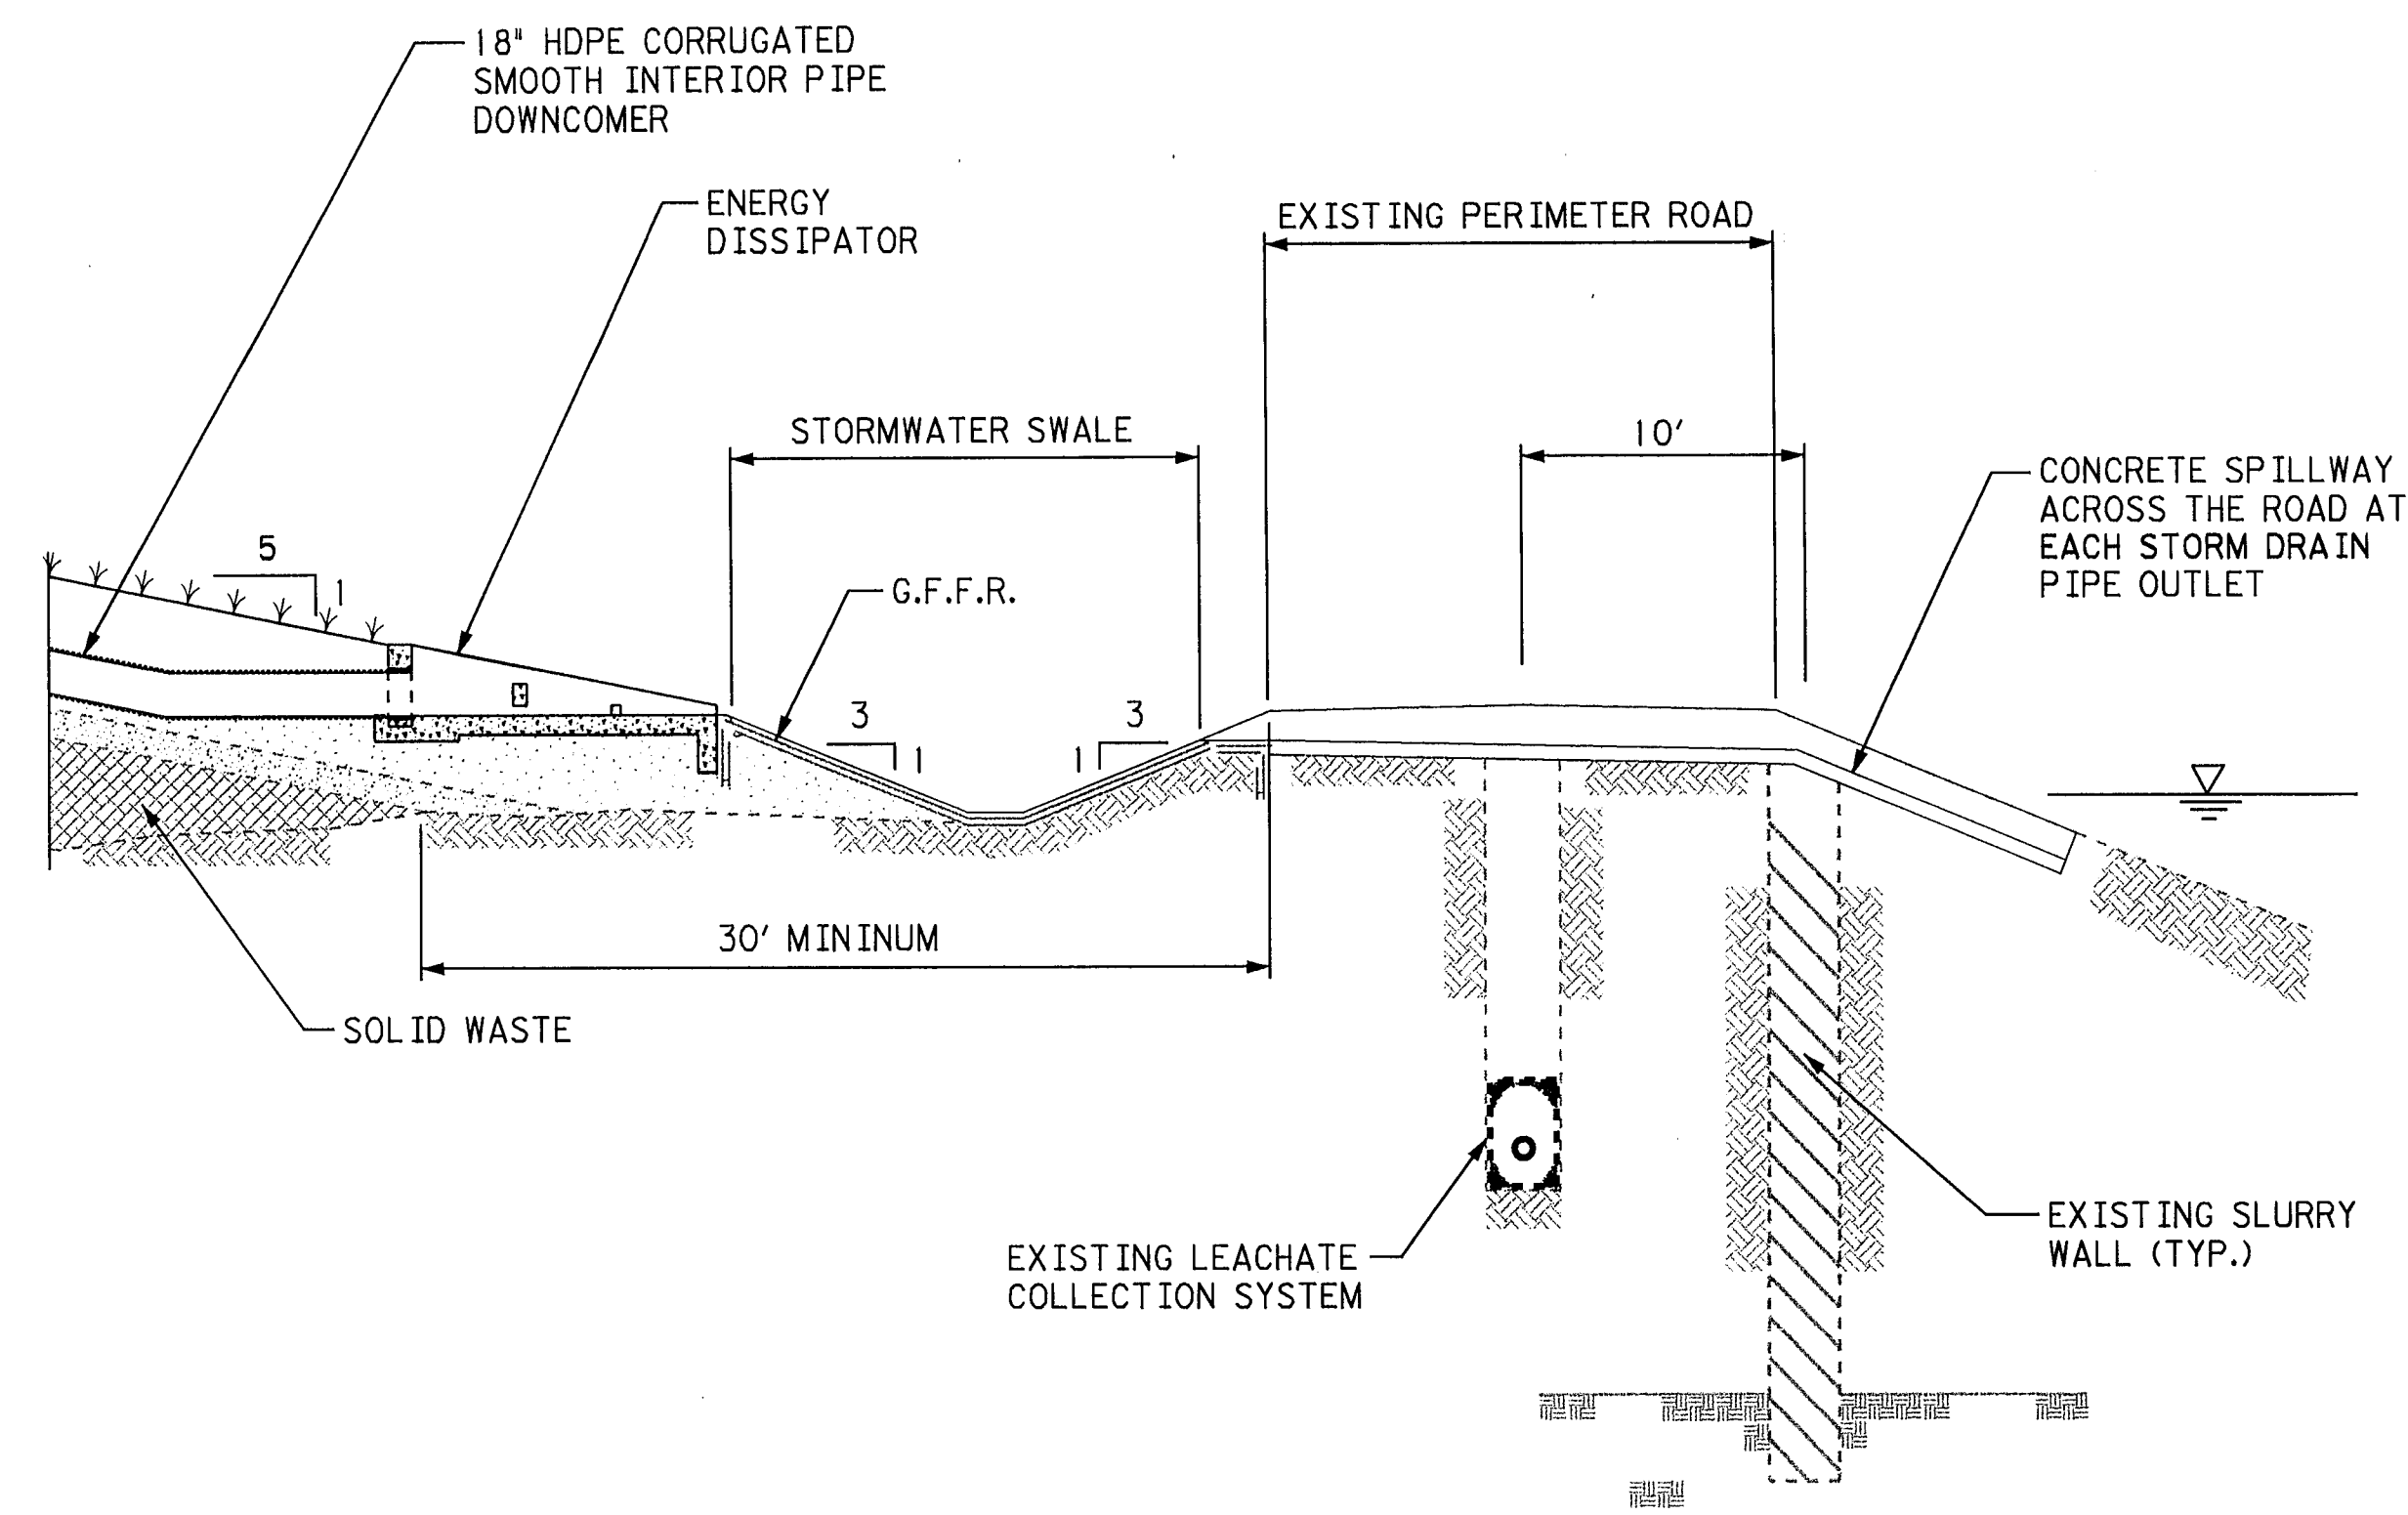


SECTION D D D D D D D
SCALE: N.T.S. C-4 C-5 C-6 C-7 C-8 C-9 C-10

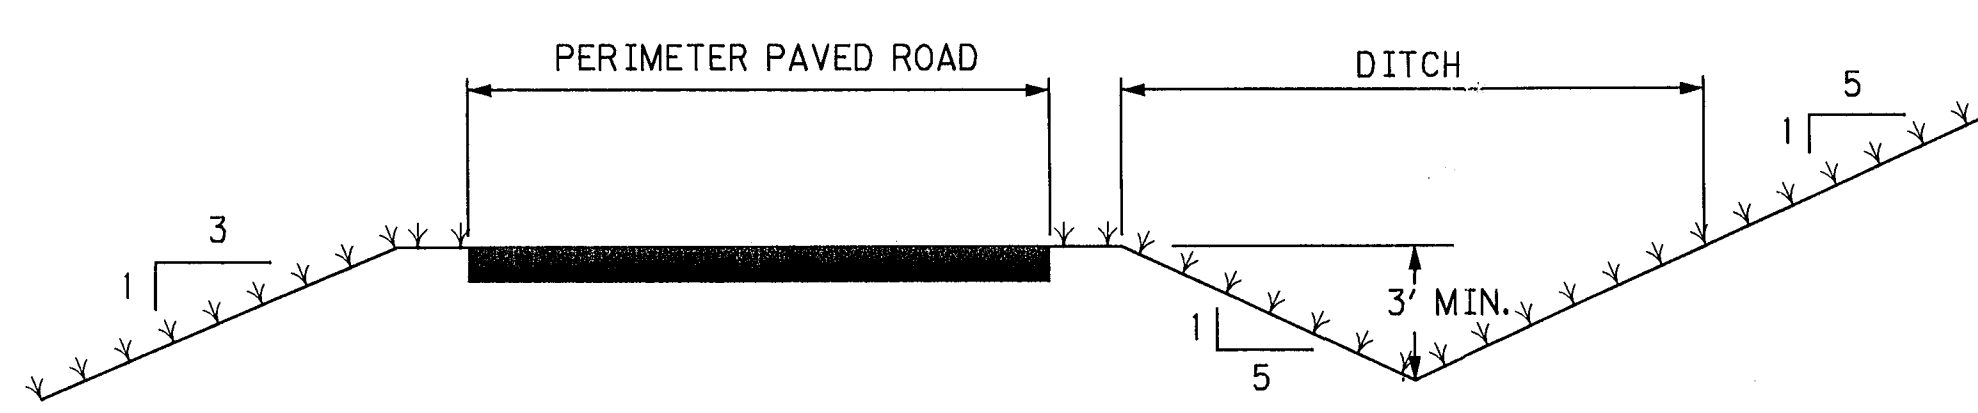


PERIMETER ROAD G G G G G G G
SCALE: N.T.S. C-4 C-5 C-6 C-7 C-8 C-9 C-10

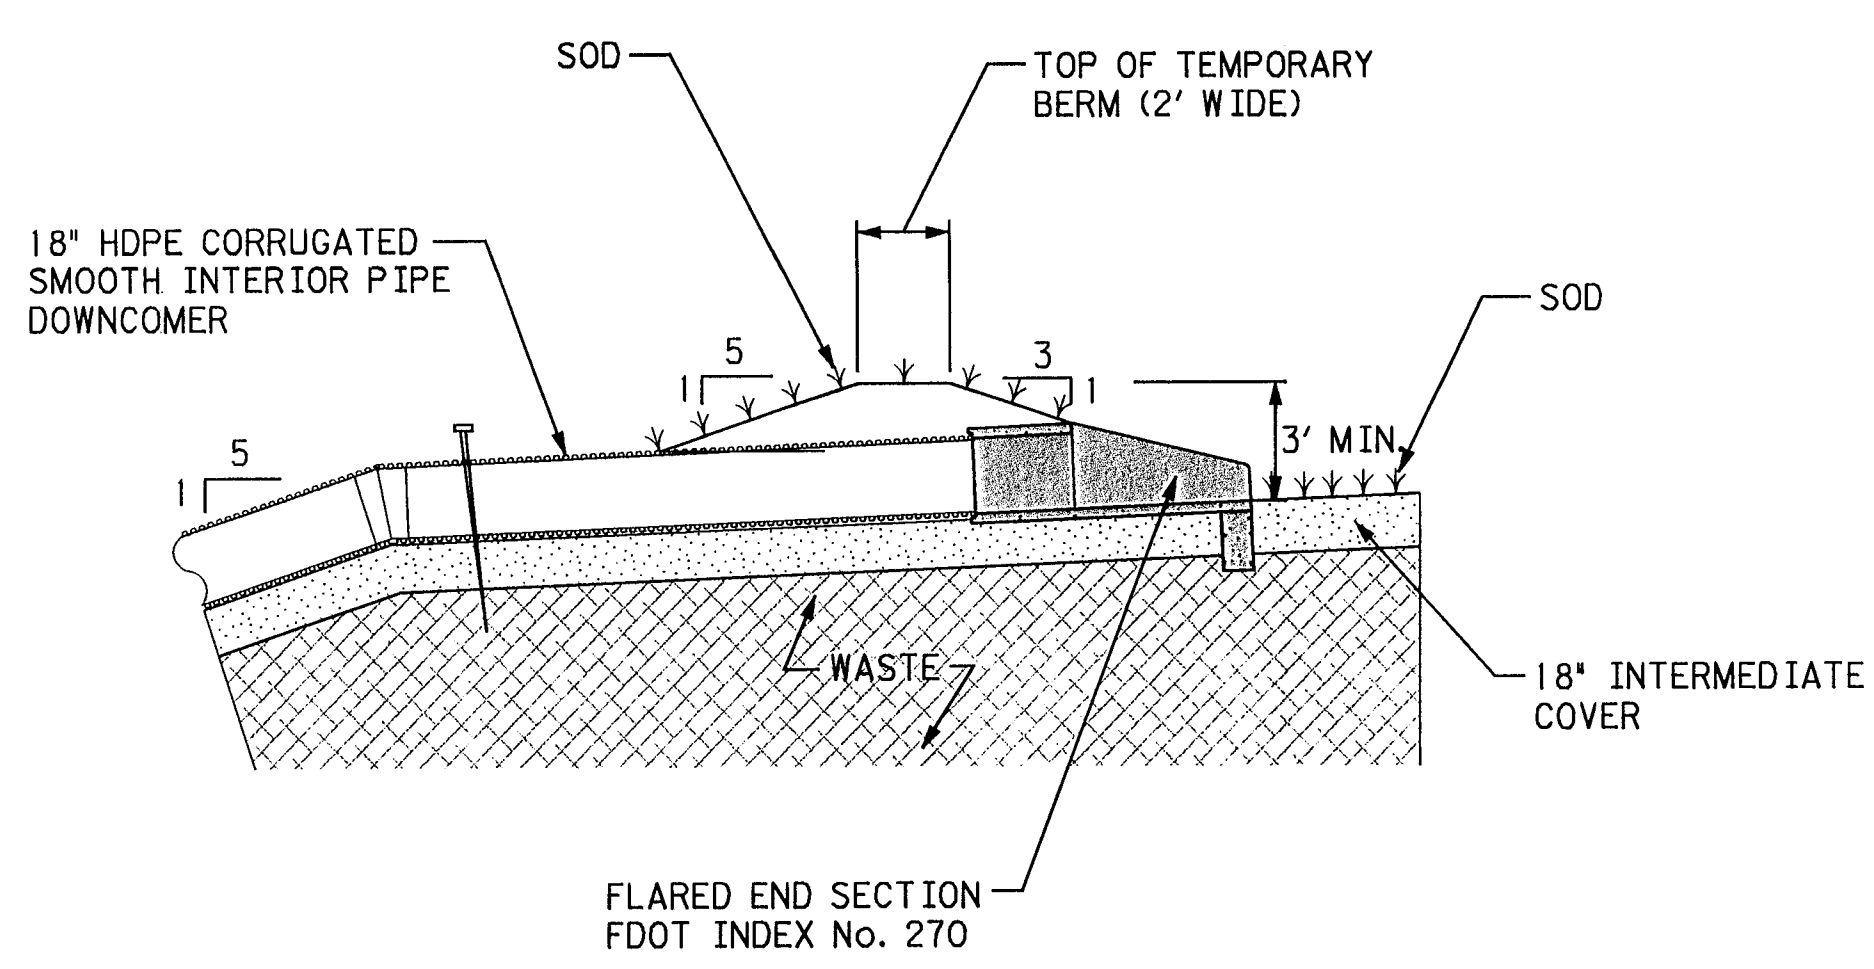


SECTION E E E E E
SCALE: N.T.S. C-6 C-7 C-8 C-9 C-10

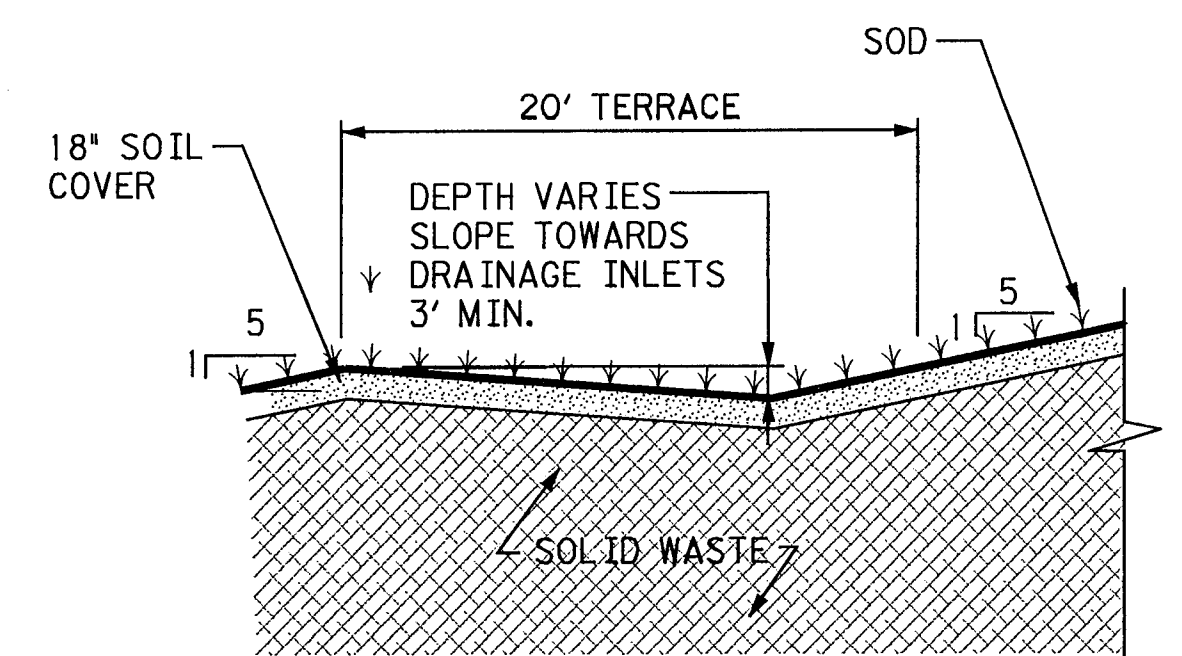

SECTION F F F
SCALE: N.T.S. C-8 C-9 C-10

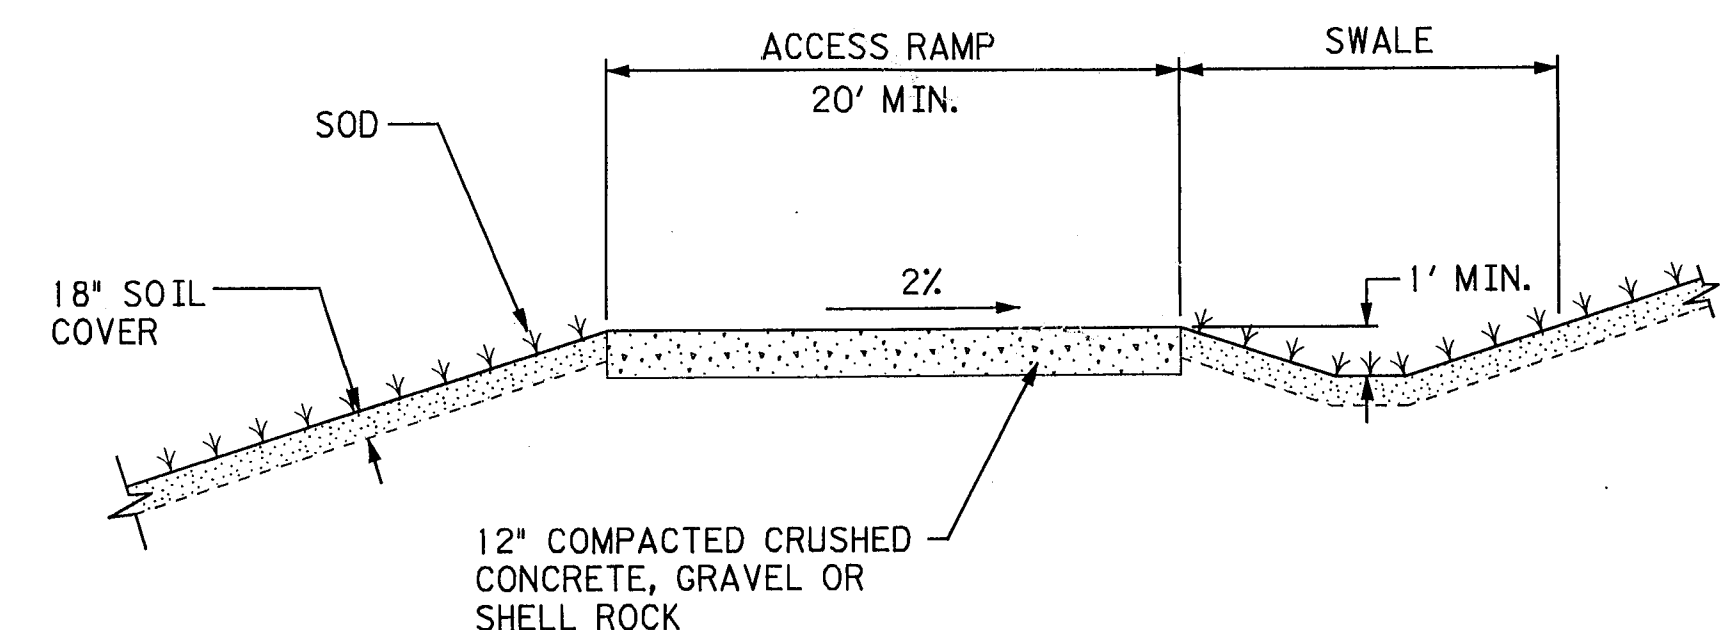

ACCESS RAMP H H H H H H H
SCALE: N.T.S. C-4 C-5 C-6 C-7 C-8 C-9 C-10

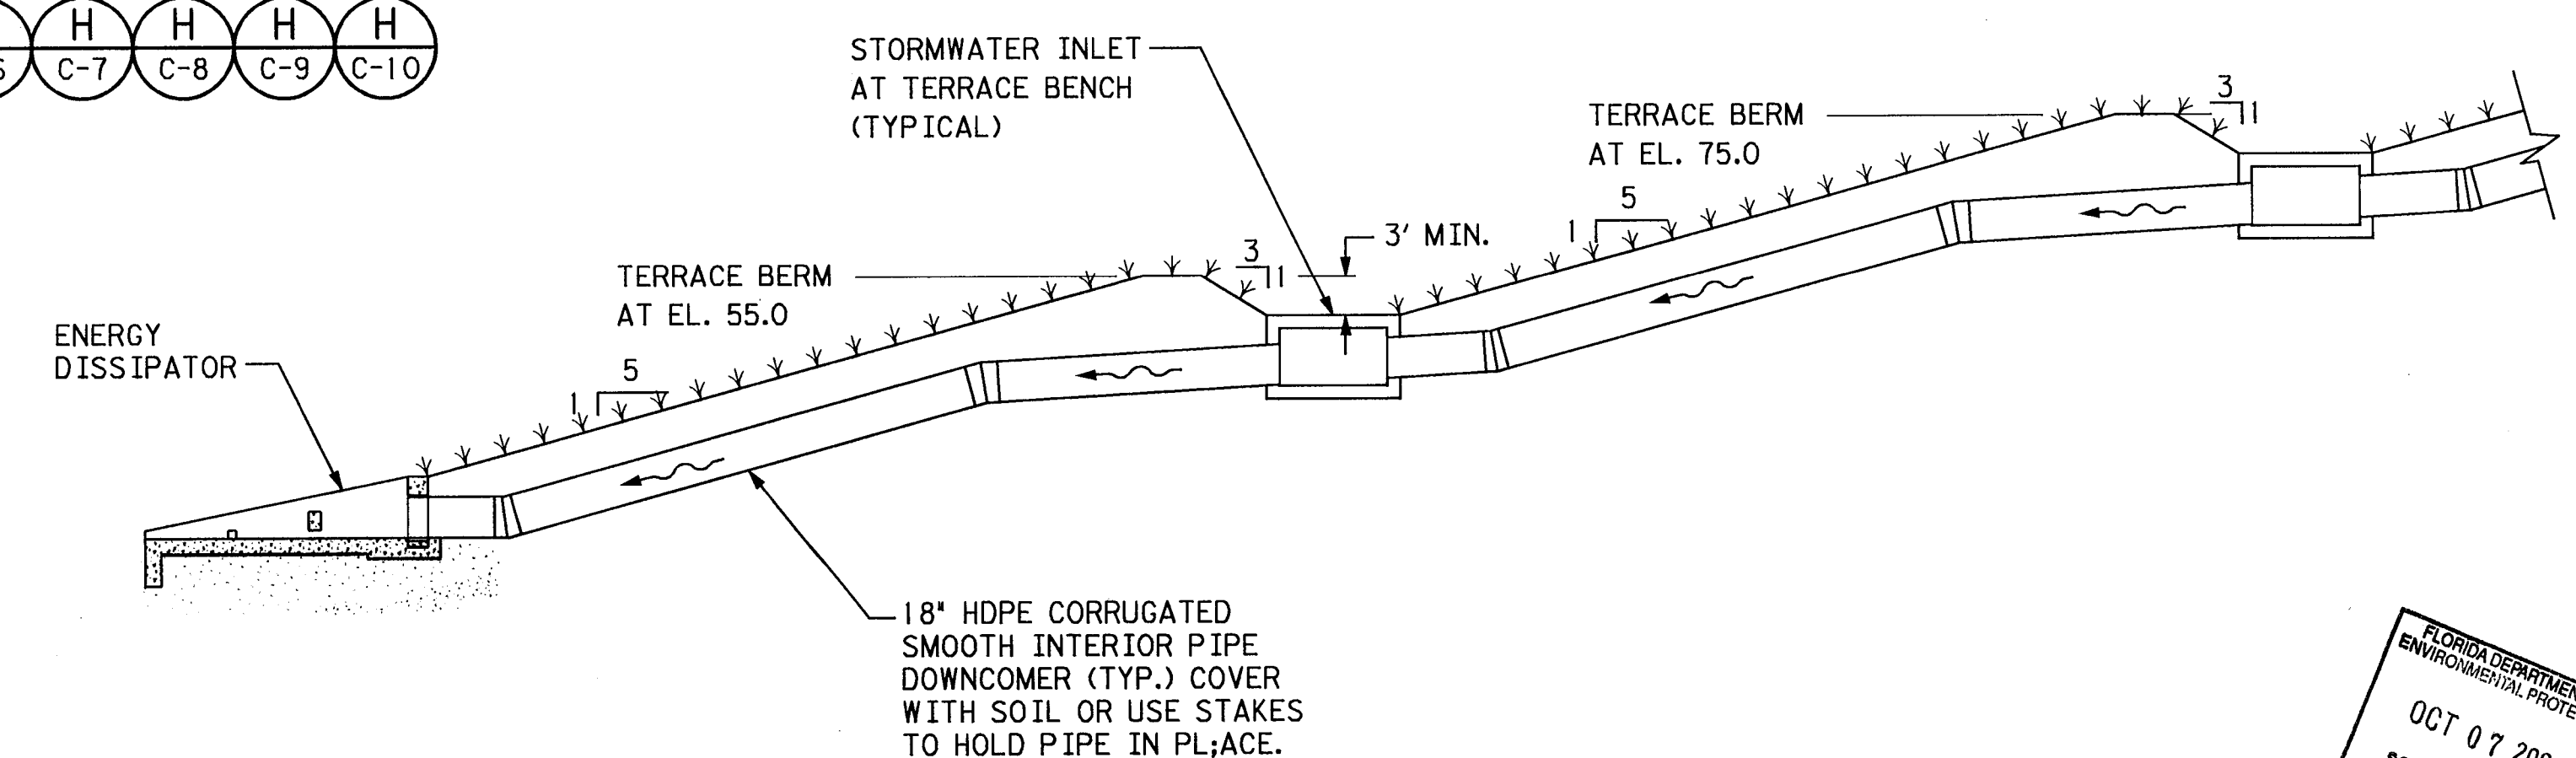

SECTION I
SCALE: N.T.S. C-5

FLORIDA DEPARTMENT OF
ENVIRONMENTAL PROTECTION
OCT 07 2004
SOUTHWEST DISTRICT
JMD

C-13



482 South Keller Road
Orlando, FL 32810-6101
Tel. (407) 647-7275
Fax. (407) 647-0624
www.pbsj.com
POST BUCKLEY, SCHUH & JERNIGAN, Inc.
Job: PBS&J
2001 N.W. 107th Ave., Miami, FL 33178-2507
FBPR Certificate of Authorization No: 24

CLIENT
MANATEE COUNTY
BOARD OF COUNTY COMMISSIONERS

PROJECT
LENA ROAD LANDFILL
FILL SEQUENCE PLAN
STAGE III LANDFILL

TASK
DETAILS

ORIGINAL MAY 2004
REVISIONS:
1. _____
2. _____
3. _____
4. _____
5. _____

Name: JOSEPH L. MILLER
Florida P.E. No.: 38177
Address: PBS&J
482 S. Keller Road
Orlando, FL 32810-6101
Signature _____ Date _____

JOB NO. 00-000.00
DRAWN RGC
DESIGN JLM/RGC
CHECKED JLM
Q.C. DED
SHEET 13/13

