D. E. R.

FEB - 5 1991

SOUTHWEST DISTINCT TAMPA

INSTALLATION OF SURFICIAL

AQUIFER PIEZOMETERS AT

"LENA ROAD LANDFILL,

MANATEE COUNTY, FLORIDA"



Ardaman & Associates, Inc.

## **OFFICES**

Orlando, 8008 S. Orange Avenue, P.O. Box 32859-13003, Orlando, Florida 32809, Phone (305) 855-3860

Bartow, 1987 S. Holland Parkway, Bartow, Florida 33830, Phone (813) 533-0858

Bradenton, 209 A 6th Avenue East, P.O. Box 34206-1335, Bradenton, Florida 34208, Phone (813) 748-3971

Cocoa, 1300 N. Cocoa Blvd., P.O. Box 32924-3557, Cocoa, Florida 32922, Phone (305) 632-2503

Fort Myers, 2508 Rockfill Road, Fort Myers, Florida 33916, Phone (813) 337-1288

Miami, 7476-7478 N.W. 8th Street, Miami, Florida 33126, Phone (305) 261-1682

Sarasota, 2500 Bee Ridge Road, P.O. Box 34277-15008, Sarasota, Florida 34239, Phone (813) 922-3526

Tallahassee, 3175 West Tharpe Street, Tallahassee, Florida 32303, Phone (904) 576-6131

## MEMBERS:

American Concrete Institute
American Society for Testing and Materials
American Consulting Engineers Council
Association of Soil and Foundation Engineers
Florida Institute of Consulting Engineers
Professional Engineers in Private Practice



## Ardaman & Associates, Inc.

Consultants in Soils, Hydrogeology, Foundations and Materials Testing

January 14, 1991 File No. 90-8073

TO:

Manatee County Public Works Department

Caller Service 25010 Bradenton, FL 34206

Attention: Mr. Greg F. Yekaitis

SUBJECT:

Installation of Surficial Aquifer Piezometers per FDER-Approved Groundwater Monitoring Plan at "Lena Road Landfill, Manatee County, Florida" (BRO-RO No. 90466-

19631)

## Gentlemen:

As requested by Mr. Greg Yekaitis, we have completed the installation of thirteen (13) surficial aquifer piezometers and the plugging of one (1) existing monitor well at the site referenced above. The piezometers are designated PZ-1 to PZ-7 and PZ-12 to PZ-17, and the plugged well is CW-3,, the locations of which are shown on the attached Figure 1.

Piezometers PZ-8 to PZ-11 are also to be installed along the Stage 2 portion of the landfill. As requested by the client, the installation of these piezometers will be postponed until the completion of other construction in the area, in order to minimize the risk of damage to the piezometers.


The piezometer installation logs are presented on Plates 1 to 13 of the Appendix of this report. The construction (or plugging) permit numbers for the piezometers and CW-3, and the latitude/longitude of each piezometer location are listed in the following table.

Piezometer No.	Permit No.*	Latitude	Longitude
PZ-1	90-680	27°28'06"	82°26'46"
PZ-2	90-681	27°27'57"	82°26'46"
PZ-3	90-682	27°27'54"	82°26'41"
PZ-4	90-683	27°27'54"	82°26'35"
PZ-5	90-684	27°27'54"	82°26'22"
PZ-6	90-685	27°28'08"	82°26'22"
PZ-7	90-686	27°28'20"	82°26'22"
PZ-12	90-687	27°28'19"	82°26'54"
PZ-13	90-688	27°28'19"	82°27'07"
PZ-14	90-689	27°28'18"	82°27'11"
PZ-15	90-690	27°28'14"	82°27'09"
PZ-16	90-691	27°28'07"	82°27'05"
PZ-17	90-692	27°28'07"	82°26'51"
CW-3	90-069P (plugged)		

<sup>\*</sup> by Manatee County Public Health Unit

Our scope of work included performing an auger boring at each piezometer location, installing the piezometers according to specifications, developing the piezometers and preparing a report presenting pertinent installation data as required per the groundwater monitoring plan for the subject site. The soil samples obtained from the borings were returned to our laboratory for visual inspection and classification in general compliance with the Unified Soil Classification System (ASTM D-2487) by a geotechnical engineer. The results of the borings were used to select the final depth and collection zone length for each piezometer. The soil profiles are shown on the respective Plate in the Appendix of this report.

The six-inch diameter bore holes for the piezometers were advanced by hollow-stem auger. After reaching the final depth, the piezometers were constructed by inserting a length of two-inch

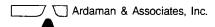

diameter slotted PVC pipe connected to a two-inch diameter solid PVC riser. The annular space was backfilled with 20/30 silica sand to above the slotted PVC. A minimum thickness of six inches of bentonite pellets were placed above the 20/30 sand to form a seal, and the remaining annular space was backfilled to ground surface with clayey sand. At the surface, a four-inch by four-inch steel casing with lockable steel cap was placed around the riser pipe and embedded in concrete to protect the piezometer. The piezometers were developed by the over-pumping method until the casing was essentially free of sand and the turbidity of the pumped water stabilized.

The latitude and longitude of each piezometer location were determined by plotting the location onto the U.S.G.S. Quadrangle Map (7.5 minute series) for the site area. These should be considered accurate only to the degree implied by the method used.

The existing monitor well CW-3 was abandoned on December 5, 1990 by grouting from bottom to top (tremie method). Prior to grouting, the total well depth was measured to be 16.1 feet below the ground surface and the existing water level to be 5.3 feet below the ground surface. Three (3) bags of portland cement were used in grouting of the well.

The elevation of the ground surface and top of casing (PVC) for each piezometer should be determined by a registered land surveyor. This data should be forwarded to our office, when available. This well completion report and the elevations should also be submitted to the Florida Department of Environmental Regulation (FDER).

We appreciate the opportunity to be of your service on this project. Please contact us when we may be of further service, or if you should have any questions concerning this report.

Very truly yours,

ARDAMAN & ASSOCIATES, INC.


Project Engineers KUEN Eng. Reg. No. 25550FICA: N


Garý H. Schmidt, P.E. Executive Vice President Eng. Reg. No. 12305

JHK/GHS:drs

Ardaman & Associates Inc. (Orlando)

**APPENDIX** 

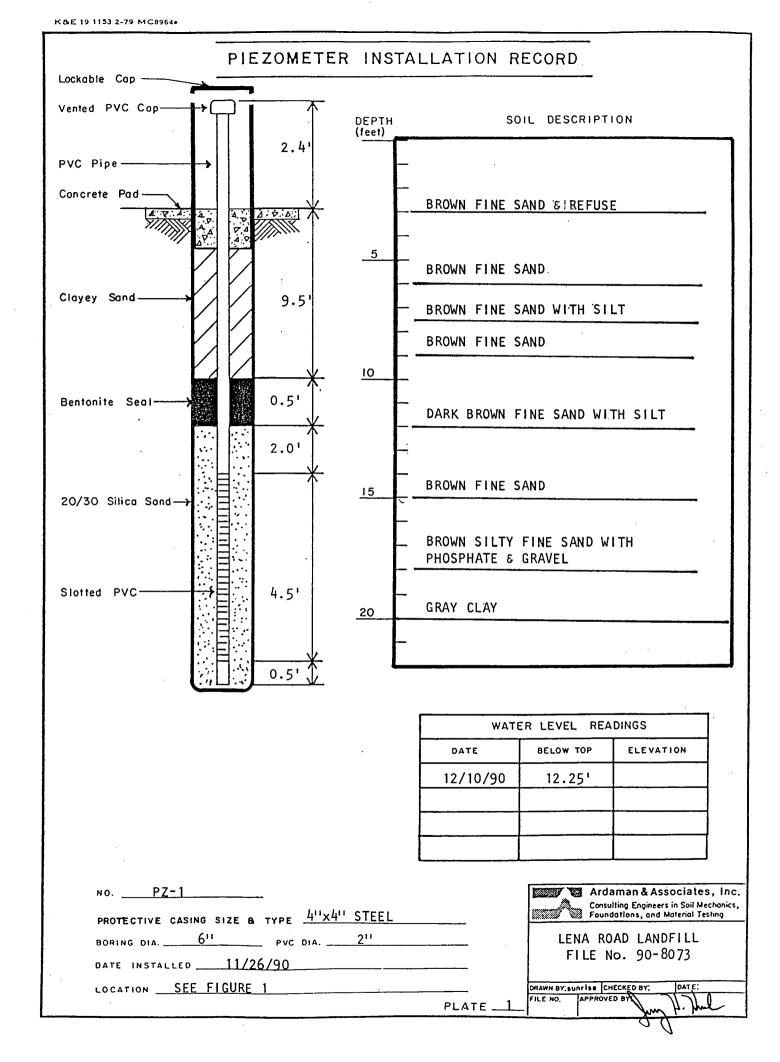

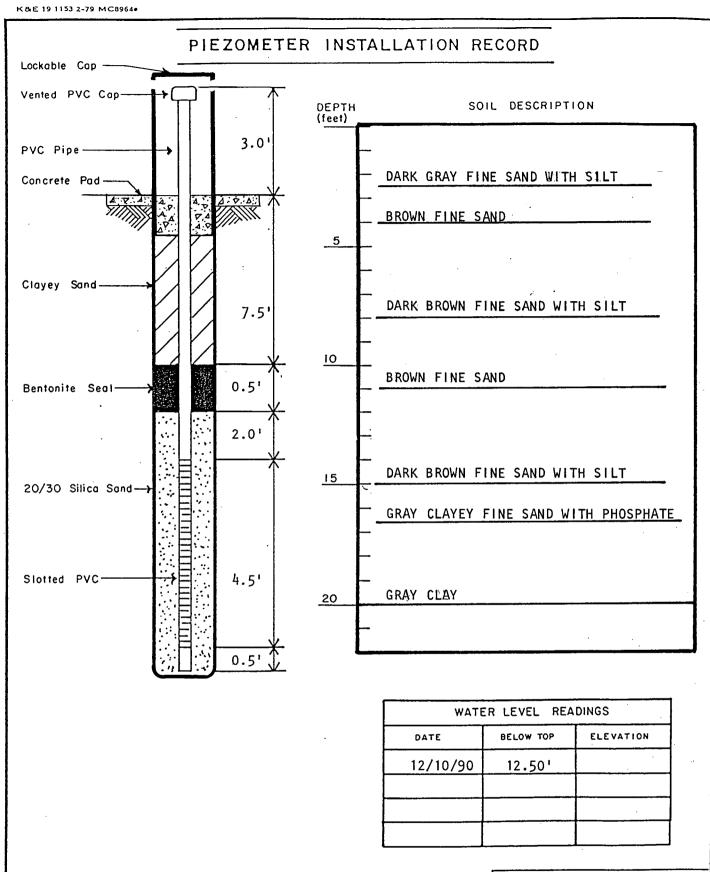



NO. <u>PZ-2</u>	-		
PROTECTIVE CASING SIZE &	TYPE	4"x4" STEEL	
BORING DIA. 611	_ PVC	DIA211	
DATE INSTALLED 11/27/	<b>′</b> 90		·
LOCATION SEE FIGURE	1		
•			PLATE


Ardaman & Associates, Inc. Consulting Engineers in Soil Mechanics, Foundations, and Material Testing


LENA ROAD LANDFILL FILE No. 90-8073

ORAWN BY: SUNFISE CHECKED BY:

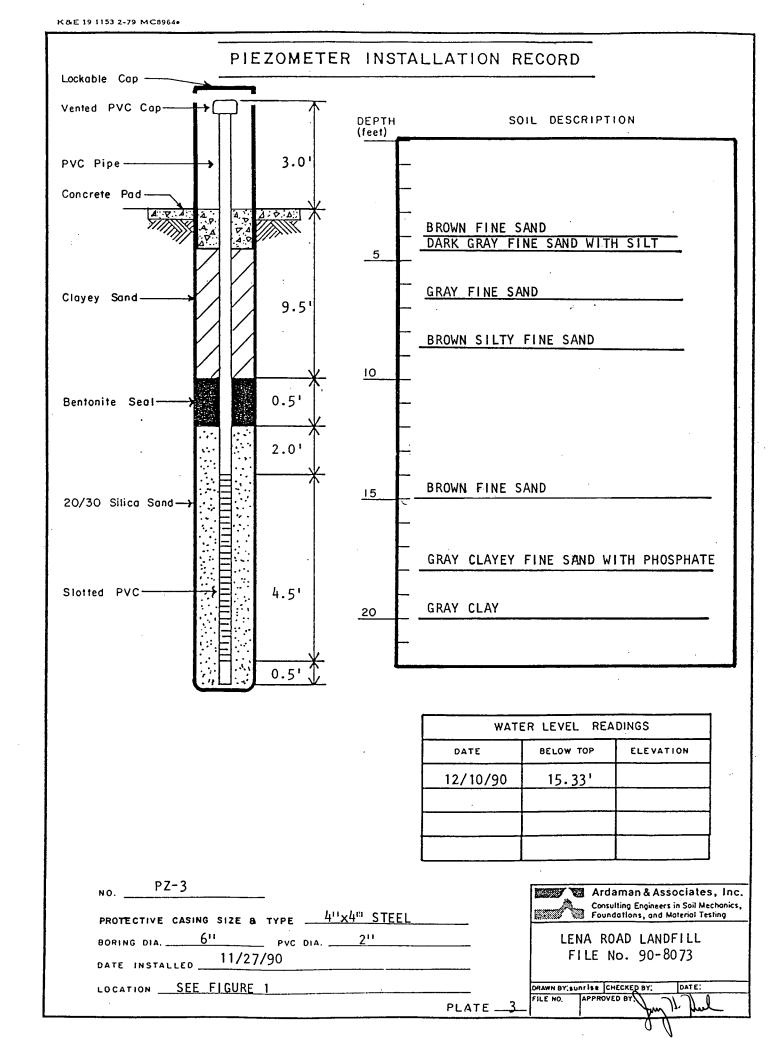

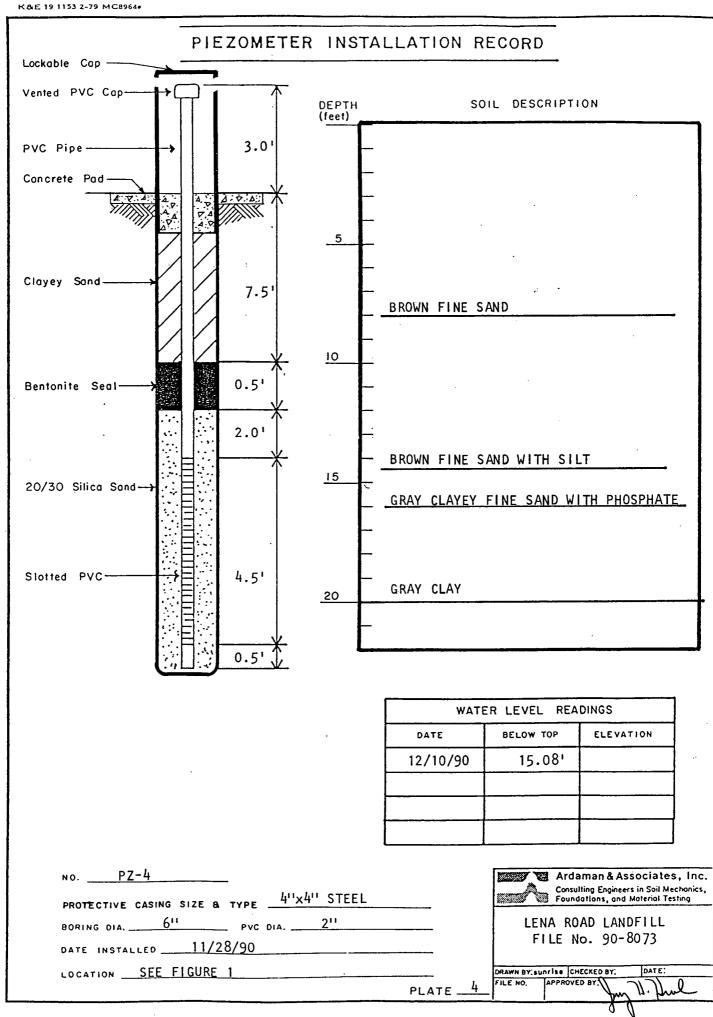

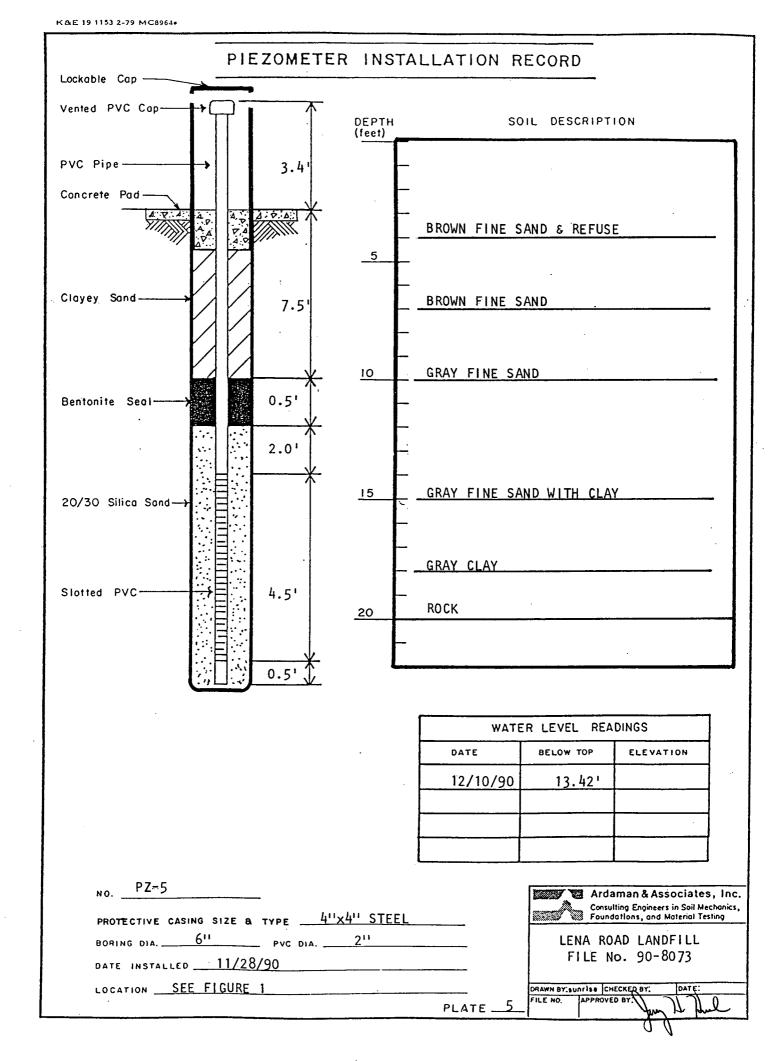

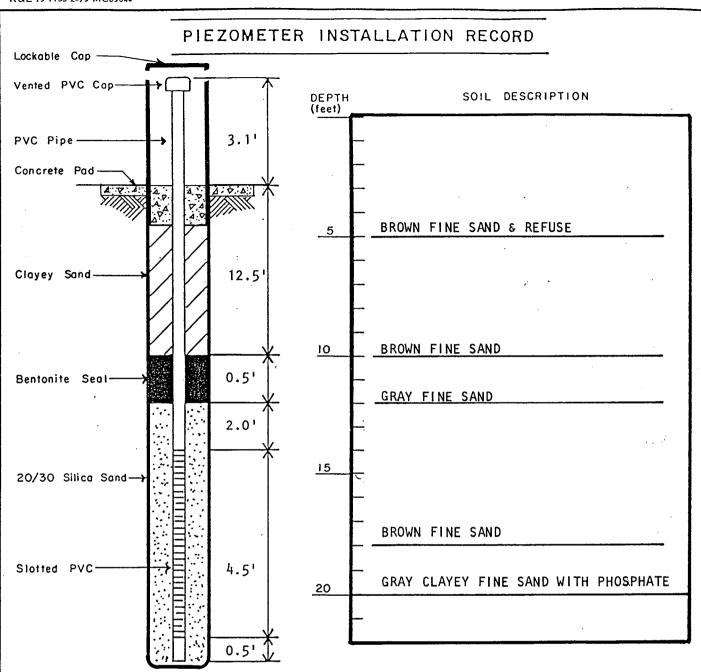


WATER LEVEL READINGS					
DATE	BELOW TOP ELEVATION				
12/10/90	13.08'				
		·			

NO. PZ-6	
PROTECTIVE CASING SIZE & TYPE 4"1×4"	STEEL
BORING DIA	
DATE INSTALLED	····
LOCATION SEE FIGURE 1	
·	PLATE

Ardaman & Associates, Inc.
Consulting Engineers in Soil Mechanics,
Foundations, and Material Testing

LENA ROAD LANDFILL FILE No. 90-8073

DRAWN BY: SURFISE CHECKED BY: DATE:

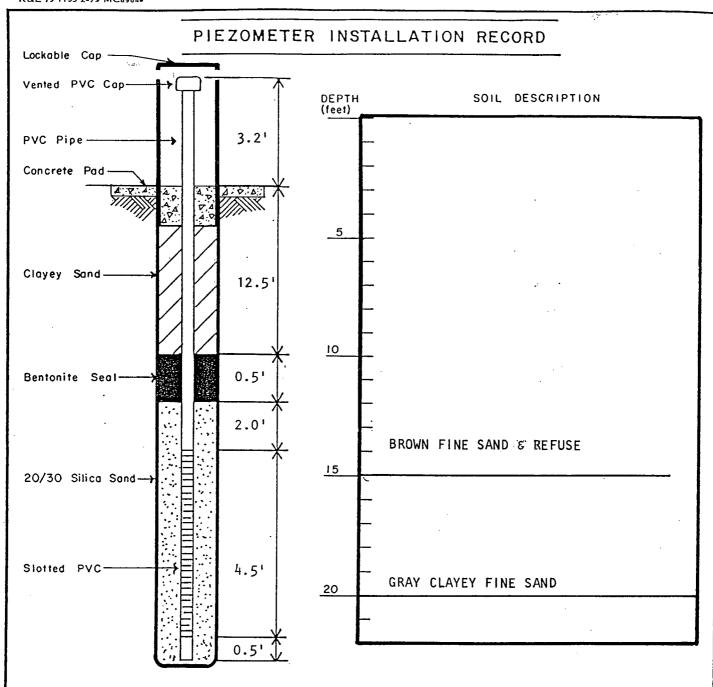


WATE	WATER LEVEL READINGS					
DATE	DATE BELOW TOP ELEVATION					
12/10/90	10.83'					

NOPZ-7	
PROTECTIVE CASING SIZE & TYPE 411×411 STEEL	
BORING DIA. 611 PVC DIA. 211	<del></del>
DATE INSTALLED 11/29/90	<del></del>
LOCATION SEE FIGURE 1	
,	PLATE_

Ardaman & Associates, Inc. Consulting Engineers in Soil Mechanics, Foundations, and Material Testing

> LENA ROAD LANDFILL FILE No. 90-8073

DRAWN BY: sunrise CHECKED BY: APPROVED BY:

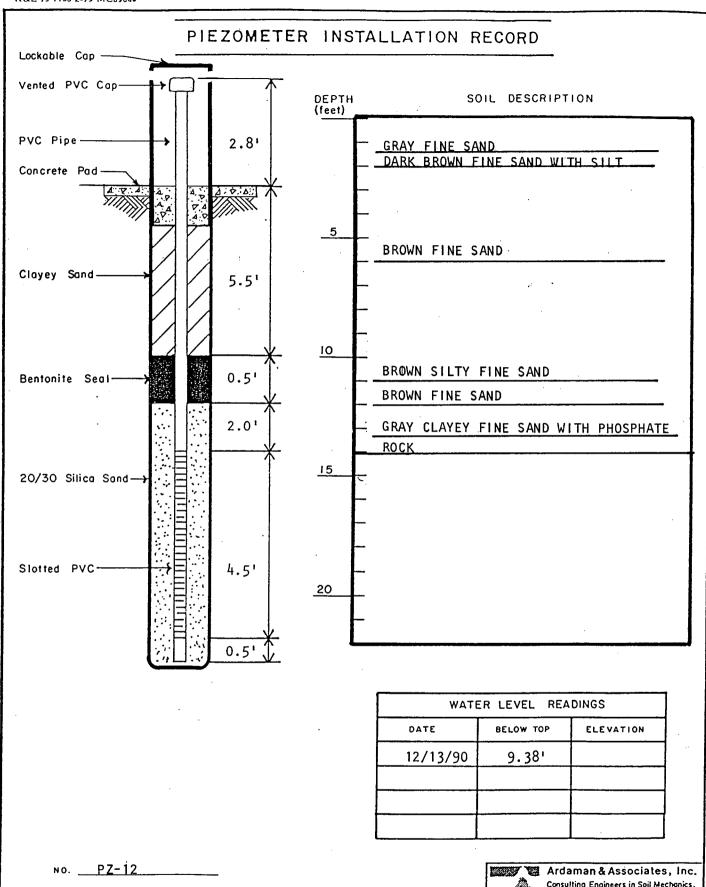

NO. <u>PZ-12</u>		
PROTECTIVE CASING SIZE & TYPE 4"1X4" STEEL		
BORING DIA. 611 PVC DIA. 211		
DATE INSTALLED 12/3/90		
LOCATION SEE FIGURE 1		
	PLATE 8	




Consulting Engineers in Soil Mechanics, Foundations, and Material Testing

LENA ROAD LANDFILL FILE No. 90-8073

DRAWN BY SUNTISE CHECKED BY: FILE NO.

APPROVED BY:

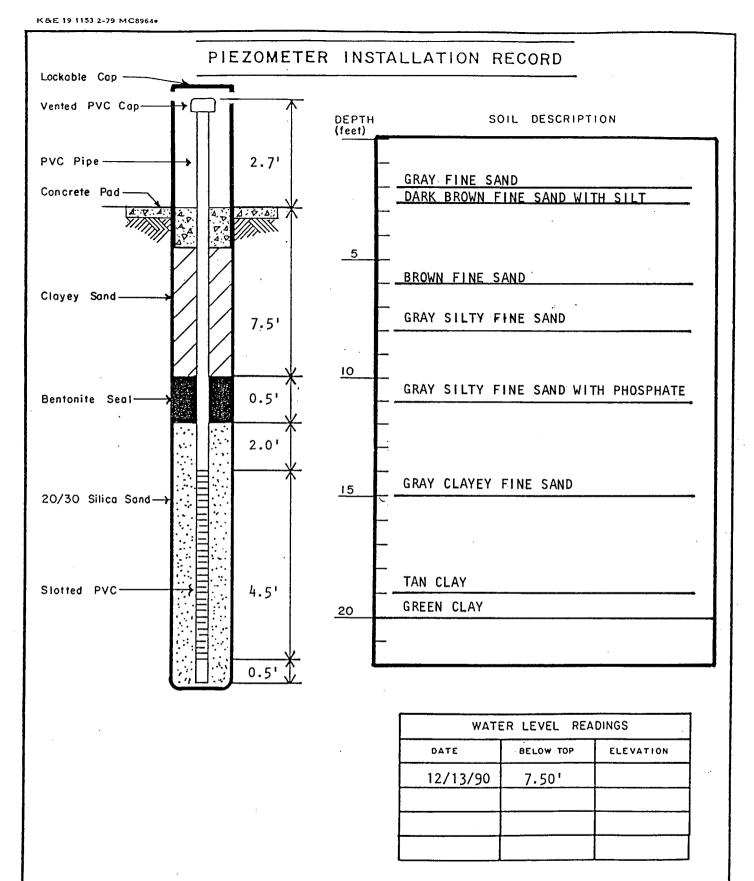

NoPZ-13	
PROTECTIVE CASING SIZE & TYPE	4"x4"STEEL
BORING DIA. 611 PVC DIA.	211
DATE INSTALLED	
OCATION SEE FIGURE 1	


Ardaman & Associates, Inc.

Consulting Engineers in Soil Mechanics, Foundations, and Material Testing

LENA ROAD LANDFILL FILE No. 90-8073

DRAWN BY: SUNTISE CHECKED BY: FILE NO. APPROVED BY:

PLATE \_9

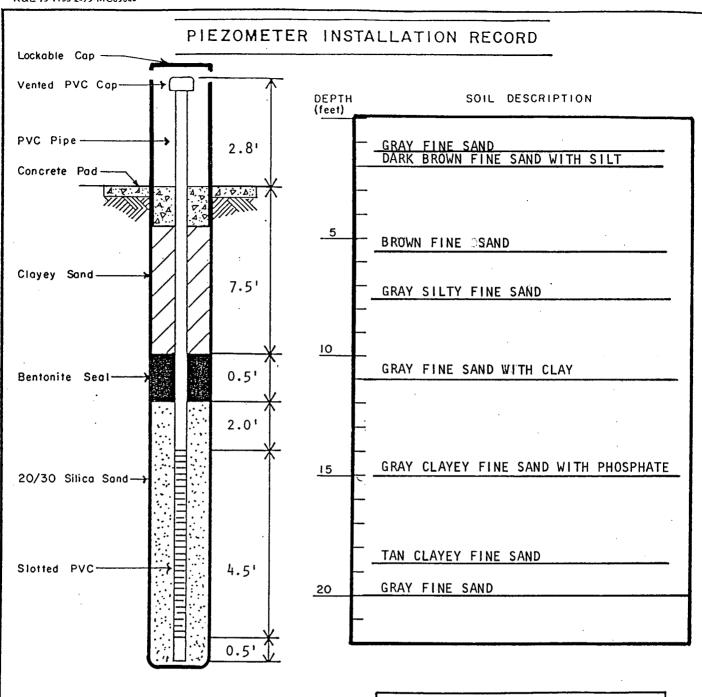

WATER LEVEL READINGS					
DATE	BELOW TOP	ELEVATION			
12/13/90 6.921					


NO.	PZ-14	_				,	
PROT	ECTIVE CASING SIZE &	TYPE	4	''×4''	STEEL	 _	
BORI	NG DIA. 611	_ PVC	DIA.	21	11	 	
DATE	INSTALLED 12/3/	<b>′</b> 90					
LOCA	TION SEE FIGURE	1				 	
						.ATE _	10

Ardaman & Associates, Inc. Consulting Engineers in Soil Mechanics, Foundations, and Material Testing

> LENA ROAD LANDFILL FILE No. 90-8073

APPROVED BY:

DRAWN BY: SUNT IS CHECKED BY:

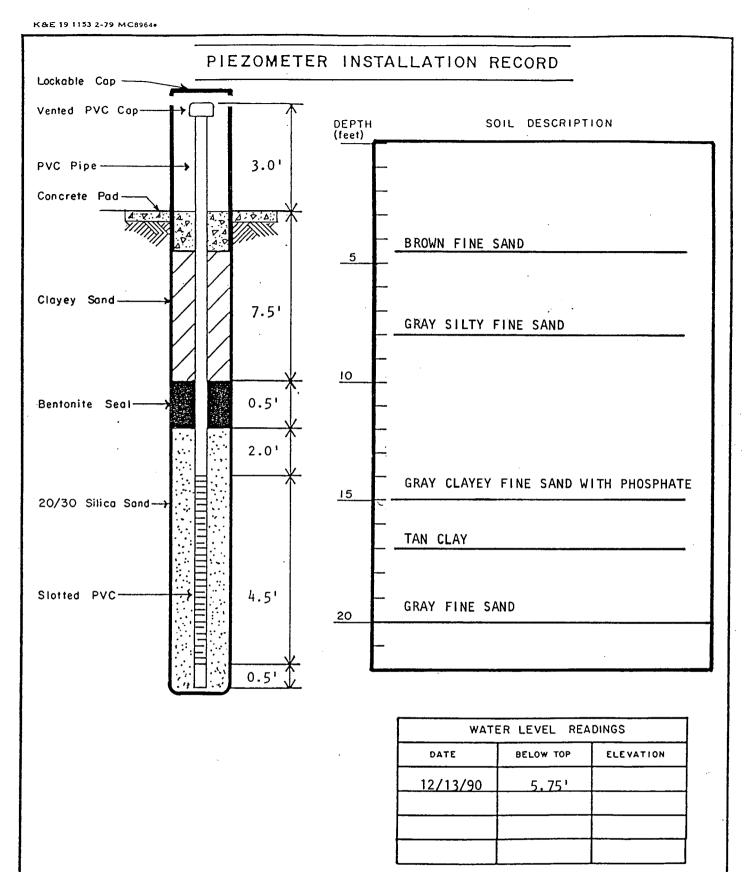

NO. PZ-15	
PROTECTIVE CASING SIZE &	TYPE 4"x4" STEEL
BORING DIA611	PVC DIA
DATE INSTALLED12/4,	/90
LOCATION SEE FIGURE	1



PLATE \_\_11

Ardaman & Associates, Inc. Consulting Engineers in Soil Mechanics, Foundations, and Material Testing

> LENA ROAD LANDFILL FILE No. 90-8073

DRAWN BY; SUNTISE CHECKED BY;

