



**Volusia County
FLORIDA**
**Public Works Department
Solid Waste Division**

Waste
27540
Received

MAY 28 2013

BSHW

May 23, 2013

Mr. F. Thomas Lubozynski, P.E.
Air & Waste Program Administrator
Florida Department of Environmental Protection
3319 Maguire Blvd., Suite 232
Orlando, FL 32803-3767

**SOLID WASTE
SECTION**
MAY 28 2013

RE: Volusia County – Tomoka Farms Road Landfill – N Cell Exp.:
Landfill Gas Collection System Expansion Sequence 1A Completion Notification Facility
ID: 1270117
Permit No. 0078767-030-SO-01

Dear Mr. Lubozynski:

I am submitting this certification report for the Volusia County (County) Phase III Sequence 1A landfill Gas Construction project at the Tomoka Farms Road Landfill (Landfill).

This report provides certification of construction of the North Cell Landfill Gas Collection System Construction for Closure – Sequence 1A. This sequence of closure included the relocation of 645 LF of 16" gas line header, 4" force main, and 2" air line along the north and west slopes of the North Cell. With the 16" gas line header being relocated up slope this project also included converting 5 existing wells to remote well heads. This sequence also included running new lateral connections for existing wells along the west slope to allow for sufficient cover in closure. Construction at the Tomoka Farms Road Landfill was carried out starting on February 5, 2012 with substantial completion on March 9, 2012.

If you should have any questions regarding this request please do not hesitate to contact me at (386) 947-2952

Sincerely,

Junos Reed, P.E.
Civil Engineer III
Volusia County, Solid Waste Division

cc: ✓ Mr. Richard Tedder, P.E. FDEP, Solid Waste Program Administrator, Tallahassee
Mr. Lenny Marion, Director, Volusia County Solid Waste Division
Ms. Jennifer Stirk, Environmental Specialist III, Volusia County SWD (File)
Mr. Carlo Lebron, P.E., Vice-President, HDR Engineering, Inc.

ADM-13-114

3151 East New York Avenue, DeLand, FL 32724
Tel: 386-943-7889 FAX: 386-943-7904
www.volusia.org/recycle

Report of Construction
February 2013 – March 2013
NORTH CELL LANFILL GAS CONSTRUCTION FOR CLOSURE
SEQUENCE 1A
TOMOKA FARMS ROAD LANDFILL

Received

MAY 28 2013

BSHW

Presented to:

Volusia County Solid Waste Division
1990 Tomoka Farms Road
Daytona Beach, FL 32124

Presented by:

Volusia County Solid Waste Construction Engineer
1990 Tomoka Farms Road
Daytona Beach, FL 32124

Florida Board of Professional Engineers
Certification No. 66408

SOLID WASTE
SECTION
MAY 28 2013

Junos Reed
5-23-13

Junos Reed, P.E.
Florida Registration No. 66408

May, 2013

Table of Contents

Table of Contents

Table of Contents

Project Summary 3

Site Background..... 3

Contact List..... 4

 Owner: 4

 Closure Sequence 1A Design Engineer:..... 4

 Construction Contractor:..... 4

 Construction Quality Assurance and Record Documentation: 4

 Surveyor: 4

 Gas to Energy Developer:..... 4

Summary of Construction 5

 North Cell Closure – Sequence 1A..... 5

 Lateral Tie-In Connections..... 5

 16” Header Installation 5

 Horizontal Well Retrofits..... 5

Appendix A 7

Daily Field Reports..... 7

Appendix B 8

Construction Photographs 8

Appendix C 22

Record Drawings 22

Project Summary

This report provides certification of construction of the North Cell Landfill Gas Collection System Construction for Closure – Sequence 1A. This sequence of closure included the relocation of 645 LF of 16” gas line header, 4” force main, and 2” air line along the north and west slopes of the North Cell. With the 16” gas line header being relocated up slope this project also included converting 5 existing wells to remote well heads. This sequence also included running new lateral connections for existing wells along the west slope to allow for sufficient cover in closure. Construction at the Tomoka Farms Road Landfill was carried out starting on February 5, 2012 with substantial completion on March 9, 2012.

Site Background

Tomoka Farms Road Landfill (Landfill) is an active municipal solid waste landfill that is owned and operated by Volusia County. It is located at 1990 Tomoka Farms Road, Volusia County, Florida. This sequence of closure was designed by HDR Engineering, Inc. with Shaw Environmental and Infrastructure, Inc, (Shaw) as the primary construction contractor. Junos Reed, P.E. with Volusia County Solid Waste provided the construction quality assurance for the project. The landfill has a methane gas to energy plant onsite which is operated by Fortistar Methane Group. The primary means of methane gas destruction is by Fortistar, a backup flare station is located adjacent to the methane to energy plant and is used in cases of excess gas or a plant shut down.

Contact List

The parties involved in this project are listed below:

Owner:

Volusia County Solid Waste Division
1990 Tomoka Farms Road
Daytona Beach, Florida 32124
(386) 947-2952

Closure Sequence 1A Design Engineer:

HDR Engineer, Inc.
200 West Forsyth Street, Suite 800
Jacksonville, Florida 32202
(904) 367-6025

Construction Contractor:

Shaw Environmental and Infrastructure, Inc
4171 Essen Lane
Baton Rouge, LA 70809
(225) 987-6803

Construction Quality Assurance and Record Documentation:

Volusia County Solid Waste Division
1990 Tomoka Farms Road
Daytona Beach, Florida 32124
(386) 947-2952

Surveyor:

Sliger & Associates, Inc
3621 Nova Road
Port Orange, Florida 32127
(386) 761-5385

Gas to Energy Developer:

Fortistar Methane Group
1990 Tomoka Farms Road
Daytona Beach, Florida 32124
(386) 239-9730

Summary of Construction

North Cell Closure – Sequence 1A

Construction at the Tomoka Farms Road Landfill commenced on February 5, 2012 with substantial completion on March 9, 2012. The design include the relocation of 645 LF of 16" gas line header, 4" force main, and 2" air line along the north and west slopes of the North Cell. With the 16" gas line header being relocated up slope this project also included converting 5 existing wells to remote well heads. This sequence also included running new lateral connections for existing wells along the west slope to allow for sufficient cover in closure. In total the North Cell Landfill Gas Collection System Construction for Closure – Sequence 1A included the installation of the following quantities as recorded by the contractor.

- 645 feet of 16" HDPE SDR 17 header piping
- 701 feet of 6" HDPE SDR 11 sub header lateral piping
- 961 feet of 4" HDPE SDR 11 sub header lateral piping
- 2354 feet of 4" HDPE SDR 11 condensate force main piping
- 2506 feet of 2" HDPE SDR 9 compressed air main piping
- Two Header/Airline/Condensate access point
- Convert 5 existing vertical wells to remote wells
- Once condensate force main isolation valve assembly

Lateral Tie-In Connections

Existing wells EW-8, EW-64, EW-65, EW-66, and EW-67 were converted to remote wells with the lateral lines connected to the new 16" header line. In addition new lateral lines were installed from EW-5, EW-9, EW-11, EW-12A, and EW-68 to the new 16" header line. All of the new lateral connections were installed with 2" compressed air and 4" condensate force main lines.

16" Header Installation

The 16" header line was installed from the point of connection on the North Slope to the point of connection on the west slope with little deviation from the design drawings. The header was installed with a minimum of a 3% slope from the high to the points of connection to the existing header on the north and west slopes. The existing header was removed from the point of connection on the north slope up to the point at which it crossed under the existing access road on the west slope. At the abandonment points a slip cap was installed. As the County re-grades the west slope and moves the access road to the west in preparation for closure, additional sections of the existing header will be removed as necessary.

Horizontal Well Retrofits

As part of the previous construction (sequence 1) the Horizontal collectors were converted to vertical wellheads and drip traps for the collection of condensate. As part of this construction (sequence 1A) Horizontal Collectors HC-1A, HC-1B, HC-2A, HC-2B, HC-3A, HC-3B, HC-4A, HC-4B, HC-5A, HC-5B, HC-6A, and HC-6B were fitted with 2" QED AP-2 pumps for dewatering. 4" condensate force main and 2"

compressed air lines were installed to each of the Horizontal Collectors and connected to the existing system on the South and North slopes respectively.

Additional Information of construction activities can be found in the daily logs.

Appendix A

Daily Field Reports

Appendix B

Construction Photographs



West Slope Header Point of Connection



Existing Header Abandonment



4" Condensate Force Main & 2" Compressed Air Line to EW-68



4" Condensate Force Main & 2" Compressed Air Line to Horizontal Collector



Expose existing lateral connection on West Slope



Converting to Existing Well to Remote Wellhead




New Lateral lines from EW-67R



Installing new 16" Header Line



Trenching for New Lateral Lines

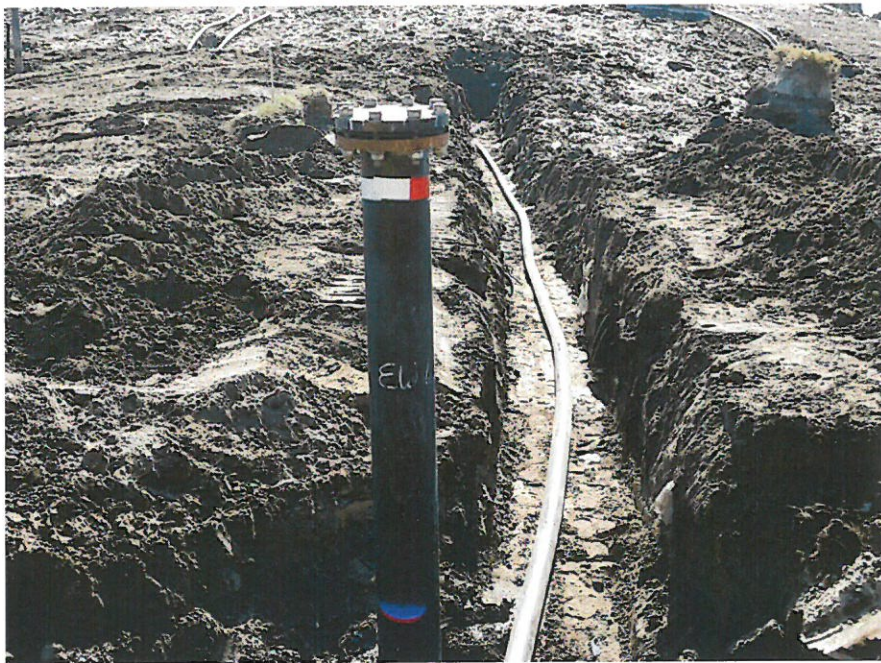

Converting EW-64 to Remote Wellhead



Running New Lateral Lines from EW-12A to EW-6



Installing new Air and Force Main for Horizontal Collectors on South Slope



Installing new Air and Force Main for Horizontal Collectors on South Slope



Point of Connection to Existing Header on North Slope



Trench for new 16" Header on North Slope



Header Tie-In on North Slope with Existing Header Abandoned



Installing New Header on North Slope



Lateral Connection from EW-8 to New Header



Lateral Connection from EW-8 to New Header



New Remote Wellheads on New Header



Access Point at High Point of New Header



New Header Installation Along South Slope



Point of Connection to Existing Header with Access Point




Point of Connection to Existing Header with Access Point



New Lateral Piping from EW-5 to Existing Header

Appendix C

Record Drawings

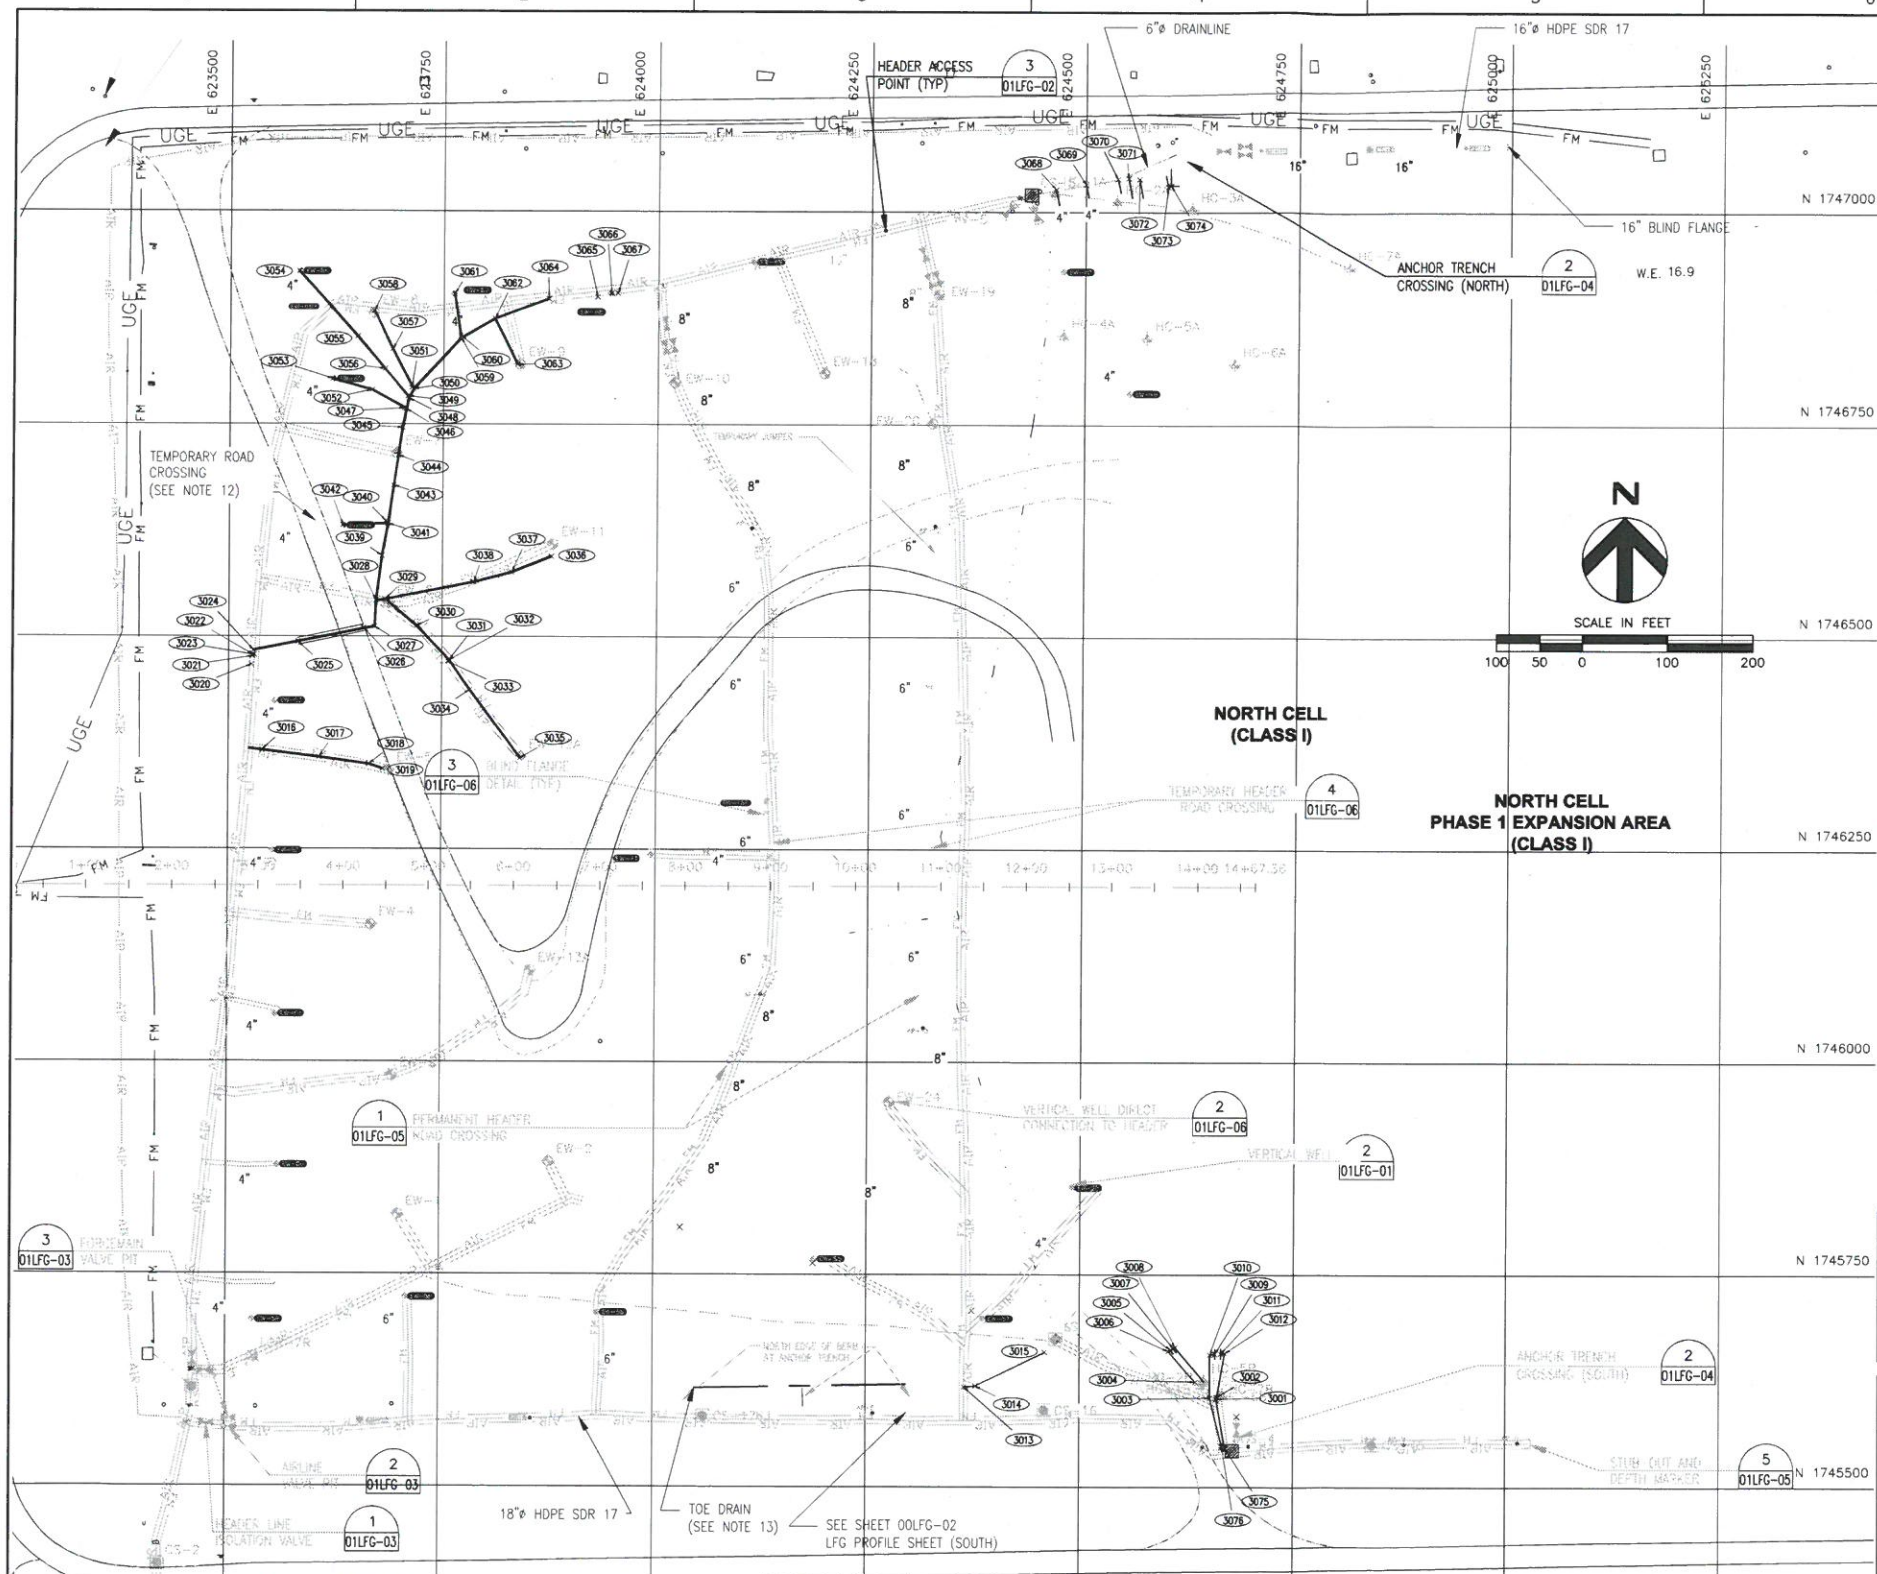

LEGEND

—	LIMITS OF LINER	○	LCR-1	EXISTING LEACHATE CLEANOUT RISER
—	LIMITS OF CONSTRUCTION	⊕	HC-7B	EXISTING HORIZONTAL LFG WELLHEAD
—	EXISTING CONTOURS (MAJOR)	○	EW-1	EXISTING LFG WELL
—	EXISTING CONTOURS (MINOR)	□	LCRS	EXISTING LEACHATE RISER SUMP
—	LFG PIPE TO BE ABANDONED	○	CS-2	EXISTING CONDENSATE SUMP
—	LFG PIPE ABANDONED IN PLACE	⊕	—	EXISTING HEADER ISOLATION VALVE
—	NEW HDPE SDR 17 LFG HEADER (SIZE VARIES)	⊕	—	ISOLATION VALVE
—	NEW HDPE SDR 11 LATERAL PIPE (SIZE VARIES)	○	CS-2	CONDENSATE SUMP
—	EXISTING LFG HEADER PIPE (SIZE VARIES)	⊕	EW-1	LFG WELL
—	EXISTING LFG LATERAL PIPE (SIZE VARIES)	⊕	EW-24	CONNECTION TO EXISTING VERTICAL WELLS
—	EXISTING LFG HORIZONTAL PIPE (SIZE VARIES)	⊕	EW-16AR	UPSLOPE WELLHEAD
—	EXISTING UNDERGROUND ELECTRIC	•	AP-2	ACCESS POINT
—	EXISTING UNDERGROUND LEACHATE FORCEMAIN	△	30.54	SURVEY MONUMENTS
		×	CP-3	CONNECTION POINTS TO EXISTING LFG SYSTEM

NOTES:

- AERIAL TOPOGRAPHY WAS TAKEN FROM AERIAL SURVEY PERFORMED BY AERIAL CARTOGRAPHICS OF AMERICA ON MAY 7, 2011.
- LIMITS OF LINER OBTAINED FROM THE TOMOKA LANDFILL LINER AS-BUILT DRAWING BY MAPTECH, INC. ON OCTOBER 4, 2005 AND FROM THE CLASS I CELL FILL SEQUENCING PLAN DRAWING PREPARED BY SCS ENGINEERS AND SUBMITTED TO FDEP ON AUGUST 14, 2009.
- UTILITY INFORMATION OBTAINED FROM THE SPECIFIC PURPOSE SURVEY GAS LINE AS-BUILTS TOMOKA FARMS ROAD LANDFILL PREPARED BY SLIGER & ASSOCIATES, INC. ON MARCH 1, 2010.
- CONTRACTOR TO PERFORM PRE CONSTRUCTION SURVEY AS SPECIFIED IN THE SPECIFICATIONS.
- EXISTING EDGE OF LINER LOCATION ALONG THE NORTH SLOPE IS APPROXIMATE. CONTRACTOR IS RESPONSIBLE FOR FIELD LOCATING LINER EDGE PRIOR TO CONSTRUCTION.
- EXISTING CLEANOUT LOCATIONS AND UTILITY LOCATIONS ARE APPROXIMATE. CONTRACTOR IS RESPONSIBLE FOR FIELD LOCATING CLEANOUTS AND UTILITY LOCATIONS PRIOR TO CONSTRUCTION.
- REBAR SPACED EVERY 50' O.C. ALTERNATING SIDES.
- CONTRACTOR SHALL PROVIDE ADDITIONAL SUBHEADER TO ALLOW FOR EXPANSION.
- 6" SUBHEADER BETWEEN ACCESS POINTS AP-12 AND AP-13, AP-14 AND AP-15 SHALL BE EXPOSED UNTIL FILLING OPERATIONS ON TOP DECK HAVE BEEN COMPLETED.
- ALL ABANDONED LATERAL LINES TO BE CUT AND CAPPED. SEE DETAIL 5 ON SHEET 01LFG-06.
- CONTRACTOR TO PROVIDE A TEMPORARY JUMPER AND UP SLOPE WELLHEAD UNTIL FILLING OPERATIONS HAVE BEEN COMPLETED.
- CONNECTION OF WELL EW-64 SHALL BE MOVED TO CONNECT TO NEW HEADER LOCATION IN PHASE III B.
- CONTRACTOR TO CONNECT LANDFILL GAS COLLECTION SYSTEM FROM NEWLY INSTALLED HEADER LINE TO HIGH POINTS OF TOE DRAIN. LATERAL SHALL BE SLOPED TO HEADER AWAY FROM TOE DRAIN. A MINIMUM OF 3% OUTSIDE OF WASTE. WELLHEAD SHALL CONSIST OF 2" BALL VALVE AND SAMPLE PORTS ON EITHER SIDE. LATERALS SHALL BE SAME SIZE DIAMETER AS TOE DRAIN. CONNECTION TO HEADER SHALL BE WITH BRANCH SADDLE. DRAIN LINE TO LCR-8 TO BE CUT AND CAPPED AT LCR-8.

PHASE III A CONSTRUCTION TABLE

ITEM DESCRIPTION	UNIT	QUANTITY
VERTICAL LFG WELLHEAD	EA	21
ACCESS POINT	EA	14
CONDENSATE SUMP	EA	5
2" HDPE SDR 9 AIRLINE	LF	5,992
4" HDPE SDR 9 CONDENSATE FORCEMAIN	LF	5,848
4" HDPE SDR 11 LATERAL	LF	1,147
6" HDPE SDR 11 LATERAL	LF	1,416
8" HDPE SDR 11 SUB-HEADER	LF	1,264
10" HDPE SDR 11 SUB-HEADER	LF	35
16" HDPE SDR 17 HEADER	LF	595
18" HDPE SDR 17 HEADER	LF	1,596

AS-BUILT LEGEND

WATER SERVICE
SEWER SERVICE
GAS SERVICE
ELECTRIC SERVICE
... (Detailed list of symbols and their meanings)

AS-BUILT ABBREVIATIONS

AS-BUILT ABBREVIATIONS
... (Detailed list of abbreviations and their meanings)

SLIGER & ASSOCIATES, INC.
PROFESSIONAL LAND SURVEYORS
LICENSED BUSINESS CERTIFICATION # 1216
2801 NORTH ROAD
NORTH ORANGE, FL 32757 • (386) 761-3385
WWW.SLIGERANDASSOCIATES.COM

DATE: 09/11
BY: M. AUSTIN
CHECKED BY: M. AUSTIN

Final
9-23-13

HDR
HDR Engineering, Inc.
300 W. Fourth St.
Jacksonville, FL 32202
FLORIDA 04-00004215

ISSUE	DATE	DESCRIPTION
1	09/11	DRAFT

PROJECT MANAGER C. LEBRON, P.E.
DESIGNED BY M. AUSTIN
DESIGNED BY
DRAWN BY M. AUSTIN
CHECKED BY
PROJECT NUMBER 000000000170244




CLASS I ACTIVE AREA TOMOKA FARMS ROAD LANDFILL VOLUSIA COUNTY, FLORIDA

PHASE III - PART A LFG SYSTEM EXPANSION

SCALE AS SHOWN

FILENAME 00LFG-01.dwg
SHEET 00LFG-01

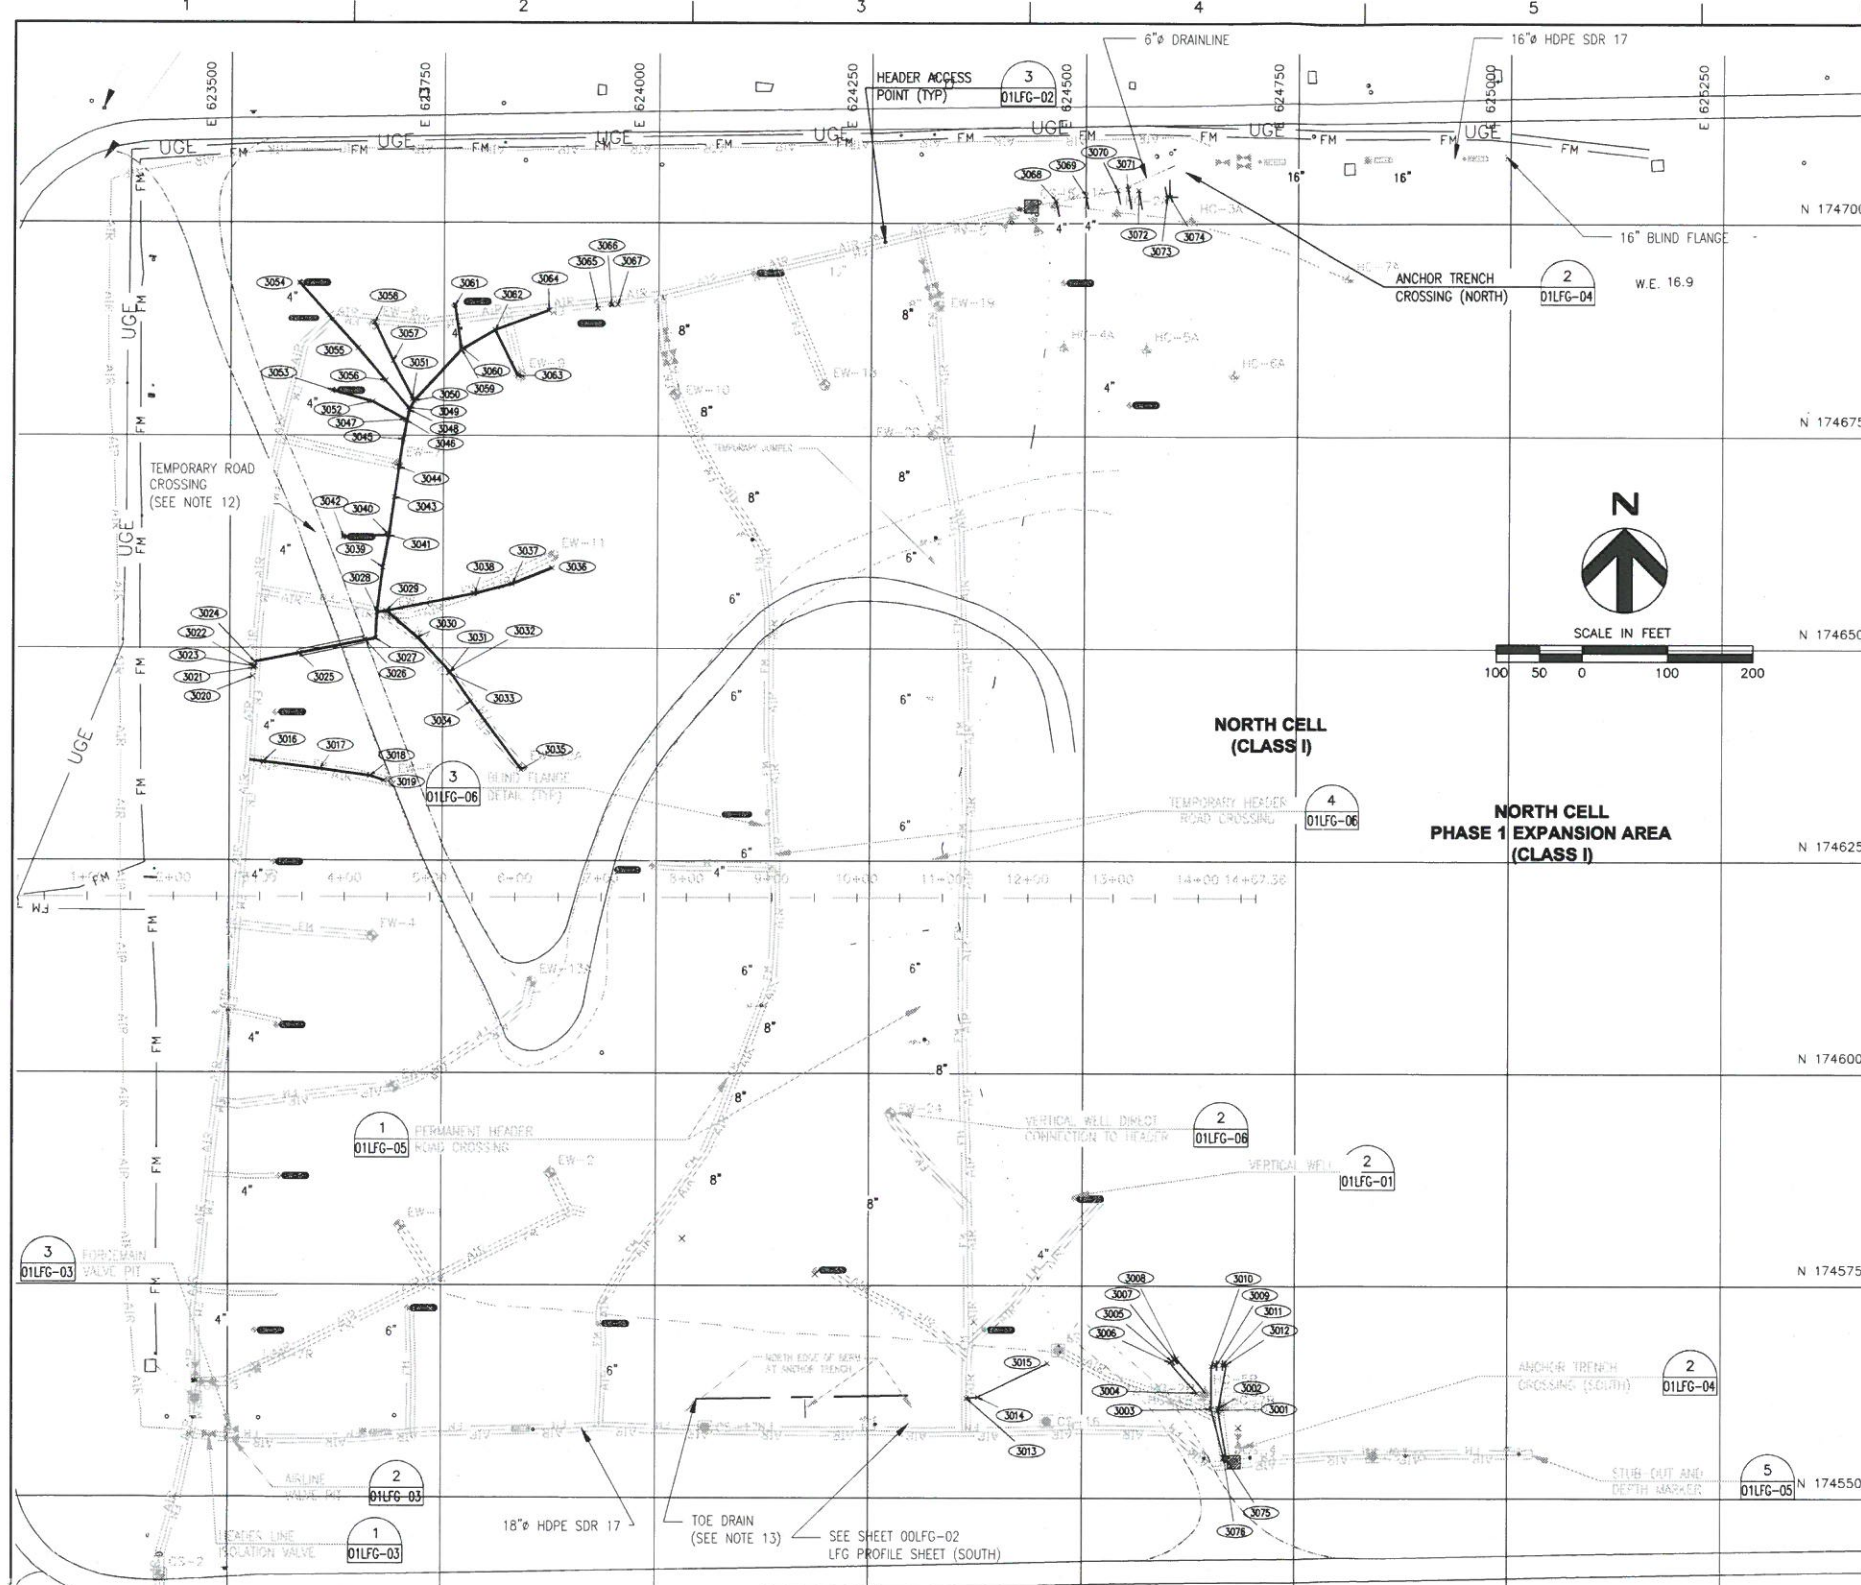

LEGEND

--- (thick)	LIMITS OF LINER	○ LCR-1	EXISTING LEACHATE CLEANOUT RISER
--- (medium)	LIMITS OF CONSTRUCTION	⊕ HC-7B	EXISTING HORIZONTAL LFG WELLHEAD
--- (thin)	EXISTING CONTOURS (MAJOR)	○ EW-1	EXISTING LFG WELL
--- (dashed)	EXISTING CONTOURS (MINOR)	□ LCRS	EXISTING LEACHATE RISER SUMP
---	LFG PIPE TO BE ABANDONED	○ CS-2	EXISTING CONDENSATE SUMP
---	LFG PIPE ABANDONED IN PLACE	⊕	EXISTING HEADER ISOLATION VALVE
---	NEW HOPE SDR 17 LFG HEADER (SIZE VARIES)	⊕	ISOLATION VALVE
HP	DENOTES HIGH POINT IN HEADER	○ CS-2	CONDENSATE SUMP
---	NEW HOPE SDR 11 LATERAL PIPE (SIZE VARIES)	⊕ EW-1	LFG WELL
---	EXISTING LFG HEADER PIPE (SIZE VARIES)	⊕ EW-24	CONNECTION TO EXISTING VERTICAL WELLS
---	EXISTING LFG LATERAL PIPE (SIZE VARIES)	⊕ EW-16AR	UPSLOPE WELLHEAD
---	EXISTING LFG HORIZONTAL PIPE (SIZE VARIES)	○ AP-2	ACCESS POINTS
---	EXISTING UNDERGROUND ELECTRIC	△ 30.54	SURVEY MONUMENTS
---	EXISTING UNDERGROUND LEACHATE FORCEMAIN	×	CONNECTION POINTS TO EXISTING LFG SYSTEM

NOTES:

- AERIAL TOPOGRAPHY WAS TAKEN FROM AERIAL SURVEY PERFORMED BY AERIAL CARTOGRAPHICS OF AMERICA ON MAY 7, 2011.
- LIMITS OF LINER OBTAINED FROM THE TOMOKA LANDFILL LINER AS-BUILT DRAWING BY MAPTECH, INC. ON OCTOBER 4, 2005 AND FROM THE CLASS I CELL FILL SEQUENCING PLAN DRAWING PREPARED BY SCS ENGINEERS AND SUBMITTED TO FDEP ON AUGUST 14, 2009.
- UTILITY INFORMATION OBTAINED FROM THE SPECIFIC PURPOSE SURVEY GAS LINE AS-BUILTS TOMOKA FARMS ROAD LANDFILL PREPARED BY SLIGER & ASSOCIATES, INC. ON MARCH 1, 2010.
- CONTRACTOR TO PERFORM FIRE CONSTRUCTION SURVEY AS SPECIFIED IN THE SPECIFICATIONS.
- EXISTING EDGE OF LINER LOCATION ALONG THE NORTH SLOPE IS APPROXIMATE. CONTRACTOR IS RESPONSIBLE FOR FIELD LOCATING LINER EDGE PRIOR TO CONSTRUCTION.
- EXISTING CLEANOUT LOCATIONS AND UTILITY LOCATIONS ARE APPROXIMATE. CONTRACTOR IS RESPONSIBLE FOR FIELD LOCATING CLEANOUTS AND UTILITY LOCATIONS PRIOR TO CONSTRUCTION.
- REBAR SPACED EVERY 50' O.C. ALTERNATING SIDES.
- CONTRACTOR SHALL PROVIDE ADDITIONAL SUBHEADER TO ALLOW FOR EXPANSION.
- 6" SUBHEADER BETWEEN ACCESS POINTS AP-12 AND AP-13, AP-14 AND AP-15 SHALL BE EXPOSED UNTIL FILLING OPERATIONS ON TOP DECK HAVE BEEN COMPLETED.
- ALL ABANDONED LATERAL LINES TO BE CUT AND CAPPED. SEE DETAIL 5 ON SHEET 01LFG-06.
- CONTRACTOR TO PROVIDE A TEMPORARY JUMPER AND UP SLOPE WELLHEAD UNTIL FILLING OPERATIONS HAVE BEEN COMPLETED.
- CONNECTION OF WELL EW-64 SHALL BE MOVED TO CONNECT TO NEW HEADER LOCATION IN PHASE III B.
- CONTRACTOR TO CONNECT LANDFILL GAS COLLECTION SYSTEM FROM NEWLY INSTALLED HEADER LINE TO HIGH POINTS OF TOE DRAIN. LATERAL SHALL BE SLOPED TO HEADER AWAY FROM TOE DRAIN. LATERALS SHALL BE SAME SIZE DIAMETER AS TOE DRAIN. CONNECTION TO HEADER SHALL BE WITH BRANCH SADDLE. DRAIN LINE TO LCR -8 TO BE CUT AND CAPPED AT LCR -8.

PHASE III A CONSTRUCTION TABLE

ITEM DESCRIPTION	UNIT	QUANTITY
VERTICAL LFG WELLHEAD	EA	21
ACCESS POINT	EA	14
CONDENSATE SUMP	EA	5
2" HOPE SDR 9 AIRLINE	LF	5,992
4" HOPE SDR 9 CONDENSATE FORCEMAIN	LF	5,848
4" HOPE SDR 11 LATERAL	LF	1,147
6" HOPE SDR 11 LATERAL	LF	1,416
8" HOPE SDR 11 SUB-HEADER	LF	1,264
10" HOPE SDR 11 SUB-HEADER	LF	35
16" HOPE SDR 17 HEADER	LF	595
18" HOPE SDR 17 HEADER	LF	1,596

AS-BUILT LEGEND

SLIGER & ASSOCIATES, INC.
 PROFESSIONAL LAND SURVEYORS
 LICENSED BUSINESS CERTIFICATION # 2009
 3201 NINA ROAD • SUITE 200 • GAITHERSBURG, MD 20878
 (301) 751-5300 • FAX (301) 751-5305
 WWW.SLIGERANDASSOCIATES.COM

AS-BUILT SURVEY

THIS SURVEY WAS CONDUCTED IN ACCORDANCE WITH THE PROFESSIONAL LAND SURVEYING ACT AND THE REGULATIONS THEREUNDER. THE SURVEY WAS CONDUCTED IN ACCORDANCE WITH THE PROFESSIONAL LAND SURVEYING ACT AND THE REGULATIONS THEREUNDER. THE SURVEY WAS CONDUCTED IN ACCORDANCE WITH THE PROFESSIONAL LAND SURVEYING ACT AND THE REGULATIONS THEREUNDER.

AS-BUILT ABBREVIATIONS:


AS-BUILT WATER SERVICE	AS-BUILT WATER VALVE	AS-BUILT WATER VALVE	AS-BUILT WATER VALVE
AS-BUILT WATER SERVICE	AS-BUILT WATER VALVE	AS-BUILT WATER VALVE	AS-BUILT WATER VALVE
AS-BUILT WATER SERVICE	AS-BUILT WATER VALVE	AS-BUILT WATER VALVE	AS-BUILT WATER VALVE

Spencer
5-23-13

HDR
 HDR Engineering, Inc.
 300 W. Phoenix Rd.
 Jacksonville, FL 32202
 FLORIDA CA 00000015

ISSUE	DATE	DESCRIPTION
1	09/11	DRAFT


PROJECT MANAGER	C. LEBRON, P.E.
DESIGNED BY	M. AUSTIN
DESIGNED BY	
DRAWN BY	M. AUSTIN
CHECKED BY	
PROJECT NUMBER	000000000170244

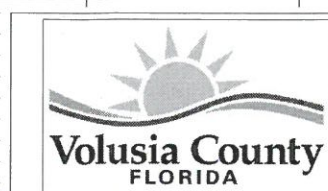

**CLASS I ACTIVE AREA
 TOMOKA FARMS ROAD LANDFILL
 VOLUSIA COUNTY, FLORIDA**

**PHASE III - PART A
 LFG SYSTEM EXPANSION**

FILENAME	00LFG-01.dwg	SHEET	00LFG-01
SCALE	AS SHOWN		

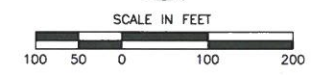

LEGEND

- LIMITS OF LINER
- LIMITS OF CONSTRUCTION
- EXISTING CONTOURS (MAJOR)
- EXISTING CONTOURS (MINOR)
- LFG PIPE TO BE ABANDONED
- LFG PIPE ABANDONED IN PLACE
- NEW HOPE SDR 17 LFG HEADER (SIZE VARIES)
- NEW HOPE SDR 11 LFG LATERAL PIPE (SIZE VARIES)
- EXISTING LFG HEADER PIPE (SIZE VARIES)
- EXISTING LFG LATERAL PIPE (SIZE VARIES)
- EXISTING LFG HORIZONTAL PIPE (SIZE VARIES)
- EXISTING UNDERGROUND ELECTRIC
- EXISTING UNDERGROUND LEACHATE FORCEMAIN
- LCR-1 EXISTING LEACHATE CLEANOUT RISER
- ▲ HC-7B EXISTING HORIZONTAL LFG WELL HEAD
- ◇ EW-1 EXISTING LFG WELL
- LCRS EXISTING LEACHATE RISER SUMP
- CS-2 EXISTING CONDENSATE SUMP
- EXISTING HEADER ISOLATION VALVE
- ISOLATION VALVE
- ◇ CS-2 CONDENSATE SUMP
- ◇ EW-1 LFG WELL
- ◇ EW-24 CONNECTION TO EXISTING VERTICAL WELLS
- ◇ EW-16AR UPSLOPE WELLHEAD
- AP-2 ACCESS POINTS
- ▲ 30.64 SURVEY MONUMENTS
- 20
- × CP-3 CONNECTION POINTS TO EXISTING LFG SYSTEM

POINT #	NORTHING	EASTING	TOP ELEV	DESCRIPTION	LATITUDE	LONGITUDE
3001	1745404.1181	626174.2804	31.37	YCL21 YCL21	29.0806145	-81.0558212
3001	1745403.8356	624869.3376	30.78	10" X 8" & 2" & 4" TEE	29.0808110	-81.0555086
3002	1745406.0404	624861.1481	31.21	2" X 4" 90°	29.0808181	-81.0555276
3003	1745405.0587	624852.8129	31.78	6" X 2" 45°	29.0808122	-81.0555370
3004	1745403.8285	624835.7031	35.71	6" X 2" 4" TOP OF PIPE	29.0808307	-81.0555583
3005	1745401.5268	624808.6336	44.50	6" X 2" 4" TEE	29.0808680	-81.0555891
3006	1745403.8283	624804.4204	44.07	6" X 2" 4" 90°	29.0808684	-81.0555917
3007	1745403.8705	624810.4586	45.14	6" X 2" 4" TEE	29.0808698	-81.0555949
3008	1745404.4774	624812.4175	45.29	6" X 2" 4" 90°	29.0808710	-81.0555926
3009	1745403.8403	624858.8355	43.84	2" X 4" TEE	29.0808634	-81.0555393
3010	1745405.8261	624858.5499	43.70	2" X 4" 90°	29.0808685	-81.0556374
3011	1745405.0468	624858.4030	44.87	2" X 4" TEE	29.0808636	-81.0555229
3012	1745405.8083	624870.0141	45.35	2" X 4" 90°	29.0808644	-81.0555177
3013	1745405.1539	624865.8030	30.51	8" X 4" & 2" & 4" TEE	29.0808243	-81.0558609
3014	1745408.9522	624878.9625	31.46	4" & 4" & 2" 2E BEND	29.0808257	-81.0558459
3015	1745405.7151	624458.7894	41.69	4" & 4" & 2" 90° BEND	29.0808651	-81.0587548
3016	1745408.4467	623538.5131	52.50	6" & 2" TIE IN	29.0815650	-81.0607932
3017	1745405.9043	623806.2011	67.46	6" & 2" TOP OF PIPE	29.0815566	-81.0607180
3018	1745404.8517	623864.3032	78.54	6" & 2" TOP OF PIPE	29.0815487	-81.0606518
3019	1745404.2679	623881.0705	81.68	6" & 2" 90° BEND	29.0815432	-81.0606336
3020	1745406.7094	623526.6129	50.26	16" HEADRISER & 2" TIE IN & END 4"	29.0816643	-81.0606079
3021	1745476.6494	623527.6491	51.81	16" X 4" ACCESS RISOR	29.0816741	-81.0606067
3022	1745476.4510	623527.9336	48.30	4" ACCESS RISOR	29.0816759	-81.0606064
3023	1745476.1469	623530.0291	49.53	2" ACCESS RISOR	29.0816756	-81.0606040
3024	1745483.6257	623528.9465	51.92	16" & 4" & 2" 90° BEND	29.0816810	-81.0606052
3025	1745483.9676	623528.9476	59.00	24" CASING	29.0816733	-81.0606053
3026	1745489.8561	623538.2291	73.04	24" CASING	29.0817072	-81.0606055
3027	1745481.7399	623670.7197	79.51	16" & 4" & 2" 90° BEND	29.0817090	-81.0606454
3028	1745482.8386	623672.3871	84.76	16" X 8" & 4" & 2" TEE	29.0817392	-81.0606435
3029	1745483.8945	623683.2296	88.80	16" X 8" & 4" & 2" WYE	29.0817406	-81.0606319
3030	1745482.8258	623729.2807	95.52	6" & 4" & 2" TOP OF PIPE	29.0817099	-81.0606079
3031	1745472.3968	623758.8982	105.08	6" TOP OF PIPE	29.0816791	-81.0605461
3032	1745471.8230	623758.2853	104.75	4" TOP OF PIPE	29.0816696	-81.0605466
3033	1745470.1480	623757.8105	104.84	2" TOP OF PIPE	29.0816679	-81.0605471
3034	1745437.5469	623783.3251	113.45	2" TOP OF PIPE	29.0816356	-81.0605183
3035	1745452.1804	623842.1804	128.85	6" & 4" & 2" 90° BEND	29.0815560	-81.0604519
3036	1745459.4373	623877.0641	137.85	6" & 4" & 2" 90° BEND	29.0817911	-81.0604128
3037	1745457.7898	623831.8045	126.68	6" & 4" & 2" TOP OF PIPE	29.0817725	-81.0604645
3038	1745464.3992	623787.0176	113.20	6" & 4" & 2" TOP OF PIPE	29.0817612	-81.0605143
3039	1745495.1373	623878.9344	87.28	16" & 4" & 2" TOP OF PIPE	29.0817916	-81.0606362
3040	1745466.0488	623858.1889	98.12	4" 90° & 2" & 4" TEE	29.0818321	-81.0606115
3041	17454633.1267	623868.0912	88.61	16" X 4" TEE	29.0818292	-81.0606282
3042	17454631.1028	623832.9778	74.01	16" X 4" TEE TO WELL & 2" & 4" 90°	29.0818271	-81.0606881
3043	17454677.9920	623882.3502	91.84	16" & 2" & 4" TOP OF PIPE	29.0818736	-81.0606212
3044	17454713.3639	623897.8102	95.54	16" X 4" & 2" & 4" TEE	29.0819096	-81.0606150
3045	1745476.8927	623702.6849	97.45	16" X 4" & 2" & 4" TEE AY2	29.0819408	-81.0606096
3046	17454768.0685	623706.3539	95.12	16" X 4" TEE	29.0819628	-81.0606055
3047	17454768.9132	623704.5827	93.39	4" 90° & 2" & 4" TEE	29.0819636	-81.0606074
3048	17454780.3298	623709.7167	94.38	16" X 4" TEE	29.0819749	-81.0606017
3049	17454782.8510	623708.5527	93.04	4" 90° & 2" & 4" TEE	29.0819774	-81.0606029
3050	17454790.9040	623715.2279	93.85	16" X 4" TEE	29.0819864	-81.0605955
3051	17454792.5492	623712.8701	92.11	4" 90° & 2" & 4" TEE	29.0819870	-81.0605981
3052	17454789.9835	623686.3424	81.02	4" & 2" & 4" TOP OF PIPE	29.0819845	-81.0606006
3053	17454802.7929	623619.7243	65.81	6" X 4" WELL TIE & 2" & 4" 90° BEND	29.0819971	-81.0607032
3054	17454839.1066	623580.1488	57.30	6" X 4" WELL TIE & 2" & 4" 90° BEND	29.0818221	-81.0607479
3055	17454852.6184	623649.5646	70.97	4" & 4" & 2" TOP OF PIPE	29.0820464	-81.0606896
3056	1745481.7486	623681.5283	82.14	4" & 4" & 2" TOP OF PIPE	29.0820090	-81.0606335
3057	17454837.7808	623690.5980	79.14	4" & 4" & 2" TOP OF PIPE	29.0820158	-81.0606233
3058	17454882.8952	623688.5706	69.39	6" X 4" TIE IN & 2" & 4" 90° BEND	29.0820762	-81.0606482
3059	17454851.1884	623770.9561	82.38	16" X 4" TEE	29.0820461	-81.0605927
3060	17454853.5410	623770.8940	80.89	4" 90° & 2" & 4" TEE	29.0820475	-81.0605330
3061	17454903.0004	623763.2127	64.86	6" X 4" TIE IN & 2" & 4" 90° BEND	29.0820964	-81.0605415
3062	17454874.0102	623810.0517	75.57	6" X 4" TEE & 2" & 4" TEE	29.0820678	-81.0604886
3063	17454820.2968	623836.8463	91.46	2" & 4" & 2" 90° BEND	29.0820746	-81.0604684
3064	17454827.1276	623822.4405	86.07	16" TIE IN & 2" & 4" TOP	29.0820507	-81.0604168
3065	17454899.6740	623928.7879	74.65	4" FM VALVE	29.0820383	-81.0603547
3066	17454904.1518	623945.5242	66.81	2" & 4" TRES	29.0820977	-81.0603359
3067	17454904.0738	623952.6905	66.95	2" & 4" TIE IN EXIST	29.0820977	-81.0603278
3068	1745485.7120	62484.9430	35.52	2" & 4" TRES	29.0821195	-81.0557602
3069	1747032.3228	624500.4028	34.04	2" & 4" TRES	29.0822250	-81.0557103
3070	1747039.1492	624537.8659	33.06	2" & 4" TRES	29.0822319	-81.0556882
3071	1747040.0823	624549.9304	33.13	2" & 4" TRES	29.0822328	-81.0556844
3072	1747038.9918	624682.9975	33.46	2" & 4" TRES TIE IN EXIST	29.0823117	-81.0556397
3073	1747039.3055	624596.1446	38.57	2" & 4" TRES	29.0822328	-81.0556023
3074	1747031.2584	624599.2569	38.10	2" & 4" 90° CUT	29.0822241	-81.0555986
3075	1745546.0807	62470.4681	33.12	2" AIR VALVE	29.0807538	-81.0555171
3076	1745548.1716	624686.7522	33.36	4" FM VALVE	29.0807558	-81.0555213

AS-BUILT LEGEND

AS-BUILT ABBREVIATIONS:


AS-BUILT SURVEY: NOT A BOUNDARY SURVEY. SURVEYOR'S CERTIFICATE: I HEREBY CERTIFY THAT THIS PLAN MEETS THE MINIMUM TECHNICAL STANDARDS SET FORTH BY THE FLORIDA BOARD OF PROFESSIONAL SURVEYORS AND MEMBERS IN COMPLIANCE WITH SECTION 473.001, FLORIDA STATUTES.

SLIGER & ASSOCIATES, INC. AS-BUILT SURVEY

PROFESSIONAL LAND SURVEYORS
 LICENSED BUSINESS CERTIFICATION # 3018
 7821 NINA ROAD • PORT ORANGE, FL 32127 • (386) 781-5383

DATE: 09/11/11
 TIME: 10:00 AM
 BY: M. AUSTIN

PROJECT NUMBER: 000000000170244

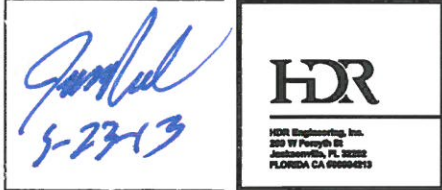

PROJECT MANAGER	C. LEBRON, P.E.	
DESIGNED BY	M. AUSTIN	
DESIGNED BY		
DESIGNED BY		
DRAWN BY	M. AUSTIN	
CHECKED BY		
ISSUE	DATE	DESCRIPTION
1	09/11	DRAFT
PROJECT NUMBER	000000000170244	



CLASS I ACTIVE AREA
TOMOKA FARMS ROAD LANDFILL
VOLUSIA COUNTY, FLORIDA
NOT FOR CONSTRUCTION

PHASE III - PART A
LFG SYSTEM EXPANSION

0 1" 2" FILENAME: DOLFG-01.dwg SHEET: 00LFG-01-1

SCALE: AS SHOWN

DATE: 09/11/11

CAD TECH: M. AUSTIN