



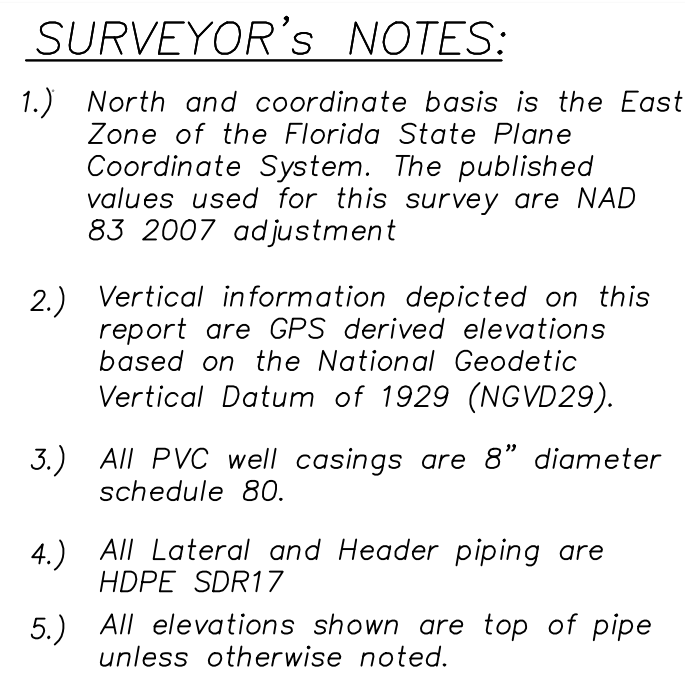

LEGEND:

D.	NUMBER
LEV.	ELEVATION
516	ASBULT POINT NUMBER
R	LICENSE BUSINESS

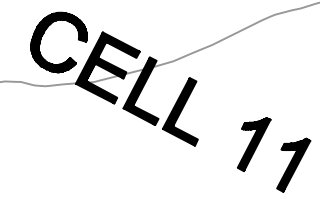

CELL 10

CELL 13

CELL 2

CELL 3

CELL 6

CELL 9

CELL 12

CELL 1

CELL 4

CELL 5


CELL 7

CELL 8

ASBUILT SURVEY - GCCS 2015
CELLS 1,2,3,4,5,6,7,8,9&10 - J.E.D.
SOLID WASTE MANAGEMENT FACILITY
1501 OMNI WAY ST. CLOUD, FL

Peavey & Associates
SURVEYING & MAPPING PA

CLIENT:
Omni Waste of Osceola
County, LLC
Waste Services, Inc.
1501 Omni Way
St. Cloud, FL 34773

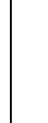NO.	DATE	REVISION
		
Drawn By:	THIS SURVEY IS NOT VALID WITHOUT THE SIGNATURE AND SEAL OF SURVEYOR	
DLP		
Party Chief:		
SP		
Field Book:		
51		
FILE NAME:	1009 abault gas 12-16-2015.dwg	

Deborah L. Peavey

DEBORAH L. PEAVEY, P.S.M.
FLORIDA REGISTRATION
NUMBER 6345
FLORIDA BUSINESS
NUMBER 7779
12/16/2015
SURVEY DATE

SCALE 1"=60'	DRAWING NO. 304
PROJECT NO. 1009	SHEET 1