




NORTH


SECONDARY LAYER

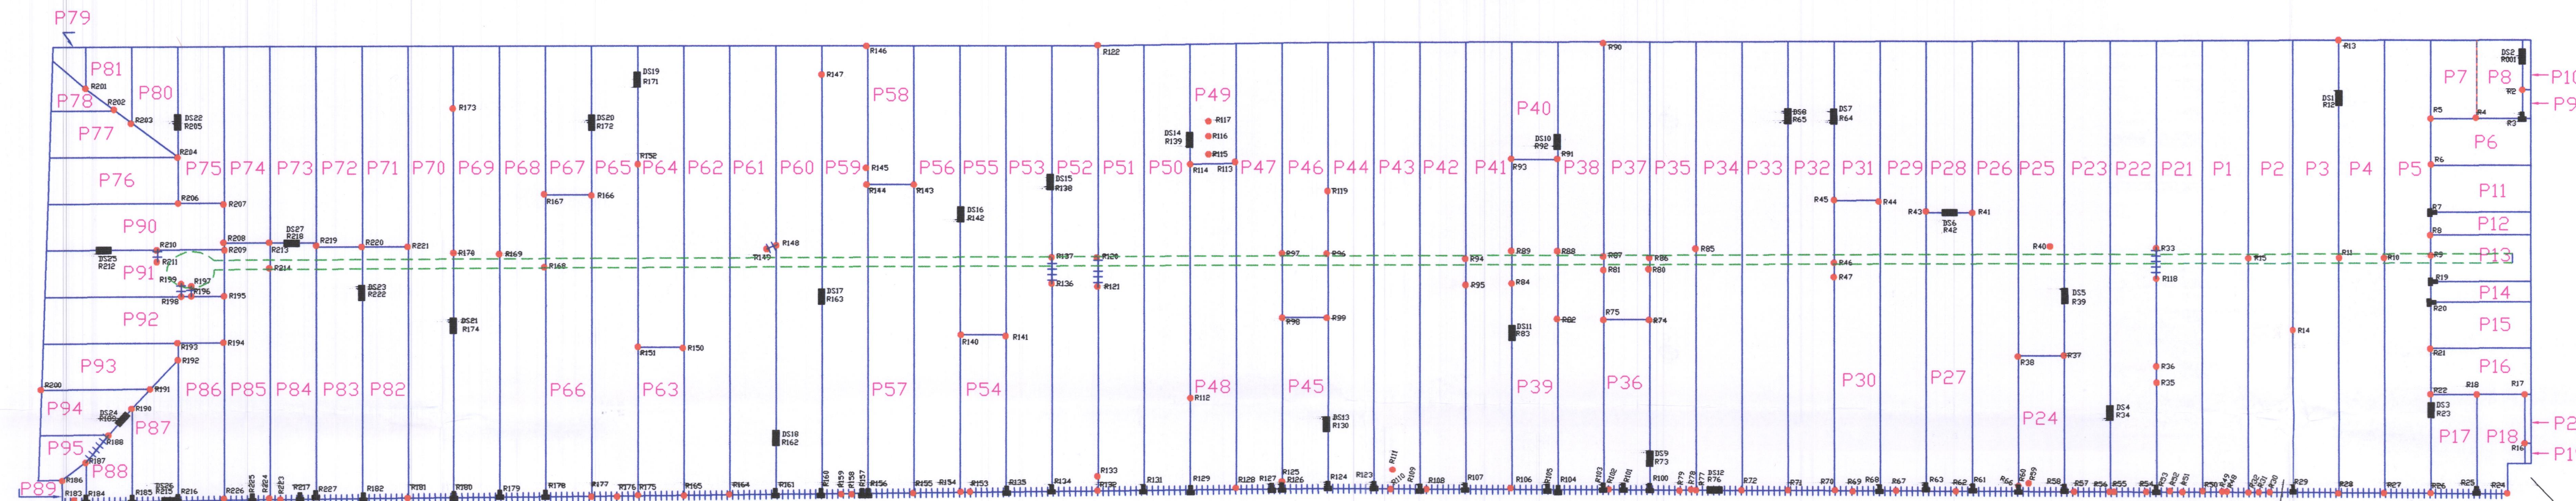

TOP OF SLOPE

ANCHOR TRENCH

PRIMARY LAYER

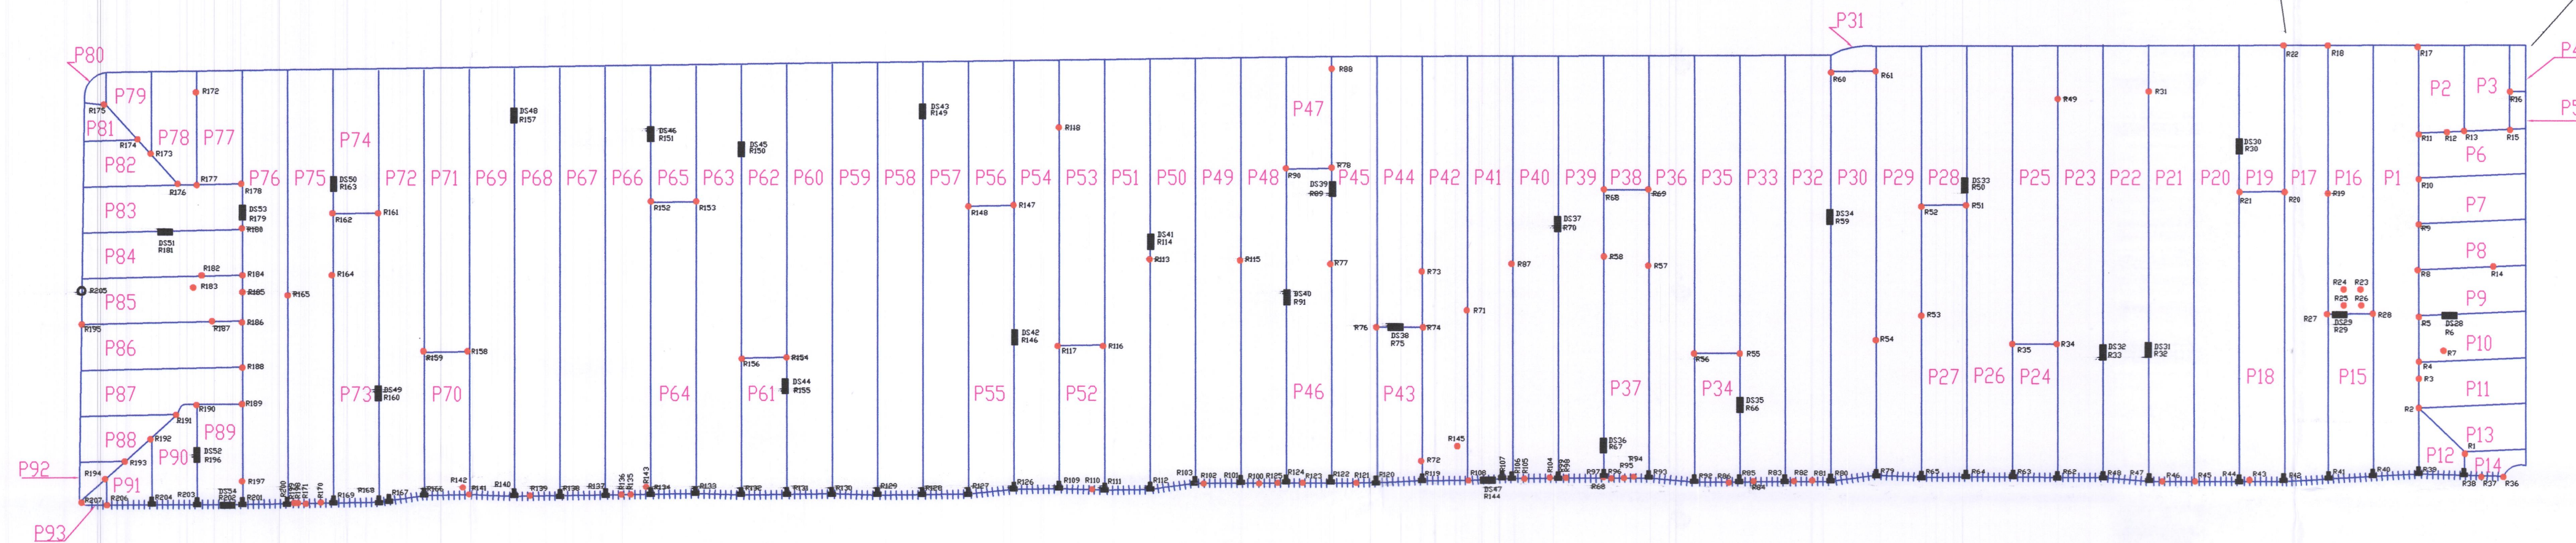

LEGEND

●	REPAIR
■	DESTRUCTIVE SAMPLE
⬇	T WELD
○	VENT
P	PANEL NUMBER
R	REPAIR NUMBER

TOMOKA FARMS ROAD LANDFILL
AS-BUILT

VOLUSIA COUNTY,
DEPARTMENT OF
SOLID WASTE SERVICES
DELAND, FLORIDA

60 MIL
TEXTURED
HDPE



7911 PROFESSIONAL PLACE
TAMPA, FLORIDA 33637
TELEPHONE: (813) 988-8829
FAX: (813) 988-8779

DRAWN BY: JAA	CHKD. BY: JP	DWG. NO:
DATE: 5/17/02	APPRVD. BY: JP	1
DWG. SCALE: 1" = 50'	FILE NAME: TOMOKA FARMS	
PROJECT NO.: 010-874		