


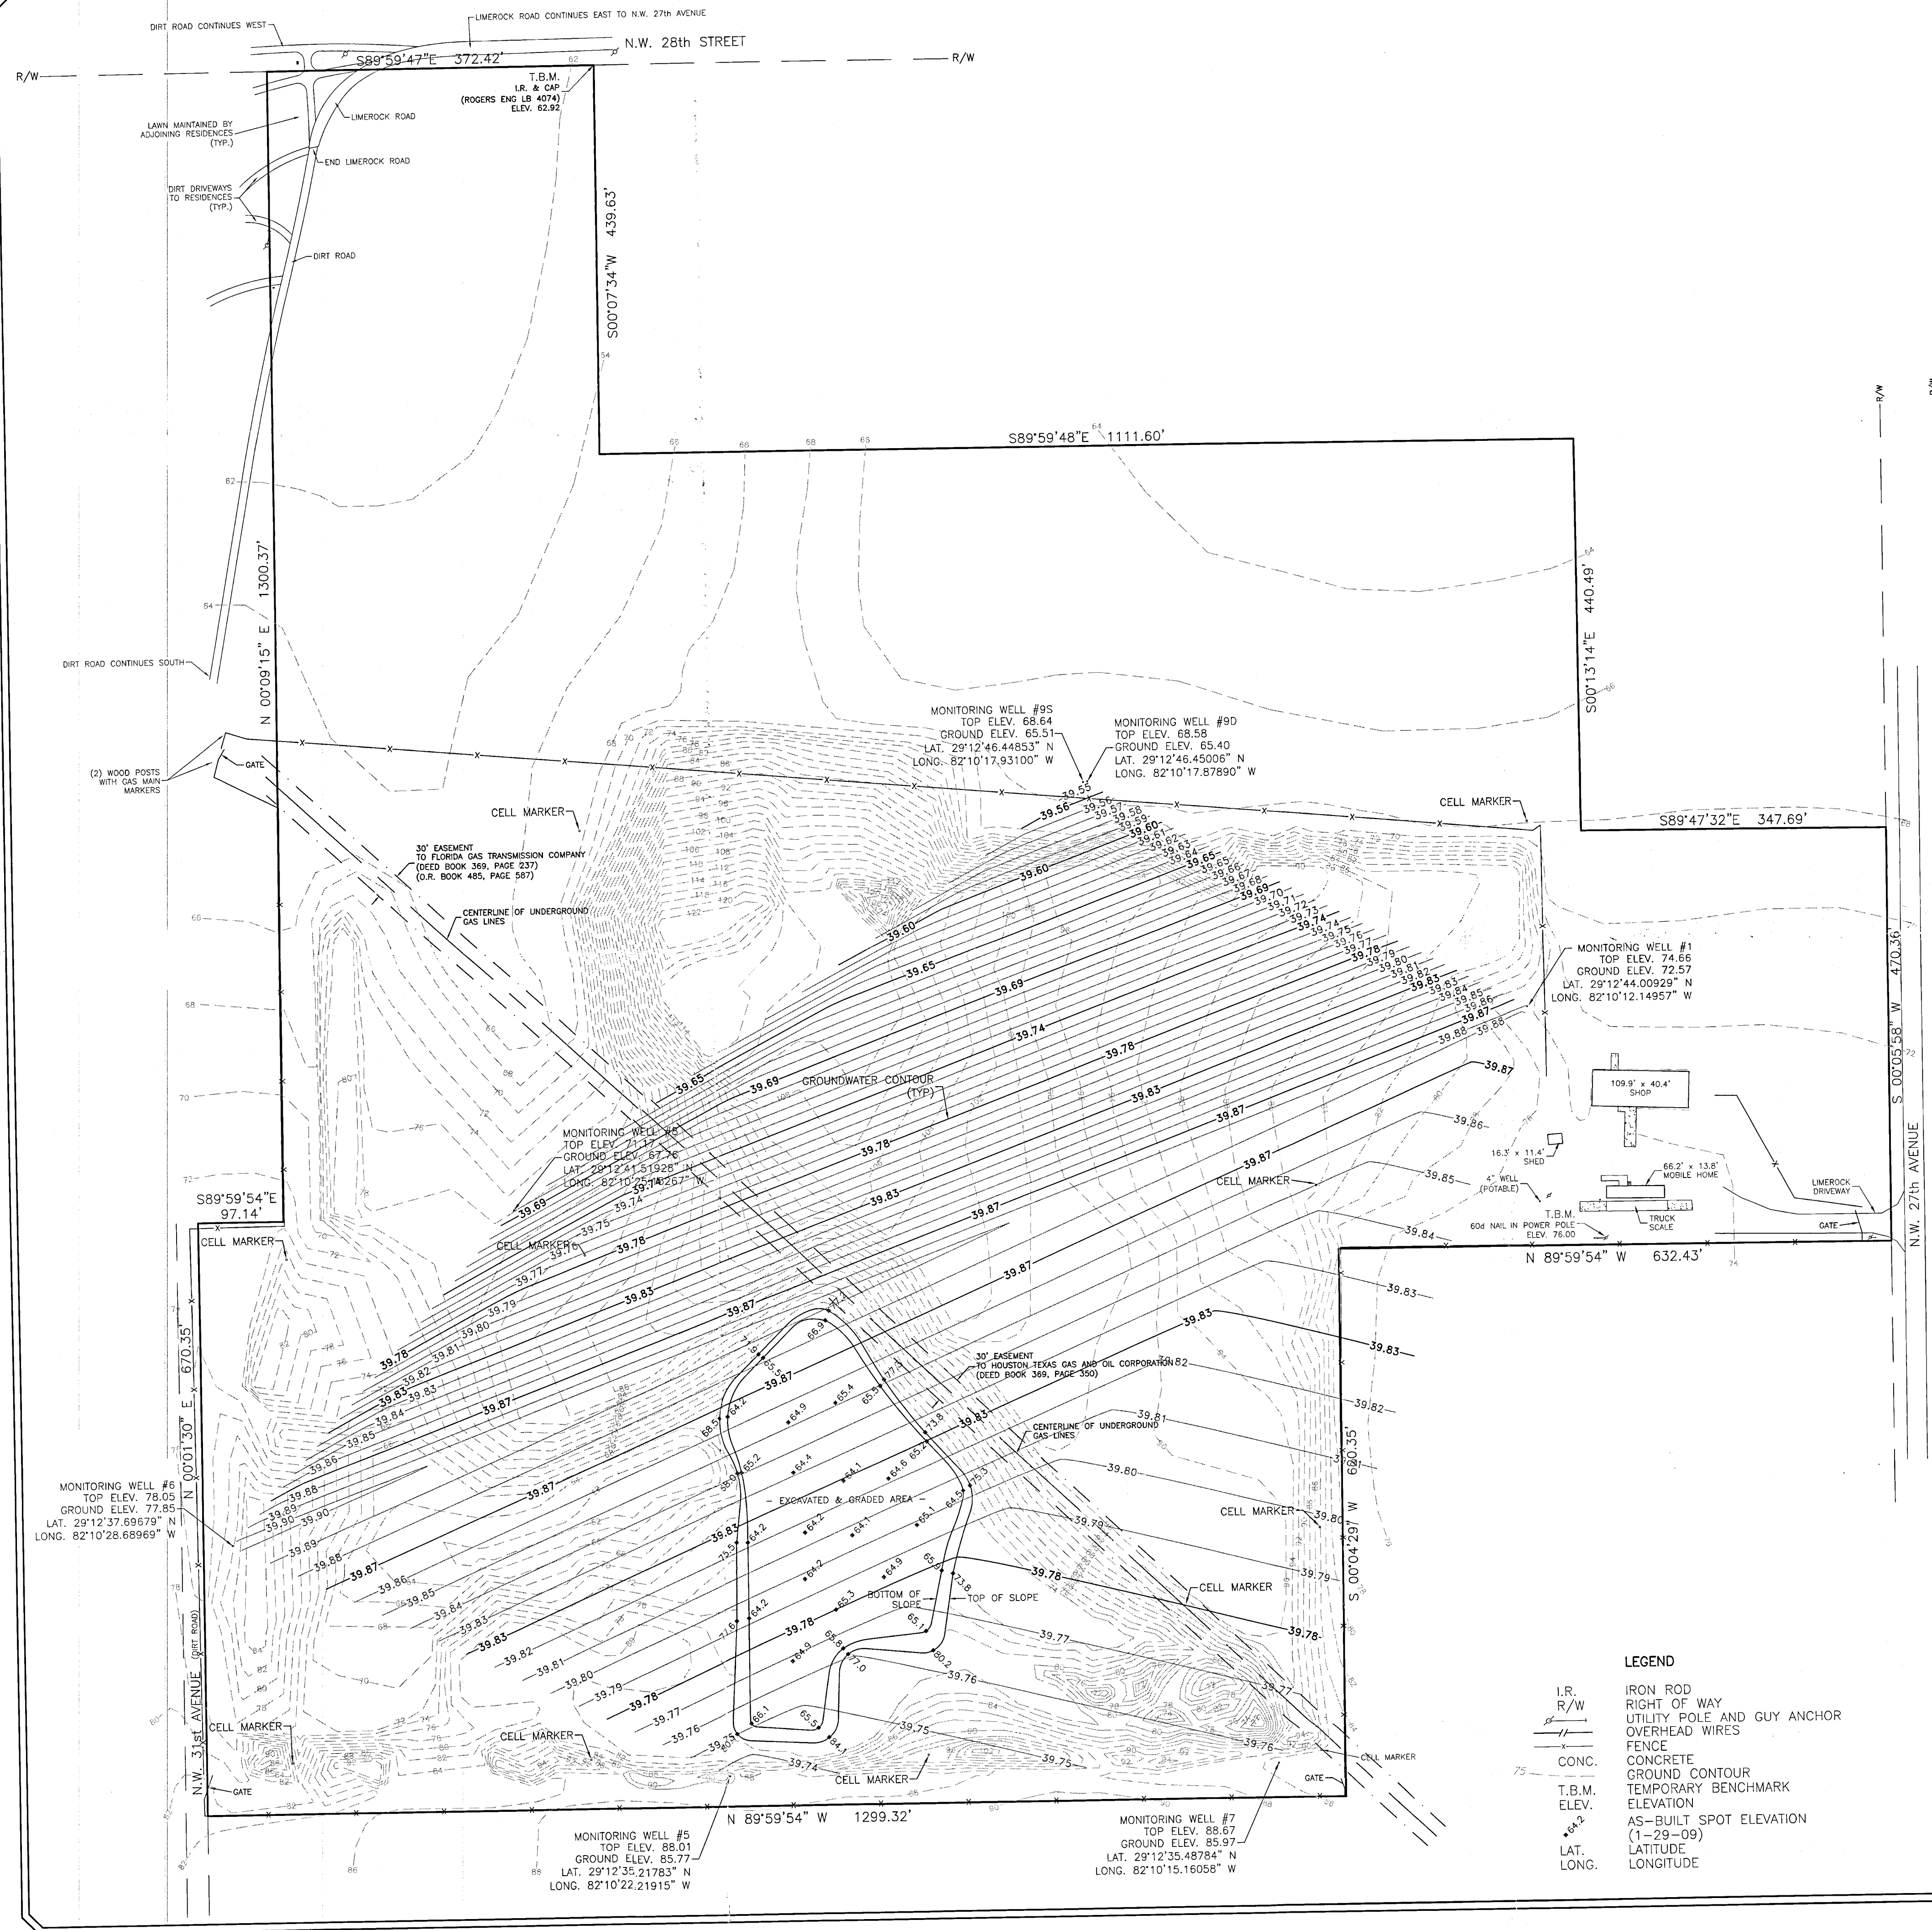


- NOTES:
1. THE BOUNDARY INFORMATION SHOWN HEREON IS BASED ON PREVIOUS BOUNDARY SURVEYS AND SKETCH OF LEGAL DESCRIPTIONS, PREPARED BY THIS FIRM FOR FRIENDS RECYCLING, L.L.C.
 2. ELEVATIONS AND CONTOURS SHOWN HEREON ARE BASED ON N.G.V.D. DATUM; CITY OF OCALA BM @ N.W. 27th AVENUE AND N.W. 18th STREET; ELEVATION 69.47 (NAVD-88).
 3. ORIGINAL FIELD SURVEY DATE: 12-03-07;
FIELD SURVEY DATE OF RELOCATED MONITORING WELLS: 8-04-08;
FIELD SURVEY DATE OF EXCAVATED & GRADED AREA: 1-29-09.
 4. THE TOP ELEVATION OF THE MONITORING WELLS, AS SHOWN HEREON, REPRESENT THE ELEVATION OF THE TOP OF THE WELL CASING ON THE NORTH EDGE. THE GROUND ELEVATION REPRESENTS THE ELEVATION OF THE GROUND, NEXT TO THE WELL CASING ON THE NORTH SIDE.
 5. CONTOURS WITHIN THE TOP & BOTTOM OF SLOPE AND WITHIN THE EXCAVATED & GRADED AREA WERE NOT SHOWN FOR CLARITY.

SURVEY PREPARED BY:
ROBERT L. ROGERS ENGINEERING CO. INC.
LIC. BUS. #4074
1105 S.E. 3rd Ave. OCALA, FLORIDA 34471 (352) 622-9214

RECEIVED
FEB 17 2012
DEP Central Dist.


ROBERT M. COUCH III, P.E. : *Robert M. Couch*
FLORIDA REG. No. 55311
DATE : 2/16/2012
C.O.A. No. 8692

SITE PLAN		ENVIRONMENTAL & CIVIL ENGINEERING CONSULTANTS		FRIENDS RECYCLING, LLC. MARION COUNTY, FLORIDA		GROUNDWATER CONTOURS	
P.N. 2009-		15290 SE HWY 42, PO BOX 152 WEIRSDALE, FLORIDA 32195		PHONE: (352) 694-1799 FAX: (866) 832-0250		DRAWN: RMC-3 DESIGNED: RMC-3 CHECKED: RMC-3 SCALE: 1" = 100'	
Sht. 1 of 1						REVISIONS Groundwater contours revised 2-9-2012	

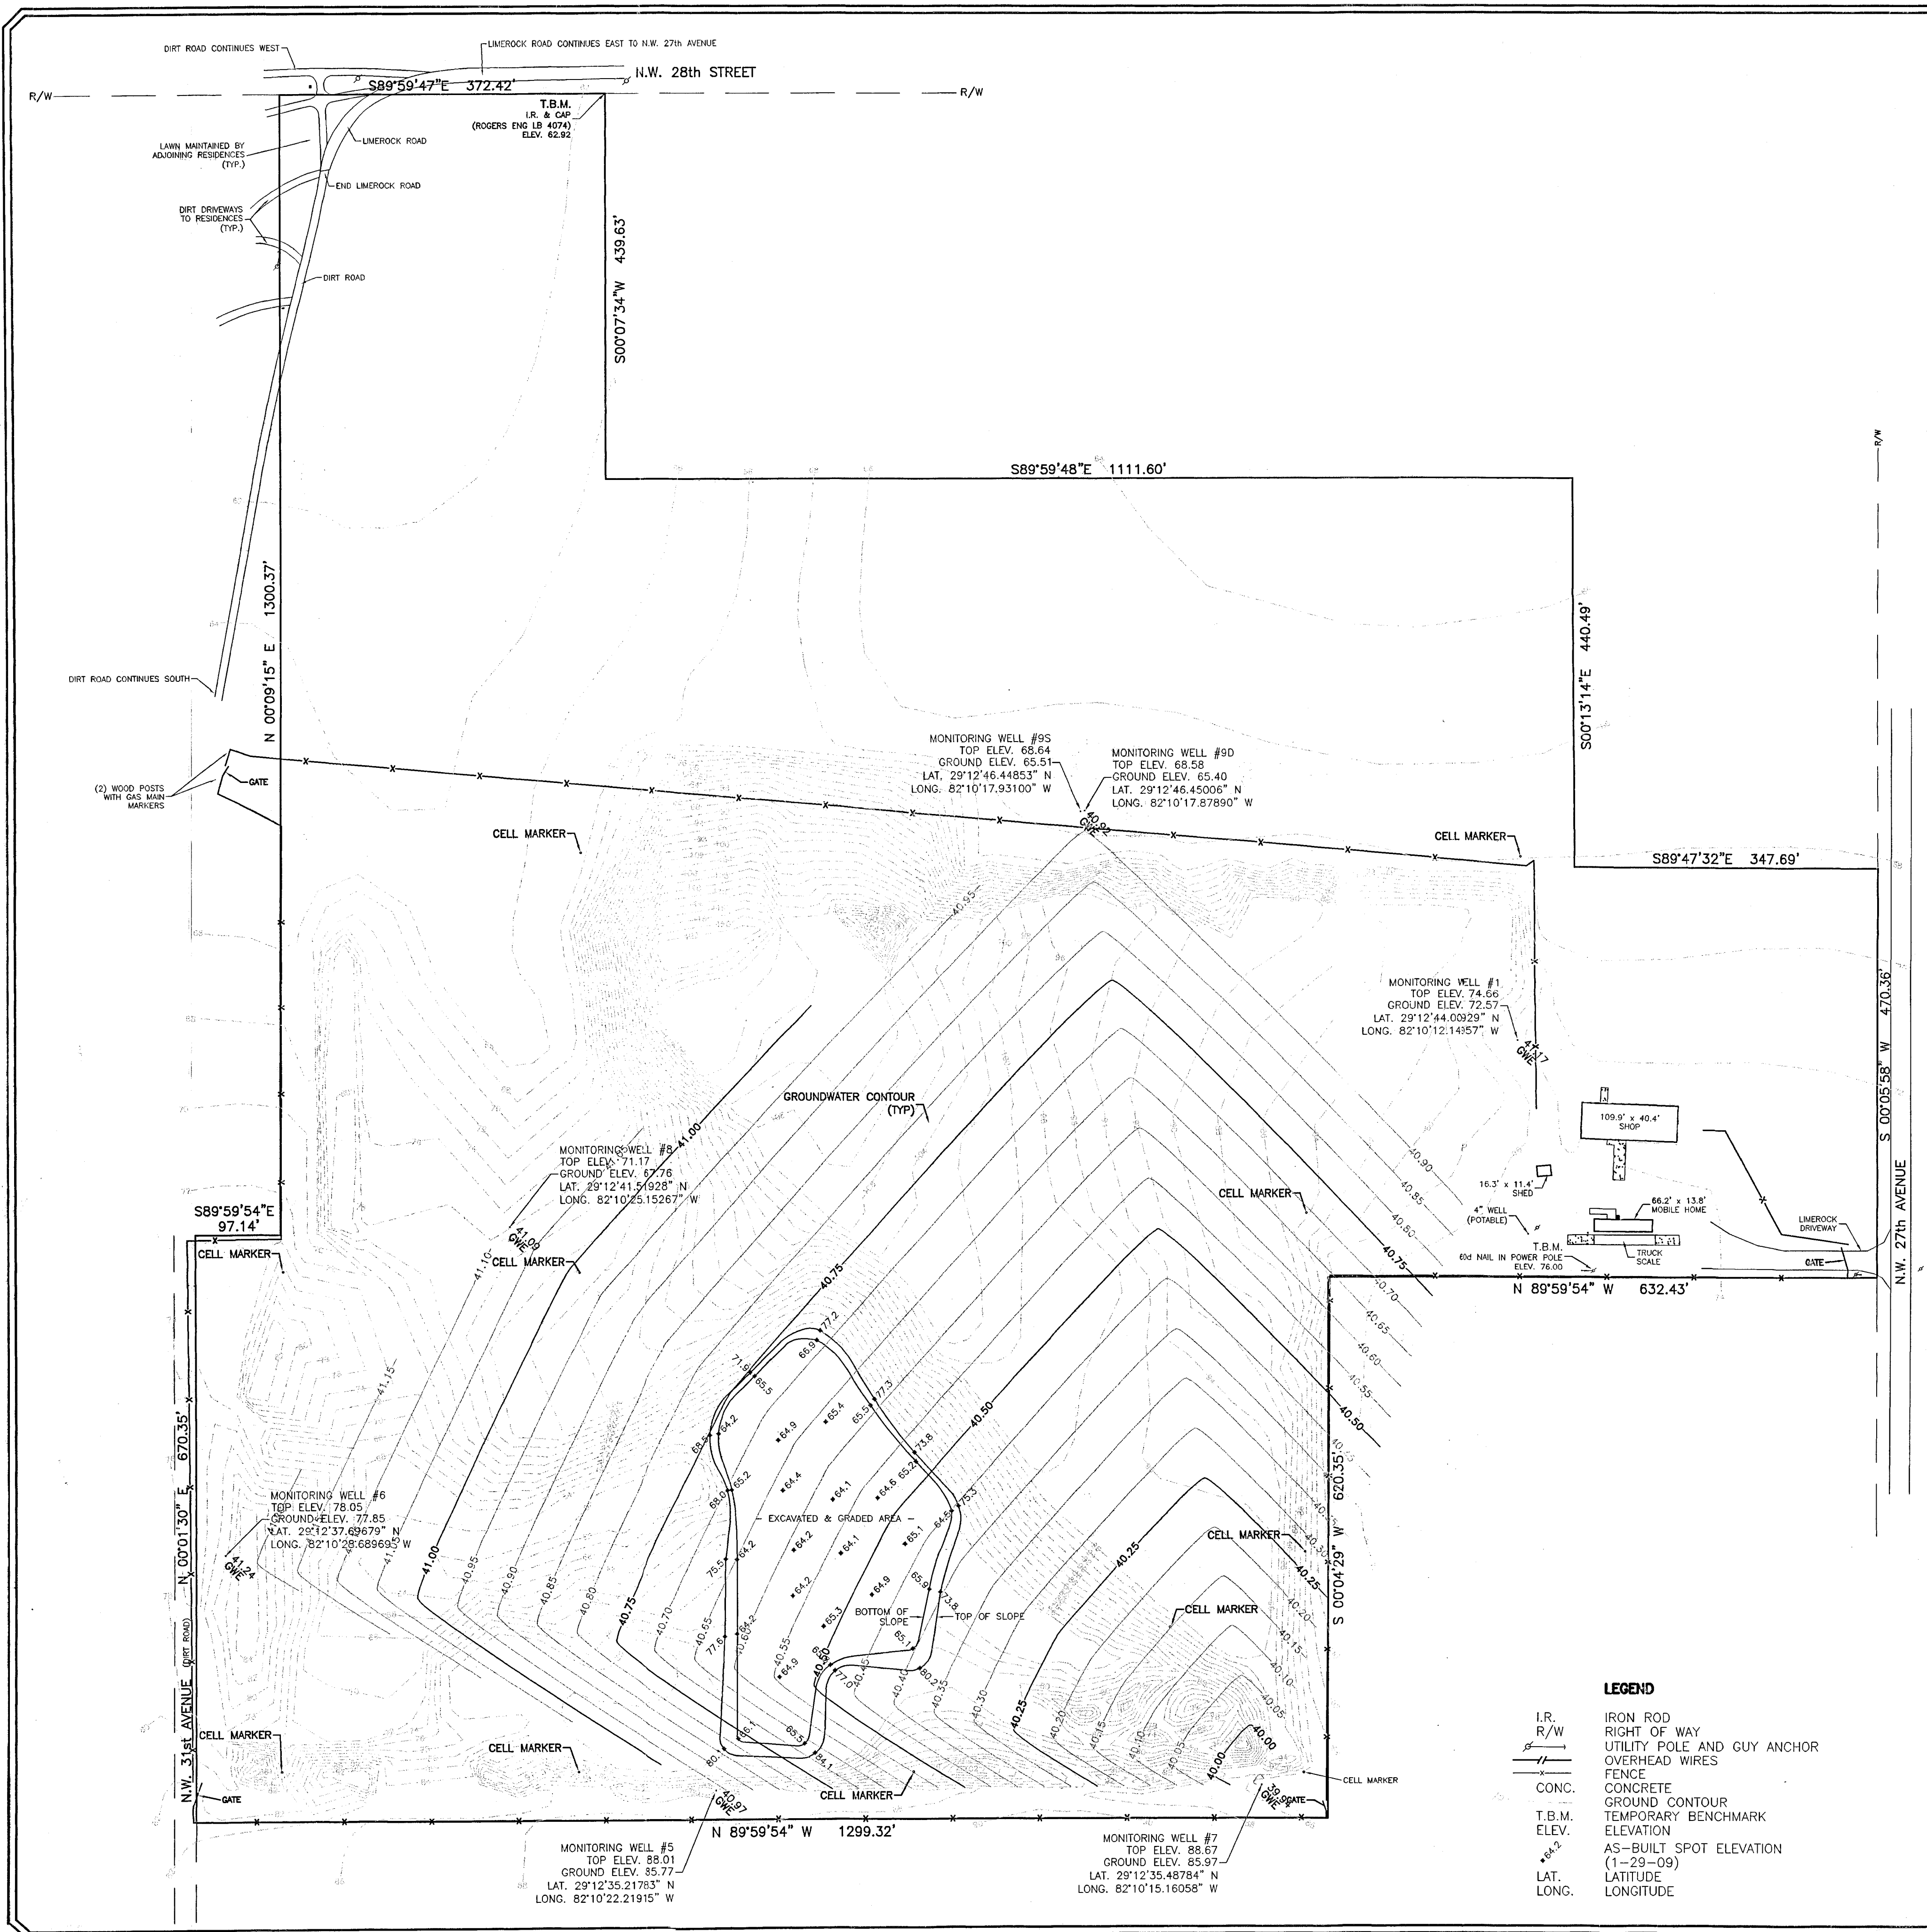

SURVEY PREPARED BY:
ROBERT L. ROGERS ENGINEERING CO. INC.
 LIC. BUS. #4074
 1105 S.E. 3rd Ave. OCALA, FLORIDA 34471 (352) 622-9214


- NOTES:**
1. THE BOUNDARY INFORMATION SHOWN HEREON IS BASED ON PREVIOUS BOUNDARY SURVEYS AND SKETCH OF LEGAL DESCRIPTIONS, PREPARED BY THIS FIRM FOR FRIENDS RECYCLING, L.L.C.
 2. ELEVATIONS AND CONTOURS SHOWN HEREON ARE BASED ON N.G.V.D. DATUM; CITY OF OCALA BM @ N.W. 27th AVENUE AND N.W. 18th STREET; ELEVATION 69.47 (NAVD-88).
 3. ORIGINAL FIELD SURVEY DATE: 12-03-07;
 FIELD SURVEY DATE OF RELOCATED MONITORING WELLS: 8-04-08;
 FIELD SURVEY DATE OF EXCAVATED & GRADED AREA: 1-29-09.
 4. THE TOP ELEVATION OF THE MONITORING WELLS, AS SHOWN HEREON, REPRESENT THE ELEVATION OF THE TOP OF THE WELL CASING ON THE NORTH EDGE. THE GROUND ELEVATION REPRESENTS THE ELEVATION OF THE GROUND, NEXT TO THE WELL CASING ON THE NORTH SIDE.
 5. CONTOURS WITHIN THE TOP & BOTTOM OF SLOPE AND WITHIN THE EXCAVATED & GRADED AREA WERE NOT SHOWN FOR CLARITY.

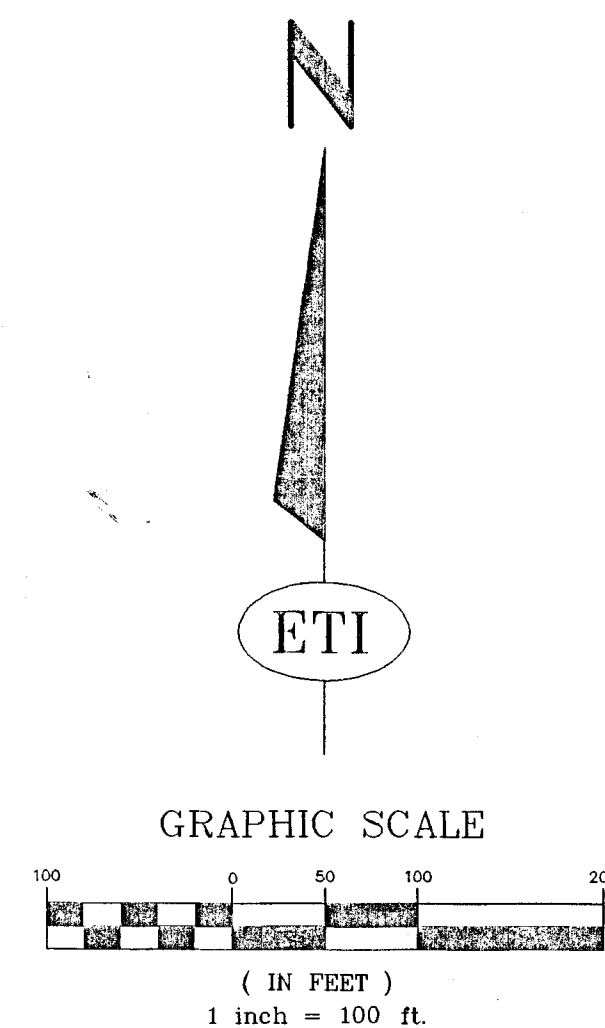

RECEIVED
 FEB 24 2010
 DEP Central Dist.

ROBERT M. COUCH III, P.E. : *Robert M. Couch III*
 FLORIDA REG. No. 55311
 DATE : 2/22/2010
 C.O.A. No. 8692

REVISIONS	PLOTTED:	RMC-3	N/A
	DRAWN:	RMC-3	N/A
	DESIGNED:	RMC-3	N/A
	CHECKED:	RMC-3	N/A
SCALE: 1" = 100'			
GROUNDWATER CONTOURS			
FRIENDS RECYCLING, L.L.C.			
MARION COUNTY, FLORIDA			
ENVIRONMENTAL & CIVIL ENGINEERING CONSULTANTS		PHONE (352) 694-1799	
FAX (866) 852-0250		15290 SE HWY 42, PO BOX 152	
WEIRSDALE, FLORIDA 32195		Sht. 1 of 1	

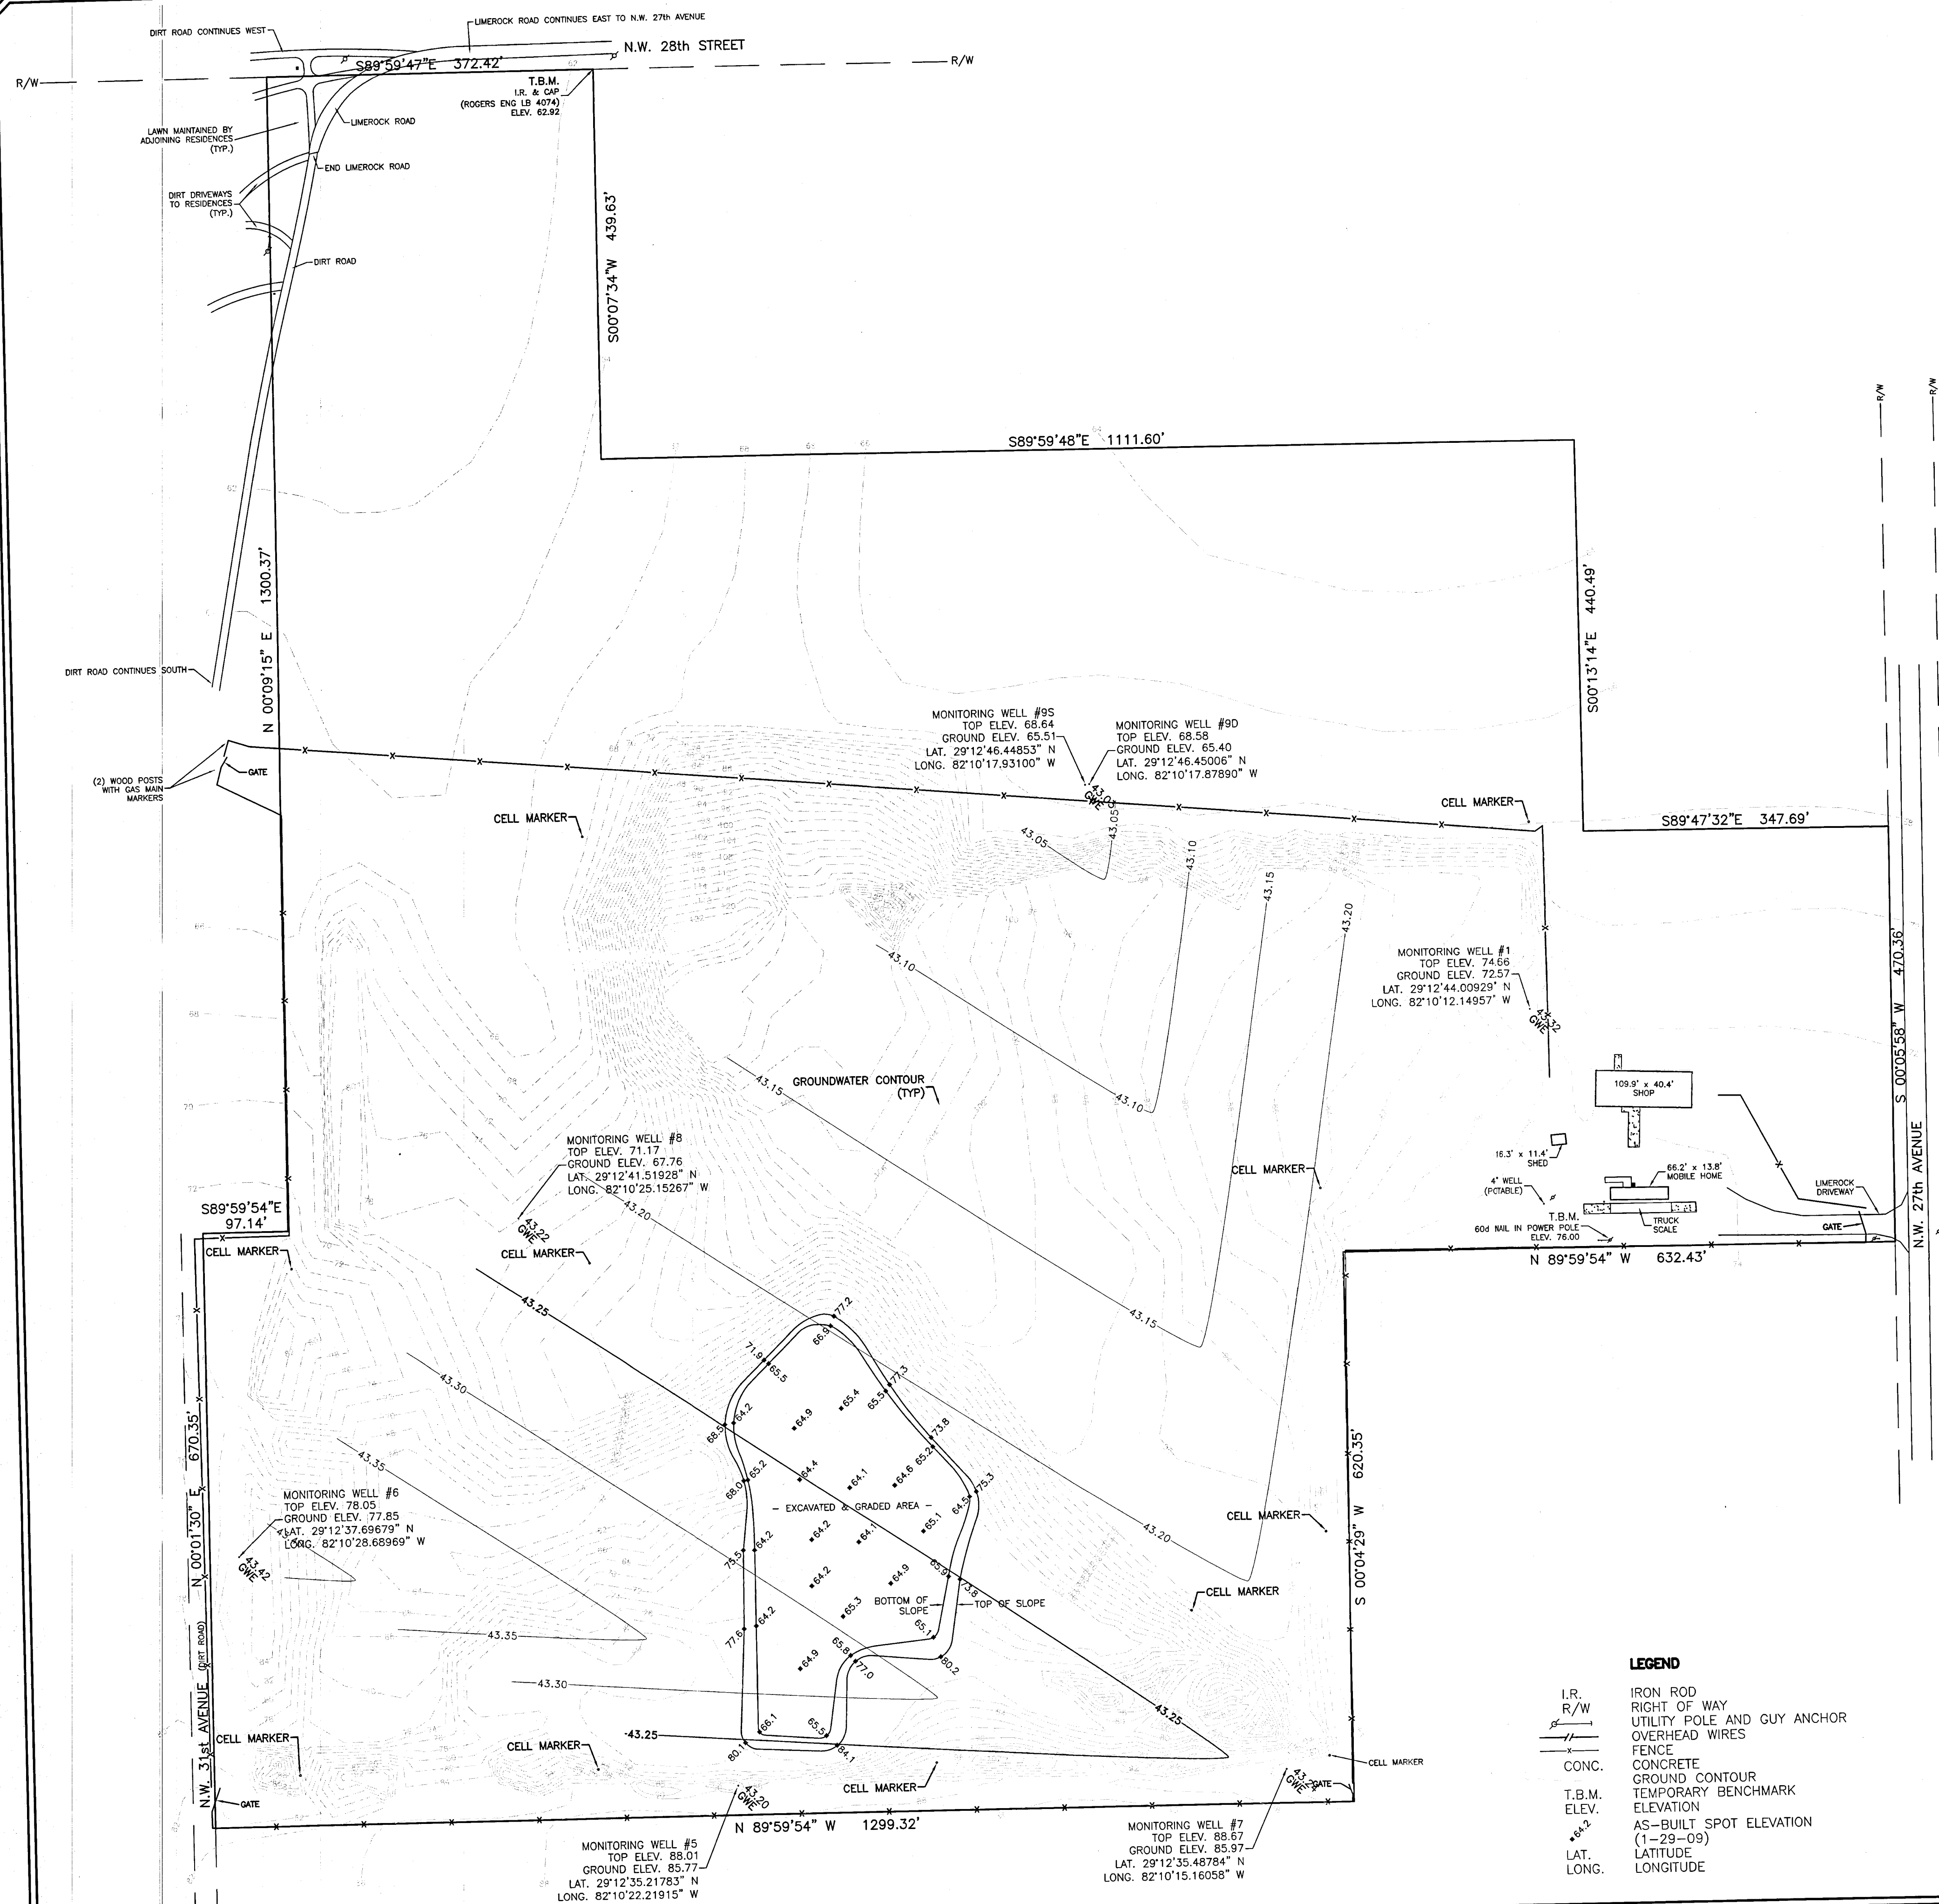

NOTES:


1. THE BOUNDARY INFORMATION SHOWN HEREON IS BASED ON PREVIOUS BOUNDARY SURVEYS AND SKETCH OF LEGAL DESCRIPTIONS, PREPARED BY THIS FIRM FOR FRIENDS RECYCLING, L.L.C.
2. ELEVATIONS AND CONTOURS SHOWN HEREON ARE BASED ON N.G.V.D. DATUM; CITY OF OCALA BM @ N.W. 27th AVENUE AND N.W. 18th STREET; ELEVATION 69.47 (NAVD-88).
3. ORIGINAL FIELD SURVEY DATE: 12-03-07;
FIELD SURVEY DATE OF RELOCATED MONITORING WELLS: 8-04-08;
FIELD SURVEY DATE OF EXCAVATED & GRADED AREA: 1-29-09.
4. THE TOP ELEVATION OF THE MONITORING WELLS, AS SHOWN HEREON, REPRESENT THE ELEVATION OF THE TOP OF THE WELL CASING ON THE NORTH EDGE. THE GROUND ELEVATION REPRESENTS THE ELEVATION OF THE GROUND, NEXT TO THE WELL CASING ON THE NORTH SIDE.
5. CONTOURS WITHIN THE TOP & BOTTOM OF SLOPE AND WITHIN THE EXCAVATED & GRADED AREA WERE NOT SHOWN FOR CLARITY.

SURVEY PREPARED BY:
ROBERT L. ROGERS ENGINEERING CO. INC.
 LIC. BUS. #4074
 1105 S.E. 3rd Ave. OCALA, FLORIDA 34471 (352) 622-9214

RECEIVED
 AUG 05 2010
 DEP Central Dist.

ROBERT M. COUCH III, P.E. : *[Signature]*
 FLORIDA REG. No. 55311
 DATE : 8/4/2010
 C.O.A. No. 8692

	ENVIRONMENTAL & CIVIL ENGINEERING CONSULTANTS		FRIENDS RECYCLING, LLC. MARION COUNTY, FLORIDA		GROUNDWATER CONTOURS		PLOTTED: RMC-3 N/A		REVISIONS	
	15290 SE HWY 42, PO BOX 152 WEIRSDALE, FLORIDA 32195				PHONE: (352) 694-1799 FAX: (866) 832-0250		DRAWN: RMC-3 N/A DESIGNED: RMC-3 N/A CHECKED: RMC-3 N/A SCALE: 1" = 100'			
	SITE PLAN		P.N. 2009-							
	Sht. 1 of 1									

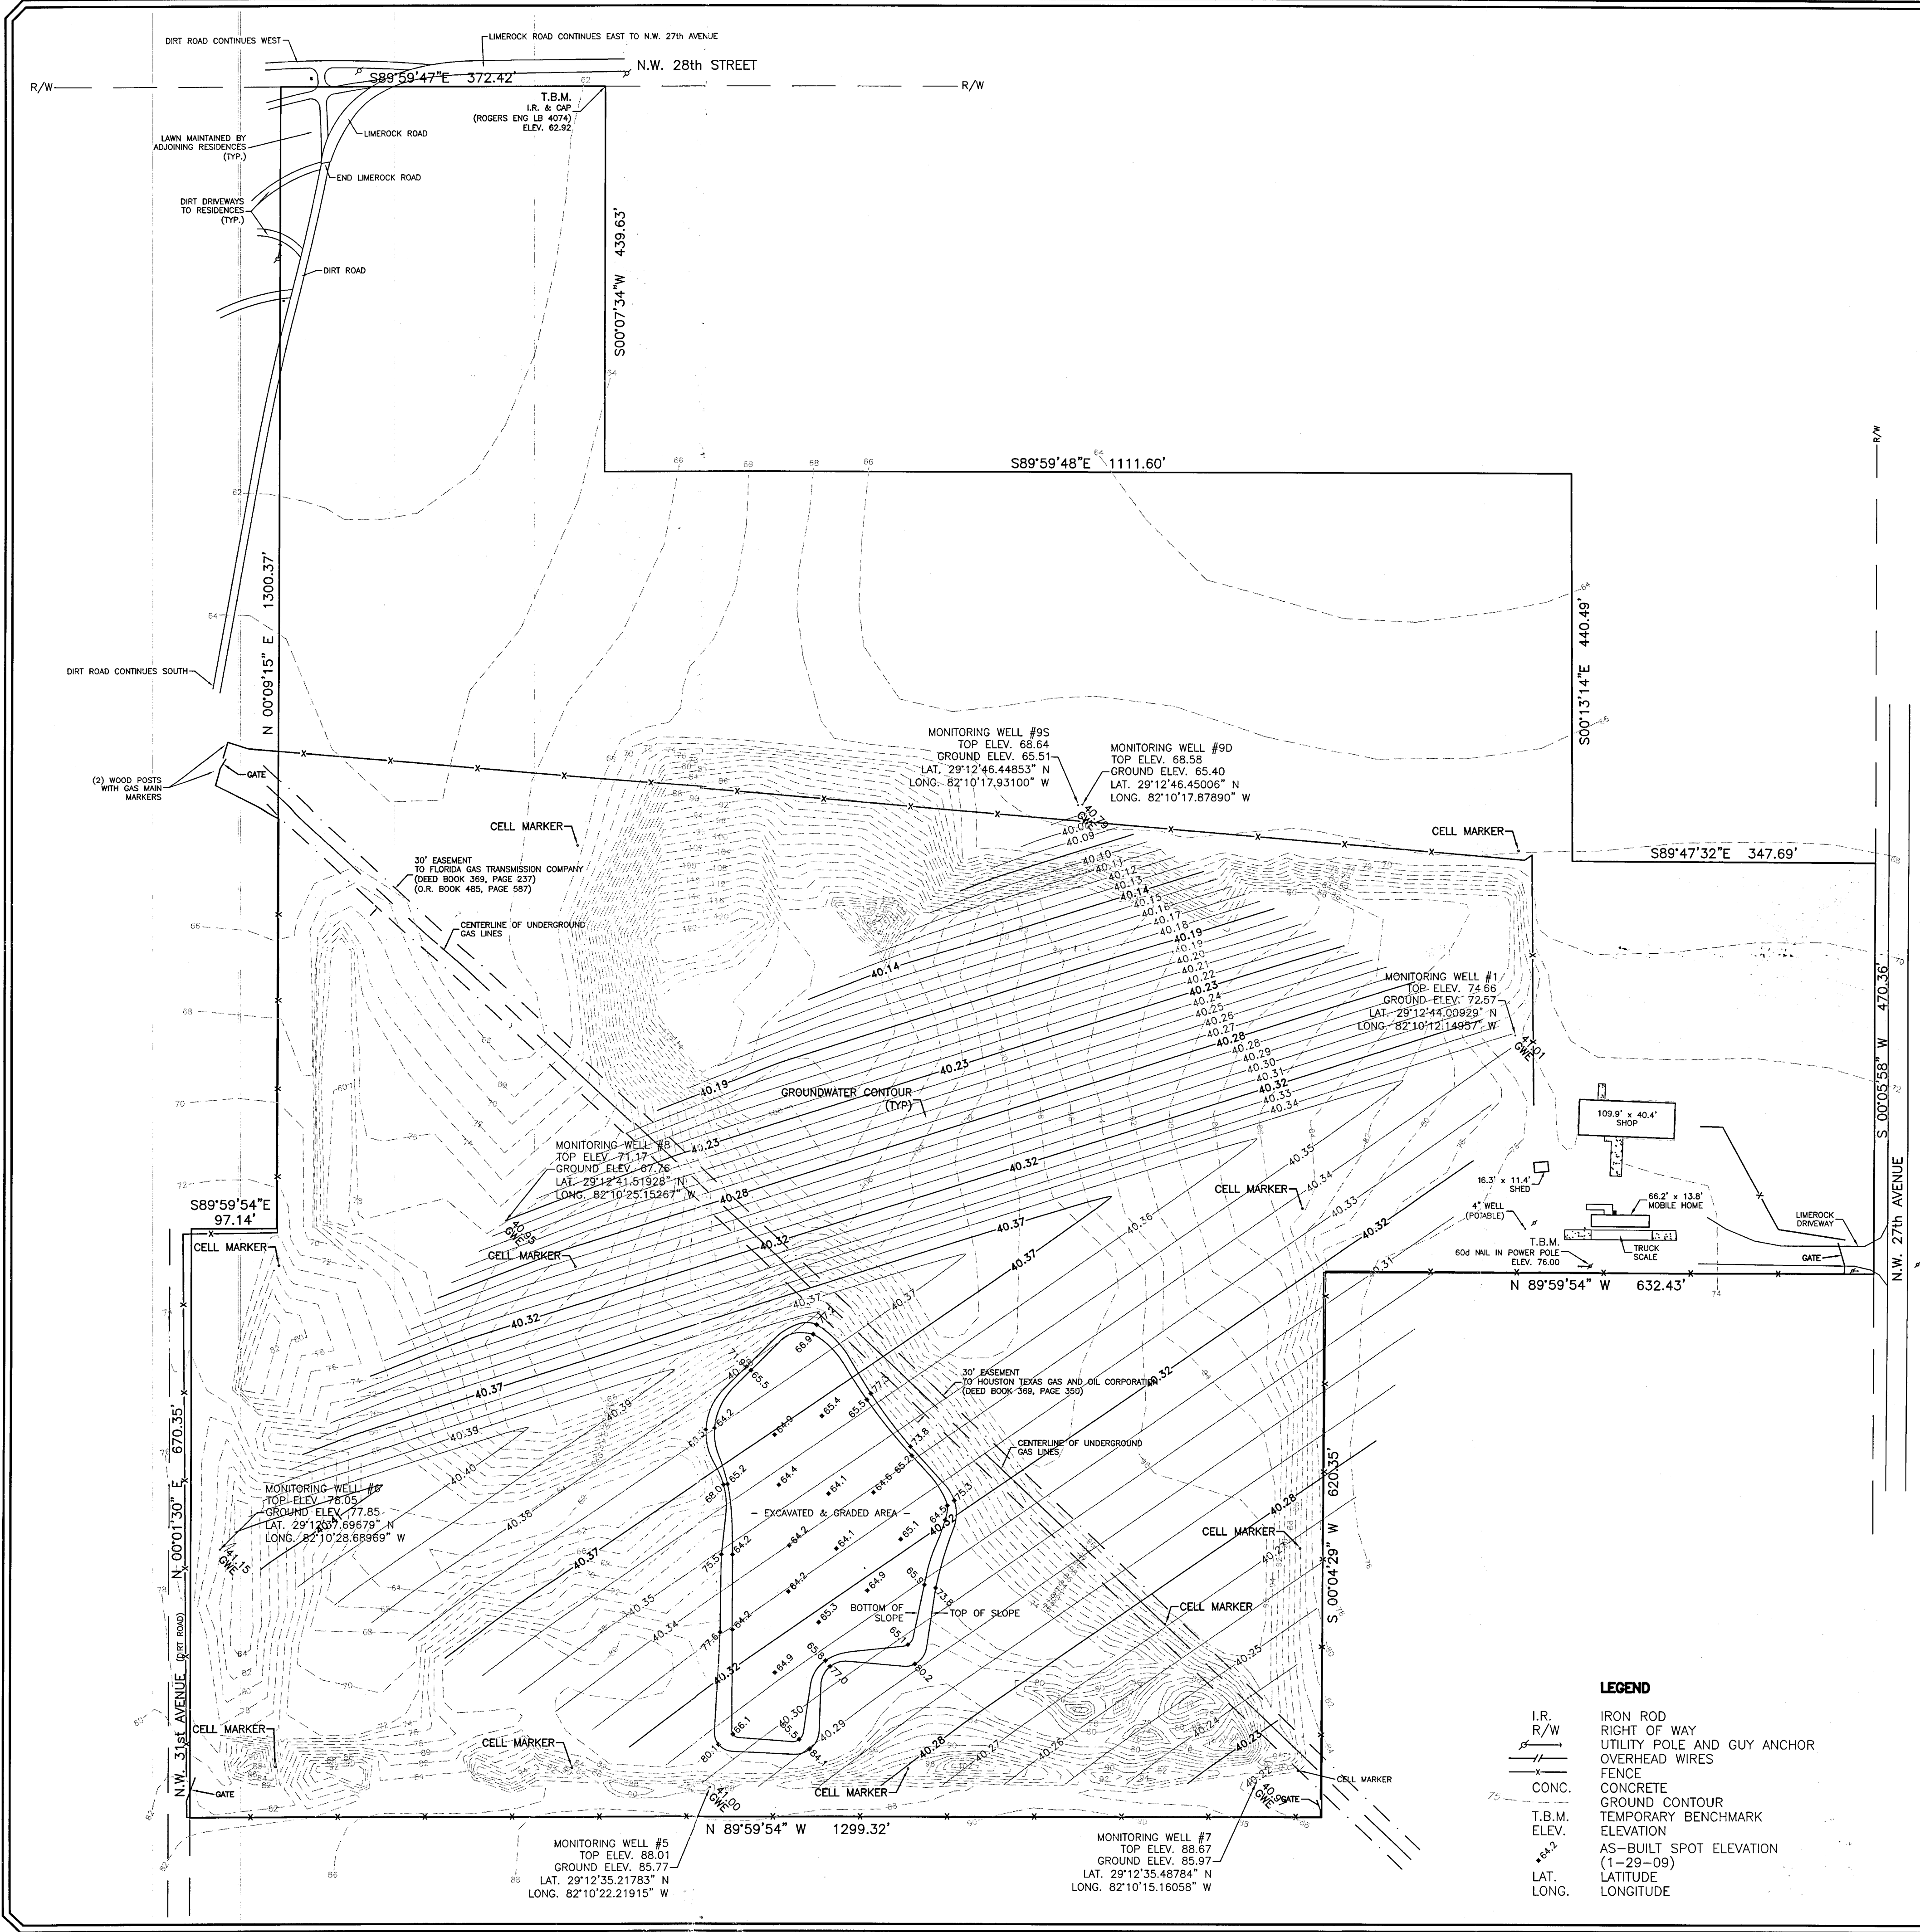

SURVEY PREPARED BY:
ROBERT I. ROGERS ENGINEERING CO. INC.
LIC. BUS. #4074
1105 S.E. 3rd Ave. OCALA, FLORIDA 34471 (352) 622-9214

RECEIVED
AUG 03 2011
DEP Central Dist.

- NOTES:
1. THE BOUNDARY INFORMATION SHOWN HEREON IS BASED ON PREVIOUS BOUNDARY SURVEYS AND SKETCH OF LEGAL DESCRIPTIONS, PREPARED BY THIS FIRM FOR FRIENDS RECYCLING, L.L.C.
 2. ELEVATIONS AND CONTOURS SHOWN HEREON ARE BASED ON N.G.V.D. DATUM; CITY OF OCALA BN @ N.W. 27th AVENUE AND N.W. 18th STREET; ELEVATION 69.47 (NAVD-88).
 3. ORIGINAL FIELD SURVEY DATE: 12-03-07;
FIELD SURVEY DATE OF RELOCATED MONITORING WELLS: 8-04-08;
FIELD SURVEY DATE OF EXCAVATED & GRADED AREA: 1-29-09.
 4. THE TOP ELEVATION OF THE MONITORING WELLS, AS SHOWN HEREON, REPRESENT THE ELEVATION OF THE TOP OF THE WELL CASING ON THE NORTH EDGE. THE GROUND ELEVATION REPRESENTS THE ELEVATION OF THE GROUND, NEXT TO THE WELL CASING ON THE NORTH SIDE.
 5. CONTOURS WITHIN THE TOP & BOTTOM OF SLOPE AND WITHIN THE EXCAVATED & GRADED AREA WERE NOT SHOWN FOR CLARITY.

- LEGEND
- IRON ROD
 - RIGHT OF WAY
 - UTILITY POLE AND GUY ANCHOR
 - OVERHEAD WIRES
 - FENCE
 - CONCRETE
 - GROUND CONTOUR
 - TEMPORARY BENCHMARK
 - ELEVATION
 - AS-BUILT SPOT ELEVATION (1-29-09)
 - LATITUDE
 - LONGITUDE

ROBERT M. COUCH III, P.E. :
FLORIDA REG. No. 55311
DATE : 8/3/2011
C.O.A. No. 8692

ENVIRO TECH, INC.		FRIENDS RECYCLING, LLC.		GROUNDWATER CONTOURS	REVISIONS	
ENVIRONMENTAL & CIVIL ENGINEERING CONSULTANTS		MARION COUNTY, FLORIDA			PLOTTED: RWC-3	N/A
15290 SE HWY 42, PO BOX 152 WEIRSDALE, FLORIDA 32195					DRAWN: RWC-3	N/A
PHONE: (352) 694-1799 FAX: (866) 832-0250					DESIGNED: RWC-3	N/A
					CHECKED: RWC-3	N/A
SITE PLAN				SCALE: 1" = 100'		
P.N. 2009-						
Sht. 1 of 1						