


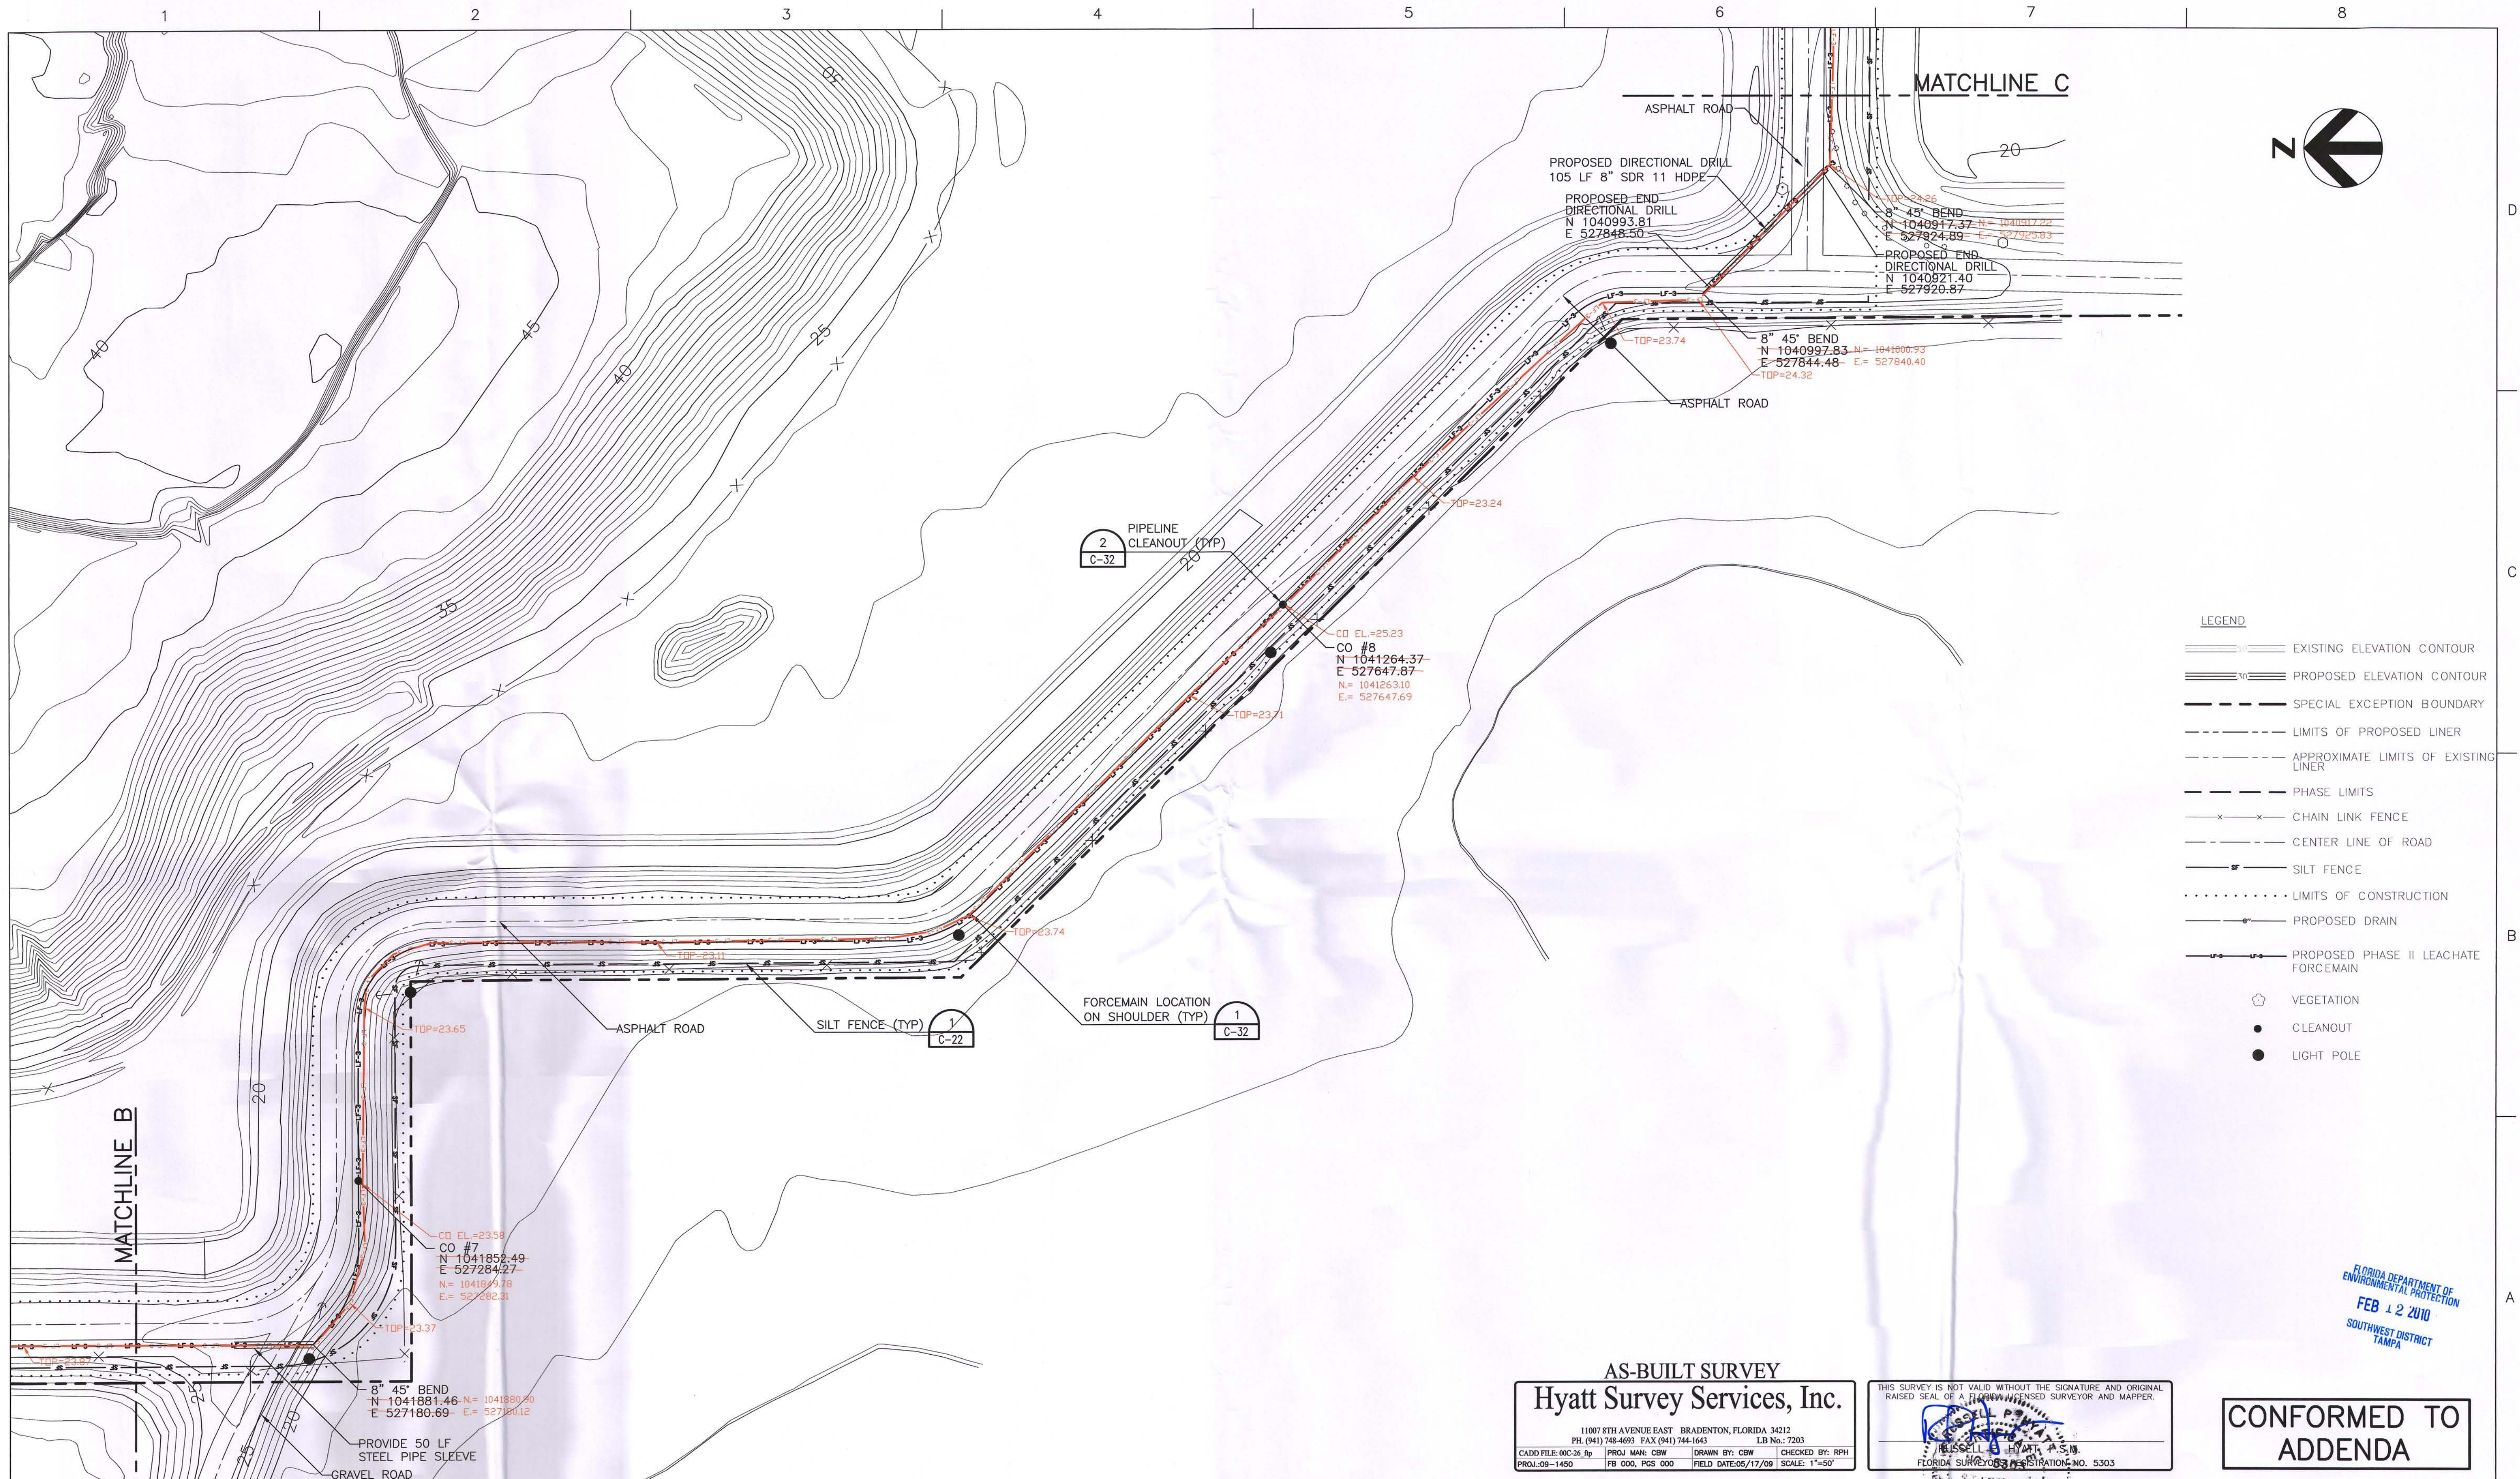

FLORIDA DEPARTMENT OF ENVIRONMENTAL PROTECTION
FEB 12 2010
SOUTHWEST DISTRICT TAMPA

AS-BUILT SURVEY
Hyatt Survey Services, Inc.
11007 9TH AVENUE EAST BRADENTON, FLORIDA 34212
PH (941) 748-4093 FAX (941) 744-1643 LB No.: 7203
CADD FILE: 00C-26.dwg PROJ MAN: CBW DRAWN BY: CBW CHECKED BY: RPH
PROJ. 00-1450 FB 000, PGS 000 FIELD DATE: 05/17/08 SCALE: 1"=50'

THIS SURVEY IS NOT VALID WITHOUT THE SIGNATURE AND ORIGINAL RAISED SEAL OF A FLORIDA LICENSED SURVEYOR AND MAPPER.
RUSSELL B. HYATT, P.S.
FLORIDA SURVEYOR REGISTRATION NO. 5303

CONFORMED TO
ADDENDA

HDR
HDR Engineering, Inc.
5426 Bay Center Drive, Suite 400
Tampa, FL 33609-3444
(813) 282-2300
Florida Certificate of Authorization
No. 00004213

ISSUE	DATE	DESCRIPTION
A	02/2009	ISSUED FOR CONSTRUCTION, CONFORMED TO ADDENDA

PROJECT MANAGER	T.M. YANOSCHAK
REVIEWED BY	J.C. READING
DRAWN BY	G.J. BLUE
PROJECT NUMBER	001916-43485-018

Thomas M. Yanoschak, P.E.
Certificate No. 44200

SARASOTA COUNTY
Central County Solid Waste Disposal Complex
PHASE II CLASS I LANDFILL EXPANSION
CONSTRUCTION DRAWINGS
FLORIDA

FORCEMAIN PLAN
0 1" 2"
FILENAME: 00C-26.dwg SHEET: **C-26**
SCALE: 1"=50'