


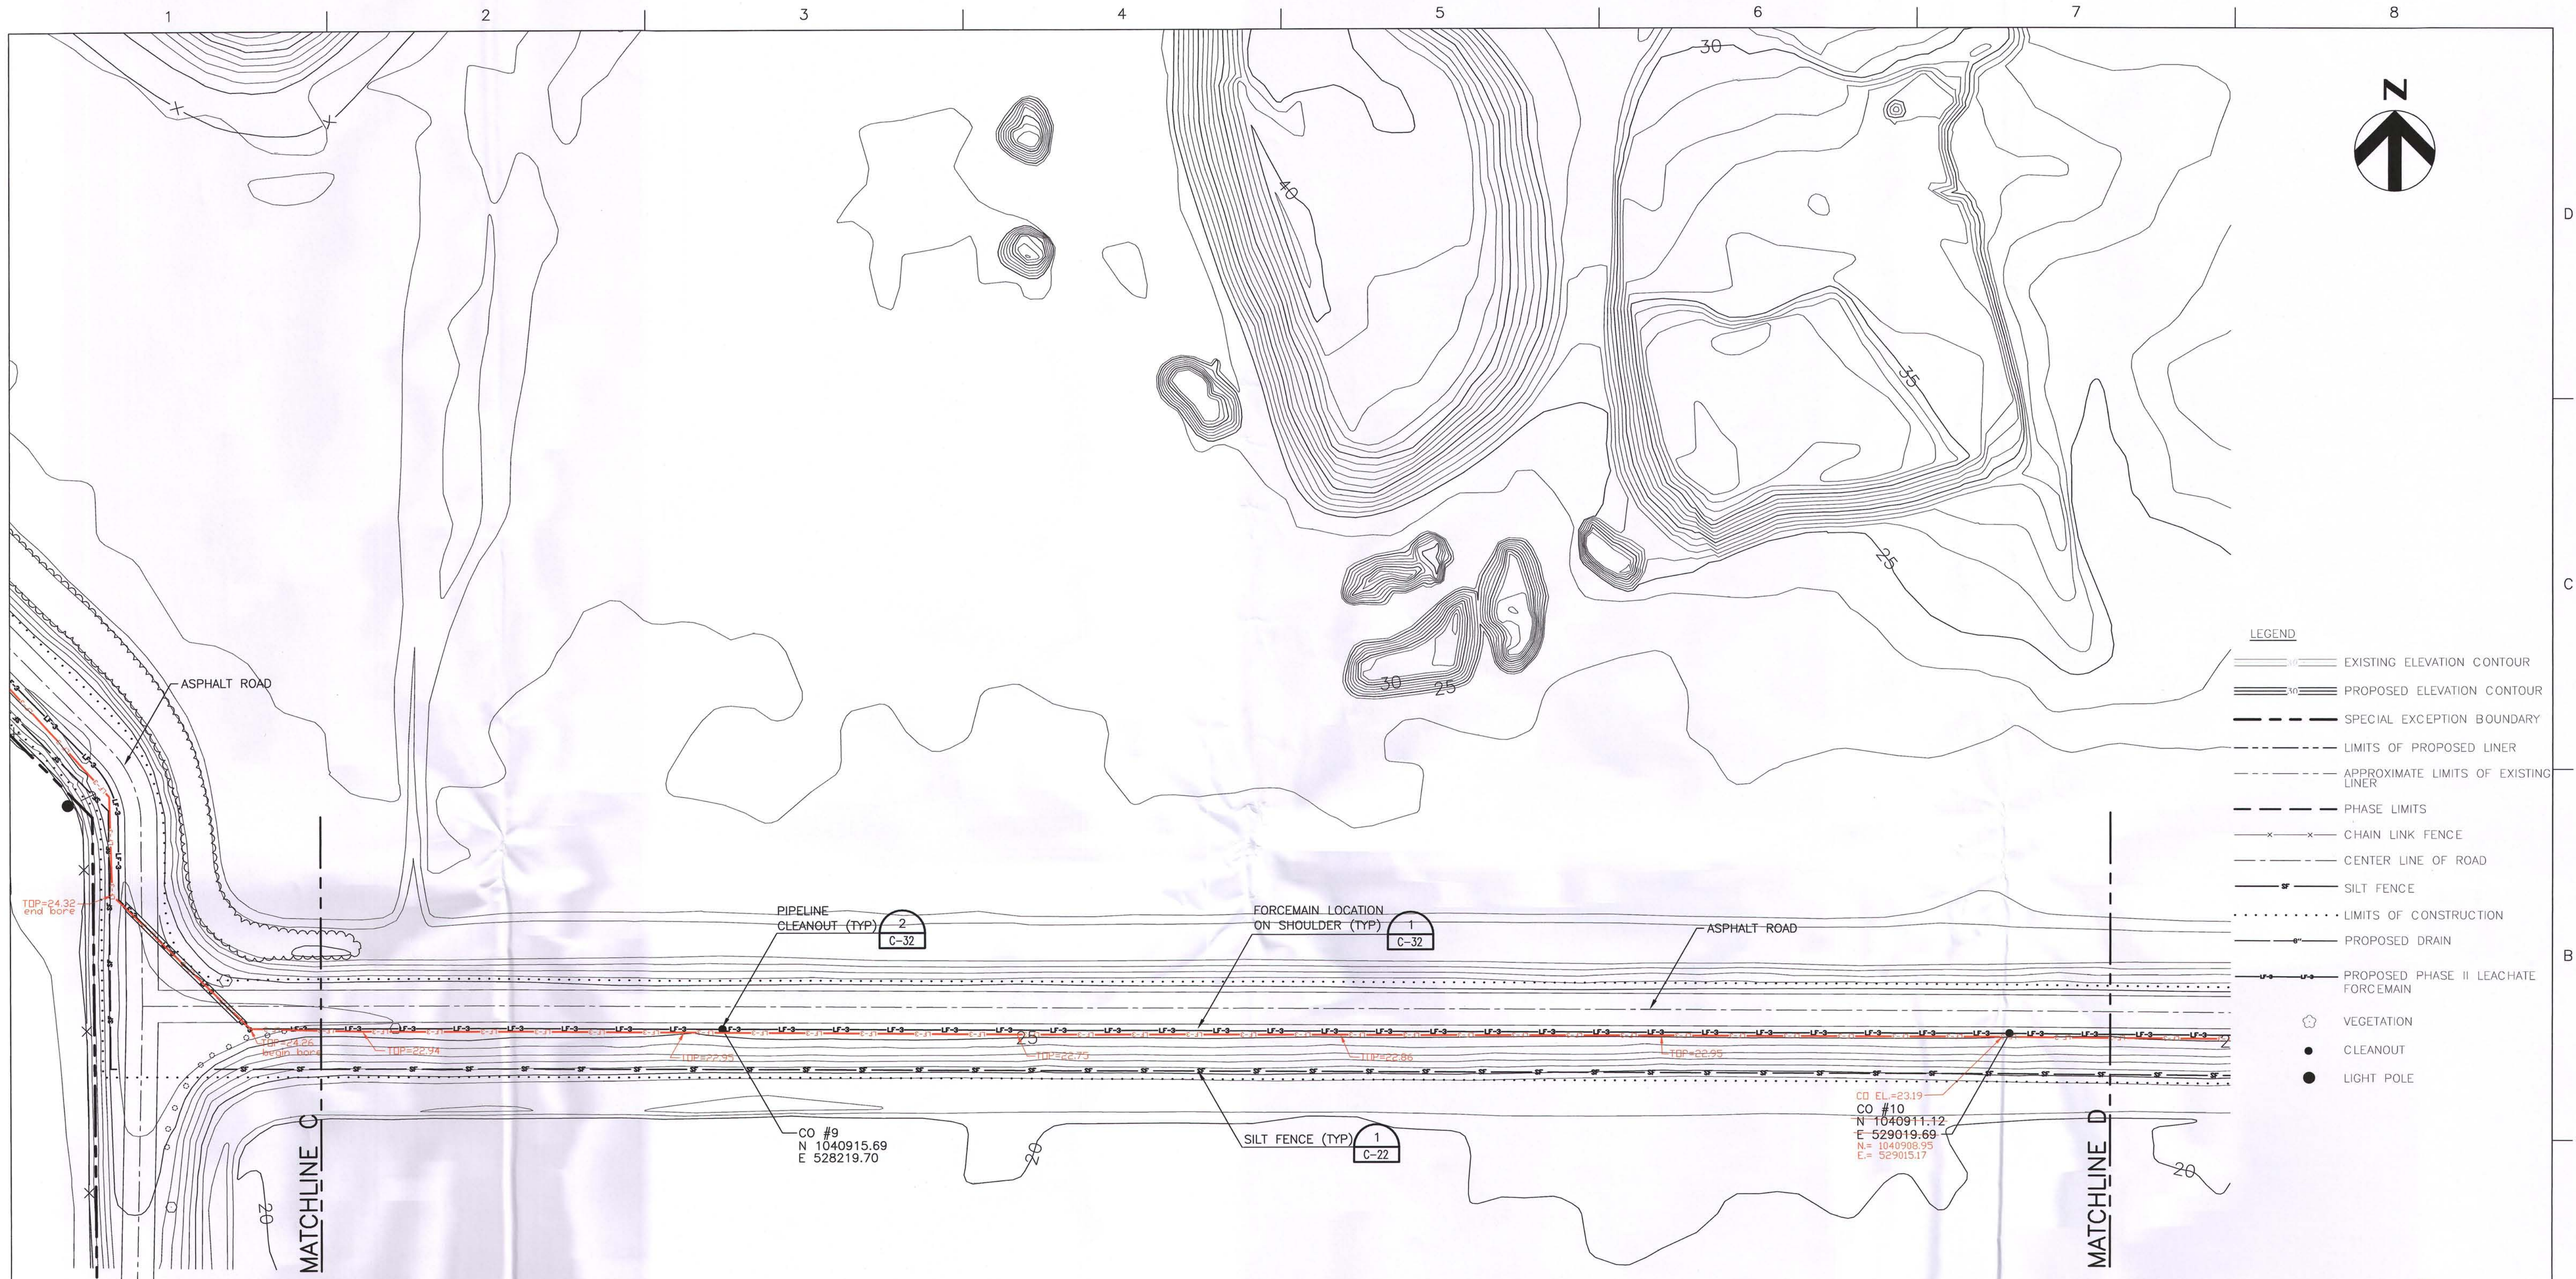

- LEGEND
- EXISTING ELEVATION CONTOUR
 - PROPOSED ELEVATION CONTOUR
 - SPECIAL EXCEPTION BOUNDARY
 - LIMITS OF PROPOSED LINER
 - APPROXIMATE LIMITS OF EXISTING LINER
 - PHASE LIMITS
 - CHAIN LINK FENCE
 - CENTER LINE OF ROAD
 - SILT FENCE
 - LIMITS OF CONSTRUCTION
 - PROPOSED DRAIN
 - PROPOSED PHASE II LEACHATE FORCEMAIN
 - VEGETATION
 - CLEANOUT
 - LIGHT POLE

AS-BUILT SURVEY
Hyatt Survey Services, Inc.
11007 8TH AVENUE EAST BRADENTON, FLORIDA 34212
PH: (941) 748-4699 FAX: (941) 744-1643 LB No.: 7203
CADD FILE: 00C-27.dwg PROJ: MAN: CRW DRAWN BY: CRW CHECKED BY: RPH
PROJ: 09-1450 FB: 000, PGS: 000 FIELD DATE: 05/17/09 SCALE: 1"=50'

THIS SURVEY IS NOT VALID WITHOUT THE SIGNATURE AND ORIGINAL RAISED SEAL OF A FLORIDA LICENSED SURVEYOR.
RUSSELL P. HYATT, P.S.M.
FLORIDA SURVEYORS REGISTRATION NO. 5303

CONFORMED TO
ADDENDA


FLORIDA DEPARTMENT OF
ENVIRONMENTAL PROTECTION
FEB 12 2010
SOUTHWEST DISTRICT
TAMPA

HDR
HDR Engineering, Inc.
5426 Bay Center Drive, Suite 400
Tampa, FL 33609-3444
(813) 282-2300
Florida Certificate of Authorization
No. 00004213

ISSUE	DATE	DESCRIPTION
A	02/2009	ISSUED FOR CONSTRUCTION, CONFORMED TO ADDENDA

PROJECT MANAGER	T.M. YANOSCHAK
REVIEWED BY	J.C. READLING
DRAWN BY	G.J. BLUE
PROJECT NUMBER	001916-43485-018

Thomas M. Yanoschak, P.E.
Certificate No. 44200

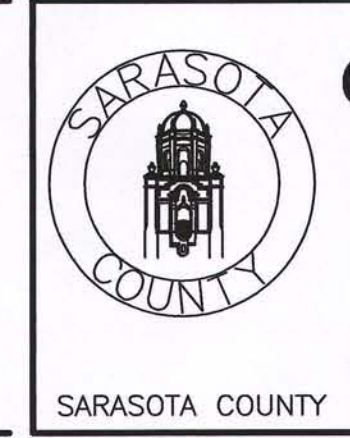

**Central County Solid Waste
Disposal Complex
PHASE II CLASS I LANDFILL
EXPANSION
CONSTRUCTION DRAWINGS**
FLORIDA

FORCEMAIN PLAN		SHEET
FILENAME	00C-27.dwg	C-27
SCALE	1"=50'	