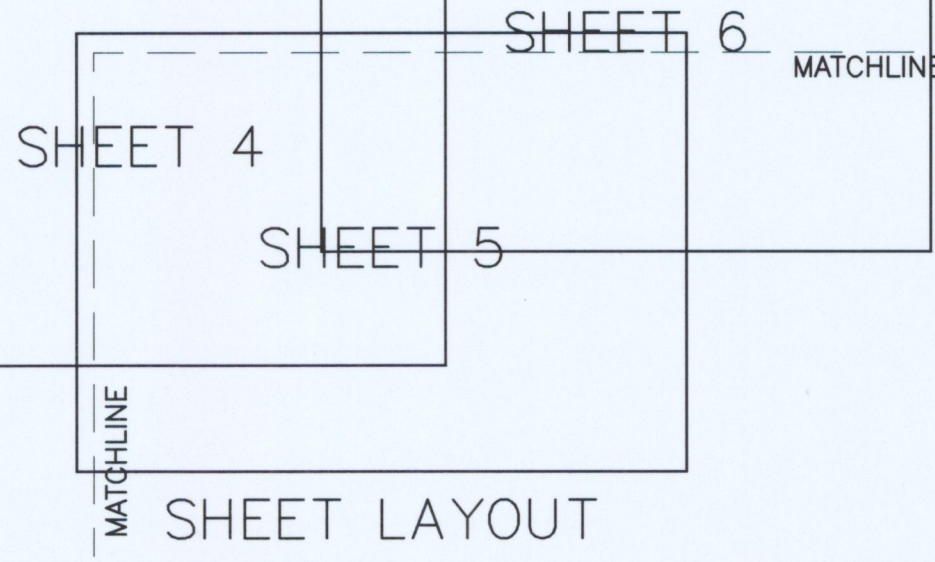


SURVEY SOURCE NOTES:

1. TOPOGRAPHIC SURVEY INFORMATION SHOWN WAS DEVELOPED BY PICKETT & ASSOCIATES, INC., 475 SOUTH FIRST AVENUE, BARTOW, FL 33830. AERIAL PHOTO DATE: 01/14/08.

2. AS-BUILT INFORMATION BASED ON SURVEY PROVIDED BY SOUTHEASTERN SURVEYING, INC., DATED 12/16/09.

RECORD DRAWING
DATE: APRIL 15, 2010

- LEGEND**
- HC-1A HORIZONTAL COLLECTOR VERTICAL BORING
 - EW-10 LFG EXTRACTION WELL
 - EW-46 DOWNSLOPE LFG EXTRACTION WELL
 - EW-88 CAISSON LFG EXTRACTION WELL
 - EW-12R REMOTE WELLHEAD LOCATION
 - UT-2 SLOPED CONDENSATE U-TRAP
 - CS-1 CONDENSATE SUMP WITH PUMP
 - CT-5 SELF-DRAINING CONDENSATE TRAP
 - HC-18R UPSLOPE HORIZONTAL COLLECTOR WELLHEAD
 - V-2 HEADER ISOLATION VALVE
 - AR-24 HEADER ACCESS RISER
 - BF BLIND FLANGE FOR FUTURE EXPANSION
 - AV-2 AIR ISOLATION VALVE/BLOWOFF
 - CV-3 DEWATERING DRAIN LINE ISOLATION VALVE
 - HP HIGH POINT
 - HP Lateral Pipe
 - AS Air Supply Line
 - CDW Condensate Drain Line/Leachate Dewatering Line
 - RC Road Crossing
 - ELC Existing Leachate Collection System Cleanout
 - PS Existing Pump Station
 - AGF Abandoned Passive Gas Flare
 - FL Limit of Landfill
 - EFM Existing Leachate Force Main
 - PL Phase Limit
 - HPCP Horizontal Collector Perforated Pipe
 - ALL Approximate Limit of Lift 12
 - EIFM Existing Irrigation Force Main
 - CDW Direction of Condensate/Dewatering Liquid Flow
 - LFG Direction of Landfill Gas Flow

BY	DESCRIPTION	DATE	REV
DR	WELL SCHEDULE UPDATED PER FIELD CONDITIONS	5/8/09	1
DR	REVISED FOR THE RECORD	4/15/10	2

OVERALL SITE PLAN

PROJECT TITLE

**SOUTHEAST COUNTY LANDFILL
LANDFILL GAS COLLECTION
AND CONTROL SYSTEM PROJECT**

CLIENT

**HILLSBOROUGH COUNTY
SOLID WASTE
MANAGEMENT DEPARTMENT
TAMPA, FLORIDA**

SCS ENGINEERS
STEARNS, CONRAD AND SCHMIDT
CONSULTING ENGINEERS
4041 PARK OAKS BLVD., SUITE 100, TAMPA, FL 33610
813 881-0080 FAX 813 882-9157
FLORIDA CERTIFICATE OF AUTHORIZATION NO. 0000882

PROJ. NO.	DWN. BY	CHK. BY	APP. BY	R.D.
09207055.00	DAW/CTN	DR	DR	

CADD FILE:

075500PROP

DATE:

OCTOBER 8, 2008

SCALE:

AS SHOWN

DRAWING NO.

3 of 30