


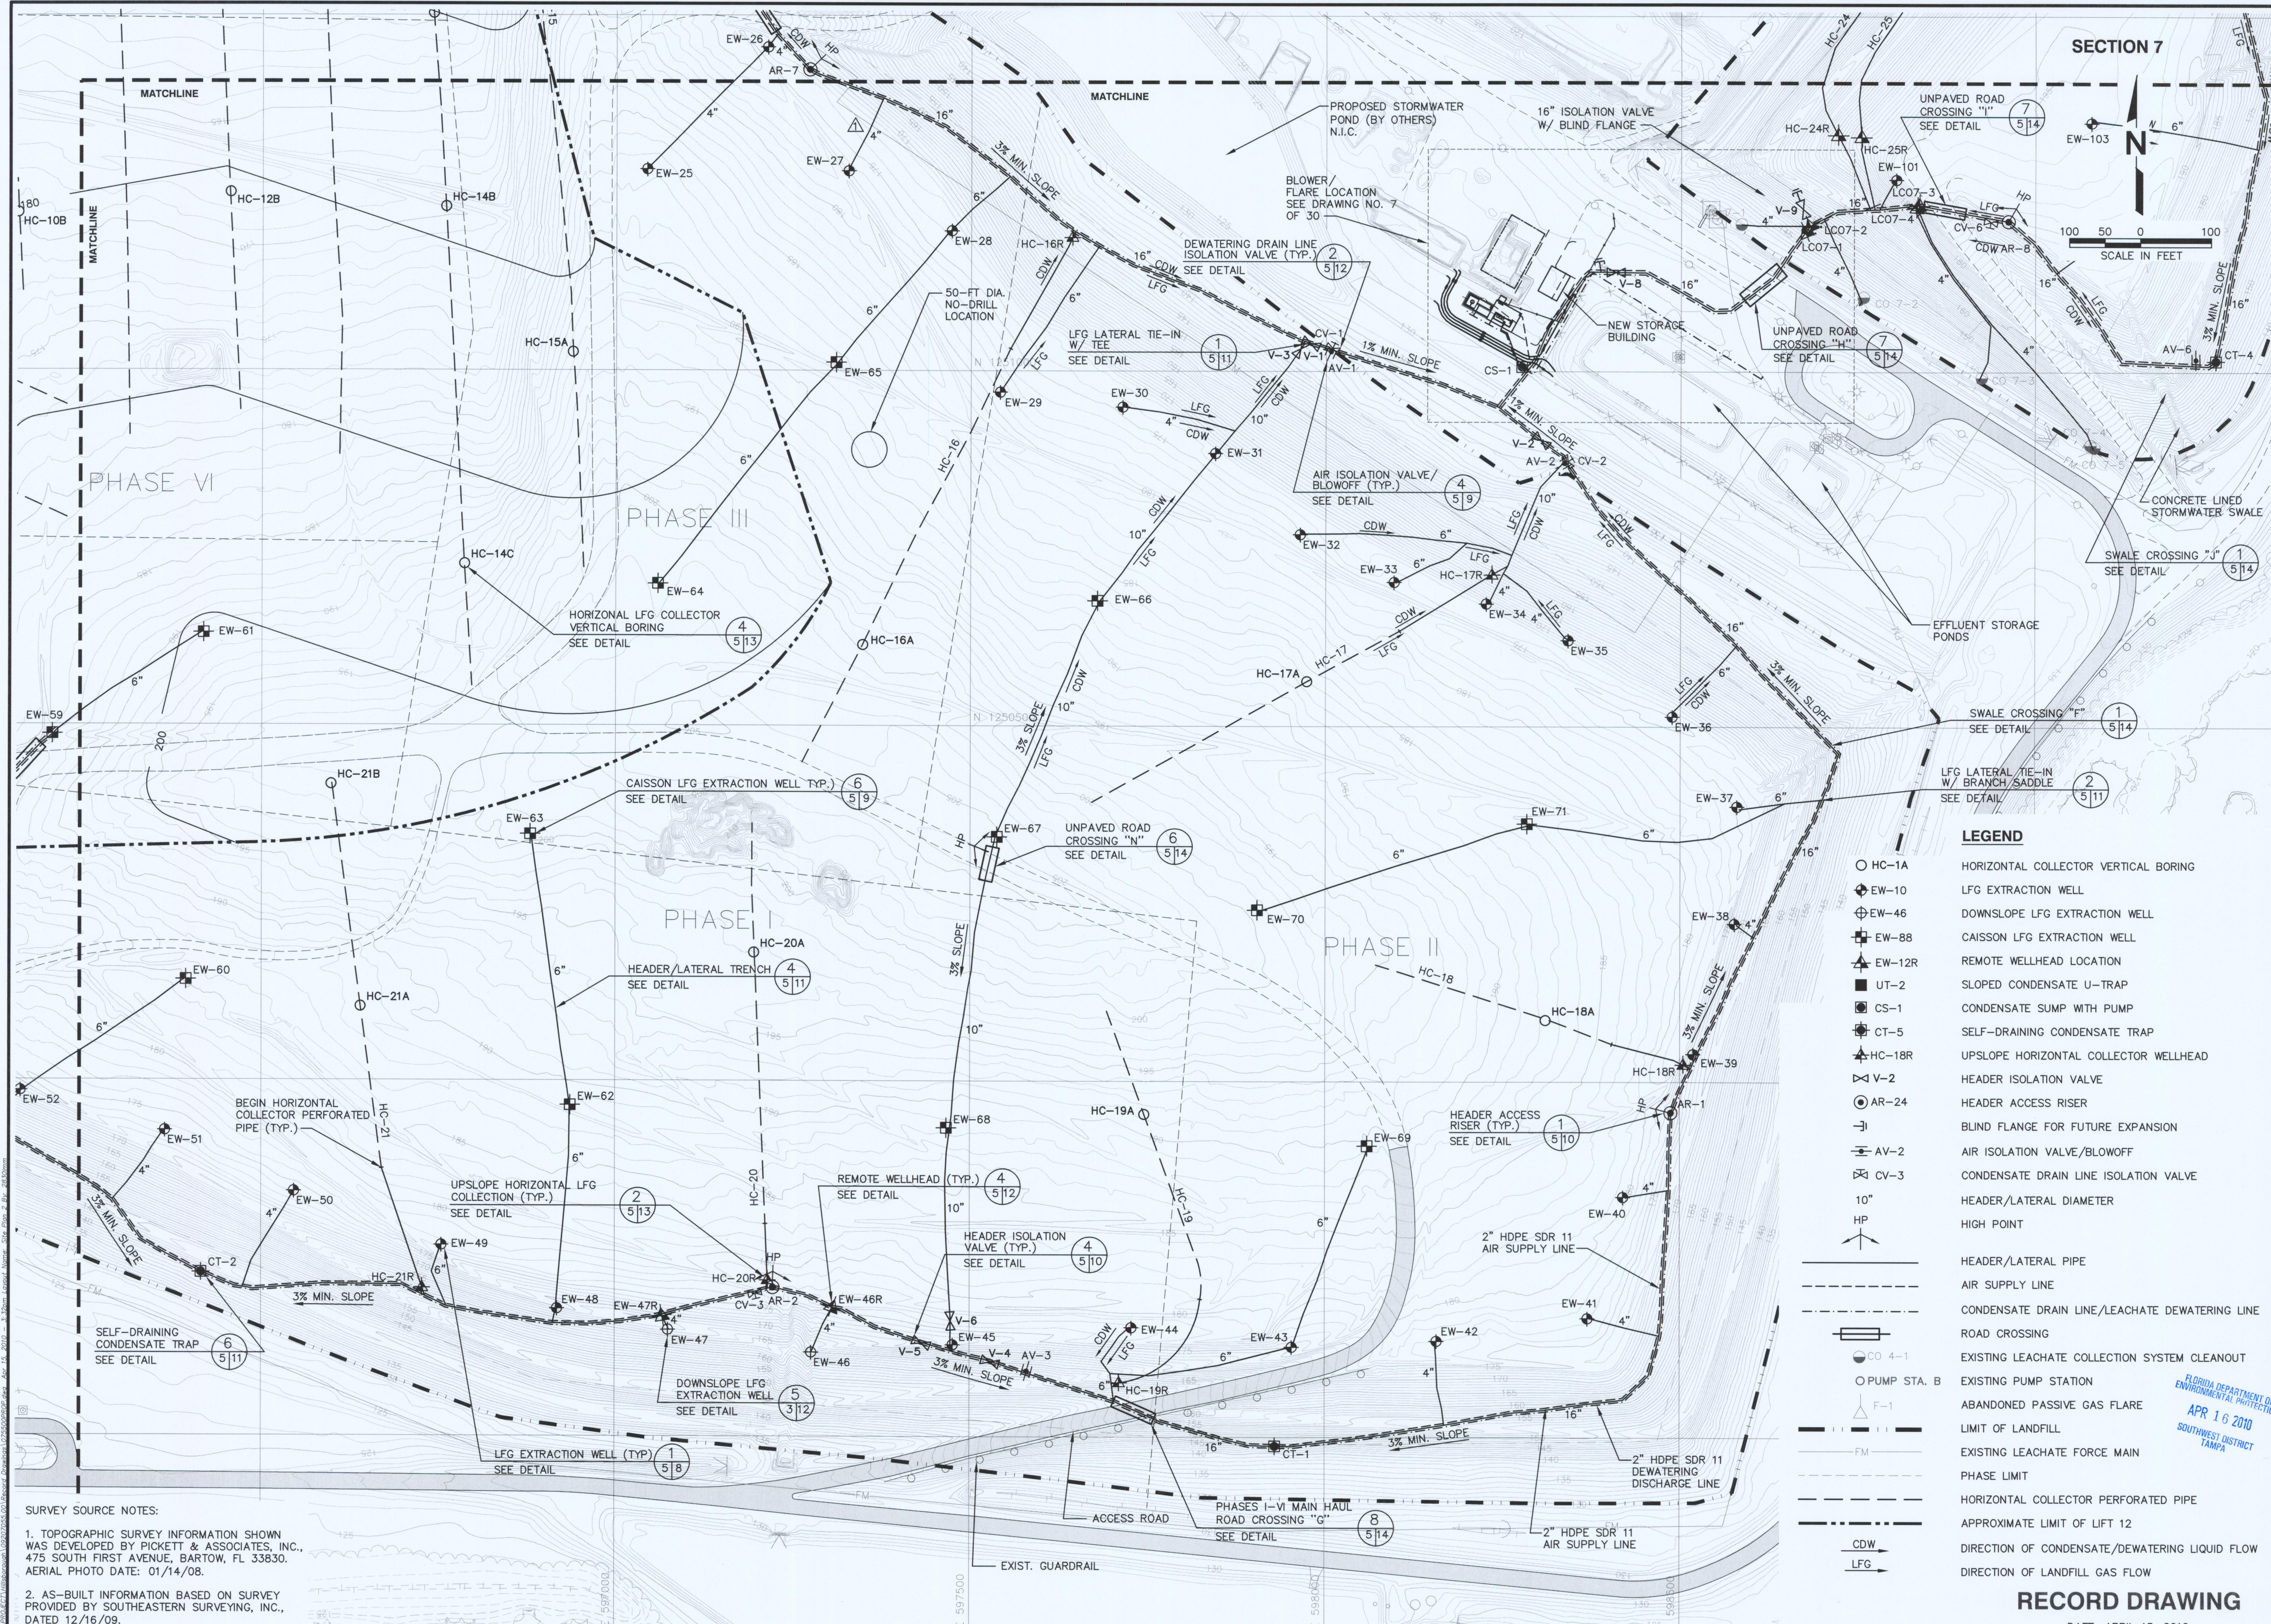

SURVEY SOURCE NOTES:

1. TOPOGRAPHIC SURVEY INFORMATION SHOWN WAS DEVELOPED BY PICKETT & ASSOCIATES, INC., 475 SOUTH FIRST AVENUE, BARTOW, FL 33830. AERIAL PHOTO DATE: 01/14/08.

2. AS-BUILT INFORMATION BASED ON SURVEY PROVIDED BY SOUTHEASTERN SURVEYING, INC., DATED 12/16/09.

- LEGEND**
- HC-1A HORIZONTAL COLLECTOR VERTICAL BORING
 - ⊕ EW-10 LFG EXTRACTION WELL
 - ⊕ EW-46 DOWNSLOPE LFG EXTRACTION WELL
 - ⊕ EW-88 CAISSON LFG EXTRACTION WELL
 - ⊕ EW-12R REMOTE WELLHEAD LOCATION
 - ⊕ UT-2 SLOPED CONDENSATE U-TRAP
 - ⊕ CS-1 CONDENSATE SUMP WITH PUMP
 - ⊕ CT-5 SELF-DRAINING CONDENSATE TRAP
 - ⊕ HC-18R UPSLOPE HORIZONTAL COLLECTOR WELLHEAD
 - ⊕ V-2 HEADER ISOLATION VALVE
 - ⊕ AR-24 HEADER ACCESS RISER
 - ⊕ AV-2 BLIND FLANGE FOR FUTURE EXPANSION
 - ⊕ CV-3 AIR ISOLATION VALVE/BLOWOFF
 - 10" HEADER/LATERAL DIAMETER
 - HP HIGH POINT
 - HEADER/LATERAL PIPE
 - AIR SUPPLY LINE
 - CONDENSATE DRAIN LINE/LEACHATE DEWATERING LINE
 - ROAD CROSSING
 - EXISTING LEACHATE COLLECTION SYSTEM CLEANOUT
 - PUMP STA. B EXISTING PUMP STATION
 - △ F-1 ABANDONED PASSIVE GAS FLARE
 - LIMIT OF LANDFILL
 - EXISTING LEACHATE FORCE MAIN
 - PHASE LIMIT
 - HORIZONTAL COLLECTOR PERFORATED PIPE
 - APPROXIMATE LIMIT OF LIFT 12
 - CDW DIRECTION OF CONDENSATE/DEWATERING LIQUID FLOW
 - LFG DIRECTION OF LANDFILL GAS FLOW

RECORD DRAWING
DATE: APRIL 15, 2010

BY	DESCRIPTION
DRC	WELL SCHEDULE UPDATED PER FIELD CONDITIONS
DRC	REVISED FOR THE RECORD
REV	DATE
Δ	5/8/09
Δ	4/15/10
Δ	
DRAWING TITLE	
SITE PLAN - 2	
PROJECT TITLE	
SOUTHEAST COUNTY LANDFILL LANDFILL GAS COLLECTION AND CONTROL SYSTEM PROJECT	
CLIENT	
HILLSBOROUGH COUNTY SOLID WASTE MANAGEMENT DEPARTMENT TAMPA, FLORIDA	
CADD FILE:	
075500PROP	
DATE:	
OCTOBER 8, 2008	
SCALE:	
AS SHOWN	
DRAWING NO.	
5 of 30	