

DRAWN BY: MAM/JC DATE: 03/20/09
CHKD BY: JH DATE:
JOB # 29005


NO.	DATE
1	12/01/09
2	01/04/10
3	01/22/10
4	02/09/10
5	03/23/10

QED-SYNTHETICS, LLC
2401 FARMER ROAD
MARIETTA, GA 30067
770-244-7979

PROJECT NAME & LOCATION
PHASE 2 CELL CONSTRUCTION
SARASOTA COUNTY LANDFILL
SARASOTA, FL

MATERIAL & SHADING DESCRIPTION
CELLS 1 THROUGH 4 SECONDARY
LANDFILL TYPING
60 MIL THICK HDPE GEOMEMBRANE
RECORD DRAWING

FILENAME
29005
SARASOTA
PHASE 2
DRAWING #
RD-5

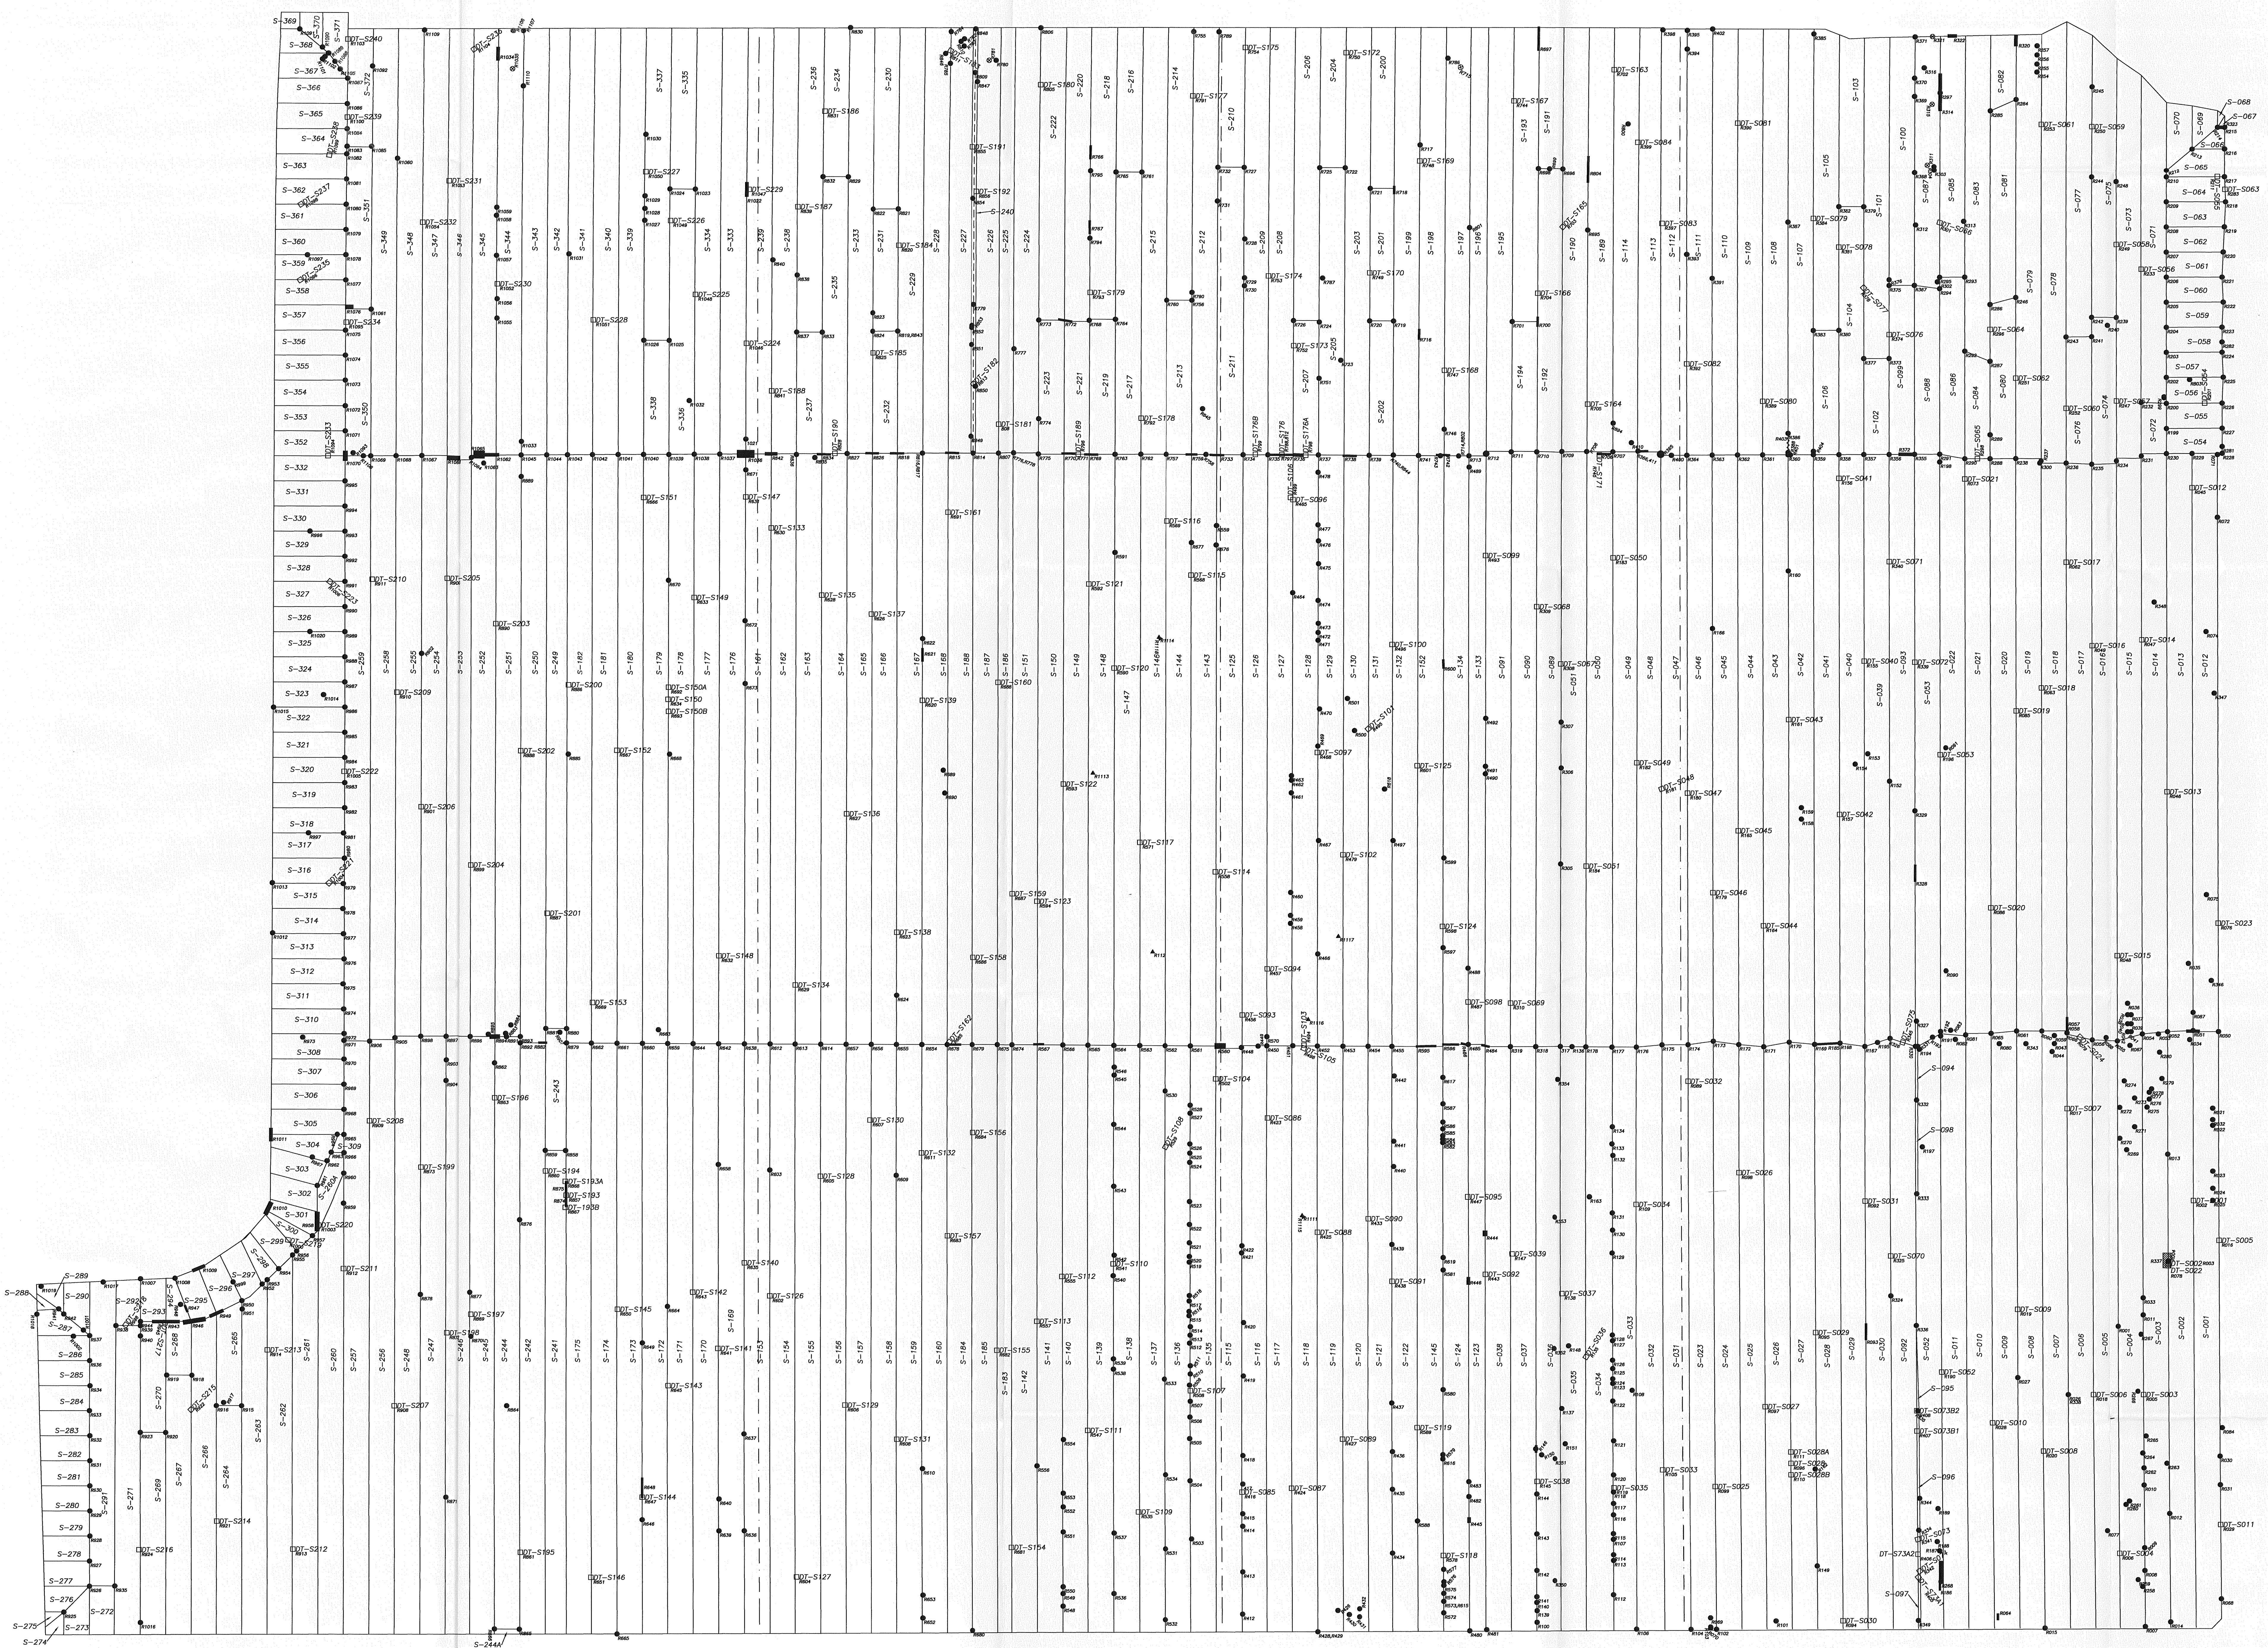

LEGEND

- CELL OUTLINE
- PANEL OUTLINE
- REPAIR NUMBER
- PATCH
- GAS VENT
- DESTRUCTIVE TEST
- PIPE BOOT
- CAP PATCH
- EXTRUSION WELD

SCALE
0 25 50