



NOTE:
1. THIS DETAIL APPLICABLE TO NORTHERN PART OF CELL WHERE TOP OF PROTECTIVE COVER EL < 29.

CELL DIVIDER BERM (TOP EL 33.0)
NOT TO SCALE

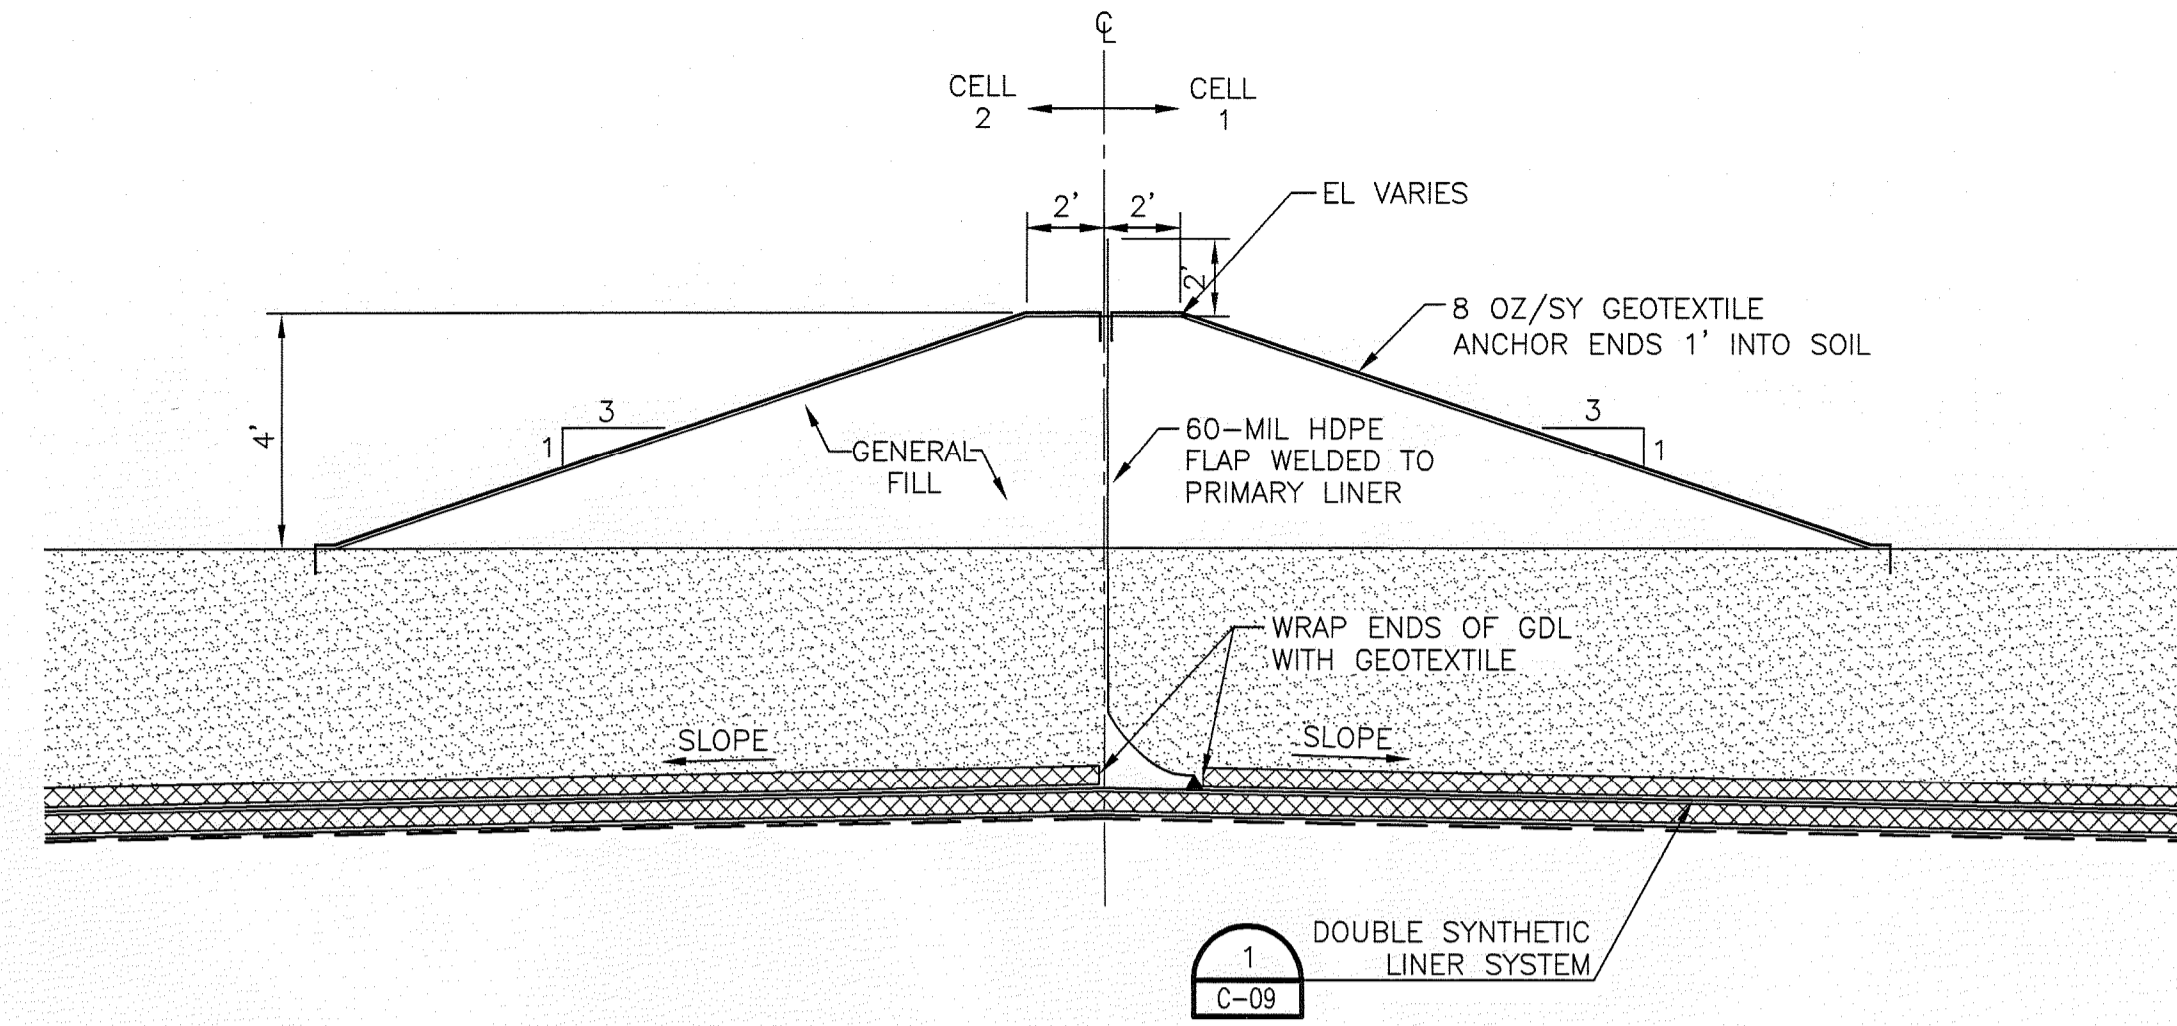


NOTE:
1. THIS DETAIL APPLICABLE TO SOUTHERN PART OF CELL WHERE TOP OF PROTECTIVE COVER EL > 29.

CELL DIVIDER BERM (TOP EL > 33.0)
NOT TO SCALE

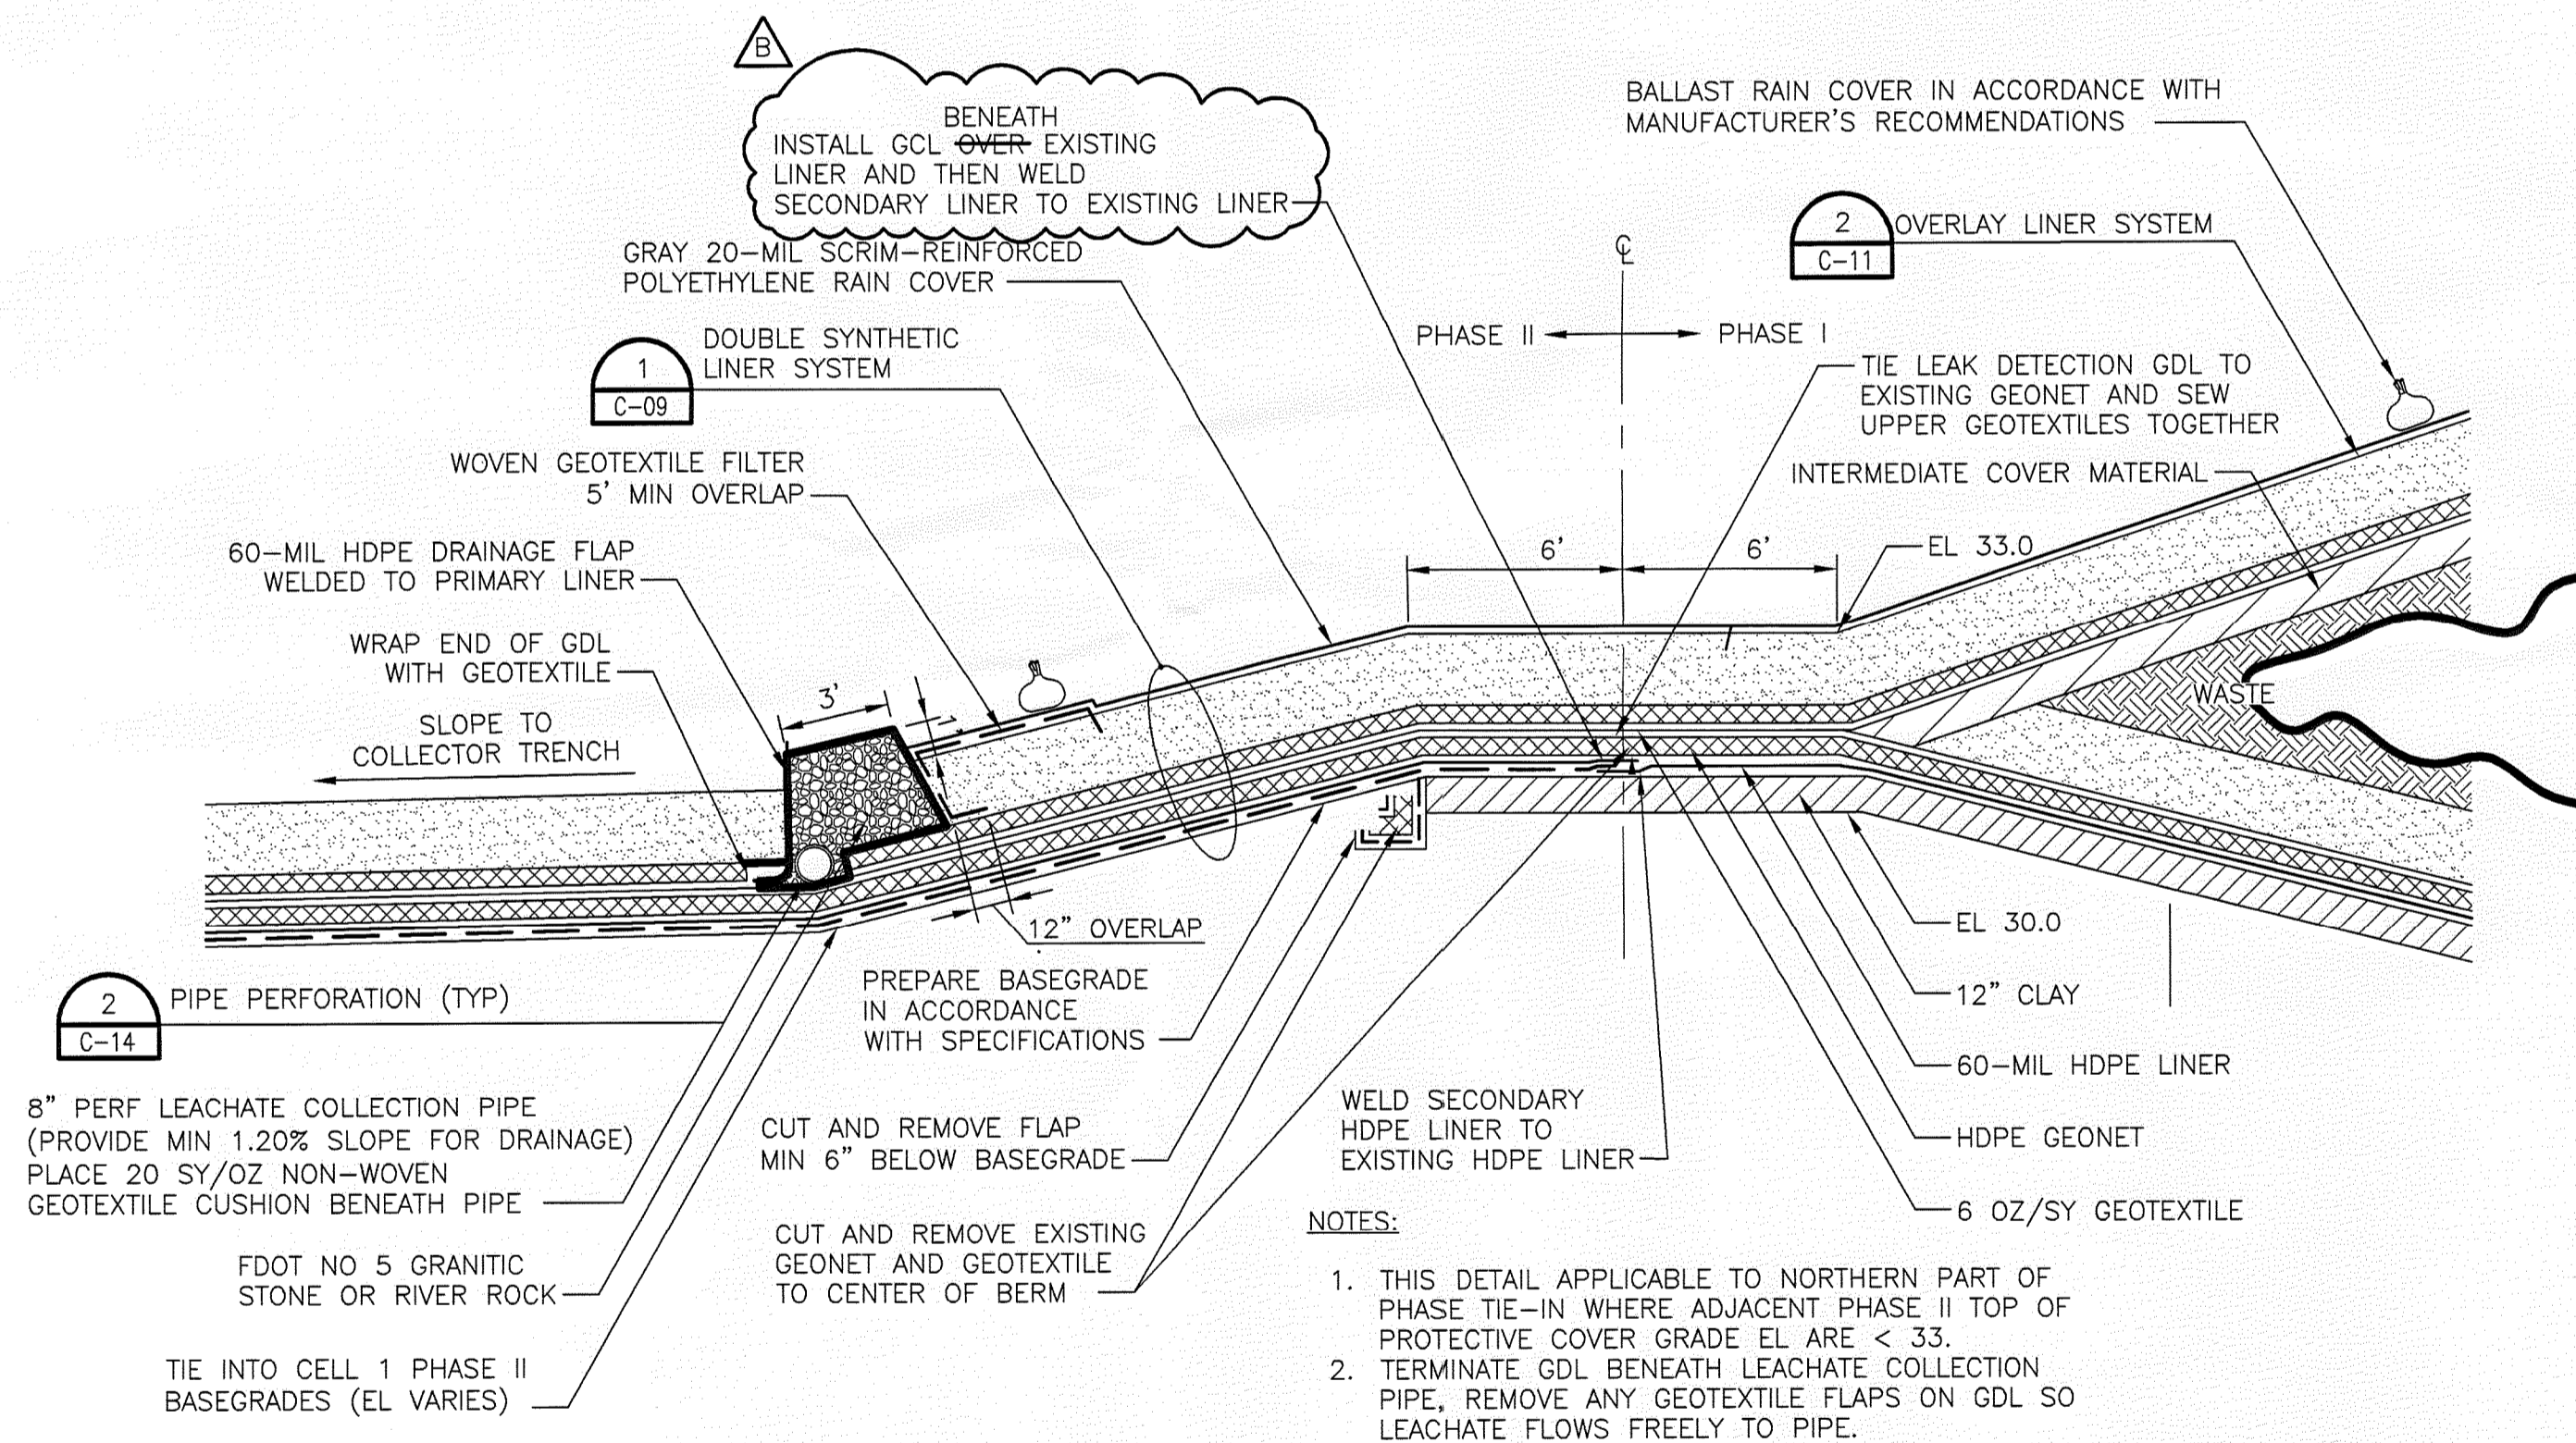

NOTES:
1. THIS DETAIL APPLICABLE TO NORTHERN PART OF PHASE TIE-IN WHERE ADJACENT PHASE II TOP OF PROTECTIVE COVER GRADE EL ARE < 33.
2. TERMINATE GDL BENEATH LEACHATE COLLECTION PIPE, REMOVE ANY GEOTEXTILE FLAPS ON GDL SO LEACHATE FLOWS FREELY TO PIPE.

PHASE I/PHASE II LINER TIE-IN (NORTH)
NOT TO SCALE

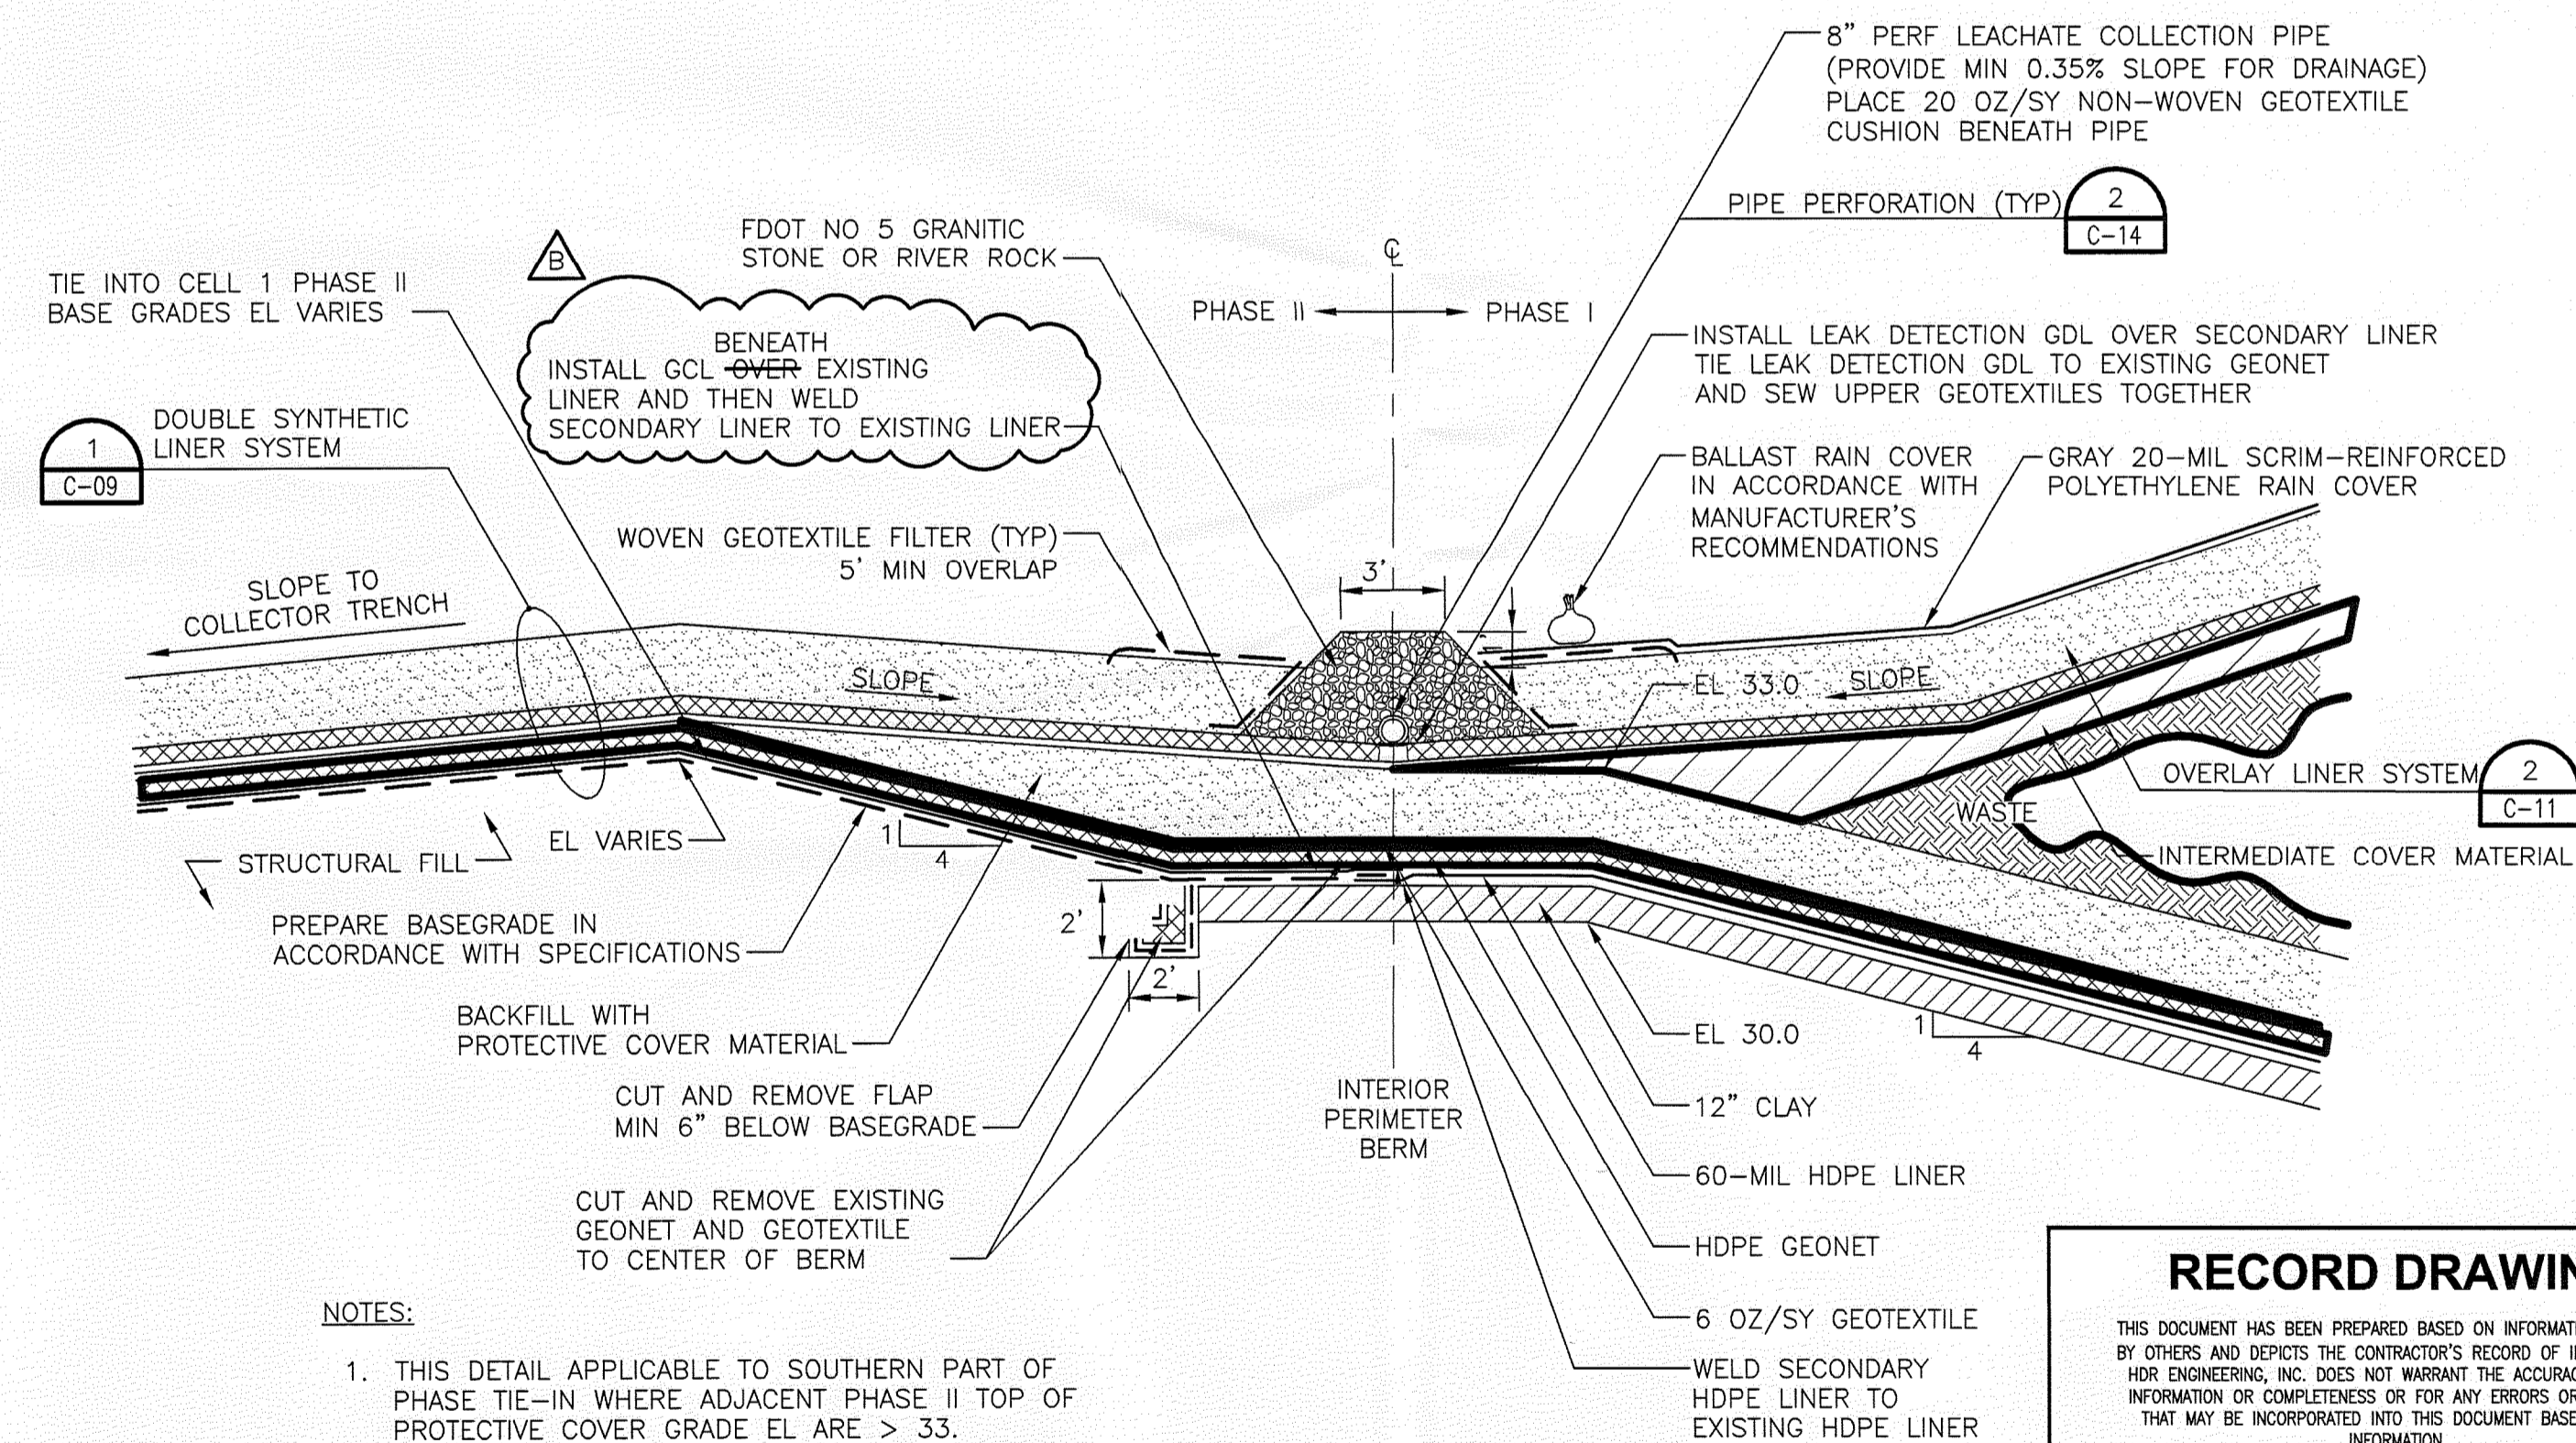

NOTES:
1. THIS DETAIL APPLICABLE TO SOUTHERN PART OF PHASE TIE-IN WHERE ADJACENT PHASE II TOP OF PROTECTIVE COVER GRADE EL ARE > 33.
2. TERMINATE GDL BENEATH LEACHATE COLLECTION PIPE, REMOVE ANY GEOTEXTILE FLAPS ON GDL SO LEACHATE FLOWS FREELY TO PIPE.

PHASE I/PHASE II LINER TIE-IN (SOUTH)
NOT TO SCALE

RECORD DRAWING
THIS DOCUMENT HAS BEEN PREPARED BASED ON INFORMATION PROVIDED BY OTHERS AND DEPOSITS THE CONTRACTOR'S RECORD OF INSTALLATIONS. HDR ENGINEERING, INC. DOES NOT WARRANT THE ACCURACY OF SUCH INFORMATION OR COMPLETENESS OR FOR ANY ERRORS OR OMISSIONS THAT MAY BE INCORPORATED INTO THIS DOCUMENT BASED ON THE INFORMATION.
THOMAS M. YANOSCHAK, P.E. No. 44200 Date 3/31/10
HDR ENGINEERING, INC.

RECORD DRAWING

HDR
HDR Engineering, Inc.
5426 Bay Center Drive, Suite 400
Tampa, FL 33609-3444
(813) 282-2300
Florida Certificate of Authorization
No. 00004213

ISSUE	DATE	DESCRIPTION
B	03/2010	RECORD DRAWING
A	02/2009	ISSUED FOR CONSTRUCTION, CONFORMED TO ADDENDA

PROJECT MANAGER	T.M. YANOSCHAK
REVIEWED BY	J.C. READING
DRAWN BY	L.E. PATTERSON
PROJECT NUMBER	001916-43485-018

THOMAS M. YANOSCHAK
LICENSE
No. 44200
FLORIDA
PROFESSIONAL ENGINEER
3/31/10
Thomas M. Yanoschak, P.E.
Certificate No. 44200

SARASOTA COUNTY
FLORIDA

Central County Solid Waste Disposal Complex
PHASE II CLASS I LANDFILL EXPANSION
CONSTRUCTION DRAWINGS

LINER AND BERM DETAILS
FLORIDA DEPARTMENT OF ENVIRONMENTAL PROTECTION
APR 13 2010
SOUTHWEST DISTRICT TAMPA
SHEET
C-10
FILENAME: OOC-10.dwg
SCALE: AS SHOWN