




TEMPORARY LINER TERMINATION
NOT TO SCALE

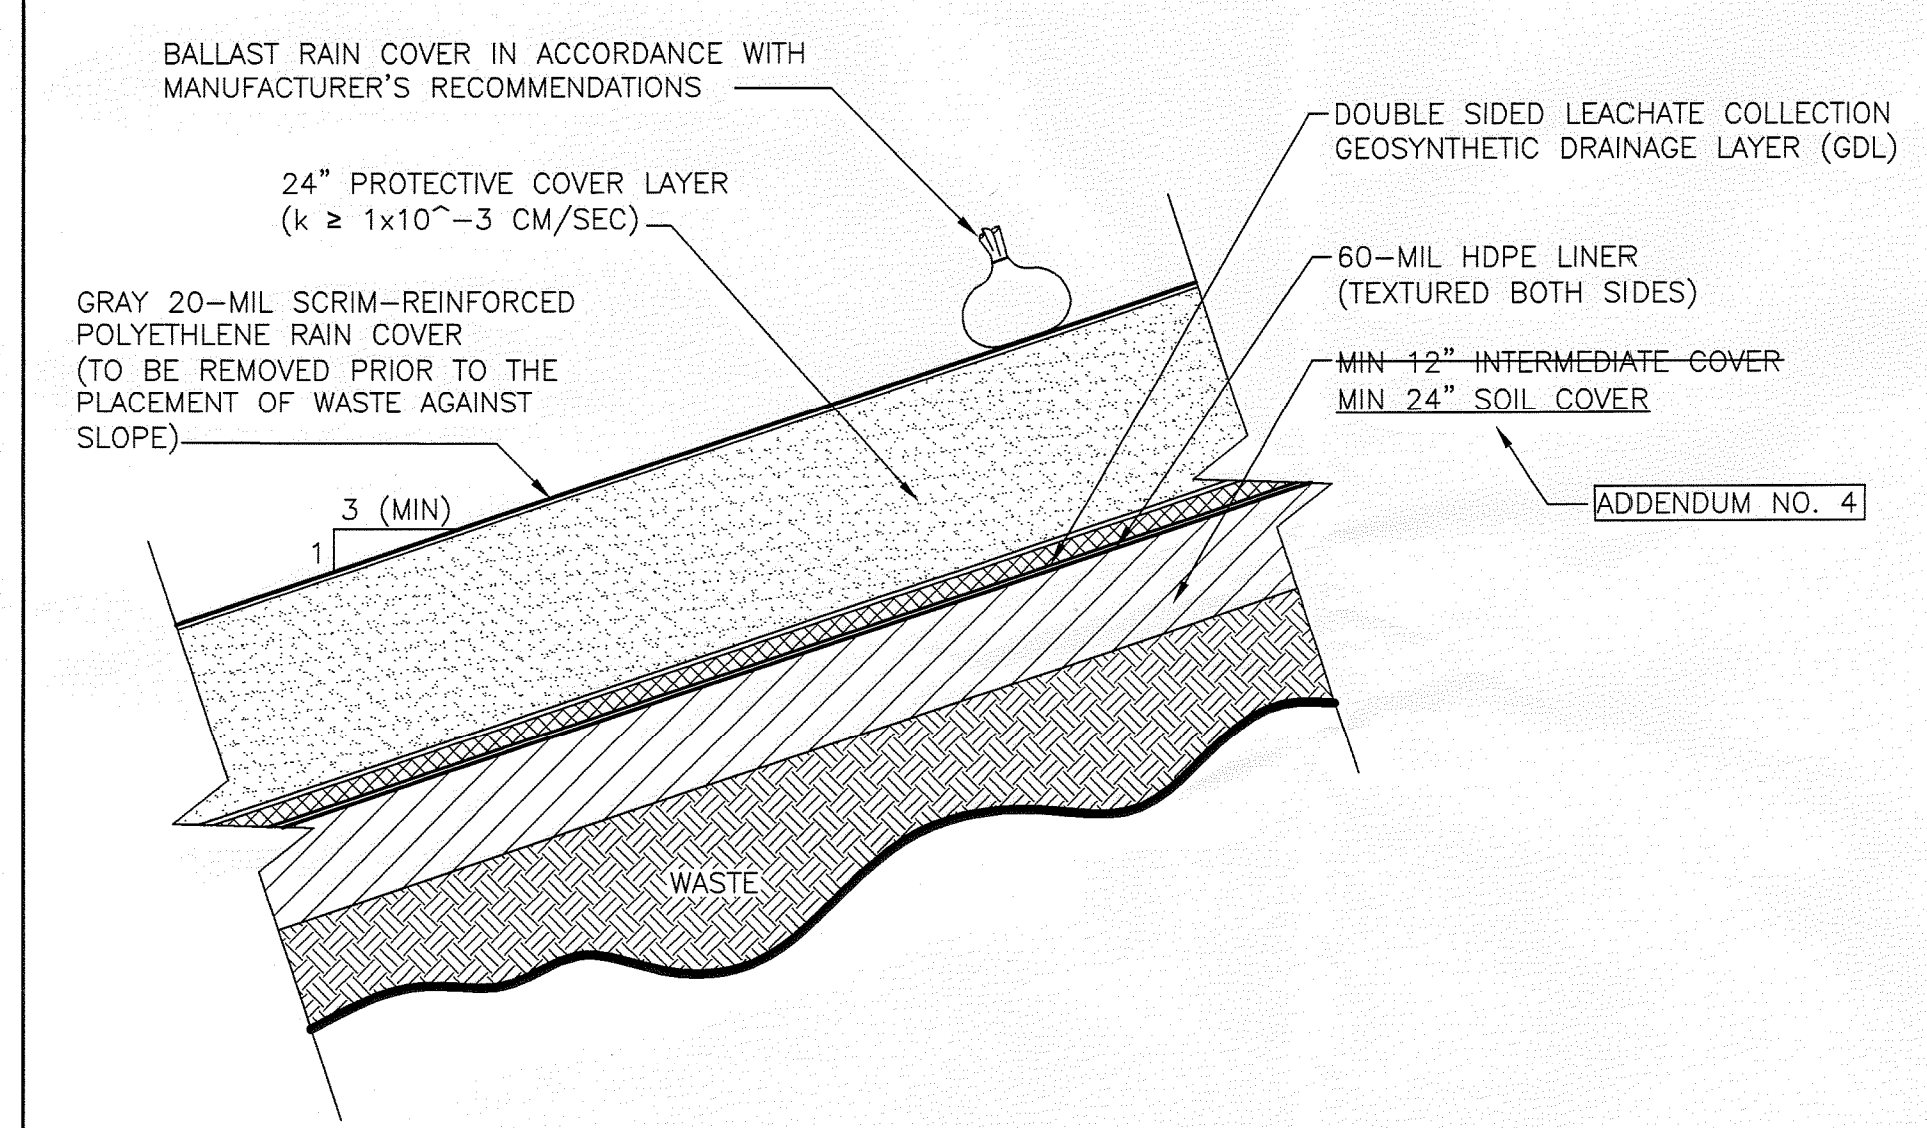

OVERLAY LINER SYSTEM
NOT TO SCALE

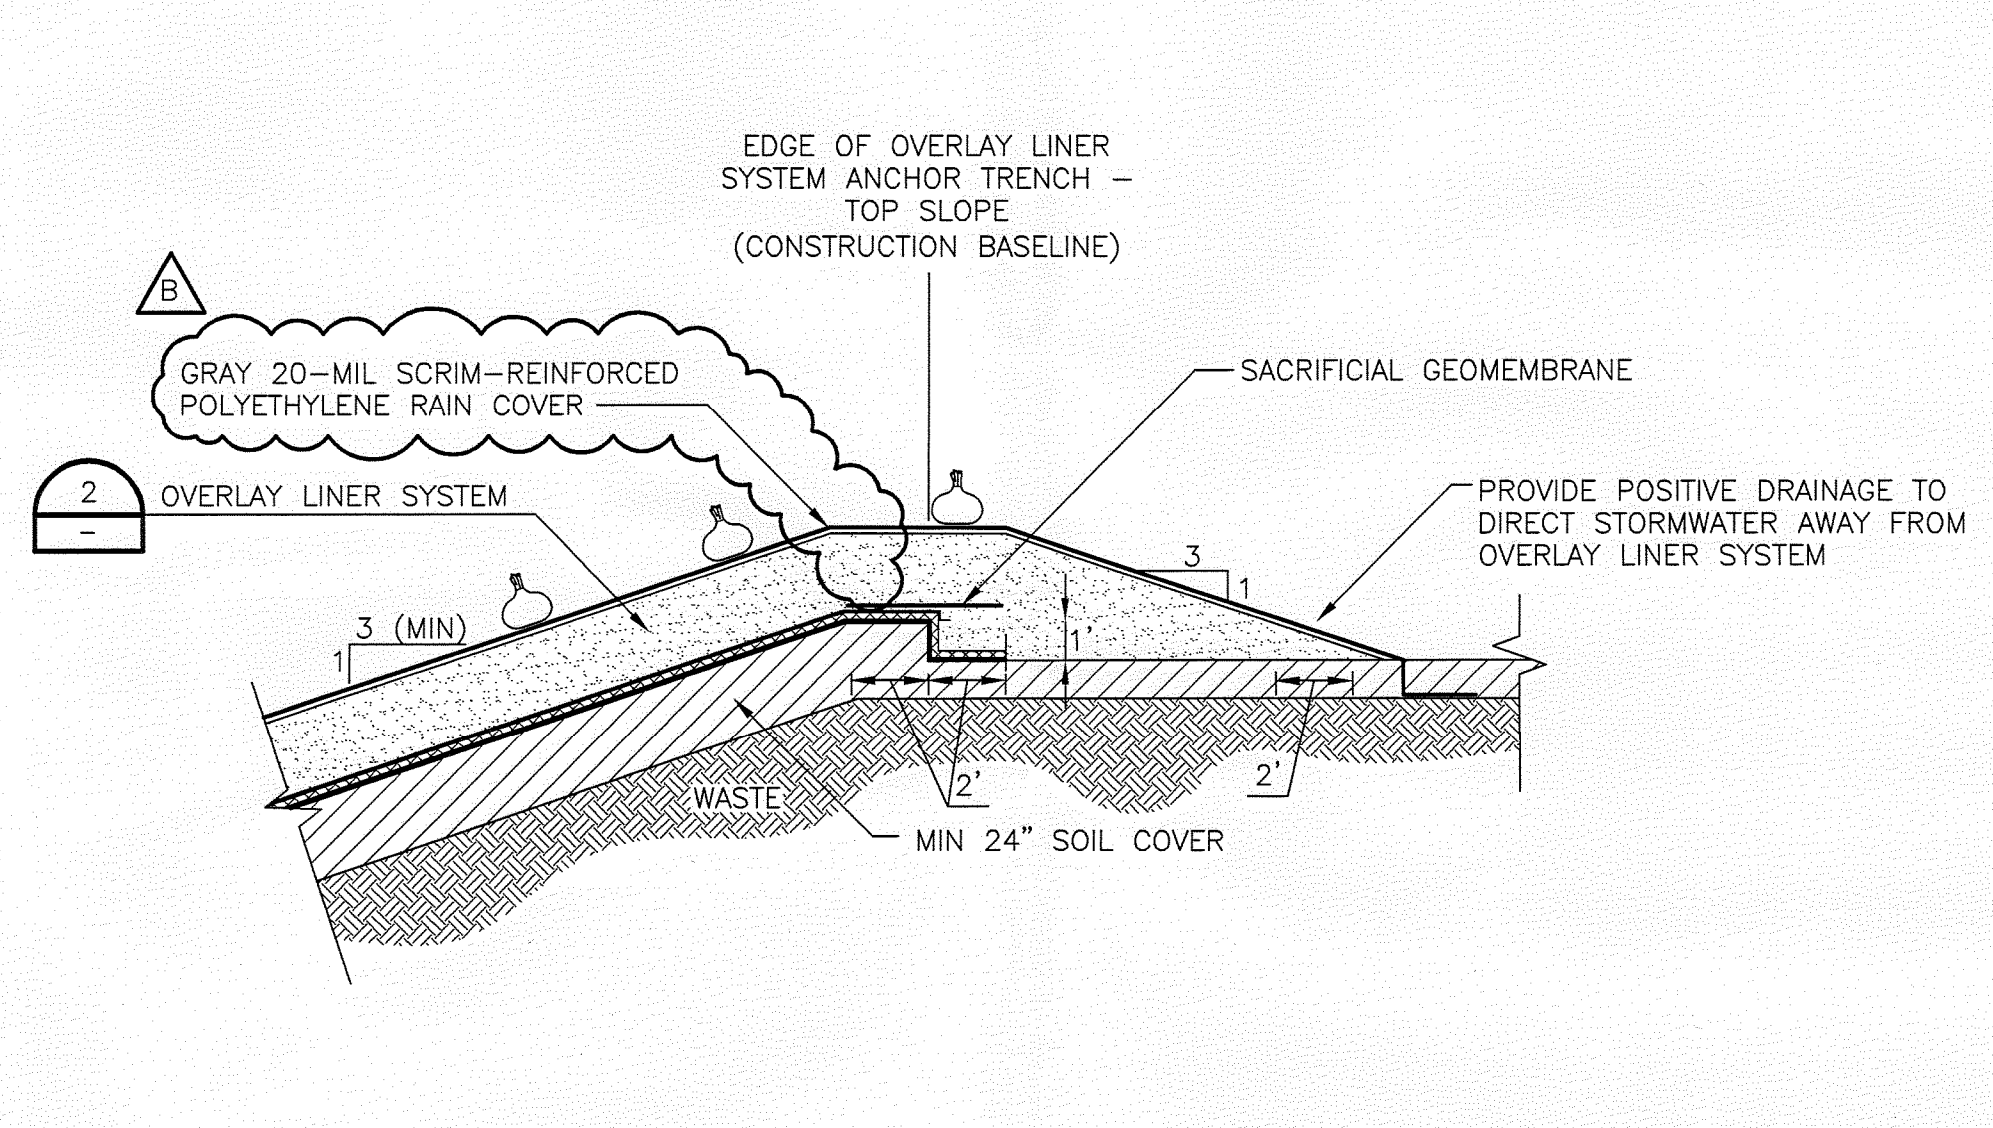

OVERLAY LINER SYSTEM ANCHOR TRENCH - TOP SLOPE
NOT TO SCALE

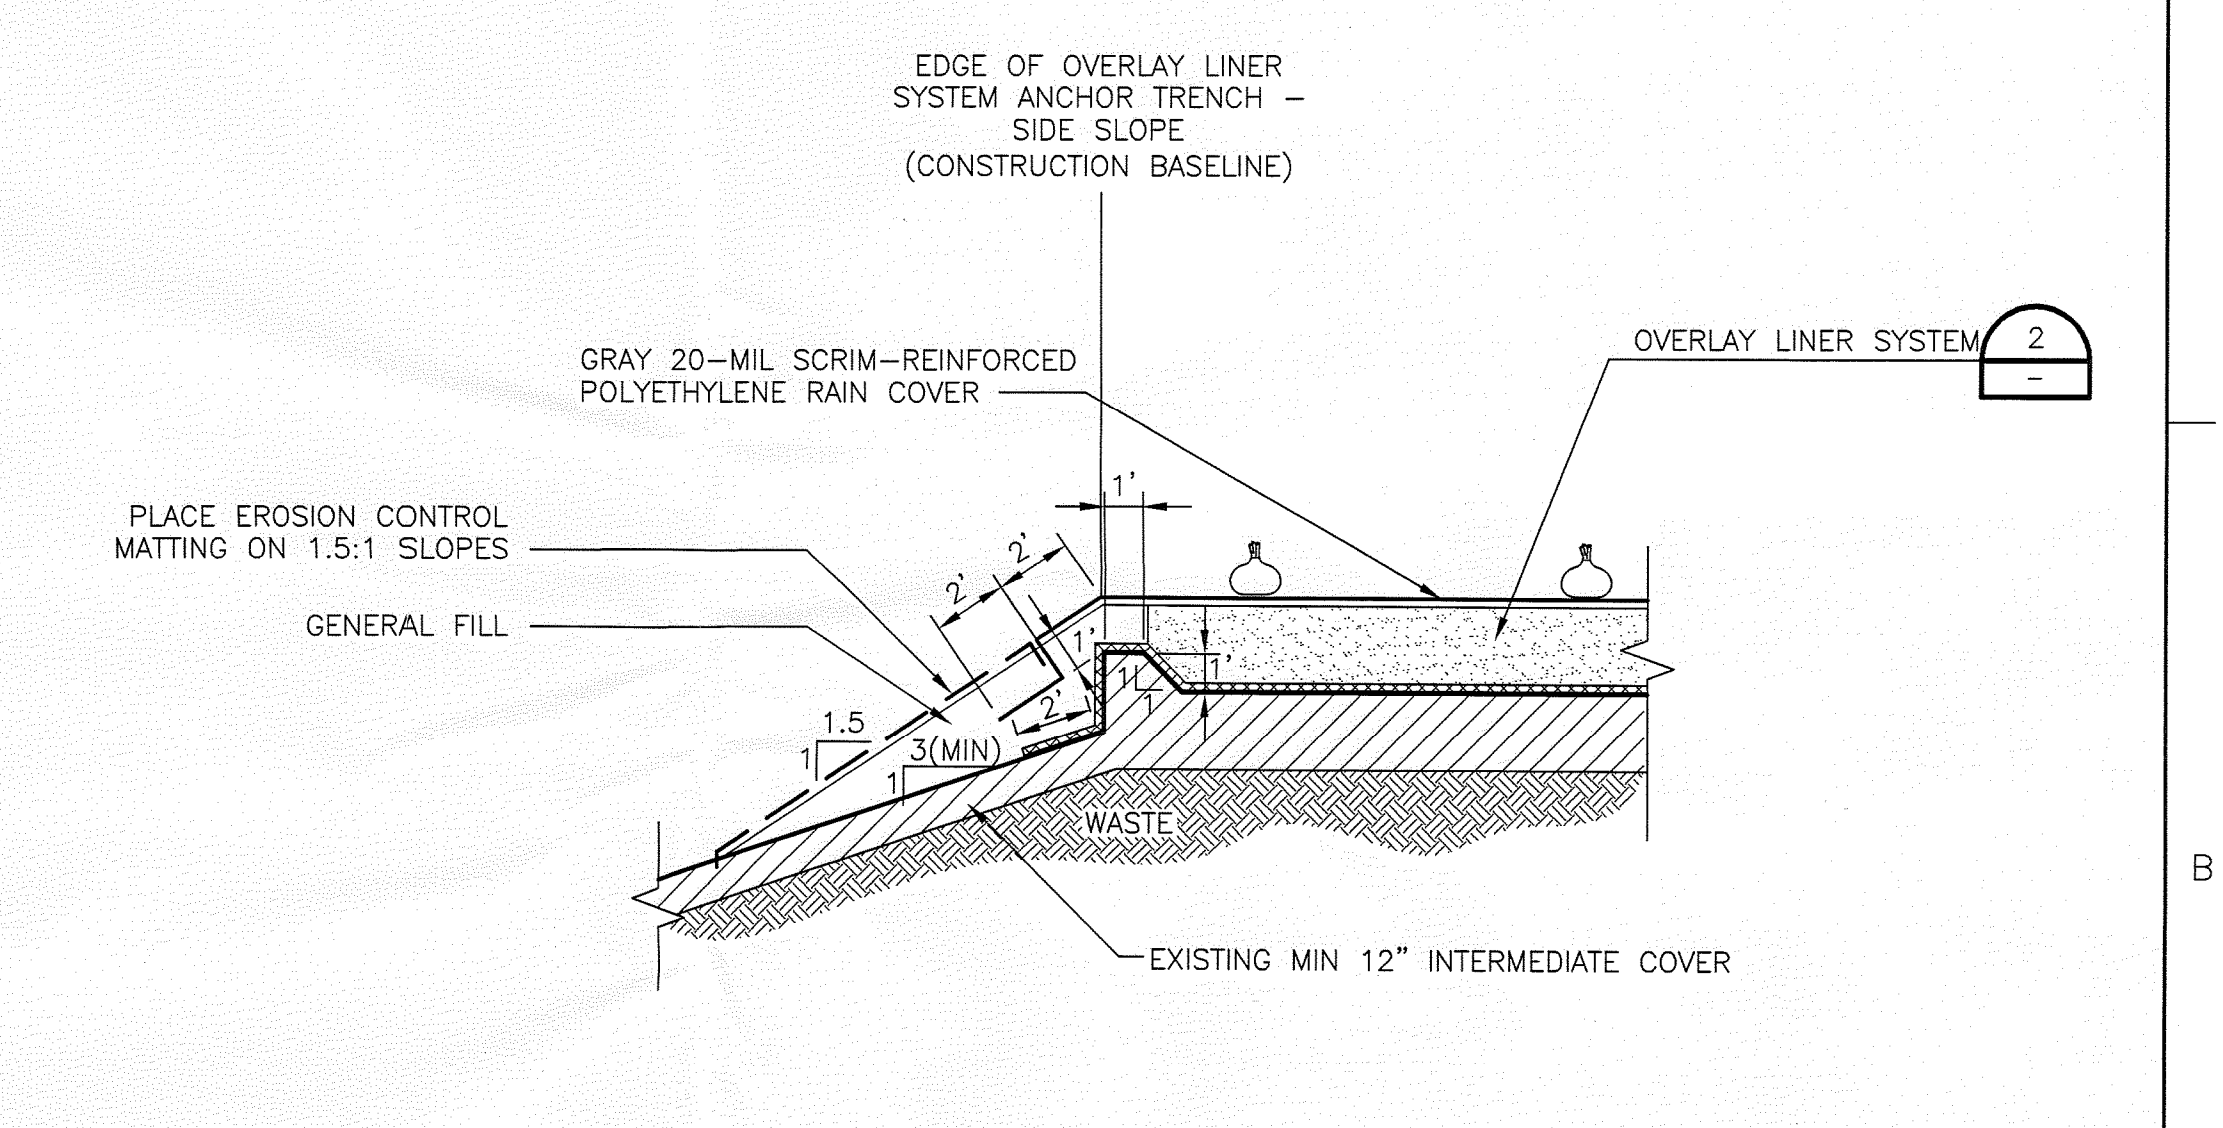

OVERLAY LINER SYSTEM ANCHOR TRENCH - SIDE SLOPE
NOT TO SCALE

NOTE:
1. INSTALL EDGE OF LINER MARKER CONSISTING OF TREATED 4"x4"x8' POST PAINTED BRIGHT ORANGE SPACED EVERY 100 FEET. IF MARKERS NEED TO BE OFFSET, CLEARLY NOTE OFFSET DISTANCE FROM EDGE OF LINER ON MARKER.

NOTE:
1. INSTALL EDGE OF LINER MARKER CONSISTING OF TREATED 4"x4"x8' POST PAINTED BRIGHT ORANGE SPACED EVERY 100 FEET. IF MARKERS NEED TO BE OFFSET, CLEARLY NOTE OFFSET DISTANCE FROM EDGE OF LINER ON MARKER.

RECORD DRAWING
THIS DOCUMENT HAS BEEN PREPARED BASED ON INFORMATION PROVIDED BY OTHERS AND DEPICTS THE CONTRACTOR'S RECORD OF INSTALLATIONS. HDR ENGINEERING, INC. DOES NOT WARRANT THE ACCURACY OF SUCH INFORMATION OR COMPLETENESS OR FOR ANY ERRORS OR OMISSIONS THAT MAY BE INCORPORATED INTO THIS DOCUMENT BASED ON THE INFORMATION.
Thomas M. Yanoschak 44200 Date 3/31/10
THOMAS M. YANOSCHAK, P.E. P.E. NUMBER
HDR ENGINEERING, INC.

RECORD DRAWING

HDR
HDR Engineering, Inc.
5426 Bay Center Drive, Suite 400
Tampa, FL 33609-3444
(813) 282-2300
Florida Certificate of Authorization
No. 00004213

ISSUE	DATE	DESCRIPTION
B	03/2010	RECORD DRAWING
A	02/2009	ISSUED FOR CONSTRUCTION, CONFORMED TO ADDENDA

PROJECT MANAGER	T.M. YANOSCHAK
REVIEWED BY	J.C. READLING
DRAWN BY	G.J. BLUE
	L.E. PATTERSON
PROJECT NUMBER	001916-43485-018

Professional Engineer Seal for Thomas M. Yanoschak, P.E., License No. 44200, State of Florida, Certificate No. 44200, dated 3/31/10.

SARASOTA COUNTY
Central County Solid Waste Disposal Complex
PHASE II CLASS I LANDFILL EXPANSION
CONSTRUCTION DRAWINGS
FLORIDA

LINER AND BERM DETAILS
ADDENDUM NO. 4
FLORIDA DEPARTMENT OF ENVIRONMENTAL PROTECTION
APR 13 2010
SOUTHWEST DISTRICT TAMPA
SCALE: AS SHOWN
FILENAME: 00C-11.dwg
SHEET: C-11