


NOTE
1. UPPER 2' OF PERIMETER BERM TO BE INSTALLED AFTER LINER SYSTEM IS INSTALLED

INTERIOR PERIMETER BERM
NOT TO SCALE

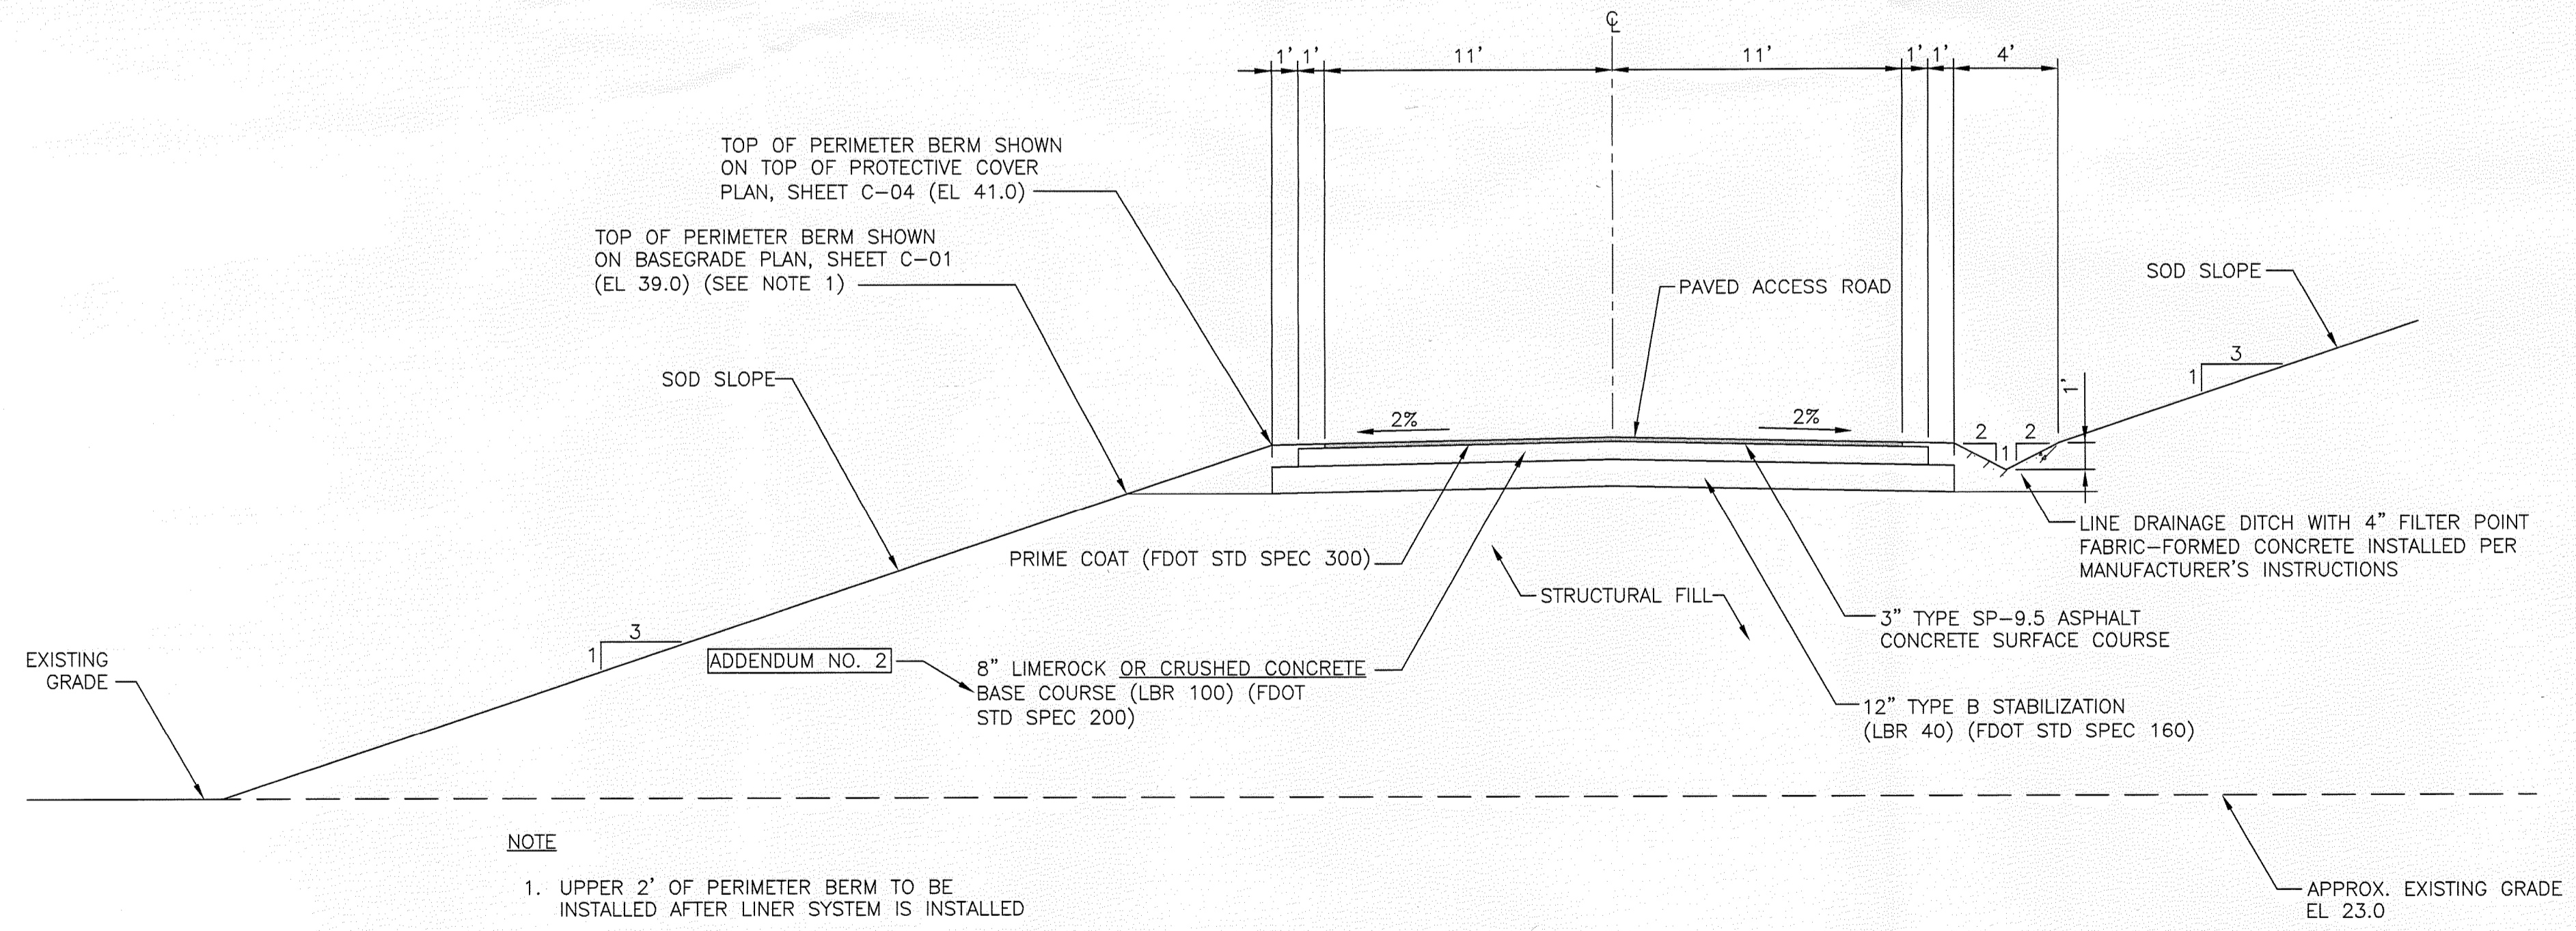

NOTE
1. UPPER 2' OF PERIMETER BERM TO BE INSTALLED AFTER LINER SYSTEM IS INSTALLED

ACCESS RAMP
NOT TO SCALE


RECORD DRAWING
THIS DOCUMENT HAS BEEN PREPARED BASED ON INFORMATION PROVIDED BY OTHERS AND DEPICTS THE CONTRACTOR'S RECORD OF INSTALLATIONS. HDR ENGINEERING, INC. DOES NOT WARRANT THE ACCURACY OF SUCH INFORMATION OR COMPLETENESS OR FOR ANY ERRORS OR OMISSIONS THAT MAY BE INCORPORATED INTO THIS DOCUMENT BASED ON THE INFORMATION.
Thomas M. Yanoschak 44200 Date 3/21/10
THOMAS M. YANOSCHAK, P.E. P.E. NUMBER
HDR ENGINEERING, INC.

RECORD DRAWING



ISSUE	DATE	DESCRIPTION
B	03/2010	RECORD DRAWING
A	02/2009	ISSUED FOR CONSTRUCTION, CONFORMED TO ADDENDA

PROJECT MANAGER	T.M. YANOSCHAK
REVIEWED BY	J.C. READLING
DRAWN BY	G.J. BLUE
PROJECT NUMBER	001916-43485-018

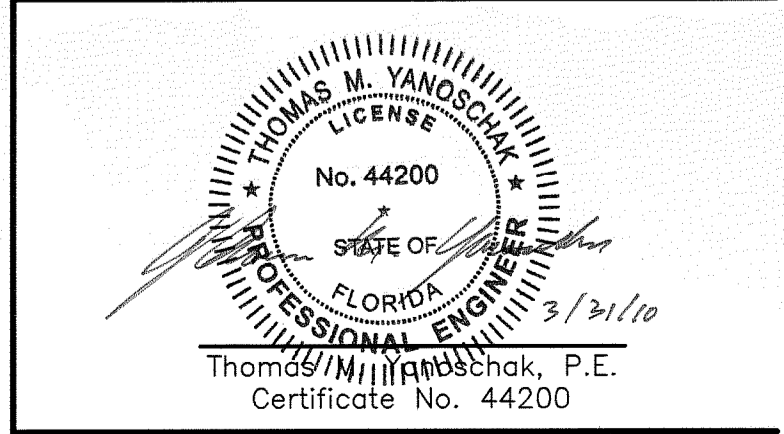

SARASOTA COUNTY

Central County Solid Waste Disposal Complex
PHASE II CLASS I LANDFILL EXPANSION
CONSTRUCTION DRAWINGS

FLORIDA

LINER AND BERM DETAILS

FLORIDA DEPARTMENT OF ENVIRONMENTAL PROTECTION
APR 13 2010
SOUTHWEST DISTRICT TAMPA

ADDENDUM NO. 2

FILENAME: OOC-12.dwg
SCALE: AS SHOWN
SHEET: **C-12**