


PREFABRICATED PIPE PENETRATION
NOT TO SCALE

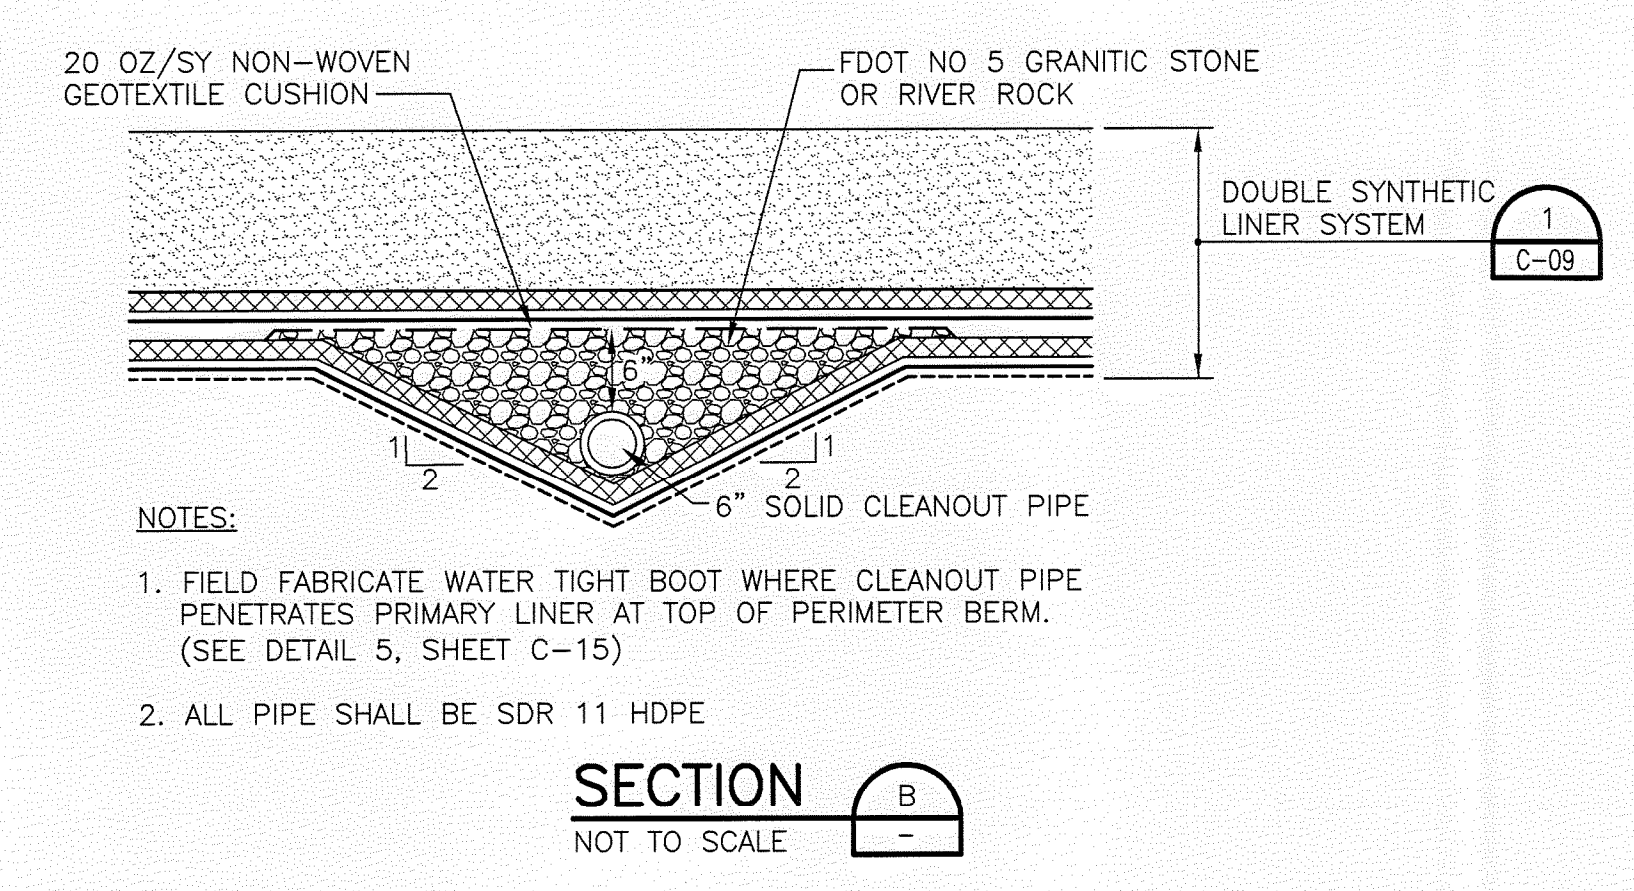

RECORD DRAWING

THIS DOCUMENT HAS BEEN PREPARED BASED ON INFORMATION PROVIDED BY OTHERS AND DEPICTS THE CONTRACTOR'S RECORD OF INSTALLATIONS. HDR ENGINEERING, INC. DOES NOT WARRANT THE ACCURACY OF SUCH INFORMATION OR COMPLETENESS OR FOR ANY ERRORS OR OMISSIONS THAT MAY BE INCORPORATED INTO THIS DOCUMENT BASED ON THE INFORMATION.

Thomas M. Yanoschak 4200 Date 3/31/10
THOMAS M. YANOSCHAK, P.E. P.E. NUMBER



HDR ENGINEERING, INC.

RECORD DRAWING



ISSUE	DATE	DESCRIPTION
B	03/2010	RECORD DRAWING
A	02/2009	ISSUED FOR CONSTRUCTION, CONFORMED TO ADDENDA

PROJECT MANAGER	T.M. YANOSCHAK
REVIEWED BY	J.C. READLING
DRAWN BY	J. HATCHER
PROJECT NUMBER	001916-43485-018

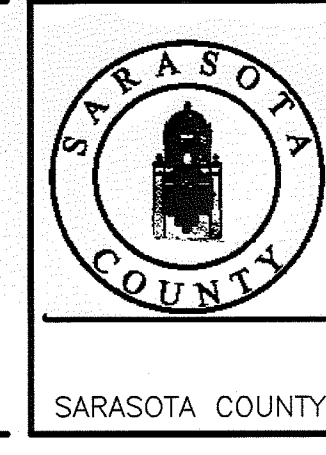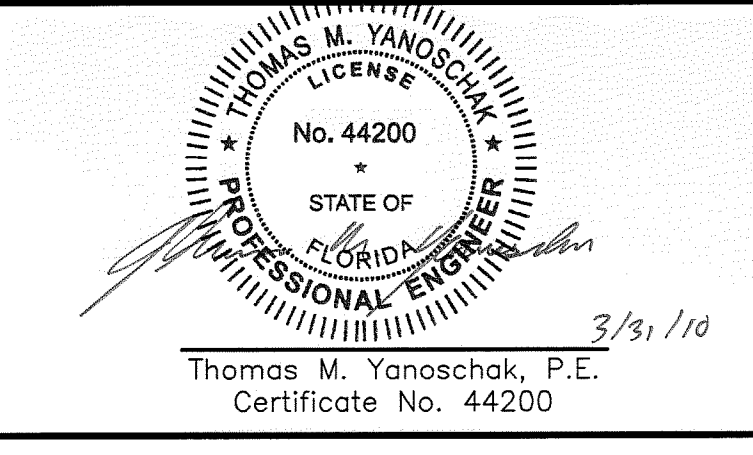

Central County Solid Waste Disposal Complex
PHASE II CLASS I LANDFILL EXPANSION
CONSTRUCTION DRAWINGS

LEACHATE COLLECTION SYSTEM DETAILS		FILENAME OOC-14.dwg	SHEET C-14
ADDENDUM NO. 4			
SCALE AS SHOWN		APR 13 2010 SOUTHWEST DISTRICT TAMPA	