

PACKAGED METERING MANHOLE
 NOT TO SCALE

RECORD DRAWING

THIS DOCUMENT HAS BEEN PREPARED BASED ON INFORMATION PROVIDED BY OTHERS AND DEPICTS THE CONTRACTOR'S RECORD OF INSTALLATIONS. HDR ENGINEERING, INC. DOES NOT WARRANT THE ACCURACY OF SUCH INFORMATION OR COMPLETENESS OR FOR ANY ERRORS OR OMISSIONS THAT MAY BE INCORPORATED INTO THIS DOCUMENT BASED ON THE INFORMATION.

Thomas M. Yanoschak 4200 Date 3/31/10
 THOMAS M. YANOSCHAK, P.E. P.E. NUMBER


HDR ENGINEERING, INC.

RECORD DRAWING



ISSUE	DATE	DESCRIPTION
B	03/2010	RECORD DRAWING
A	02/2009	ISSUED FOR CONSTRUCTION, CONFORMED TO ADDENDA

PROJECT MANAGER	T.M. YANOSCHAK
REVIEWED BY	J.C. READLING
DRAWN BY	G.J. BLUE
PROJECT NUMBER	001916-43485-018

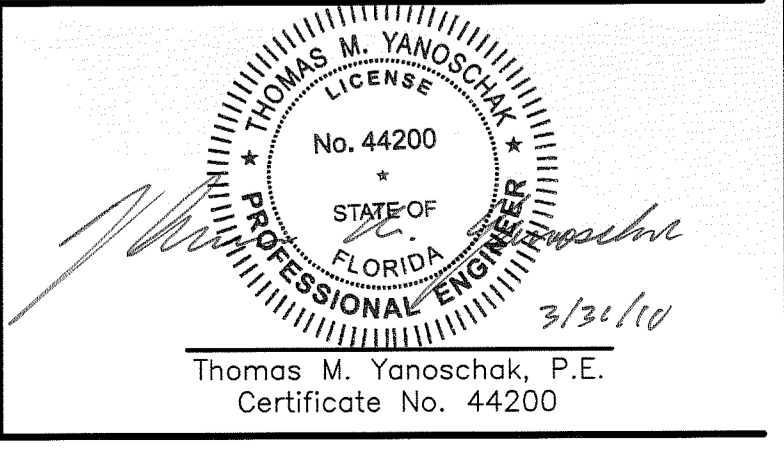

SARASOTA COUNTY

Central County Solid Waste Disposal Complex
PHASE II CLASS I LANDFILL EXPANSION
CONSTRUCTION DRAWINGS

FLORIDA

LEACHATE COLLECTION SYSTEM DETAILS
PACKAGED METERING MANHOLE

APR 13 2010
 ENVIRONMENTAL PROTECTION
 DEPARTMENT OF
 SOUTHWEST DISTRICT
 TAMPA

0 1" 2"

FILENAME OOC-18.dwg
 SCALE AS SHOWN

SHEET **C-18**