

RECORD DRAWING
 THIS DOCUMENT HAS BEEN PREPARED BASED ON INFORMATION PROVIDED BY OTHERS AND DEPICTS THE CONTRACTOR'S RECORD OF INSTALLATIONS. HDR ENGINEERING, INC. DOES NOT WARRANT THE ACCURACY OF SUCH INFORMATION OR COMPLETENESS OR FOR ANY ERRORS OR OMISSIONS THAT MAY BE INCORPORATED INTO THIS DOCUMENT BASED ON THE INFORMATION.
 Thomas M. Yanoschak, P.E. No. 44200 Date 3/31/10
 THOMAS M. YANOSCHAK, P.E. P.E. NUMBER
HDR ENGINEERING, INC.


RECORD DRAWING

DISCHARGE TO LEACHATE TANK
 3/8"=1'-0"



ISSUE	DATE	DESCRIPTION
B	03/2010	RECORD DRAWING
A	02/2009	ISSUED FOR CONSTRUCTION, CONFORMED TO ADDENDA

PROJECT MANAGER	T.M. YANOSCHAK
REVIEWED BY	J.C. READLING
DRAWN BY	G.J. BLUE
PROJECT NUMBER	001916-43485-018

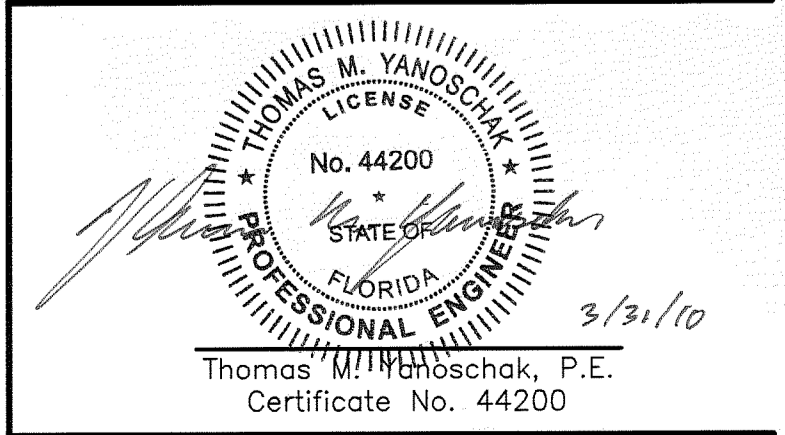

SARASOTA COUNTY
Central County Solid Waste Disposal Complex
PHASE II CLASS I LANDFILL EXPANSION
CONSTRUCTION DRAWINGS
 FLORIDA

FORCEMAIN AT LEACHATE STORAGE TANK
 FLORIDA DEPARTMENT OF ENVIRONMENTAL PROTECTION
 APR 13 2010
 SOUTHWEST DISTRICT TAMPA

0 1" 2"
 FILENAME: OOC-31.dwg
 SCALE: AS SHOWN
 SHEET: **C-31**