


1 inch = 40 ft.

NO.	NUMBER
ELEV.	ELEVATION

x 73.35 ASBUILT SPOT ELEVATION - SUBGRADE
LB LICENCE BUSINESS
— (5' INTERVAL) — ASBUILT SUBGRADE CONTOUR
(1 FOOT INTERVAL)
— TOE OF SLOPE
— TOP OF SLOPE
— EXISTING LINER MARKER
— EXISTING LINER TIE-IN

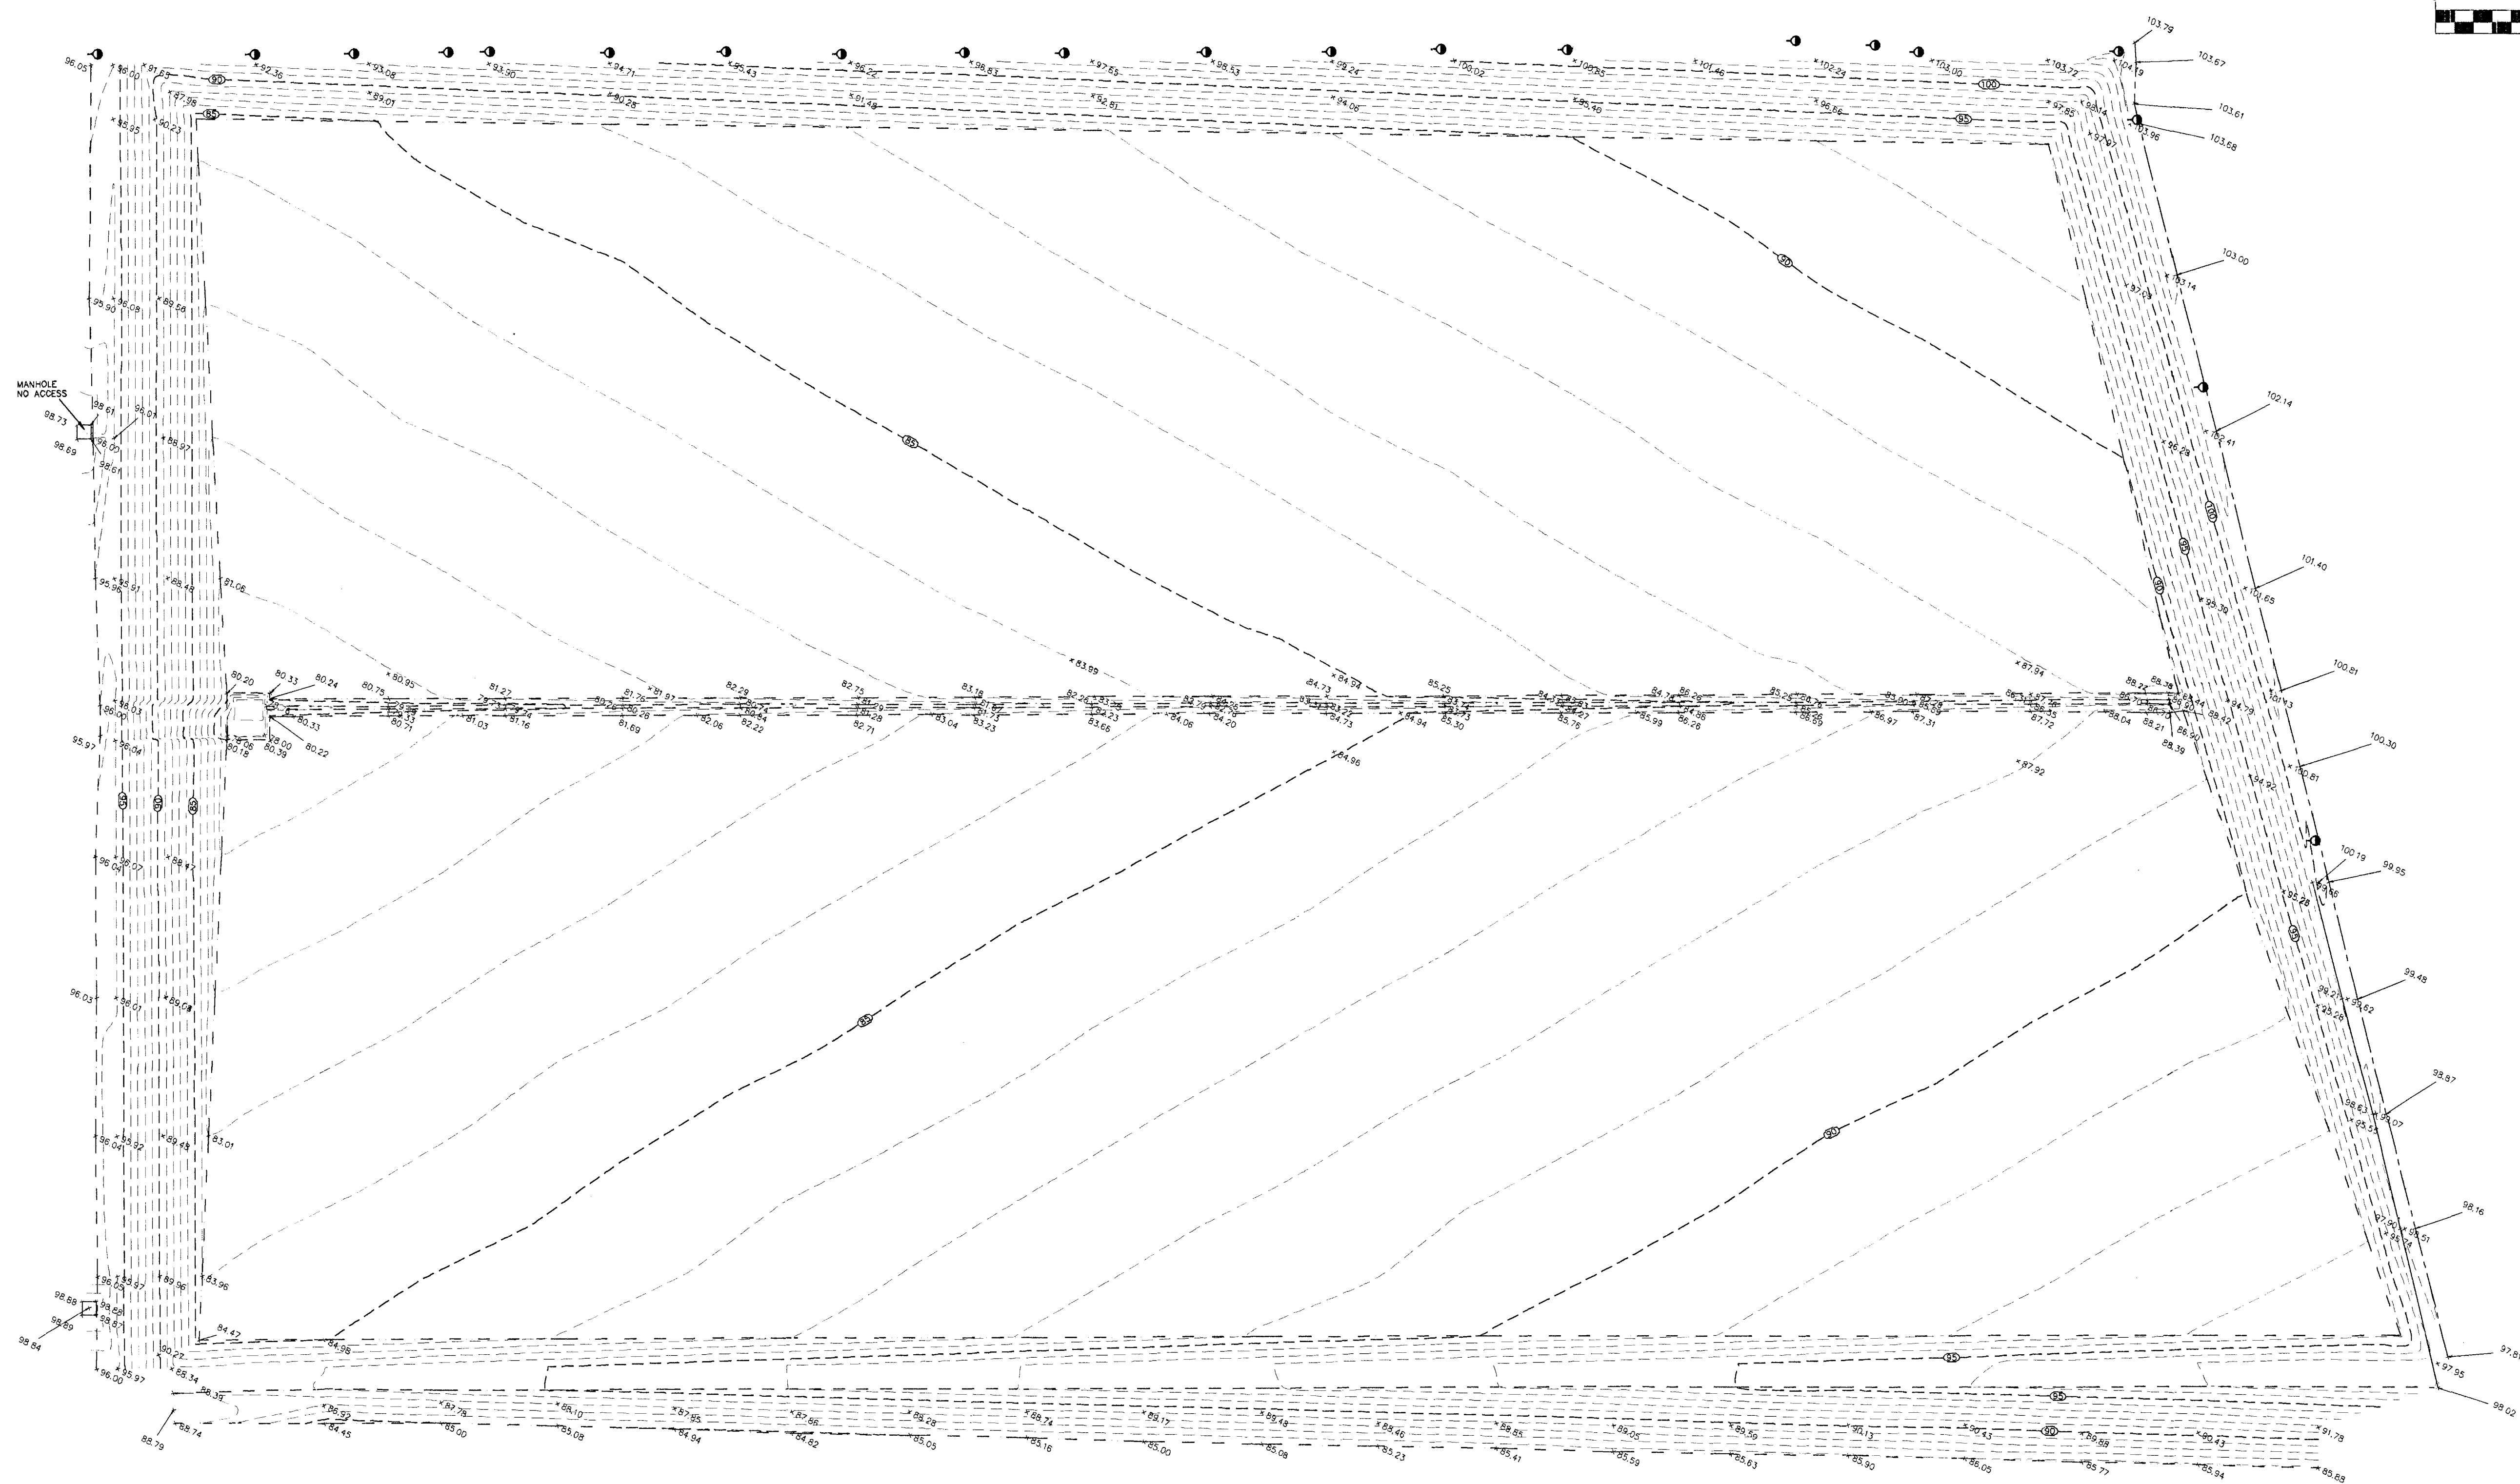

PEAVEY




& ASSOCIATES SURVEYING & MAPPING PA
FLORIDA BUSINESS NUMBER 7779
690 ALICE PLACE
BARTOW, FL 33830
PHONE: 863-738-4960

CLIENT:

ERC GENERAL CONTRACTOR
390 Carter Road Suite 170
Winter Garden, FL 34787

**ASBUILT SURVEY - TOP OF LINER SUBBASE
CELL 7 CONSTRUCTION
J.J.E.D. SOLID WASTE MANGEMENT FACILITY
1501 OMNI WAY ST. CLOUD, FL**

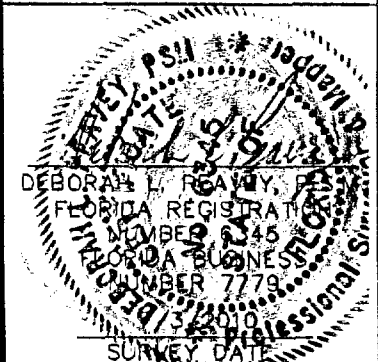


SCALE 1"=40'	DRAWING NO. 173
PROJECT NO. 113	SHEET 1 OF 3

MAGNETIC

1 inch = 40 ft.

NO.	NUMBER
ELEV.	ELEVATION
x 73.35	ASBUILT SPOT ELEVATION - FINAL COVER
LB	LICENCE NUMBER
— — — — —	ASBUILT FINAL COVER CONTOUR (5 FOOT INTERVAL)
— — — — —	ASBUILT FINAL COVER CONTOUR (1 FOOT INTERVAL)
— — — — —	TOE OF SLOPE
— — — — —	TOP OF SLOPE
— — — — —	LINER MARKER
	ASBUILT LINEROCK
— — — — —	LIMITS OF LINER

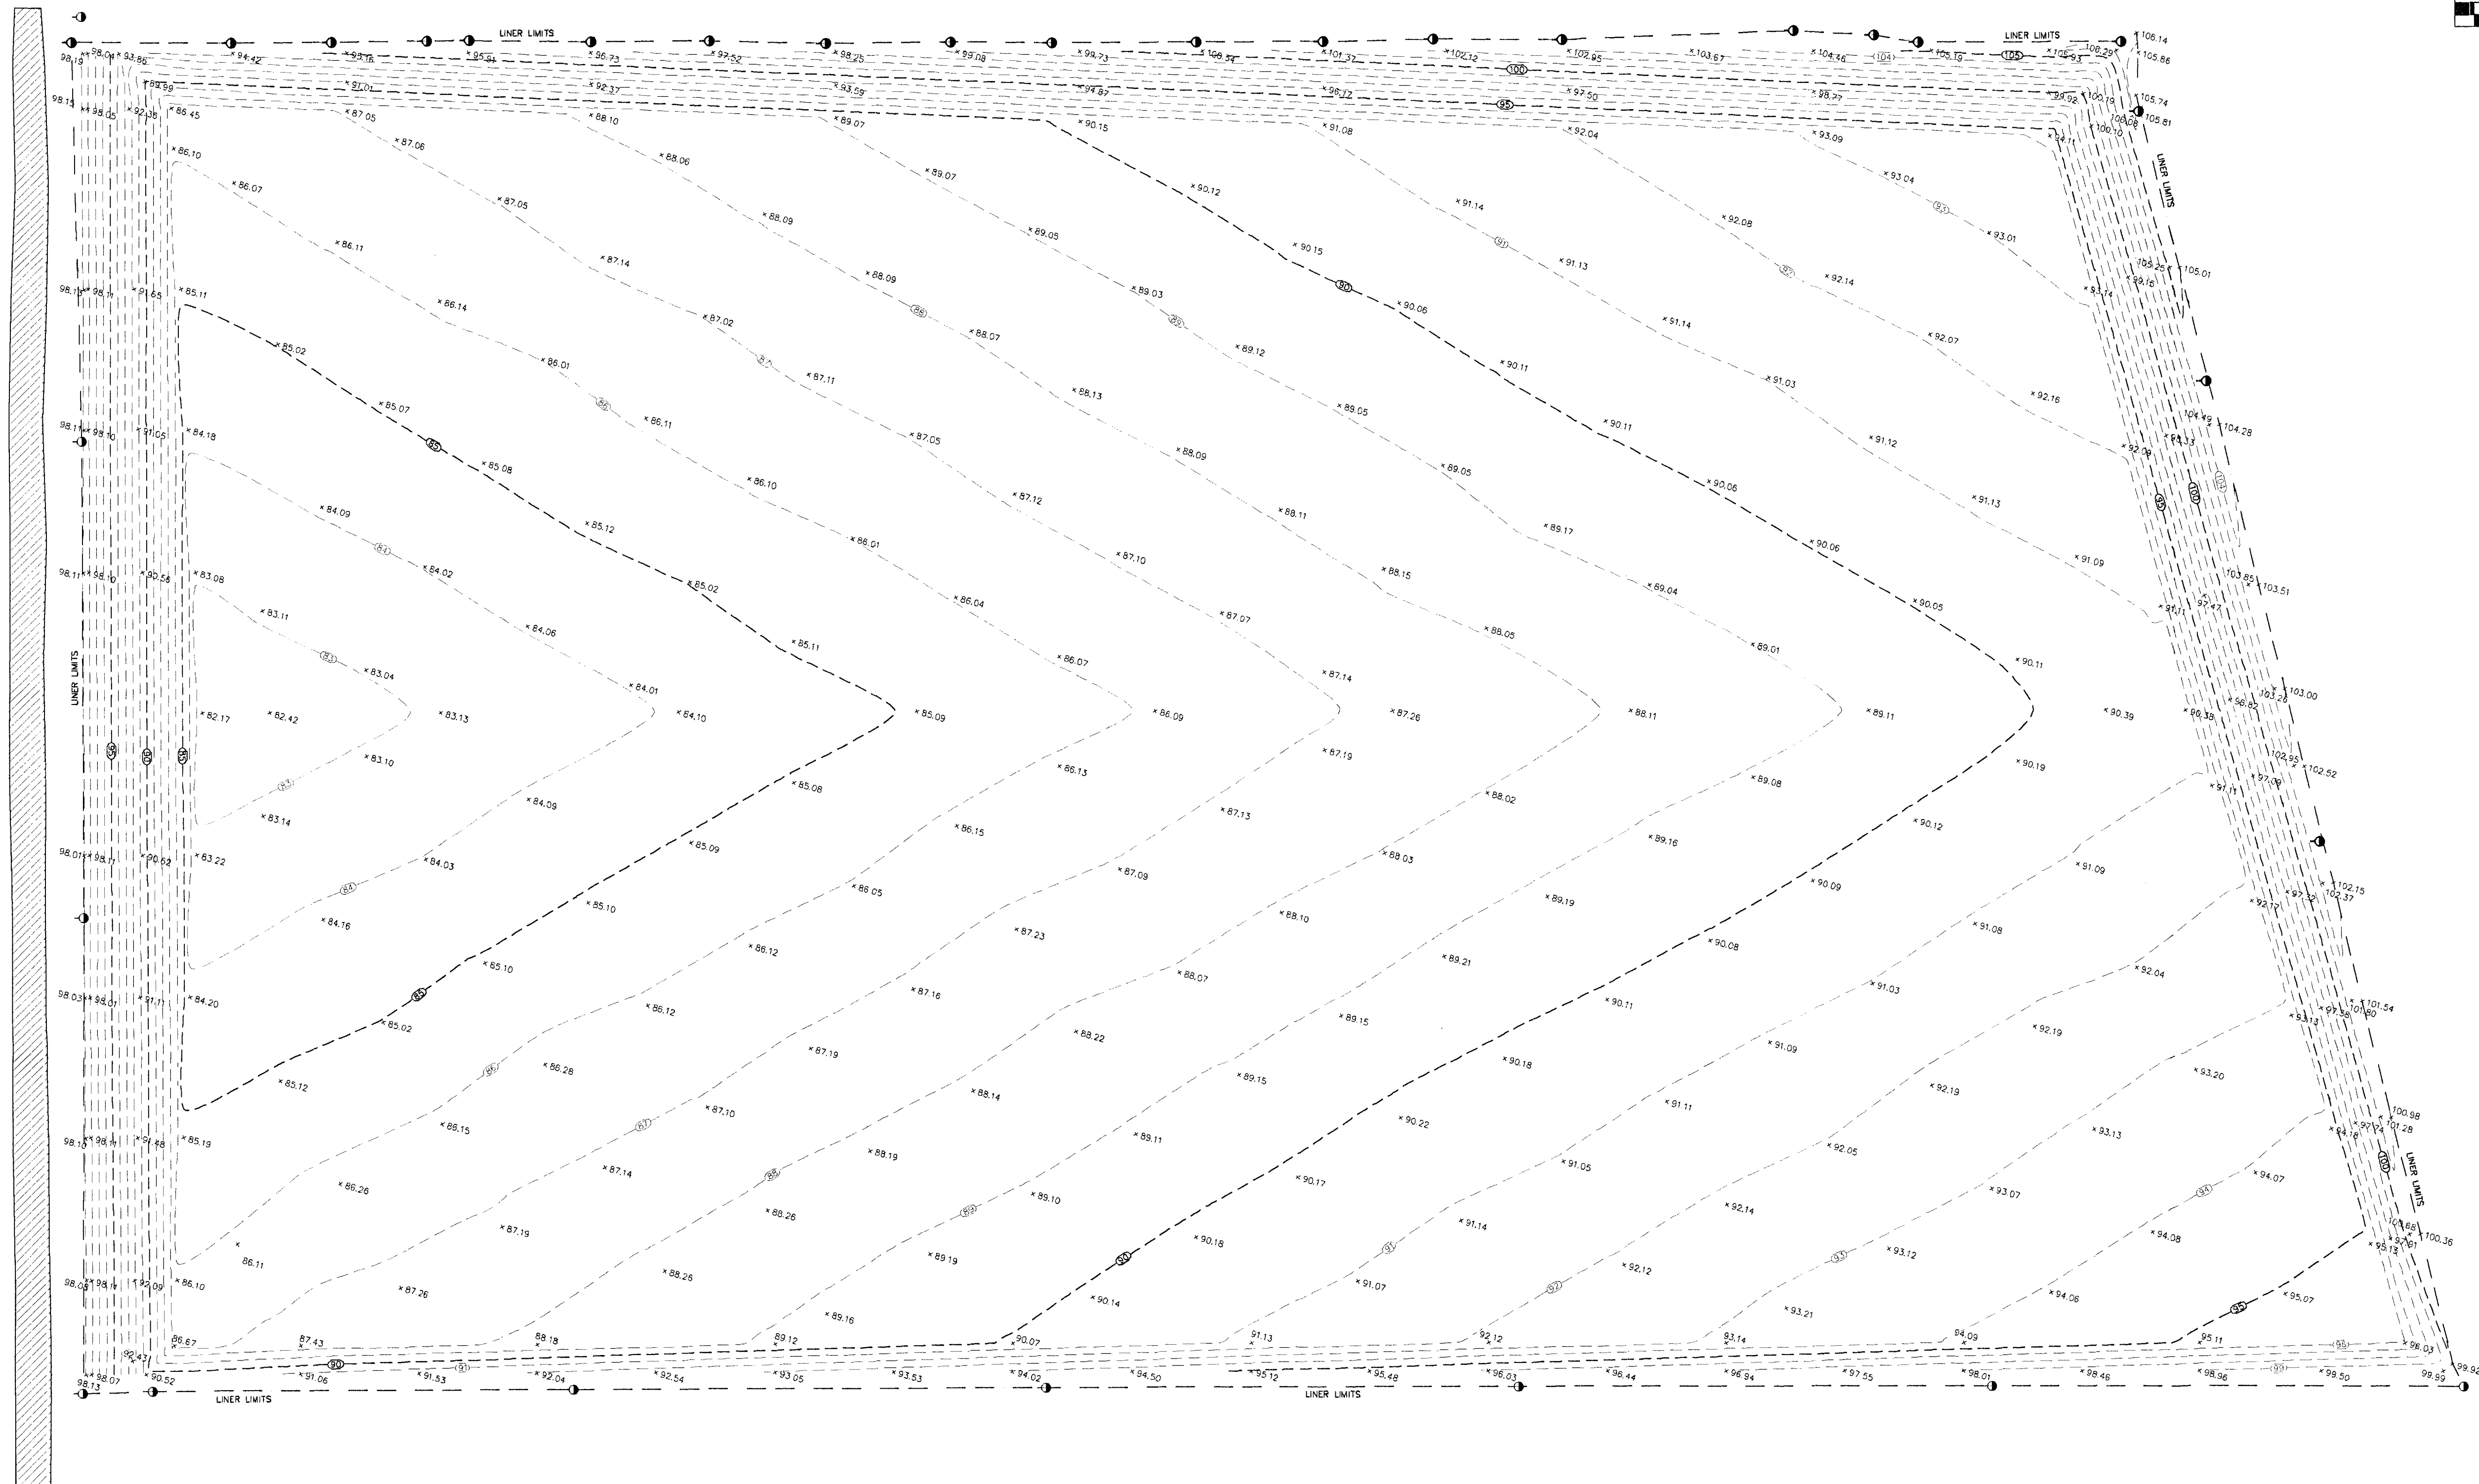
[illegible]

Drawn By:	DLP
Party Chief:	DR
Field Book:	
Page:	

PEAVEY
& ASSOCIATES SURVEYING & MAPPING PA
FLORIDA BUSINESS NUMBER 7779
690 ALICE PLACE
BARTOW, FL 33830
PHONE: 863-738-4960

CLIENT:
ERC GENERAL CONTRACTOR
890 Carter Road Suite 170
Winter Garden, FL 34787

ASBUILT SURVEY-TOP OF PROTECTIVE COVER
CELL 7 CONSTRUCTION
J.J.E.D. SOLID WASTE MANAGEMENT FACILITY
1501 OMNI WAY ST. CLOUD, FL

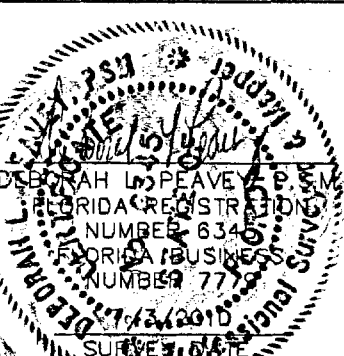

SCALE 1"=40'	DRAWING NO. 173
PROJECT NO. 113	SHEET 2 OF 3

