

ANGELO'S RECYCLED MATERIALS

41111 Enterprise Road
Dade City, FL 33525



APOPKA 407.290.8010 407.290.8115 (FAX)
DADE CITY 352.567.7676 352.567.9448 (FAX)

TAMPA 813.903.0588 813.632.9157 (FAX)
LARGO 727.581.1544 727.586.5676 (FAX)

August 24, 2011

Ms. Nancy Gaskin
Solid Waste Section
Florida Department of Environmental Protection - Southwest District
13051 North Telecom Parkway
Temple Terrace, FL 33637-0926

RE: Angelo's Aggregate Materials, LTD
Permit No.: 303741-001-WT/02
WACS Id.: 87895

Dept. Of Environmental Protection

AUG 24 2011

Southwest District

Dear Ms. Gaskin:

I received your email dated August 16, 2011 that was in response to the Certification of Construction Completion (FDEP Form No. 62-701.900(2)) dated August 8, 2011. You requested that we provide the Department with photographs of the finished construction and an "as-built" site plan.

Attached, please find photographs showing the various corner posts, soil stockpile, and the earthen embankments. I have enclosed two signed/sealed "as-built" drawings. Since there are no additions, deletions, or revisions to the approved site plan, this correspondence serves as the narrative to document such.

Please let me know if you have any questions or need any additional information.

Sincerely,

A handwritten signature in black ink, appearing to read "John Arnold".

John Arnold, P.E.

attachments

xc: Dominic A. Iafrate
Jake Varn, Fowler White Boggs

AUG 24 2011

Southwest District





Dept. Of Environmental Protection

AUG 24 2011

Southwest District





Dept. Of Environmental Protection

AUG 24 2011



Southwest District




Dept. Of Environmental Protection

AUG 24 2011

Southwest District



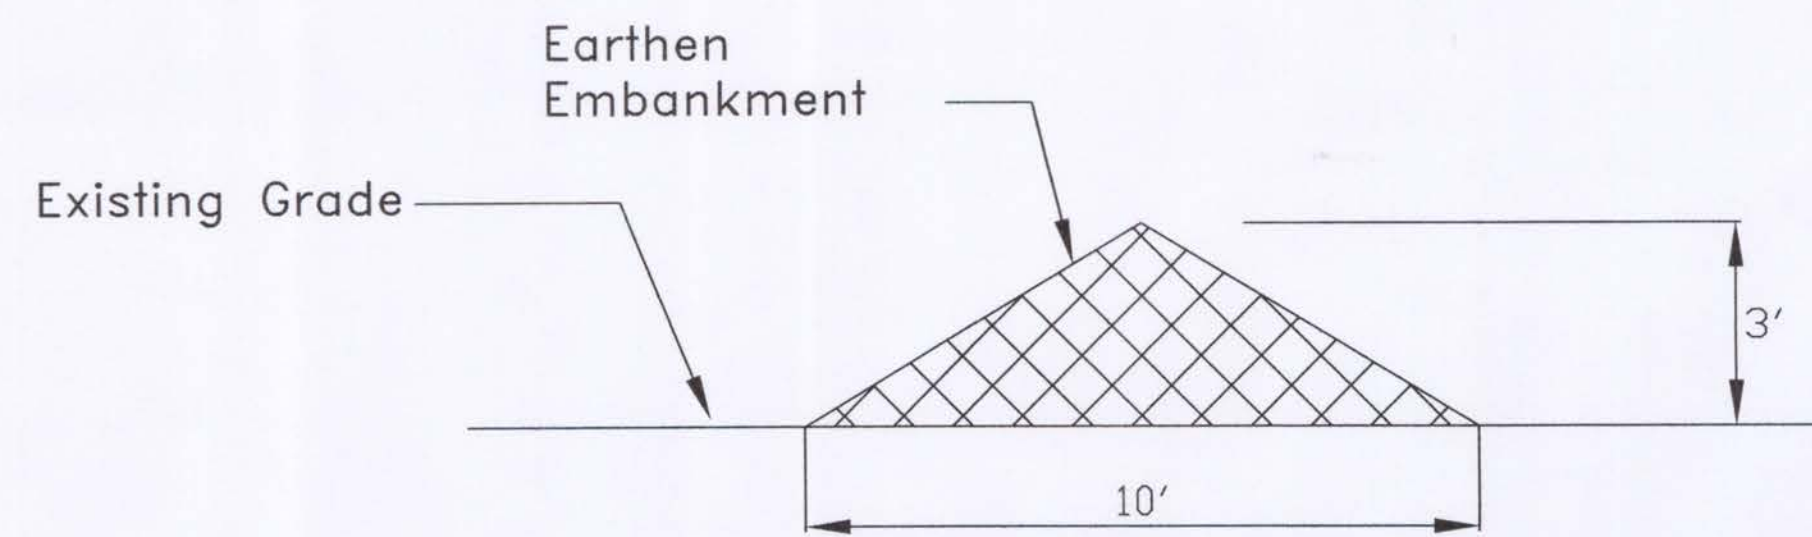


Section A-A
not to scale

Note: Mulch exterior surface of earthen embankment to provide erosion protection

1 Waste Tire Processing Facility Site Plan

Coordinate Layout Table		
Name	N	E
A	1000+00	1000+00
B	1505+00	1000+00
C	1505+00	1423+05
D	1475+81	1463+71
E	1000+00	1455+00

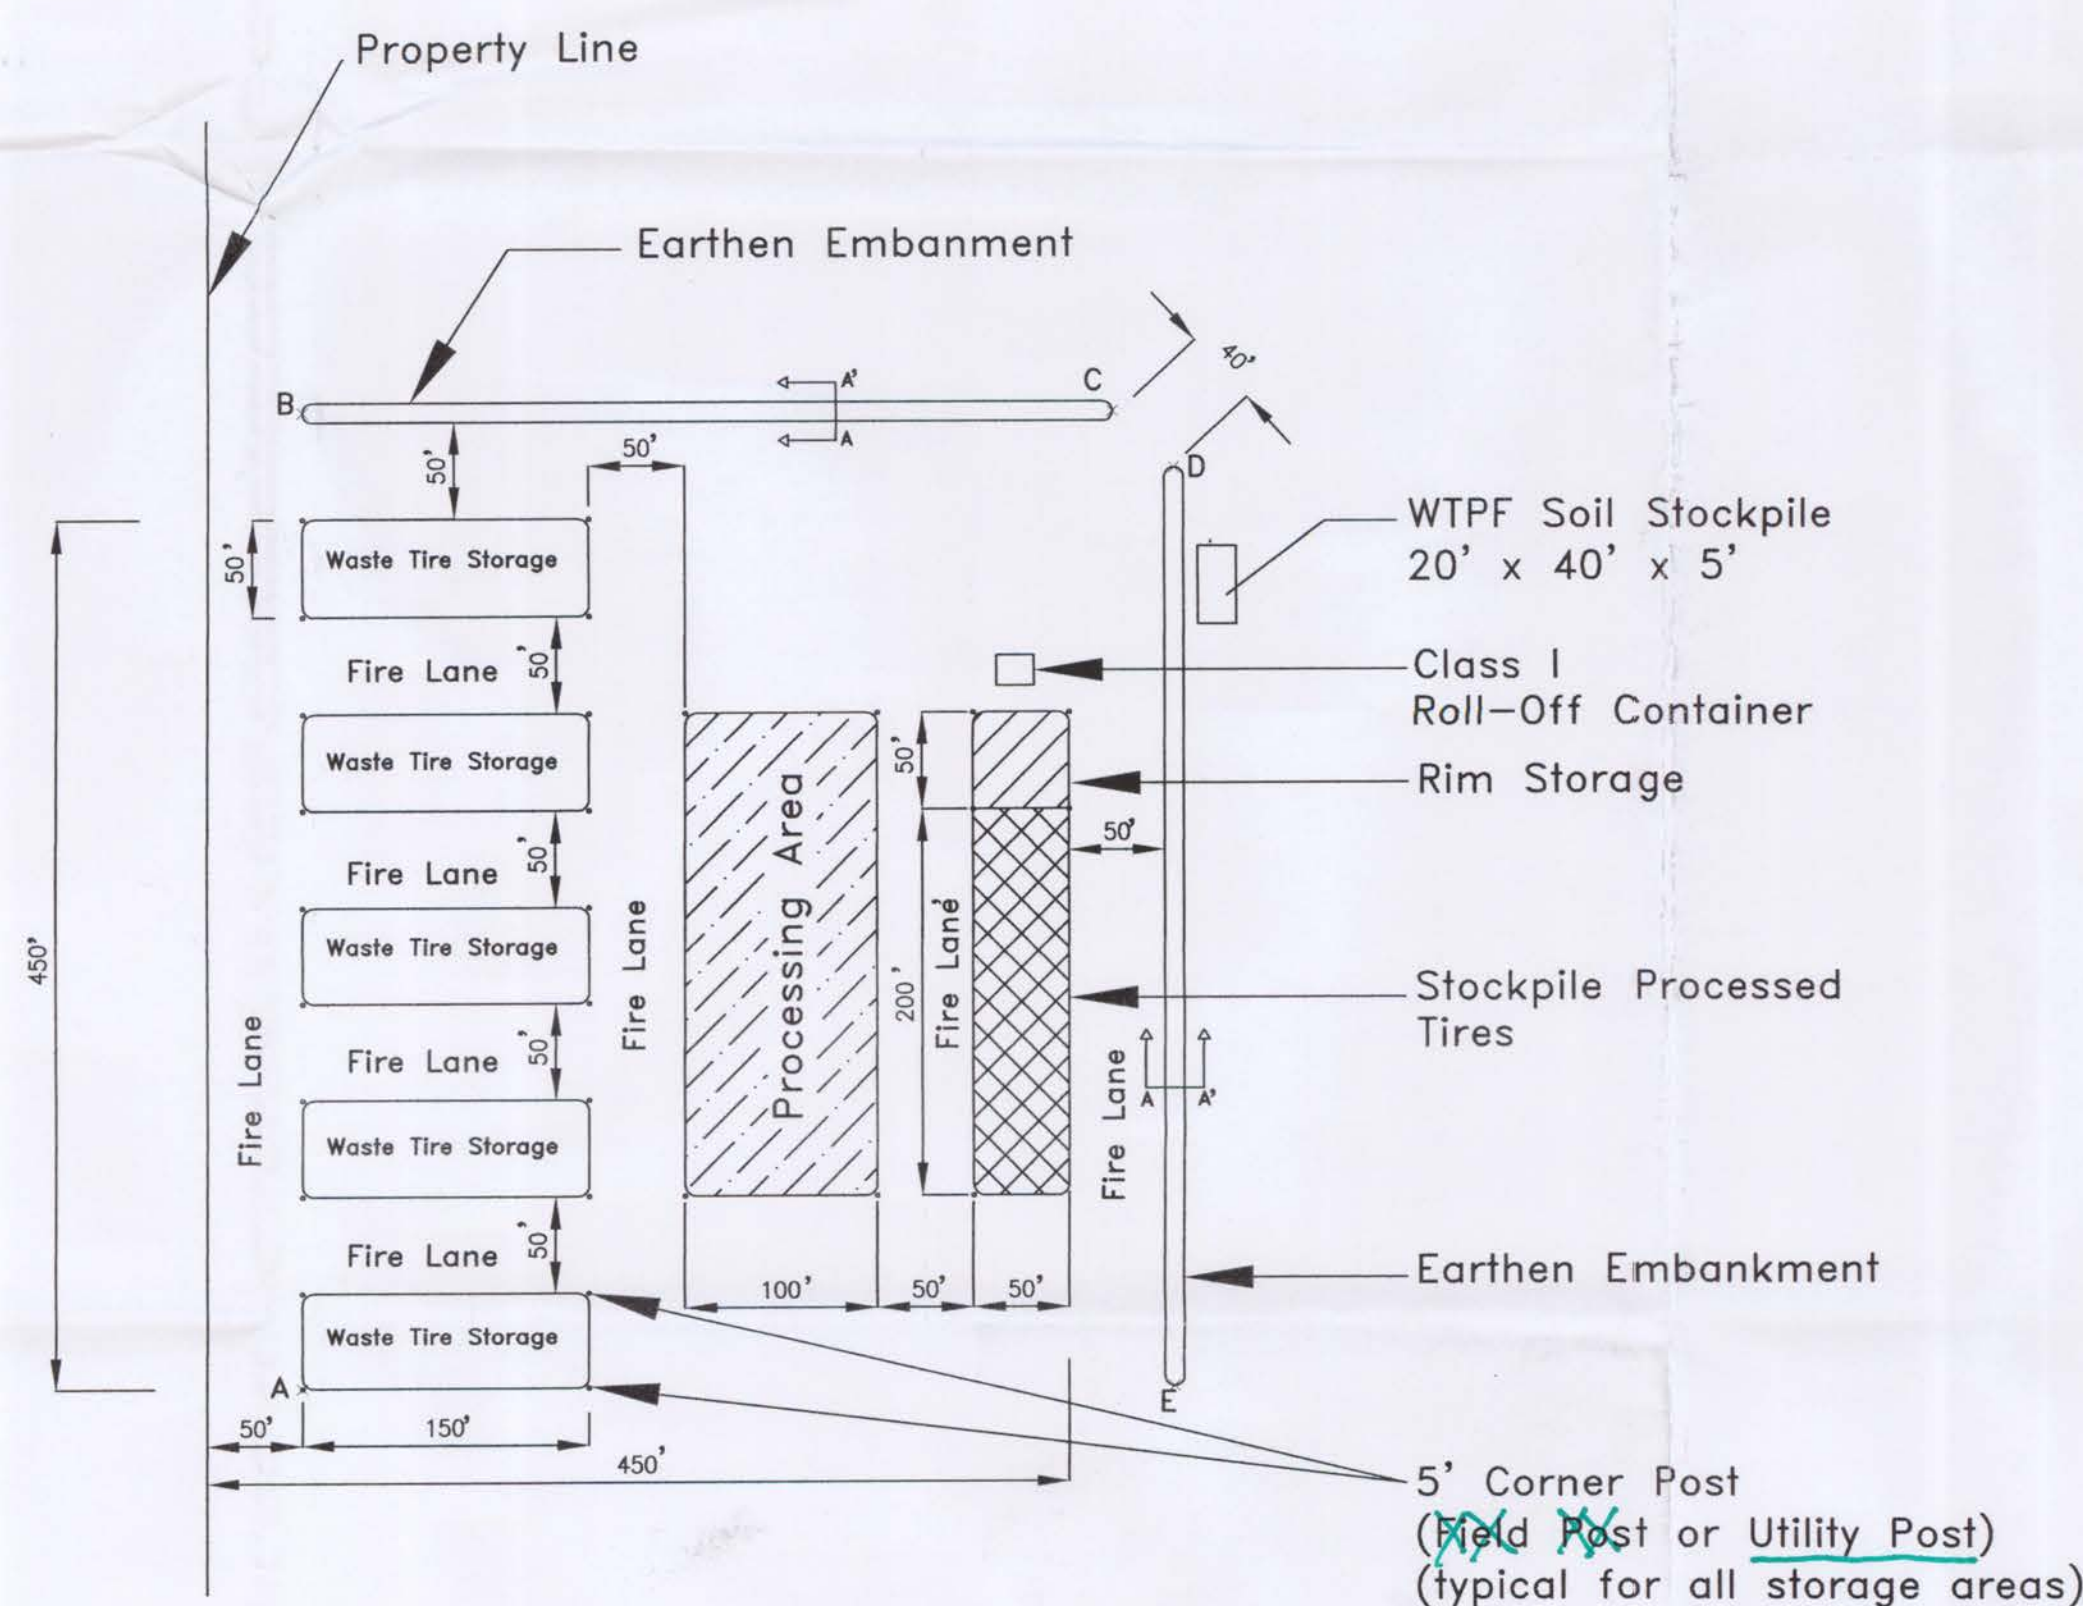

1 Waste Tire Processing Facility Site Plan

AS-BUILT 8/24/11

As-Built Certification in General Accordance with approval Plans.
 John Arnold 8/24/11
 34924 Williams County Rd
 Dade City FL 33525
 PE 47164
 Ph 352.339.1408



Notes:
 1. Topographic Contour lines show at the waste processing facility represent information from the USGS Dade City, Florida Quadrangle, photo, revised 1988.
 2. Aerial photograph from Google Earth Maps, Imagery Date: Dec. 2010.

Enterprise Class III Facility Site Plan

SCALE - 1" = 200'

DATE: AUG 24 2011
 DATE: 8/24/11

AS-BUILT

Job No.	01.B.08:	Rev. #1	2.8.11
Drawn By:	NDR	Revisions	
Date:	10.15.10	John Arnold	8/24/11
Scale:	as noted	PE 47164	
Approved By:	JPA	34924 W. C. Rd.	
Plot Date:	2.8.11	Dade City FL	
		33525	

ANGELO'S RECYCLED MATERIALS
 41111 Enterprise Rd.
 Dade City FL 33525
 Email: John.Phillip.Arnold@gmail.com
 Phone: (352) 567-7676 Fax: (352) 567-9448

Owner: ANGELOS RECYCLED MATERIALS
 Project Name: Dade City Tire Processing
 Address: 41111 Enterprise Rd.
 (352) 567-7676

C-1