



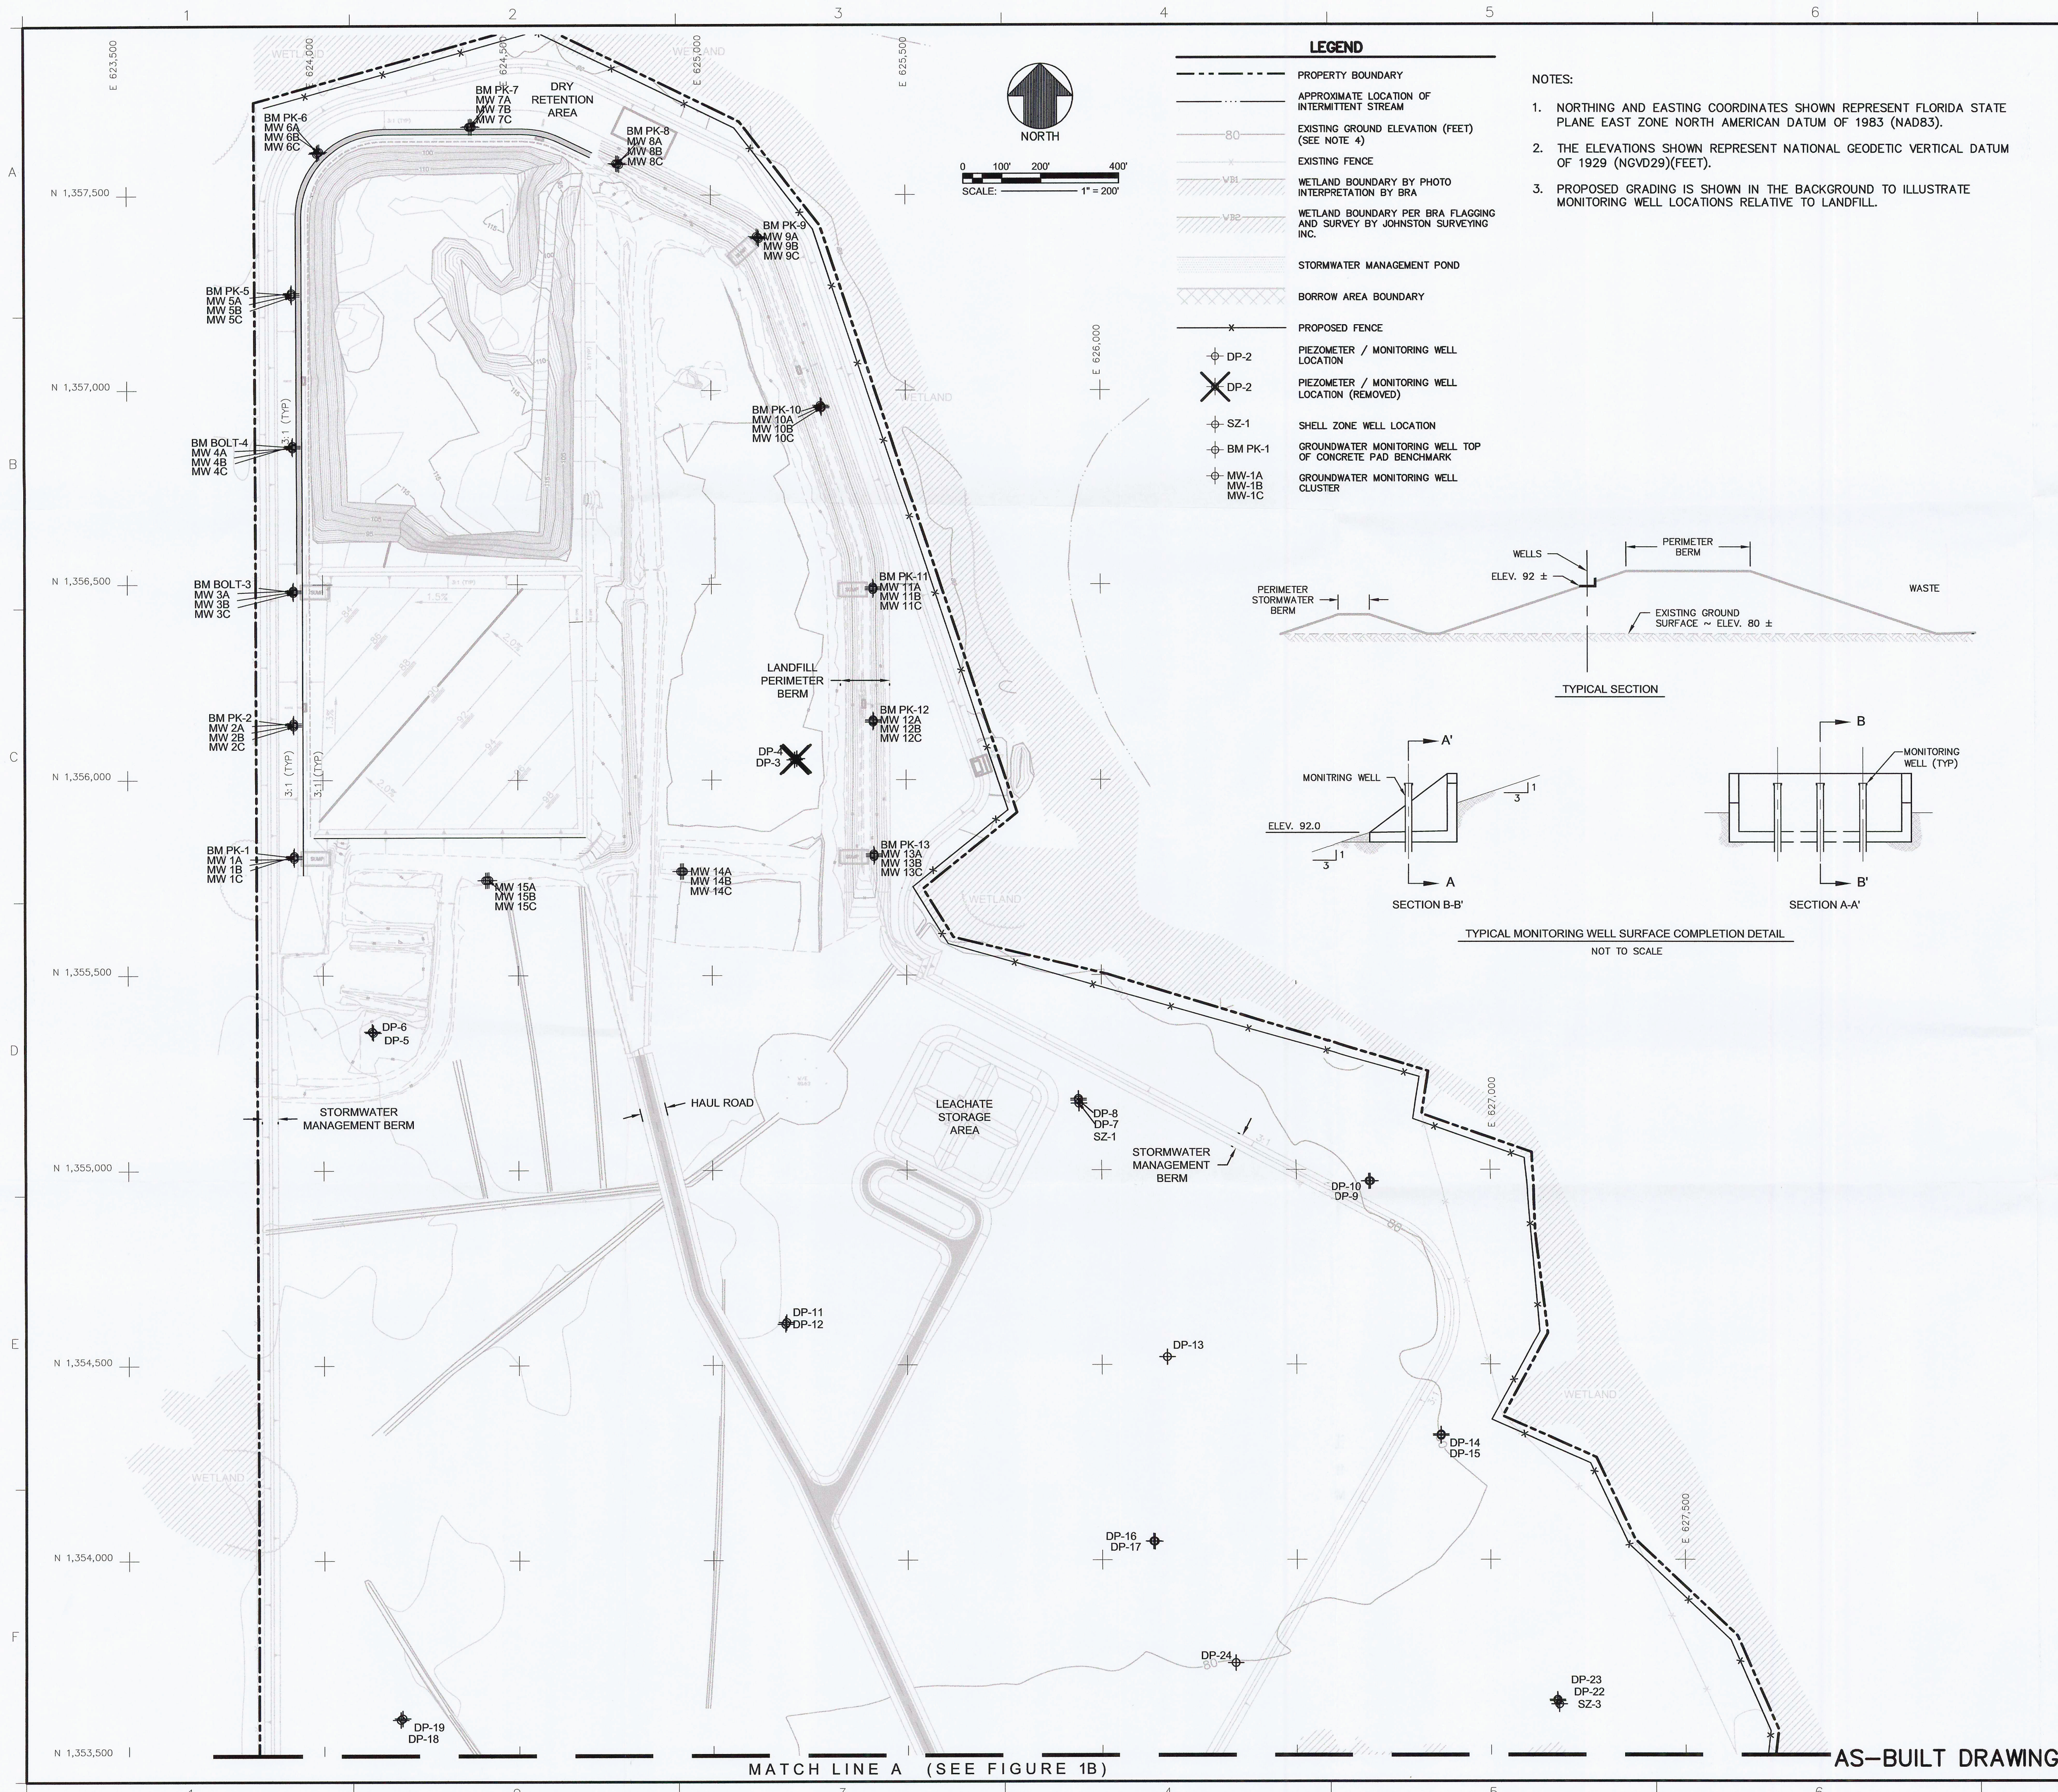

LEGEND

- PROPERTY BOUNDARY
- APPROXIMATE LOCATION OF INTERMITTENT STREAM (SEE NOTE 4)
- EXISTING GROUND ELEVATION (FEET)
- EXISTING FENCE
- WETLAND BOUNDARY BY PHOTO INTERPRETATION BY BRA
- WETLAND BOUNDARY PER BRA FLAGGING AND SURVEY BY JOHNSTON SURVEYING INC.
- STORMWATER MANAGEMENT POND
- BORROW AREA BOUNDARY
- PROPOSED FENCE
- PIEZOMETER / MONITORING WELL LOCATION
- PIEZOMETER / MONITORING WELL LOCATION (REMOVED)
- SHELL ZONE WELL LOCATION
- GROUNDWATER MONITORING WELL TOP OF CONCRETE PAD BENCHMARK
- GROUNDWATER MONITORING WELL CLUSTER

- NOTES:
- NORTHING AND EASTING COORDINATES SHOWN REPRESENT FLORIDA STATE PLANE EAST ZONE NORTH AMERICAN DATUM OF 1983 (NAD83).
 - THE ELEVATIONS SHOWN REPRESENT NATIONAL GEODETIC VERTICAL DATUM OF 1929 (NGVD29)(FEET).
 - PROPOSED GRADING IS SHOWN IN THE BACKGROUND TO ILLUSTRATE MONITORING WELL LOCATIONS RELATIVE TO LANDFILL.

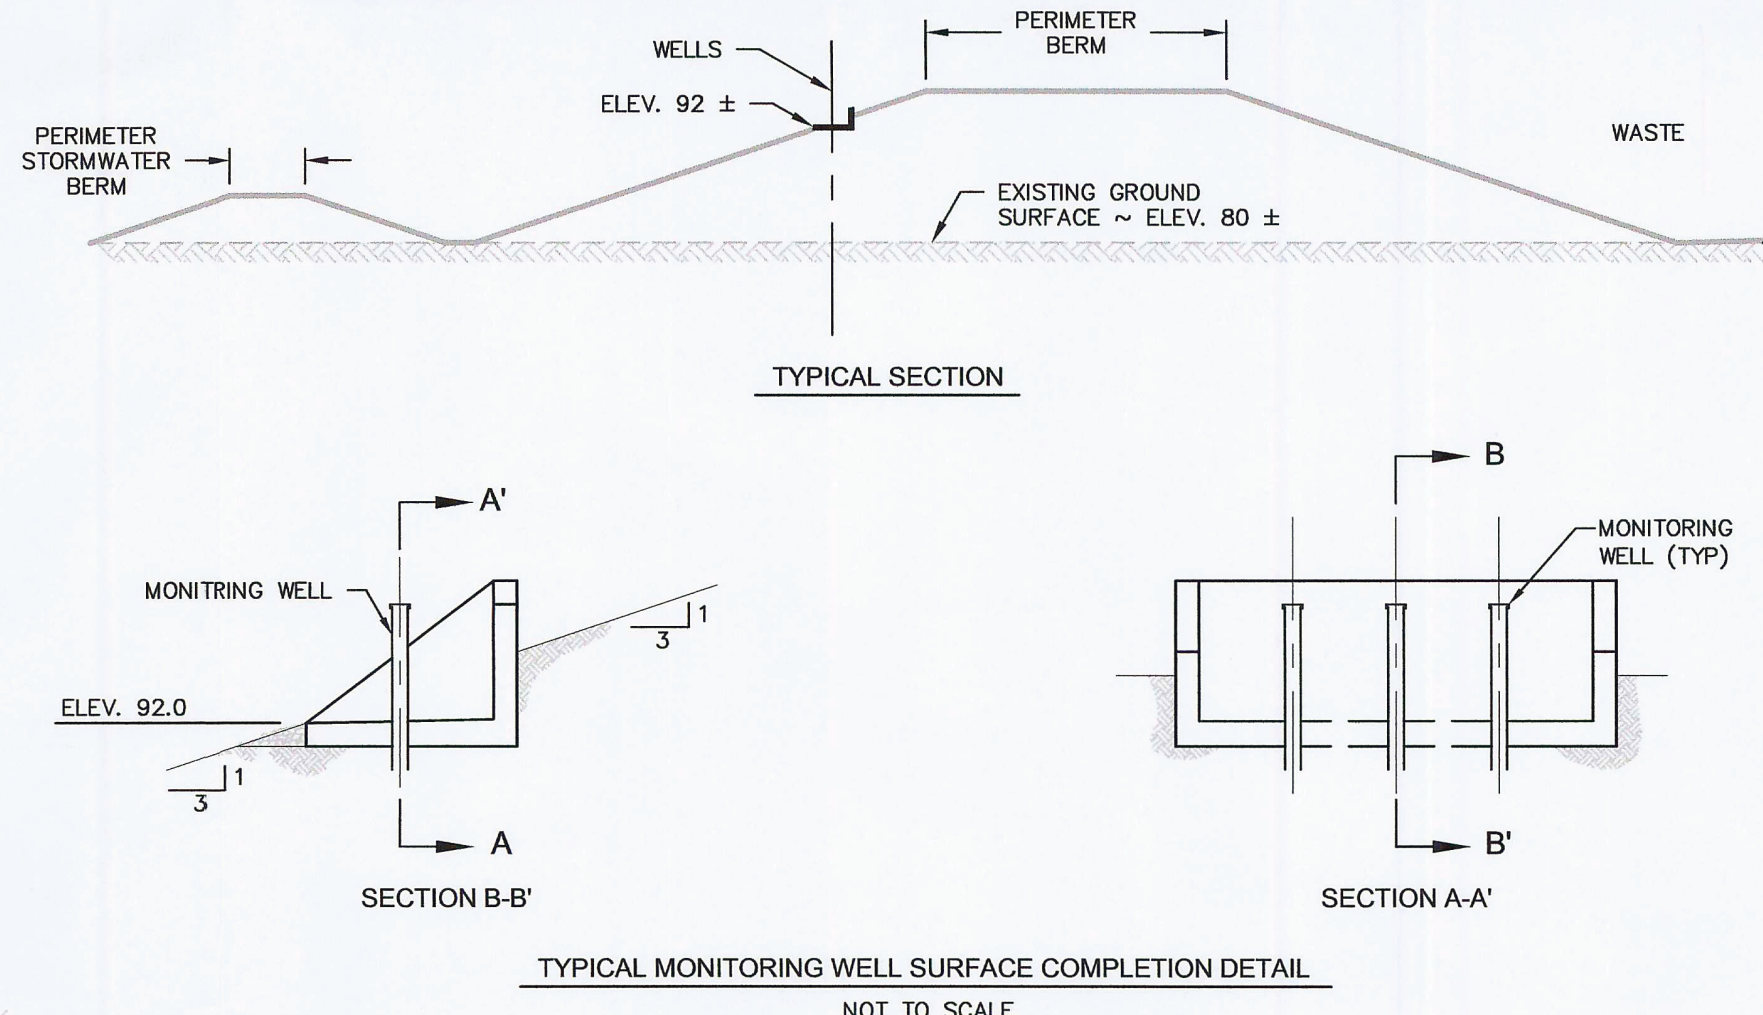

SITE INVESTIGATION GROUNDWATER MONITORING WELLS			
Description	Northing	Easting	Elevation (TOC)
DP-1			Piezometer Abandoned 03 October 2003
DP-2			Piezometer Abandoned 03 October 2003
DP-3			Piezometer Abandoned 16 January 2006
DP-4			Piezometer Abandoned 16 January 2006
DP-5	1,355,353.25	624,128.08	84.13
DP-6	1,355,356.37	624,125.45	84.23
DP-7	1,355,177.88	625,941.53	82.63
DP-8	1,355,182.23	625,941.31	82.78
DP-9	1,354,970.41	626,691.23	81.58
DP-10	1,354,970.16	626,687.84	81.59
DP-11	1,354,609.00	625,190.27	84.06
DP-12	1,354,604.52	625,187.66	84.18
DP-13	1,354,519.86	626,168.29	83.09
DP-14	1,354,321.35	626,873.19	81.97
DP-15	1,354,318.16	626,873.34	81.98
DP-16	1,354,048.17	626,132.23	82.57
DP-17	1,354,047.58	626,135.33	82.58
DP-18	1,353,592.44	624,195.90	84.38
DP-19	1,353,596.07	624,200.39	84.34
DP-22	1,353,637.77	627,171.49	81.00
DP-23	1,353,641.31	627,170.88	81.27
DP-24	1,353,736.22	626,342.40	82.22
SZ-1	1,355,170.25	625,942.43	82.43
SZ-3	1,353,629.43	627,175.45	81.27

PHASE I				
Description	Northing	Easting	Elevation (TOC)	Wacs ID
MW 1A	1,355,798.49	623,926.46	95.12	19900
MW 1B	1,355,802.59	623,926.20	95.00	19901
MW 1C	1,355,806.37	623,926.66	95.18	19902
MW 2A	1,356,145.78	623,925.58	95.21	19903
MW 2B	1,356,141.26	623,925.71	95.17	19904
MW 2C	1,356,137.51	623,925.87	95.32	19905
MW 3A	1,356,484.95	623,925.16	94.64	19906
MW 3B	1,356,481.57	623,925.19	94.68	19907
MW 3C	1,356,478.10	623,925.17	94.66	19908
MW 4A	1,356,851.54	623,924.06	95.48	19909
MW 4B	1,356,855.01	623,924.07	95.18	19910
MW 4C	1,356,858.61	623,924.22	95.39	19911
MW 5A	1,357,250.20	623,921.86	95.32	19912
MW 5B	1,357,245.88	623,922.02	95.30	19913
MW 5C	1,357,241.29	623,922.25	95.39	19914
MW 6A	1,357,611.54	623,994.19	94.72	19915
MW 6B	1,357,609.34	623,990.94	94.60	19916
MW 6C	1,357,607.07	623,987.86	94.58	19917
MW 7A	1,357,674.42	624,385.52	95.48	19918
MW 7B	1,357,674.51	624,382.31	95.27	19919
MW 7C	1,357,674.43	624,378.32	94.93	19920
MW 8A	1,357,580.31	624,756.36	94.67	19921
MW 8B	1,357,579.19	624,759.97	94.58	19922
MW 8C	1,357,577.70	624,764.25	94.50	19923
MW 9A	1,357,392.41	625,117.91	94.66	19924
MW 9B	1,357,389.45	625,121.09	94.63	19925
MW 9C	1,357,386.99	625,123.87	94.54	19926
MW 10A	1,356,981.53	625,281.78	95.25	19927
MW 10B	1,356,987.91	625,283.13	95.23	19928
MW 10C	1,356,954.76	625,284.09	96.36	19929
MW 11A	1,356,492.64	625,415.70	93.56	19930
MW 11B	1,356,489.00	625,415.84	93.59	19931
MW 11C	1,356,485.39	625,415.96	93.65	19932
MW 12A	1,356,153.77	625,415.64	95.10	19933
MW 12B	1,356,150.78	625,415.56	95.01	19934
MW 12C	1,356,147.27	625,415.63	95.10	19935
MW 13A	1,355,810.14	625,416.90	95.19	19936
MW 13B	1,355,806.36	625,417.25	95.12	19937
MW 13C	1,355,802.61	625,417.08	95.04	19938
MW 14A	1,355,766.25	624,926.84	85.88	19939
MW 14B	1,355,766.18	624,923.22	85.80	19940
MW 14C	1,355,766.01	624,919.45	85.92	19941
MW 15A	1,355,743.48	624,417.00	85.92	19942
MW 15B	1,355,743.72	624,421.11	85.65	19943
MW 15C	1,355,744.15	624,425.40	85.89	19944

SURFACE WATER MONITORING SITES				
Description	Northing	Easting	Elevation	Wacs ID
SW-3	1,358,138.00	623,814.00	-	19945
SW-4	1,352,974.10	631,682.40	-	19946

BENCHMARKS			
Description	Northing	Easting	Elevation
BM PK-1 (MW-1 CLUSTER)	1,355,802.68	623,925.11	92.88
BM PK-2 (MW-2 CLUSTER)	1,356,141.33	623,924.13	93.10
BM BOLT-3 (MW-3 CLUSTER)	1,356,481.71	623,923.83	92.85
BM BOLT-4 (MW-4 CLUSTER)	1,356,855.04	623,922.97	93.14
BM PK-5 (MW-5 CLUSTER)	1,357,246.05	623,920.66	93.41
BM PK-6 (MW-6 CLUSTER)	1,357,610.45	623,990.25	92.93
BM PK-7 (MW-7 CLUSTER)	1,357,675.78	624,382.31	93.51
BM PK-8 (MW-8 CLUSTER)	1,357,580.48	624,760.63	92.24
BM PK-9 (MW-9 CLUSTER)	1,357,390.56	625,121.91	92.74
BM PK-10 (MW-10 CLUSTER)	1,356,985.45	625,284.45	94.09
BM PK-11 (MW-11 CLUSTER)	1,356,489.00	625,417.28	91.73
BM PK-12 (MW-12 CLUSTER)	1,356,150.74	625,417.14	93.26
BM PK-13 (MW-13 CLUSTER)	1,355,806.34	625,418.41	92.92

0 31-MAR-06 ISSUED FOR REPORT

REV. NO. DATE DESCRIPTION DES. BY DR. BY CHK. BY RW. BY APP. BY

PROJECT: PHASE 1 OAK HAMMOCK DISPOSAL FACILITY


TITLE: GROUNDWATER MONITORING NETWORK

Owner/Facility: WSI 1501 OMNI WAY, ST. CLOUD, FLORIDA 34773 TEL: 407-841-3720 FAX: 407-841-3730

Consultant/Engineer: GeoSYNTEC CONSULTANTS 14055 RIVEREDGE DRIVE, SUITE 300, TAMPA, FLORIDA 33637 USA TEL: 813-558-0990 FAX: 813-558-9726 AUTHORIZATION CERTIFICATE NO. 00004321

DATE: 31 MARCH 2006 SCALE: 1" = 200' PROJECT NO.: FQ0884.01 FILE NO.: FQ0884.01F-0004 FIGURE NO.: 1A

SCANNED
SEP 15 2006
FEDERAL
PATY
IN OCULUS

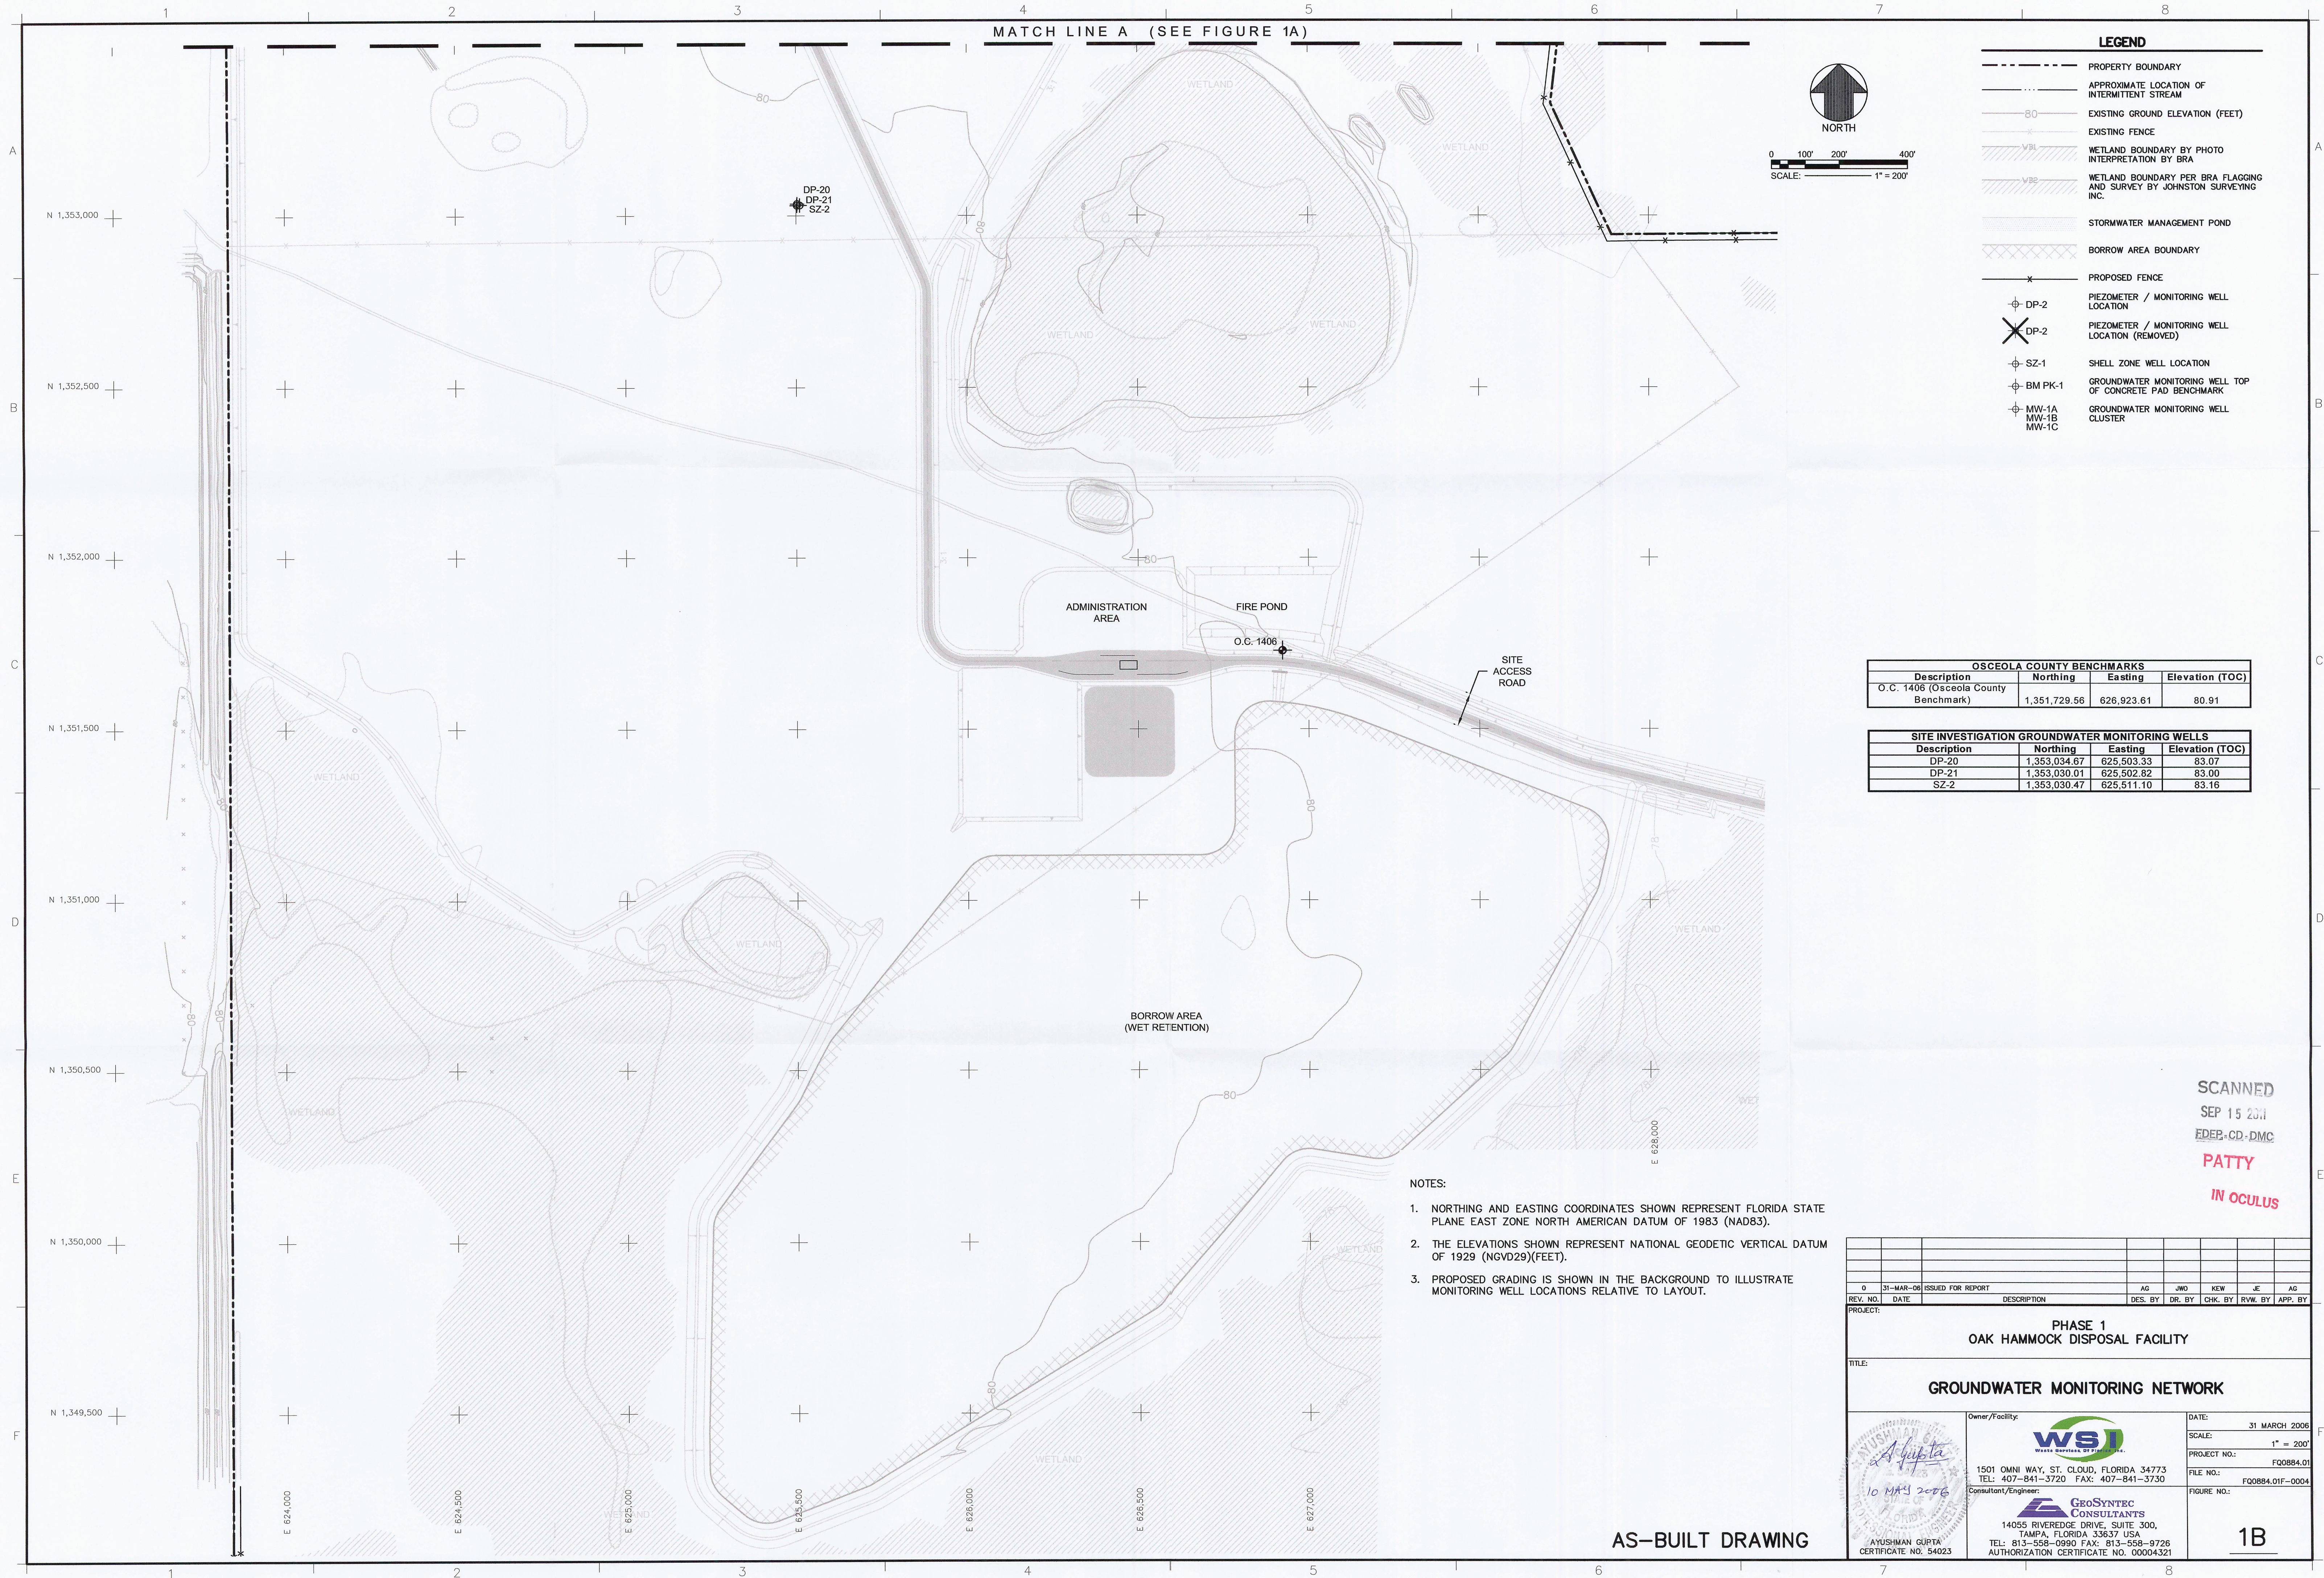

- LEGEND**
- PROPERTY BOUNDARY
 - APPROXIMATE LOCATION OF INTERMITTENT STREAM
 - EXISTING GROUND ELEVATION (FEET)
 - EXISTING FENCE
 - WETLAND BOUNDARY BY PHOTO INTERPRETATION BY BRA
 - WETLAND BOUNDARY PER BRA FLAGGING AND SURVEY BY JOHNSTON SURVEYING INC.
 - STORMWATER MANAGEMENT POND
 - BORROW AREA BOUNDARY
 - PROPOSED FENCE
 - PIEZOMETER / MONITORING WELL LOCATION
 - PIEZOMETER / MONITORING WELL LOCATION (REMOVED)
 - SHELL ZONE WELL LOCATION
 - GROUNDWATER MONITORING WELL TOP OF CONCRETE PAD BENCHMARK
 - GROUNDWATER MONITORING WELL CLUSTER

OSCEOLA COUNTY BENCHMARKS			
Description	Northing	Easting	Elevation (TOC)
O.C. 1406 (Osceola County Benchmark)	1,351,729.56	626,923.61	80.91

SITE INVESTIGATION GROUNDWATER MONITORING WELLS			
Description	Northing	Easting	Elevation (TOC)
DP-20	1,353,034.67	625,503.33	83.07
DP-21	1,353,030.01	625,502.82	83.00
SZ-2	1,353,030.47	625,511.10	83.16

- NOTES:
- NORTHING AND EASTING COORDINATES SHOWN REPRESENT FLORIDA STATE PLANE EAST ZONE NORTH AMERICAN DATUM OF 1983 (NAD83).
 - THE ELEVATIONS SHOWN REPRESENT NATIONAL GEODETIC VERTICAL DATUM OF 1929 (NGVD29)(FEET).
 - PROPOSED GRADING IS SHOWN IN THE BACKGROUND TO ILLUSTRATE MONITORING WELL LOCATIONS RELATIVE TO LAYOUT.

REV. NO.	DATE	DESCRIPTION	DES. BY	DR. BY	CHK. BY	RVW. BY	APP. BY
0	31-MAR-06	ISSUED FOR REPORT					
PROJECT: PHASE 1 OAK HAMMOCK DISPOSAL FACILITY							
TITLE: GROUNDWATER MONITORING NETWORK							
Owner/Facility:		DATE: 31 MARCH 2006		SCALE: 1" = 200'		PROJECT NO.: FQ0884.01	
1501 OMNI WAY, ST. CLOUD, FLORIDA 34773 TEL: 407-841-3720 FAX: 407-841-3730		CONSULTANT/ENGINEER:		14055 RIVEREDGE DRIVE, SUITE 300, TAMPA, FLORIDA 33637 USA TEL: 813-558-0990 FAX: 813-558-9726 AUTHORIZATION CERTIFICATE NO. 00094321		FILE NO.: FQ0884.01F-0004 FIGURE NO.: 1B	

AS-BUILT DRAWING