
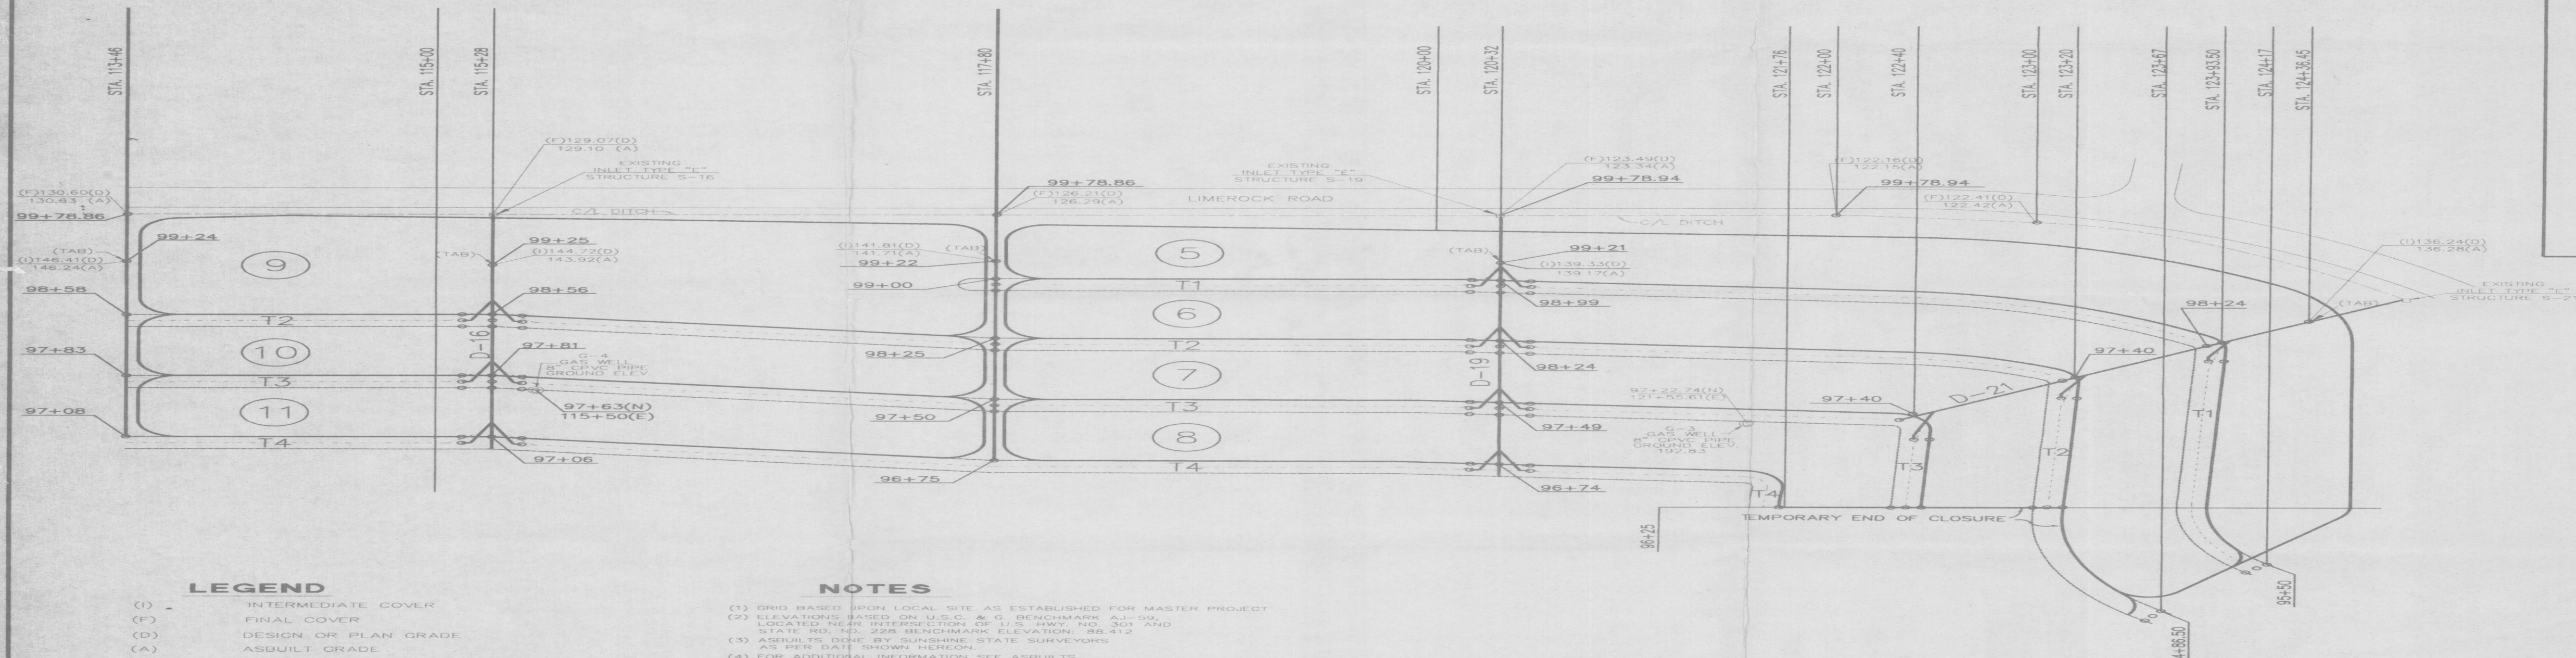


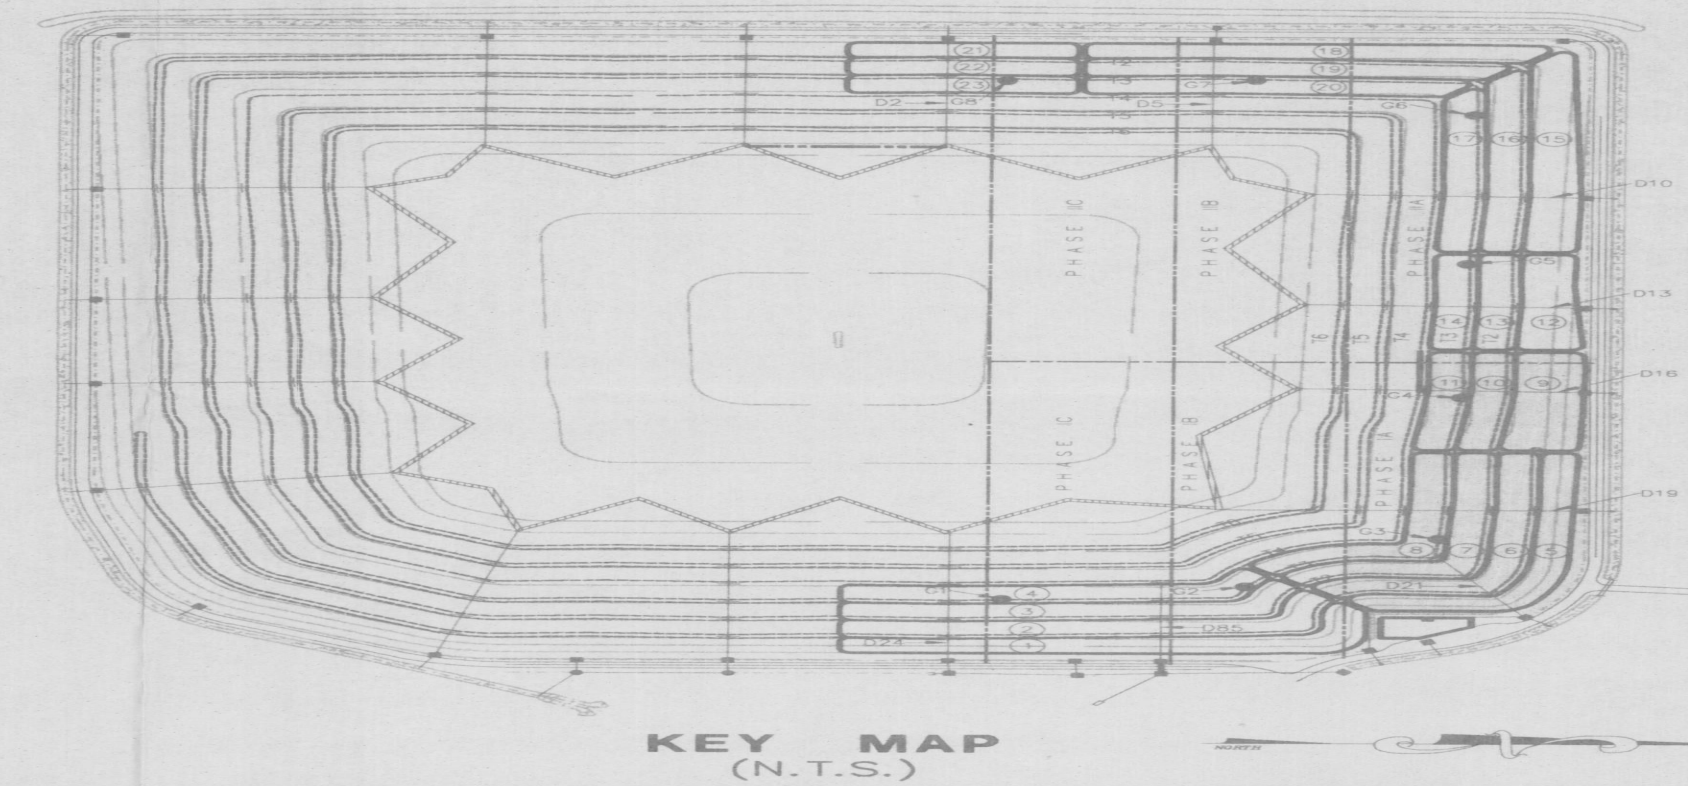

DATE		REVISION		SHEET		F.B. - PG.	
1	8-2-94	ASBUILT FINAL COVER UNITS TO 1 & 11		1	1	1	1
2	8-2-94	ASBUILT FINAL COVER UNITS TO 10 & 11		1	1	1	1
3	8-29-94	ASBUILT INTERMEDIATE COVER UNITS 10 & 11		1	1	1	1
4	8-2-94	ASBUILT INTERMEDIATE COVER UNITS 10 & 11		1	1	1	1
5	8-2-94	ASBUILT INTERMEDIATE COVER UNITS 10 & 11		1	1	1	1
6	1-14-94	ASBUILT FINAL COVER TERRACE 1 & 2		1	1	1	1
7	8-2-94	ASBUILT FINAL COVER TERRACE 1 & 2		1	1	1	1
8	1-5-94	ASBUILT FINAL COVER TERRACE 1		1	1	1	1
9	8-2-94	ASBUILT FINAL COVER TERRACE 1 & 3		1	1	1	1
10	12-12-93	ASBUILT FINAL COVER TERRACE 1 & 2		1	1	1	1
11	8-2-94	ASBUILT INTERMEDIATE COVER UNITS 1 & 2		1	1	1	1
12	10-28-93	ASBUILT INTERMEDIATE COVER UNIT 8		1	1	1	1
13	10-28-93	ASBUILT INTERMEDIATE COVER UNIT 8		1	1	1	1
14	10-28-93	ASBUILT INTERMEDIATE COVER UNIT 8		1	1	1	1
15	8-2-94	APPROVED BEST GROUND SLAB T12 UNIT 6		1	1	1	1
16	8-2-94	APPROVED BEST GROUND SLAB T12 UNIT 6		1	1	1	1

SUNSHINE STATE SURVEYORS, INC. ENGINEERS, SURVEYORS & LAND PLANNERS 3131 ST. JOHN'S BLVD. S.W. SOUTH JACKSONVILLE, FLORIDA 32244		951 84
	NOTE: NOT VALID WITHOUT RAISED DATE 1-5-80 SCALE 1/2"=50' DATE 9/29/83	RECORD CAD 1.1 NON-CODED ORDER NO. 03-181 DRAWN BY: J. R. [Signature] FIELD BOOK: 420 COUNTY: [Blank] DUAL FILE NO. 920-4545
	APPROVED & WITNESSED BY: [Signature] REGISTERED LAND SURVEYOR, STATE OF FLORIDA	[Blank]