



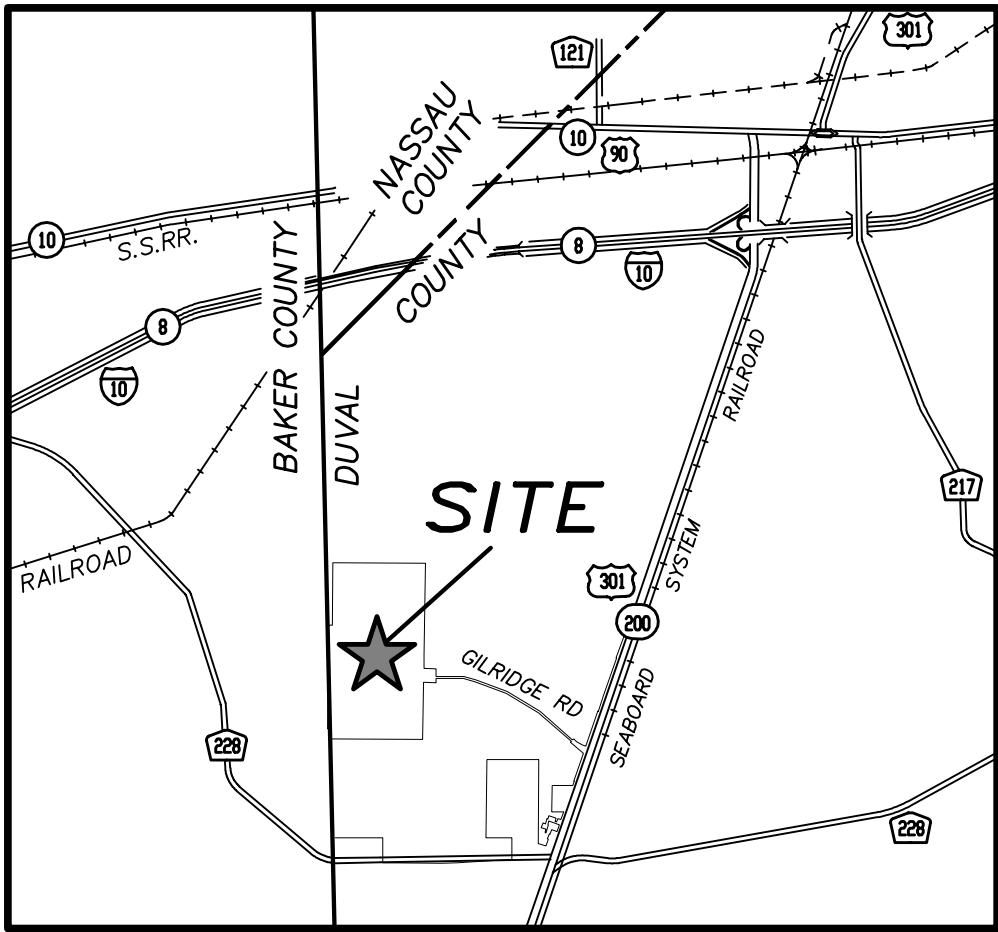


VICINITY MAP
(NOT TO SCALE)

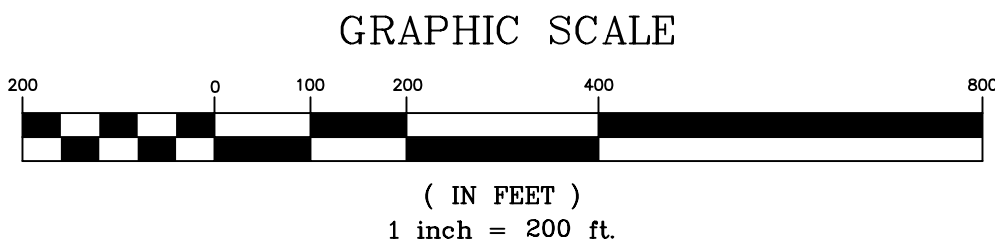

- GENERAL NOTES:
- 1) THE PURPOSE OF THIS SURVEY IS TO DENOTE THE AS-BUILT DATA FOR TRAIL RIDGE LANDFILL INCREMENTAL CLOSURE (CLOSURE PHASE 3) OF THE SIDE SLOPES.
 - 2) THE HORIZONTAL GRID DEPICTED HEREON IS REFERENCED TO A LOCAL DATUM.
 - 3) SOURCE BENCHMARK IS A CONCRETE MONUMENT WITH A U.S. COASTAL AND GEODETIC SURVEY DISK STAMPED "AJ-59", LOCATED ALONG U.S. HIGHWAY No. 301, APPROXIMATELY 800 FEET NORTHERLY OF ITS INTERSECTION WITH STATE ROAD No. 228. PID No. B01401, ELEVATION 88.41 FEET (NATIONAL GEODETIC VERTICAL DATUM 1929).
 - 4) THIS COMPILATION OF AS-BUILT DATA WAS COLLECTED BY THIS FIRM FROM NOVEMBER 2011 THROUGH SEPTEMBER 2012.

AS-BUILT

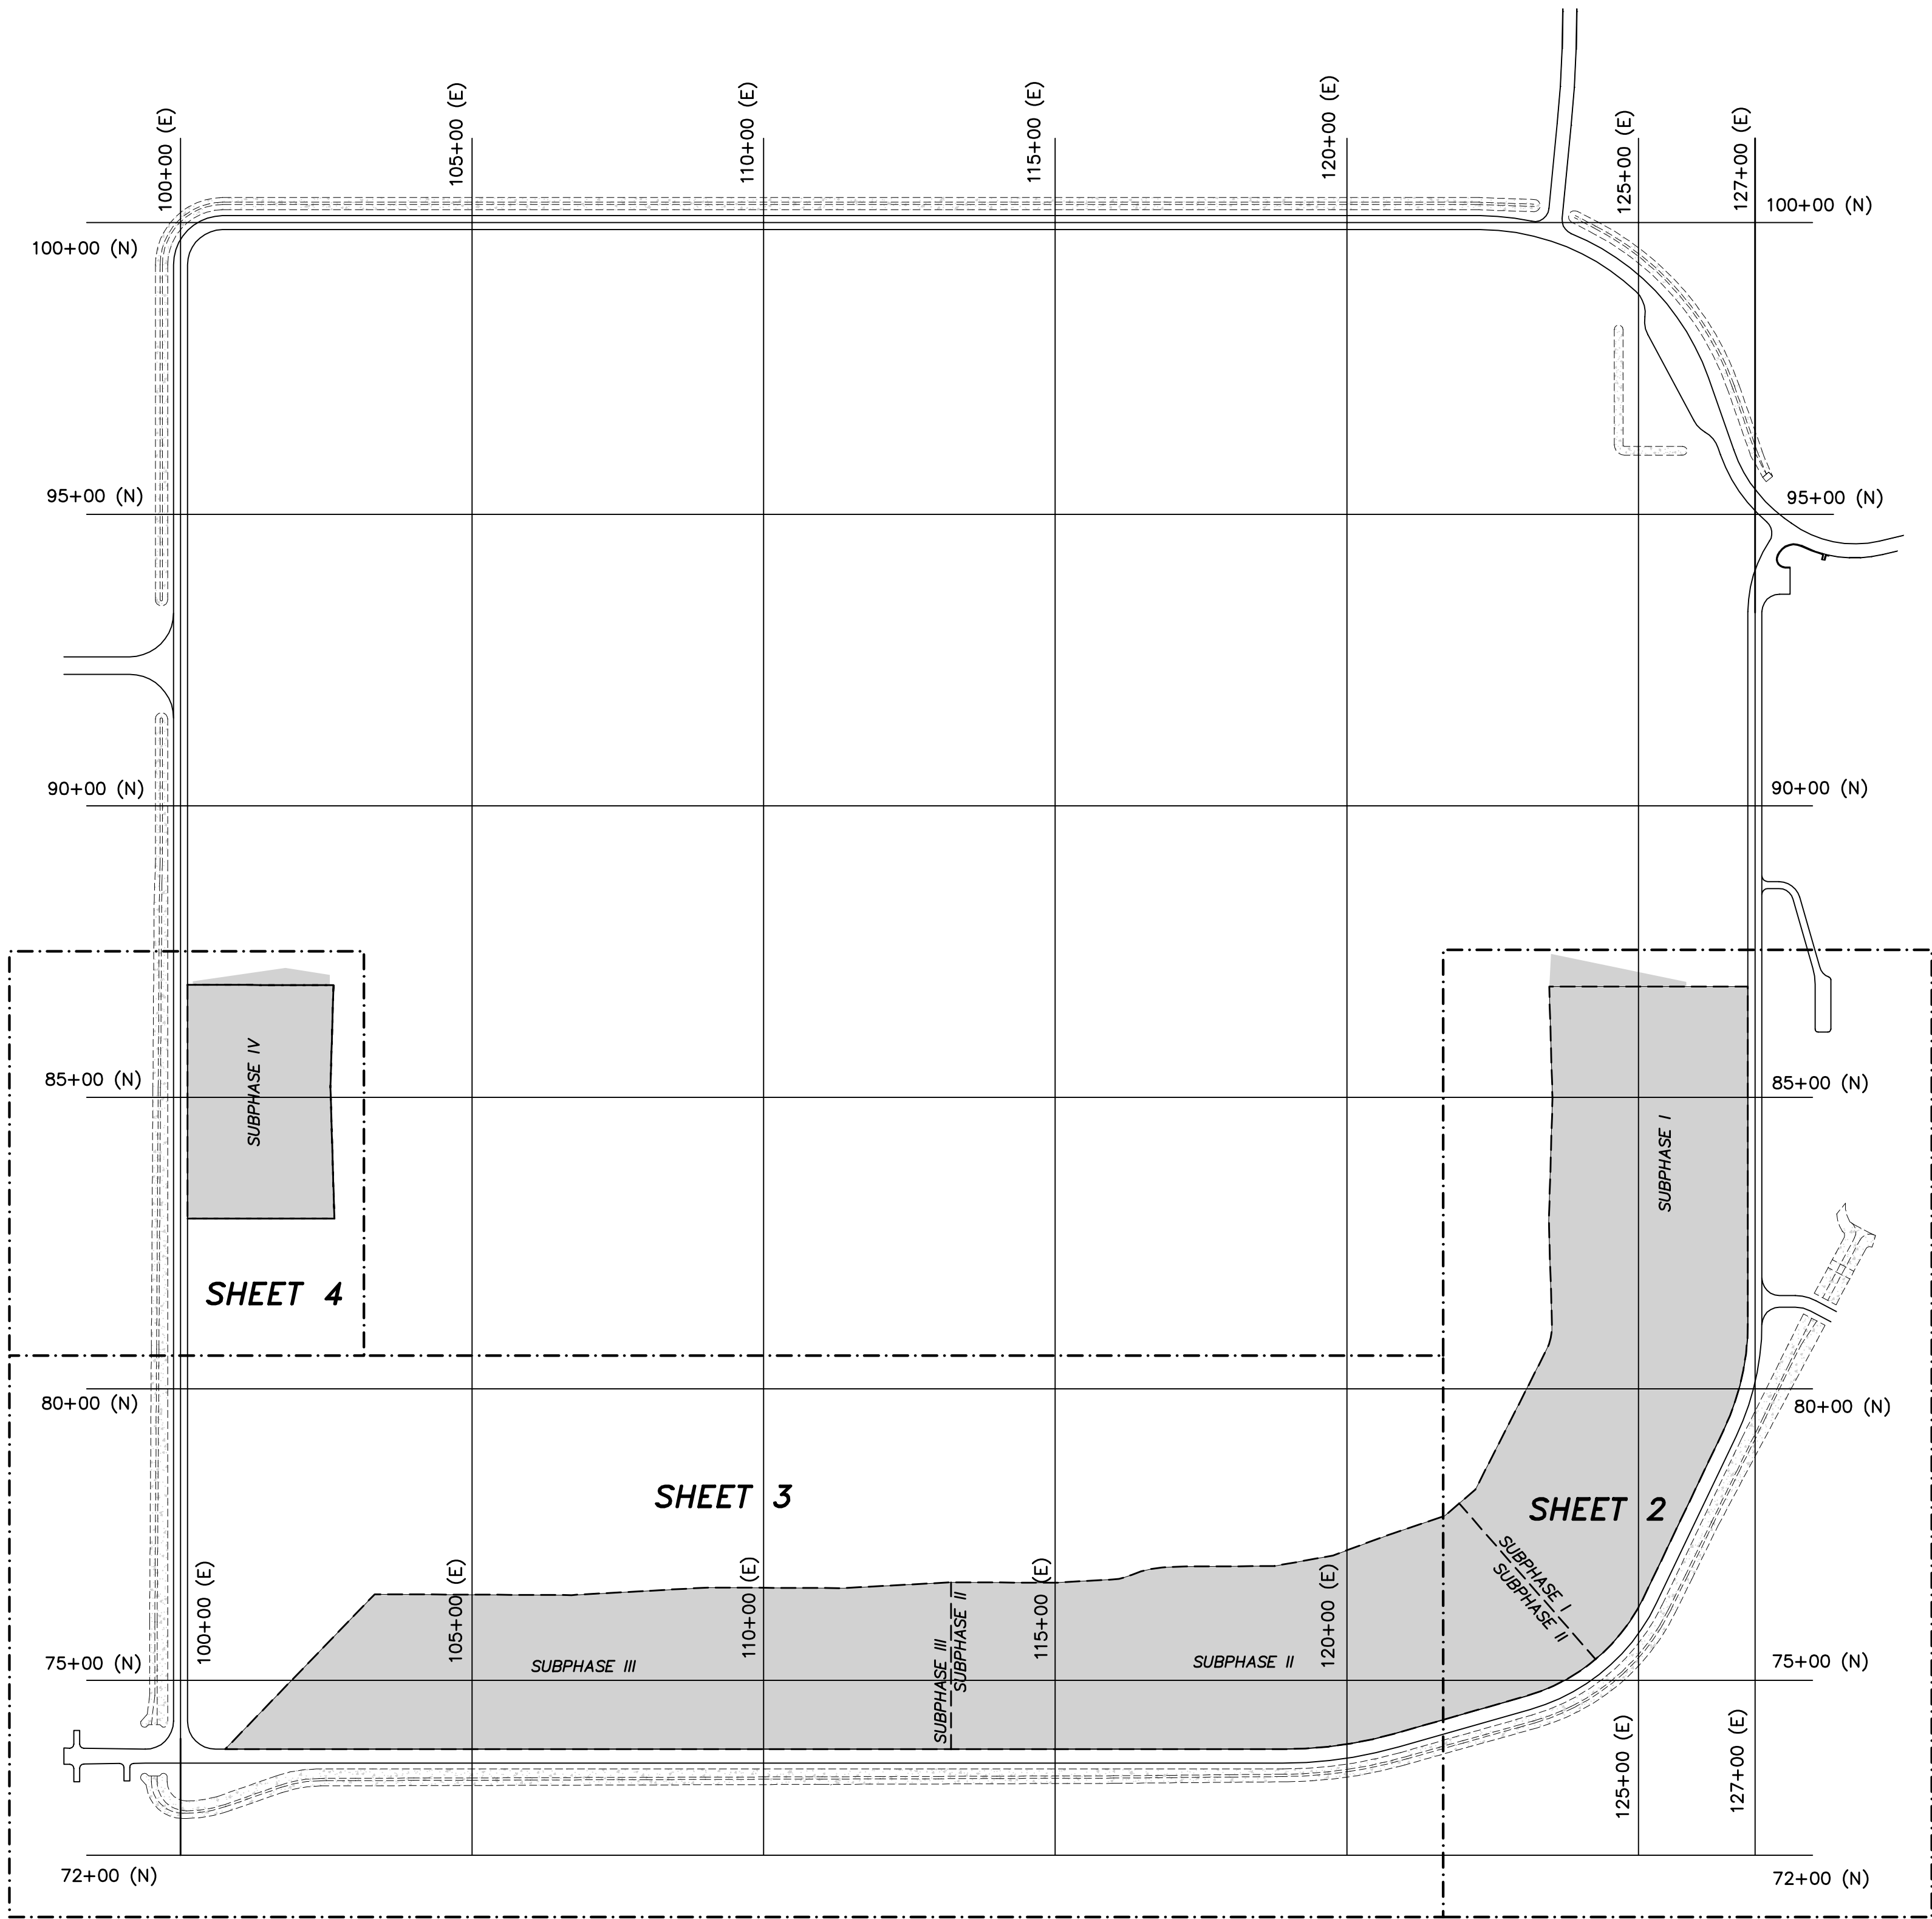

- LEGEND:
- | | |
|---------|------------------------------|
| S-35 | STRUCTURE NUMBER |
| T1 | TERRACE NUMBER |
| D333 | DOWNCOMER PIPE NUMBER |
| --- --- | DOWNCOMER PIPE |
| ① | SLOPE PROFILE NUMBER |
| 39 | SIDE SLOPE UNIT |
| ■ | LIMITS OF SIDE SLOPE CLOSURE |
| ▨ | CLOSED SIDE SLOPE UNIT |



AS-BUILT SURVEY OF
TRAIL RIDGE LANDFILL INCREMENTAL CLOSURE PHASE 3
A PORTION OF SECTION 19, TOWNSHIP 3 SOUTH,
RANGE 23 EAST, DUVAL COUNTY, FLORIDA, ALSO BEING
A PORTION OF THOSE LANDS DESCRIBED AND RECORDED
IN OFFICIAL RECORDS BOOK 7245, PAGE 1751,
OF THE CURRENT PUBLIC RECORDS OF SAID COUNTY.

RMA
ROBERT M. LANGAS ASSOCIATES, INC.
SURVEYORS • PLANNERS • CIVIL ENGINEERS
14775 Old St. Augustine Road, Jacksonville, FL 32258
Tel: 904.766.1665
Fax: 904.766.1665
Certificate of Authorization No.: LB 3624


SHEET
1
OF
4

LEGEND:
S-35 STRUCTURE NUMBER
TI TERRACE NUMBER
D33 DOWNCOMER PIPE NUMBER
T-T DOWNCOMER PIPE
① SLOPE PROFILE NUMBER
39 SIDE SLOPE UNIT
LIMITS OF SIDE SLOPE CLOSURE
CLOSED SIDE SLOPE UNIT

EASTERN SLOPE (CLOSURE CLAY TIE IN)						
DESCRIPTION	LOCATION STATION	TOP OF CLAY				
		DESIGN	AS-BUILT	DATE	DESIGN	AS-BUILT
TERRACE No. 1 TOP	86+98.29 N	125+81.91 E	NA	147.08	8-6-12	
TERRACE No. 1 BOTTOM	86+98.22 N	125+73.86 E	NA	144.56	8-6-12	
TERRACE No. 2 TOP	87+12.63 N	125+07.67 E	NA	163.97	8-6-12	
TERRACE No. 2 BOTTOM	87+13.11N	125+00.04 E	NA	162.92	8-6-12	
TERRACE No. 3 TOP	87+24.78 N	124+33.95 E	NA	180.74	8-6-12	
TERRACE No. 3 BOTTOM	87+26.94 N	124+25.94 E	NA	179.73	8-6-12	
TERRACE No. 4 TOP	87+42.28 N	123+59.33 E	NA	196.76	8-6-12	
TERRACE No. 4 BOTTOM	-	-	NA	-	-	

EASTERN SLOPE (Profile 1-High Point)							
SLOPE PROFILE No.	DESCRIPTION	LOCATION STATION	INITIAL COVER			FINAL COVER	
			DESIGN	AS-BUILT	DATE	DESIGN	AS-BUILT
1	CENTER OF PERIMETER ROAD	86+90 N	126+99.77 E	NA	-	122.00	121.32
1	EDGE OF PERIMETER ROAD	86+90 N	126+87.77 E	NA	-	-	121.60
1	TOE OF PERIMETER SWALE	86+90 N	126+80 E	NA	-	119.10	119.77
1	TOP OF PERIMETER SWALE	86+90 N	126+70 E	NA	-	121.76	123.32
1	TERRACE No. 1 TOP	86+90.00 N	125+78.75 E	148.94	148.86	7-30-12	152.10
1	TERRACE No. 1 BOTTOM	86+90.00 N	125+71.25 E	146.44	146.37	7-30-12	149.60
1	TERRACE No. 2 TOP	86+90.00 N	125+03.75 E	168.94	168.90	7-30-12	172.10
1	TERRACE No. 2 BOTTOM	86+90.00 N	124+96.25 E	166.44	166.44	7-30-12	169.60
1	TERRACE No. 3 TOP	86+90.00 N	124+28.75 E	188.94	188.84	7-30-12	192.10
1	TERRACE No. 3 BOTTOM	86+90.00 N	124+21.25 E	186.44	186.43	7-30-12	189.60
1	TERRACE No. 4 TOP	86+90.00 N	123+53.75 E	208.94	208.89	7-30-12	212.10
1	TERRACE No. 4 BOTTOM	86+90.00 N	123+46.25 E	206.44	206.37	7-30-12	209.60


EASTERN SLOPE (Profile 2-Low Point at Downcomer D-27)							
SLOPE PROFILE No.	DESCRIPTION	LOCATION STATION	INITIAL COVER			FINAL COVER	
			DESIGN	AS-BUILT	DATE	DESIGN	AS-BUILT
2	CENTER OF PERIMETER ROAD	84+80 N	126+99.77 E	NA	-	122.00	121.38
2	EDGE OF PERIMETER ROAD	84+80 N	126+87.77 E	NA	-	-	121.13
2	TOE OF PERIMETER SWALE	84+80 N	126+80 E	NA	-	119.50	119.78
2	TOP OF PERIMETER SWALE	84+80 N	126+70 E	NA	-	121.76	122.65
2	TERRACE No. 1 TOP	84+80.00 N	125+85.05 E	146.84	146.82	7-26-12	150.00
2	TERRACE No. 1 BOTTOM	84+80.00 N	125+77.55 E	144.34	144.32	7-26-12	147.50
2	TERRACE No. 2 TOP	84+80.00 N	125+10.05 E	166.84	166.84	7-26-12	170.00
2	TERRACE No. 2 BOTTOM	84+80.00 N	125+02.55 E	164.34	164.33	7-26-12	167.50
2	TERRACE No. 3 TOP	84+80.00 N	124+35.05 E	186.84	186.84	7-26-12	190.00
2	TERRACE No. 3 BOTTOM	84+80.00 N	124+27.55 E	184.34	184.32	7-26-12	187.50
2	TERRACE No. 4 TOP	84+80.00 N	123+60.05 E	206.84	206.84	7-26-12	210.00
2	TERRACE No. 4 BOTTOM	84+80.00 N	123+52.55 E	204.34	204.32	7-26-12	207.50

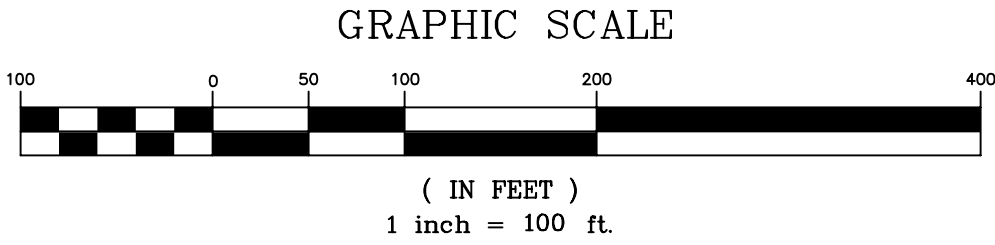

EASTERN SLOPE (Profile 3-High Point)									
SLOPE PROFILE No.	DESCRIPTION	LOCATION STATION	INITIAL COVER			FINAL COVER			
			DESIGN	AS-BUILT	DATE	DESIGN	AS-BUILT	DATE	DATE
3	CENTER OF PERIMETER ROAD	82+41 N	126+99.77 E	NA	-	122.00	121.72	9-26-12	
3	EDGE OF PERIMETER ROAD	82+42 N	126+87.77 E	NA	-	-	121.49	9-26-12	
3	TOE OF PERIMETER SWALE	82+43 N	126+80 E	NA	-	118.80	119.96	9-26-12	
3	TOP OF PERIMETER SWALE	82+45 N	126+70 E	NA	-	121.76	121.78	9-26-12	
3	TERRACE No. 1 TOP	82+56.39 N	125+77.99 E	149.24	149.24	4-26-12	152.40	152.38	7-30-12
3	TERRACE No. 1 BOTTOM	82+57.44 N	125+70.42 E	146.74	146.80	4-26-12	149.90	149.88	7-30-12
3	TERRACE No. 2 TOP	82+66.04 N	125+03.21 E	169.14	169.14	4-26-12	172.30	172.28	7-30-12
3	TERRACE No. 2 BOTTOM	82+67.00 N	124+95.67 E	166.64	166.67	4-26-12	169.80	169.76	7-30-12
3	TERRACE No. 3 TOP	82+75.59 N	124+28.54 E	189.04	189.10	4-26-12	192.20	192.11	7-30-12
3	TERRACE No. 3 BOTTOM	82+76.58 N	124+21.04 E	186.54	186.63	4-26-12	189.70	189.63	7-30-12
3	TERRACE No. 4 TOP	82+85.19 N	123+53.87 E	208.94	208.99	4-26-12	212.10	212.02	7-30-12
3	TERRACE No. 4 BOTTOM	82+86.12 N	123+46.29 E	206.44	206.49	4-26-12	209.60	209.58	7-30-12

EASTERN SLOPE (Profile 4-Low Point at Downcomer D-33)									
SLOPE PROFILE No.	DESCRIPTION	LOCATION STATION	INITIAL COVER			FINAL COVER			
			DESIGN	AS-BUILT	DATE	DESIGN	AS-BUILT	DATE	DATE
4	CENTER OF PERIMETER ROAD	79+99 N	126+84 E	NA	-	122.00	121.60	9-26-12	
4	EDGE OF PERIMETER ROAD	80+01 N	126+72 E	NA	-	-	121.32	9-26-12	
4	TOE OF PERIMETER SWALE	80+02 N	126+64 E	NA	-	118.80	118.57	9-26-12	
4	TOP OF PERIMETER SWALE	80+06 N	126+55 E	NA	-	121.76	121.36	9-26-12	
4	TERRACE No. 1 TOP	80+26.50 N	125+72.06 E	146.84	146.87	4-11-12	150.00	-	-
4	TERRACE No. 1 TOP S.	80+03 N	125+64 E	25 FOOT OFFSETS (DUE TO DOWNCOMER)			150.25	150.18	7-26-12
4	TERRACE No. 1 TOP N.	80+59 N	125+78 E	25 FOOT OFFSETS (DUE TO DOWNCOMER)			150.25	150.19	7-26-12
4	TERRACE No. 1 BOTTOM	80+28.39 N	125+64.63 E	144.34	144.34	4-11-12	147.50	-	-
4	TERRACE No. 1 BOTTOM S.	80+05 N	125+57 E	25 FOOT OFFSETS (DUE TO DOWNCOMER)			147.75	147.75	7-26-12
4	TERRACE No. 1 BOTTOM N.	80+53 N	125+70 E	25 FOOT OFFSETS (DUE TO DOWNCOMER)			147.75	147.71	7-26-12
4	TERRACE No. 2 TOP	80+45.05 N	124+97.25 E	166.84	166.86	4-11-12	170.00	-	-
4	TERRACE No. 2 TOP S.	80+21 N	124+90 E	25 FOOT OFFSETS (DUE TO DOWNCOMER)			170.25	170.18	7-26-12
4	TERRACE No. 2 TOP N.	80+70 N	125+02 E	25 FOOT OFFSETS (DUE TO DOWNCOMER)			170.25	170.24	7-26-12
4	TERRACE No. 2 BOTTOM	80+46.86 N	124+90.10 E	164.34	164.42	4-11-12	167.50	-	-
4	TERRACE No. 2 BOTTOM S.	80+23 N	124+82 E	25 FOOT OFFSETS (DUE TO DOWNCOMER)			167.75	167.71	7-26-12
4	TERRACE No. 2 BOTTOM N.	80+71 N	124+95 E	25 FOOT OFFSETS (DUE TO DOWNCOMER)			167.75	167.69	7-26-12
4	TERRACE No. 3 TOP	80+63.54 N	124+22.83 E	186.84	186.85	4-11-12	190.00	-	-
4	TERRACE No. 3 TOP S.	80+40 N	124+14 E	25 FOOT OFFSETS (DUE TO DOWNCOMER)			190.25	190.24	7-26-12
4	TERRACE No. 3 TOP N.	80+88 N	124+27 E	25 FOOT OFFSETS (DUE TO DOWNCOMER)			190.25	190.23	7-26-12
4	TERRACE No. 3 BOTTOM	80+65.43 N	124+15.40 E	184.34	184.41	4-11-12	187.50	-	-
4	TERRACE No. 3 BOTTOM S.	80+42 N	124+06 E	25 FOOT OFFSETS (DUE TO DOWNCOMER)			187.75	187.72	7-26-12
4	TERRACE No. 3 BOTTOM N.	80+90 N	124+20 E	25 FOOT OFFSETS (DUE TO DOWNCOMER)			187.75	187.70	7-26-12
4	TERRACE No. 4 TOP	80+81.95 N	123+48.18 E	206.84	206.87	4-11-12	210.00	-	-
4	TERRACE No. 4 TOP S.	80+59 N	123+38 E	25 FOOT OFFSETS (DUE TO DOWNCOMER)			210.25	210.24	7-26-12
4	TERRACE No. 4 TOP N.	81+06 N	123+52 E	25 FOOT OFFSETS (DUE TO DOWNCOMER)			210.25	210.22	7-26-12
4	TERRACE No. 4 BOTTOM	80+83.90 N	123+40.94 E	204.34	204.38	4-11-12	207.50	-	-
4	TERRACE No. 4 BOTTOM S.	80+61 N	123+31 E	25 FOOT OFFSETS (DUE TO DOWNCOMER)			207.75	207.71	7-26-12
4	TERRACE No. 4 BOTTOM N.	81+09 N	123+44 E	25 FOOT OFFSETS (DUE TO DOWNCOMER)			207.75	207.73	7-26-12

EASTERN SLOPE (Profile 5-High Point)									
SLOPE PROFILE No.	DESCRIPTION	LOCATION STATION	INITIAL COVER			FINAL COVER			
			DESIGN	AS-BUILT	DATE	DESIGN	AS-BUILT	DATE	DATE
5	CENTER OF PERIMETER ROAD	75+27 N	124+35 E	NA	-	123.71	123.41	9-26-12	
5	EDGE OF PERIMETER ROAD	75+36 N	124+27 E	NA	-	-	123.33	9-26-12	
5	TOE OF PERIMETER SWALE	75+37 N	124+20 E	NA	-	120.50	121.29	9-26-12	
5	TOP OF PERIMETER SWALE	75+50 N	124+15 E	NA	-	123.47	124.11	9-26-12	
5	TERRACE No. 1 TOP	76+19.47 N	123+53.67 E	151.34	151.26	4-11-12	154.50	154.50	7-13-12
5	TERRACE No. 1 BOTTOM	76+25.12 N	123+48.73 E	148.84	148.81	4-11-12	152.00	151.99	7-13-12
5	TERRACE No. 2 TOP	76+75.00 N	123+05.04 E	170.94	170.87	4-11-12	174.10	174.05	7-13-12
5	TERRACE No. 2 BOTTOM	76+80.64 N	123+00.10 E	168.44	168.36	4-11-12	171.60	171.57	7-13-12
5	TERRACE No. 3 TOP	77+32.32 N	122+54.84 E	190.44	190.39	4-11-12	193.60	193.51	7-13-12
5	TERRACE No. 3 BOTTOM	77+37.96 N	122+49.90 E	187.94	187.86	4-11-12	191.10	191.09	7-13-12
5	TERRACE No. 4 TOP	77+93.41 N	122+01.34 E	210.14	210.05	4-11-12	213.30	213.23	7-13-12
5	TERRACE No. 4 BOTTOM	77+99.05 N	121+96.40 E	207.64	207.55	4-11-12	210.80	210.80	7-13-12

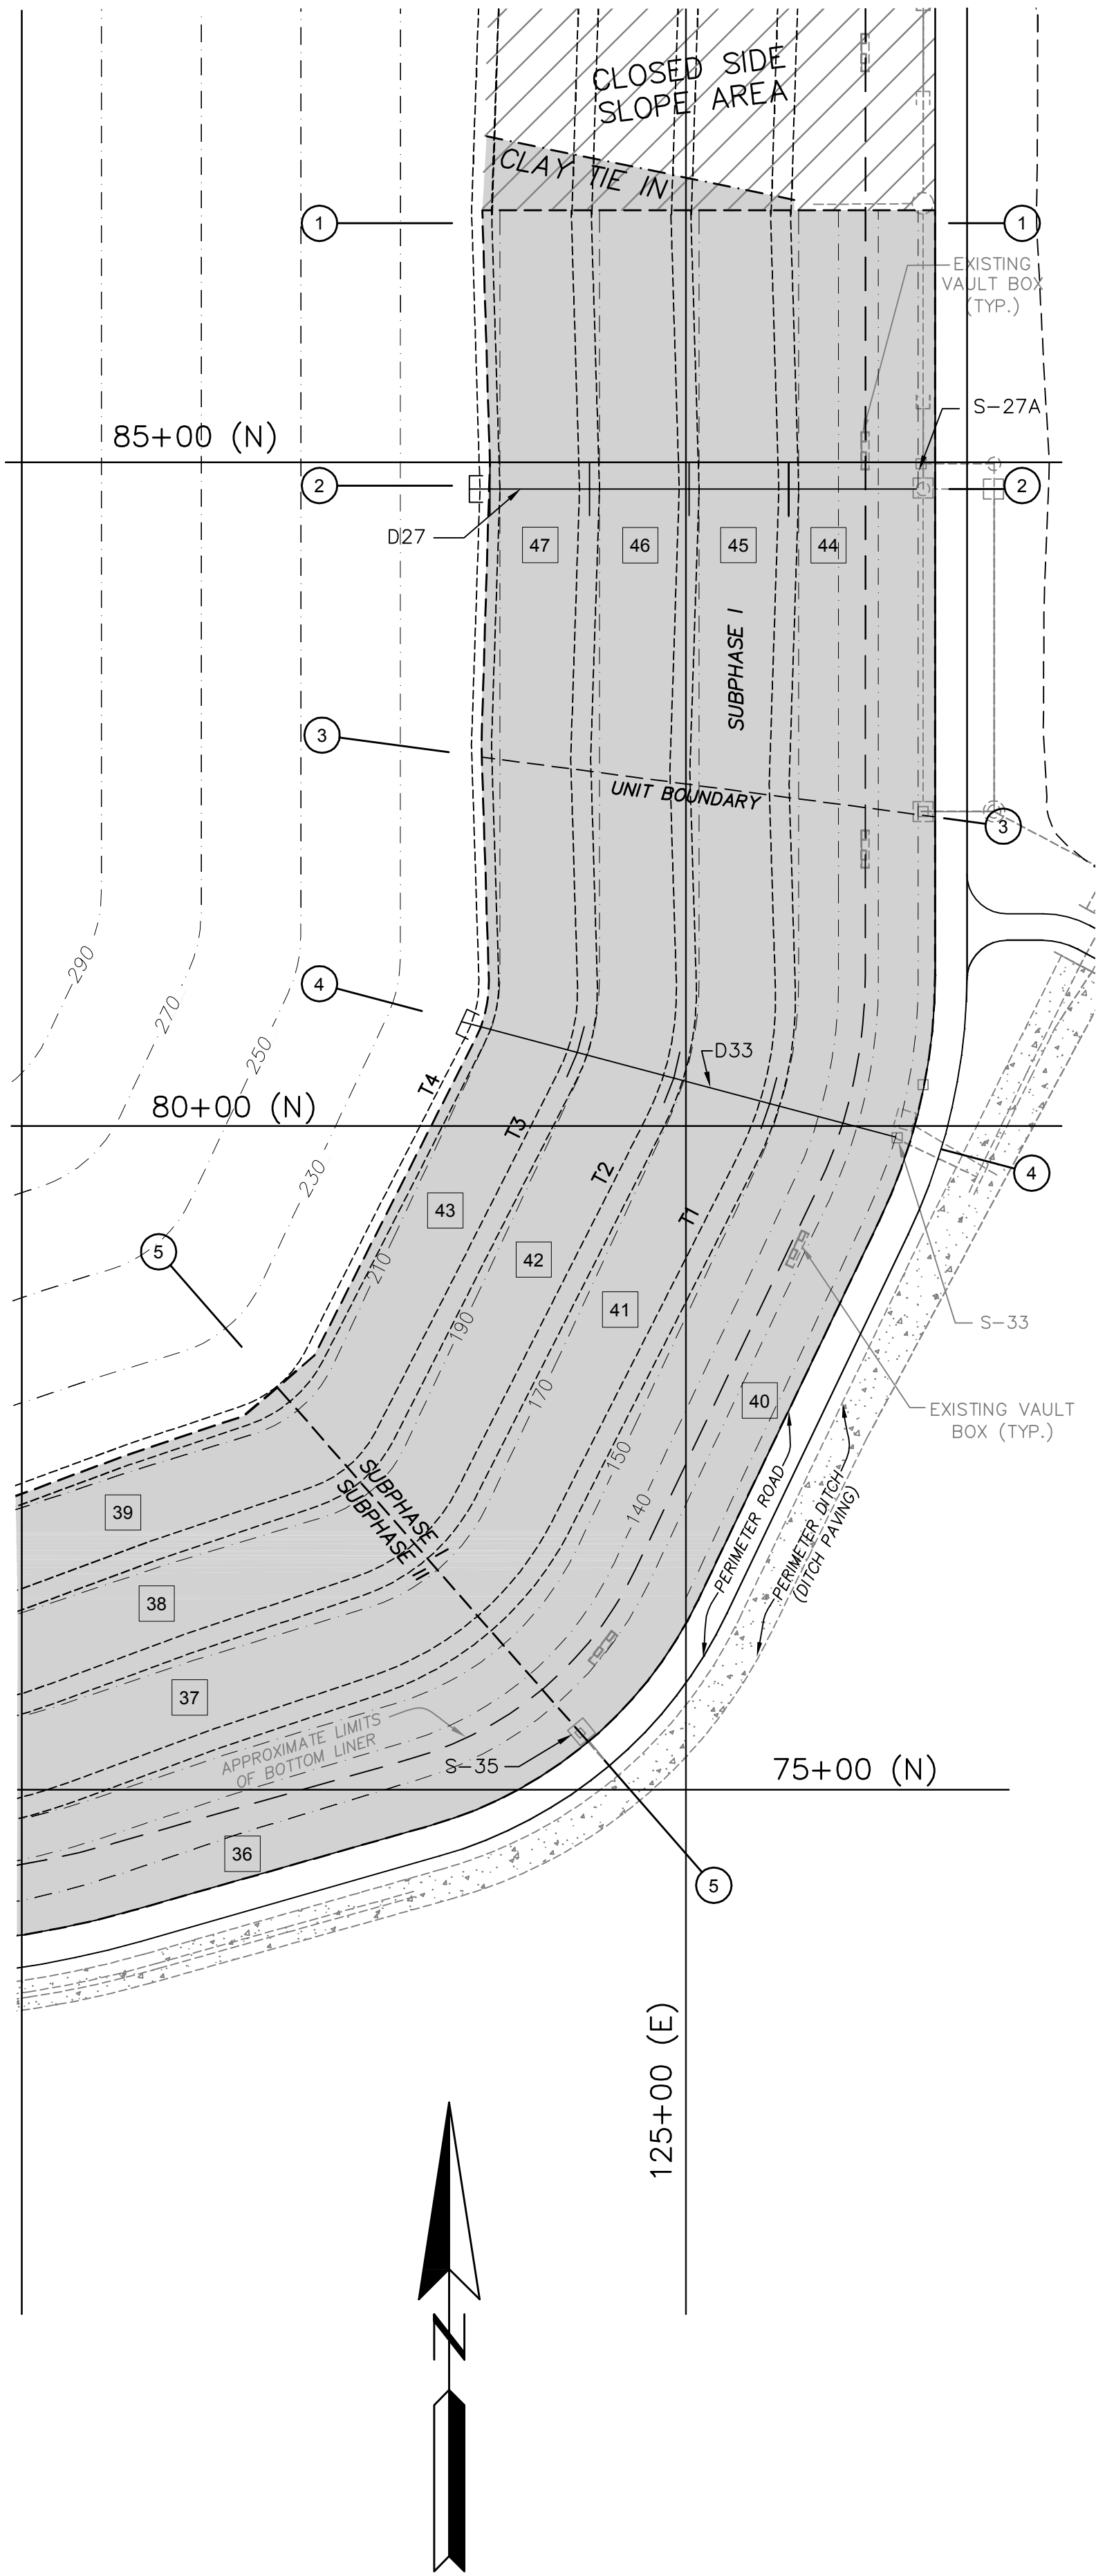

AS-BUILT SURVEY OF
TRAIL RIDGE LANDFILL INCREMENTAL CLOSURE PHASE 3
A PORTION OF SECTION 19, TOWNSHIP 3 SOUTH,
RANGE 23 EAST, DUVAL COUNTY, FLORIDA, ALSO BEING
A PORTION OF THOSE LANDS DESCRIBED AND RECORDED
IN OFFICIAL RECORDS BOOK 7245, PAGE 1751,
OF THE CURRENT PUBLIC RECORDS OF SAID COUNTY.

RMA
ROBERT M. ANGAS ASSOCIATES, INC.
SURVEYORS • PLANNERS • CIVIL ENGINEERS
14775 Old St. Augustine Road, Jacksonville, FL 32258
Tel: 904.766.1100 Fax: 904.766.1105
Certificate of Authorization No. LB 3624



SHEET
2
OF
4

SEE SHEET 1 FOR GENERAL NOTES.

LEGEND:
S-35 STRUCTURE NUMBER
T1 TERRACE NUMBER
D33 DOWNCOMER PIPE NUMBER
--- DOWNCOMER PIPE
① SLOPE PROFILE NUMBER
39 SIDE SLOPE UNIT
LIMITS OF SIDE SLOPE CLOSURE
CLOSED SIDE SLOPE UNIT

WESTERN SLOPE (CLOSURE CLAY TIE IN)					
DESCRIPTION	LOCATION	STATION	TOP OF CLAY		
			DESIGN	AS-BUILT	DATE
TOE OF PERIMETER SWALE	--	--	NA	--	--
TOP OF PERIMETER SWALE	86+92 N	100+94 E	NA	164.52	3-20-12
TERRACE No. 2 TOP	86+92 N	101+03 E	NA	167.79	3-20-12
TERRACE No. 2 BOTTOM	86+92 N	101+12 E	NA	166.28	3-20-12
TERRACE No. 3 TOP	86+90 N	101+77 E	NA	183.55	3-20-12
TERRACE No. 3 BOTTOM	86+90 N	101+87 E	NA	179.42	3-20-12
TERRACE No. 4 TOP	86+93 N	102+53 E	NA	196.63	3-20-12
TERRACE No. 4 BOTTOM	86+88 N	102+61 E	NA	193.00	3-20-12

WESTERN SLOPE (EXISTING TOP SOIL NORTH OF TIE IN)					
DESCRIPTION	LOCATION	STATION	TOP SOIL		
			DESIGN	AS-BUILT	DATE
TOE OF PERIMETER SWALE	86+99 N	100+21 E	NA	144.17	3-20-12
TOP OF PERIMETER SWALE	86+99 N	100+31 E	NA	146.69	3-20-12
TERRACE No. 2 TOP	87+19 N	101+03 E	NA	170.38	3-20-12
TERRACE No. 2 BOTTOM	87+22 N	101+09 E	NA	169.08	3-20-12
TERRACE No. 3 TOP	87+22 N	101+80 E	NA	187.15	3-20-12
TERRACE No. 3 BOTTOM	87+21 N	101+90 E	NA	182.12	3-20-12
TERRACE No. 4 TOP	87+10 N	102+56 E	NA	204.16	3-20-12
TERRACE No. 4 BOTTOM	87+10 N	102+60 E	NA	204.15	3-20-12
TERRACE No. 5 TOP	86+92 N	103+27 E	NA	223.70	3-20-12
TERRACE No. 5 BOTTOM	86+91 N	103+34 E	NA	222.79	3-20-12

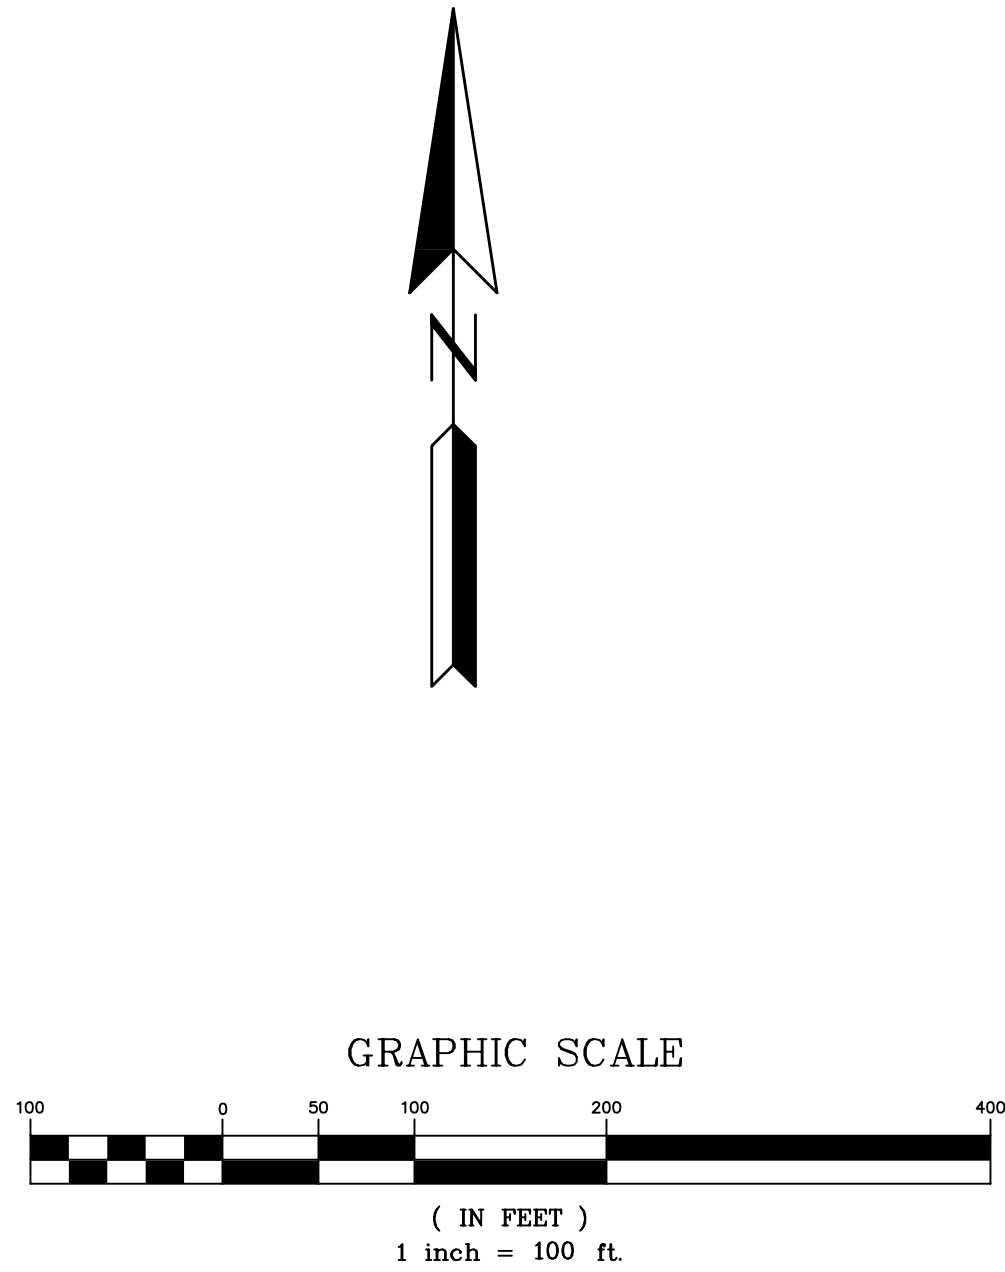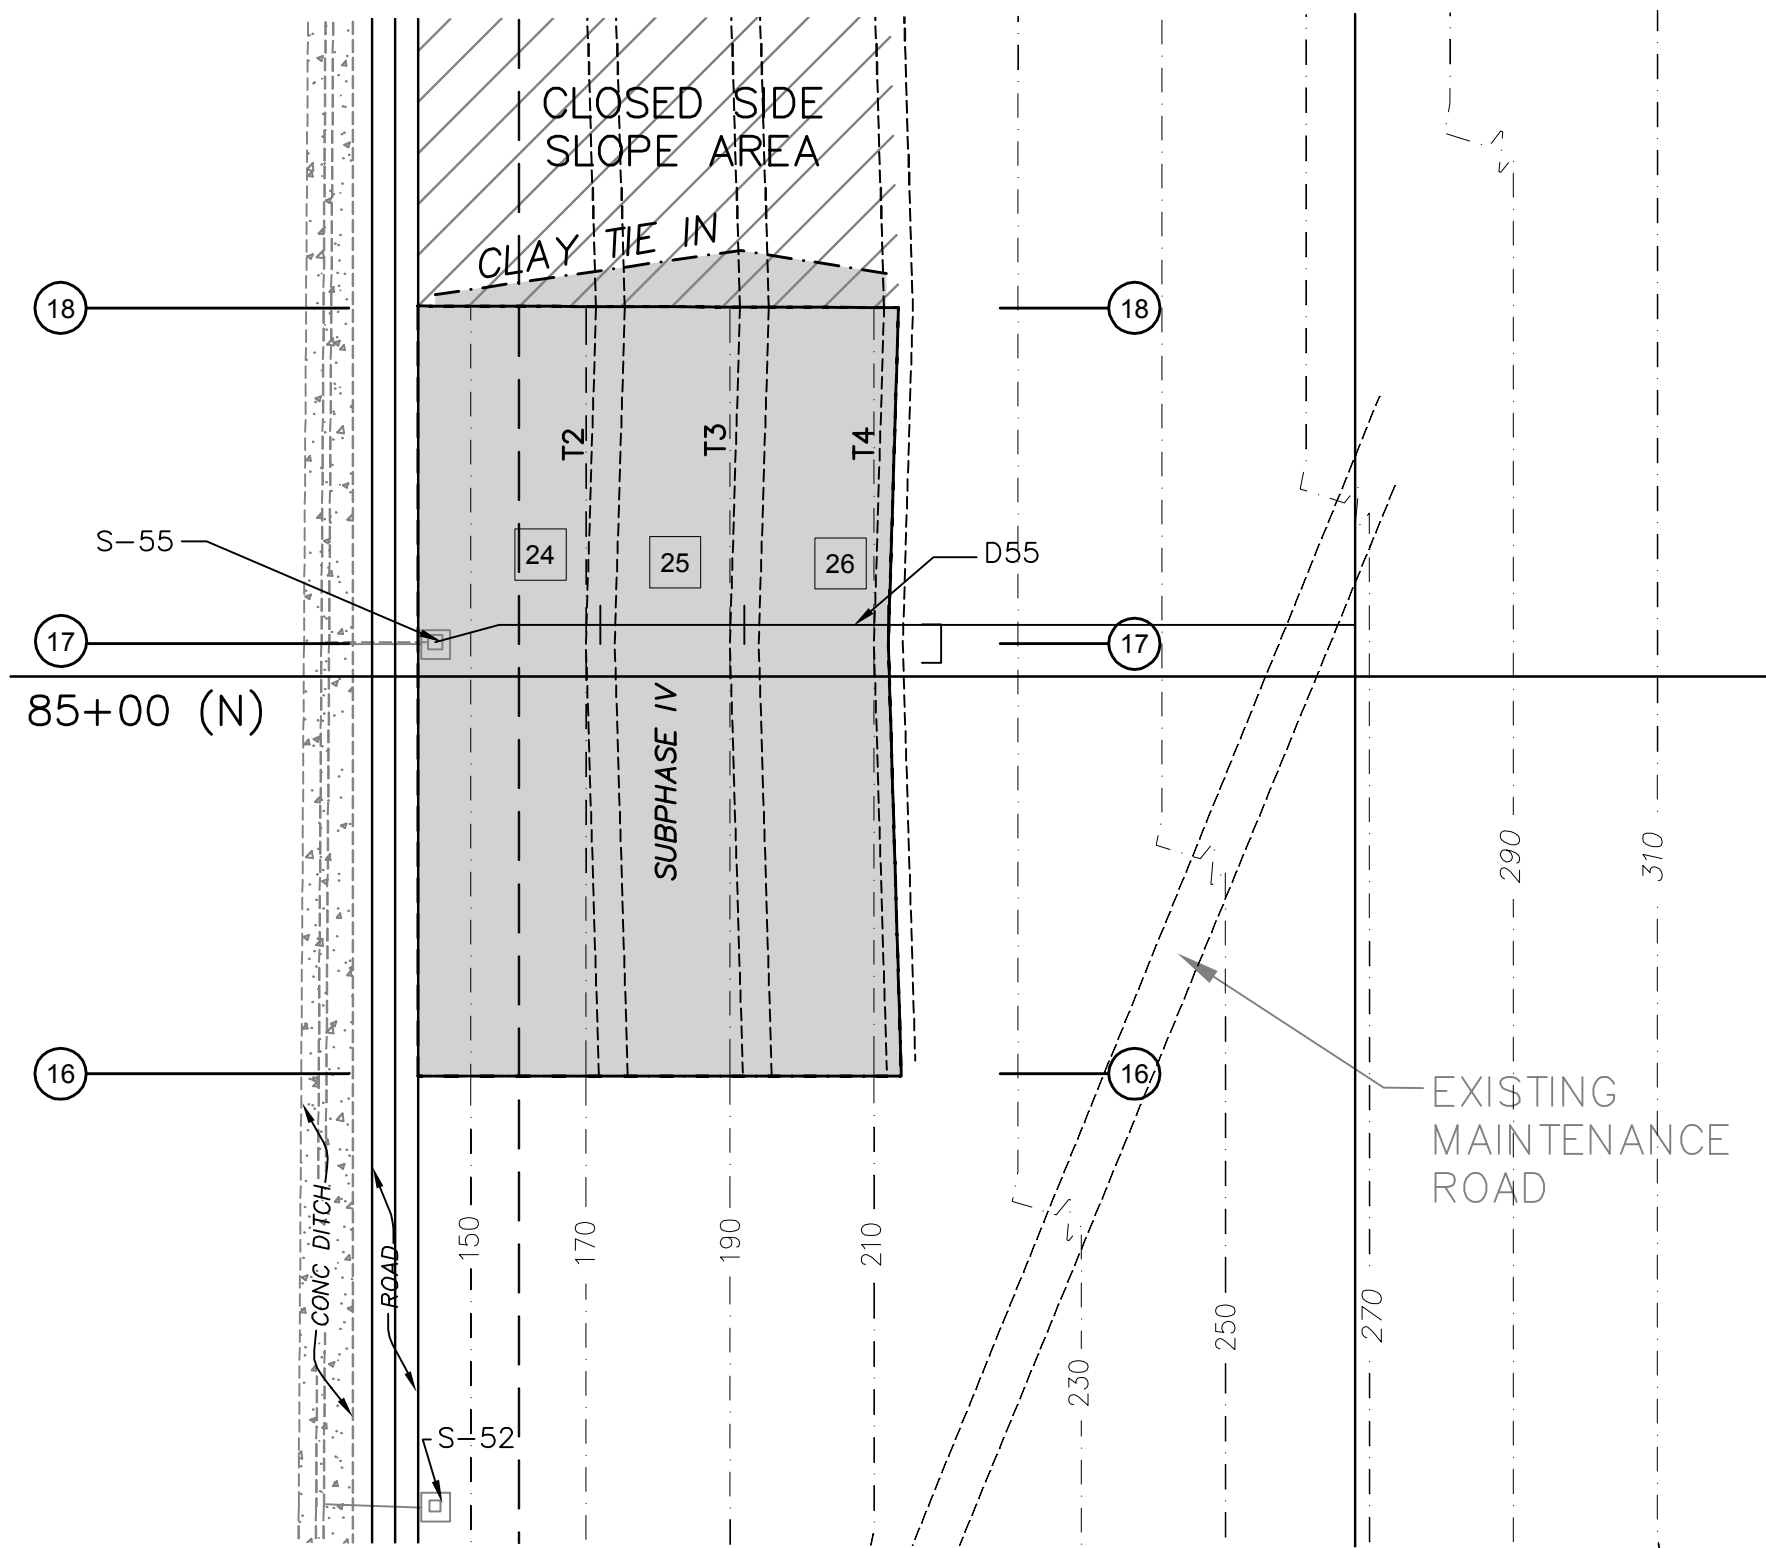

WESTERN SLOPE (Profile 16--High Point)									
SLOPE PROFILE No.	DESCRIPTION	LOCATION	STATION	INITIAL COVER			FINAL COVER		
				DESIGN	AS-BUILT	DATE	DESIGN	AS-BUILT	DATE
16	CENTER OF PERIMETER ROAD	82+92 N	100+00 E	NA	--	--	147.00	146.68	9-26-12
16	EDGE OF PERIMETER ROAD	82+92 N	100+12 E	NA	--	--	--	146.75	9-26-12
16	TOE OF PERIMETER SWALE	82+92 N	100+21 E	NA	--	--	143.90	145.14	9-26-12
16	TOP OF PERIMETER SWALE	82+92 N	100+30 E	NA	--	--	146.76	146.86	9-26-12
16	TERRACE No. 2 TOP	82+92.00 N	101+06.70 E	169.14	169.15	1-31-12	172.30	172.36	5-10-12
16	TERRACE No. 2 BOTTOM	82+92.00 N	101+14.10 E	166.64	166.65	1-31-12	169.80	169.82	5-10-12
16	TERRACE No. 3 TOP	82+92.10 N	101+81.55 E	189.14	189.16	1-31-12	192.30	192.32	5-10-12
16	TERRACE No. 3 BOTTOM	82+91.95 N	101+89.15 E	186.64	186.64	1-31-12	189.80	189.82	5-10-12
16	TERRACE No. 4 TOP	82+92.00 N	102+56.65 E	209.14	209.16	1-31-12	212.30	212.34	5-10-12
16	TERRACE No. 4 BOTTOM	82+92.00 N	102+64.20 E	206.64	206.66	1-31-12	209.80	209.83	5-10-12

WESTERN SLOPE (Profile 17--Lowpoint at Downcomer D-55)									
SLOPE PROFILE No.	DESCRIPTION	LOCATION	STATION	INITIAL COVER			FINAL COVER		
				DESIGN	AS-BUILT	DATE	DESIGN	AS-BUILT	DATE
17	CENTER OF PERIMETER ROAD	85+27 N	100+00 E	NA	--	--	147.00	146.47	9-26-12
17	EDGE OF PERIMETER ROAD	85+27 N	100+12 E	NA	--	--	--	145.82	9-26-12
17	TOE OF PERIMETER SWALE	85+27 N	100+21 E	NA	--	--	143.90	144.00	9-26-12
17	TOP OF PERIMETER SWALE	85+27 N	100+30 E	NA	--	--	146.76	147.18	9-26-12
17	TERRACE No. 2 TOP	85+26.92 N	100+99.68 E	166.84	166.88	1-31-12	170.00	170.02	5-10-12
17	TERRACE No. 2 BOTTOM	85+26.95 N	101+07.25 E	164.34	164.36	1-31-12	167.50	167.55	5-10-12
17	TERRACE No. 3 TOP	85+27.01 N	101+74.75 E	186.84	186.92	1-31-12	190.00	190.01	5-10-12
17	TERRACE No. 3 BOTTOM	85+27.05 N	101+82.25 E	184.34	184.42	1-31-12	187.50	187.50	5-10-12
17	TERRACE No. 4 TOP	85+27.08 N	102+49.75 E	206.84	206.89	1-31-12	210.00	210.01	5-10-12
17	TERRACE No. 4 BOTTOM	85+27.00 N	102+57.25 E	204.34	204.39	1-31-12	207.50	207.60	5-10-12

WESTERN SLOPE (Profile 18--High Point)									
SLOPE PROFILE No.	DESCRIPTION	LOCATION	STATION	INITIAL COVER			FINAL COVER		
				DESIGN	AS-BUILT	DATE	DESIGN	AS-BUILT	DATE
18	CENTER OF PERIMETER ROAD	86+92 N	100+00 E	NA	--	--	147.00	146.56	9-26-12
18	EDGE OF PERIMETER ROAD	86+92 N	100+12 E	NA	--	--	--	146.33	9-26-12
18	TOE OF PERIMETER SWALE	86+92 N	100+21 E	NA	--	--	145.00	144.35	9-26-12
18	TOP OF PERIMETER SWALE	86+92 N	100+30 E	NA	--	--	146.76	146.68	9-26-12
18	TERRACE No. 2 TOP	86+92.00 N	101+05.07 E	168.64	168.65	4-11-12	171.80	171.81	5-10-12
18	TERRACE No. 2 BOTTOM	86+91.92 N	101+12.62 E	166.14	166.22	4-11-12	169.30	169.33	5-10-12
18	TERRACE No. 3 TOP	86+92.00 N	101+80.12 E	188.64	188.65	4-11-12	191.80	191.84	5-10-12
18	TERRACE No. 3 BOTTOM	86+91.95 N	101+87.68 E	186.14	186.19	4-11-12	189.30	189.39	5-10-12
18	TERRACE No. 4 TOP	86+92.07 N	102+55.12 E	208.64	208.67	4-11-12	211.80	211.80	5-10-12
18	TERRACE No. 4 BOTTOM	86+92.00 N	102+62.60 E	206.14	206.21	4-11-12	209.30	209.33	5-10-12

SEE SHEET 1 FOR GENERAL NOTES.

AS-BUILT SURVEY OF
TRAIL RIDGE LANDFILL INCREMENTAL CLOSURE PHASE 3
A PORTION OF SECTION 19, TOWNSHIP 3 SOUTH,
RANGE 23 EAST, DUVAL COUNTY, FLORIDA, ALSO BEING
A PORTION OF THOSE LANDS DESCRIBED AND RECORDED
IN OFFICIAL RECORDS BOOK 7245, PAGE 1751,
OF THE CURRENT PUBLIC RECORDS OF SAID COUNTY.

RMA
ROBERT M. ANKAS ASSOCIATES, INC.
SURVEYORS • PLANNERS • CIVIL ENGINEERS
14775 Old St. Augustine Road, Jacksonville, FL 32258
Tel: 904.766.1655 Fax: 904.766.1656
Certificate of Authorization No.: LB 3624

SHEET
4
OF
4