


- REVISIONS
- A-09/26/92-PRELIMINARY REVIEW & COMMENTS.
  - B-12/04/92-REVISED BOILER AREA, SCRUBBER, SCREW CONVEYORS & APC AREA.
  - C-02/08/93-REVISED APC AREA & SCREW CONVEYORS.
  - D-03/16/93-REVISED CRANE ELEVATION.
  - E-07/15/93-REVISED 987 ISSUE FOR CLIENT REVIEW & COMMENTS.
  - F-07/23/93-REVISED ISSUE FOR CONSTRUCTION.
  - G-10/20/93-REVISED DIM'S, ACCESS LADDERS TO BAGHOUSE.
  - H-02/14/95-RECORD DWG.

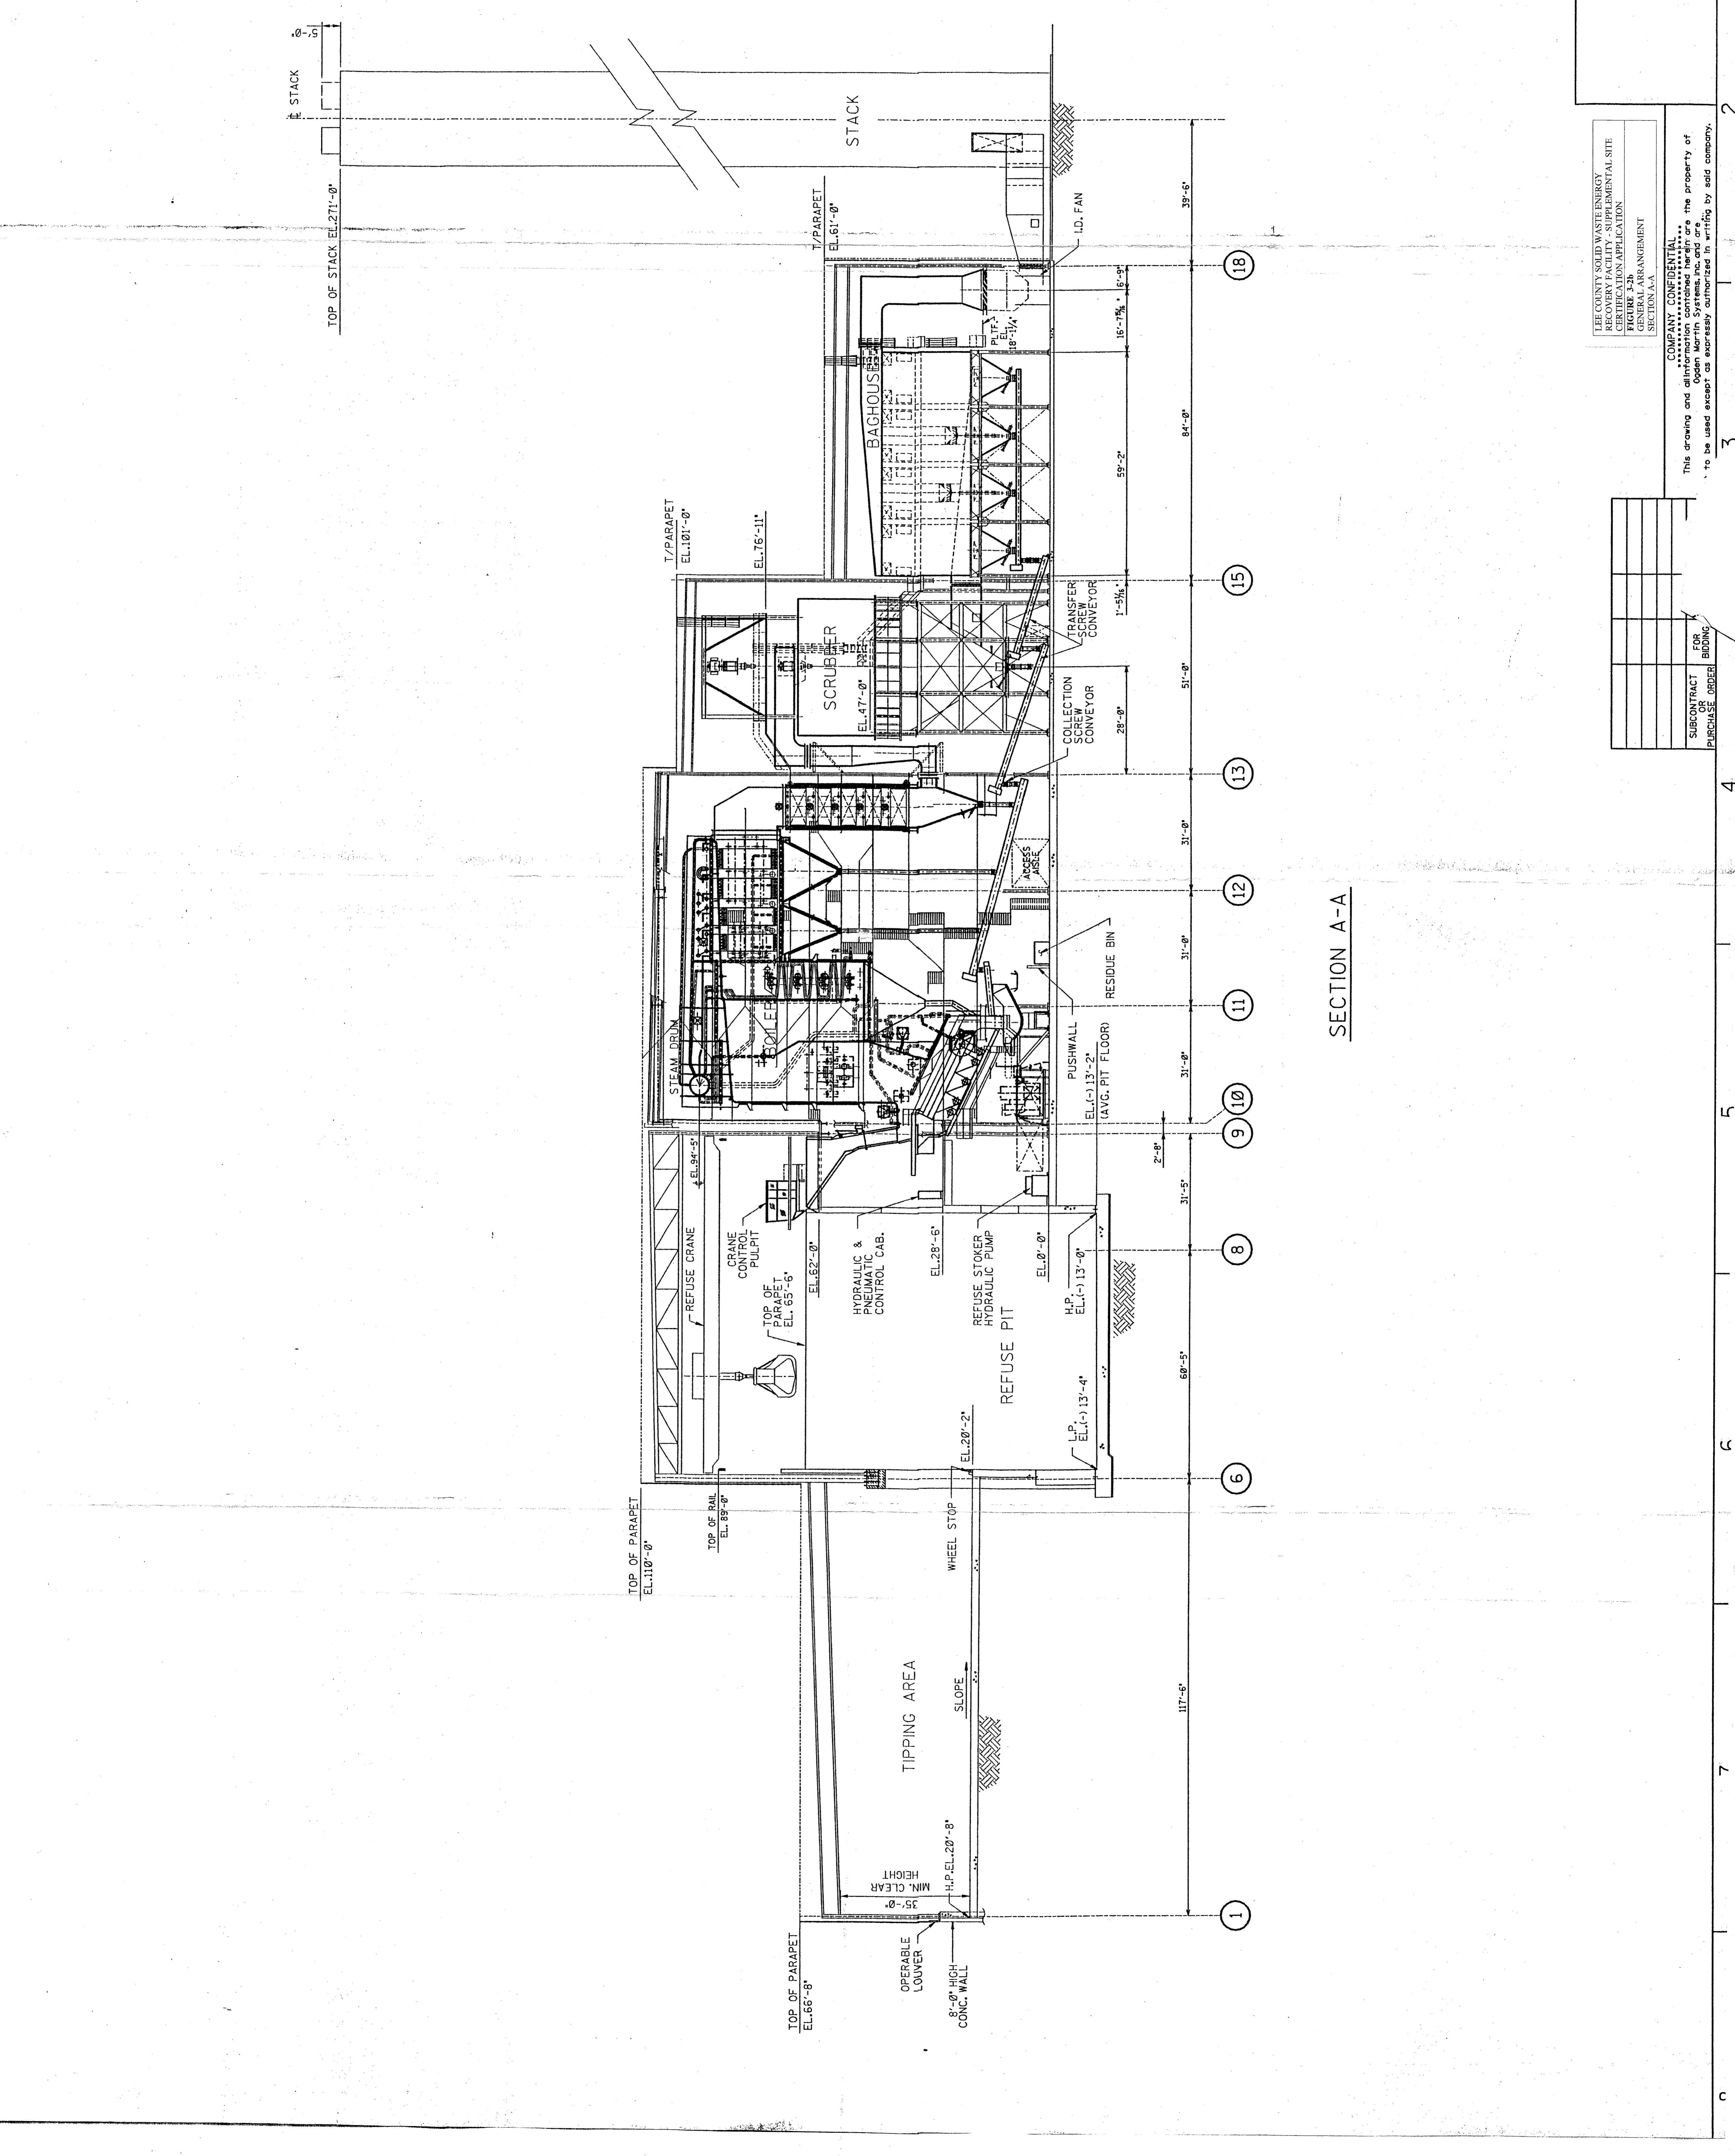

SECTION A-A

**United Engineers & Constructors**  
A LibertyGroup Company

GENERAL ARRANGEMENT SECTION A-A  
LEE COUNTY SOLID WASTE RESOURCE RECOVERY FACILITY

**OGDEN MARTIN SYSTEMS OF LEE, INC.**

DATE	REVISION
12/04/92	D.L.B.
08/01/95	H.S.D.
09/14/95	H.S.D.
PROJECT NO.	C-1033
DATE	7/10/95
SCALE	1/4" = 1'-0"
NO.	2
PROJECT	7102-E-210901
MICROSTATION	

LEE COUNTY SOLID WASTE RESOURCE RECOVERY FACILITY - SUPPLEMENTAL SITE CERTIFICATION APPLICATION

FIGURE 3-2b  
GENERAL ARRANGEMENT SECTION A-A

**COMPANY CONFIDENTIAL**

This drawing and all information contained herein are the property of Ogden Martin Systems, Inc. and are to be used except as expressly administered in writing by said company.

SUBCONTRACT FOR ORDER	
PURCHASE ORDER	