

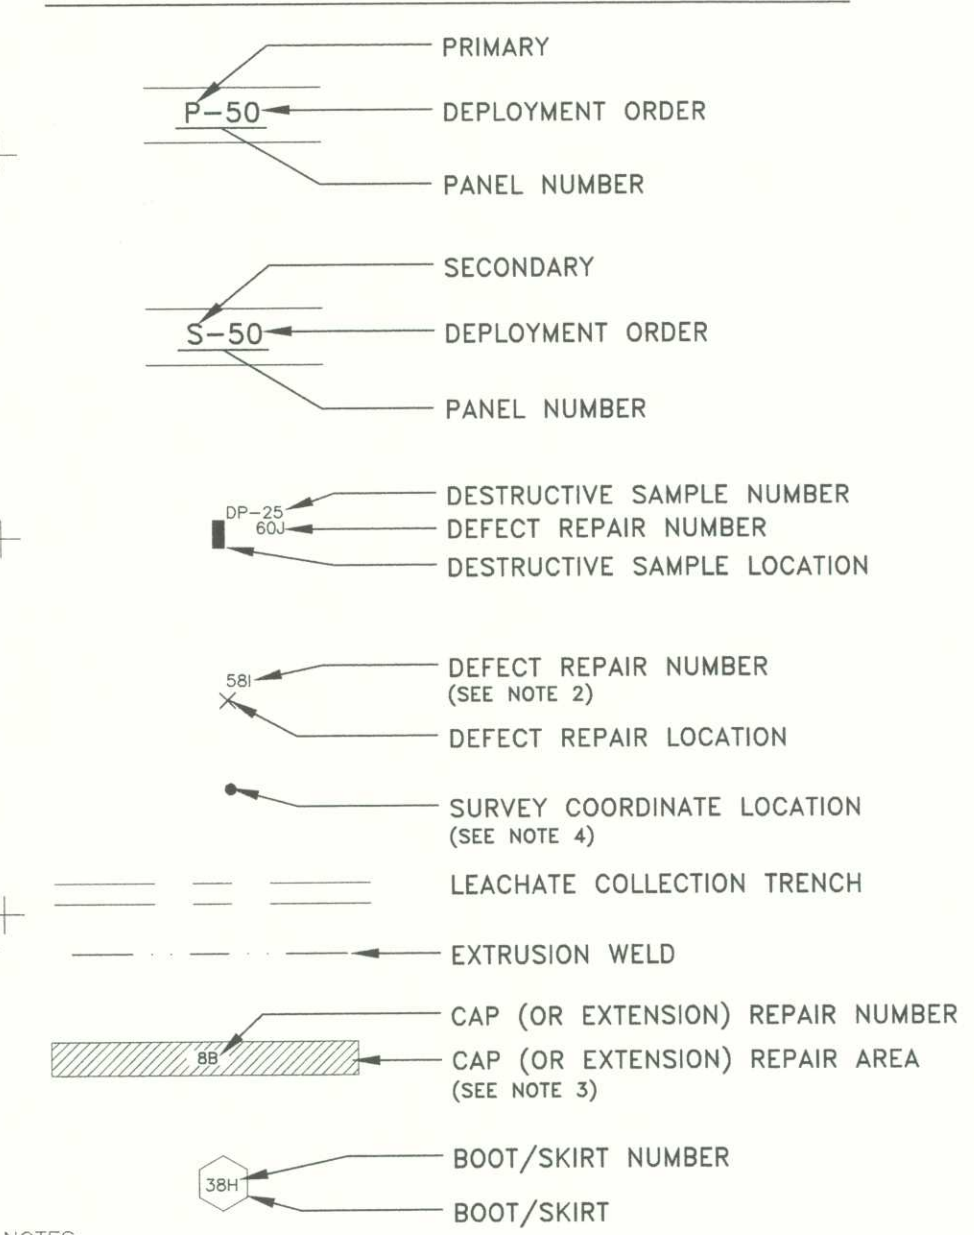


LEGEND

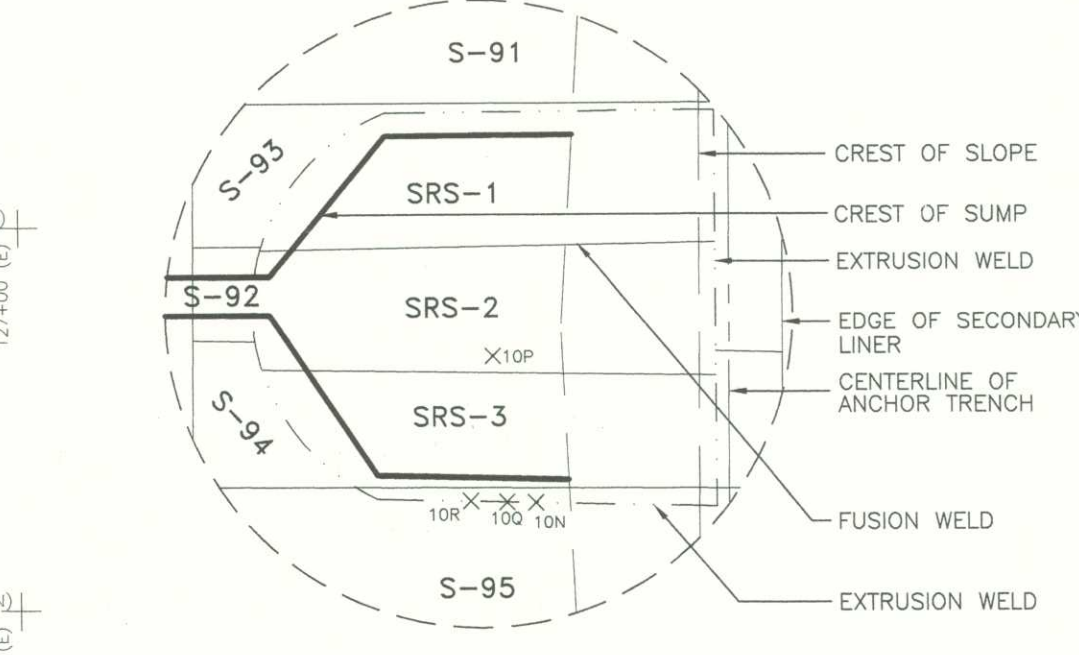



- NOTES:**
- THE LOCATIONS AND DIMENSIONS OF ALL PANELS, SEAMS, DESTRUCTIVE TEST SAMPLES AND REPAIRS SHOWN ON THIS DRAWING ARE APPROXIMATE AND ARE BASED ON FIELD MEASUREMENTS.
 - GEOMEMBRANE SEAM AND DEFECT/REPAIR INFORMATION IS PROVIDED IN APPENDICES I AND J, RESPECTIVELY, OF THE RECORD DOCUMENTATION REPORT.
 - DEFECT REPAIR LOCATIONS SHOWN AS CAPPED AREAS REPRESENT ONLY THE LARGER CAPS.
 - SELECTIVE SEAMS WERE SURVEYED BY R. M. ANGUS AND ASSOCIATES TO PROVIDE CONTROL FOR DEVELOPMENT OF THIS RECORD DRAWING. THIS SURVEY DATA IS NOT SHOWN ON THIS DRAWING FOR PURPOSES OF CLARITY BUT WAS SUBMITTED TO TRAIL RIDGE LANDFILL, INC.
 - THIS RECORD DRAWING REPRESENTS THE FINAL SECONDARY AND PRIMARY GEOMEMBRANE LINERS FOR PHASE IIC FOLLOWING ALL REPAIRS.
 - TEMPORARY VENTS WERE LEFT ALONG THE PRIMARY TO SECONDARY WELD AT THE SOUTHERN PERIMETER OF PHASE IIC DURING PLACEMENT OF THE PROTECTIVE SAND BLANKET. THESE VENTS WERE NOT WELDED AT THE COMPLETION OF THE PROTECTIVE SAND BLANKET PLACEMENT SINCE THE LINER SYSTEM CONSTRUCTION IN PHASE VA WAS IN PROGRESS. THE ENTIRE PRIMARY TO SECONDARY WELD OF PHASE IIC WILL BE REMOVED TO TIE-IN THE SECONDARY AND PRIMARY GEOMEMBRANE LINERS BETWEEN PHASES IIC AND VA.

**PHASE IIC
SECONDARY GEOMEMBRANE LINER**

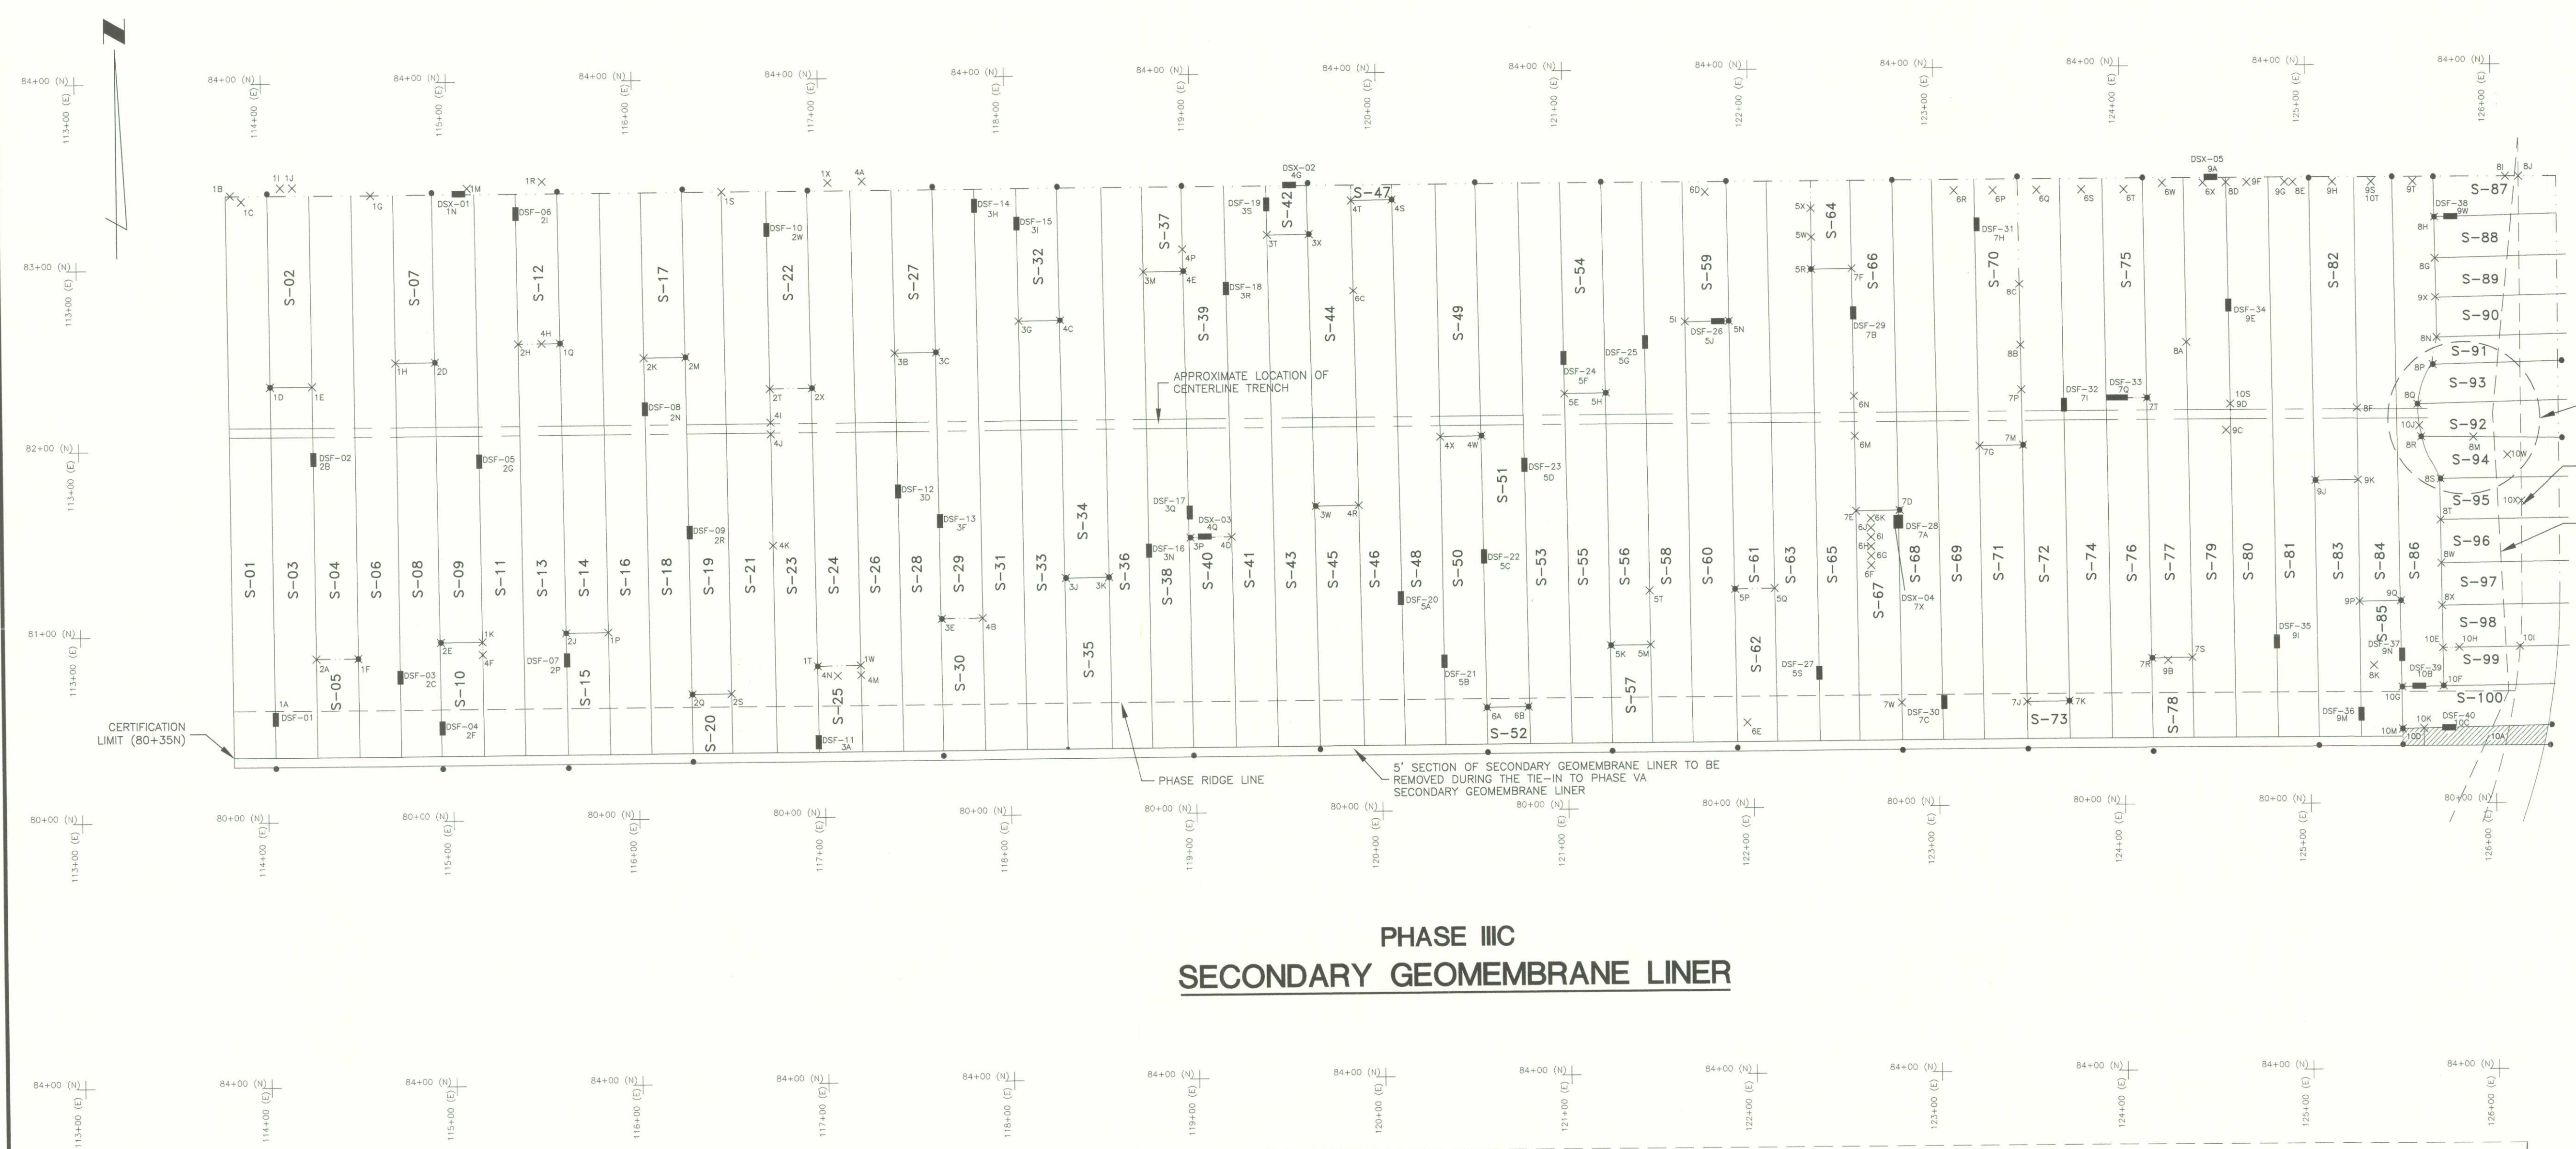

SECONDARY LINER RUBSHEET IN SUMP
SCALE: 1" = 25'

**PHASE IIC
PRIMARY GEOMEMBRANE LINER**

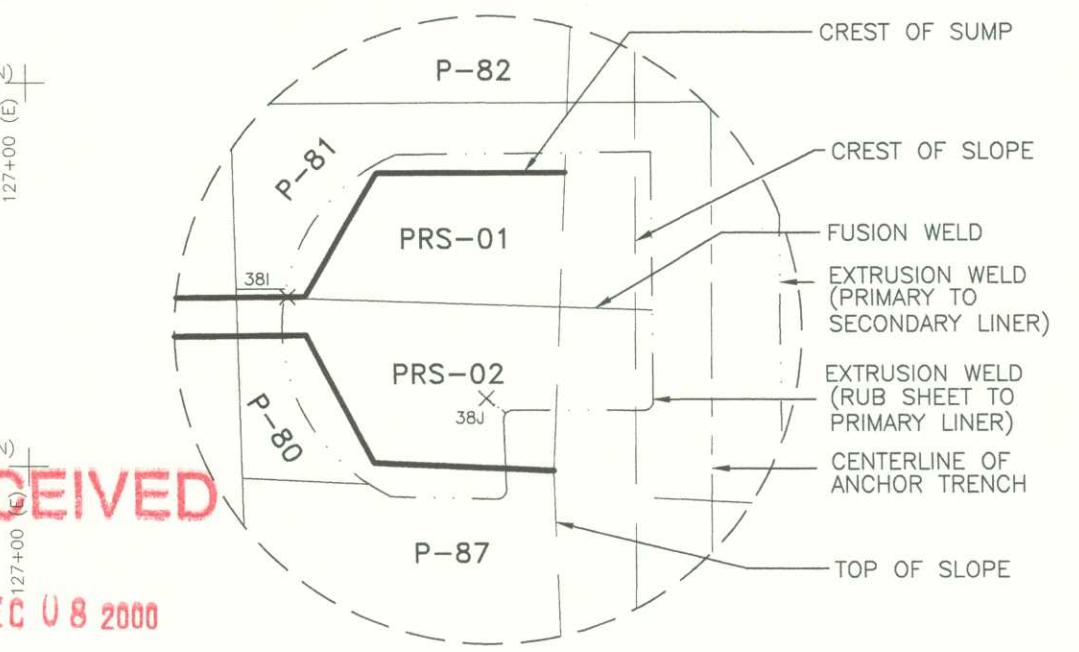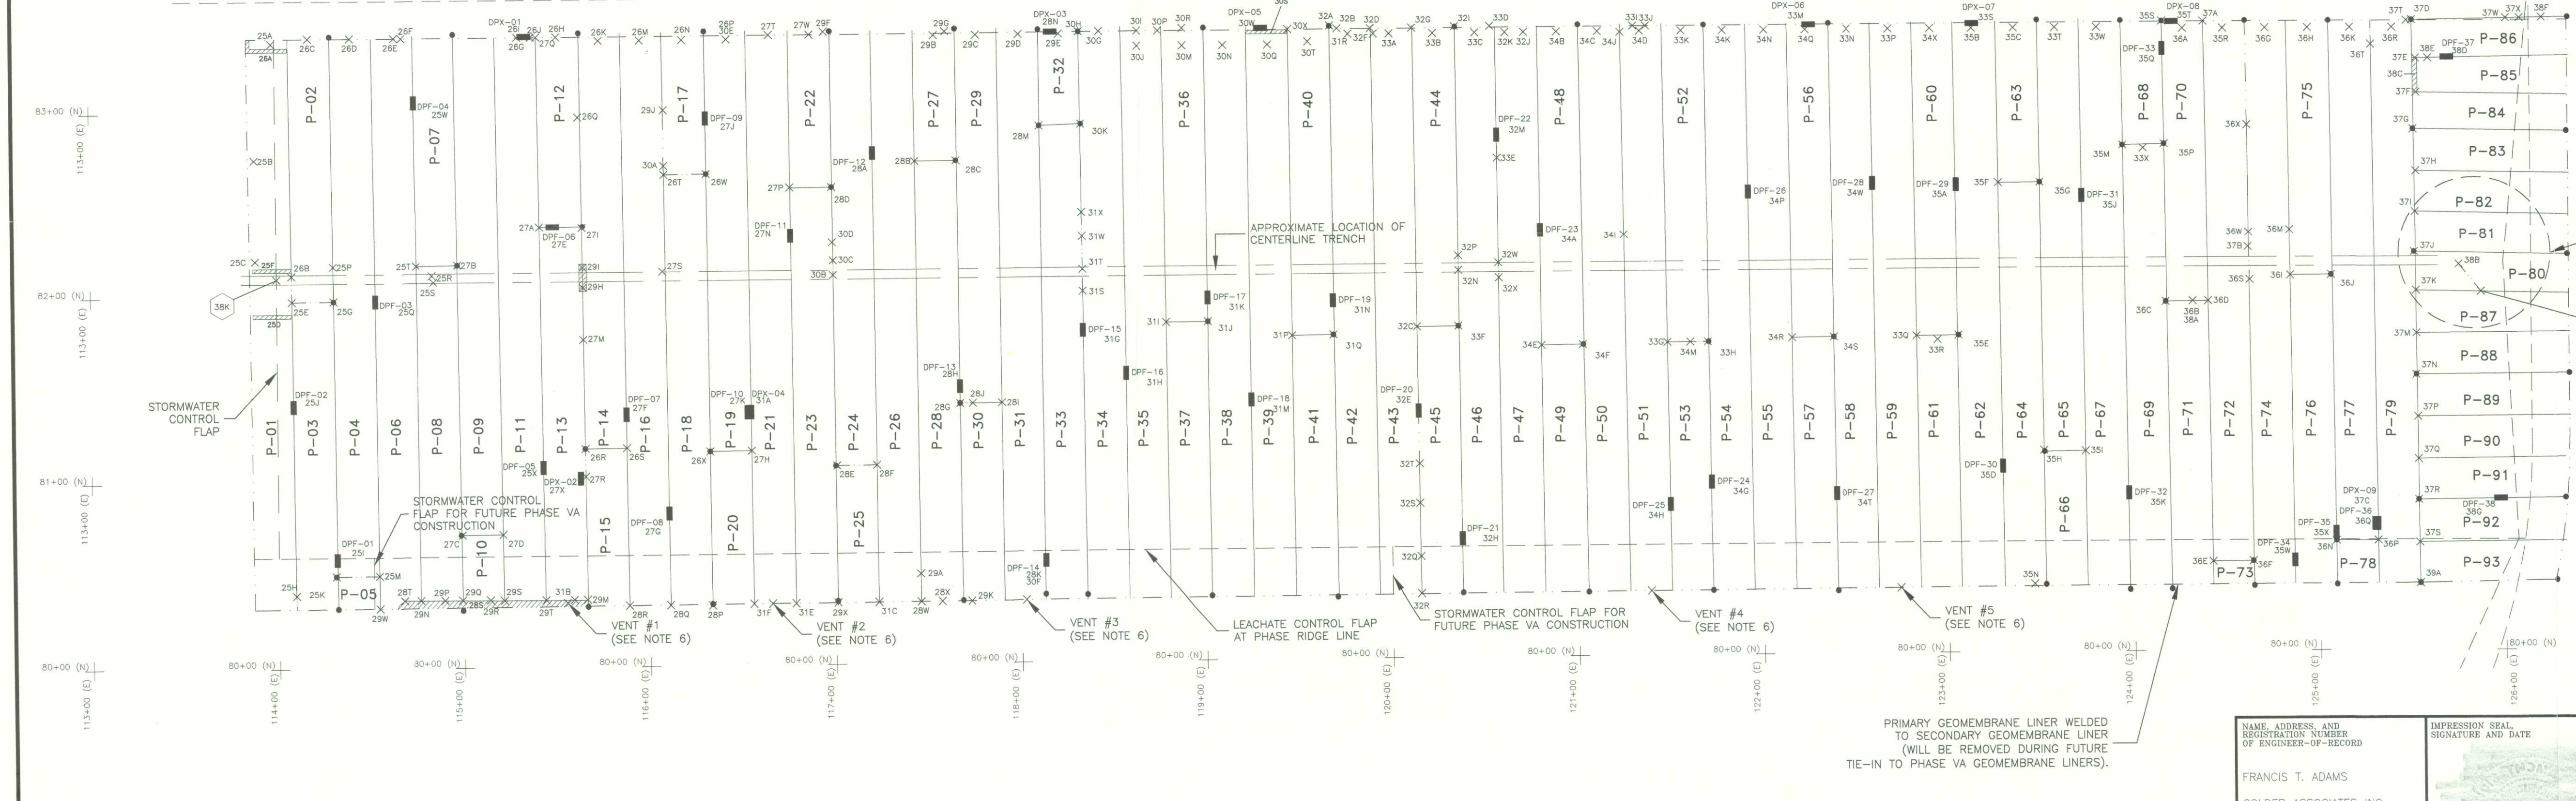

PRIMARY LINER RUBSHEET IN SUMP
SCALE: 1" = 25'

RECEIVED
DEC 08 2000

STATE OF FLORIDA
DEPT. OF ENVIRONMENTAL PROTECTION
NORTHEAST DISTRICT OFFICE - JAX

CLIENT/PROJECT
**TRAIL RIDGE LANDFILL
THIRD CONSTRUCTION INCREMENT
BALDWIN, FLORIDA**

TITLE
**RECORD PANEL LAYOUT OF SECONDARY AND PRIMARY
GEOMEMBRANE LINERS FOR PHASE IIC**

JACKSONVILLE, FLORIDA		DATE	11/17/00
DRAWN	GMS	SCALE	AS SHOWN
CHECKED	692	DWG. NO.	3979F
REVIEWED	312	JOB NO.	003-3979
APPROVED	312	SUBTITLE	003-3979
FILE NO.			3

NAME, ADDRESS, AND REGISTRATION NUMBER OF ENGINEER-OF-RECORD
FRANCIS T. ADAMS
GOLDER ASSOCIATES INC.
8933 WESTERN WAY
SUITE 12
JACKSONVILLE, FLORIDA
32256
FLORIDA P.E. NO. 46417

IMPRESSION SEAL, SIGNATURE AND DATE
Francis T. Adams
11/17/00

