


SCALE: 1"=200'

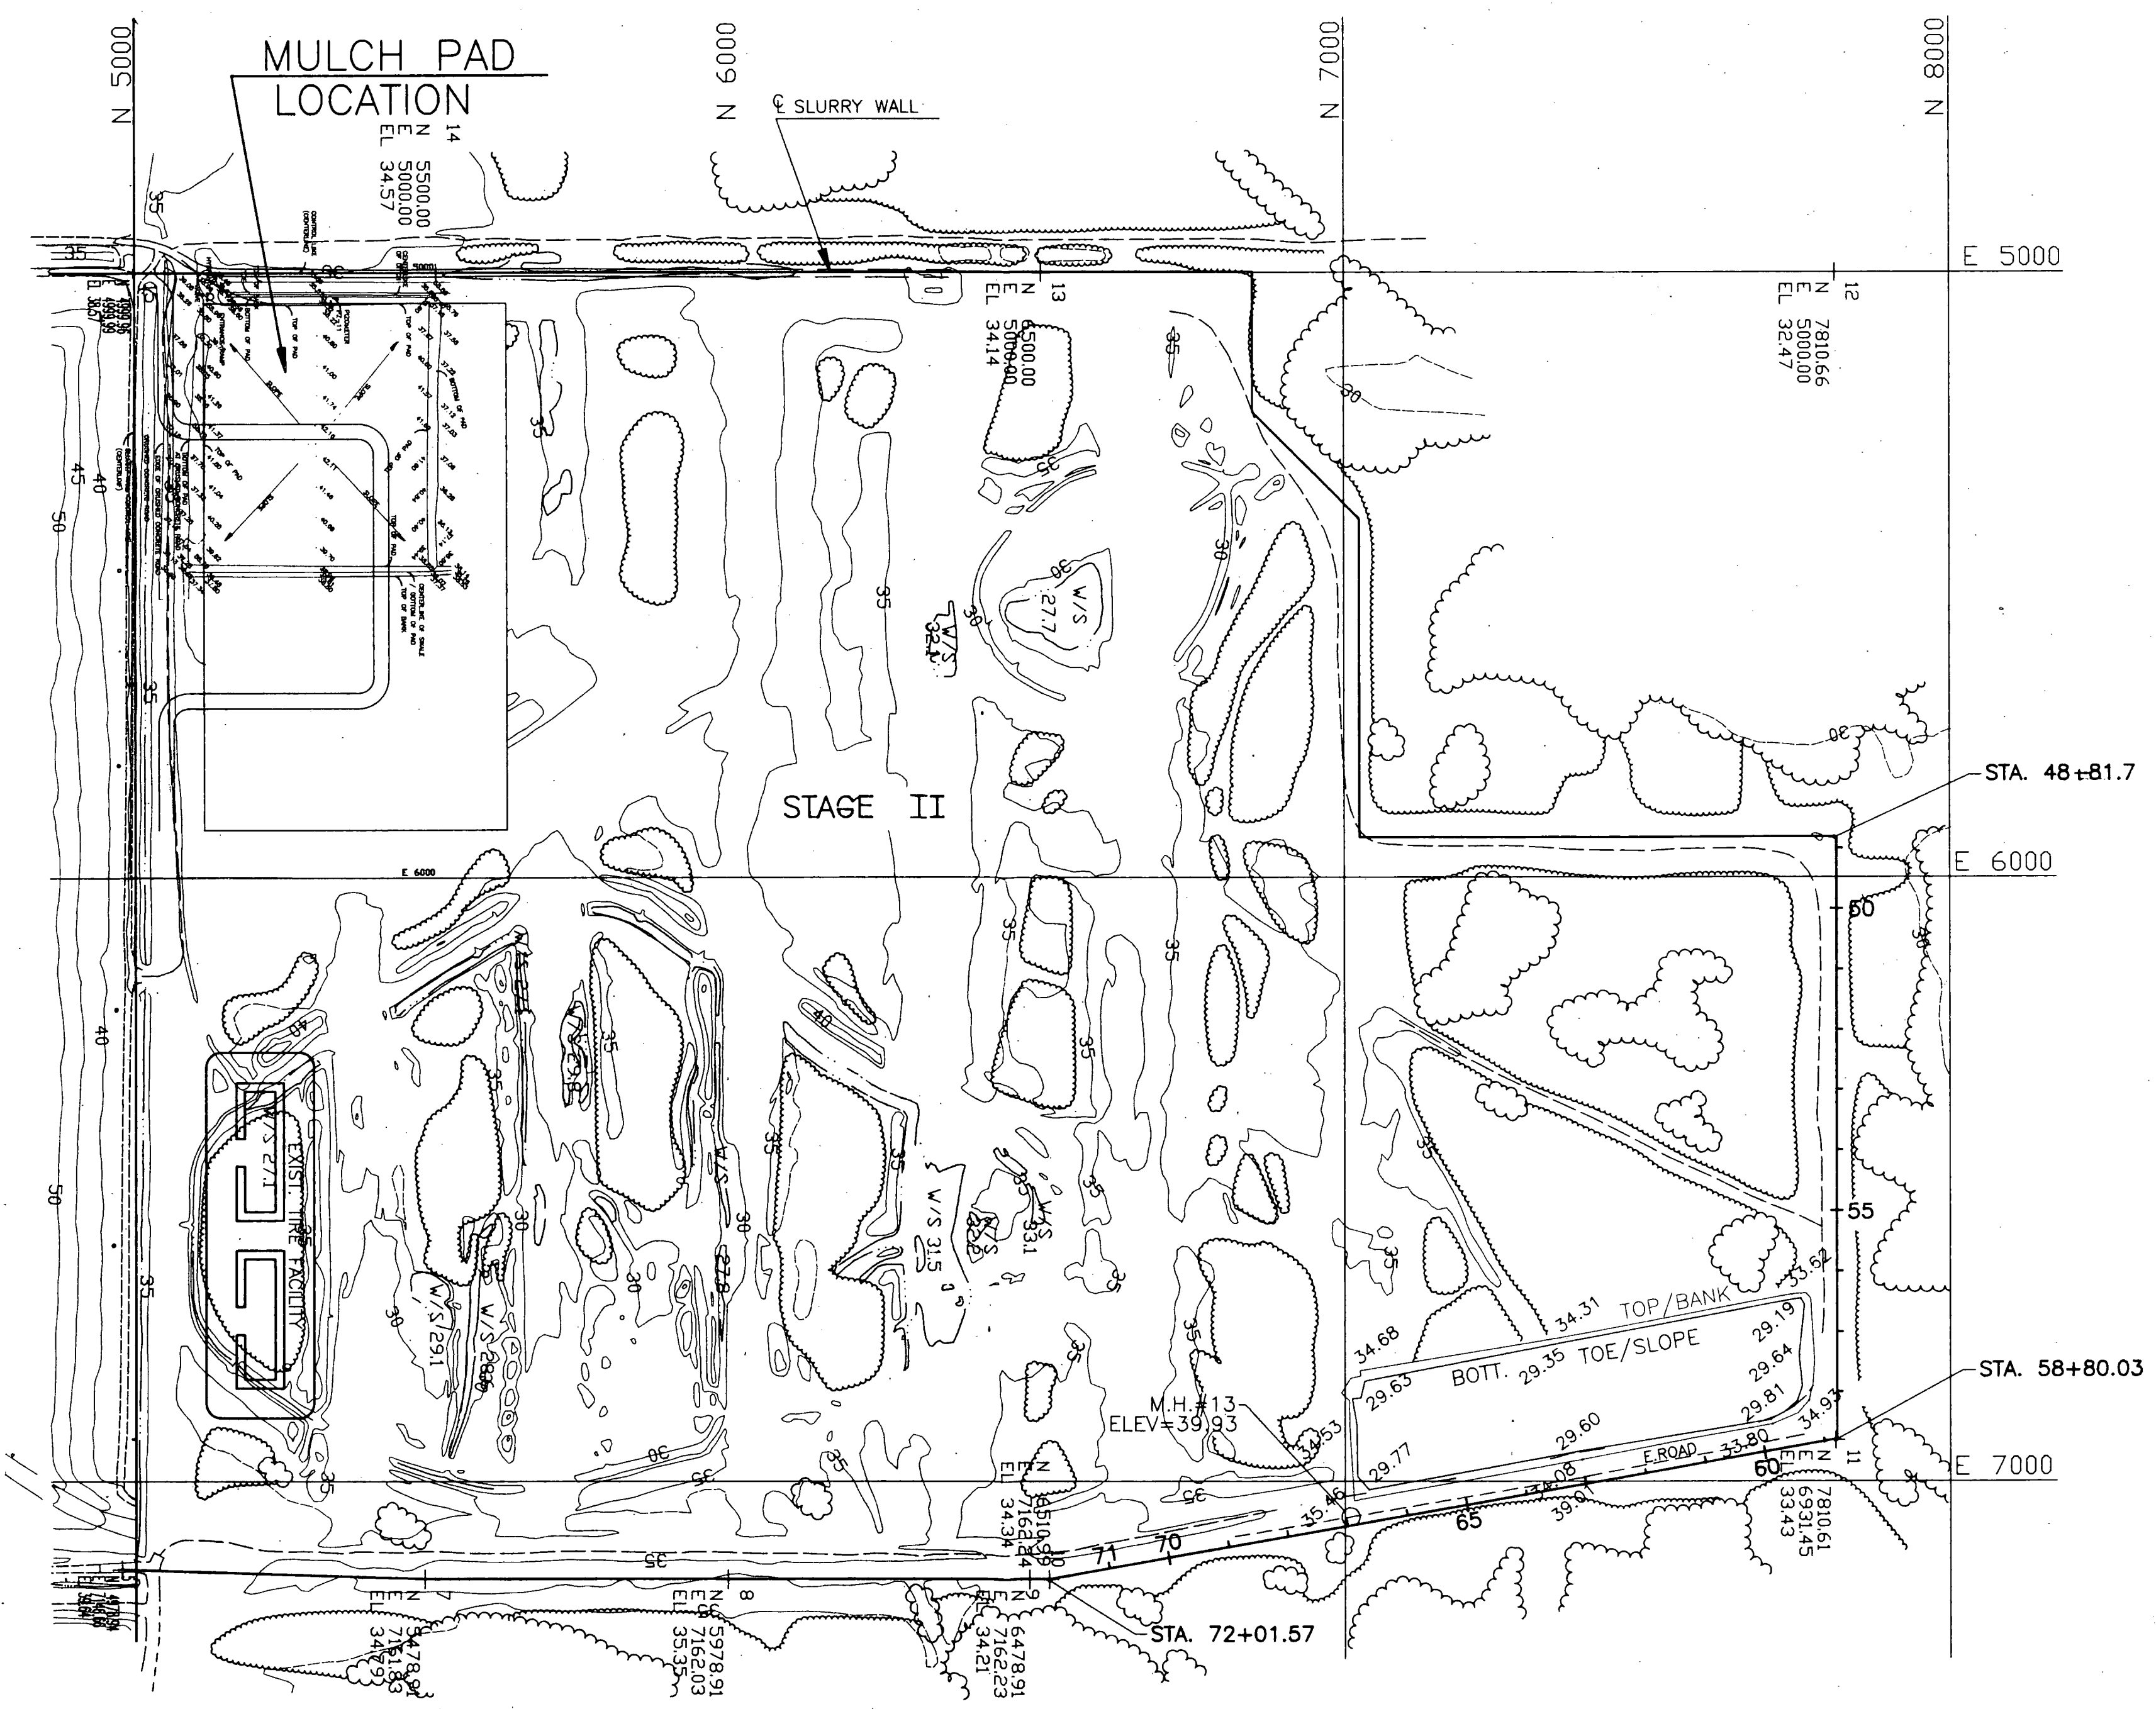


| PLAN/PROFILE ~ BOOK NOS. |         |      |  |
|--------------------------|---------|------|--|
| By                       | Checked | Date |  |
|                          |         |      |  |
|                          |         |      |  |
| BY | CHECKED | DATE |
|----|---------|------|
|    |         |      |
|    |         |      |
|    |         |      |
|    |         |      |




| ENGINEER | PUBLIC SERVICES DEPT. |
|----------|-----------------------|
|          |                       |
|          |                       |

## LENA ROAD LANDFILL MULCH SITE SITE PLAN


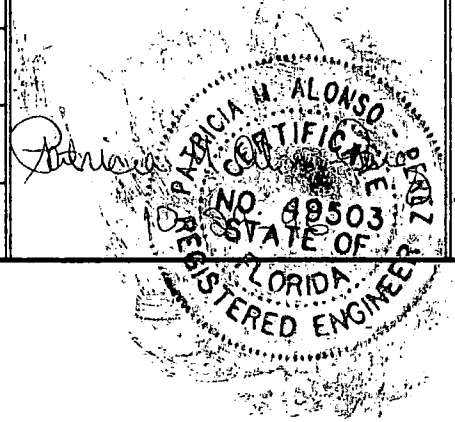


| REVISION DESCRIPTION & DATE | BY  | NO. |
|-----------------------------|-----|-----|
| RECORD DRAWING 10/96        | TCS |     |
|                             |     |     |
|                             |     |     |
|                             |     |     |

|           |              |
|-----------|--------------|
| Proj. No. | 480-4615-534 |
| Dwg. Date | 5/96         |
| Dwg. No.  | PLAN.DWG     |
| Sht.      | 2 of 3       |

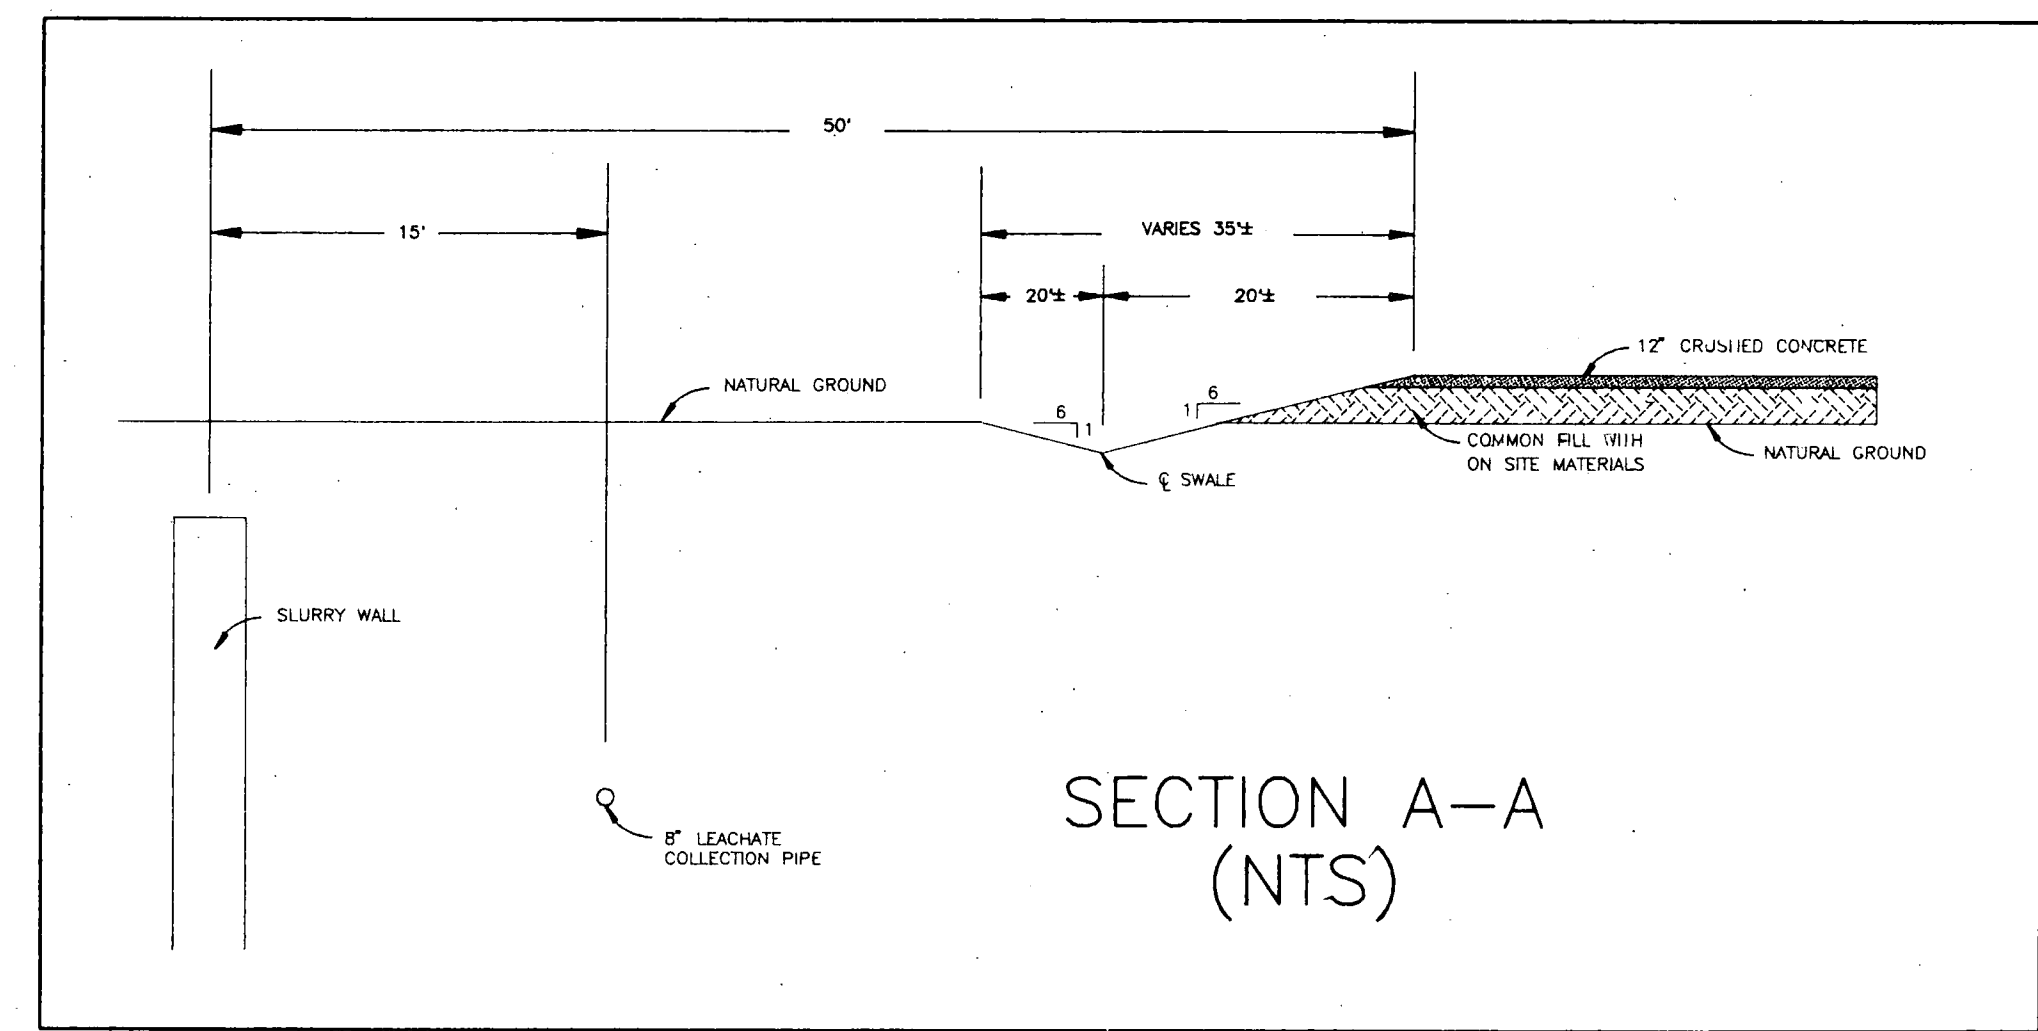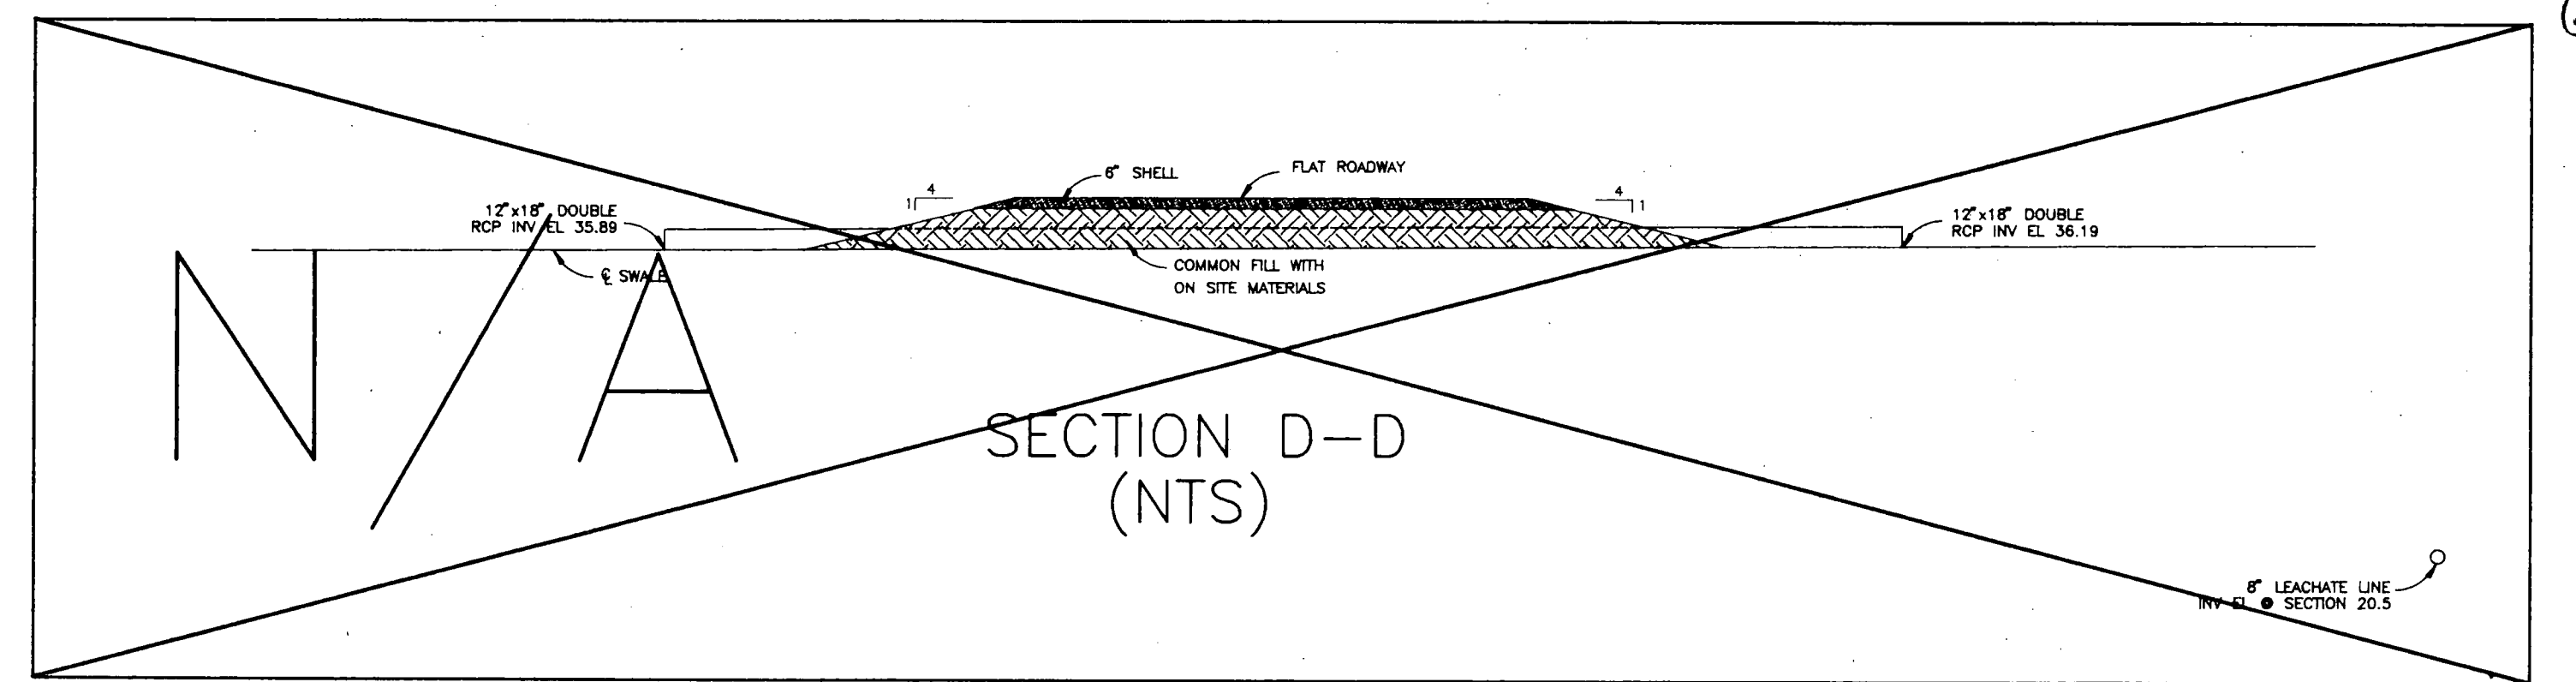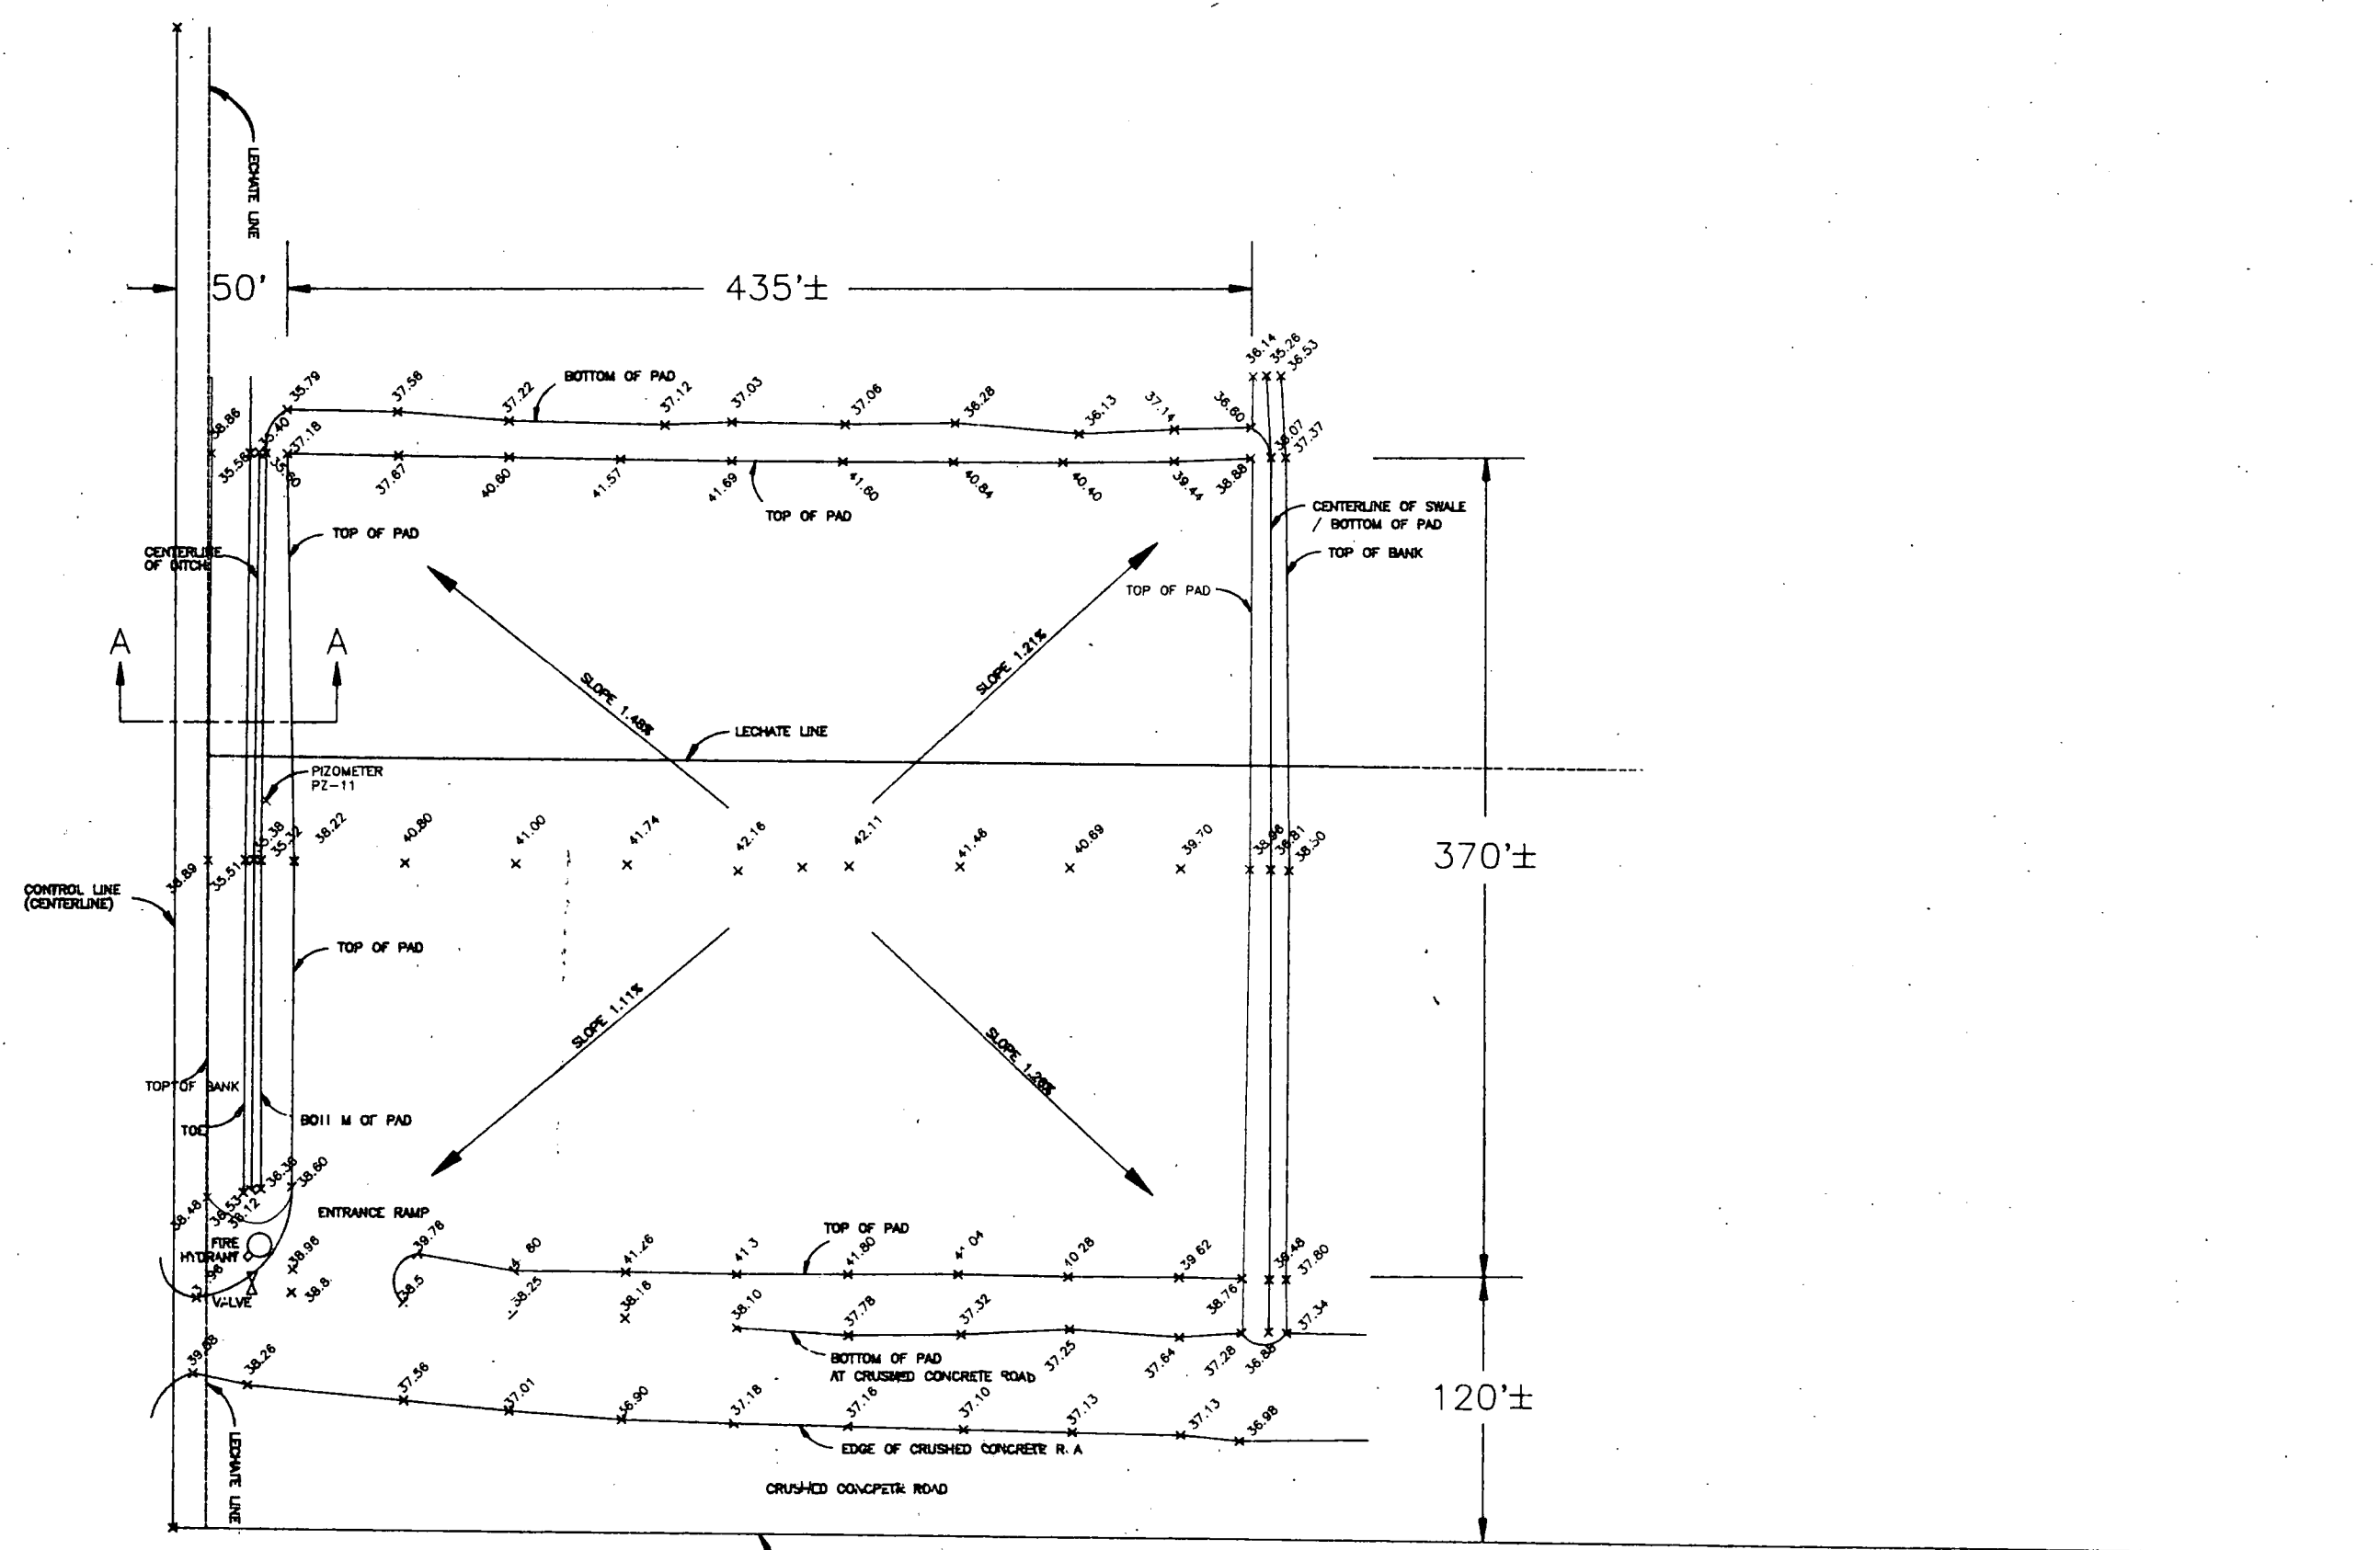

D.E.P.  
OCT 30 1996  
QUALITYWES: TAMPA

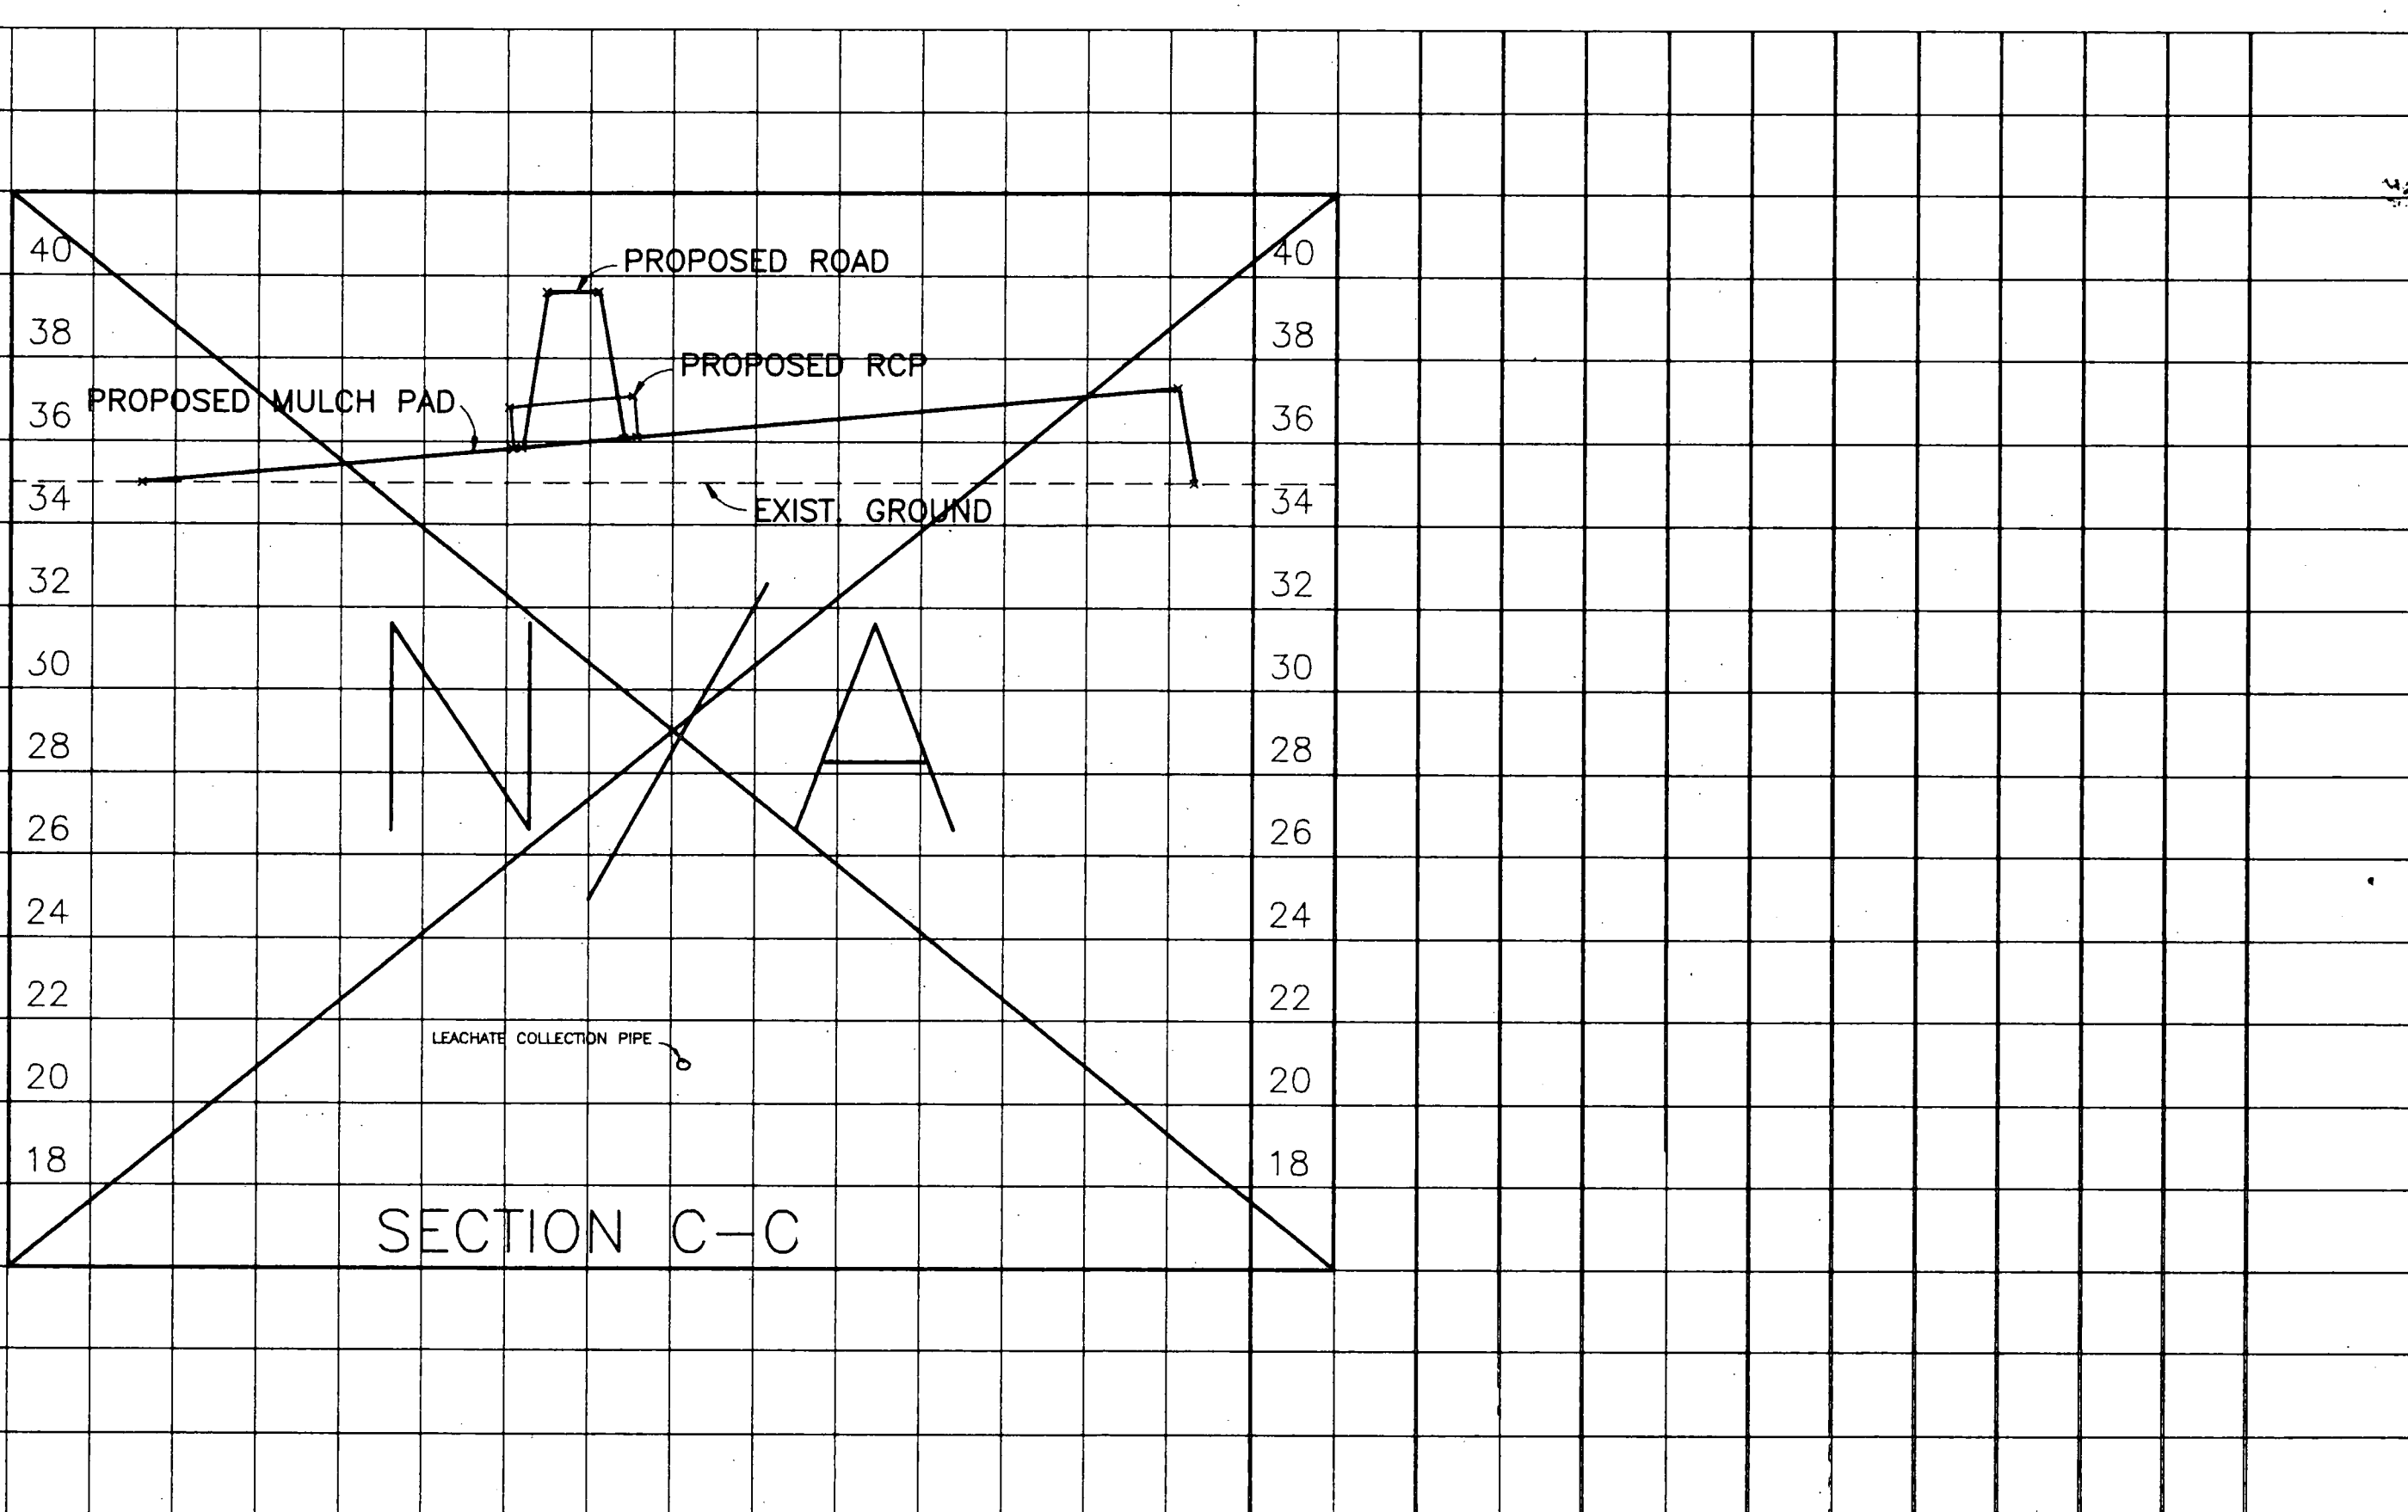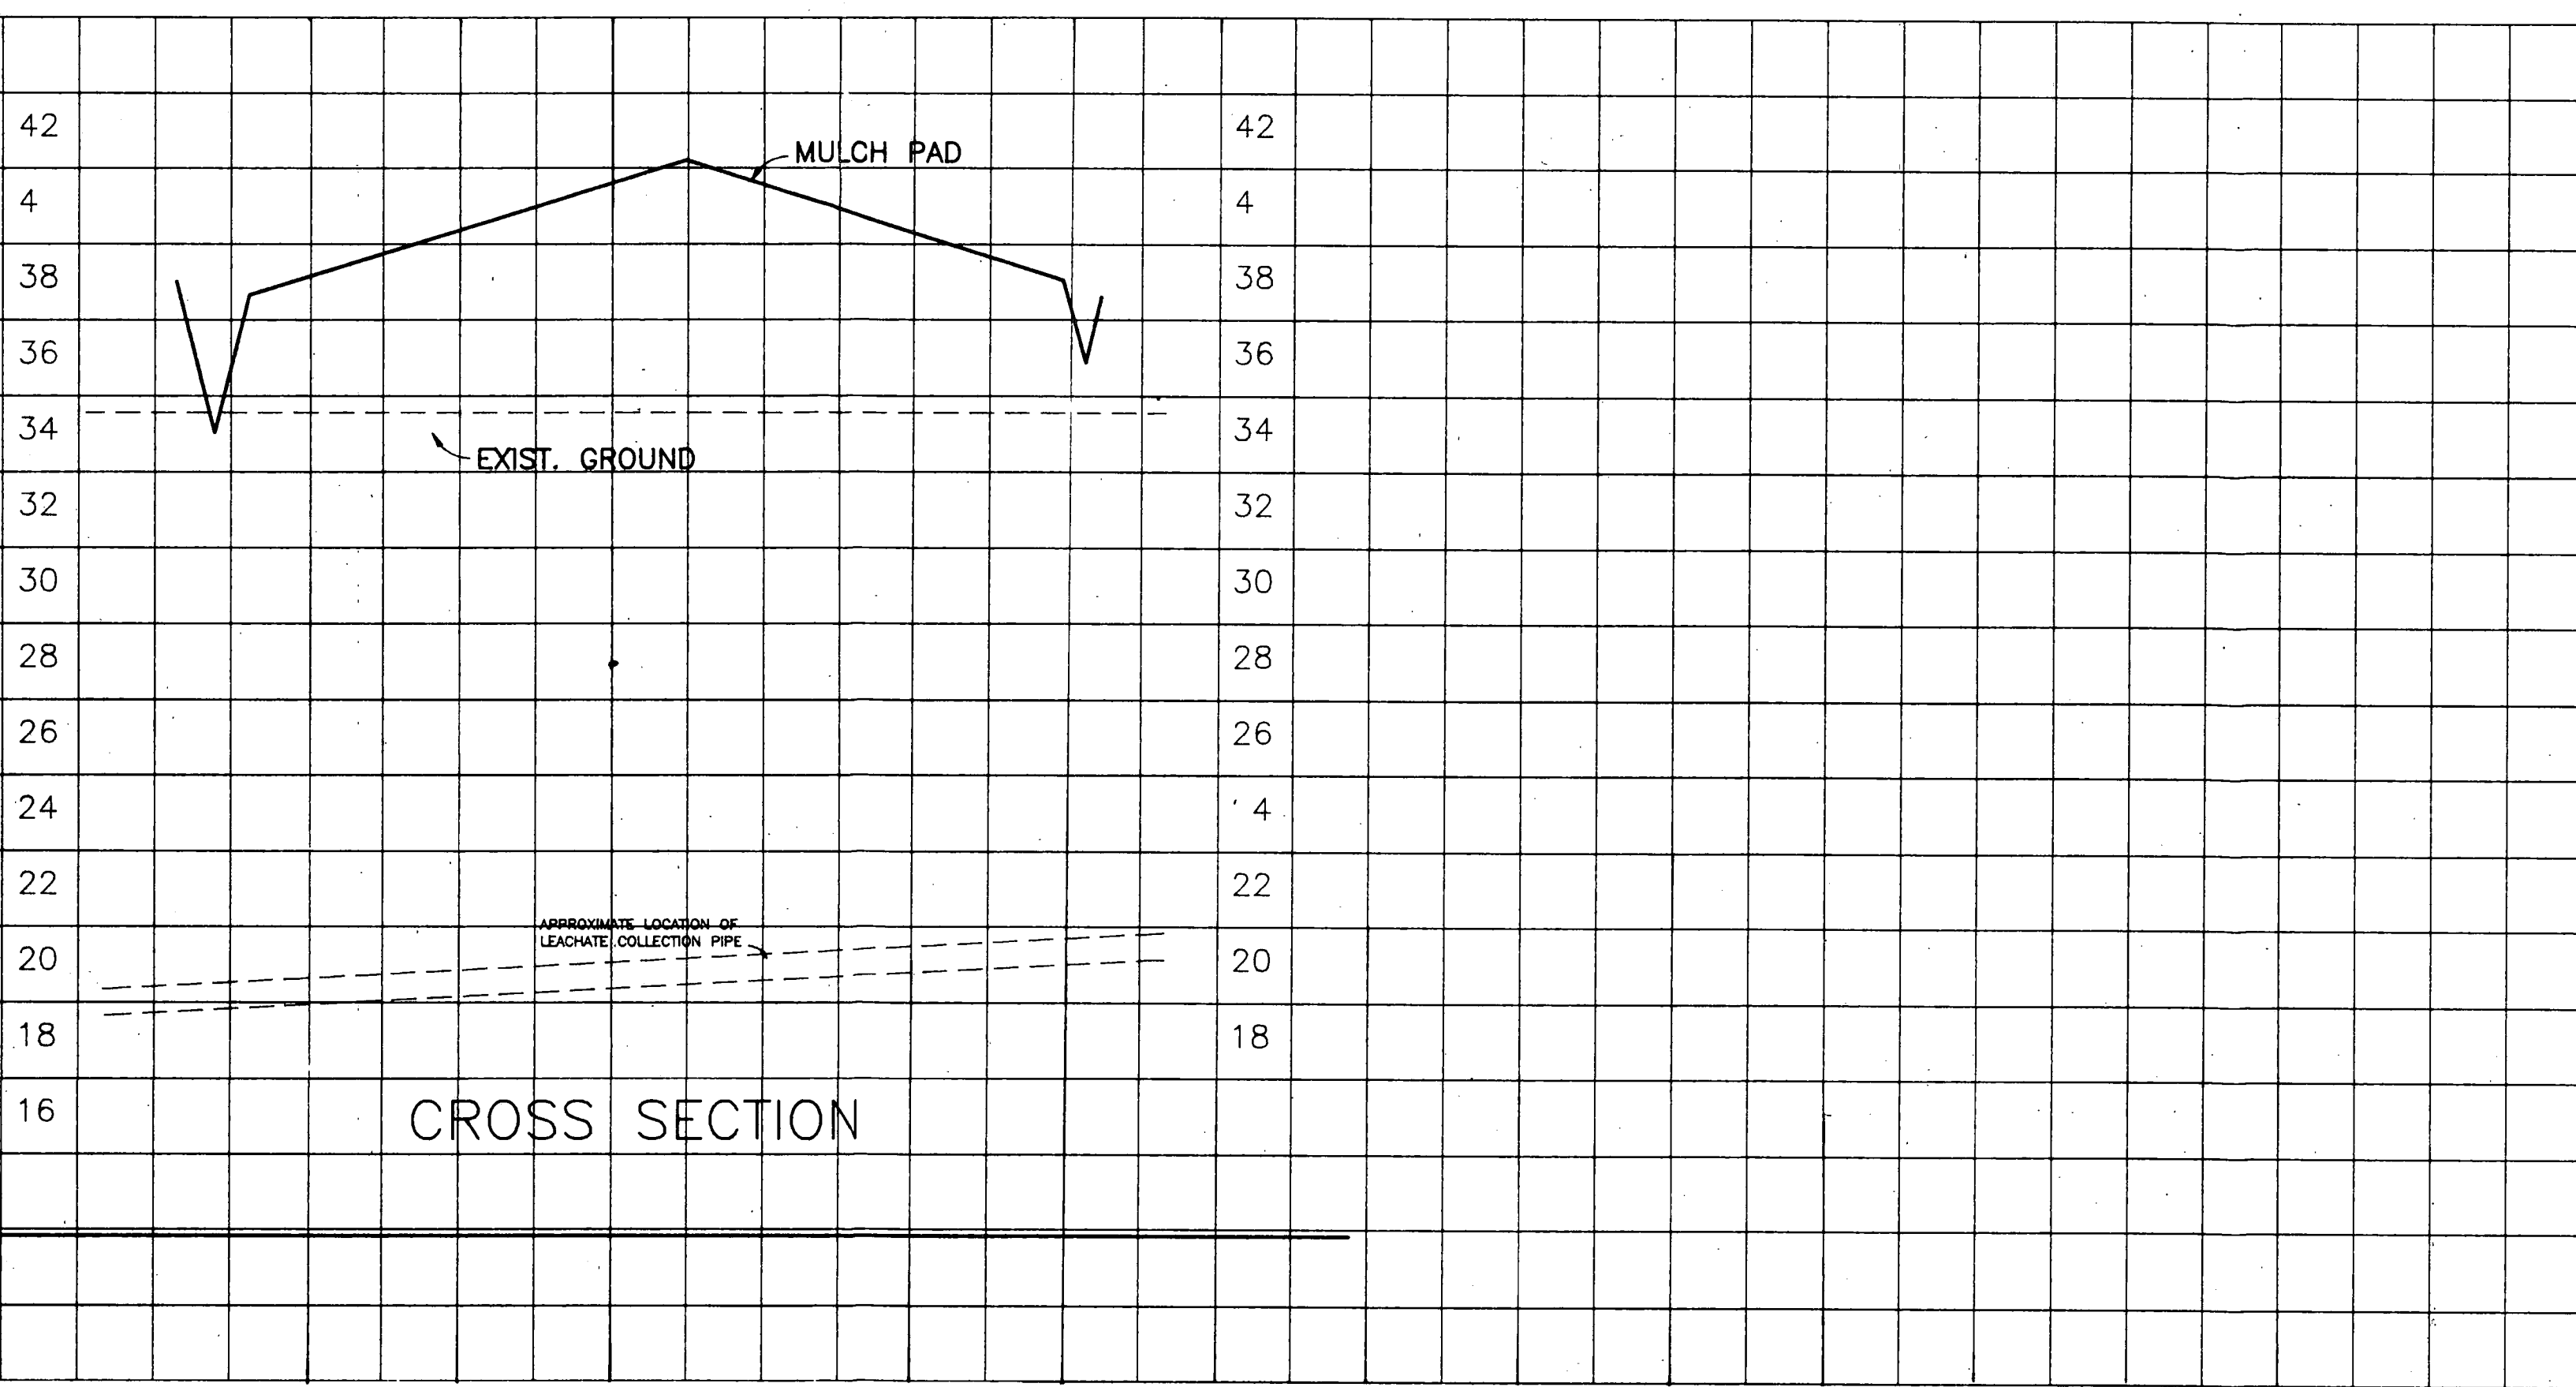

| PLAN/PROFILE ~ BOOK NOS.                 |    |         |            | BY       | CHECKED | DATE | ENGINEER | PUBLIC WORKS DEPT.  | REVISION DESCRIPTION & DATE |           | BY       | NO. | Proj. No     |  |  |
|--|----|---------|------------|----------|---------|------|----------|---|-----------------------------|-----------|----------|-----|--------------|--|--|
| Surveyed                                 | By | Checked | Date       | Designed | L.L.P.  | 5/96 |          |   | RECORD DRAWINGS             | 10/96     | TCS      |     | 480-4615-534 |  |  |
| Plotted                                  |    |         | Drawn      | T.C.S.   | 5/96    |      |          |   |                             | Dwg. Date | 5/96     |     |              |  |  |
| Alignment                                |    |         | Quantities |          |         |      |          |   |                             | Dwg. No.  | XSEC.DWG |     |              |  |  |
| Right of Way                             |    |         |            |          |         |      |          |   |                             | Sht.      | 3        | of  | 3            |  |  |
| Scale Horz. 1" = 80' Scale Vert. 1" = 4' |    |         |            |          |         |      |          | <p><b>LENA ROAD LANDFILL</b><br/><b>MULCHING SITE</b><br/><b>PROFILE &amp; SECTIONS</b></p> |                             |           |          |     |              |  |  |