
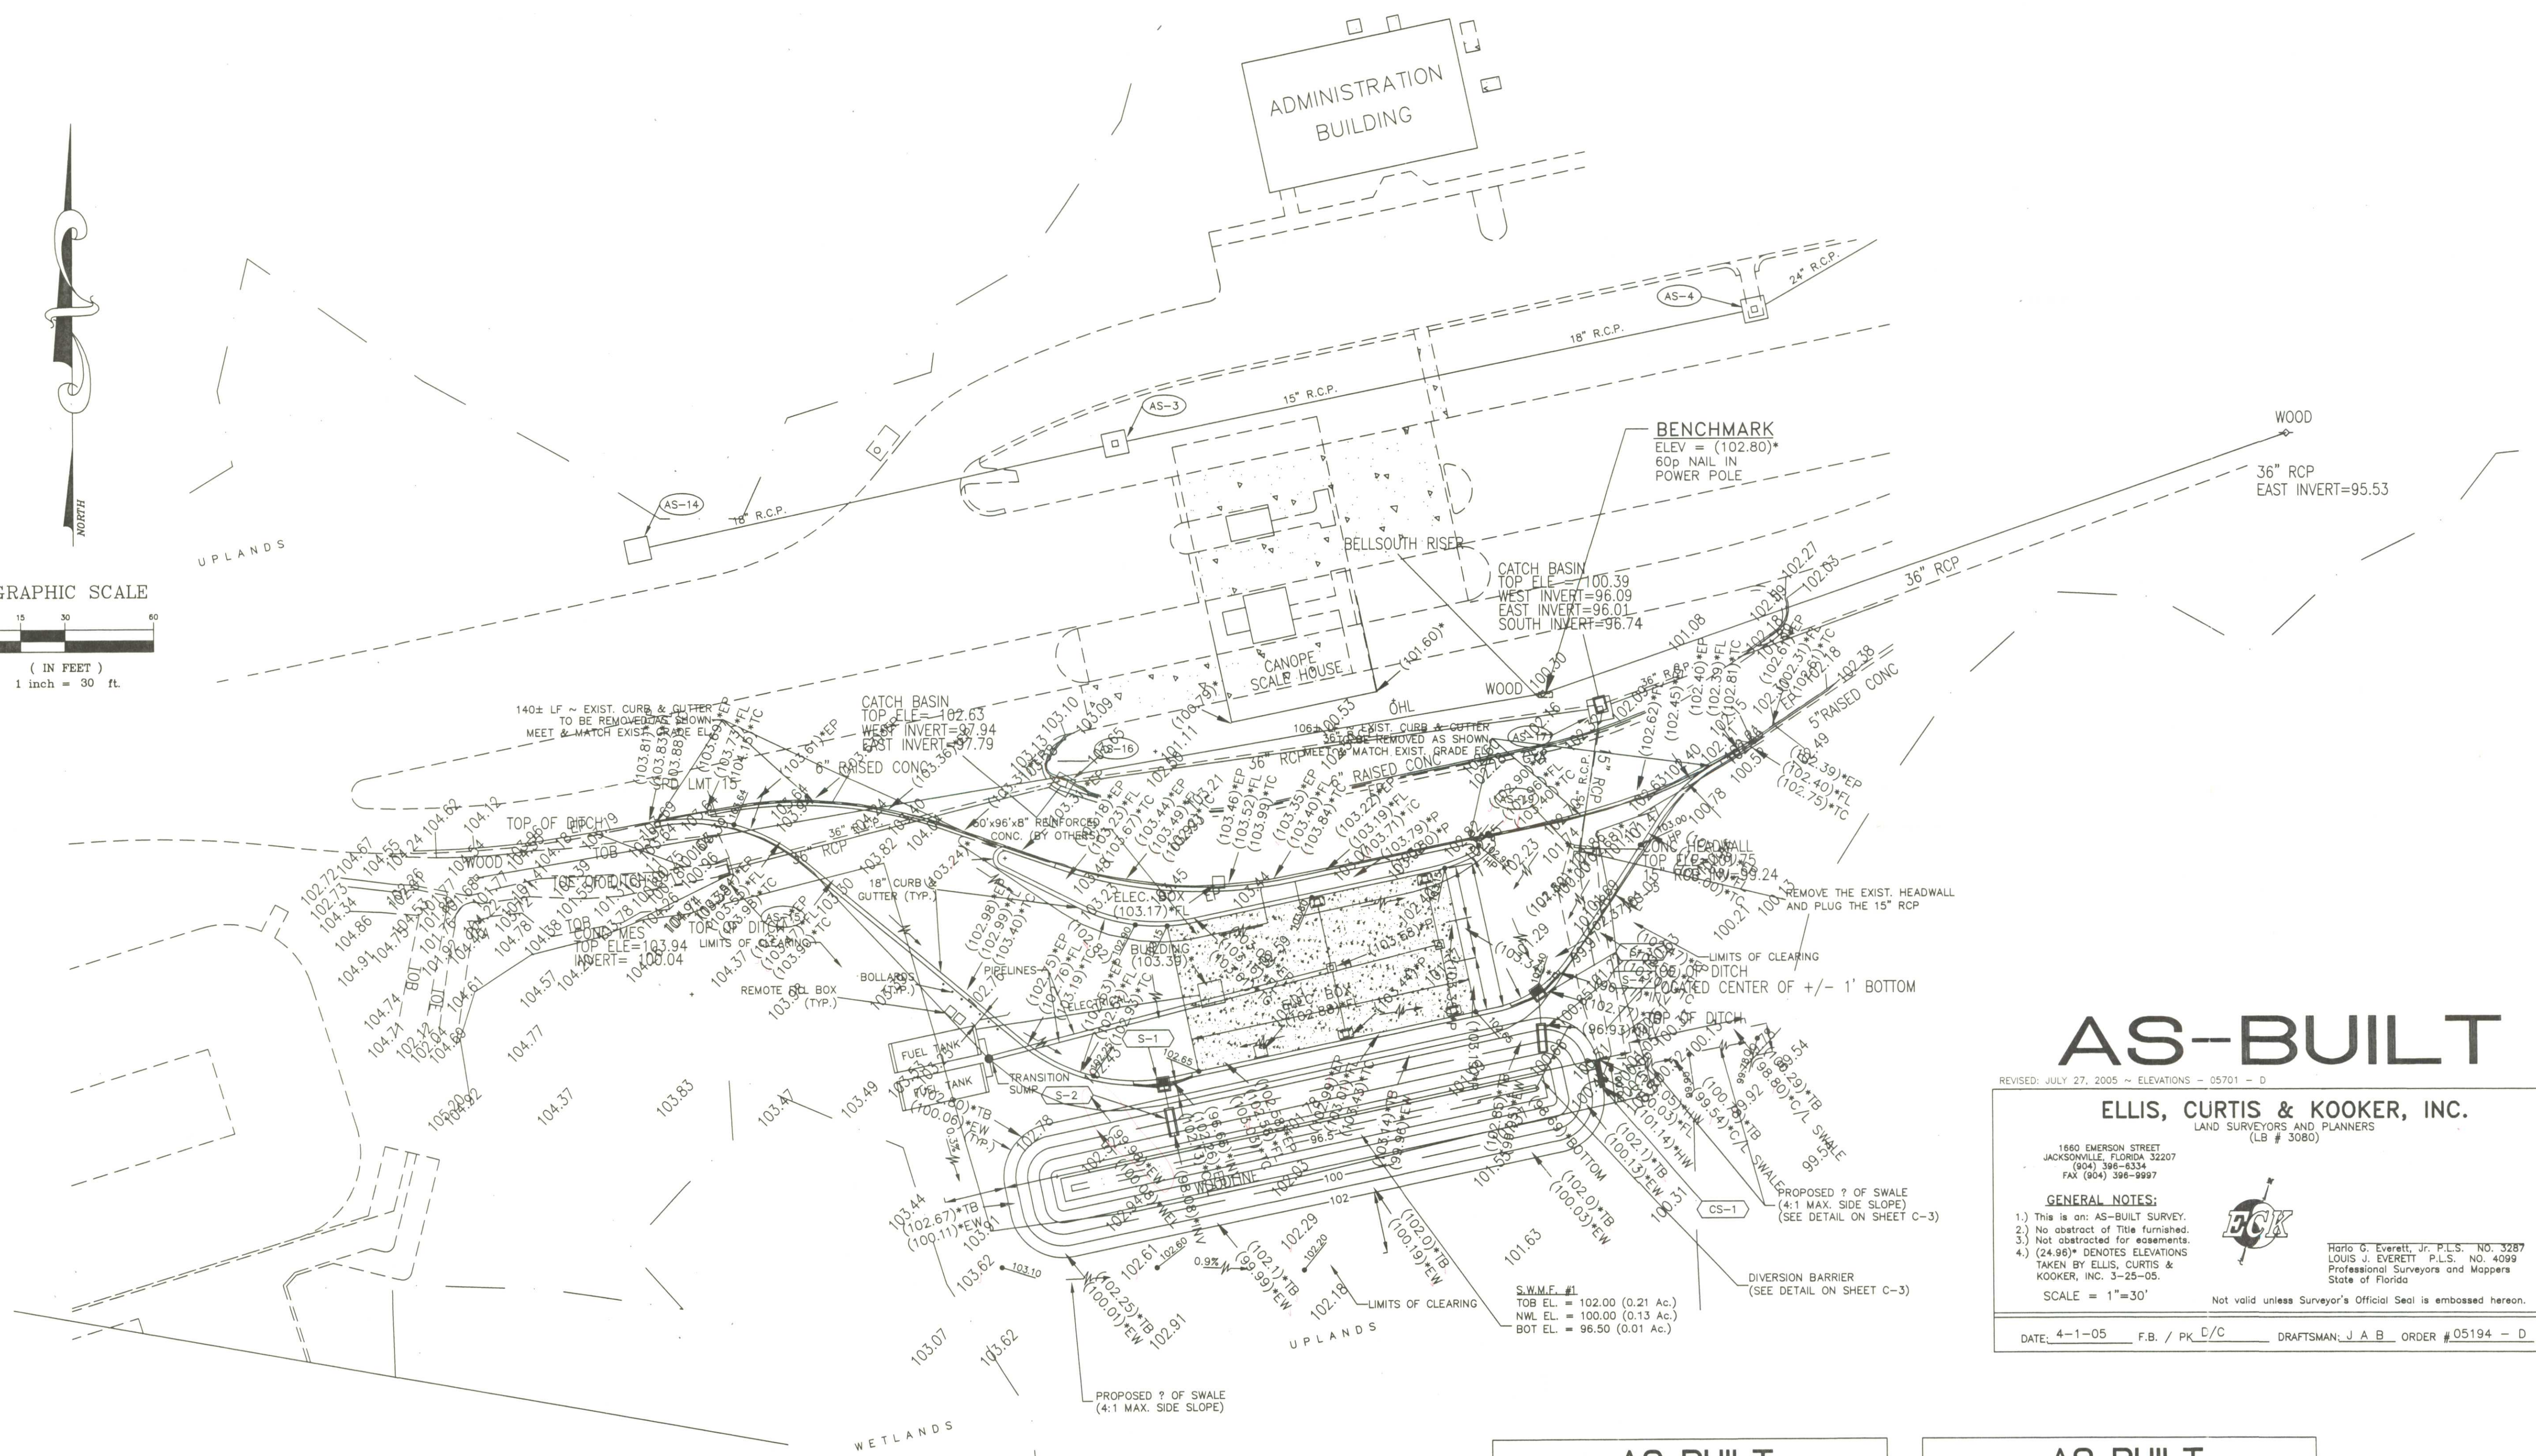


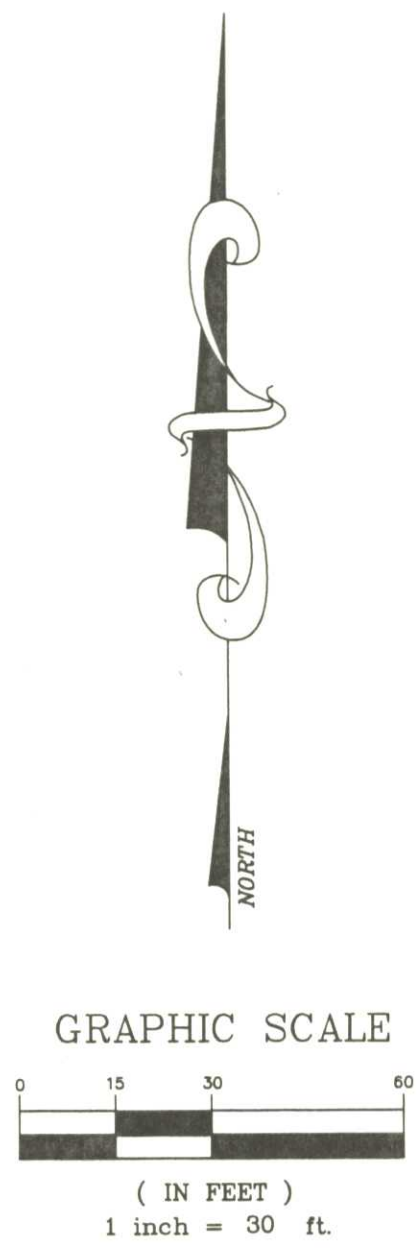

DRAINAGE STRUCTURE TABLE & SCHEDULE OF PIPES									
STRUCT. No.	STRUCT. TYPE	TOP ELEV.	E.O.P. ELEV.	THROAT ELEV.	INV. IN	PIPE TYPE	PIPE SIZE	PIPE LENGTH	PIPE SLOPE (%)
S-1	C.I.	-	102.26	102.15	96.77	(S) RCP	15"	24'	0.83
S-2	M.E.S.	-	-	-	96.60	-	-	-	-
S-3	DBL C.I.	-	102.40	102.30	97.00	(S) RCP	15"	20'	1.00
S-4	M.E.S.	-	-	-	96.80	-	-	-	-
CS-1	SEE DETAIL ON SHEET C-3								

NOTE:
1. LIMITS OF CONSTRUCTION ARE 2 FT. FROM THE LIMITS OF CLEARING.
2. ALL DISTURBED AREA SHALL BE SODED OR SEEDED AND MULCHED.

AS-BUILT

REVISD: JULY 27, 2005 ~ ELEVATIONS - 05701 - D

ELLIS, CURTIS & KOOKER, INC.
LAND SURVEYORS AND PLANNERS
(LB # 3080)

1660 EMERSON STREET
JACKSONVILLE, FLORIDA 32207
(904) 396-6334
FAX (904) 396-9997

GENERAL NOTES:
1) This is an AS-BUILT SURVEY.
2) No abstract of Title furnished.
3) Not obstructed for easements.
4) (24.96) DENOTES ELEVATIONS TAKEN BY ELLIS, CURTIS & KOOKER, INC. 3-25-05.

SCALE = 1"=30'

Not valid unless Surveyor's Official Seal is embossed hereon.

DATE: 4-1-05 F.B. / PK C/C DRAFTSMAN: J A B ORDER #05194 - D

AS-BUILT

DATE: 4-1-05
INFORMATION PROVIDED BY: LOUIS J. EVERETT
NAME: LOUIS J. EVERETT
ADDRESS: 1660 EMERSON STREET
JACKSONVILLE, FLORIDA 32207
PHONE NO.: (904) 396-6334

I HEREBY CERTIFY THAT THE:
PAVEMENT WATER MAIN
CURB & GUTTER SANITARY GRAVITY SYSTEM
STORM & DRAINAGE FORCE MAIN
SYSTEM LIFT STATION

ARE AT THE HORIZONTAL AND VERTICAL LOCATIONS AS SHOWN ON THESE "AS-BUILT" DRAWINGS AND MEET THE MINIMUM TECHNICAL STANDARDS SET FORTH BY THE FLORIDA BOARD OF LAND SURVEYORS PURSUANT TO SECTION 472.027, FLORIDA STATUTES AND THAT THERE ARE NOT ANY ENCROACHMENTS WITHIN THE EASEMENTS OR RIGHT-OF-WAY, EXCEPT AS SHOWN.

SIGNATURE: *Louis J. Everett*
NAME: LOUIS J. EVERETT
PROFESSIONAL LAND SURVEYOR NO.: 4099

AS-BUILT

INFORMATION PROVIDED BY: *8/5/05*
DATE: *8/5/05*
NAME: ONAS CORPORATION
ADDRESS: 2044 UNIVERSITY BLVD. N.
JACKSONVILLE, FLORIDA 32211
PHONE (904) 745-0508

CONTRACTOR:
I HEREBY CERTIFY THAT THE MATERIALS AND QUANTITIES USED IN CONSTRUCTION OF:
PAVEMENT WATER MAIN
CURB & GUTTER SANITARY GRAVITY SYSTEM
STORM & DRAINAGE FORCE MAIN
SYSTEM LIFT STATION

ARE IN ACCORDANCE WITH THE APPROVED PLANS AND CITY SPECIFICATIONS, UNLESS OTHERWISE APPROVED BY THE CITY ENGINEER

SIGNATURE: *Bondie Onas*
NAME: BONDIE ONAS
UNDERGROUND UTILITY LICENSE NUMBER: 2405749

Rev-Bor	Rev-C	Rev-D	Rev-E	Rev-F	Rev-G	Rev-H	Rev-I	Rev-J	Rev-K	Rev-L	Rev-M	Rev-N	Rev-O	Rev-P	Rev-Q	Rev-R	Rev-S	Rev-T	Rev-U	Rev-V	Rev-W	Rev-X	Rev-Y	Rev-Z																			
ETMAG-BOR PROJ-NO	DR-BOR	DES-BOR	CHK-BOR	SOT	DATE																																						
TOP-TITLE																																											
MID-TITLE																																											
BOT-TITLE																																											
TITLE UNIT CITY-TITLE																																											
England-Thims & Miller, Inc.																																											
ENGINEERS - PLANNERS - SURVEYORS - LANDSCAPE ARCHITECTS																																											
14776 ST. AUGUSTINE ROAD JACKSONVILLE, FLORIDA 32256																																											
CERTIFICATE OF AUTHORIZATION NUMBER: 2584																																											
PHONE NUMBER (904) 642-6890 FAX NUMBER (904) 646-9465																																											
DR-NO																																											
WMDNO																																											



