

DATE: OCTOBER 2006

SCALE: 1" = 40'

PROJECT NO.: F00852.01

FILE NO.: F00852.01F001

FIGURE NO.: C-1

CONSULTANT/Engineer:

1501 OMNI WAY, ST. CLOUD, FLORIDA 34773

TEL: 407-841-3720 FAX: 407-841-3730

14055 RIVEREDGE DRIVE, SUITE 200, TAMPA, FLORIDA 33637 USA

TEL: 813-558-0990 FAX: 813-558-9726

AUTHORIZATION CERTIFICATE NO. 00004321

OWNER/Property:

AVIUSMAN GURITA

CERTIFICATE NO. 54023

PROJECT:

CELL 3

OAK HAMMOCK DISPOSAL FACILITY

LINEAR TOP OF SUBBASE AS-BUILT

REV. NO.

DATE

DESCRIPTION

DES. BY

DR. BY

CHK. BY

RVW. BY

APP. BY

AG

0

17/OCT/06

SUBMITTAL TO RFP

-

NOTE:

1. AS BUILT DRAWING IS BASED ON SURVEYS PERFORMED BY HARTMAN AND ASSOCIATES, INC., ORLANDO, FLORIDA

AS-BUILT SURVEY POINT AND ELEVATION PROVIDED BY HARTMAN & ASSOCIATES, INC.

TOP OF SUBBASE ELEVATION (FEET)

91.01

LEGEND

90


91.01

SCALE: 1" = 40'

0 20 40 80


NORTH



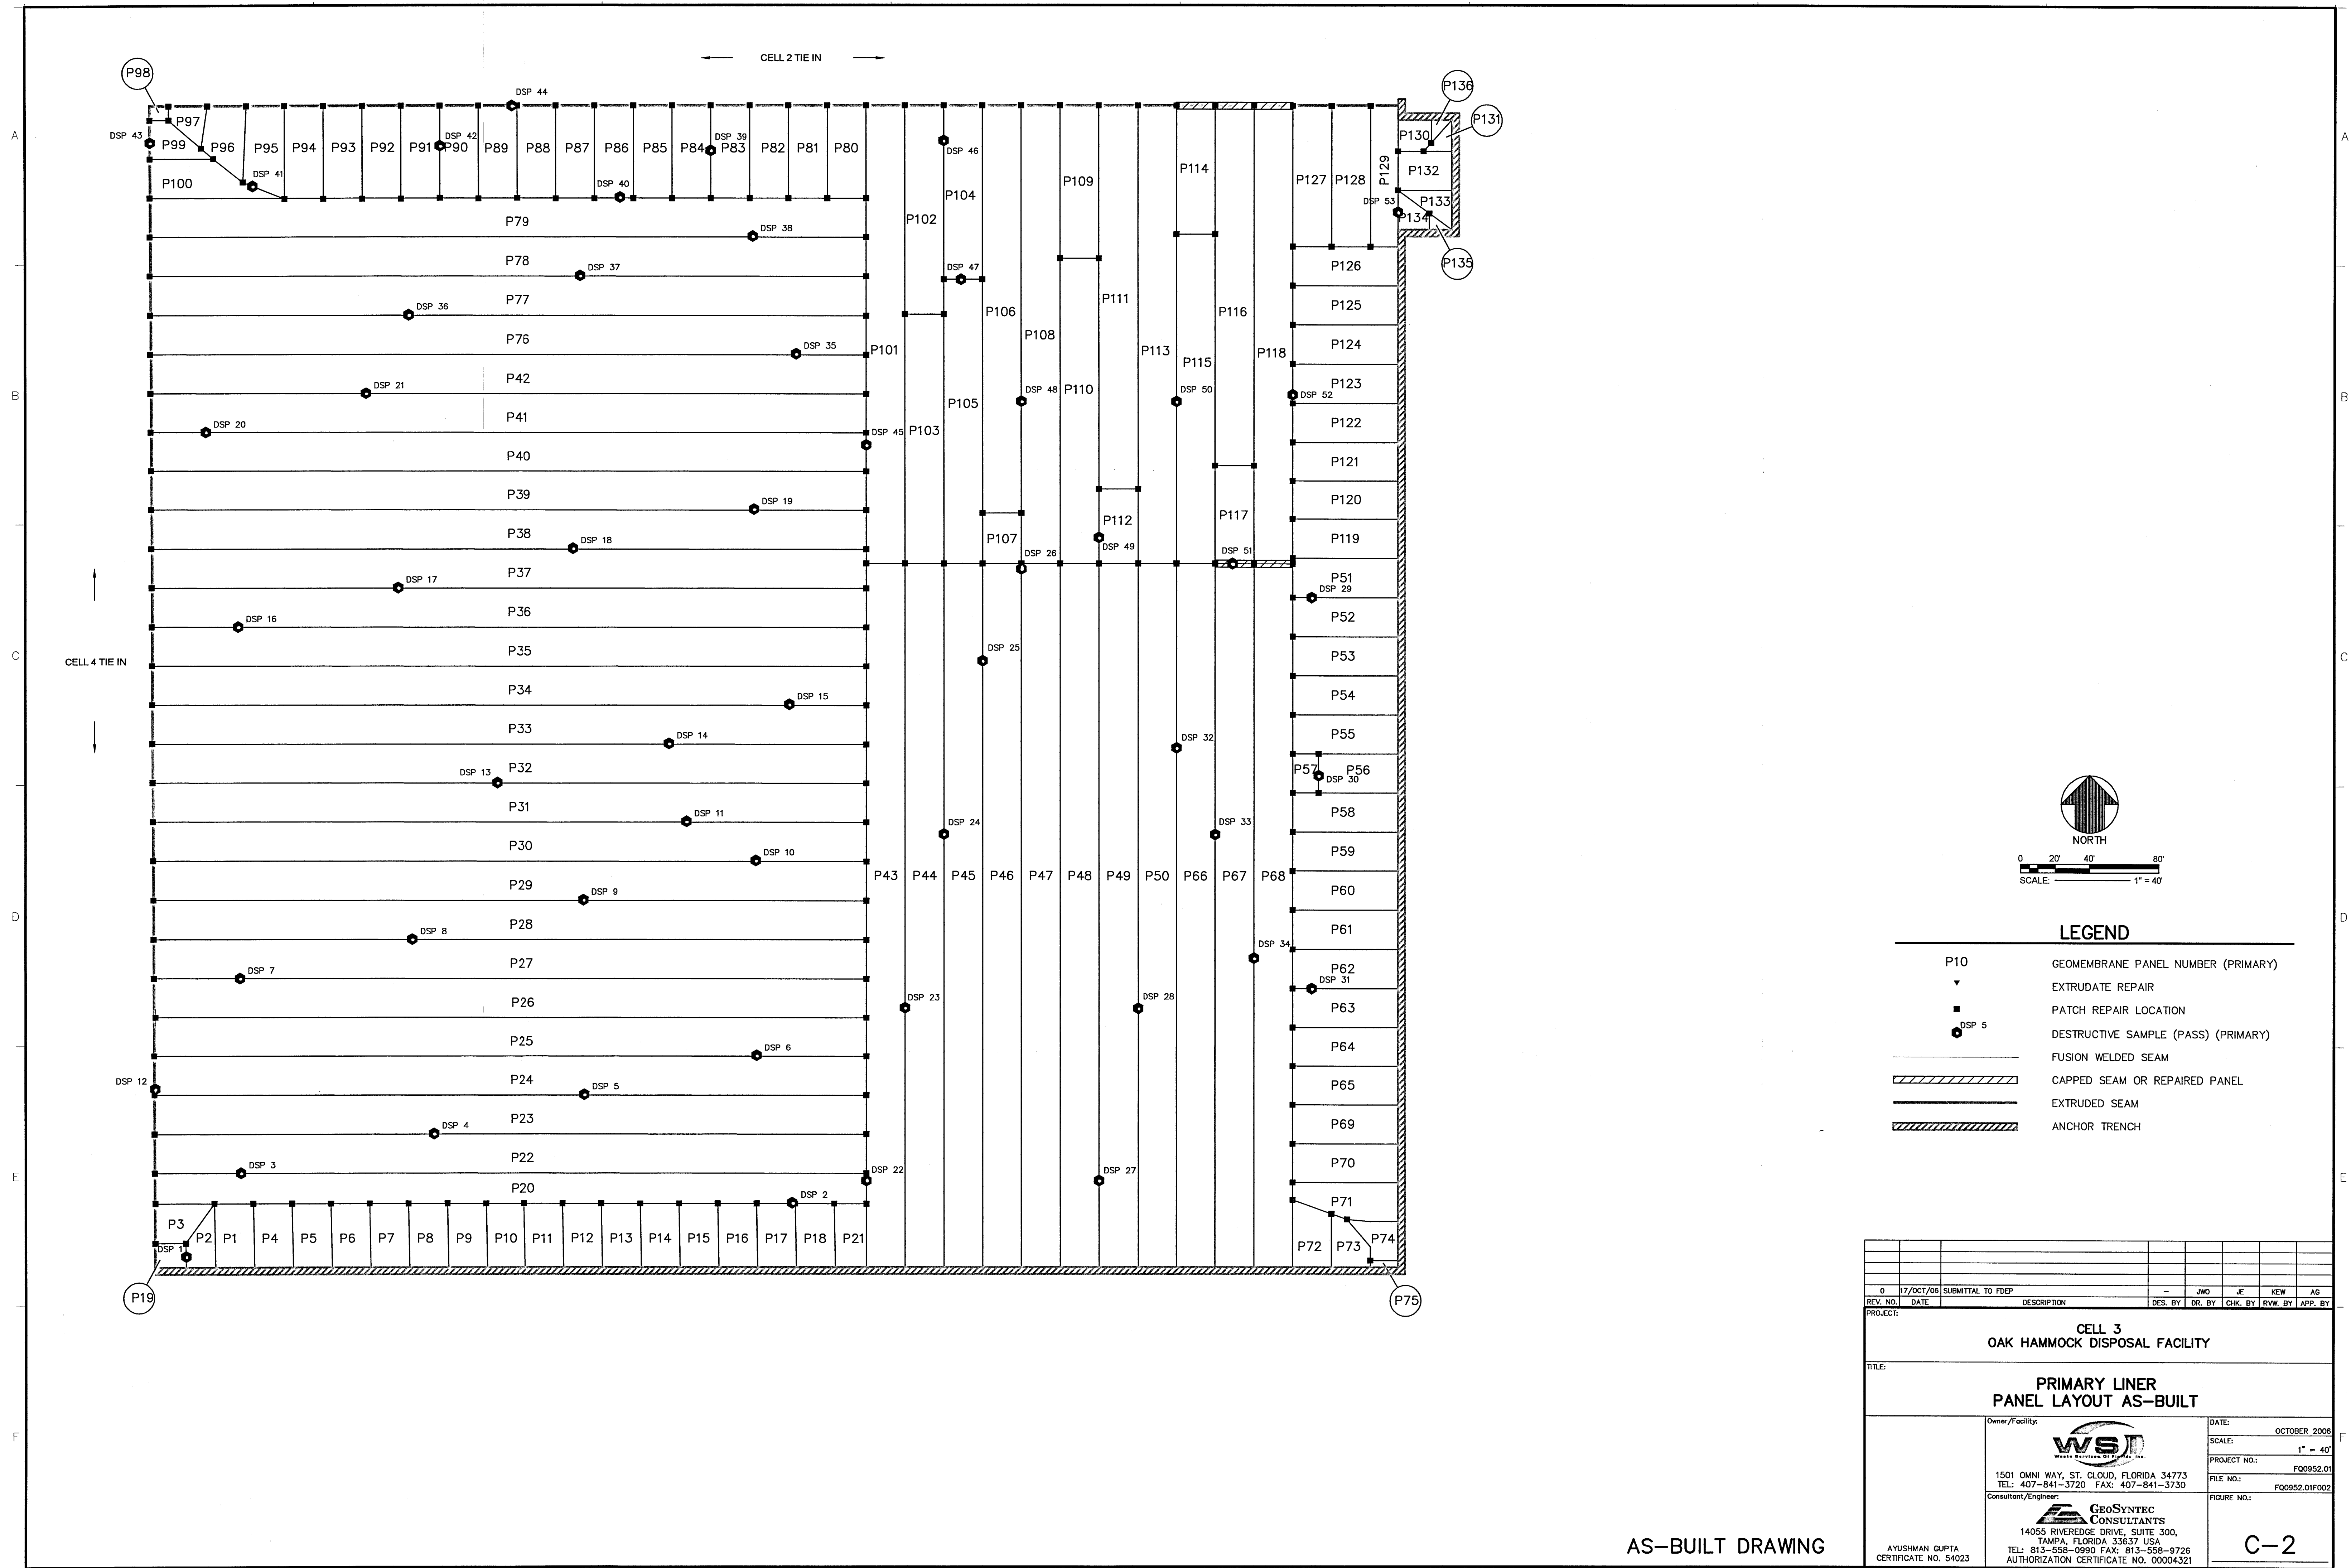

AS-BUILT DRAWING



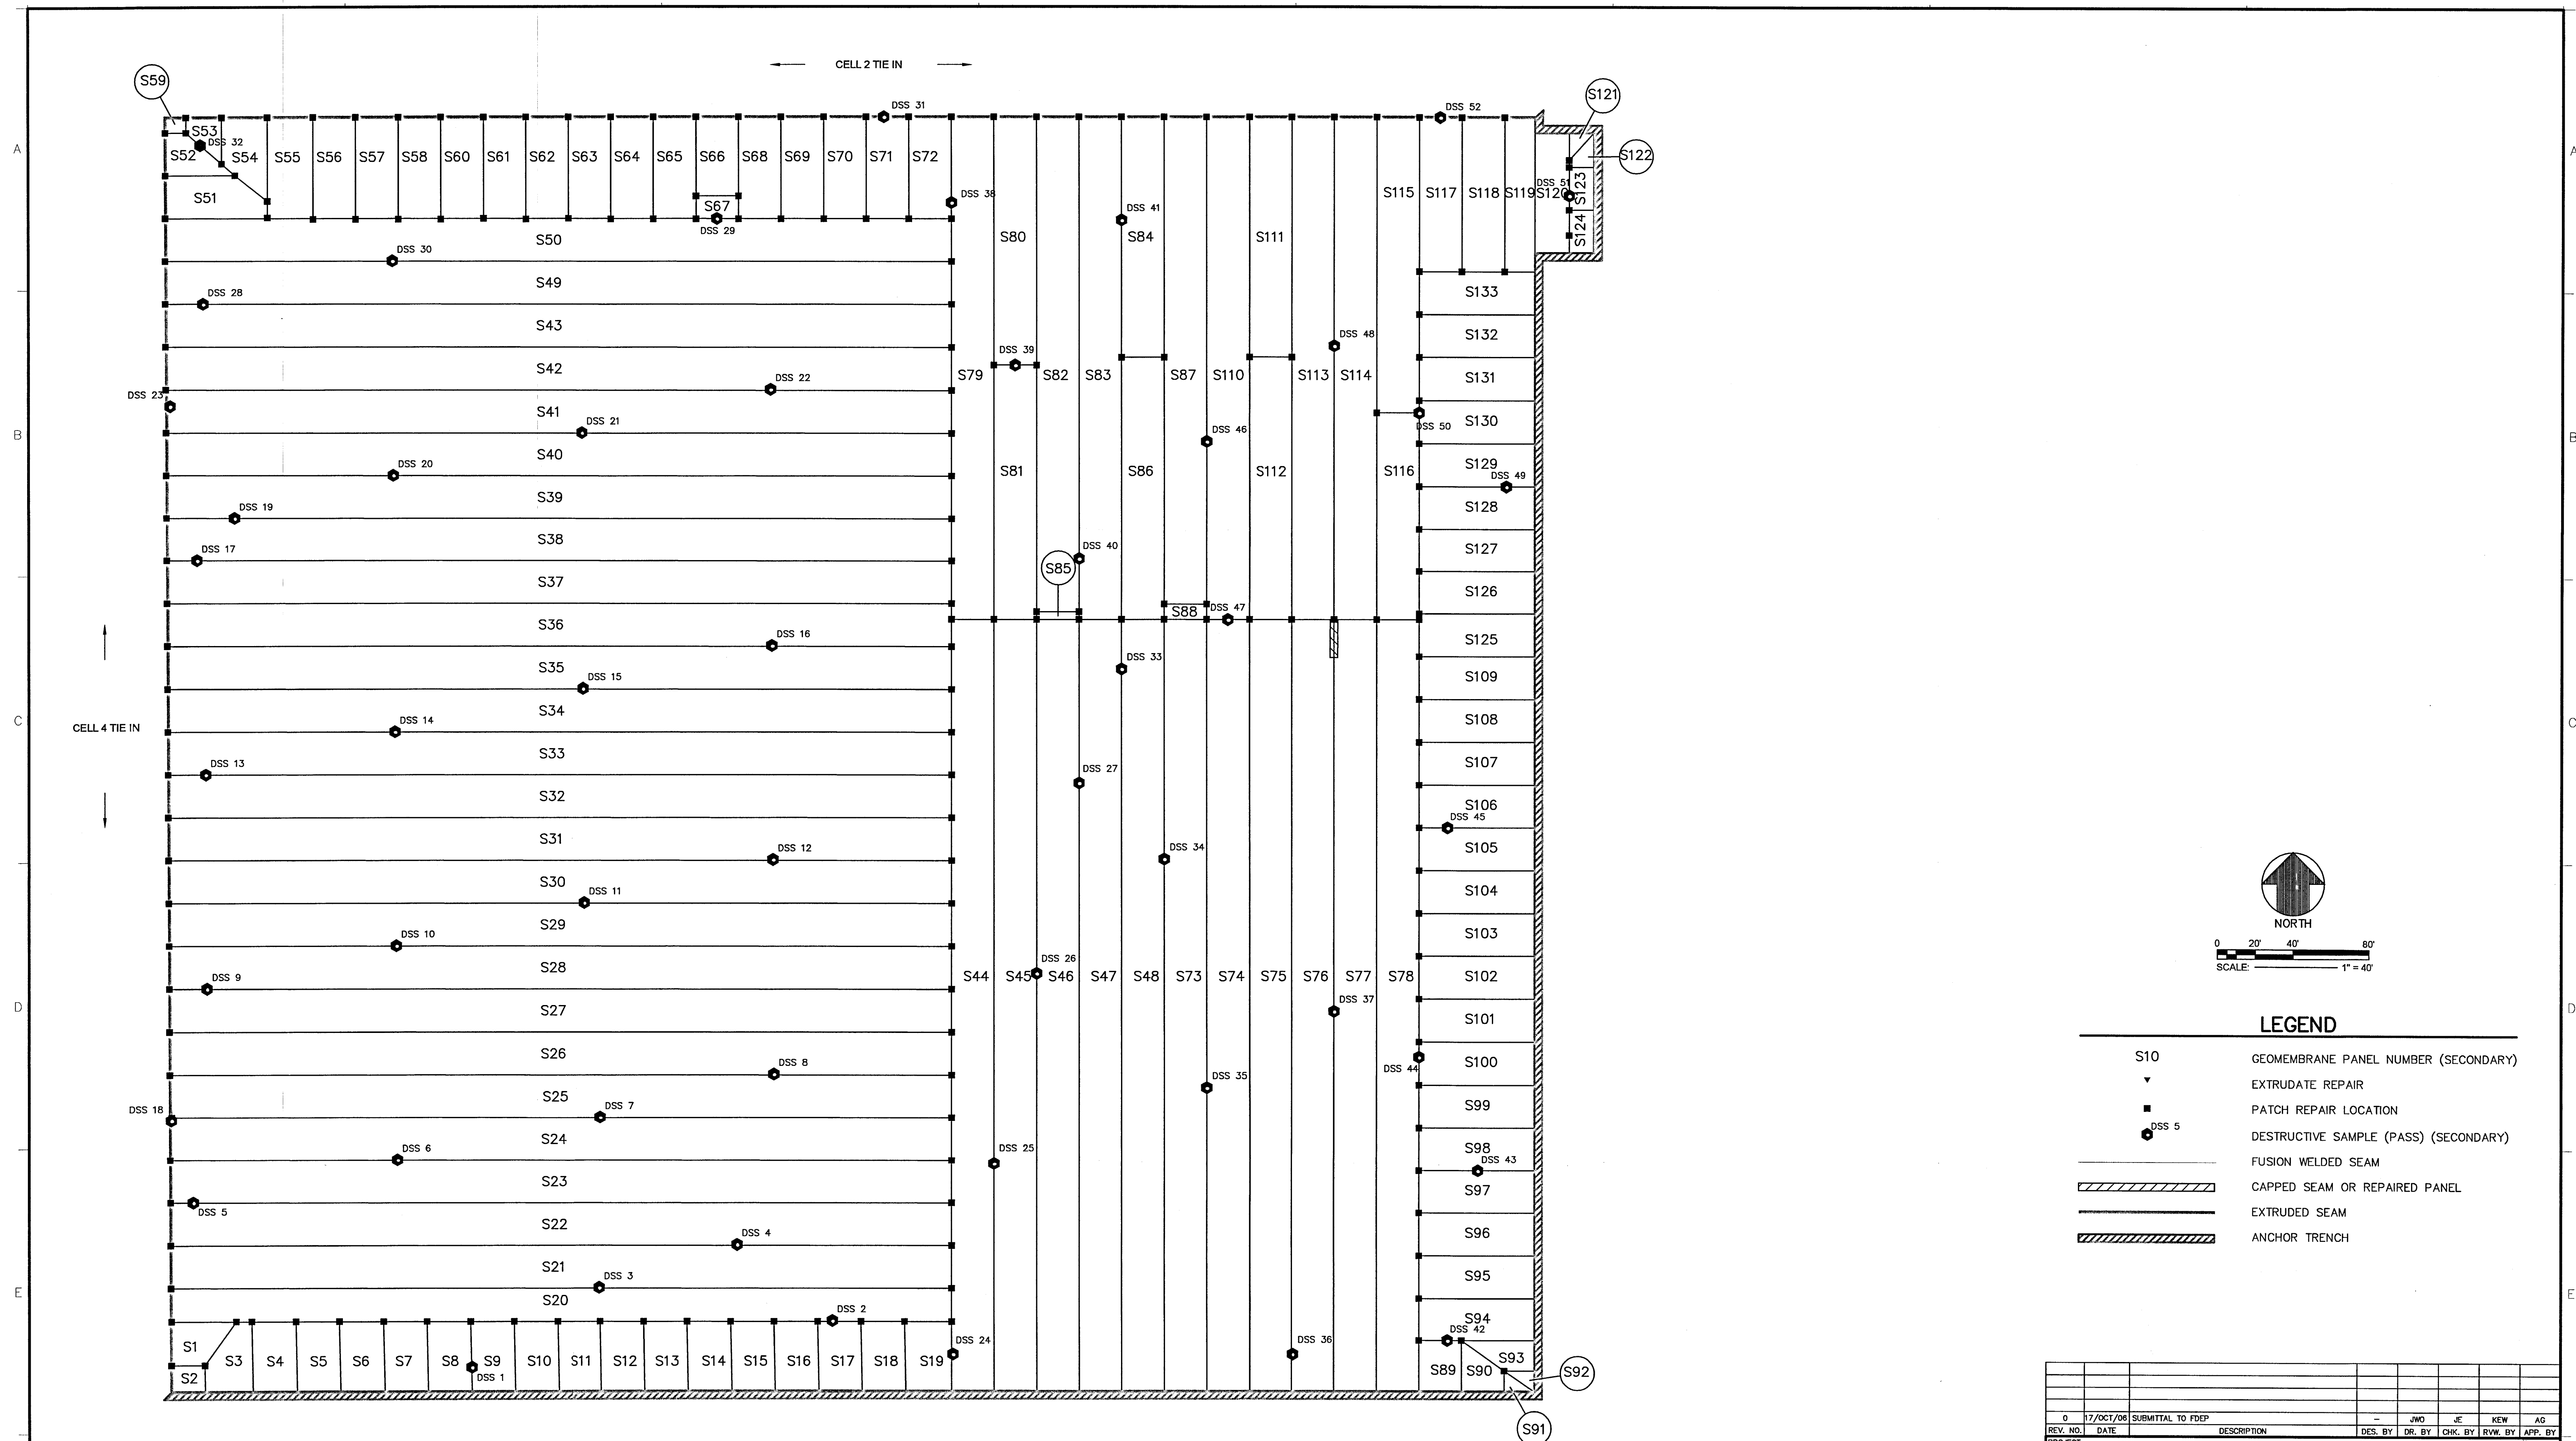

AS-BUILT DRAWING

[illegible]