

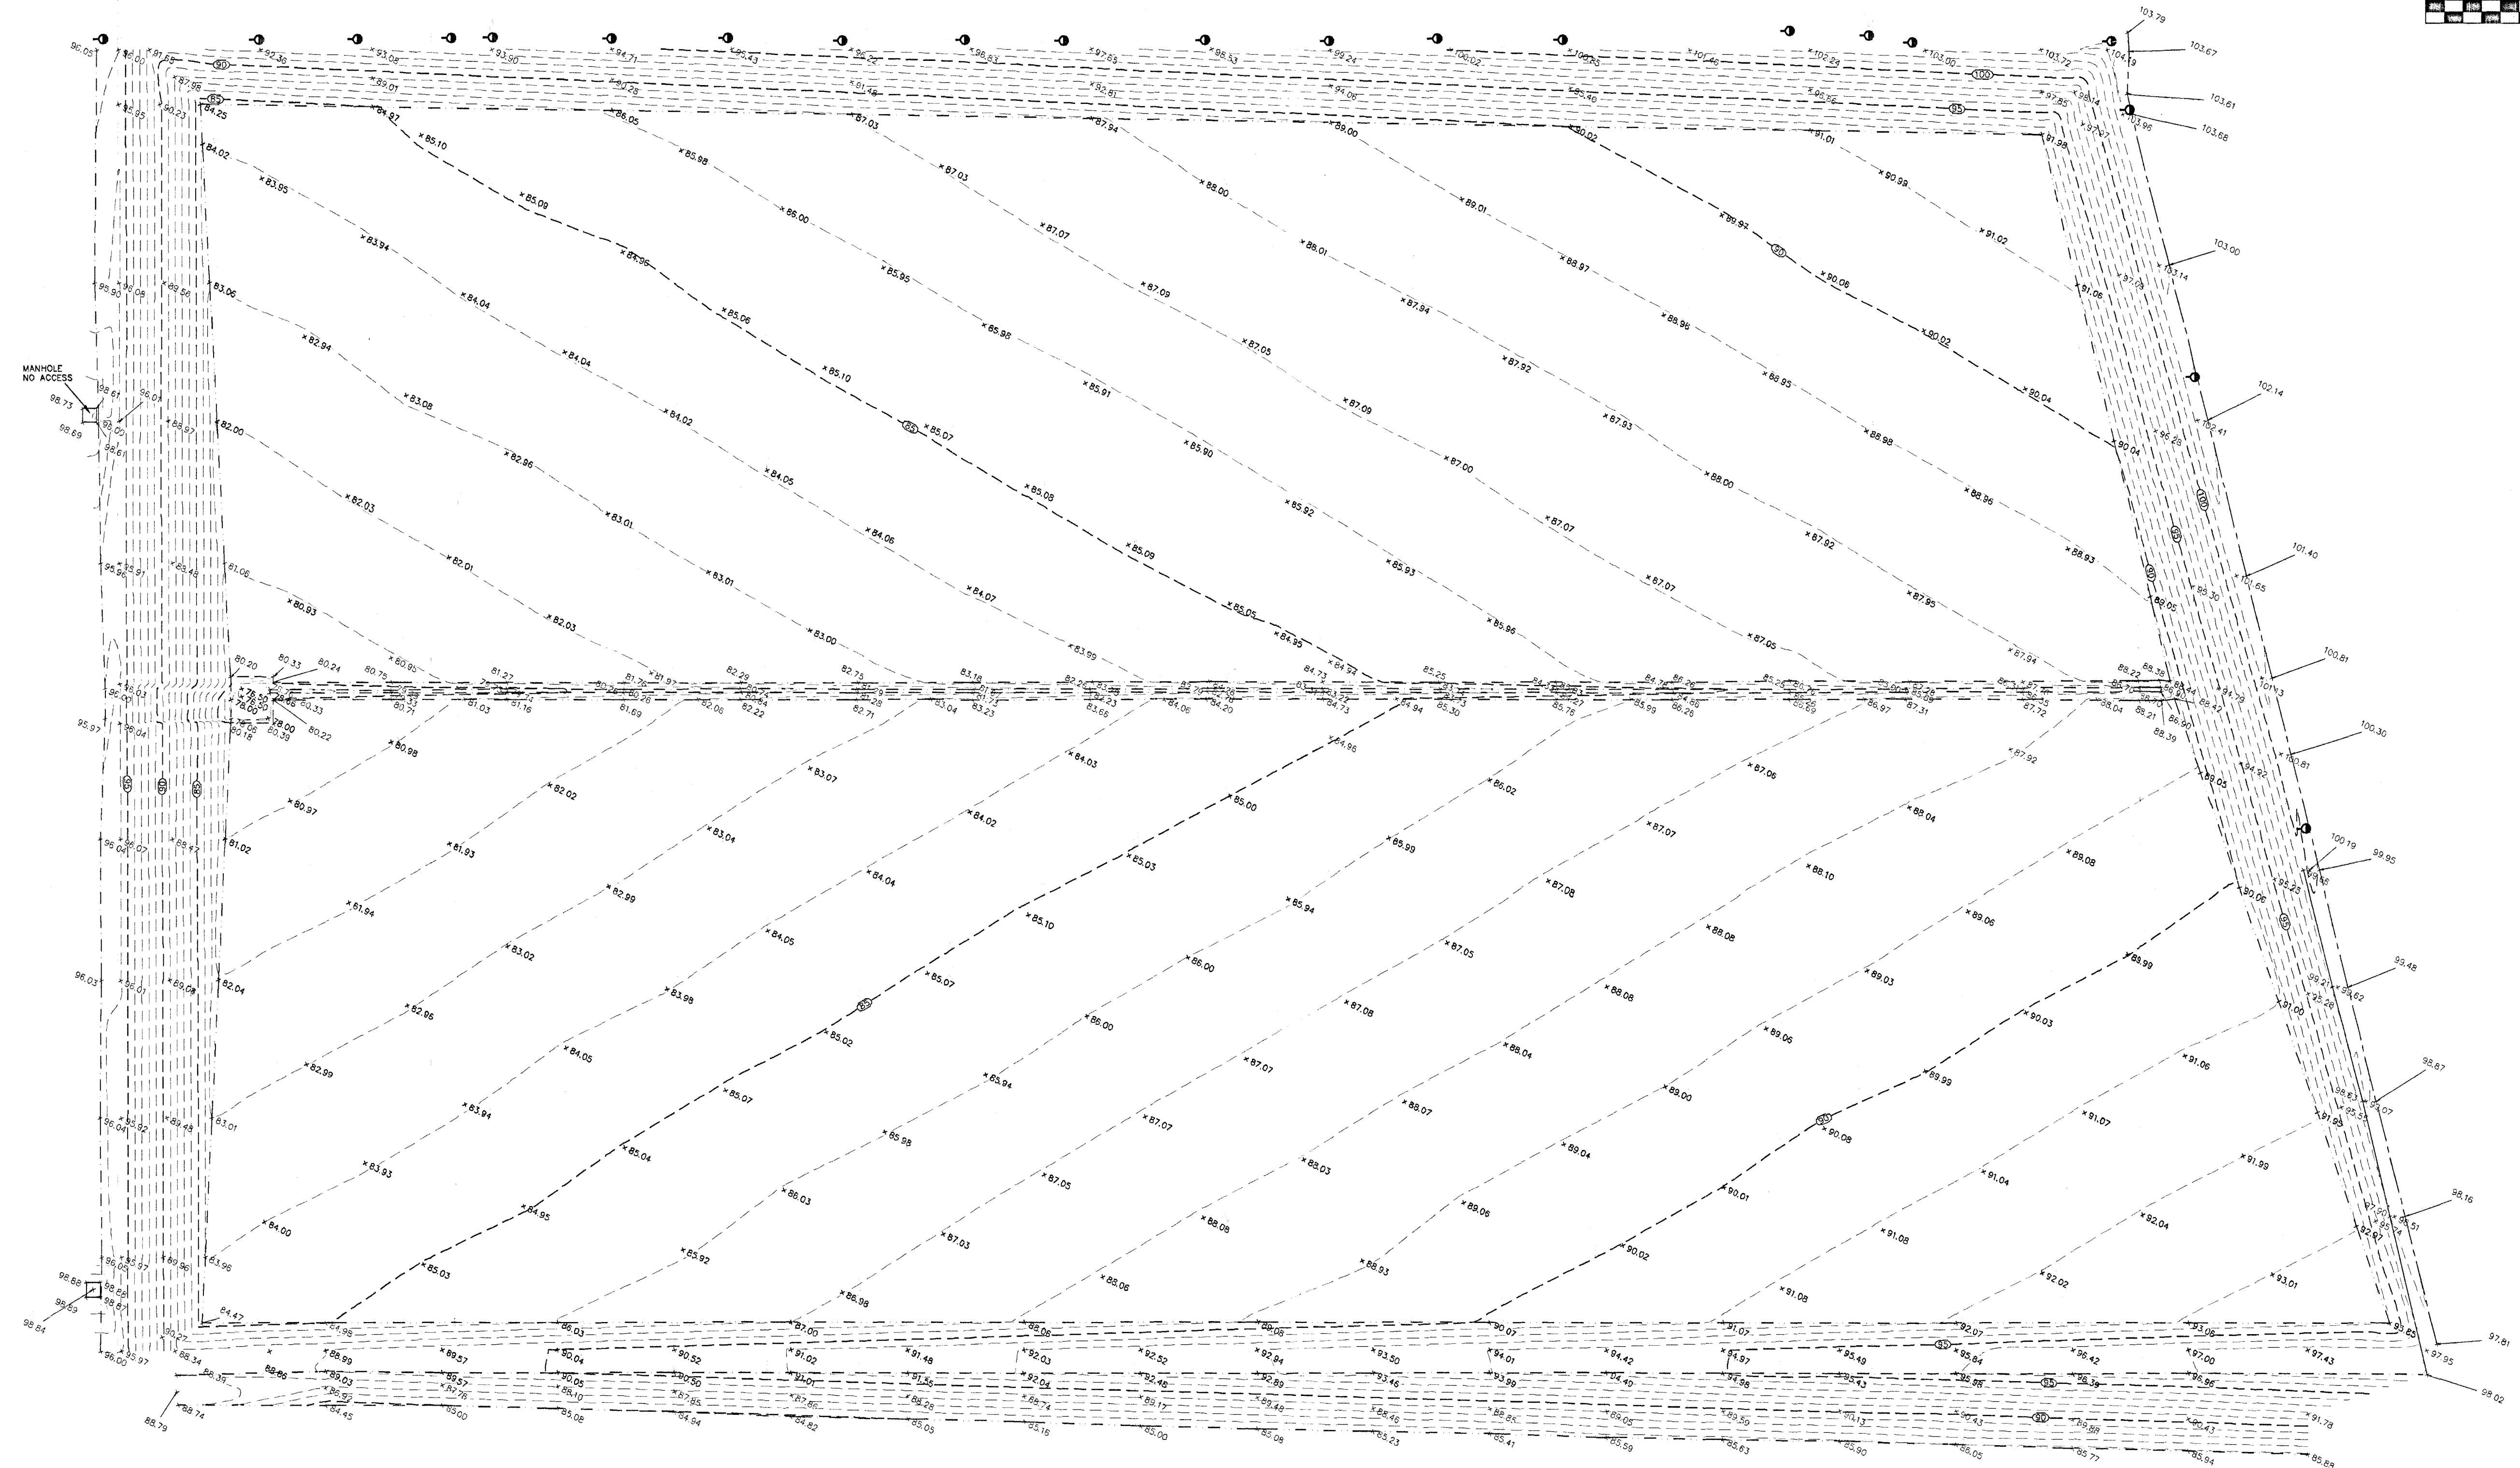
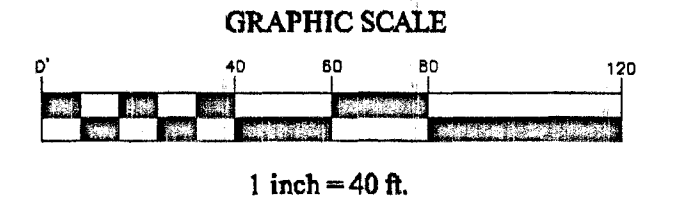


AS-BUILT SURVEY

- LEGEND:**
- NO. NUMBER
 - ELEV. ELEVATION
 - AS-BUILT SPOT ELEVATION - SUBGRADE
 - LB LICENCE BUSINESS
 - AS-BUILT SUBGRADE CONTOUR (5 FOOT INTERVAL)
 - AS-BUILT SUBGRADE CONTOUR (1 FOOT INTERVAL)
 - TOE OF SLOPE
 - TOP OF SLOPE
 - EXISTING LINER MARKER
 - AS-BUILT LINER TIE-IN

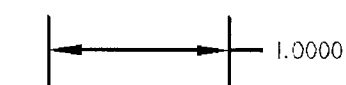

THIS SURVEY IS NOT VALID WITHOUT THE SIGNATURE AND ORIGINAL SEAL OF A LICENSED SURVEYOR AND MAPPER. FILE NAME: 113-JED-Helpaw-subbase	
Drawn By: DLP Party Code: DR Field Book: 113-JED-Helpaw-subbase Page: 1	PEAVEY & ASSOCIATES SURVEYING & MAPPING PA FLORIDA 690 ALICE PLACE BARTOW, FL 33830 PHONE: 883-739-4960
CLIENT: ERC GENERAL CONTRACTOR 890 Center Road Suite 170 Winter Garden, FL 34787	
AS-BUILT SURVEY - TOP OF LINER SUBBASE CELL 7 CONSTRUCTION J.E.D. SOLID WASTE MANGEMENT FACILITY 1501 OMNI WAY ST. CLOUD, FL	
RECEIVED NOV 01 2010 DEP Central Dist.	
SCALE: 1"=40' PROJECT NO: 113	DRAWING NO: 173 SHEET: 1 OF 3


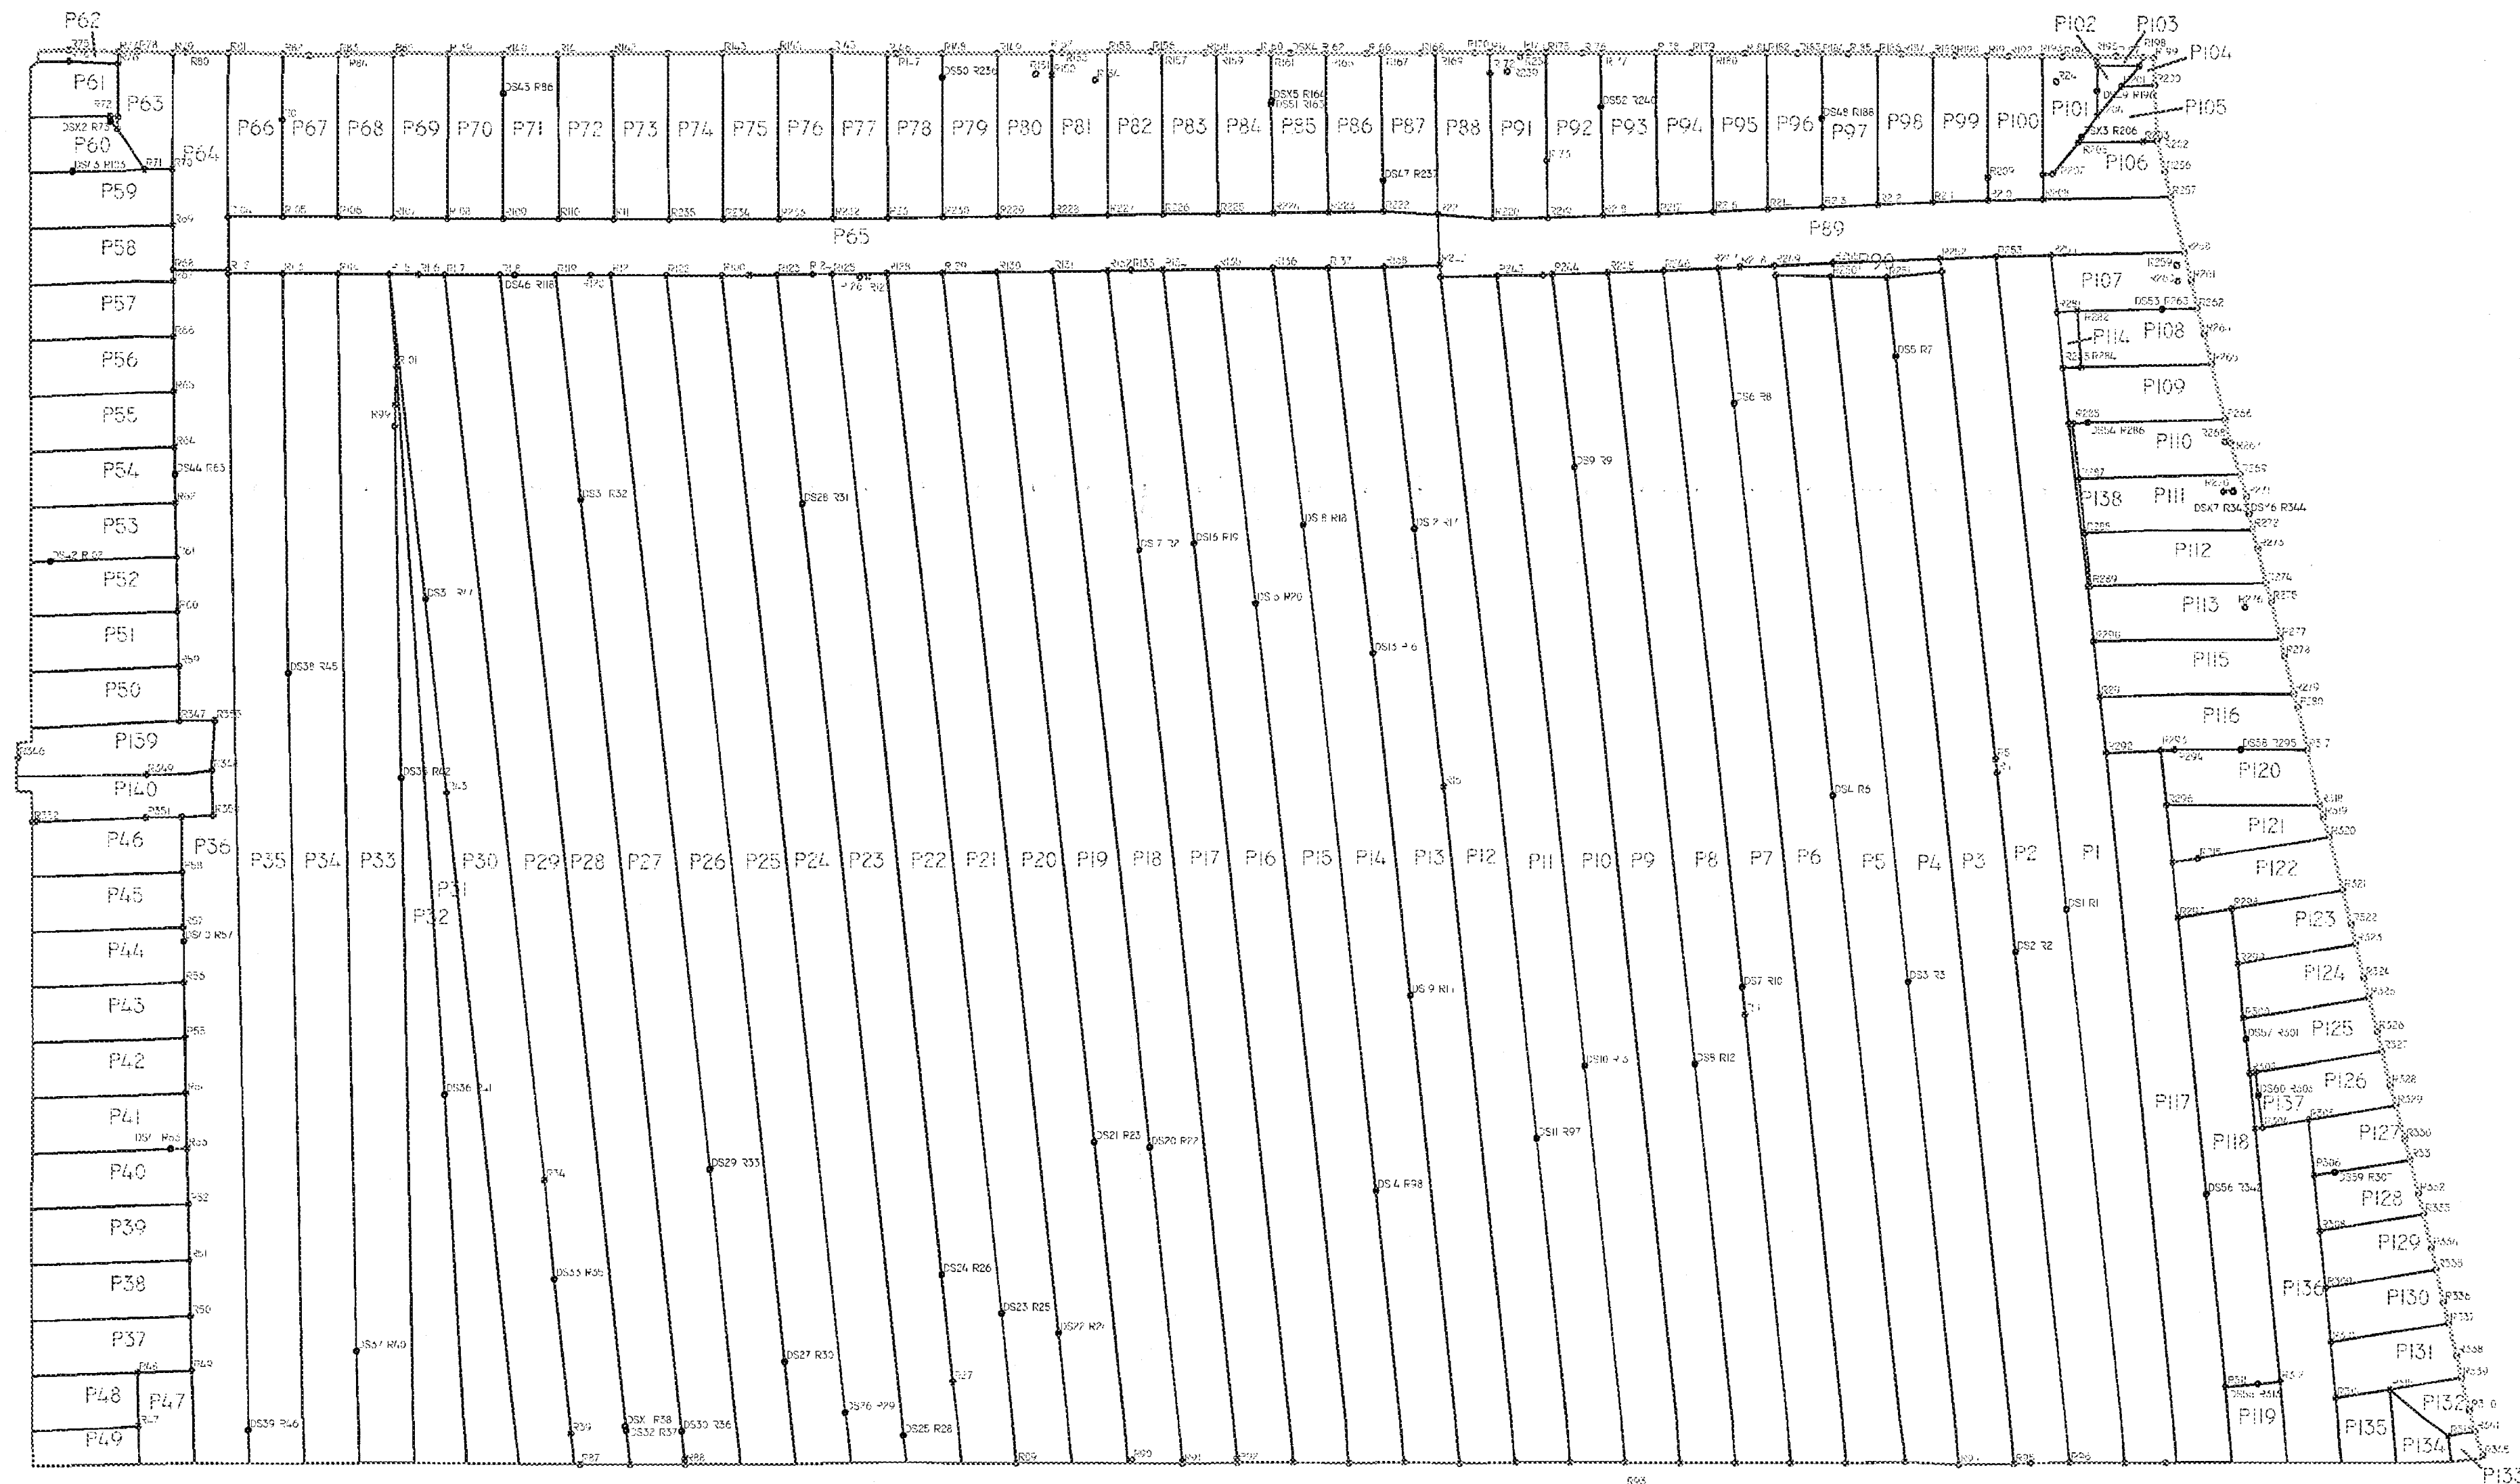


PLOT SCALE: 1" = 50'
PROJECT NO.: 03103981

LEGEND

P	PANEL NUMBER	—	CAP
R	REPAIR NUMBER	○	PATCH
DT	DESTRUCTIVE TEST NUMBER	○	DESTRUCTIVE TEST
		—	EXTRUSION WELD

Liner As-Built Survey provided by Comanco Environmental Corporation

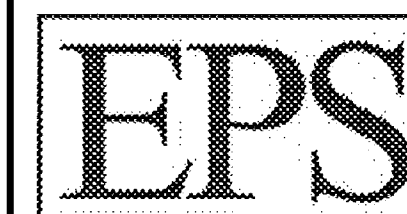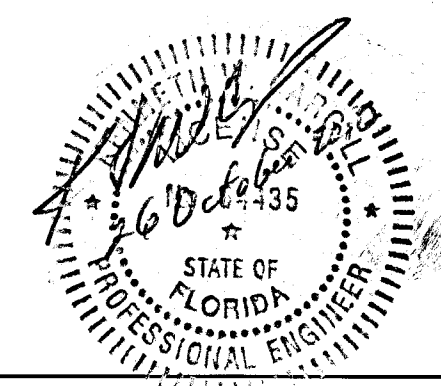

Environmental Planning Specialists, Inc.
900 Ashwood Parkway, Suite 350
Atlanta, GA 30338
Phone: (404) 315-9113
Fax: (404) 315-8509

DES	
DRN	
CHK	
REV	
APP	
PROJ MGR	KW 08/10
OPER	


DATE: August 2010

J.E.D Solid Waste
Management Facility
Osceola County, Florida

Cell 7 Construction
Primary Geomembrane Panel
As-Built Drawing


FIGURE

1

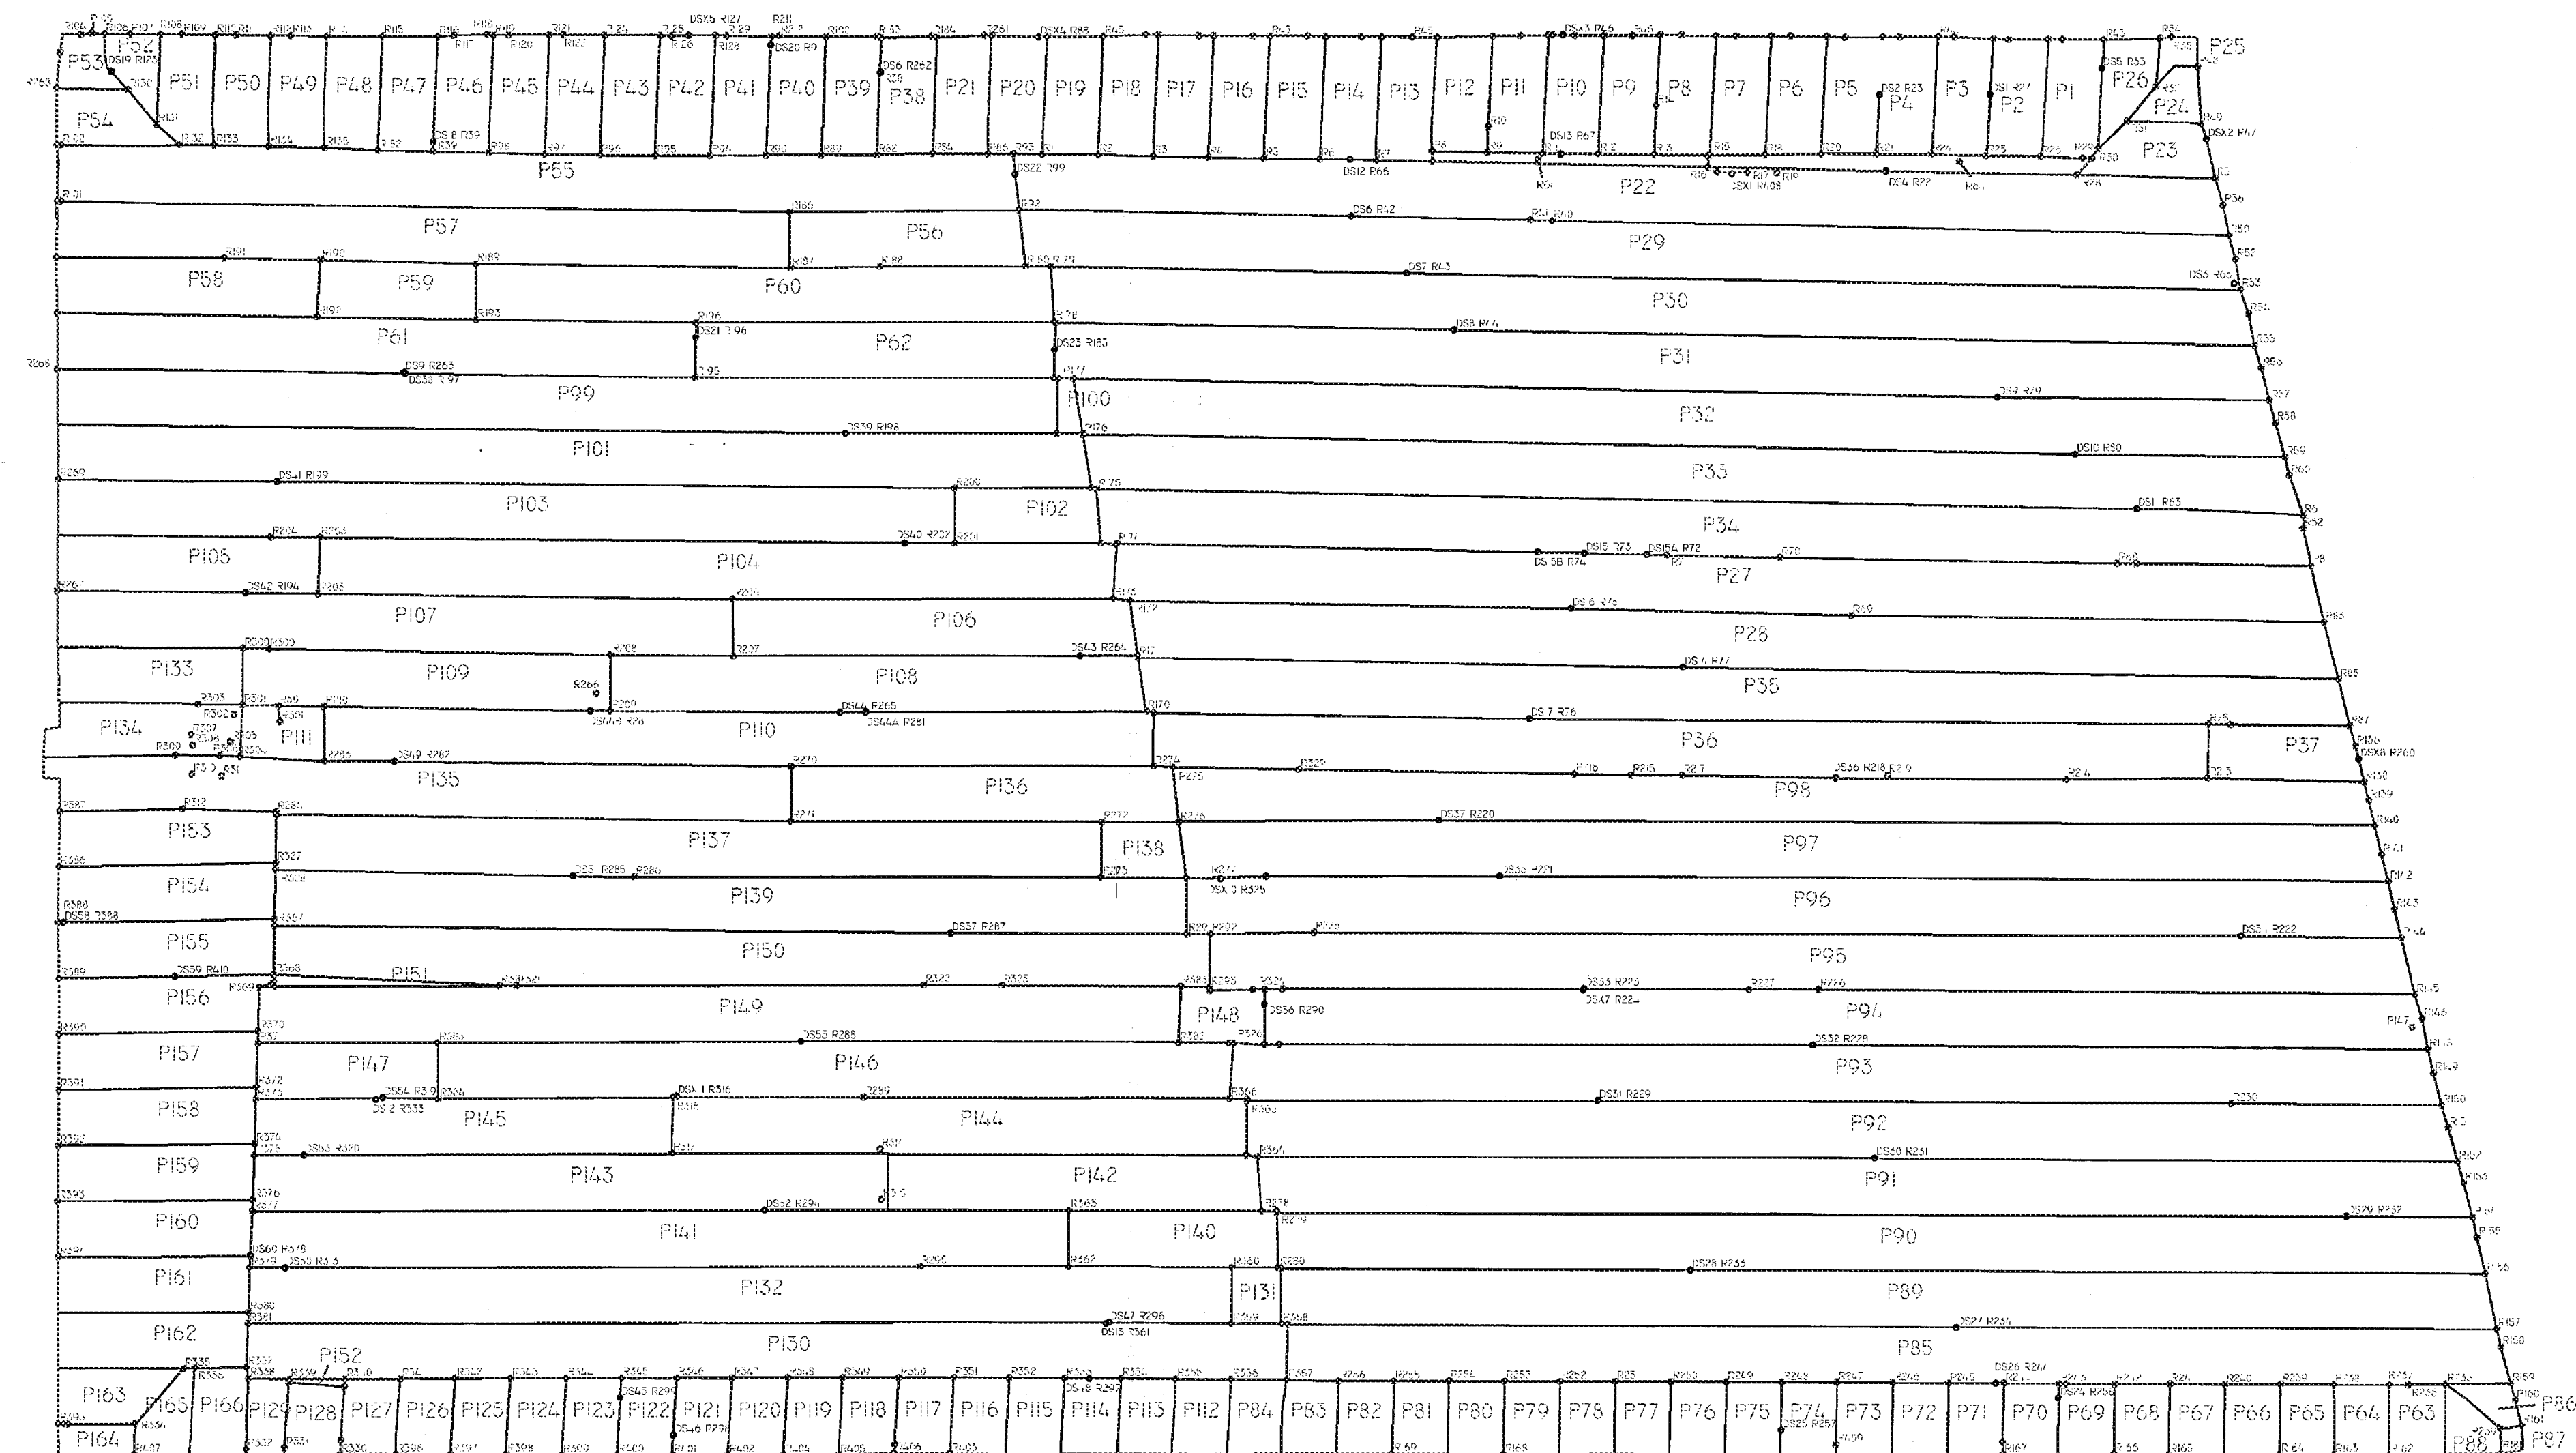

P	PANEL NUMBER		CAP
R	REPAIR NUMBER		PATCH
DT	DESTRUCTIVE TEST NUMBER		DESTRUCTIVE TEST
			EXTRUSION WELD

Environmental Planning Specialists, Inc.
900 Ashwood Parkway, Suite 350
Atlanta, GA 30338
Phone: (404) 315-9113
Fax: (404) 315-8509

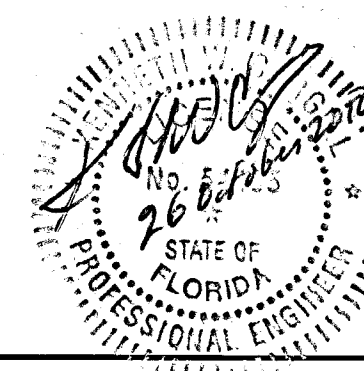

DES			DATE: August 2010	
DRN			J.E.D. Solid Waste Management Facility Osceola County, Florida	
CHK				
REV				
APP				
PROJ MGR	KW	08/2010		
OPER				
Cell 7 Construction Secondary Geomembrane Panel As-Built Drawing				FIGURE 1