


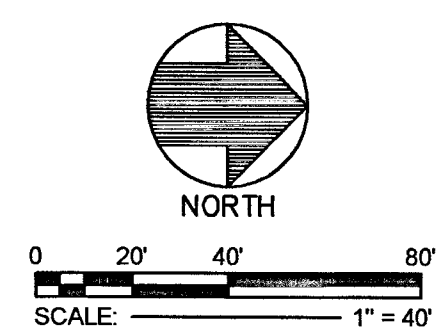

NOTE:

1. AS BUILT DRAWING IS BASED ON SURVEYS PERFORMED BY
HARTMAN AND ASSOCIATES, INC., ORLANDO, FLORIDA



LEGEND

80 TOP OF SUBBASE ELEVATION (FEET)

89.1 AS-BUILT SURVEY POINT AND ELEVATION
PROVIDED BY HARTMAN & ASSOCIATES, INC.

[illegible]

C-1

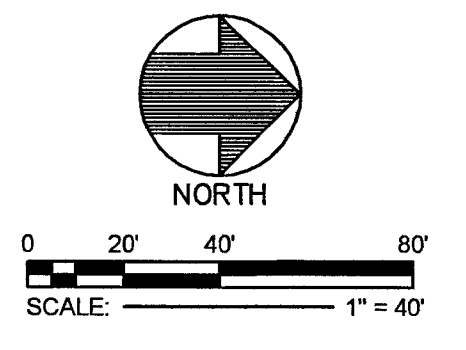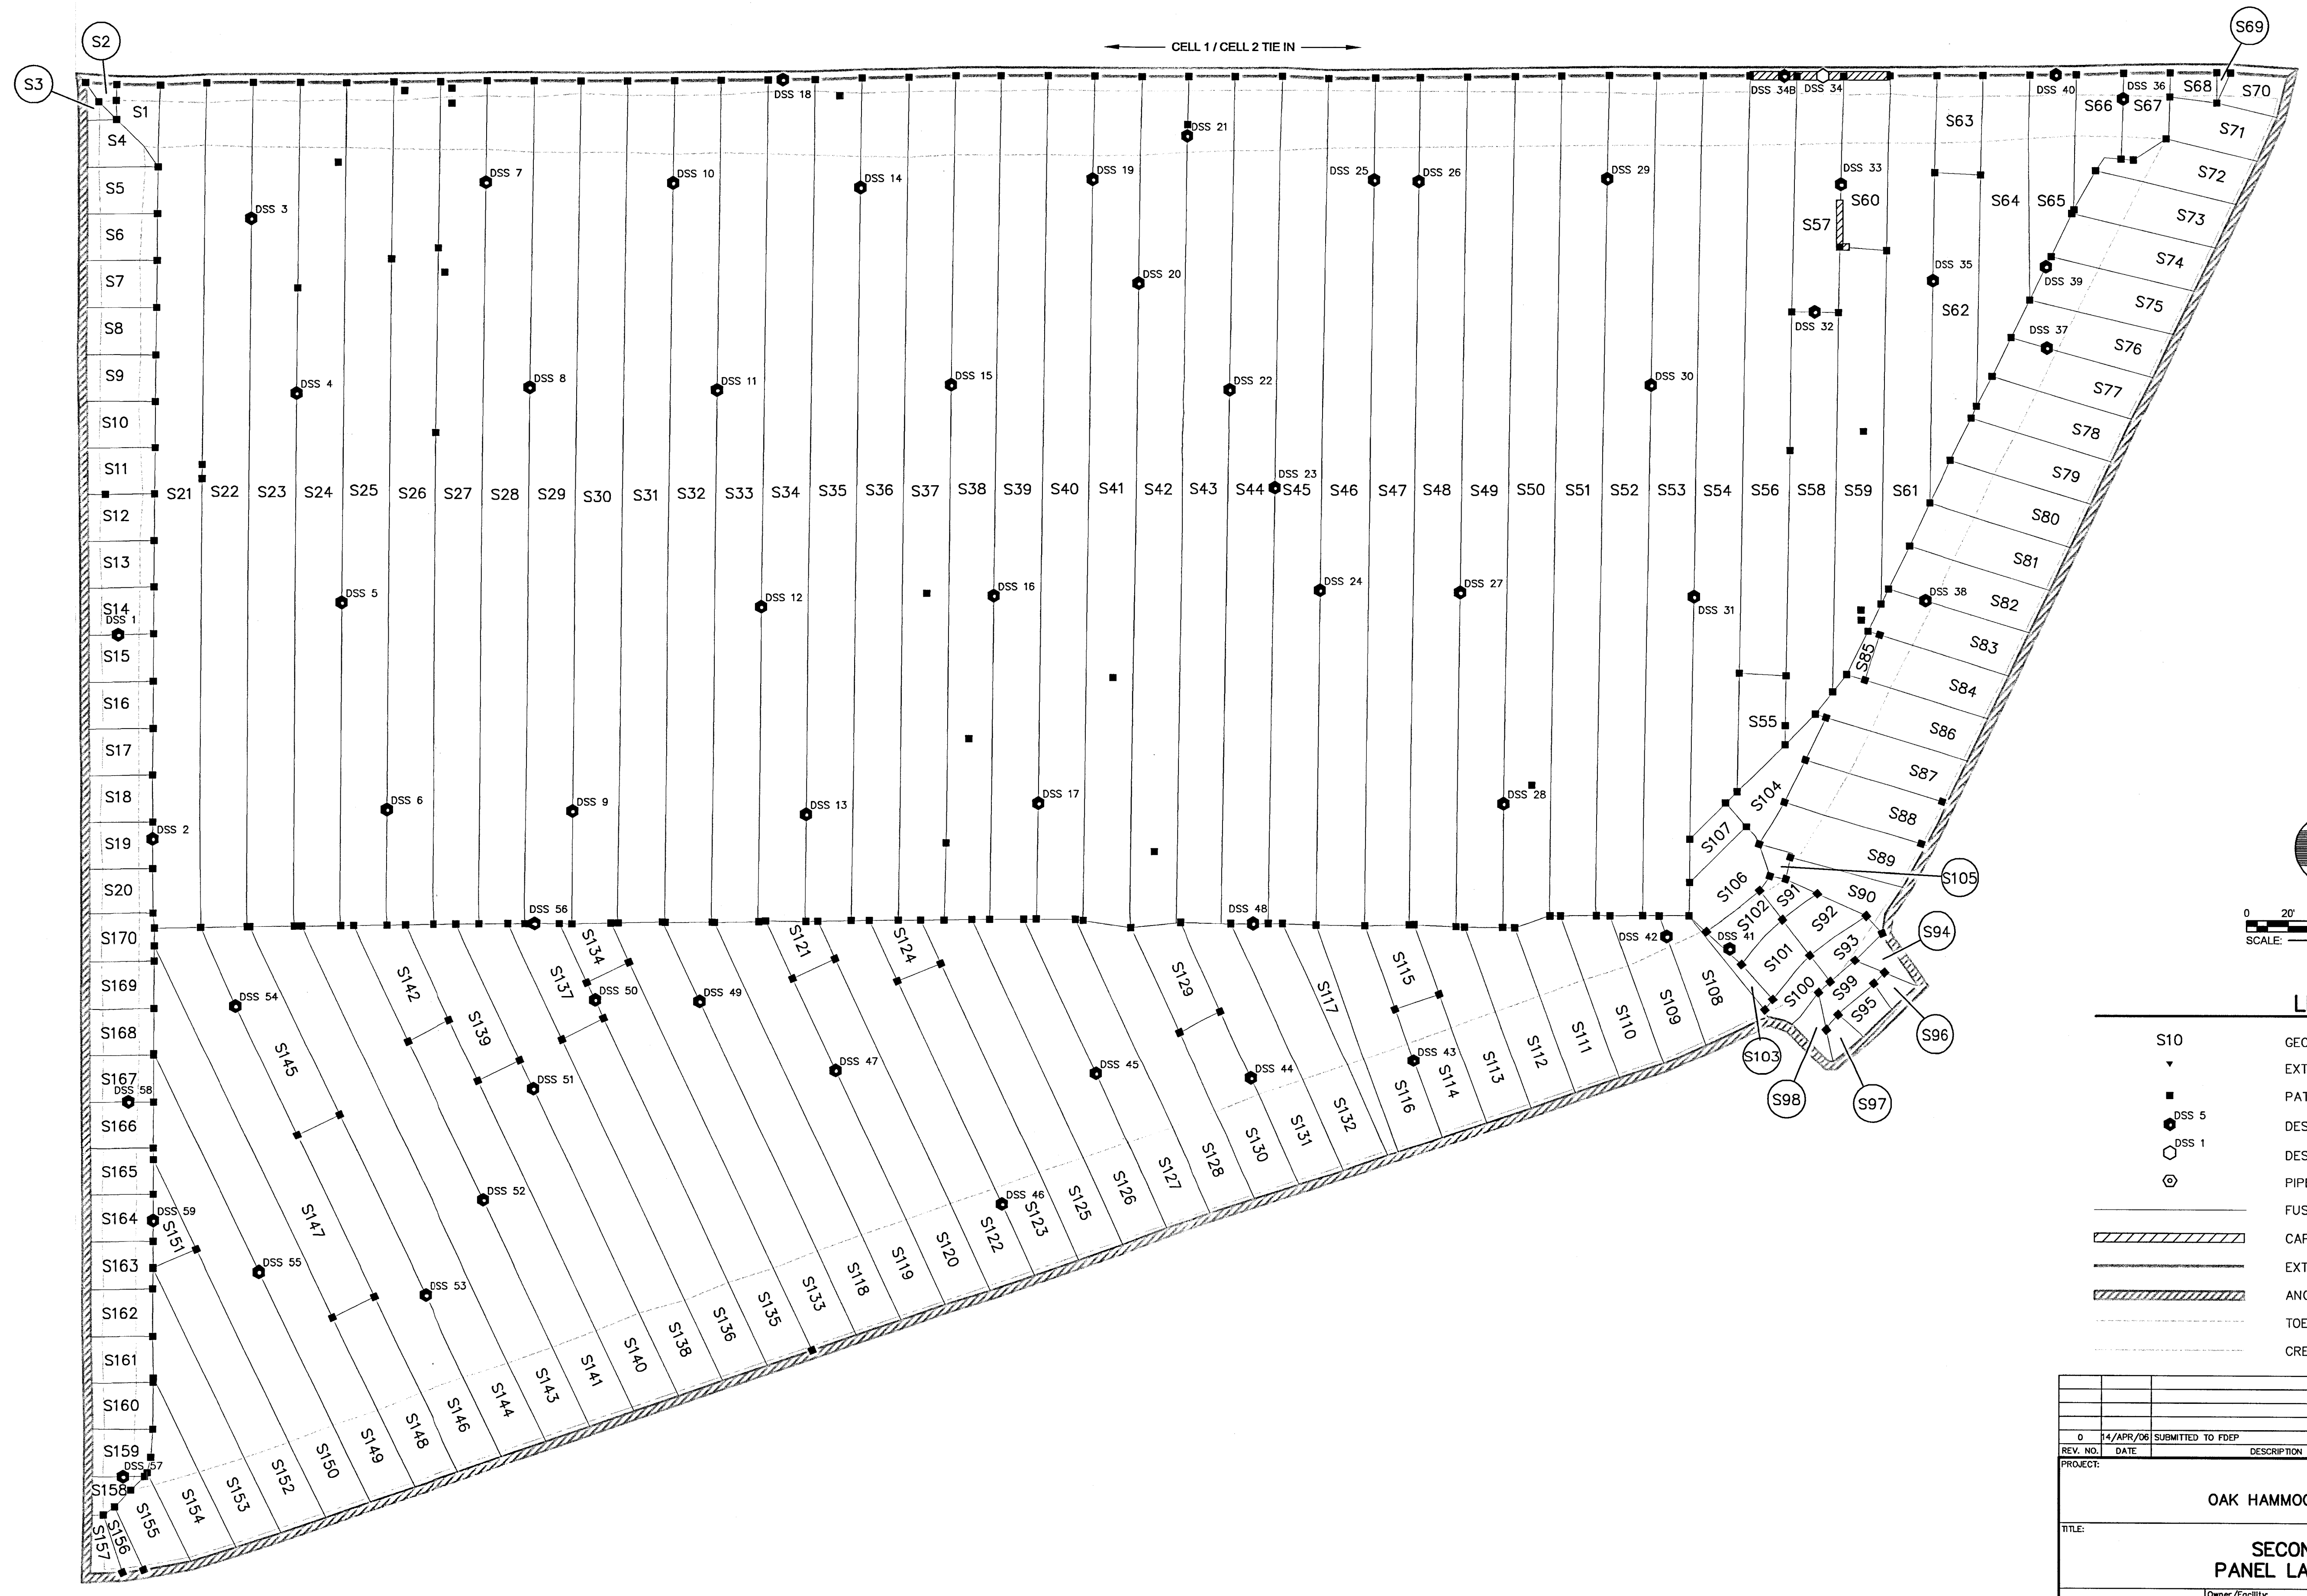

LEGEND

- S10 GEOMEMBRANE PANEL NUMBER (SECONDARY)
- ▼ EXTRUDED REPAIR
- PATCH REPAIR LOCATION
- DSS 5 DESTRUCTIVE SAMPLE (PASS) (SECONDARY)
- DSS 1 DESTRUCTIVE SAMPLE (FAIL) (SECONDARY)
- ⊙ PIPE PENETRATION
- FUSION WELDED SEAM
- ▨ CAPPED SEAM OR REPAIRED PANEL
- EXTRUDED SEAM
- ▨ ANCHOR TRENCH
- TOE
- CREST

0	14/APR/06	SUBMITTED TO FDEP	-	EC:	JE	KEW
REV. NO.	DATE	DESCRIPTION	DES. BY	DR. BY	CHK. BY	RVW. BY
PROJECT:						

CELL 2
OAK HAMMOCK DISPOSAL FACILITY

SECONDARY LINER
PANEL LAYOUT AS-BUILT

Owner/Facility:	DATE: APRIL
1501 OMNI WAY, ST. CLOUD, FLORIDA 34773 TEL: 407-841-3720 FAX: 407-841-3730	SCALE: 1"
Consultant/Engineer:	PROJECT NO.: F00852
GeoSYNTEC CONSULTANTS 14055 RIVEREDGE DRIVE, SUITE 300, TAMPA, FLORIDA 33637 USA TEL: 813-558-0990 FAX: 813-558-9726 AUTHORIZATION CERTIFICATE NO. 00004321	FIGURE NO.: F00852
AYUSHMAN GUPTA CERTIFICATE NO. 54023	C-3

AS-BUILT DRAWING

