
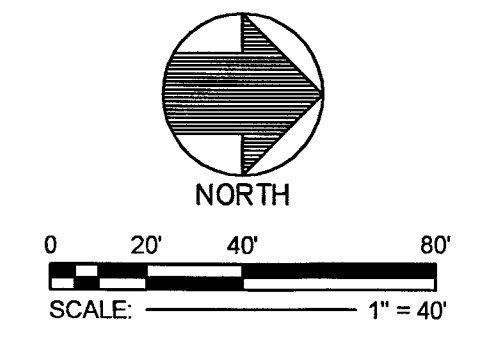


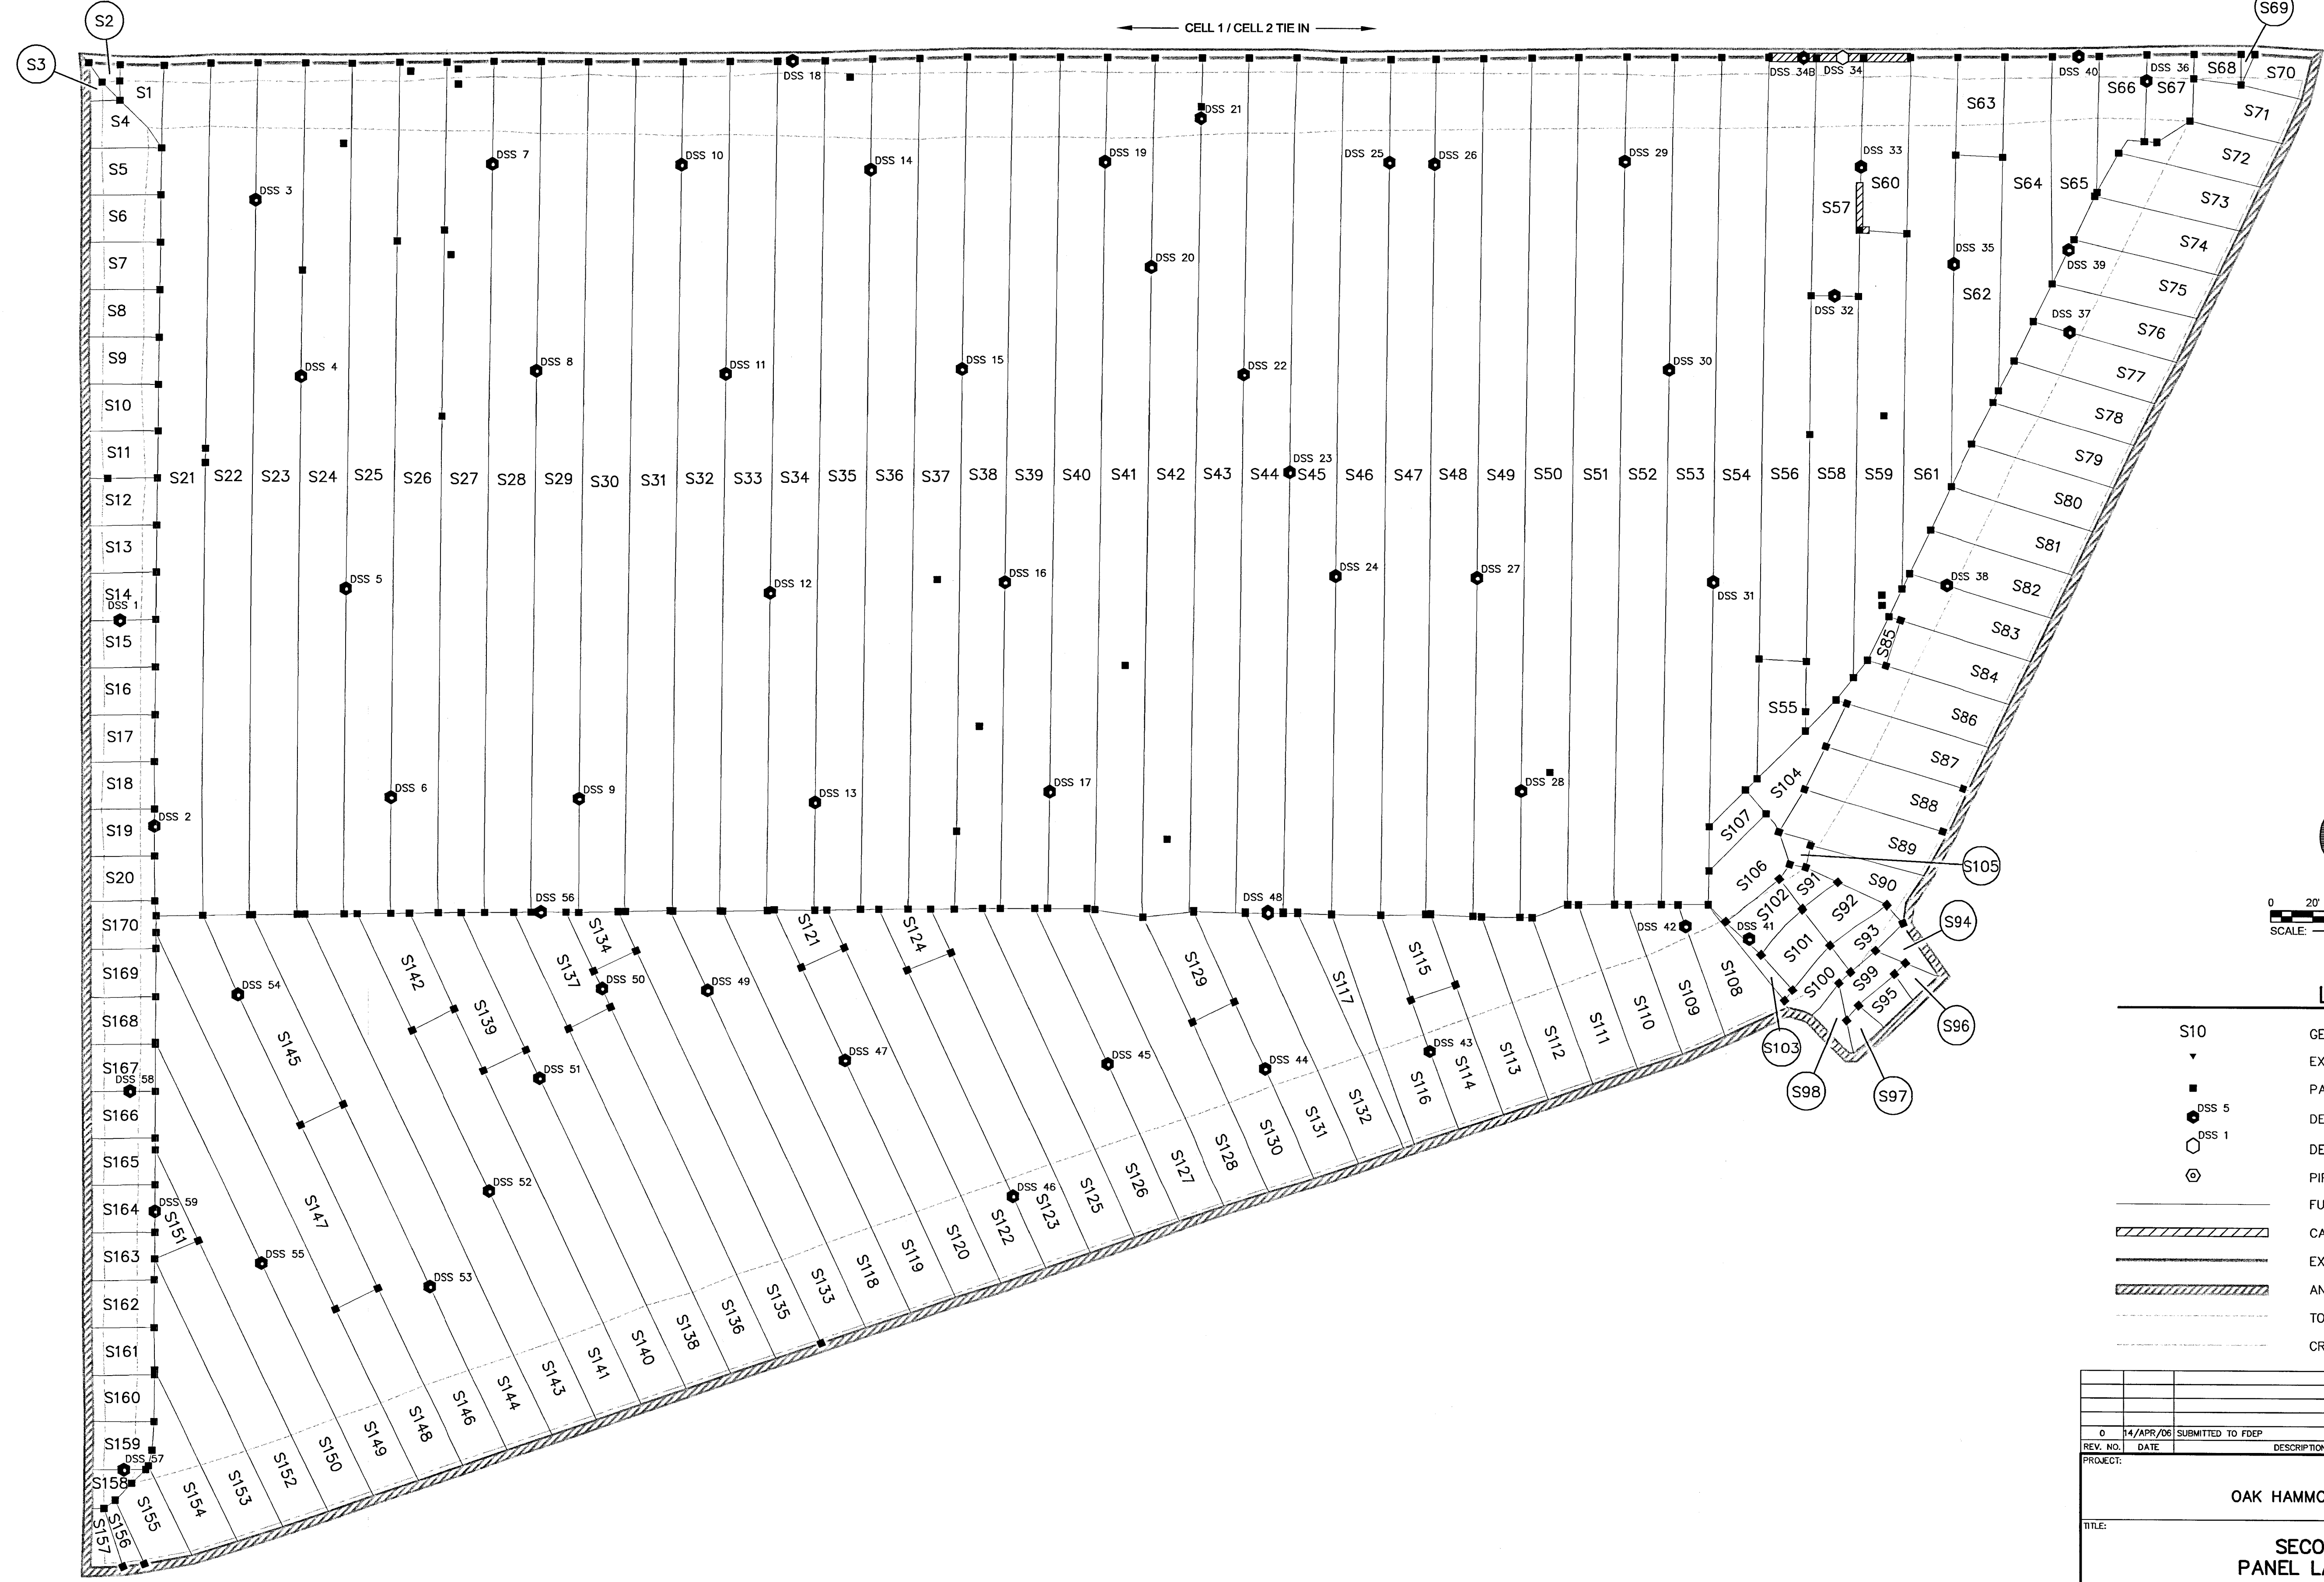

LEGEND


- S10 GEOMEMBRANE PANEL NUMBER (SECONDARY)
- ▼ EXTRUDATE REPAIR
- PATCH REPAIR LOCATION
- DSS 5 DESTRUCTIVE SAMPLE (PASS) (SECONDARY)
- DSS 1 DESTRUCTIVE SAMPLE (FAIL) (SECONDARY)
- ⊙ PIPE PENETRATION
- FUSION WELDED SEAM
- ▨ CAPPED SEAM OR REPAIRED PANEL
- EXTRUDED SEAM
- ▨ ANCHOR TRENCH
- TOE
- CREST

0	14/APR/06	SUBMITTED TO FDP	—	EC	JE	KEW	AG
REV. NO.	DATE	DESCRIPTION	DES. BY	DR. BY	CHK. BY	RVW. BY	APP. BY
PROJECT: CELL 2 OAK HAMMOCK DISPOSAL FACILITY							
TITLE: SECONDARY LINER PANEL LAYOUT AS-BUILT							
Owner/Facility: WSP WASTE SERVICES OF FLORIDA, INC. 1501 OMNI WAY, ST. CLOUD, FLORIDA 34773 TEL: 407-841-3720 FAX: 407-841-3730				DATE: APRIL 2006 SCALE: 1" = 40' PROJECT NO.: F00852.03 FILE NO.: F00852.03F001 FIGURE NO.: C-3			
Consultant/Engineer: GEO SYNTAC CONSULTANTS 14055 RIVEREDGE DRIVE, SUITE 300, TAMPA, FLORIDA 33637 USA TEL: 813-558-0990 FAX: 813-558-9726 AUTHORIZATION CERTIFICATE NO. 00004321				AYUSHMAN GUPTA CERTIFICATE NO. 54023			

AS-BUILT DRAWING



CELL 1 / CELL 2 TIE IN

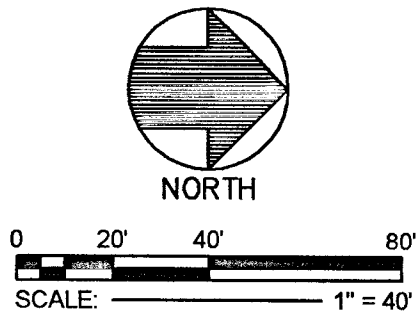

- NOTE:
- AS BUILT DRAWING IS BASED ON SURVEYS PERFORMED BY HARTMAN AND ASSOCIATES, INC., ORLANDO, FLORIDA

LEGEND

- 80 — TOP OF SUBBASE ELEVATION (FEET)
- 89.1 AS-BUILT SURVEY POINT AND ELEVATION PROVIDED BY HARTMAN & ASSOCIATES, INC.

REV. NO.	DATE	DESCRIPTION	DES. BY	DR. BY	CHK. BY	RVW. BY	APP. BY
0	14/APR/06	SUBMITTAL TO FDEP	—	JWO	J.E	KEW	AG
PROJECT: CELL 2 OAK HAMMOCK DISPOSAL FACILITY							
TITLE: LINER TOP OF SUBBASE AS-BUILT							
Owner/Facility:  1501 OMNI WAY, ST. CLOUD, FLORIDA 34773 TEL: 407-841-3720 FAX: 407-841-3730			DATE: APRIL 2006 SCALE: 1" = 40' PROJECT NO.: FQ0852.03 FILE NO.: FQ0852.03F003 FIGURE NO.: C-1				
Consultant/Engineer:  14055 RIVEREDGE DRIVE, SUITE 300, TAMPA, FLORIDA 33637 USA TEL: 813-558-0990 FAX: 813-558-9726 AUTHORIZATION CERTIFICATE NO. 00004321			AYUSHMAN GUPTA CERTIFICATE NO. 54023				

AS-BUILT DRAWING