



“AS - BUILTS” OF TRAIL RIDGE LANDFILL PHASES I, II, IIIA, IIIB, IIIC, IVA, IVB AND IVC FOR TRAIL RIDGE LANDFILL, INC. AND CITY OF JACKSONVILLE, FLORIDA

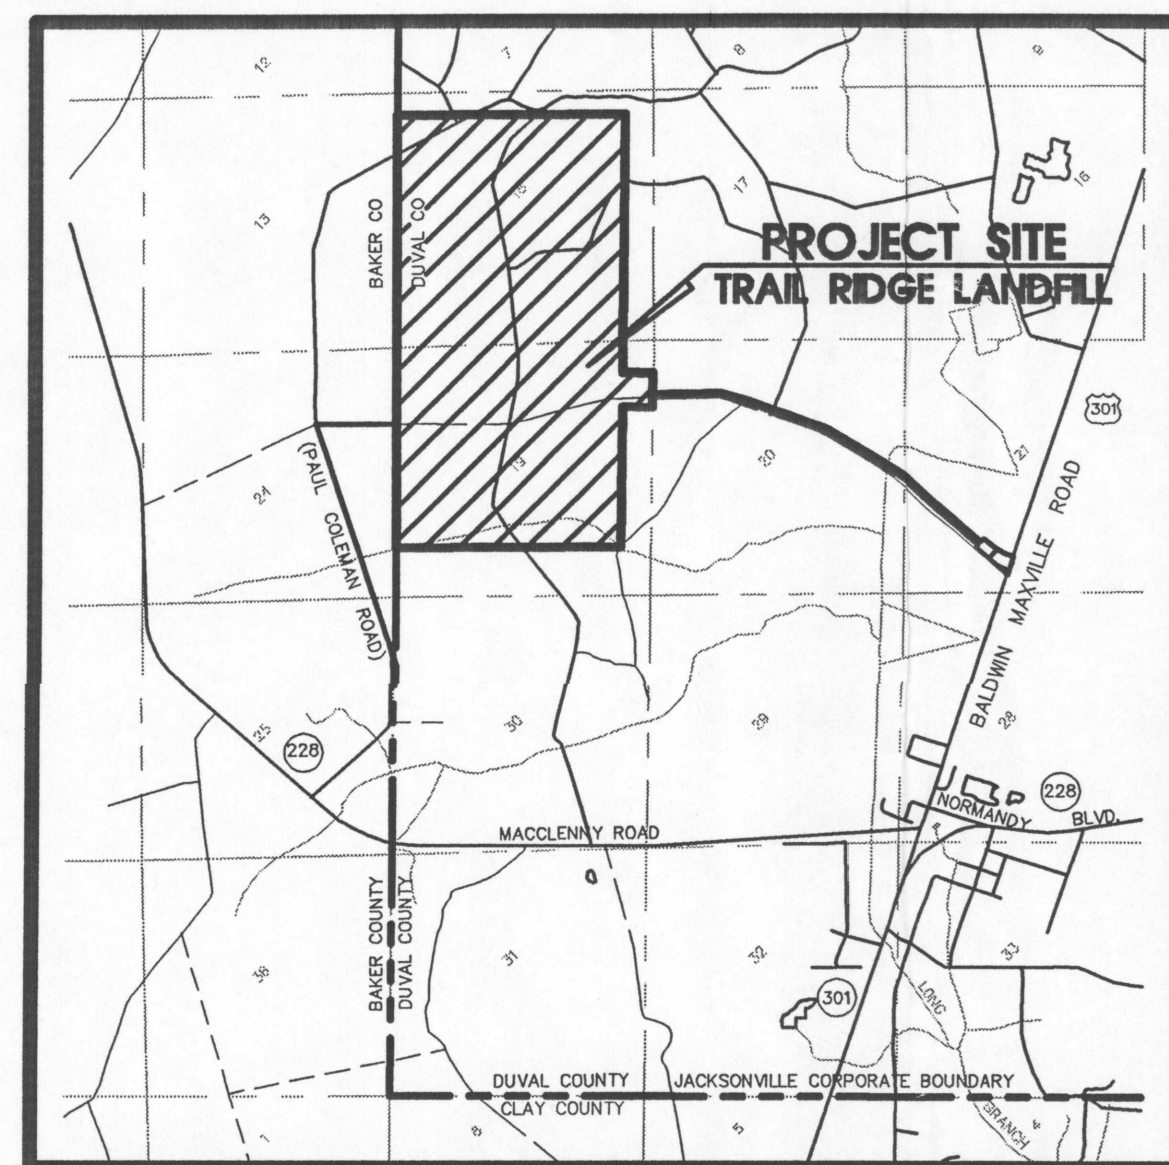

VICINITY MAP

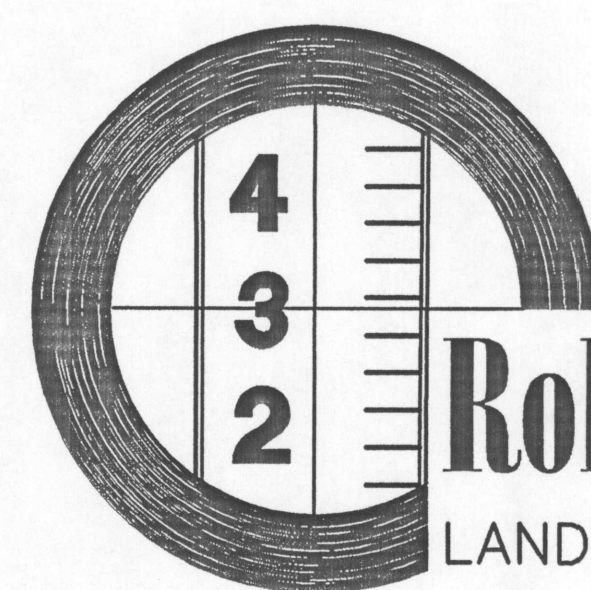

Robert M. Angas Associates, inc.

LAND SURVEYORS, PLANNERS AND CIVIL ENGINEERS
SINCE 1924

14775 St. Augustine Road, Jacksonville, FL. 32258
Telephone: (904) 642-8550 Fax: (904) 642-4165

Certificate of Authorization No.: LB 3624

(FORMERLY SUNSHINE STATE SURVEYORS)

UPDATED: JANUARY, 2001
UPDATED: DECEMBER, 2000
UPDATED: DECEMBER, 1996
UPDATED: SEPTEMBER, 1995
UPDATED: JANUARY, 1993
UPDATED: DECEMBER, 1992
DATE: SEPTEMBER, 1992


INDEX OF DRAWINGS

SHEET NO.	DESCRIPTION
COVER SHEET NUMBER 1	COVER SHEET
GROUNDWATER WELLS	
GW-1	GROUNDWATER MONITORING WELLS
LINER SYSTEM	
LS-1	LINER SYSTEM - PHASES I AND II
LS-2	LINER SYSTEM - PHASES I AND II
LS-3	LINER SYSTEM - PHASES I AND II
LS-4	LINER SUBGRADE - PHASES IIIA, IIIB, IVA, IVB
LS-5	LINER SYSTEM - PHASES IIIA, IIIB, IVA, IVB
LS-6	LINER SYSTEM LOCATION - PHASES IIIA, IIIB, IVA, IVB
LS-7	LINER SUBGRADE - PHASES IIIA, IIIB, IVA, IVB
LS-8	LINER SYSTEM - PHASE IIIIC AND IVC
LS-9	LINER SYSTEM LOCATION - PHASE IIIIC AND IVC
LEACHATE SYSTEM	
LE-1	LEACHATE FORCE MAIN
LE-2	LEACHATE FORCE MAIN - PHASE IIIIC
ELECTRICAL SYSTEM	
E-1	ELECTRICAL SYSTEM
E-2	ELECTRICAL SYSTEM
E-3	ELECTRICAL SYSTEM
DRAINAGE PLANS	
D-1	DRAINAGE STRUCTURE AND SPREADER PIPE DATA SHEET
D-2	PHASES I AND II DRAINAGE STRUCTURES
D-3	DETENTION LAKE
D-4	FILTER BED AREA
D-5	DRAINAGE STRUCTURES - PHASES IIIA, IIIB, IIIIC, IVA, IVB & IVC
D-6	DRAINAGE STRUCTURE TABLE - PHASES IIIA, IIIB, IIIIC, IVA, IVB, & IVC
ANCILLARY FACILITIES	
A-1	ANCILLARY AREA FORCE MAIN, WATER MAIN AND STORM DRAINAGE
A-2	ANCILLARY AREA FORCE MAIN, WATER MAIN AND STORM DRAINAGE
ENTRANCE ROAD	
ER-1	ENTRANCE ROAD STORM DRAINAGE
ER-2	ENTRANCE ROAD STORM DRAINAGE
ER-3	ENTRANCE ROAD STORM DRAINAGE
ER-4	ENTRANCE ROAD STORM DRAINAGE
ER-5	ENTRANCE ROAD STORM DRAINAGE
ER-6	ENTRANCE ROAD STORM DRAINAGE
ER-7	ENTRANCE ROAD STORM DRAINAGE
FIRE PUMP	
P-1	CLASS I FIRE PUMP / HYDROTANK STORMWATER
WATER TREATMENT FACILITIES	
WT-1	WATER TREATMENT FACILITY
WT-2	WATER TREATMENT FACILITY
WT-3	WATER TREATMENT FACILITY
WT-4	WATER TREATMENT PLANT
ANCILLARY FACILITIES BUILDINGS	
201-711	ANCILLARY FACILITIES BUILDINGS PROVIDED BY THE HASKELL COMPANY
L-1 THRU L-4	ANCILLARY FACILITIES BUILDINGS PROVIDED BY THE HASKELL COMPANY


NORTHEAST DISTRICT
RECEIVED
JAN 31 2001
DEB-JACKSONVILLE

COVER SHEET NO. 1


AC only

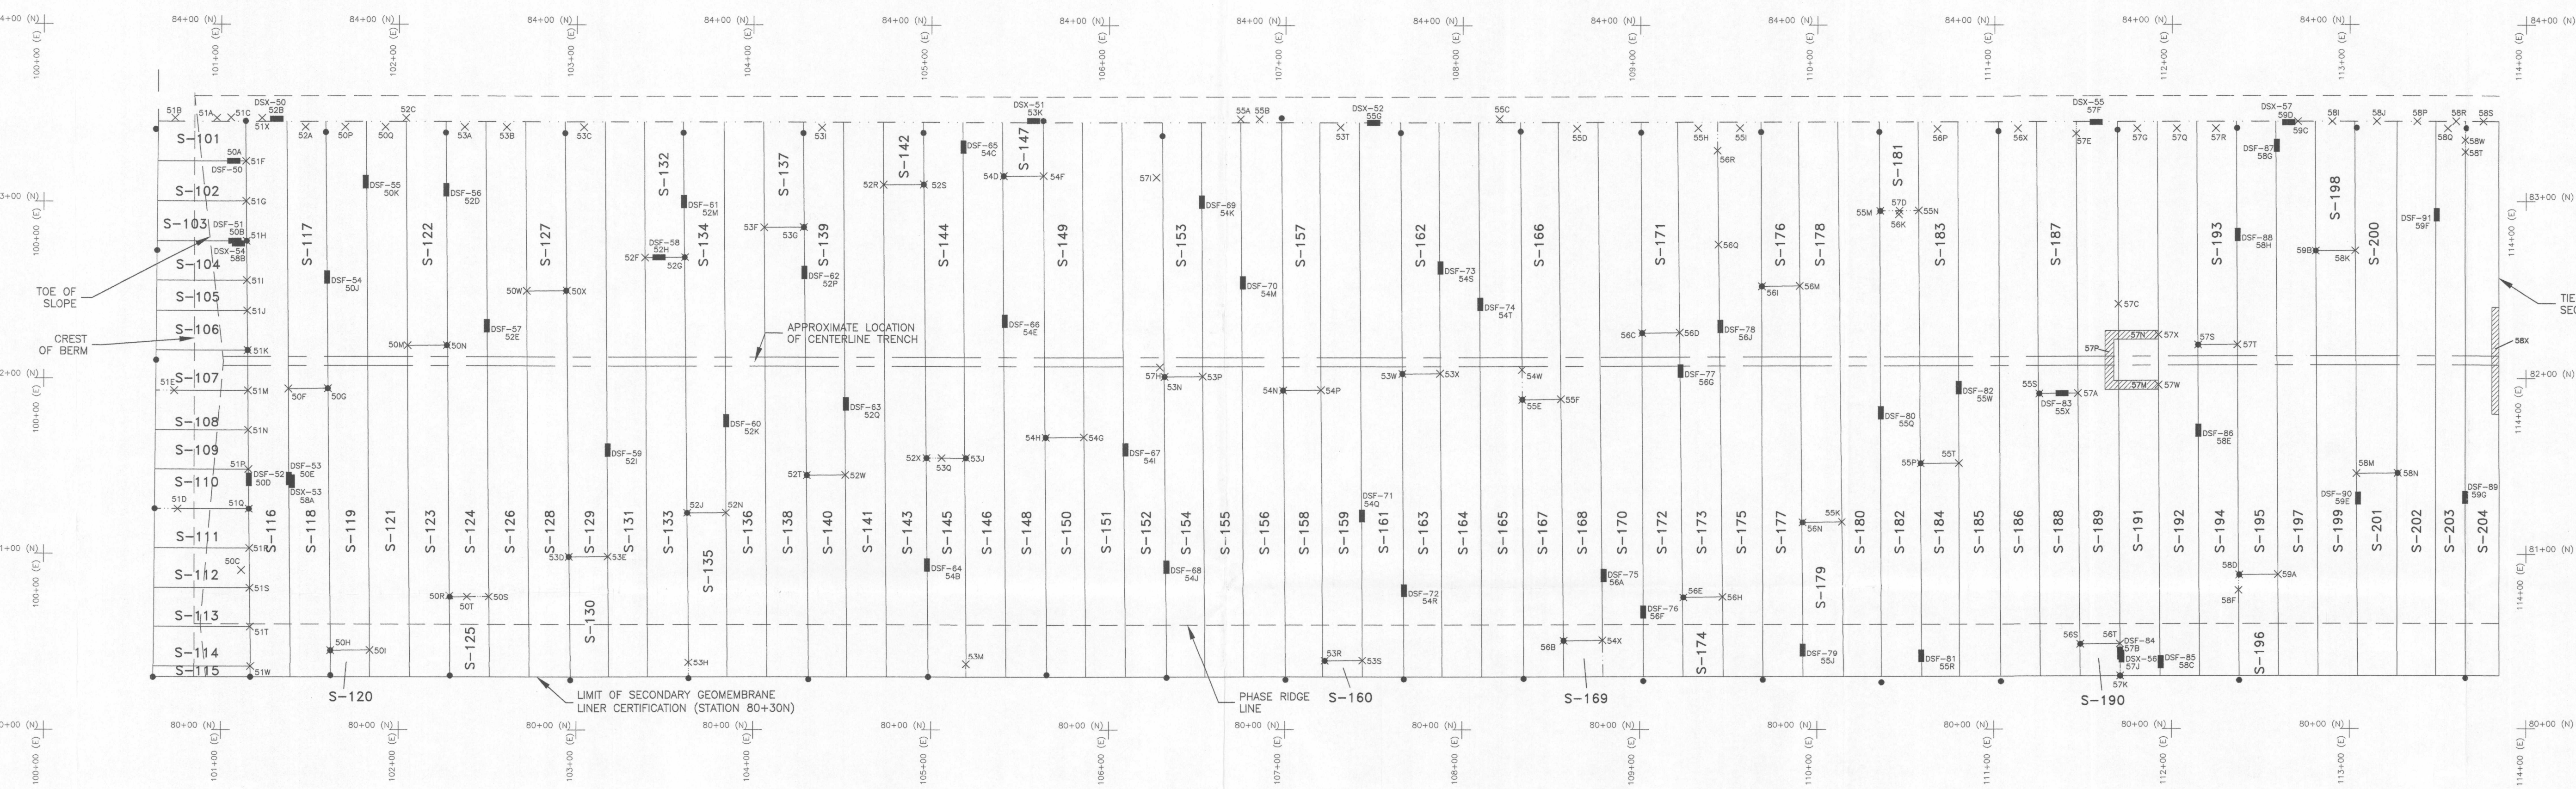

- LEGEND**
- PRIMARY DEPLOYMENT ORDER
 - PANEL NUMBER
 - SECONDARY DEPLOYMENT ORDER
 - PANEL NUMBER
 - DESTRUCTIVE SAMPLE NUMBER
 - DESTRUCTIVE SAMPLE LOCATION
 - DESTRUCTIVE REPAIR NUMBER
 - DESTRUCTIVE REPAIR LOCATION
 - SURVEY COORDINATE LOCATION (SEE NOTE 4)
 - LEACHATE COLLECTION TRENCH
 - EXTRUSION WELD
 - CAP (OR EXTENSION) REPAIR NUMBER
 - CAP (OR EXTENSION) REPAIR AREA (SEE NOTE 3)
 - BOOT/SKIRT NUMBER
 - BOOT/SKIRT

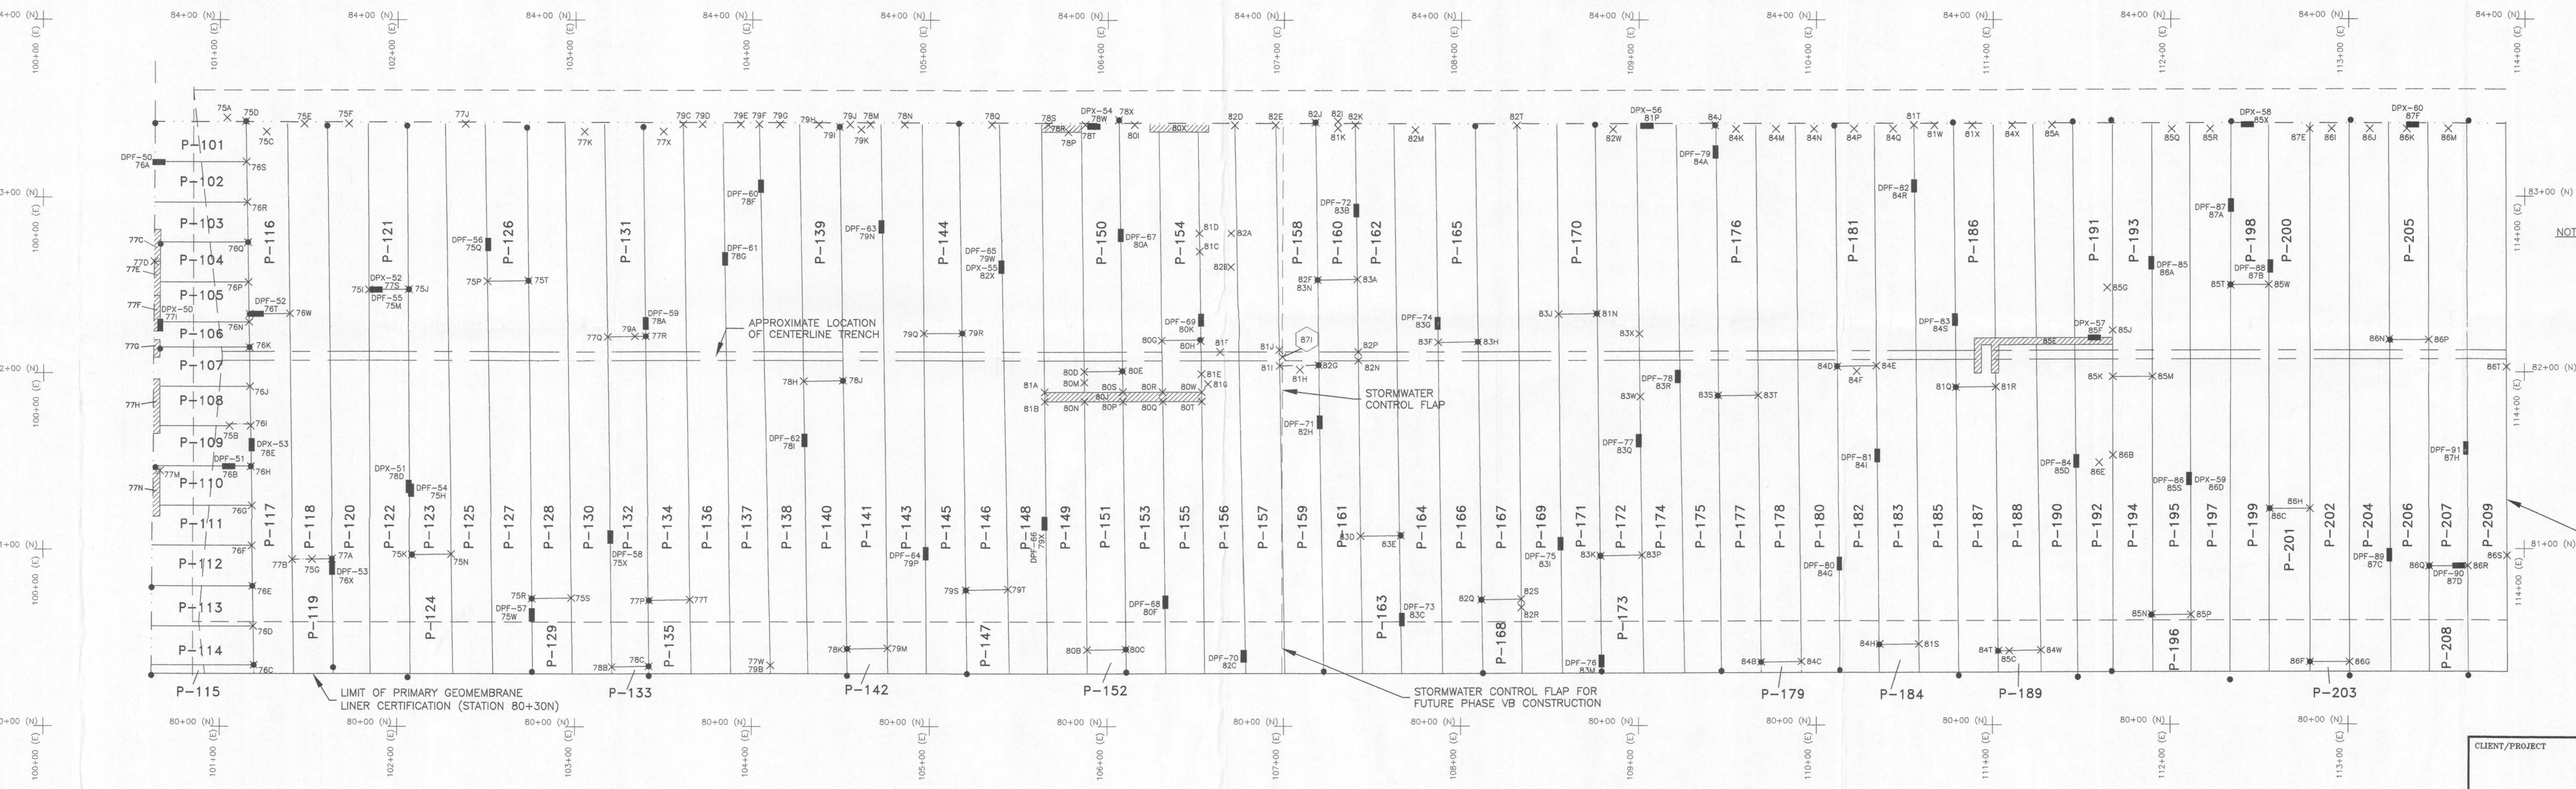

- NOTES:**
- THE LOCATIONS AND DIMENSIONS OF ALL PANELS, SEAMS, DESTRUCTIVE TEST SAMPLES AND REPAIRS SHOWN ON THIS DRAWING ARE APPROXIMATE AND ARE BASED ON FIELD MEASUREMENTS.
 - GEOMEMBRANE SEAM AND DEFECT/REPAIR INFORMATION IS PROVIDED IN APPENDICES I AND J, RESPECTIVELY, OF THE RECORD DOCUMENTATION REPORT.
 - DEFECT REPAIR LOCATIONS SHOWN AS CAPPED AREAS REPRESENT ONLY THE LARGER CAPS.
 - SELECTIVE SEAMS WERE SURVEYED BY ROBERT M. ANGUS ASSOCIATES, INC. TO PROVIDE CONTROL FOR DEVELOPMENT OF THIS RECORD DRAWING. THIS SURVEY DATA IS NOT SHOWN ON THIS DRAWING FOR PURPOSES OF CLARITY BUT WAS SUBMITTED TO TRAIL RIDGE LANDFILL, INC.
 - THIS RECORD DRAWING REPRESENTS THE FINAL SECONDARY AND PRIMARY GEOMEMBRANE LINERS FOR PHASE IVC FOLLOWING ALL REPAIRS.

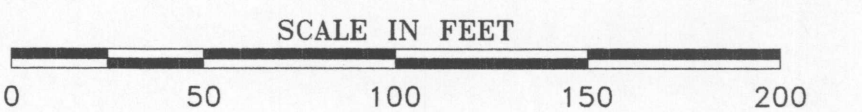

PHASE IVC
PRIMARY GEOMEMBRANE LINER

NAME, ADDRESS, AND REGISTRATION NUMBER OF ENGINEER-OF-RECORD

FRANCIS T. ADAMS

GOLDER ASSOCIATES INC.
8933 WESTERN WAY
SUITE 12
JACKSONVILLE, FLORIDA 32256

FLORIDA P.E. NO. 46417

IMPRESSION SEAL, SIGNATURE AND DATE

Francis T. Adams

1/23/01

CLIENT/PROJECT

TRAIL RIDGE LANDFILL
THIRD CONSTRUCTION INCREMENT
BALDWIN, FLORIDA

TITLE



RECORD PANEL LAYOUT OF SECONDARY AND PRIMARY GEOMEMBRANE LINERS FOR PHASE IVC

JACKSONVILLE, FLORIDA



DRAWN	GMS	DATE	1/23/01
CHECKED	AS	SCALE	AS SHOWN
REVIEWED	AS	DWG. NO.	3979G
APPROVED	AS	JOB NO.	003-3979
FILE NO.		SUBTITLE	003-3979

Golder Associates

FIGURE 3

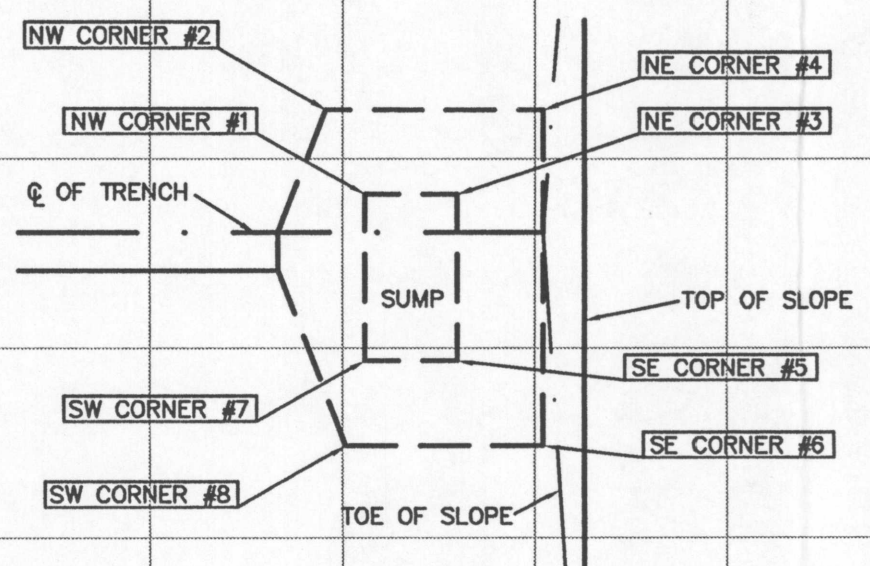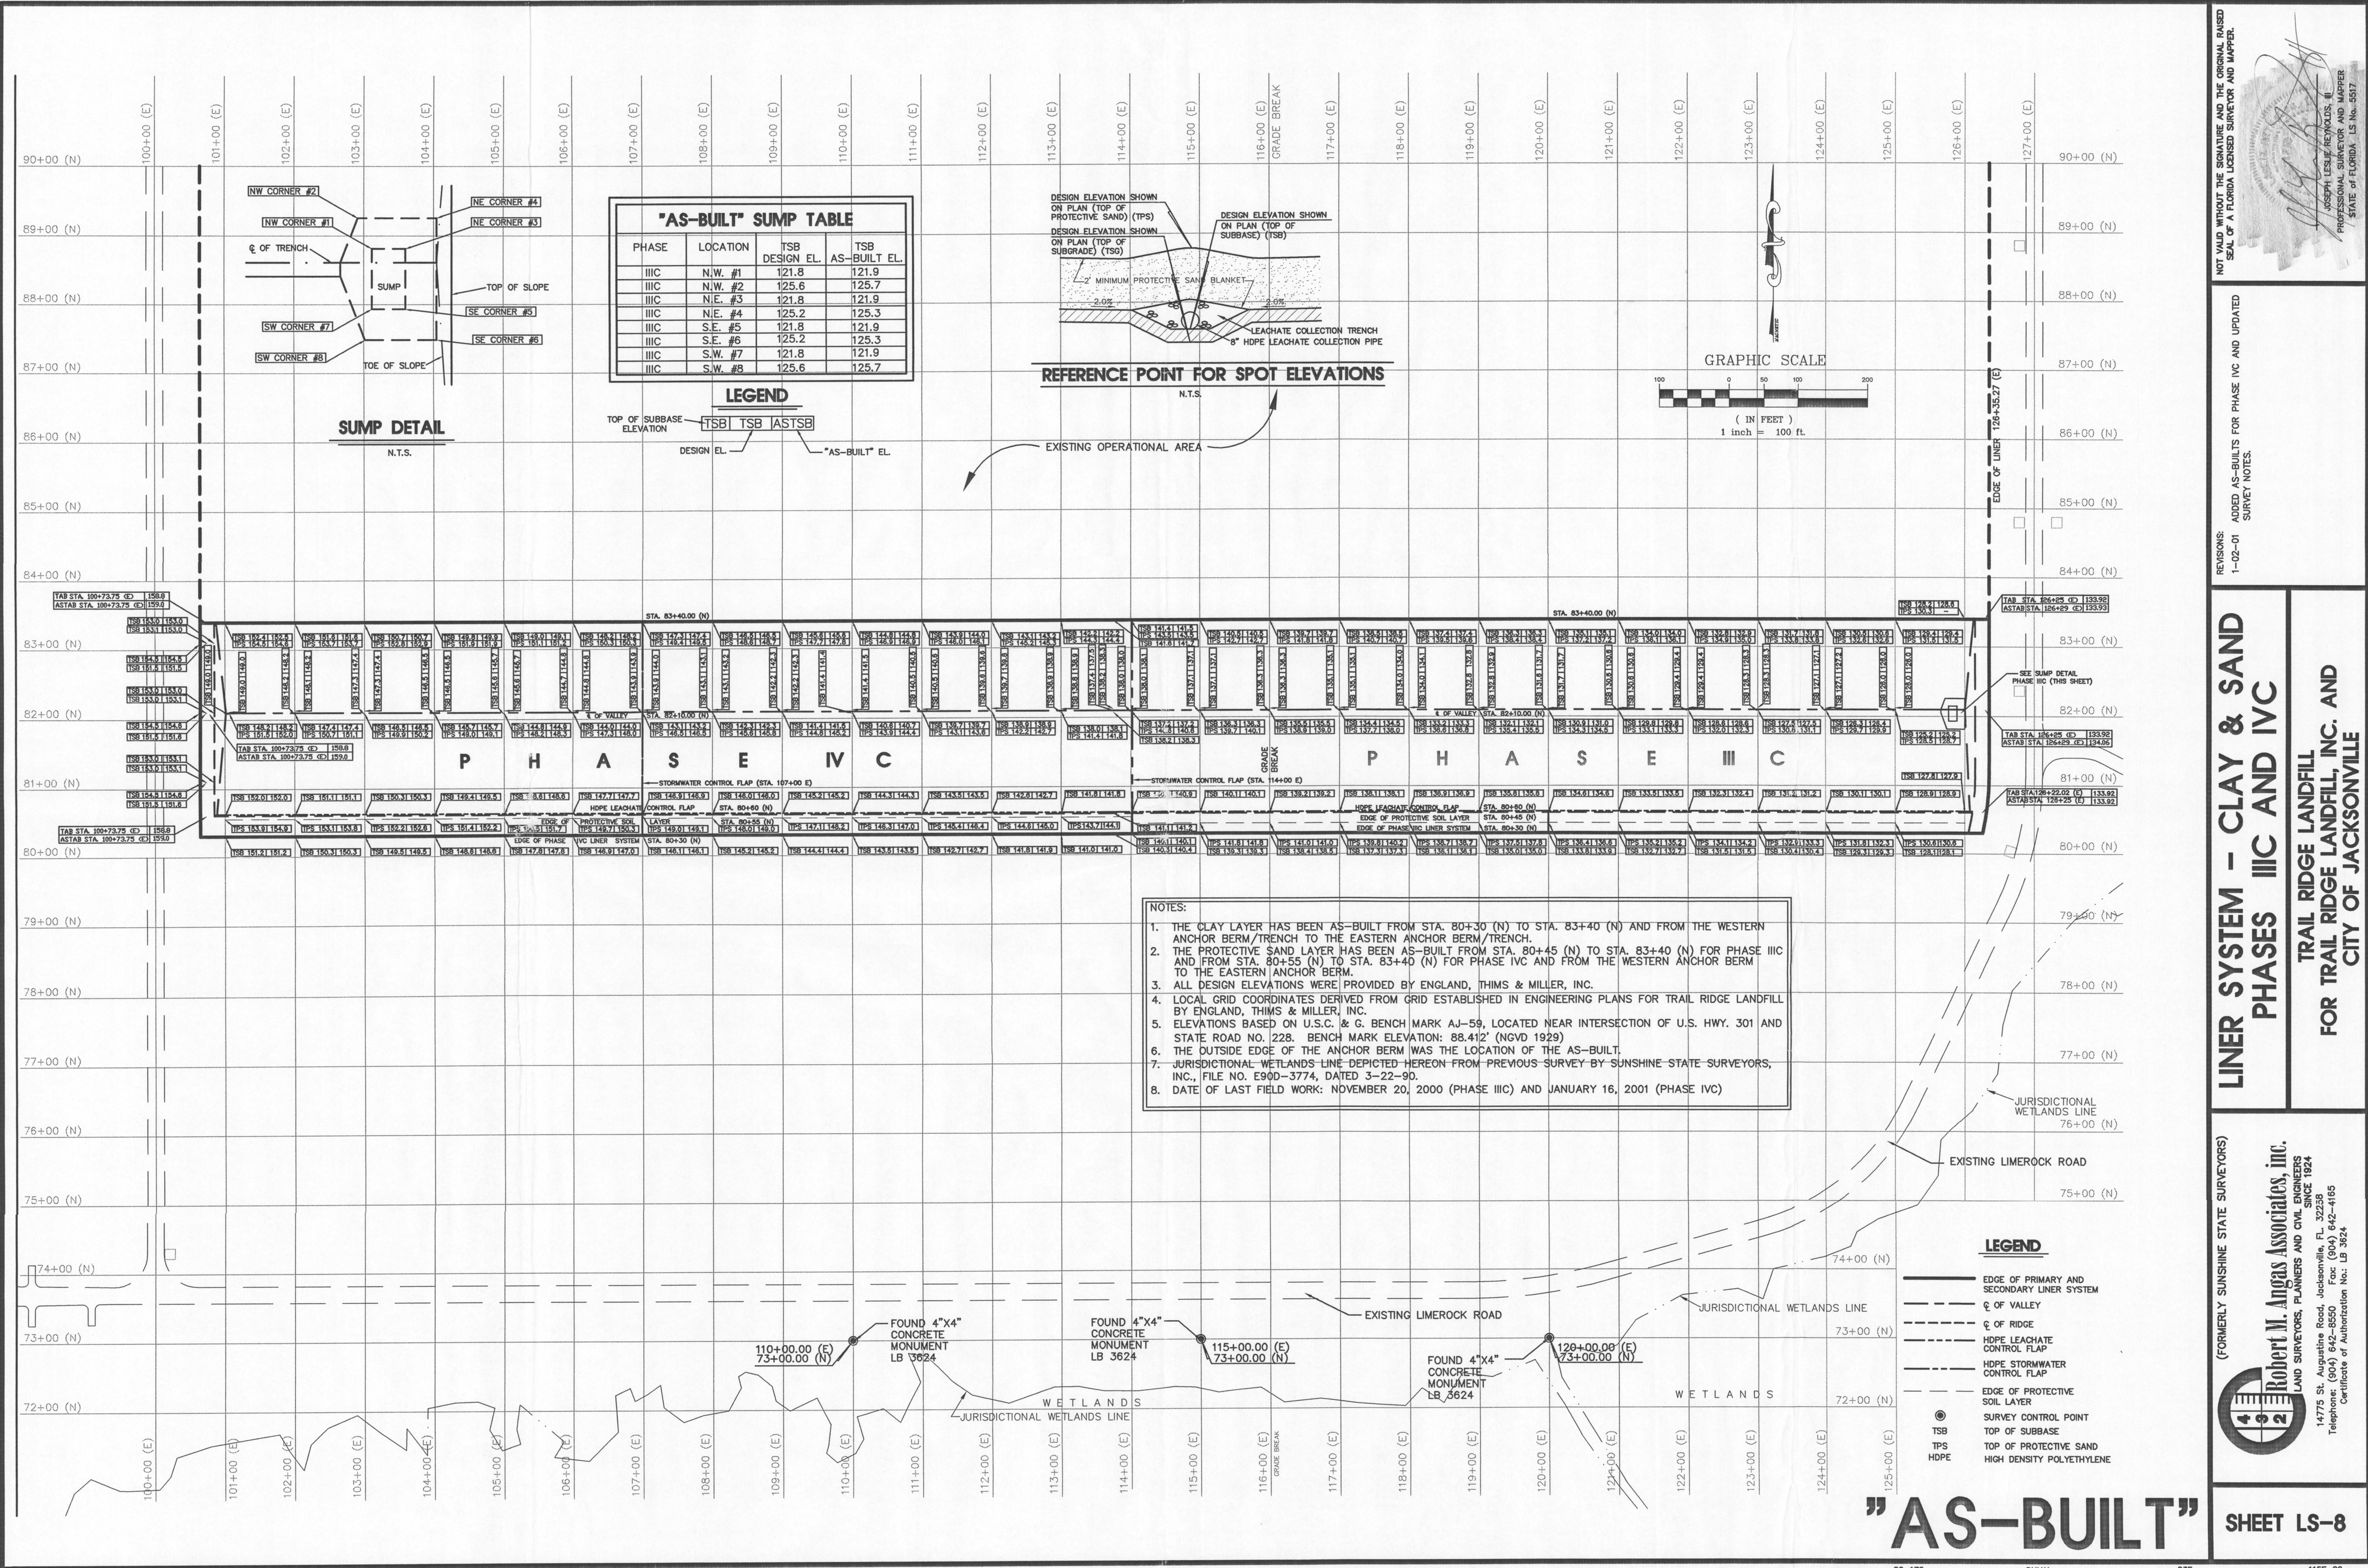

"AS-BUILT" SUMP TABLE			
PHASE	LOCATION	TSB DESIGN EL.	TSB AS-BUILT EL.
IIC	N.W. #1	121.8	121.9
IIC	N.W. #2	125.6	125.7
IIC	N.E. #3	121.8	121.9
IIC	N.E. #4	125.2	125.3
IIC	S.E. #5	121.8	121.9
IIC	S.E. #6	125.2	125.3
IIC	S.W. #7	121.8	121.9
IIC	S.W. #8	125.6	125.7

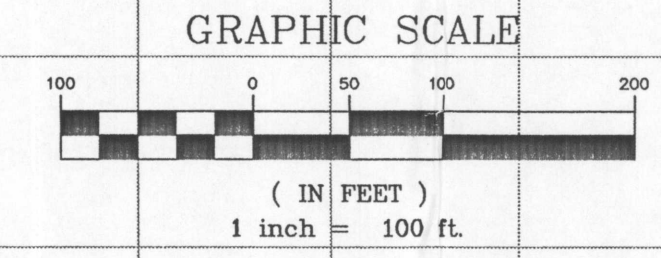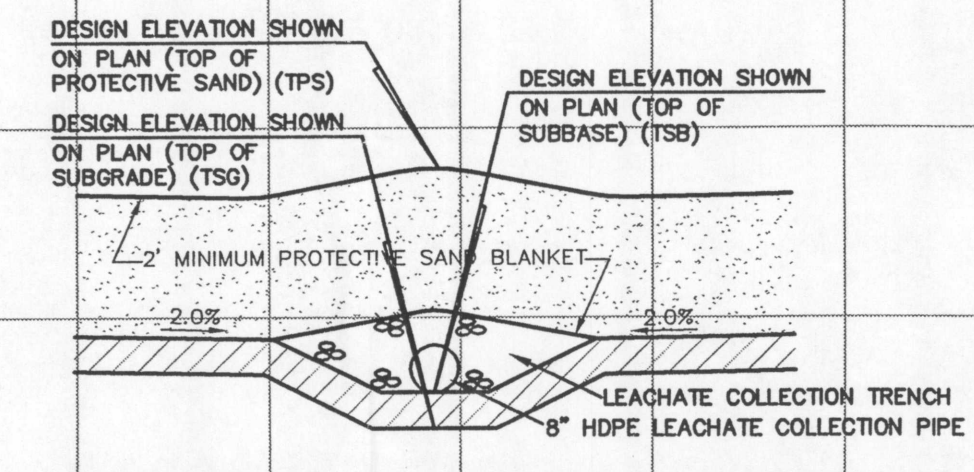

LEGEND	
TOP OF SUBBASE ELEVATION	TSB
DESIGN EL.	TSB
"AS-BUILT" EL.	ASTSB

- NOTES:
1. THE CLAY LAYER HAS BEEN AS-BUILT FROM STA. 80+30 (N) TO STA. 83+40 (N) AND FROM THE WESTERN ANCHOR BERM/TRENCH TO THE EASTERN ANCHOR BERM/TRENCH.
 2. THE PROTECTIVE SAND LAYER HAS BEEN AS-BUILT FROM STA. 80+45 (N) TO STA. 83+40 (N) FOR PHASE IIC AND FROM STA. 80+55 (N) TO STA. 83+40 (N) FOR PHASE IVC AND FROM THE WESTERN ANCHOR BERM TO THE EASTERN ANCHOR BERM.
 3. ALL DESIGN ELEVATIONS WERE PROVIDED BY ENGLAND, THIMS & MILLER, INC.
 4. LOCAL GRID COORDINATES DERIVED FROM GRID ESTABLISHED IN ENGINEERING PLANS FOR TRAIL RIDGE LANDFILL BY ENGLAND, THIMS & MILLER, INC.
 5. ELEVATIONS BASED ON U.S.C. & G. BENCH MARK AJ-59, LOCATED NEAR INTERSECTION OF U.S. HWY. 301 AND STATE ROAD NO. 228. BENCH MARK ELEVATION: 88.412' (NGVD 1929)
 6. THE OUTSIDE EDGE OF THE ANCHOR BERM WAS THE LOCATION OF THE AS-BUILT.
 7. JURISDICTIONAL WETLANDS LINE DEPICTED HEREON FROM PREVIOUS SURVEY BY SUNSHINE STATE SURVEYORS, INC., FILE NO. E900-3774, DATED 3-22-90.
 8. DATE OF LAST FIELD WORK: NOVEMBER 20, 2000 (PHASE IIC) AND JANUARY 16, 2001 (PHASE IVC)

LEGEND	
---	EDGE OF PRIMARY AND SECONDARY LINER SYSTEM
---	Q OF VALLEY
---	Q OF RIDGE
---	HDPE LEACHATE CONTROL FLAP
---	HDPE STORMWATER CONTROL FLAP
---	EDGE OF PROTECTIVE SOIL LAYER
●	SURVEY CONTROL POINT
TSB	TOP OF SUBBASE
TPS	TOP OF PROTECTIVE SAND
HDPE	HIGH DENSITY POLYETHYLENE

NOT VALID WITHOUT THE SIGNATURE AND THE ORIGINAL RAISED SEAL OF A FLORIDA LICENSED SURVEYOR AND MAPPER.

JOSEPH LESLY REYNOLDS, II
PROFESSIONAL SURVEYOR AND MAPPER
STATE OF FLORIDA, LS No. 5517

REVISIONS:
1-02-01 ADDED AS-BUILTS FOR PHASE IVC AND UPDATED SURVEY NOTES.

**LINER SYSTEM - CLAY & SAND
PHASES IIC AND IVC**


TRAIL RIDGE LANDFILL
FOR TRAIL RIDGE LANDFILL, INC. AND
CITY OF JACKSONVILLE

(FORMERLY SUNSHINE STATE SURVEYORS)

Robert M. Angas Associates, Inc.
LAND SURVEYORS, PLANNERS AND CIVIL ENGINEERS
14775 St. Augustine Road, Jacksonville, FL 32238
Telephone: (904) 642-8550 Fax: (904) 642-4185
Certificate of Authorization No.: LB 3624

"AS-BUILT"

SHEET LS-8


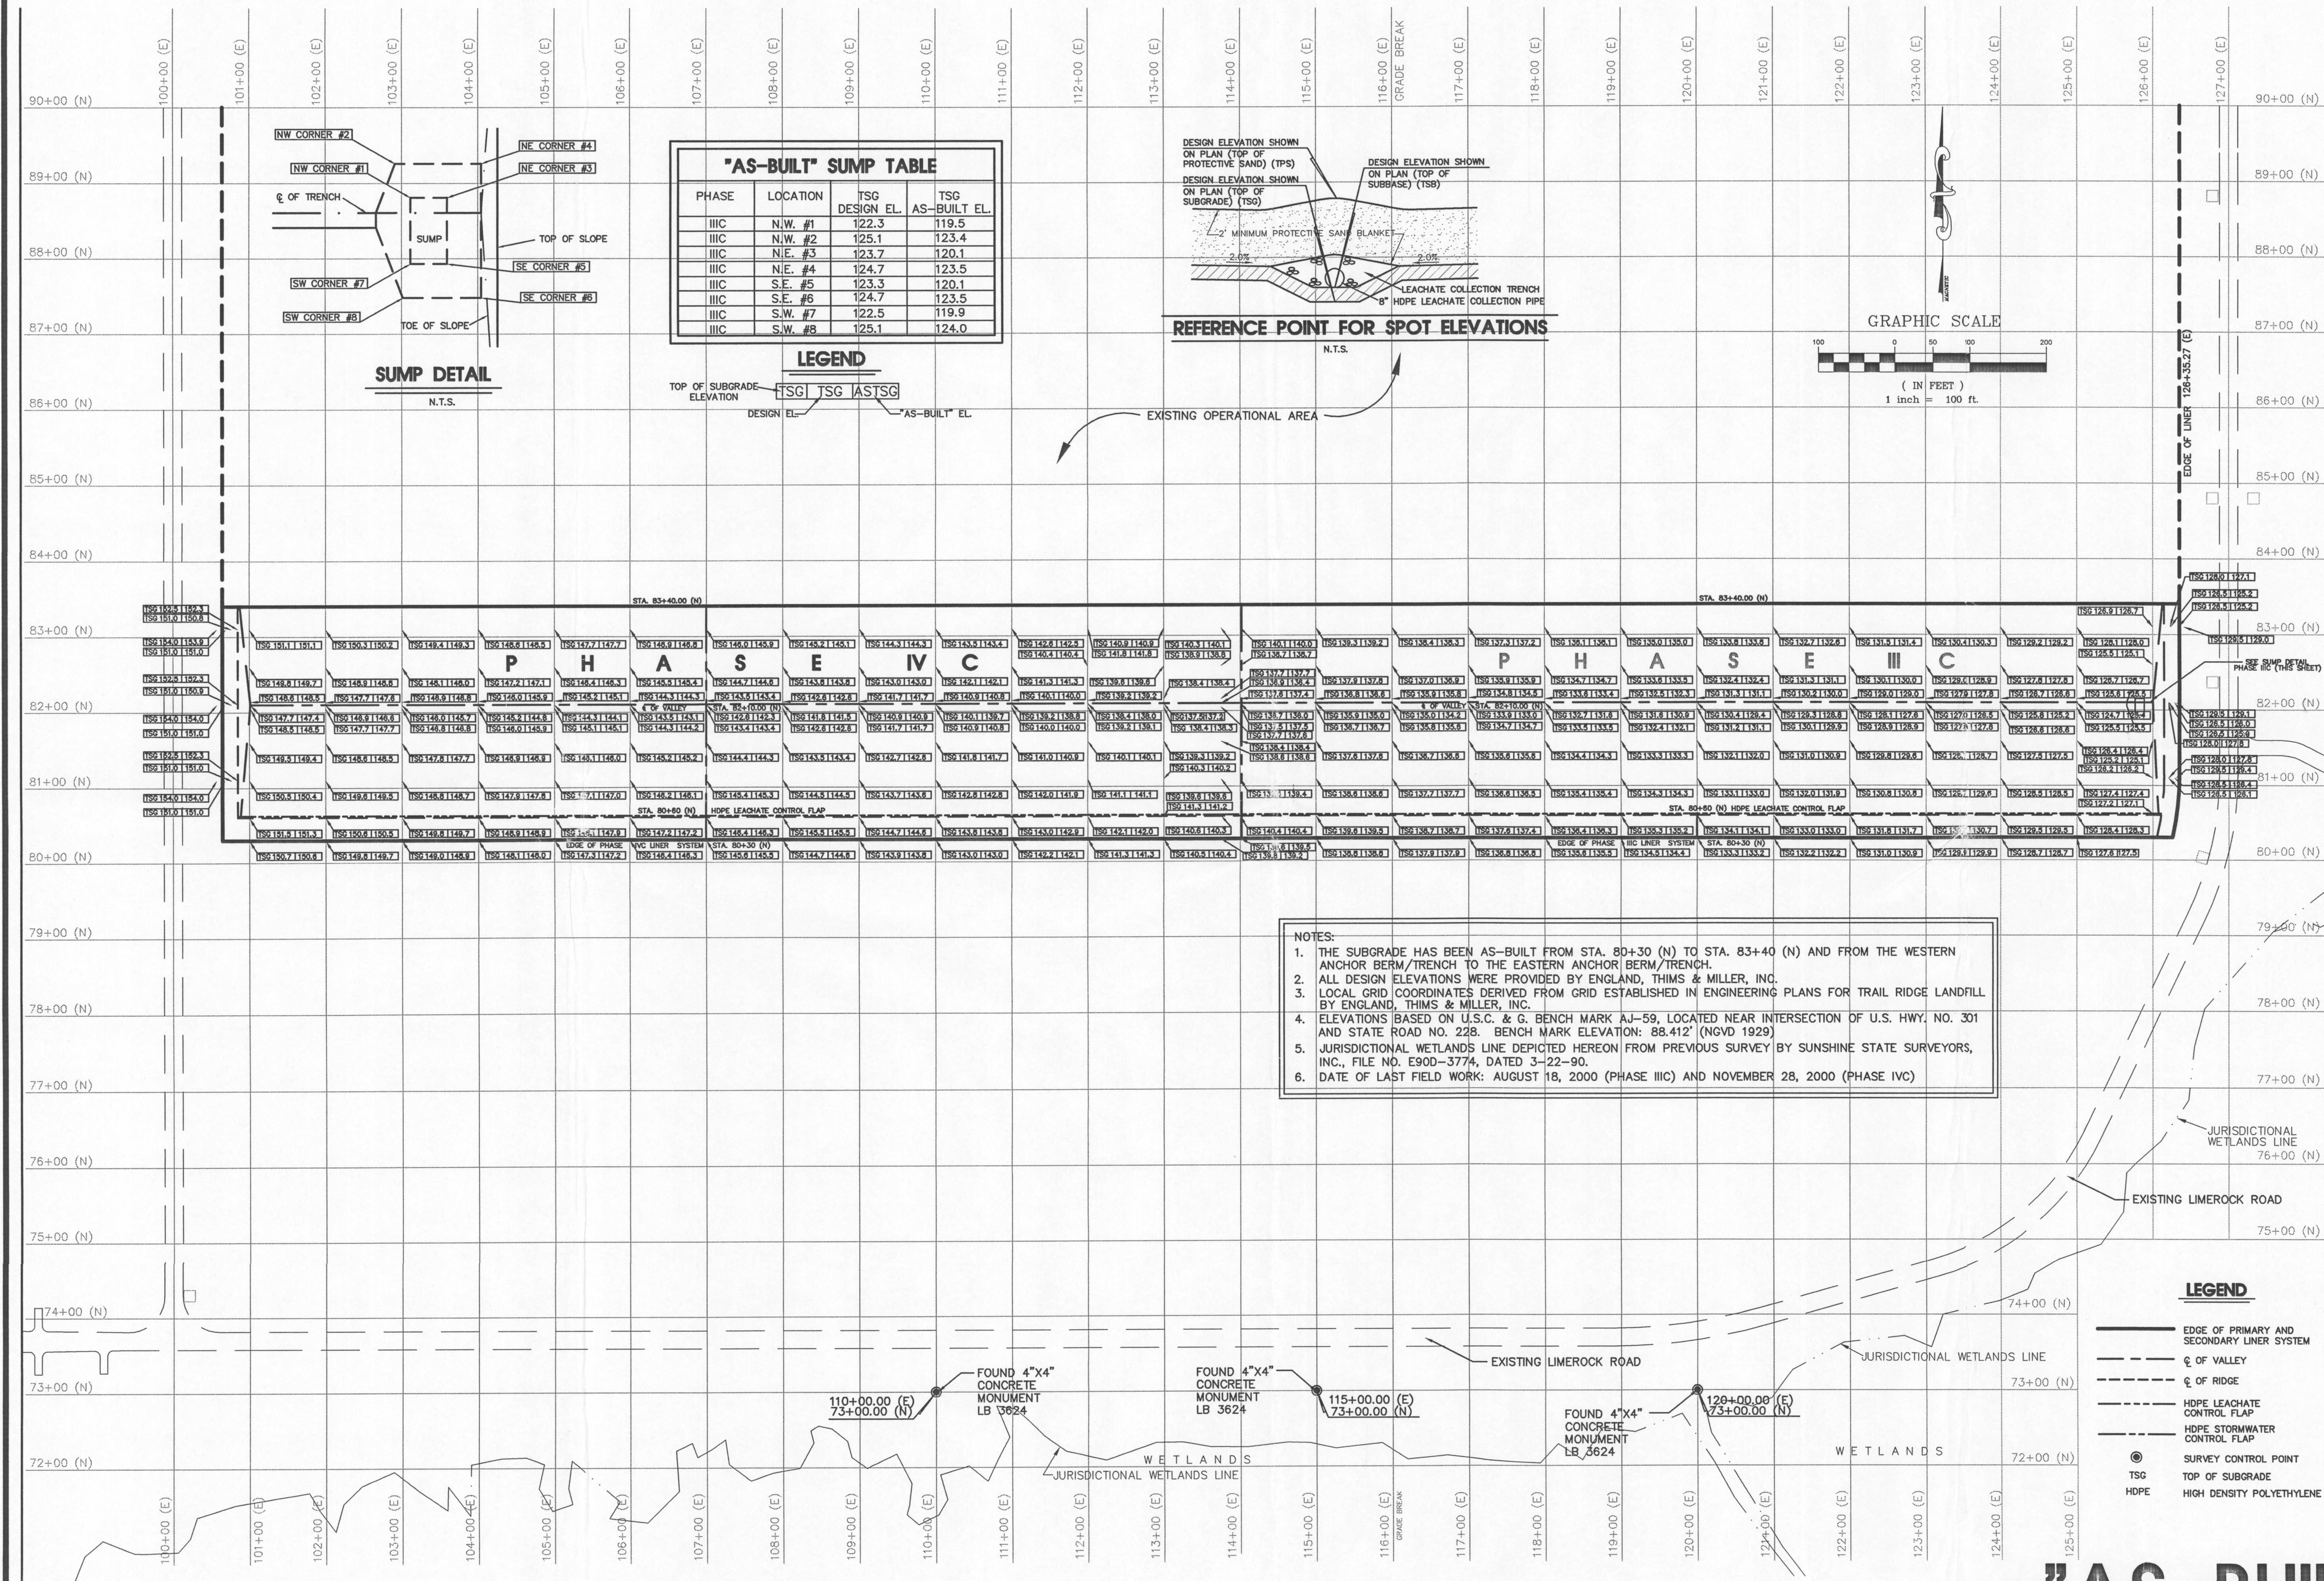


**LINER SYSTEM - SUBGRADE
PHASES IIC AND IVC**
TRAIL RIDGE LANDFILL
FOR TRAIL RIDGE LANDFILL, INC. AND
CITY OF JACKSONVILLE

(FORMERLY SUNSHINE STATE SURVEYORS)
Robert M. Angas Associates, Inc.
LAND SURVEYORS, PLANNERS AND CIVIL ENGINEERS
SINCE 1924
14775 St. Augustine Road, Jacksonville, FL 32236
Telephone: (904) 842-8850 Fax: (904) 842-4165
Certificate of Authorization No. LB 3624

NOT VALID WITHOUT THE SIGNATURE AND THE ORIGINAL RAISED
SEAL OF A FLORIDA LICENSED SURVEYOR AND MAPPER.
JOSEPH LESLIE REYNOLDS, III
PROFESSIONAL SURVEYOR AND MAPPER
STATE OF FLORIDA License No. 5597

REVISIONS:
1-02-01 ADDED AS-BUILTS FOR PHASE IVC AND UPDATED
SURVEY NOTES.

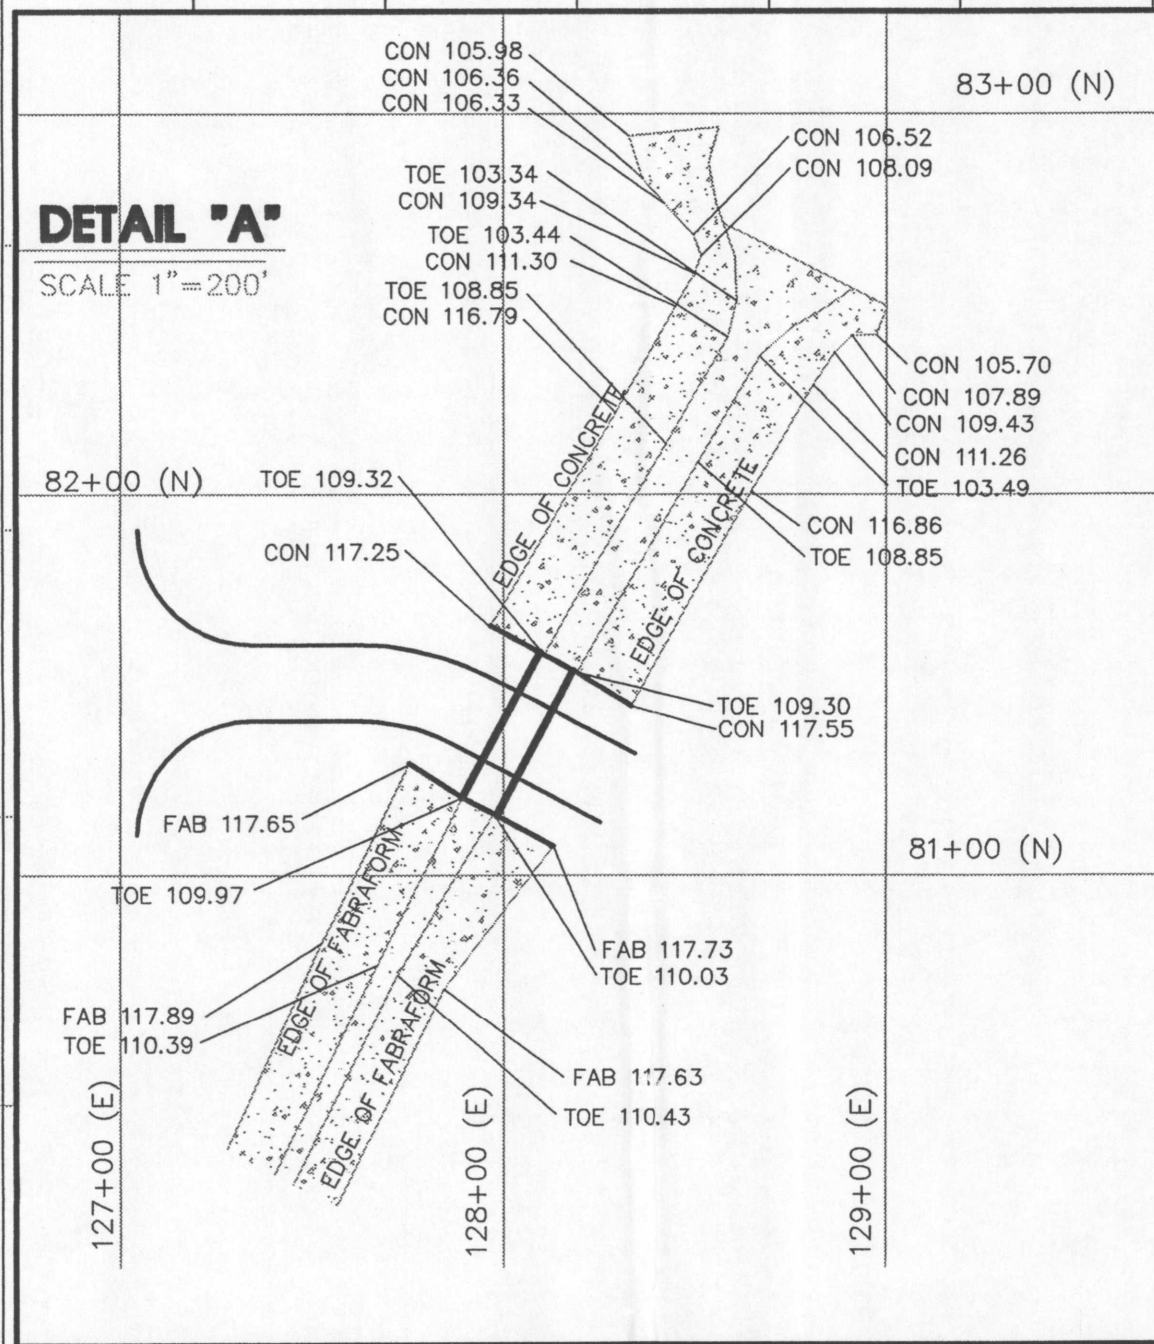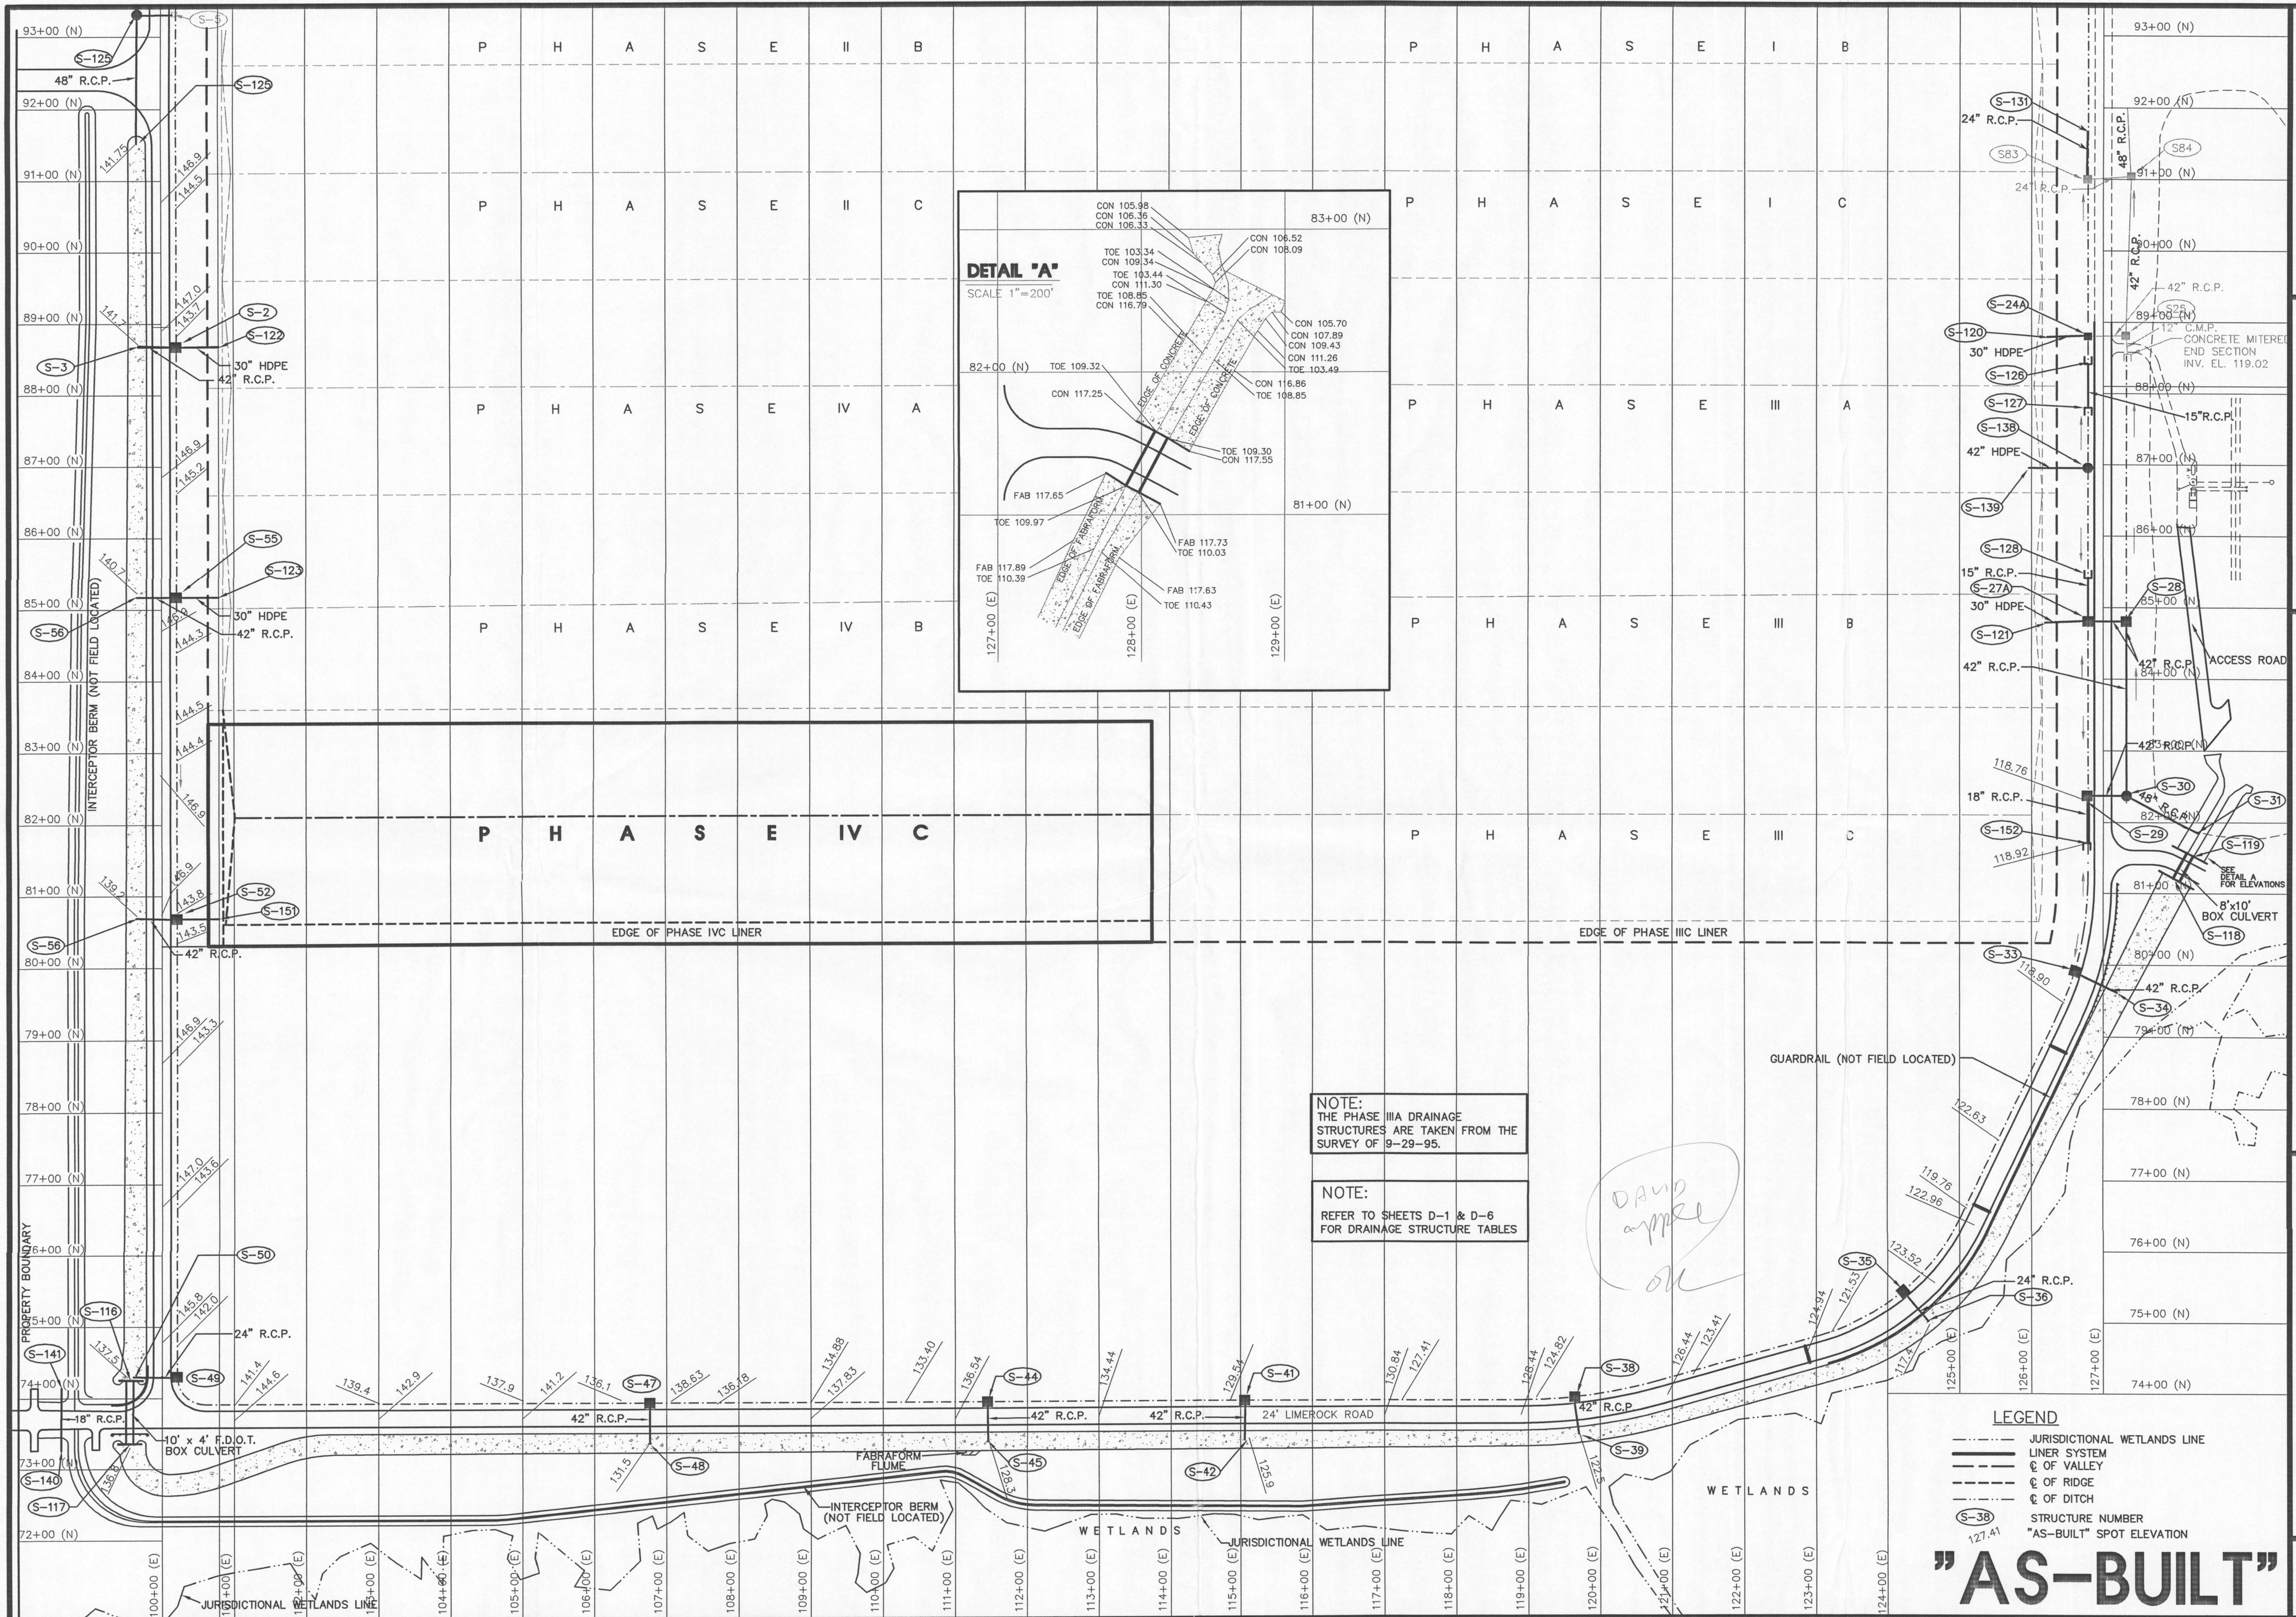

NOTE:
THE PHASE IIIA DRAINAGE
STRUCTURES ARE TAKEN FROM THE
SURVEY OF 9-29-95.

NOTE:
REFER TO SHEETS D-1 & D-6
FOR DRAINAGE STRUCTURE TABLES

- LEGEND**
- JURISDICTIONAL WETLANDS LINE
 - LINER SYSTEM
 - OF VALLEY
 - OF RIDGE
 - OF DITCH
 - (S-38) STRUCTURE NUMBER
 - "AS-BUILT" SPOT ELEVATION

"AS-BUILT"

NOT VALID WITHOUT THE SIGNATURE AND THE ORIGINAL RAISED SEAL OF A FLORIDA LICENSED SURVEYOR AND MAPPER.

REVISIONS:

DATE	DESCRIPTION
12/16/96	ADDED DRAINAGE STRUCTURES FOR PHASES IIIA, IVA, IVB.
12/20/00	ADDED DRAINAGE STRUCTURE S-152 FOR PHASE IIIC.
01/05/01	ADDED DRAINAGE STRUCTURE S-151 FOR PHASE IVC.

**DRAINAGE STRUCTURES
PHASES IIIA, IIIB, IIIC, IVA, IVB AND IVC**

**TRAIL RIDGE LANDFILL
FOR TRAIL RIDGE LANDFILL, INC. AND
CITY OF JACKSONVILLE**

Robert M. Angas Associates, Inc.
LAND SURVEYORS, PLANNERS AND CIVIL ENGINEERS
SINCE 1924
14775 St. Augustine Road, Jacksonville, FL 32258
Telephone: (904) 642-8550 Fax: (904) 642-4165
Certificate of Authorization No.: LB 3624

SHEET D-5

Q:\AS-BUILT\AS-BUILT\Trail\AS-BUILT\3rd\INDOR - 2.dwg 01/01/2016 10:44 AM, JLL

PHASE IIIA

STRUCTURE NUMBER	STRUCTURE DESCRIPTION	TOP ELEVATION		SLOT ELEVATION		INVERT ELEVATION		STATION	
		DESIGN	ASBUILT	DESIGN	ASBUILT	DESIGN	ASBUILT	DESIGN	ASBUILT
S-27	MOD. FDOT TYPE "E" INLET (DETAIL A)	121.50	121.48	118.78 (S)	118.65 (S)	115.28 (30" HDPE W) 115.28 (42" R.C.P. E) 118.78 (15" R.C.P. N)	FUTURE 30" HDPE W 115.23 (42" R.C.P. E) 118.58 (15" R.C.P. N)	84+80.00 (N) 128+78.01 (E)	84+80.18 (N) 128+78.01 (E)
S-28	FDOT TYPE "E" INLET W/ 7' TYPE J BOTTOM (ALTERNATE A)	121.50	121.57	118.50 (N&S)	118.48 (N&S)	115.28 (42" R.C.P. W) 113.00 (42" R.C.P. S)	115.17 (42" R.C.P. W) 112.90 (42" R.C.P. S)	84+80.00 (N) 127+33.57 (E)	84+81.14 (N) 128+78.89 (E)
S-29	FDOT TYPE "E" INLET	121.50	121.52	118.78 (N&S)	118.77(N&S)	118.28 (42" R.C.P. E) 118.28 (42" C.M.P. W)	118.48 (42" R.C.P. E) 115.50 (42" C.M.P. W)	82+37.00 (N) 128+77.27 (E)	82+37.03 (N) 128+78.89 (E)
S-30	FDOT TYPE "E" INLET W/ 7' TYPE J BOTTOM (ALTERNATE A)	121.50	121.53	120.00 (S)	120.00 (S)	118.28 (42" R.C.P. W) 110.98 (42" R.C.P. N) 110.48 (48" R.C.P. SE)	115.80 (42" R.C.P. W) 110.85 (42" R.C.P. N) 110.50 (48" R.C.P. SE)	82+37.00 (N) 127+32.27 (E)	82+45.81 (N) 127+32.12 (E)
S-31	CONST. 48" MITERED END INTO DITCH PAVING	—	—	—	—	109.10 (48" R.C.P. NW)	108.92 (48" R.C.P. NW)	81+84.78 (N) 128+30.89 (E)	81+84.78 (N) 128+31.13 (E)
S-33	MOD. FDOT TYPE "E" INLET (DETAIL A)	121.75	121.74	118.78 (N&S)	118.68 (N) 118.68 (S)	115.00 (30" HDPE NW) 111.85 (42" R.C.P. SE)	FUTURE 30" HDPE NW 111.98 (42" R.C.P. SE)	79+91.26 (N) 128+80.49 (E)	80+03.41 (N) 128+85.38 (E)
S-34	CONST. MITERED END INTO DITCH PAVING	—	—	—	—	111.85 (42" R.C.P. NW)	111.84 (42" R.C.P. NW)	79+91.82 (N) 127+19.07 (E)	79+93.30 (N) 127+17.68 (E)
S-111	18" C.M.P.	—	—	—	—	143.70 (18" C.M.P. E)	143.64 (18" C.M.P. E)	82+52.59 (N) 108+37.99 (E)	82+51.82 (N) 108+37.63 (E)
S-112	18" C.M.P.	—	—	—	—	142.70 (18" C.M.P. W)	142.64 (18" C.M.P. W)	82+52.59 (N) 103+81.00 (E)	82+52.54 (N) 103+82.01 (E)
S-113	18" C.M.P.	—	—	—	—	143.80 (18" C.M.P. E)	143.78 (18" C.M.P. E)	82+52.59 (N) 103+38.99 (E)	82+52.55 (N) 103+38.99 (E)
S-114	18" C.M.P.	—	—	—	—	142.40 (18" C.M.P. W)	142.32 (18" C.M.P. W)	82+52.59 (N) 104+80.80 (E)	82+52.55 (N) 104+80.44 (E)
S-115	18" C.M.P.	—	—	—	—	142.00 (18" C.M.P. E)	142.06 (18" C.M.P. E)	82+52.59 (N) 108+87.41 (E)	82+52.55 (N) 108+87.41 (E)
S-118	10' X 8' BOX CULVERT BOX CULVERT WITH 9.75' X 54' ENDWALL	—	—	—	—	110.00	110.07	81+54.02 (N) 128+20.27 (E)	81+54.88 (N) 128+21.85 (E)
S-119	10' X 8' BOX CULVERT BOX CULVERT WITH 9.75' X 54' ENDWALL	—	—	—	—	109.30	109.36	81+54.02 (N) 128+20.27 (E)	81+54.88 (N) 128+21.85 (E)
S-128	15" FDOT MITERED END SECTION	—	—	—	—	118.80 (15" R.C.P. S)	118.77 (15" R.C.P. S)	88+40.50 (N) 128+78.77 (E)	88+46.74 (N) 128+79.37 (E)
S-127	15" FDOT MITERED END SECTION	—	—	—	—	119.00 (15" R.C.P. N)	118.94 (15" R.C.P. N)	87+79.50 (N) 128+78.77 (E)	87+87.18 (N) 128+78.47 (E)
S-128	15" FDOT MITERED END SECTION	—	—	—	—	119.00 (15" R.C.P. N)	118.89 (15" R.C.P. N)	85+40.50 (N) 128+78.77 (E)	85+54.74 (N) 128+78.47 (E)

AS-BUILT DRAINAGE STRUCTURE TABLE

PHASES IIIB, IVA AND IVB

STRUCTURE NUMBER	STRUCTURE DESCRIPTION	TOP ELEVATION		SLOT ELEVATION		INVERT ELEVATION		STATION	
		DESIGN	ASBUILT	DESIGN	ASBUILT	DESIGN	ASBUILT	DESIGN	ASBUILT
S-2	MOD. FDOT TYPE "E" INLET (DETAIL B)	146.50	146.88	143.78 (N&S)	143.89 (N&S)	141.28 (30" HDPE E) 141.28 (42" R.C.P. W)	141.28 (42" R.C.P. W)	88+87.00 (N) 100+21.00 (E)	88+87.08 (N) 100+20.88 (E)
S-3	CONST. MITERED END INTO DITCH PAVING	—	—	—	—	141.28 (42" R.C.P. E)	141.37 (42" R.C.P. E)	88+87.00 (N) 99+88.00 (E)	88+88.88 (N) 99+88.45 (E)
S-24A	MOD. FDOT TYPE "E" INLET (DETAIL A)	121.50	121.45	118.78 (N&S)	118.71 (N) 118.67 (S)	116.87 (30" HDPE W) 116.87 (42" R.C.P. E)	118.78 (30" HDPE W) 118.78 (42" R.C.P. E)	88+80.00 (N) 128+78.77 (E)	15701.7482 (N) 22530.5721 (E)
S-35	FDOT TYPE "E" INLET	123.00	122.83	120.48 (SW)	120.81 (SW)	117.20 (24" R.C.P. SE)	117.19 (24" R.C.P. SE)	75+43.59 (N) 124+21.39 (E)	75+42.14 (N) 12418.7658 (E)
S-36	CONST. MITERED END INTO DITCH PAVING	—	—	—	—	117.20 (24" R.C.P. NW)	117.28 (24" R.C.P. NW)	75+01.85 (N) 124+56.65 (E)	75+01.83 (N) 12456.4795 (E)
S-38	MOD. FDOT TYPE "E" INLET (DETAIL B) (SEE DETAIL S-38)	128.80	127.04	124.28 (W)	124.39 (W)	122.36 (FUTURE 30" HDPE N) 122.36 (42" R.C.P. S)	122.31 (42" R.C.P. S)	73+85.00 (N) 119+64.40 (E)	73+84.27 (N) 119+62.94 (E)
S-39	CONST. MITERED END INTO DITCH PAVING	—	—	—	—	122.36 (42" R.C.P. N)	122.48 (42" R.C.P. N)	73+42.84 (N) 119+70.00 (E)	73+42.84 (N) 119+70.35 (E)
S-41	MOD. FDOT TYPE "E" INLET (DETAIL B)	132.00	132.19	129.31 (W)	129.57 (W)	125.80 (FUTURE 30" HDPE N) 125.80 (42" R.C.P. S)	125.59 (42" R.C.P. S)	73+91.00 (N) 115+08.00 (E)	73+91.32 (N) 115+08.72 (E)
S-42	CONST. MITERED END INTO DITCH PAVING	—	—	—	—	125.80 (42" R.C.P. N)	125.85 (42" R.C.P. N)	73+36.08 (N) 115+06.00 (E)	73+35.39 (N) 115+05.98 (E)
S-44	MOD. FDOT TYPE "E" INLET (DETAIL B) (SEE DETAIL S-44)	135.00	135.34	132.30 (W)	132.49 (W)	128.27 (FUTURE 30" HDPE N) 128.27 (42" R.C.P. S)	128.22 (42" R.C.P. S)	73+91.00 (N) 111+45.00 (E)	73+91.04 (N) 111+45.22 (E)
S-45	CONST. MITERED END INTO DITCH PAVING	—	—	—	—	128.27 (42" R.C.P. N)	128.33 (42" R.C.P. N)	73+34.65 (N) 111+45.00 (E)	73+34.77 (N) 111+45.64 (E)
S-47	MOD. FDOT TYPE "E" INLET (DETAIL B) (SEE DETAIL S-47)	138.00	138.07	136.35 (W)	136.42 (W)	131.46 (FUTURE 30" HDPE N) 131.46 (42" R.C.P. S)	130.73 (42" R.C.P. S)	73+91.00 (N) 108+77.00 (E)	73+90.52 (N) 108+77.11 (E)
S-48	CONST. MITERED END INTO DITCH PAVING	—	—	—	—	131.46 (42" R.C.P. N)	131.54 (42" R.C.P. N)	73+33.35 (N) 106+77.00 (E)	73+33.46 (N) 106+76.98 (E)
S-49	FDOT TYPE "E" INLET (SEE DETAIL S-47)	145.00	145.02	142.36 (N)	142.41 (N)	136.73 (24" R.C.P. W)	138.09 (24" R.C.P. W) BOTTOM OF BOX	74+30.00 (N) 100+21.00 (E)	74+28.17 (N) 100+20.10 (E)
S-50	CONST. MITERED END INTO DITCH PAVING	—	—	—	—	136.73 (24" R.C.P. E)	136.74 (24" R.C.P. E)	74+30.00 (N) 99+60.00 (E)	74+29.82 (N) 99+60.38 (E)
S-52	MOD. FDOT TYPE "E" INLET (DETAIL B)	146.50	146.59	143.78 (N&S)	143.83 (N) 143.80 (S)	138.74 (FUTURE 30" HDPE E) 138.74 (42" R.C.P. W)	138.13 (42" R.C.P. W)	80+88.00 (N) 100+21.00 (E)	80+87.27 (N) 100+20.68 (E)
S-53	CONST. MITERED END INTO DITCH PAVING	—	—	—	—	138.74 (42" R.C.P. E)	138.70 (42" R.C.P. E)	80+88.00 (N) 99+83.00 (E)	80+89.08 (N) 99+84.43 (E)
S-55	MOD. FDOT TYPE "E" INLET (DETAIL B)	146.50	146.56	143.78 (N&S)	143.82 (N) 143.86 (S)	140.13 (30" HDPE E) 140.13 (42" R.C.P. W)	140.28 (42" R.C.P. W)	85+17.00 (N) 100+21.00 (E)	85+17.28 (N) 100+20.48 (E)
S-56	CONST. MITERED END INTO DITCH PAVING	—	—	—	—	140.13 (42" R.C.P. E)	140.32 (42" R.C.P. E)	85+17.00 (N) 99+85.74 (E)	85+18.10 (N) 99+85.77 (E)
S-116	10' X 4' FDOT BOX CULVERT WITH 5.75' X 46' ENDWALL	—	142.50	—	—	136.71	136.94	74+24.15 (N) 99+55.00 (E)	74+24.71 (N) 99+56.87 (E)
S-117	10' X 4' FDOT BOX CULVERT WITH 5.75' X 46' ENDWALL	—	142.22	—	—	136.42	136.36	73+36.15 (N) 99+55.00 (E)	73+35.88 (N) 99+54.78 (E)
S-121	30" HDPE PIPE	—	—	—	—	134.28 (30" HDPE E)	133.02 (30" HDPE E)	84+80.00 (N) 128+19.57 (E)	84+80.43 (N) 128+40.93 (E)
S-122	30" HDPE PIPE	—	—	—	—	159.00 (30" HDPE W)	159.00 (30" HDPE W)	88+87.00 (N) 100+79.40 (E)	88+87.68 (N) 100+79.89 (E)
S-123	30" HDPE PIPE	—	—	—	—	159.00 (30" HDPE W)	159.00 (30" HDPE W)	85+17.00 (N) 100+79.40 (E)	85+17.43 (N) 100+79.76 (E)
S-124	J-1-D MANHOLE	146.50	147.31 N. RM	—	—	141.42 EXIST 42" C.M.P. 141.42 (48" R.C.P. S)	141.51 (48" R.C.P. S)	93+31.00 (N) 99+67.00 (E)	93+29.98 (N) 99+66.74 (E)
S-125	CONST. MITERED END INTO DITCH PAVING	—	—	—	—	141.30 (48" R.C.P. N)	141.21 (48" R.C.P. N)	91+49.00 (N) 99+67.00 (E)	91+51.82 (N) 99+66.37 (E)
S-131	15" FDOT MITERED END SECTION	—	—	—	—	118.75 (15" R.C.P. S)	118.01 (15" R.C.P. S)	91+80.00 (N) 128+78.77 (E)	91+85.87 (N) 128+78.61 (E)
S-132	15" FDOT MITERED END SECTION	—	—	—	—	118.40 (15" R.C.P. S)	118.40 (15" R.C.P. S)	94+40.00 (N) 128+78.77 (E)	94+44.48 (N) 127+07.78 (E)
S-133	15" FDOT MITERED END SECTION	—	—	—	—	118.15 (15" R.C.P. N)	119.34 (15" R.C.P. N)	93+80.00 (N) 128+78.77 (E)	93+78.83 (N) 128+83.28 (E)
S-138	J-1-C MANHOLE	127.50	—	—	—	118.78 (42" C.M.P. W) 118.78 (42" C.M.P. S)	119.54 (42" C.M.P. S)	88+94.81 (N) 128+78.77 (E)	87+02.72 (N) 127+81.43 (E)
S-139	42" C.M.P.	—	—	—	—	135.00 (42" C.M.P. E)	135.29 (42" C.M.P. E)	88+94.81 (N) 128+00.00 (E)	87+05.28 (N) 128+64.01 (E)

PHASES IIIC AND IVC

STRUCTURE NUMBER	STRUCTURE DESCRIPTION	TOP ELEVATION		SLOT ELEVATION		INVERT ELEVATION		STATION	
		DESIGN	ASBUILT	DESIGN	ASBUILT	DESIGN	ASBUILT	DESIGN	ASBUILT
S-152	18" FDOT MITERED END SECTION	—	—	—	—	118.9 (18" R.C.P.)	118.9 (18" R.C.P.)	81+70.82 (N) 128+78.77 (E)	81+70.83 (N) 128+78.48 (E)
S-151	30" HDPE PIPE	—	—	—	—	158.0 (30" HDPE W)	158.1 (30" HDPE W)	80+68.00 (N) 100+78.40 (E)	80+68.90 (N) 100+78.80 (E)

REVISIONS:


12/16/96
ADDED DRAINAGE STRUCTURES FOR
PHASES IIIB, IVA, IVB AND IVB
12/20/00
ADDED DRAINAGE STRUCTURE DATA
FOR PHASE IIIC
01/05/01
ADDED DRAINAGE STRUCTURE DATA
FOR PHASE IVC.

DRAINAGE STRUCTURE TABLES

PHASES IIIA, IIIB, IIIC, IVA, IVB AND IVC

TRAIL RIDGE LANDFILL
FOR TRAIL RIDGE LANDFILL, INC. AND
CITY OF JACKSONVILLE

(FORMERLY SUNSHINE STATE SURVEYORS)

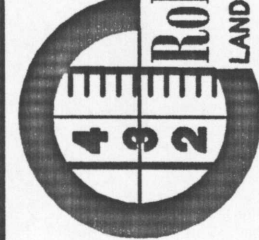

Robert M. Angas Associates, Inc.
LAND SURVEYORS, PLANNERS AND CIVIL ENGINEERS
SINCE 1924
14775 St. Augustine Road, Jacksonville, FL 32258
Telephone: (904) 642-8550 Fax: (904) 642-4165
Certificate of Authorization No.: LB 3624

SHEET D-6

"AS-BUILT"

NOT VALID WITHOUT THE SIGNATURE AND THE ORIGINAL RAISED
SEAL OF A FLORIDA LICENSED SURVEYOR AND MAPPER.
JOSEPH LESLIE REYNOLDS, III
PROFESSIONAL SURVEYOR AND MAPPER
STATE OF FLORIDA LS No. 5917

"AS-BUILT" SUBGRADE LOCATION TABLE		
PHASE	DATE:	LOCATION:
IIIC	07-11-00	STA. 80+60.00 TO STA. 81+60.00 (NORTH) STA. 114+00.00 TO STA. 115+00.00 (EAST)
IIIC	07-17-00	STA. 80+60.00 TO STA. 82+10.00 (NORTH) STA. 115+50.00 TO STA. 121+00.00 (EAST)
IIIC	07-21-00	STA. 80+30.00 TO STA. 82+10.00 (NORTH) STA. 114+00.00 TO STA. 125+50.00 (EAST)
IIIC	07-31-00	STA. 82+02.50 TO STA. 82+17.50 (NORTH) STA. 114+00.00 TO STA. 125+50.00 (EAST)
IIIC	08-01-00	STA. 82+00.50 TO STA. 82+16.50 (NORTH) STA. 114+24.00 TO STA. 125+50.00 (EAST)
IIIC	08-04-00	STA. 82+15.50 TO STA. 83+10.00 (NORTH) STA. 114+00.00 TO STA. 120+00.00 (EAST)
IIIC	08-08-00	STA. 82+15.50 TO STA. 83+39.00 (NORTH) STA. 114+00.00 TO STA. 125+50.00 (EAST)
IIIC	08-10-00	STA. 80+30.00 TO STA. 83+40.00 (NORTH) STA. 113+60.00 TO STA. 126+01.73 (EAST)
IIIC	08-14-00	STA. 80+30.00 TO STA. 83+40.00 (NORTH) STA. 126+00.00 TO STA. 126+40.77 (EAST)
IIIC	08-15-00	STA. 80+30.00 TO STA. 82+60.00 (NORTH) STA. 126+00.00 TO STA. 126+34.77 (EAST)
IIIC	08-18-00	STA. 79+75.00 TO STA. 80+22.00 (NORTH) STA. 119+00.00 TO STA. 123+50.00 (EAST)
IVC	09-01-00	STA. 80+60.00 TO STA. 82+60.00 (NORTH) STA. 101+00.00 TO STA. 104+00.00 (EAST)
IVC	09-05-00	STA. 80+30.00 TO STA. 83+35.00 (NORTH) STA. 101+00.00 TO STA. 108+00.00 (EAST)
IVC	09-06-00	STA. 80+30.00 TO STA. 83+35.00 (NORTH) STA. 104+50.00 TO STA. 108+50.00 (EAST)
IVC	09-12-00	STA. 82+05.10 TO STA. 82+14.60 (NORTH) STA. 109+00.00 TO STA. 113+00.00 (EAST)
IVC	09-13-00	STA. 80+30.00 TO STA. 83+35.00 (NORTH) STA. 100+57.00 TO STA. 100+99.00 (EAST)
IVC	09-15-00	STA. 80+30.00 TO STA. 83+35.00 (NORTH) STA. 107+50.00 TO STA. 112+50.00 (EAST)
IVC	09-15-00	STA. 80+30.00 TO STA. 83+35.00 (NORTH) STA. 107+50.00 TO STA. 112+50.00 (EAST)
IVC	10-19-00	STA. 82+10.00 TO STA. 83+37.00 (NORTH) STA. 112+70.60 TO STA. 113+54.90 (EAST)
IVC	11-28-00	STA. 80+30.00 TO STA. 82+16.00 (NORTH) STA. 113+00.00 TO STA. 113+50.00 (EAST)

"AS-BUILT" SUBBASE LOCATION TABLE		
PHASE	DATE:	LOCATION:
IIIC	08-17-00	STA. 82+06.40 TO STA. 83+40.00 (NORTH) STA. 113+75.00 TO STA. 116+00.00 (EAST)
IIIC	08-18-00	STA. 80+30.00 TO STA. 82+12.50 (NORTH) STA. 113+75.00 TO STA. 116+00.00 (EAST)
IIIC	08-22-00	STA. 80+30.00 TO STA. 83+40.00 (NORTH) STA. 113+75.00 TO STA. 117+00.00 (EAST)
IIIC	08-23-00	STA. 80+30.00 TO STA. 83+40.00 (NORTH) STA. 116+50.00 TO STA. 120+00.00 (EAST)
IIIC	08-25-00	STA. 80+30.00 TO STA. 83+40.00 (NORTH) STA. 120+00.00 TO STA. 121+00.00 (EAST)
IIIC	08-26-00	STA. 80+30.00 TO STA. 83+40.00 (NORTH) STA. 121+50.00 TO STA. 125+00.00 (EAST)
IIIC	09-26-00	STA. 82+06.50 TO STA. 83+40.00 (NORTH) STA. 124+60.00 TO STA. 125+50.00 (EAST)
IIIC	09-27-00	STA. 82+60.00 TO STA. 83+40.00 (NORTH) STA. 126+00.00 TO STA. 126+37.27 (EAST)
IIIC	09-28-00	STA. 80+60.00 TO STA. 82+32.41 (NORTH) STA. 125+62.96 TO STA. 126+34.77(EAST)
IIIC	10-04-00	STA. 80+30.00 TO STA. 81+60.00 (NORTH) STA. 126+04.31 TO STA. 126+35.75 (EAST)
IIIC	11-10-00	STA. 80+60.00 TO STA. 83+40.00 (NORTH) STA. 126+21.00 TO STA. 126+25.00 (EAST)
IIIC	11-28-00	STA. 80+60.00 TO STA. 83+40.00 (NORTH) STA. 126+25.00 TO STA. 126+29.00 (EAST)
IVC	10-06-00	STA. 80+60.00 TO STA. 83+40.00 (NORTH) STA. 101+00.00 TO STA. 106+00.00 (EAST)
IVC	10-09-00	STA. 80+60.00 TO STA. 80+30.00 (NORTH) STA. 106+50.00 TO STA. 109+00.00 (EAST)
IVC	10-10-00	STA. 80+30.00 TO STA. 83+40.00 (NORTH) STA. 100+63.40 TO STA. 112+00.00 (EAST)
IVC	12-01-00	STA. 80+30.00 TO STA. 83+40.00 (NORTH) STA. 112+50.00 TO STA. 113+50.00 (EAST)

"AS-BUILT" SAND BLANKET LOCATION TABLE		
PHASE	DATE:	LOCATION:
IIIC	11-13-00	STA. 81+10.00 TO STA. 83+40.00 (NORTH) STA. 115+00.00 TO STA. 117+50.00 (EAST)
IIIC	11-14-00	STA. 80+45.00 TO STA. 83+40.00 (NORTH) STA. 118+00.00 TO STA. 123+50.00 (EAST)
IIIC	11-15-00	STA. 80+45.00 TO STA. 83+40.00 (NORTH) STA. 124+00.00 TO STA. 125+50.00 (EAST)
IIIC	11-20-00	STA. 80+68.00 TO STA. 83+40.00 (NORTH) STA. 114+00.00 (EAST)
IIIC	12-01-00	STA. 80+05.00 TO STA. 82+15.00 (NORTH) STA. 114+00.00 (EAST)
IVC	12-06-00	STA. 80+55.00 TO STA. 80+65.00 (NORTH) STA. 101+00.00 TO STA. 110+00.00 (EAST)
IVC	12-13-00	STA. 80+60.00 TO STA. 83+40.00 (NORTH) STA. 100+73.75 (EAST)
IVC	01-03-01	STA. 80+55.00 TO STA. 80+65.00 (NORTH) STA. 110+00.00 TO STA. 113+00.00 (EAST)
IVC	01-04-01	STA. 81+10.00 TO STA. 83+40.00 (NORTH) STA. 100+86.50 TO STA. 106+50.00 (EAST)
IVC	01-08-01	STA. 80+55.00 TO STA. 83+40.00 (NORTH) STA. 100+87.60 TO STA. 113+50.00 (EAST)
IVC	01-15-01	STA. 81+10.00 TO STA. 83+40.00 (NORTH) STA. 107+50.00 TO STA. 110+00.00 (EAST)
IVC	01-16-01	STA. 81+10.00 TO STA. 83+40.00 (NORTH) STA. 110+50.00 TO STA. 113+50.00 (EAST)

AS-BUILT LOCATION TABLE
PHASES IIIA, IIIB, IIIC, IVA, IVB AND IVC
TRAIL RIDGE LANDFILL
FOR TRAIL RIDGE LANDFILL, INC. AND
CITY OF JACKSONVILLE

4

3

2

Robert M. Angas Associates, inc.
LAND SURVEYORS, PLANNERS AND CIVIL ENGINEERS
14775 St. Augustine Road, Jacksonville, FL 32258
Telephone: (904) 642-8550 Fax: (904) 642-4165
Certificate of Authorization No.: LB 3624

(FORMERLY SUNSHINE STATE SURVEYORS)

NOT VALID WITHOUT THE SIGNATURE AND THE ORIGINAL RAISED SEAL OF A FLORIDA LICENSED SURVEYOR AND MAPPER.

Joseph Leslie Bernoldus, III
PROFESSIONAL SURVEYOR AND MAPPER
STATE OF FLORIDA - LS No. 5517

REVISIONS:
1-03-01 ADDED AS-BUILTS FOR PHASE IVC

"AS-BUILT"

SHEET LS-9