


1 BLOWER BLDG. CROSS SECTION
 S-6 SCALE: 3/8" = 1'-0"

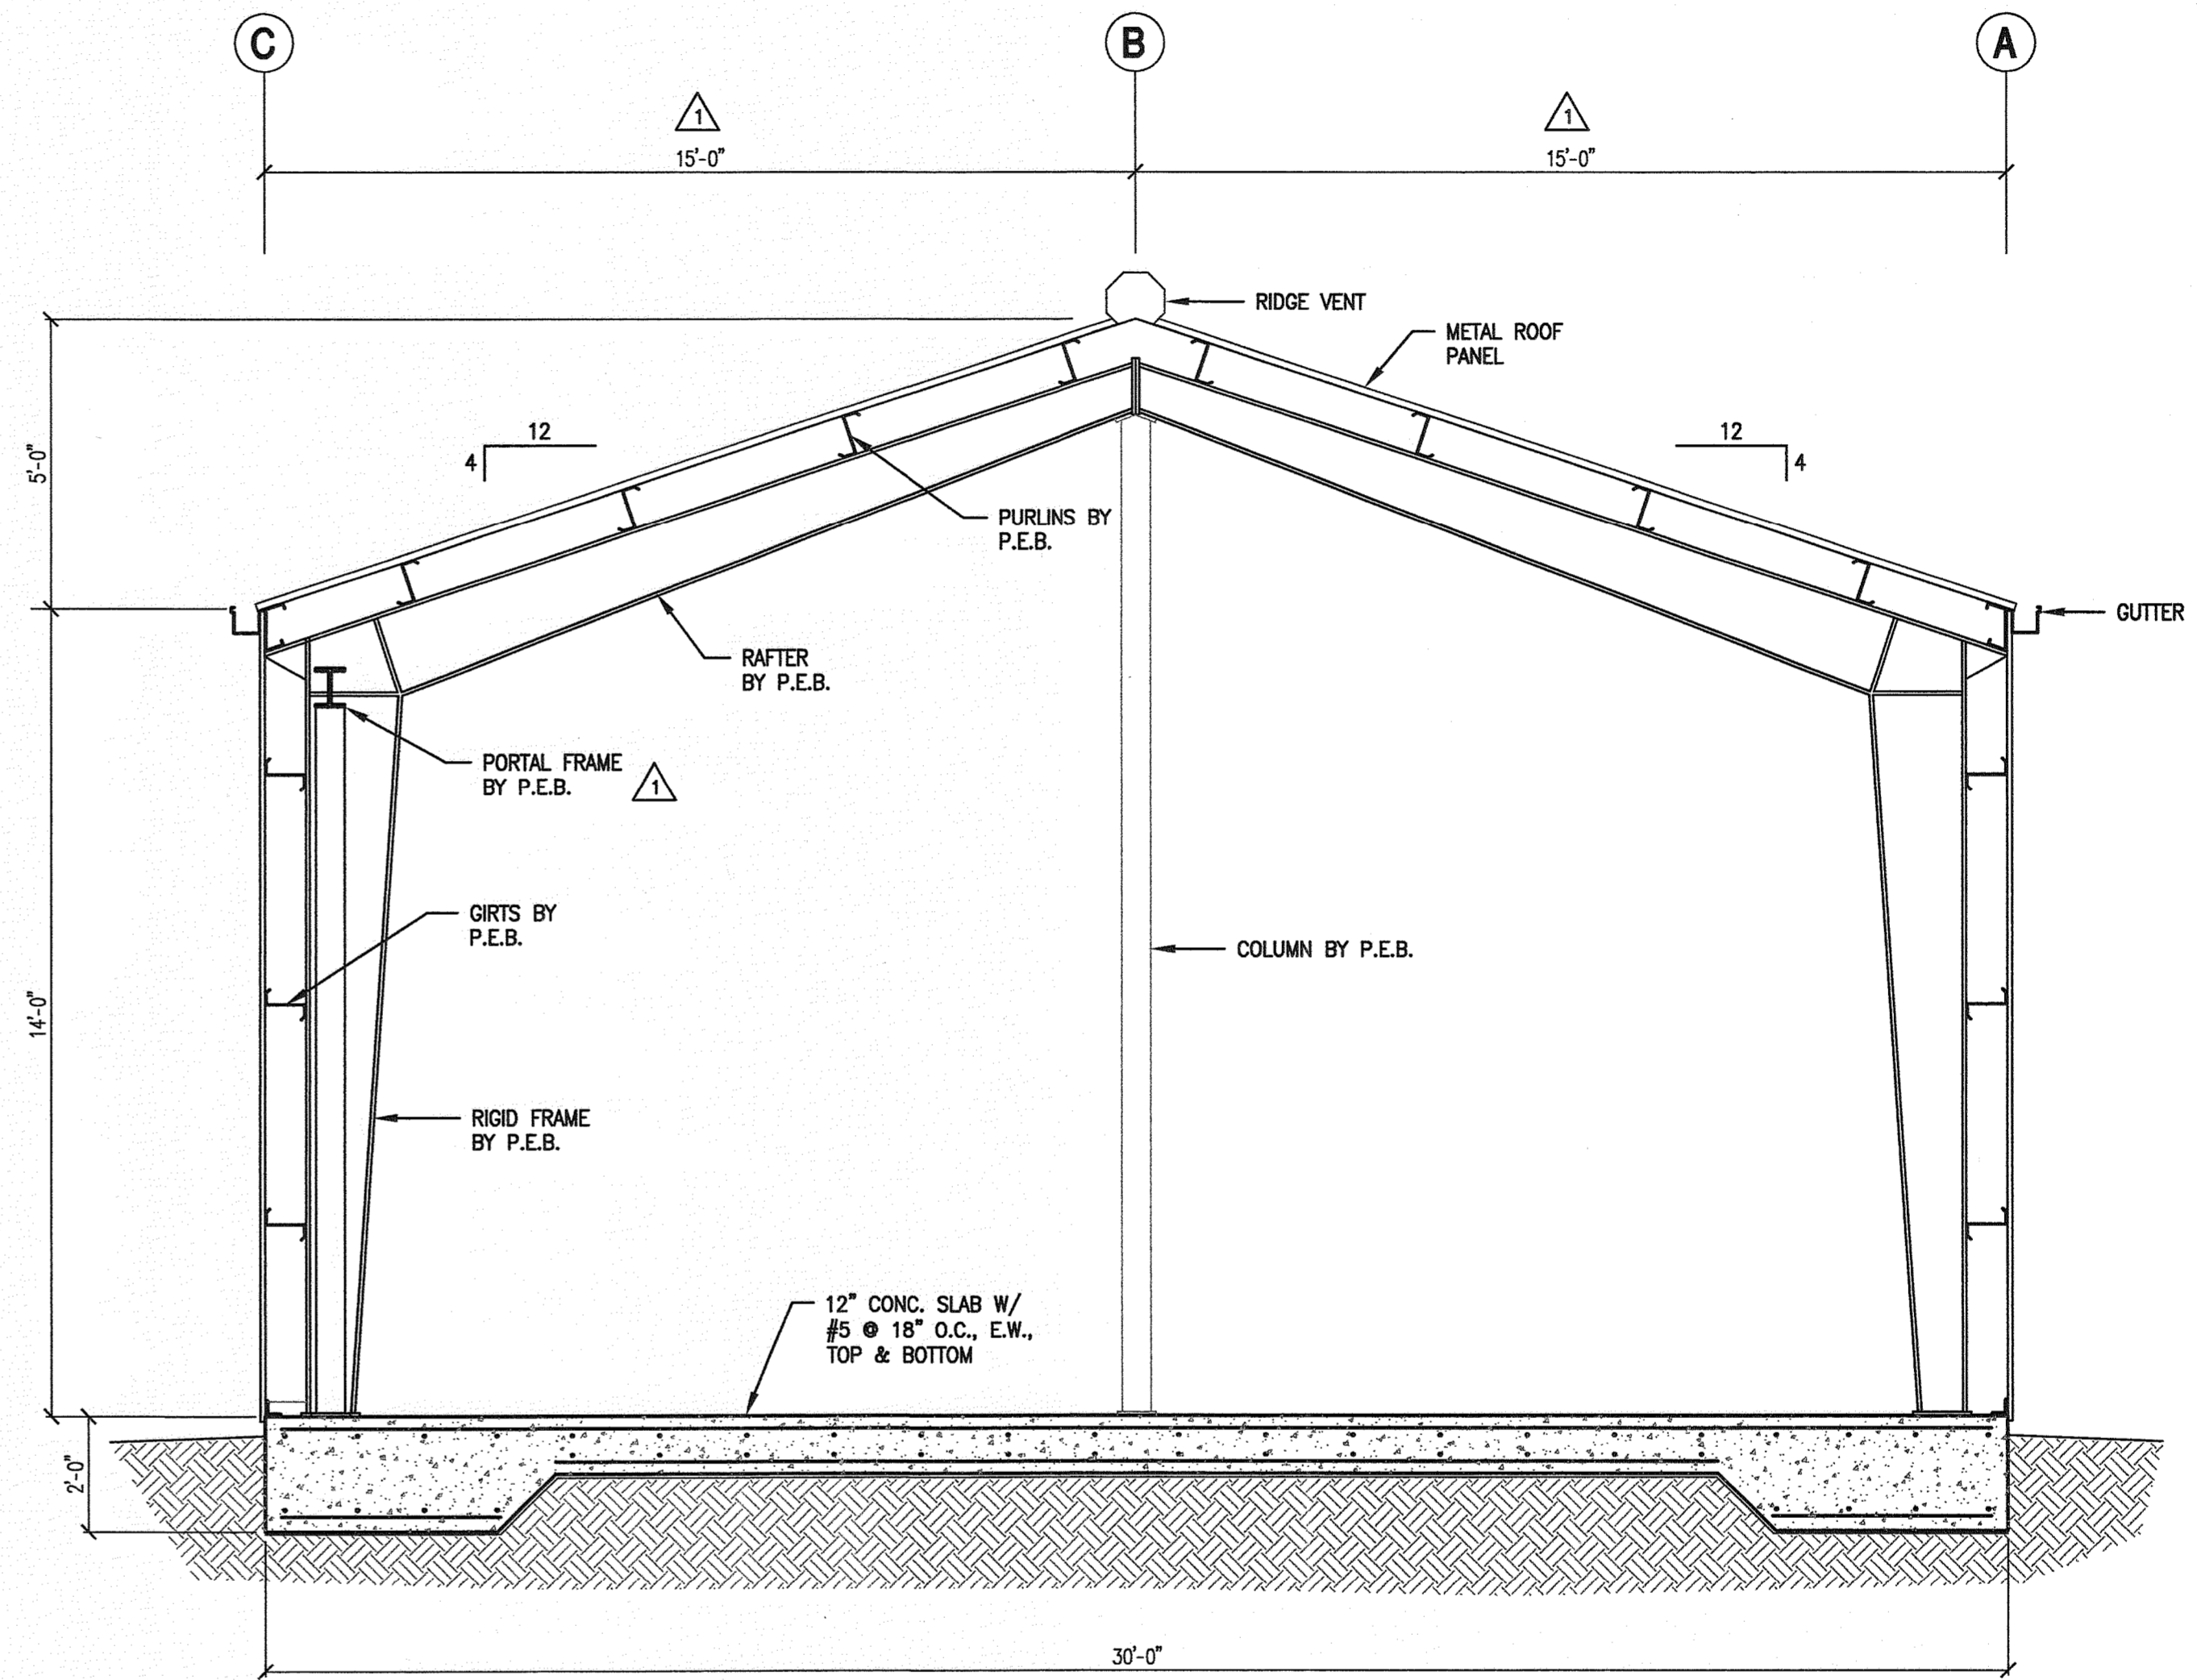

2 STORAGE BLDG. CROSS SECTION
 S-6 SCALE: 3/8" = 1'-0"

REV	DATE	DESCRIPTION	BY
1	04/21/09	COLUMN CHANGE - PER OWNER	BE
2	4/15/10	REVISION FOR THE RECORD	BE
3			
4			
5			

DRAWING TITLE	BLOWER/STORAGE BUILDINGS
	CROSS SECTIONS
PROJECT	SOUTHFLORIDA COUNTY LANDFILL
	LANDFILL GAS COLLECTION AND CONTROL SYSTEM
CLIENT	HILLSBOROUGH COUNTY SOLID WASTE MANAGEMENT DEPARTMENT TAMPA, FLORIDA
SCS ENGINEERS	STEARNES, CONRAD AND SCHMIDT CONSULTING ENGINEERS 4041 Park Oaks Blvd., Suite 100, Tampa, FL 33610 PH (813) 821-0080 FAX NO. (813) 822-9757 FLORIDA CERTIFICATE OF AUTHORIZATION NO. 00004882
CADD FILE:	BE-3531 - S-6
DATE:	JULY 2008
SCALE:	AS SHOWN
DRAWING NO.	S-6 of 30

FLORIDA DEPARTMENT OF ENVIRONMENTAL PROTECTION
 APR 16 2010
 SOUTHWEST DISTRICT
 TAMPA

RECORD DRAWING
 DATE: APRIL 15, 2010

ELIZABETH A. BROADWAY
 PROFESSIONAL ENGINEER
 FLORIDA REGISTRATION NO. 38558

BROADWAY ENGINEERING, P.A.
 CIVIL, MECHANICAL, STRUCTURAL AND BUILDING DESIGN
 See Us At www.Broadway-Eng.com
 1335 W. Cass Street
 Tampa, Florida 33606 813-251-9244
 Fax 813-251-9330 Bus. Email: Info@Broadway-Eng.com
 Cell. Email: EB@Broadway-Eng.com
 BE-3531 Certificate of Authorization No. 4599

C:\Users\elb1321\Documents\10-04-2010 - 3 1/2" Blower Layout.dwg Apr 15, 2010 3:18pm Layout Name: S-6 By: 02/26/10 10:09